


Pursuant to a contract with and instructions from Edward Tiffin Surveyor General of the United States, bearing date the 2^d day of September 1855. We have examined, laid out, and surveyed the above described fractional Township and do hereby certify that it had such marks and bounds, both natural and artificial, as are represented on said plat, and described in the field notes made thereof and returned with the plat into the Surveyor General's Office. Certified this 5th day of April 1856

498



Scale of 40 Ch?

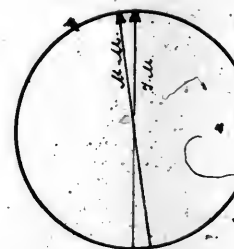

Wm. Telford
W. W. Grant
John M. Lee

327




Township 9 South Range 2 West of the 4th Principal Meridian


Township N. 10 South of Base Line Range N. ² West of 4th Principal Meridian
page 13 of 20.




78. 8
40. 30
28. 5-3
3. 2

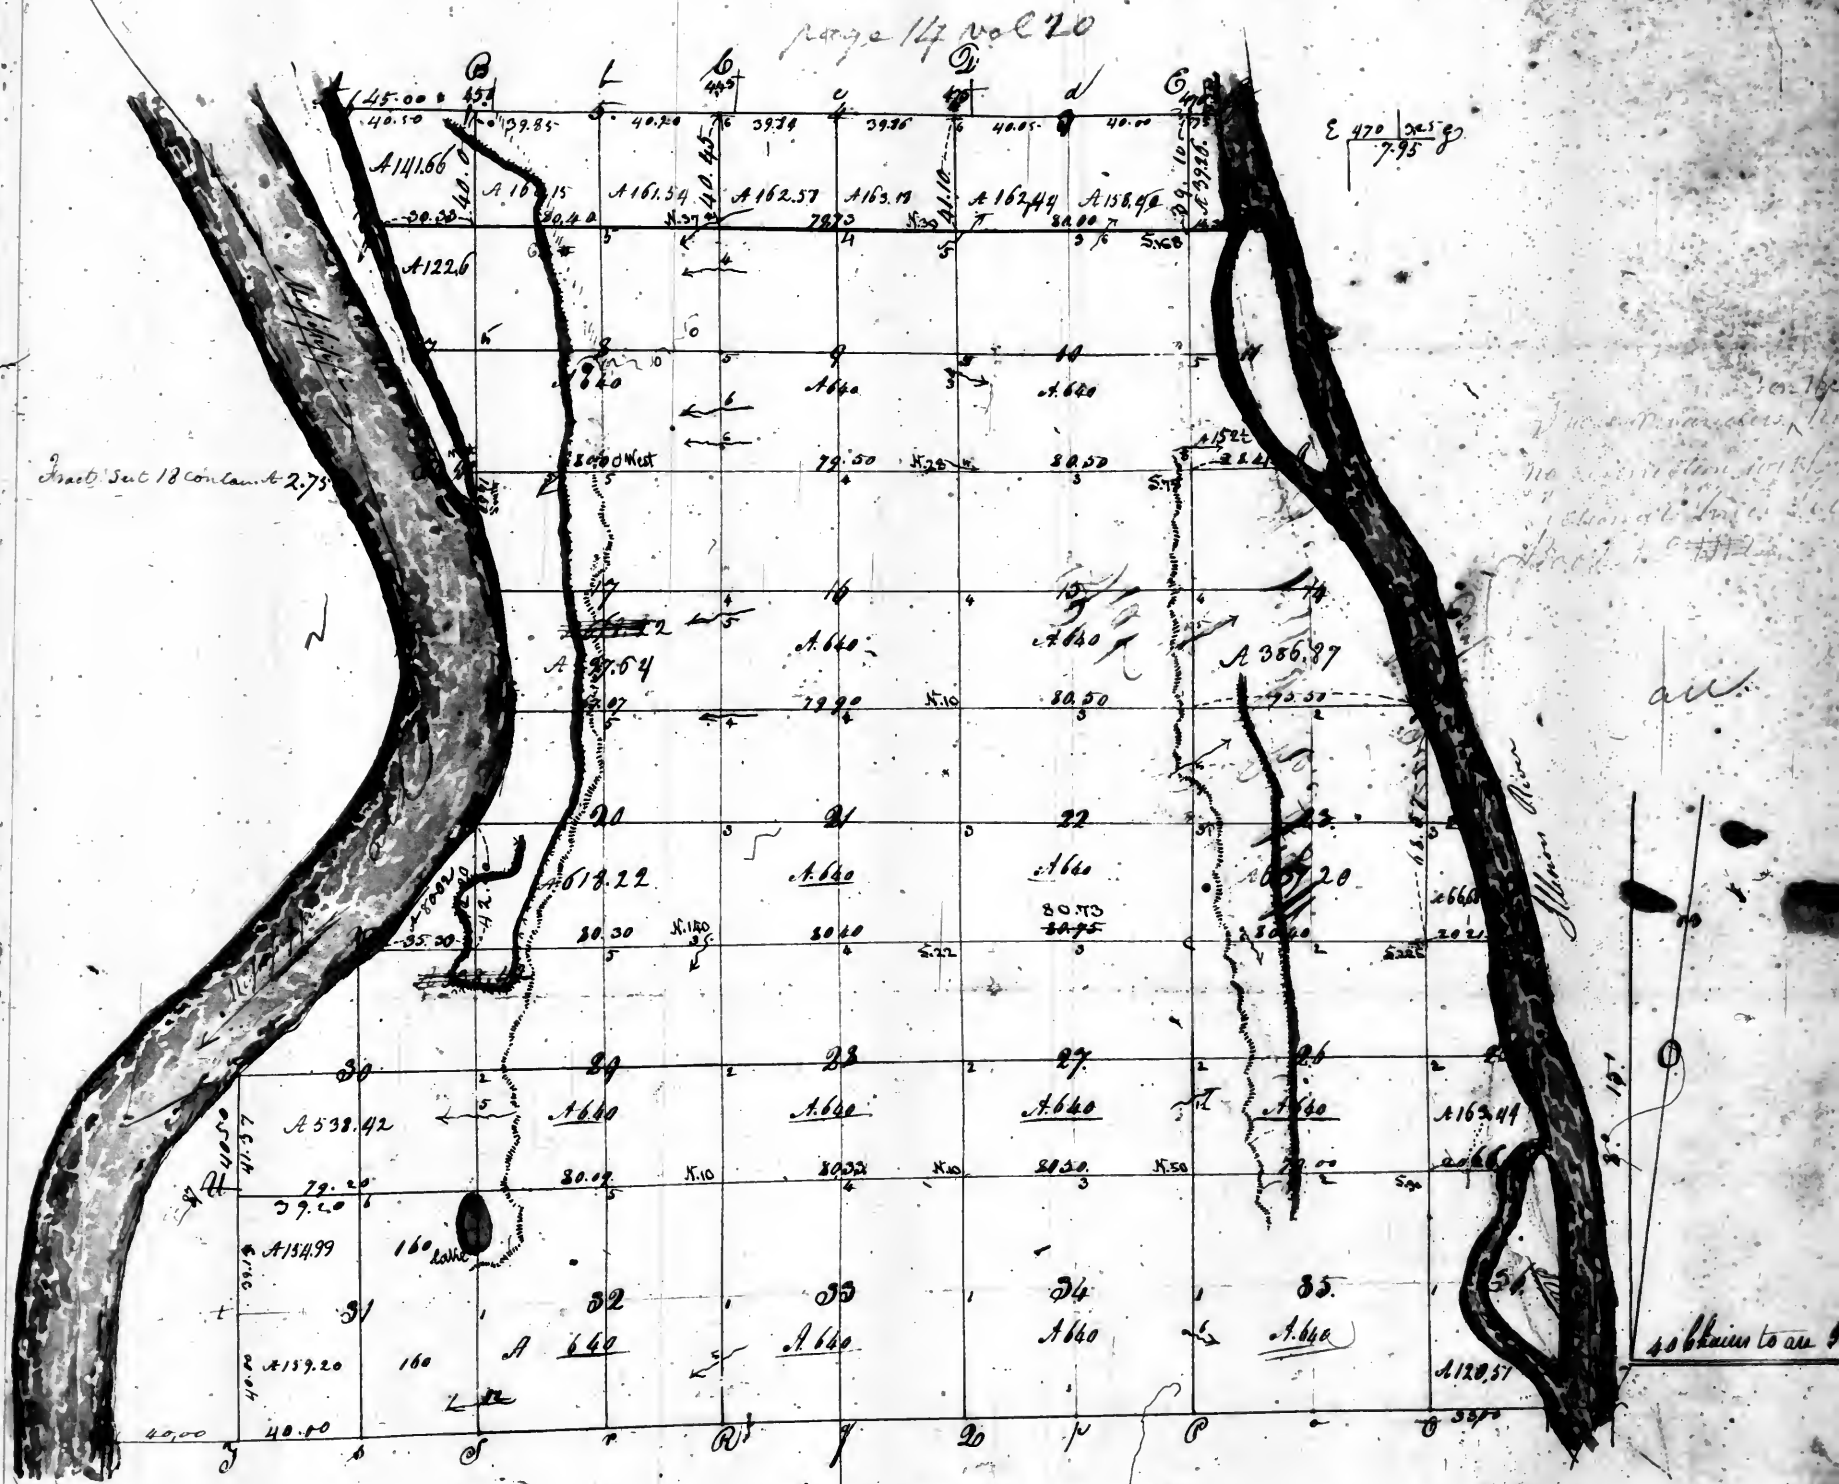


Township N. 11. South Range N. 2. West 4 Principle, Mordaan

For new Plat see Vol. 25. pag. 17

#118

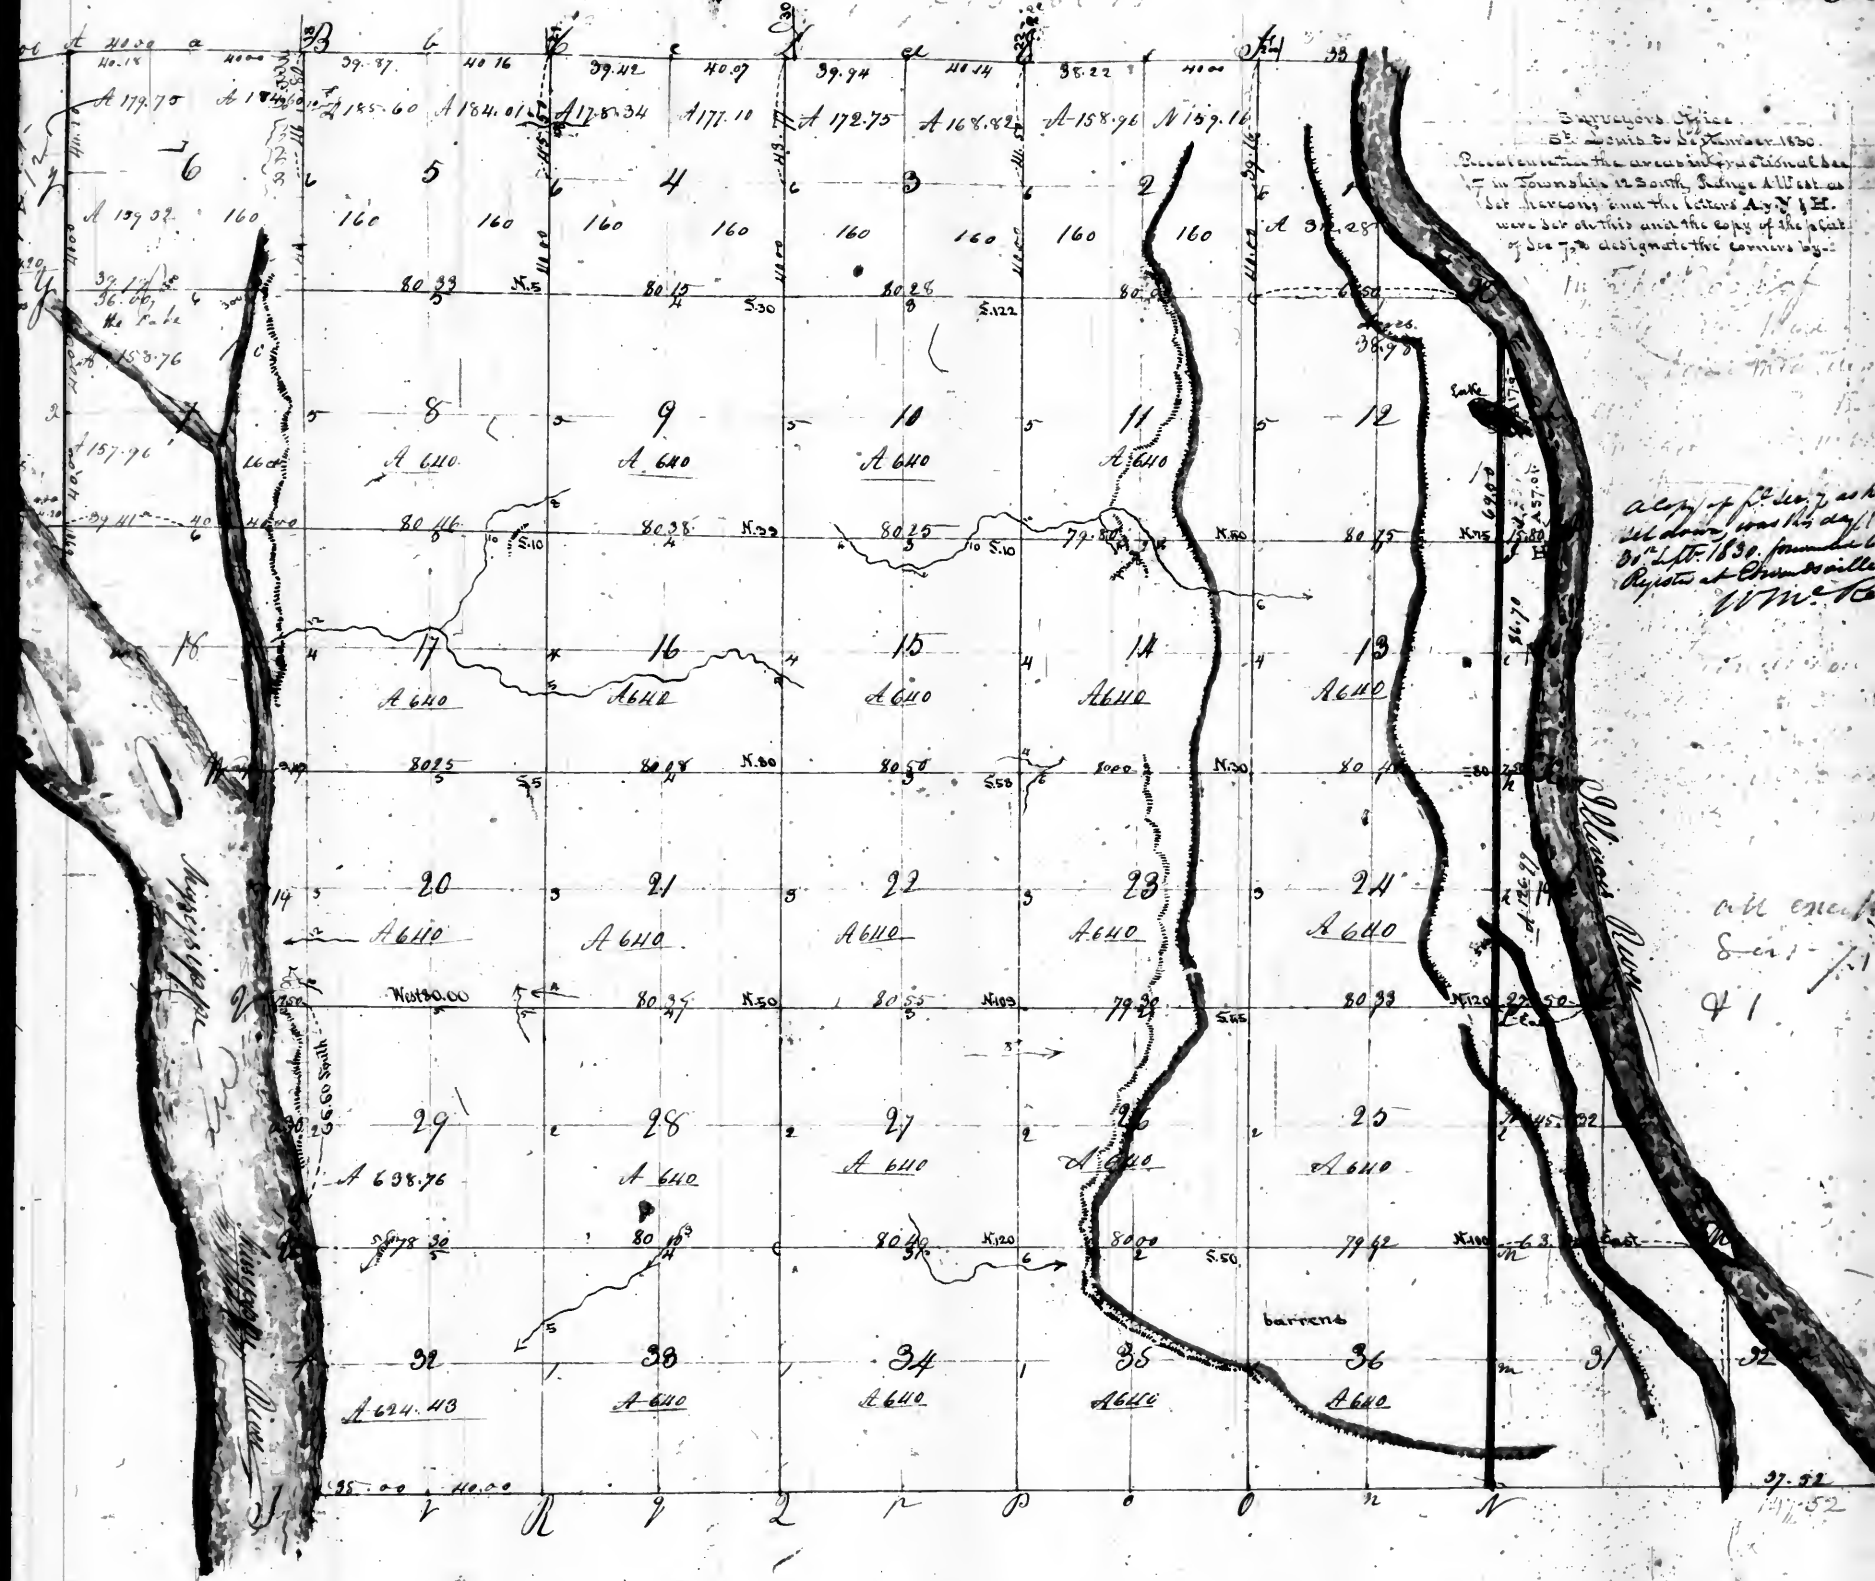


T 12 S. R. 2. W. & Fract T 12 S. R. 1. W. H. J. M. M.

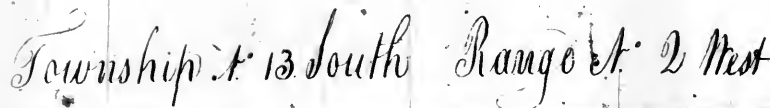

Corrected this 4th day of June 1817 John McDonald Do.

Township 1 South 2d Range 3 West of the Principal Meridian

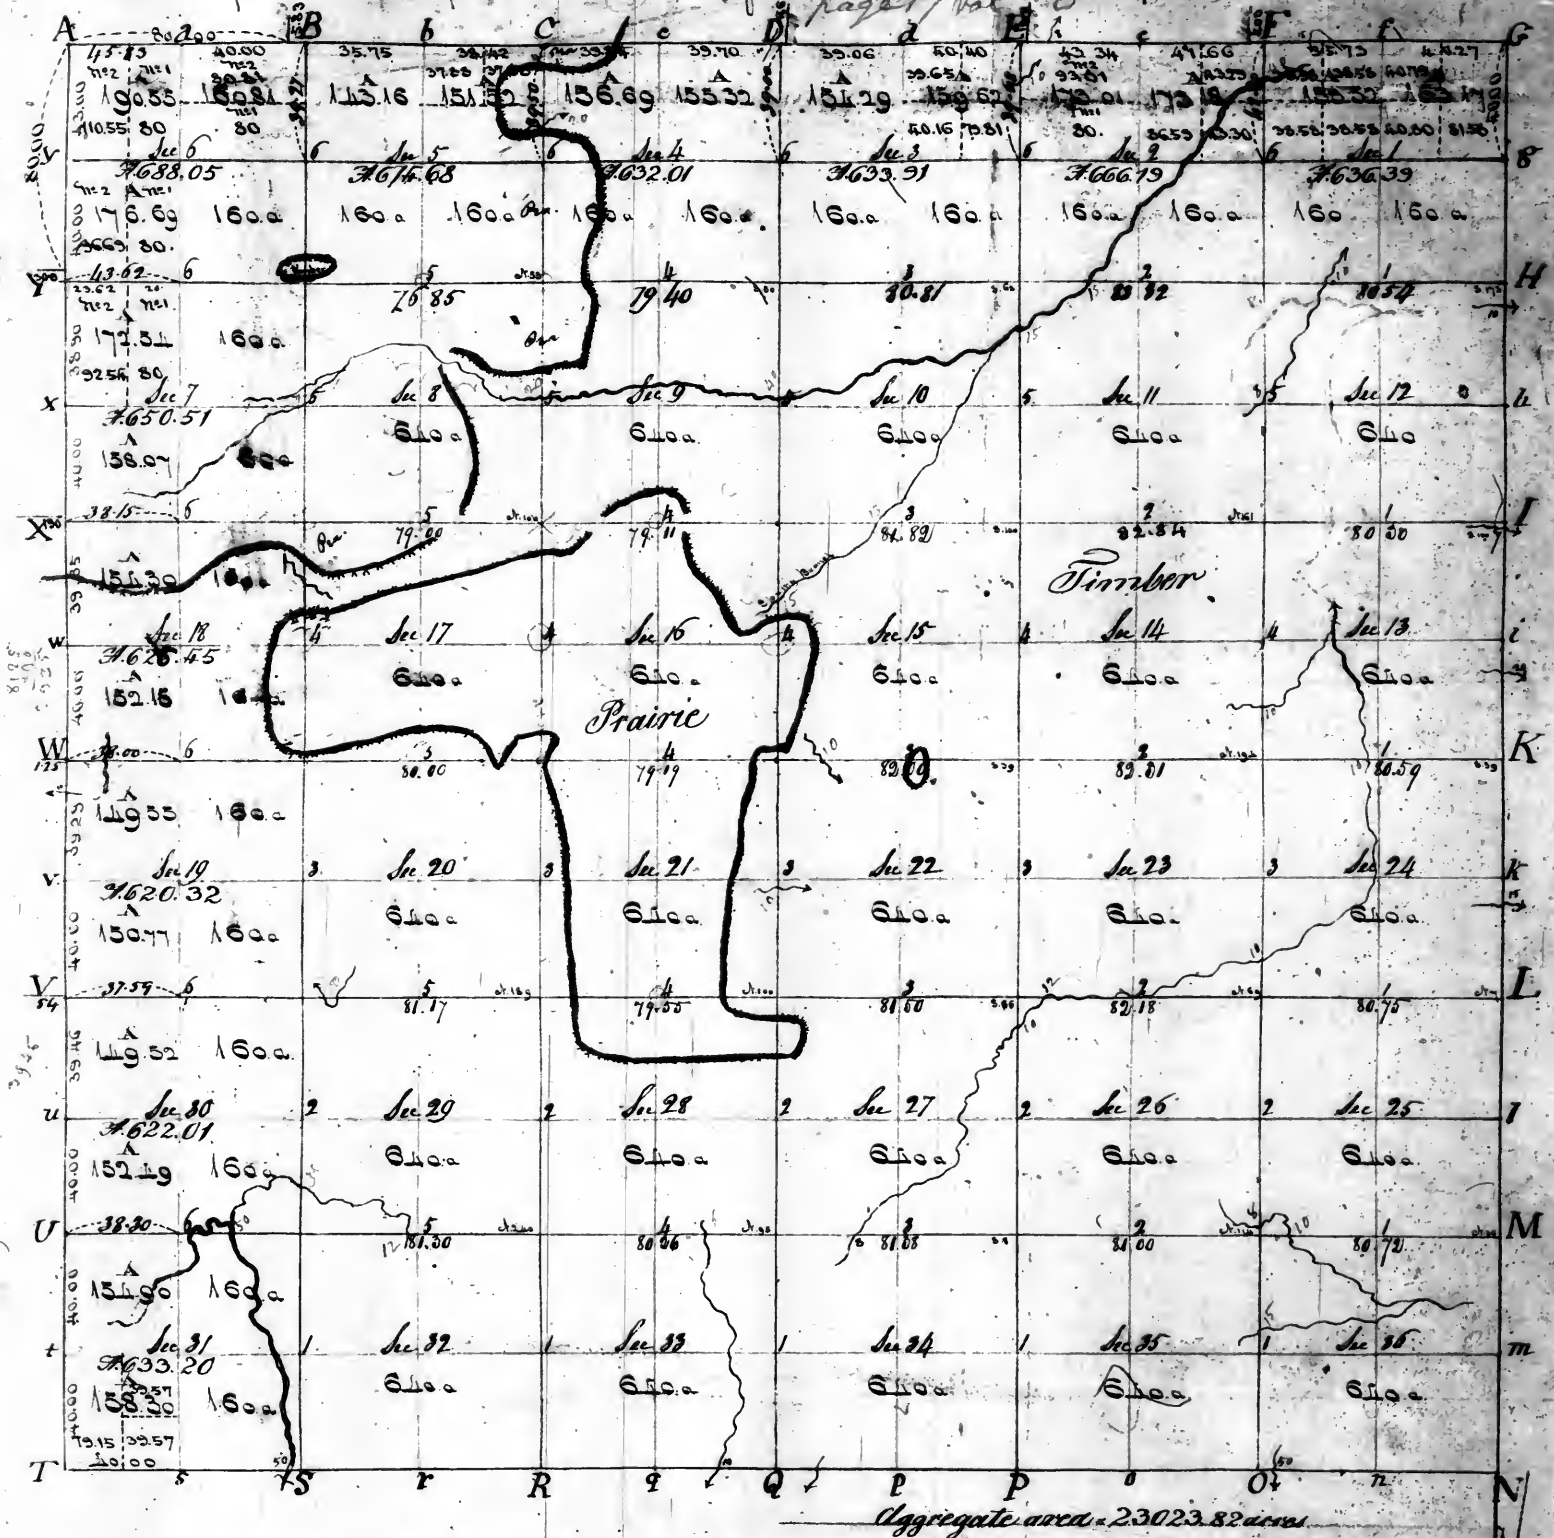

Pursuant to a contract with and Instructions from Edward Jeffers Surveyor General of the United States bearing date the second day of September 1815 I have admeasured laid out and Surveyed the above described Township and do Certify that it has such Mark and bounds both Natural and Artificial as are represented on said Plat and described in the field notes made therey & returned with the Plat into the Surveyor General's Office

Certified this 9 day of June 1816

John McKee




Pursuant to a contract with and Instructions from Edward Tiffin Surveyor General of the United States bearing date the second day of September 1815 I have admeasured laid out & surveyed the above described Township and do hereby certify that it has such marks & bounds both natural & artificial are represented on said Plat and described in the field Notes made thereof & returned with the Plat into the Surveyor General's Office

Certified this 9th day of June 1816

John McKee


Township No 3 South, Range No 3 West of 4th Meridian.

page 19 vol 20

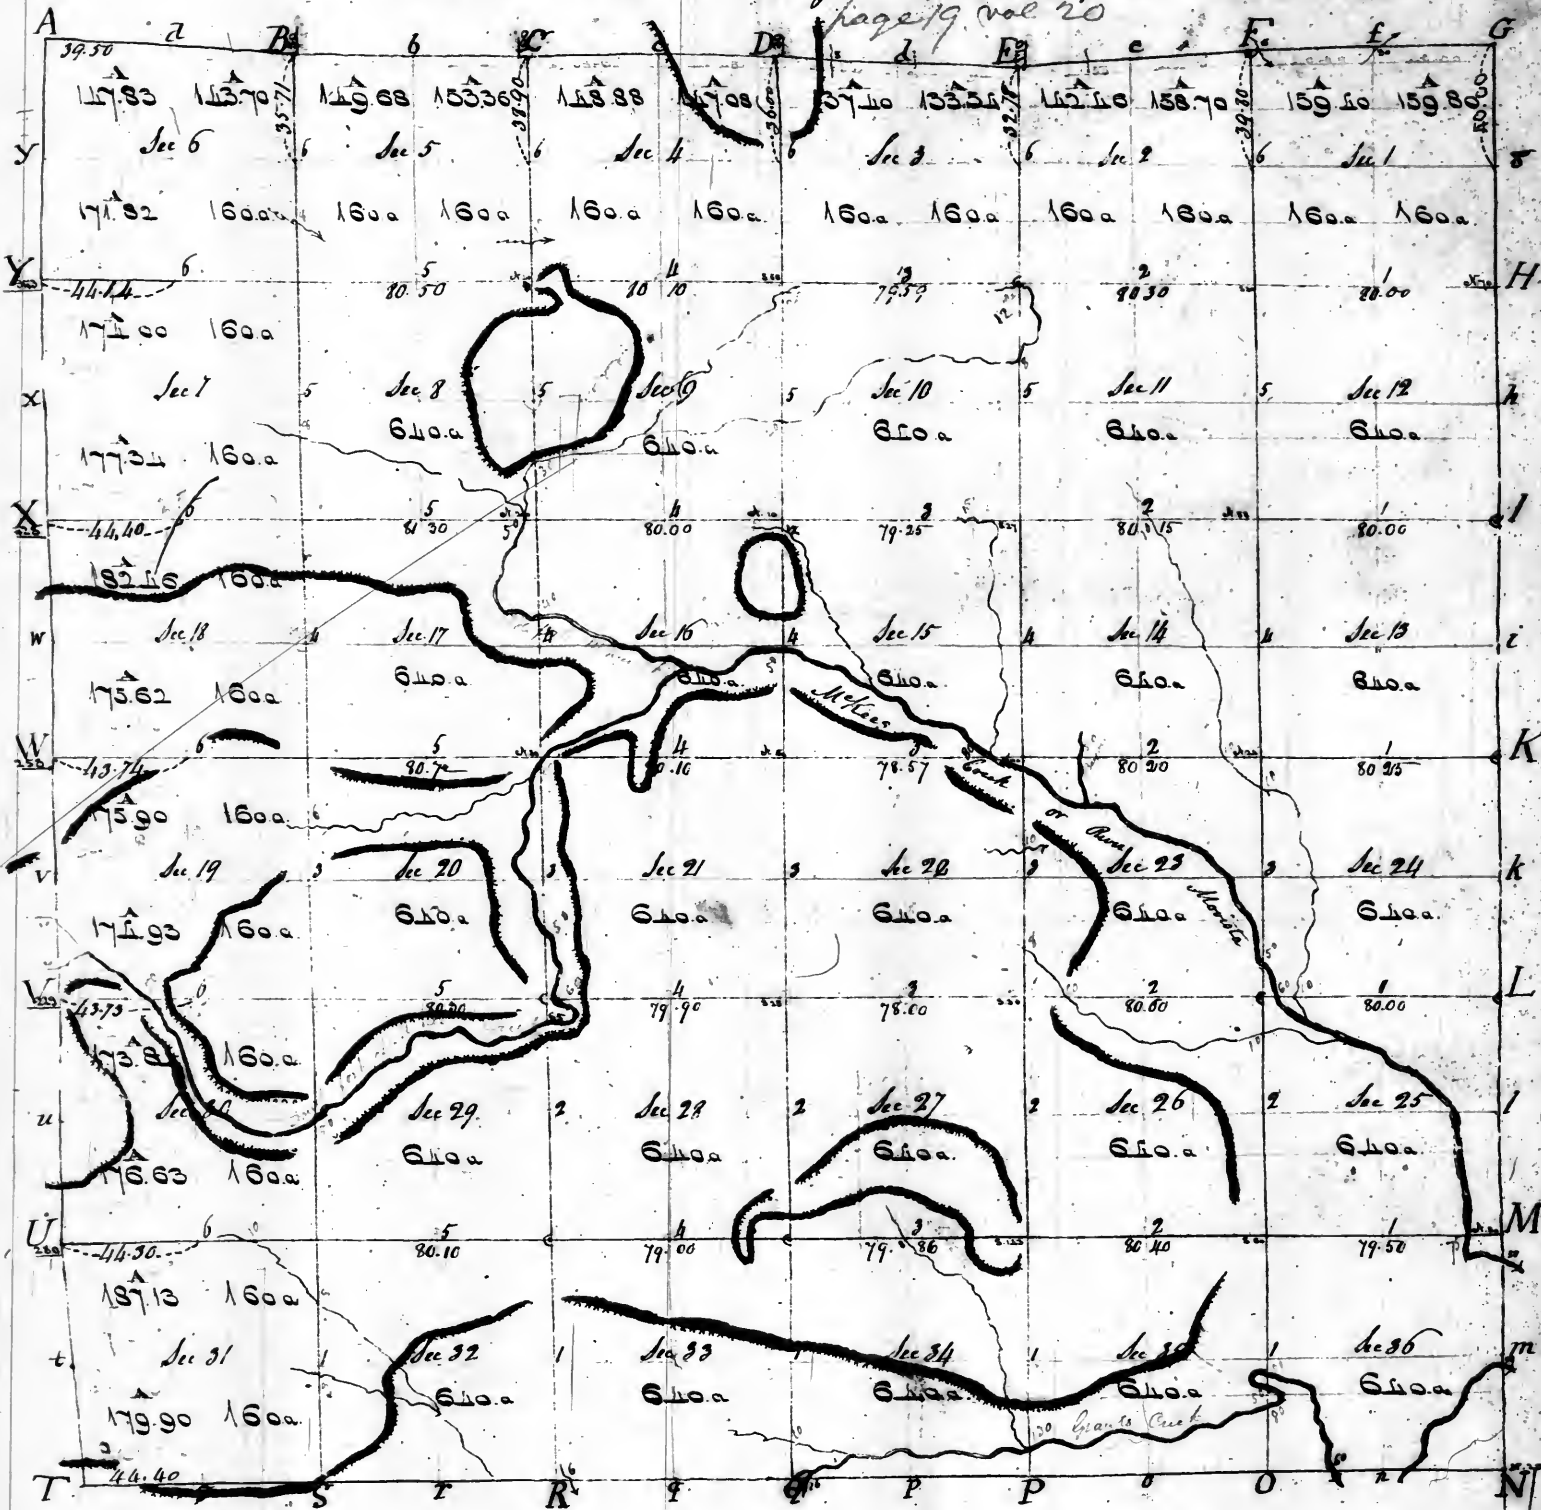

Pursuant to a Contract with and Instructions from Edward Tiffin Surveyor General of the United States bearing date the second day of September 1815 I have admeasured laid out & surveyed the above described Township and do hereby Certify that it has such marks & bounds both natural and Artificial as are represented on said Plat and described in the field notes made thereof and returned with the Plat into the Surveyor General's Office.


Certified this 9th day of April 1816
J. H. Miller

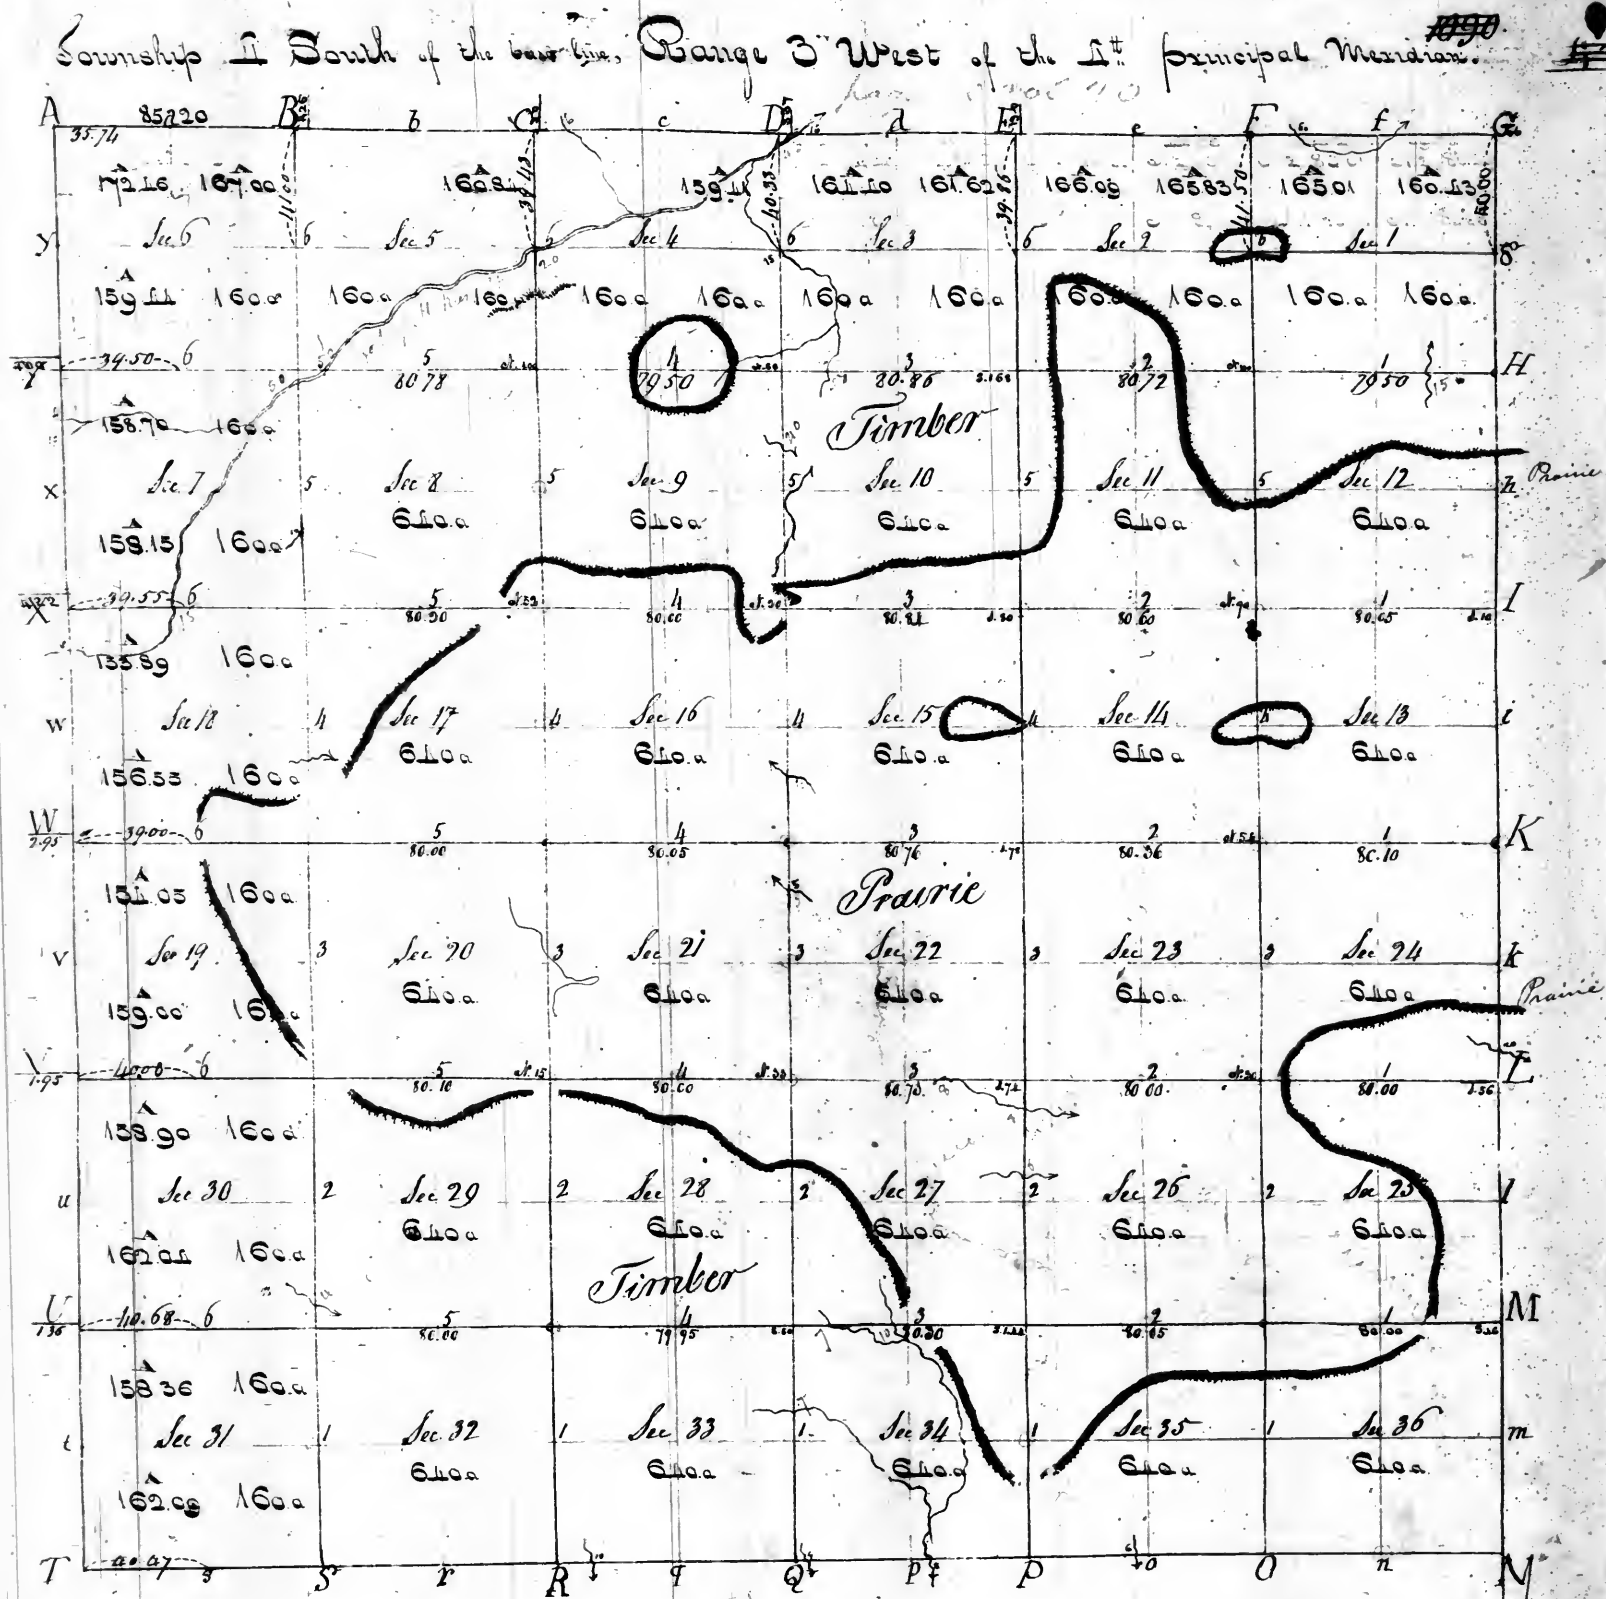

Pursuant to a contract with and Instructions from Edward Tiffin Surveyor General of the United States bearing date the second day of September 1815 I have admeasured laid out & surveyed the above described Township and do hereby certify that it has such Marks & bounds both Natural and Artificial as are represented on said Plat and described in the field notes made thereof and returned with the Plat into the Surveyor Generals Office

Certified this 9th day of April 1816

John McKee

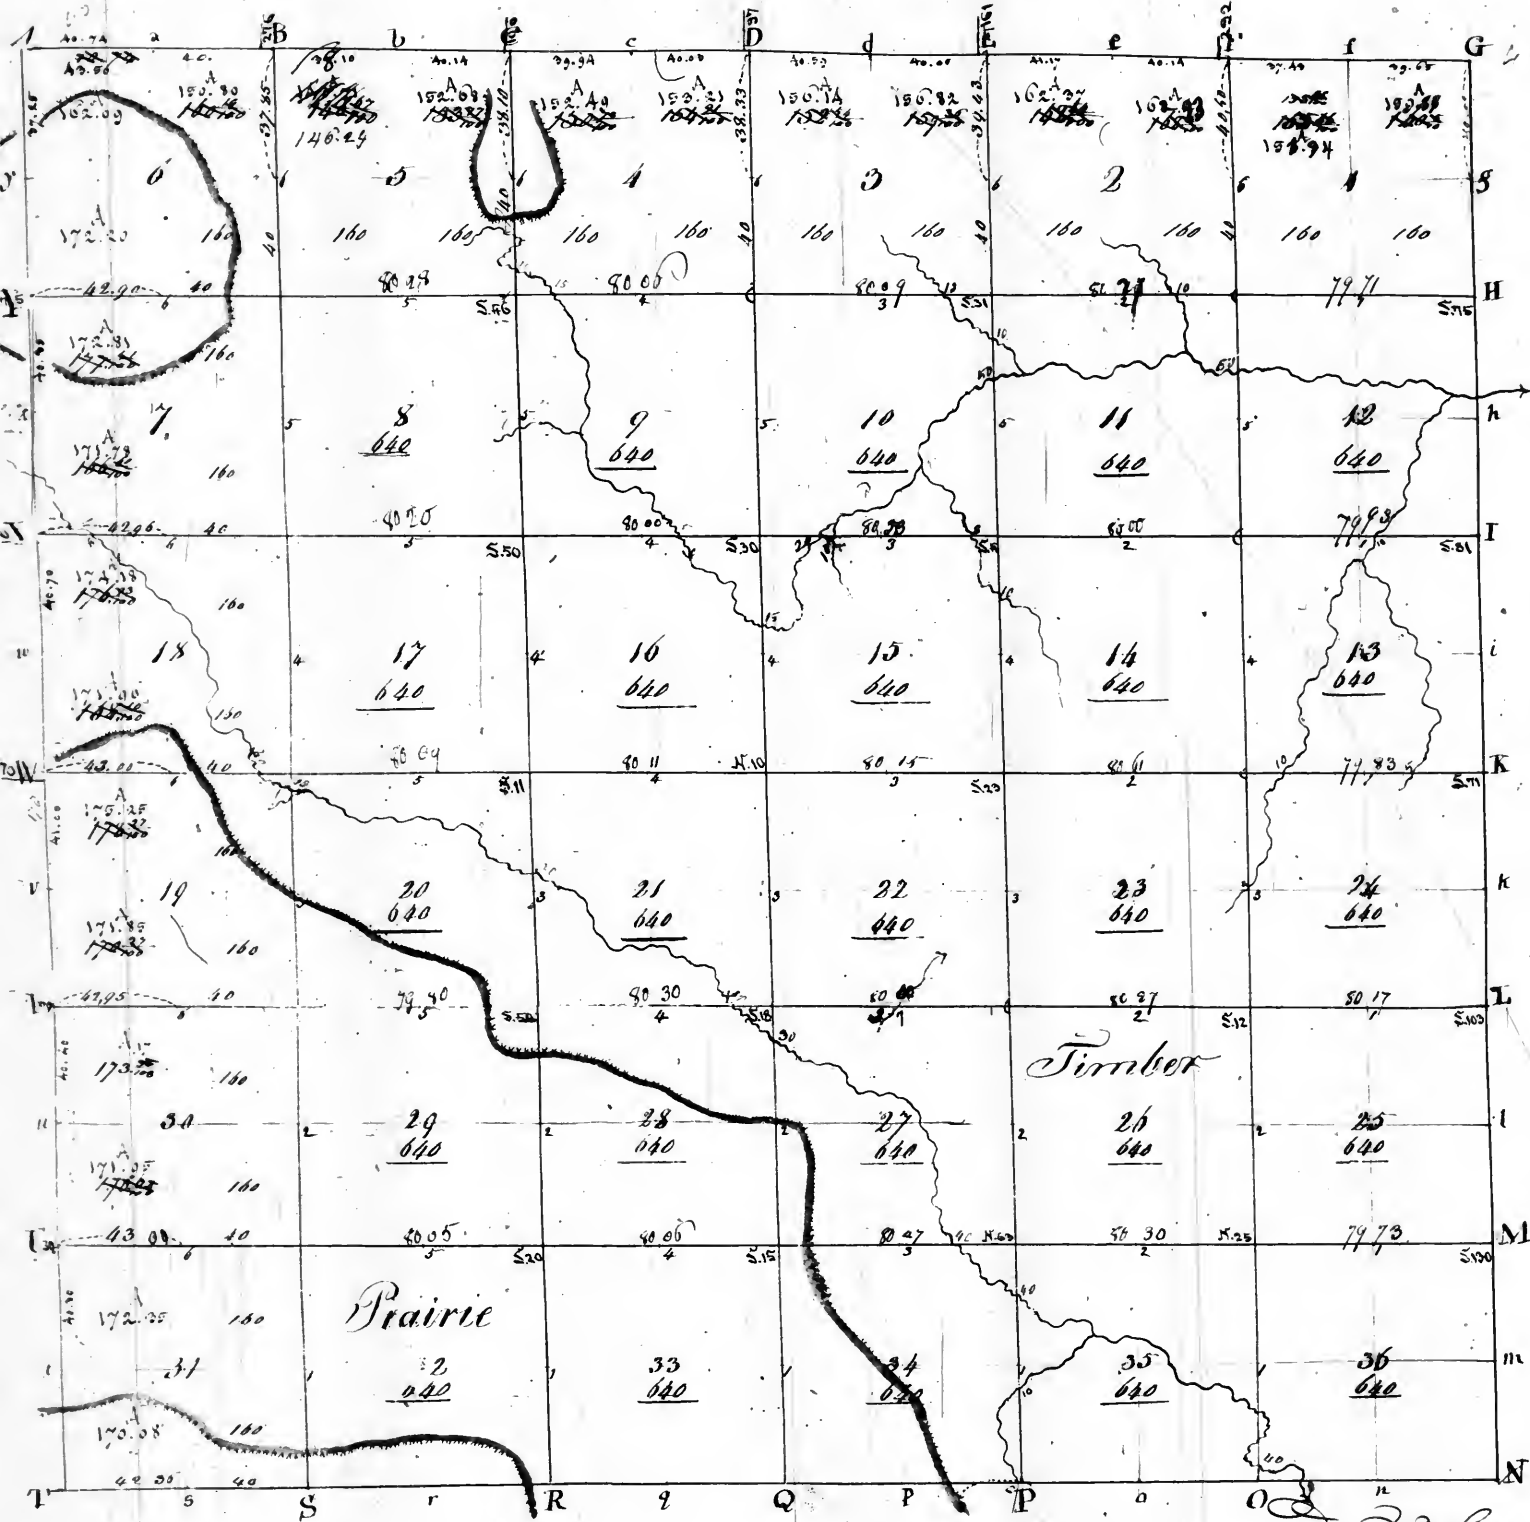


Surveyed by James McDonald D.S.
 Town 5 S. Range 3 W.
 July 1877



See new plat in Vol. 25 pag. 23

25


Page 23 of 20

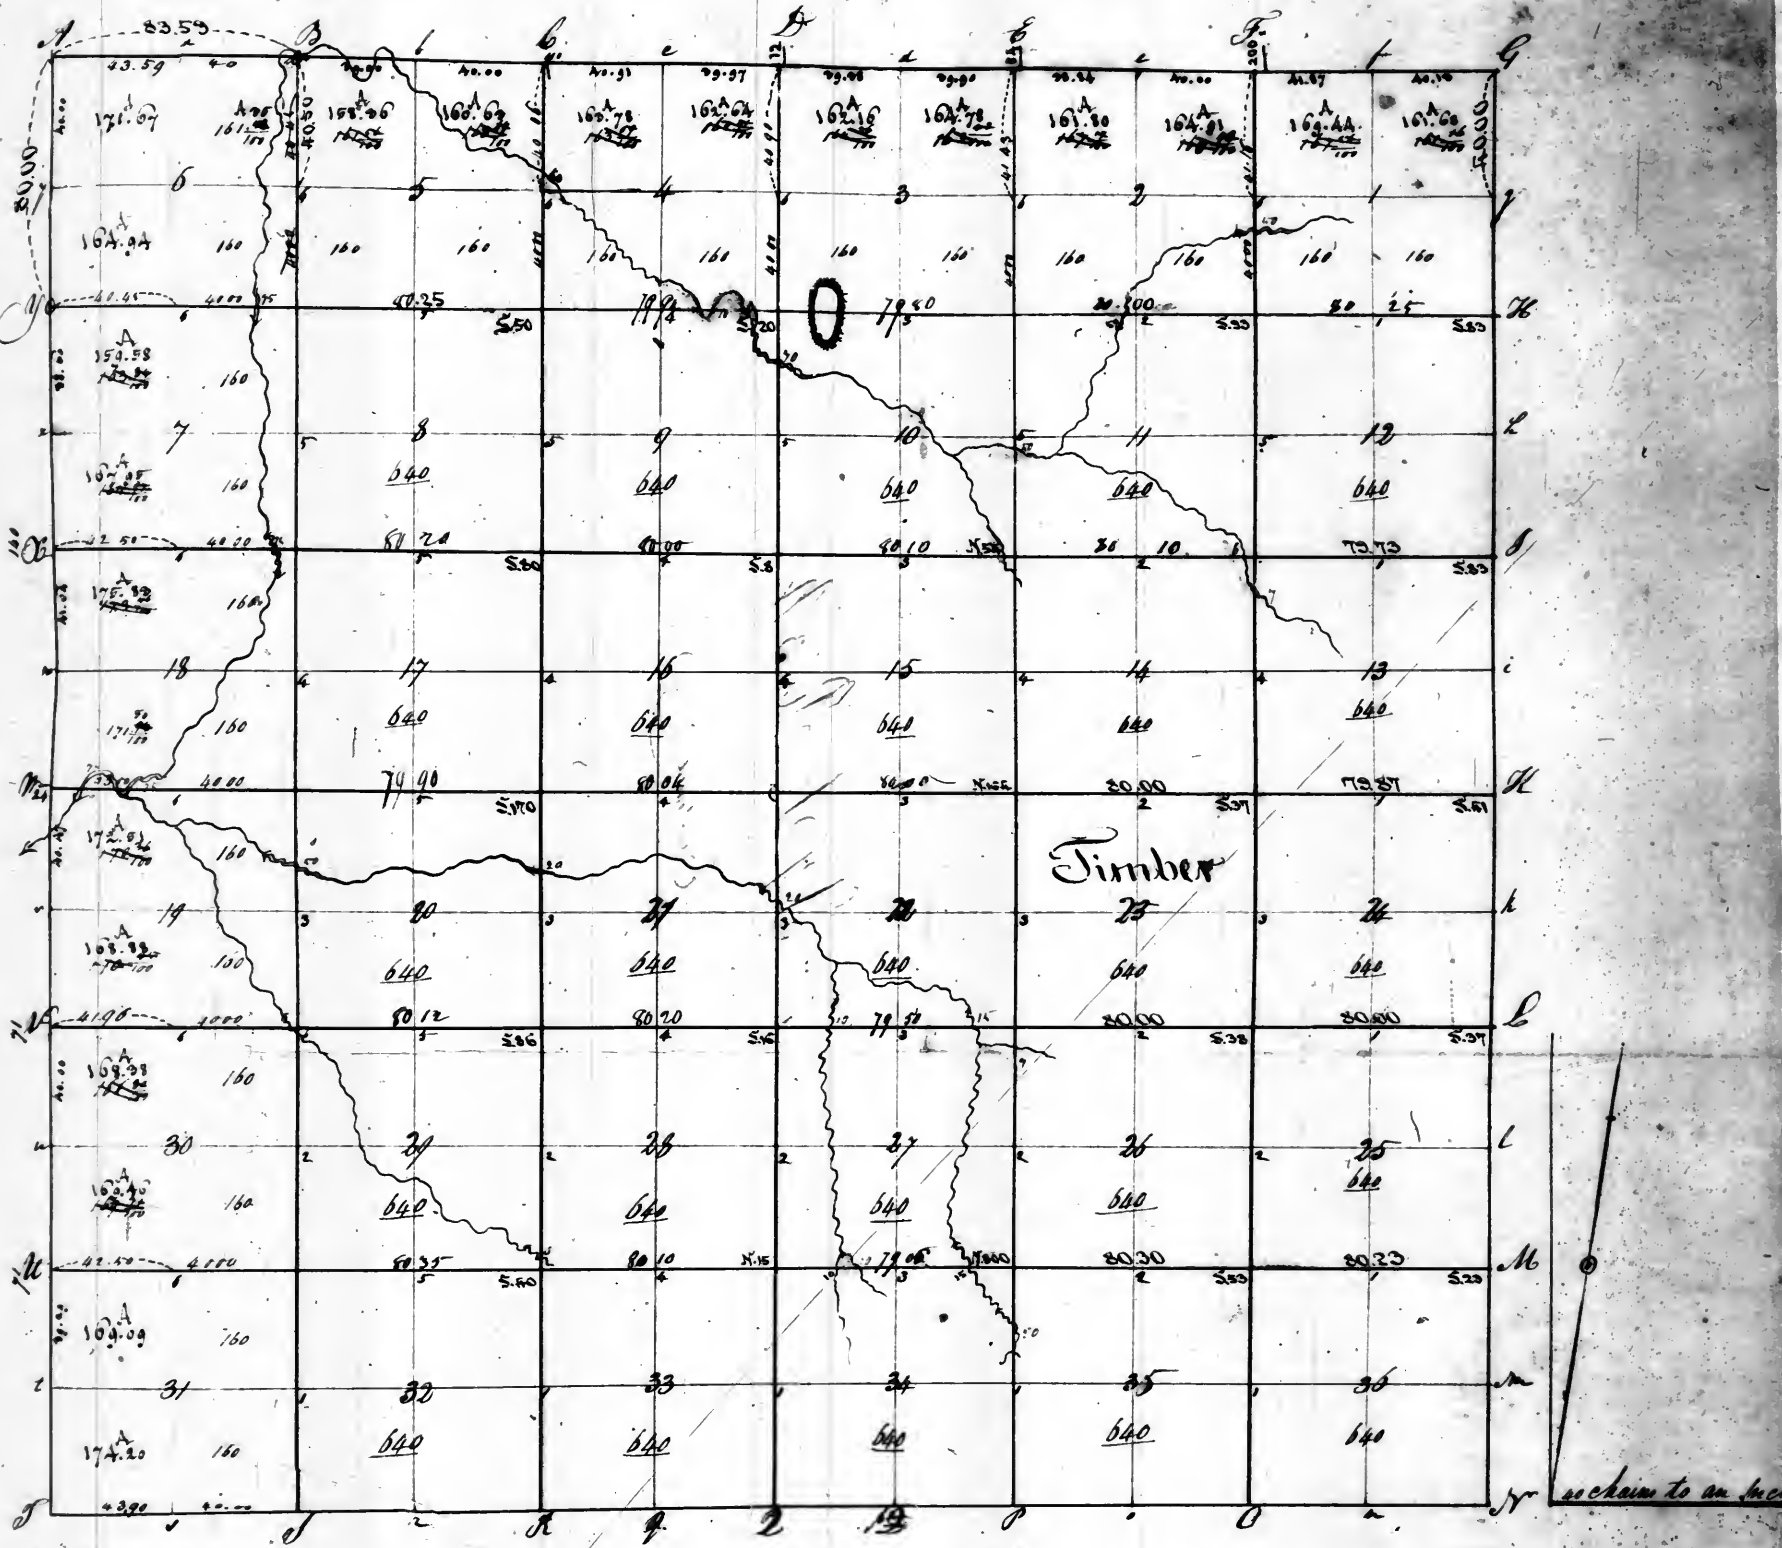

Township 7 South Range 3 West

Township N. 8 South of the Base Line of Range N. 3 West of the 4th Principal Meridian.

page 725 vol. 20

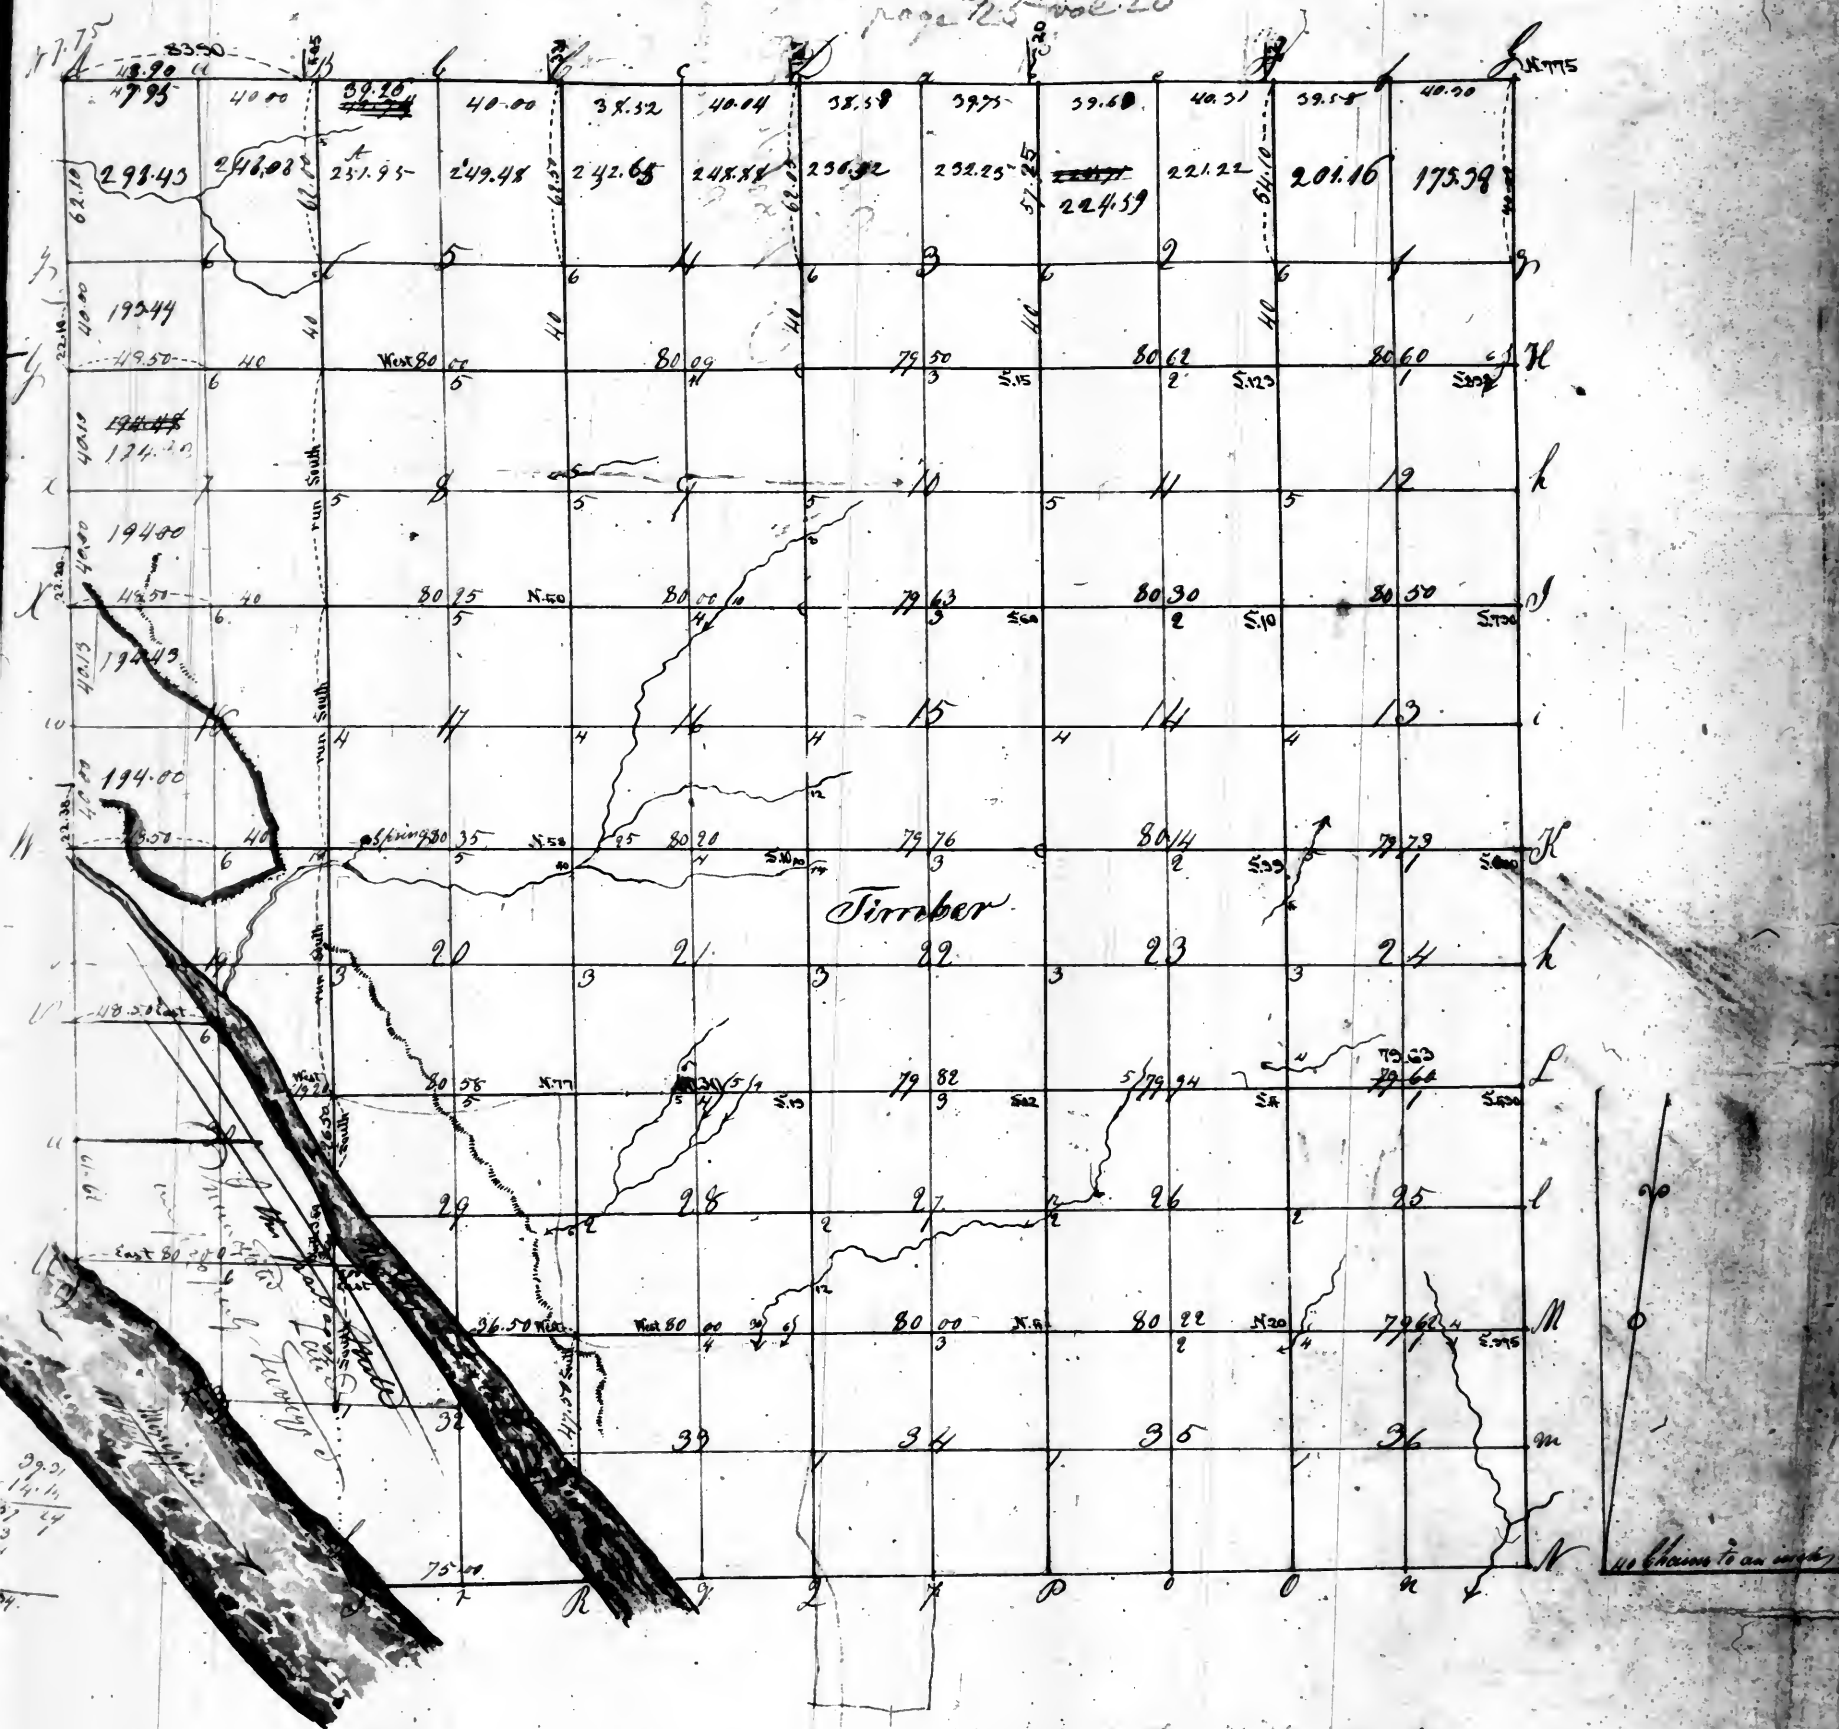


39.21
14.14
24.34

35
28.0

all

to the 4th Principal Meridian
N. 41/2

page 26^A vol 20

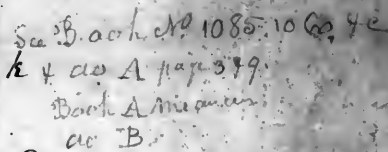


Pursuant to a contract with Edward Tiffin Surveyor Genl. of the United States and instructions from William Bextor Surveyor of the Lands of United States of the Illinois & Missouri Territories I have admeasured and surveyed the above described ^{Tractings} Townships and do hereby certify that it has such marks and bound both natural and artificial as are represented on said plat and Described in the field notes made thereof and returned ~~into~~ ^{with} this plat into the Office of the Surveyor of the Lands of the United States for the Territory of Illinois & Missouri.

Witness my hand this 7th day of June 1817

John A. Donaldson D. S.

testified the 7.th day of June 1817 John McDonald D. S.

Township N. 9 South of the Base Line Range N. 2 West of the 2nd Principal Meridian
 Page 263 of 264

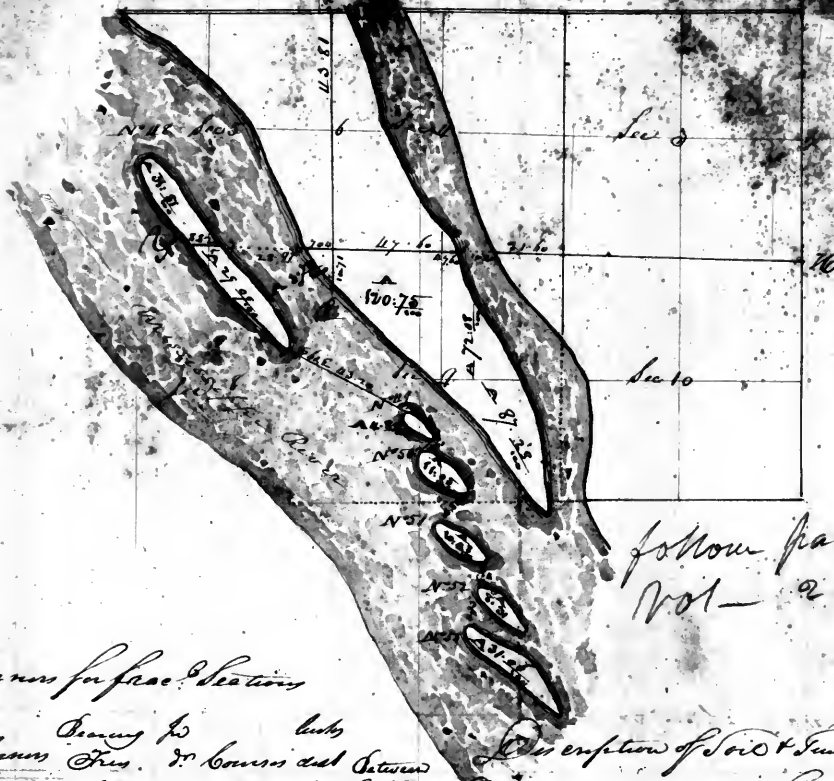

follow page 26
 Vol - 20

Cornus frax. Sections

Section	Survey	Acres	Section	Description of Soil & Timber
4 5 8-9	Post in ground	44.9	Land rather wet rich soil timber ash maple & birch	
		5.8	" " " "	
		8.9	" " " "	
		4.5	" " " " rich soil timber Elm maple ash birch & oak	
		4.5	" " " " Land on Island N. 48	
		4.5	" " " " rich soil timber Elm Hackberry mulberry & C	
		4.5	" " " " Land on Island N. 49	
		4.5	" " " " thin sandy soil timber cottonwood & maple	
		4.5	" " " " Land on Island N. 50	
		4.5	" " " " Same as N. 49	
		4.5	" " " " Land on Island N. 51	
		4.5	" " " " Same as N. 50	
		4.5	" " " " Land on Island N. 52	
		4.5	" " " " Same	
		4.5	" " " " Land on Island N. 53	
		4.5	" " " " rich soil timber oak maple & cottonwood	
		4.5	" " " " "	
		4.5	" " " " "	
		4.5		

Township N 10 South of the Base Line Range N 10 West of the Meridian
 page 26 C. Vol 20.



London Island N. 54
 thin sandy soil Timber Elm maple Cotton wood


to follow the
 plot which follows page 26 Vol 20



page 10. D. 11. 120

Concession for track section

at G. Ben Elm of 1769

do 1762

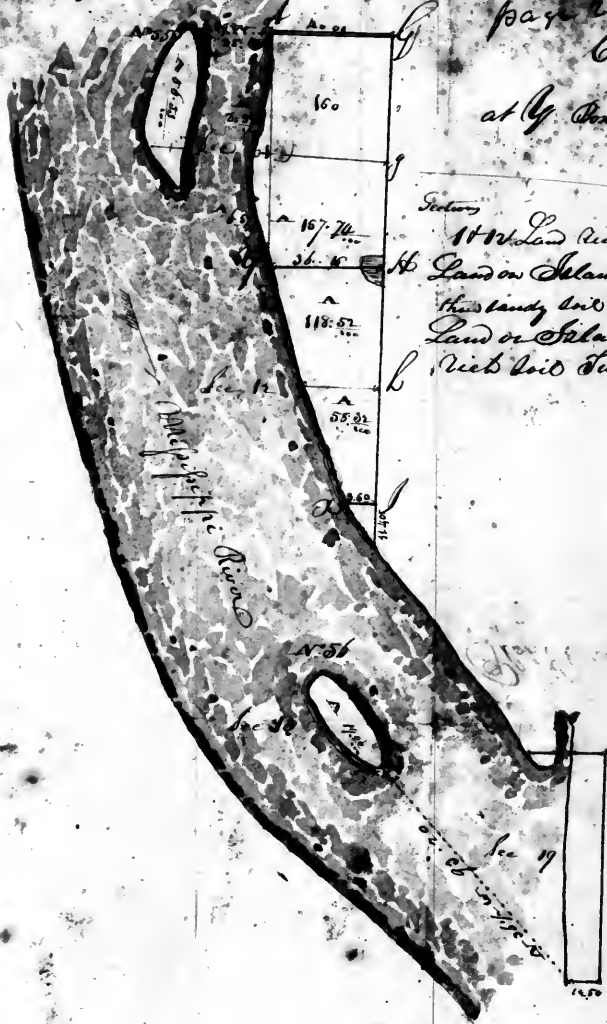

Section

1762 Ben Elm of 1769

Land on Island N. 55

the sandy land timber bottomwood and willow

Land on Island N. 55

Rich Soil Timber Bottomwood and willow


1762 Ben Elm of 1769

55.44

12.50

17.94

12.06

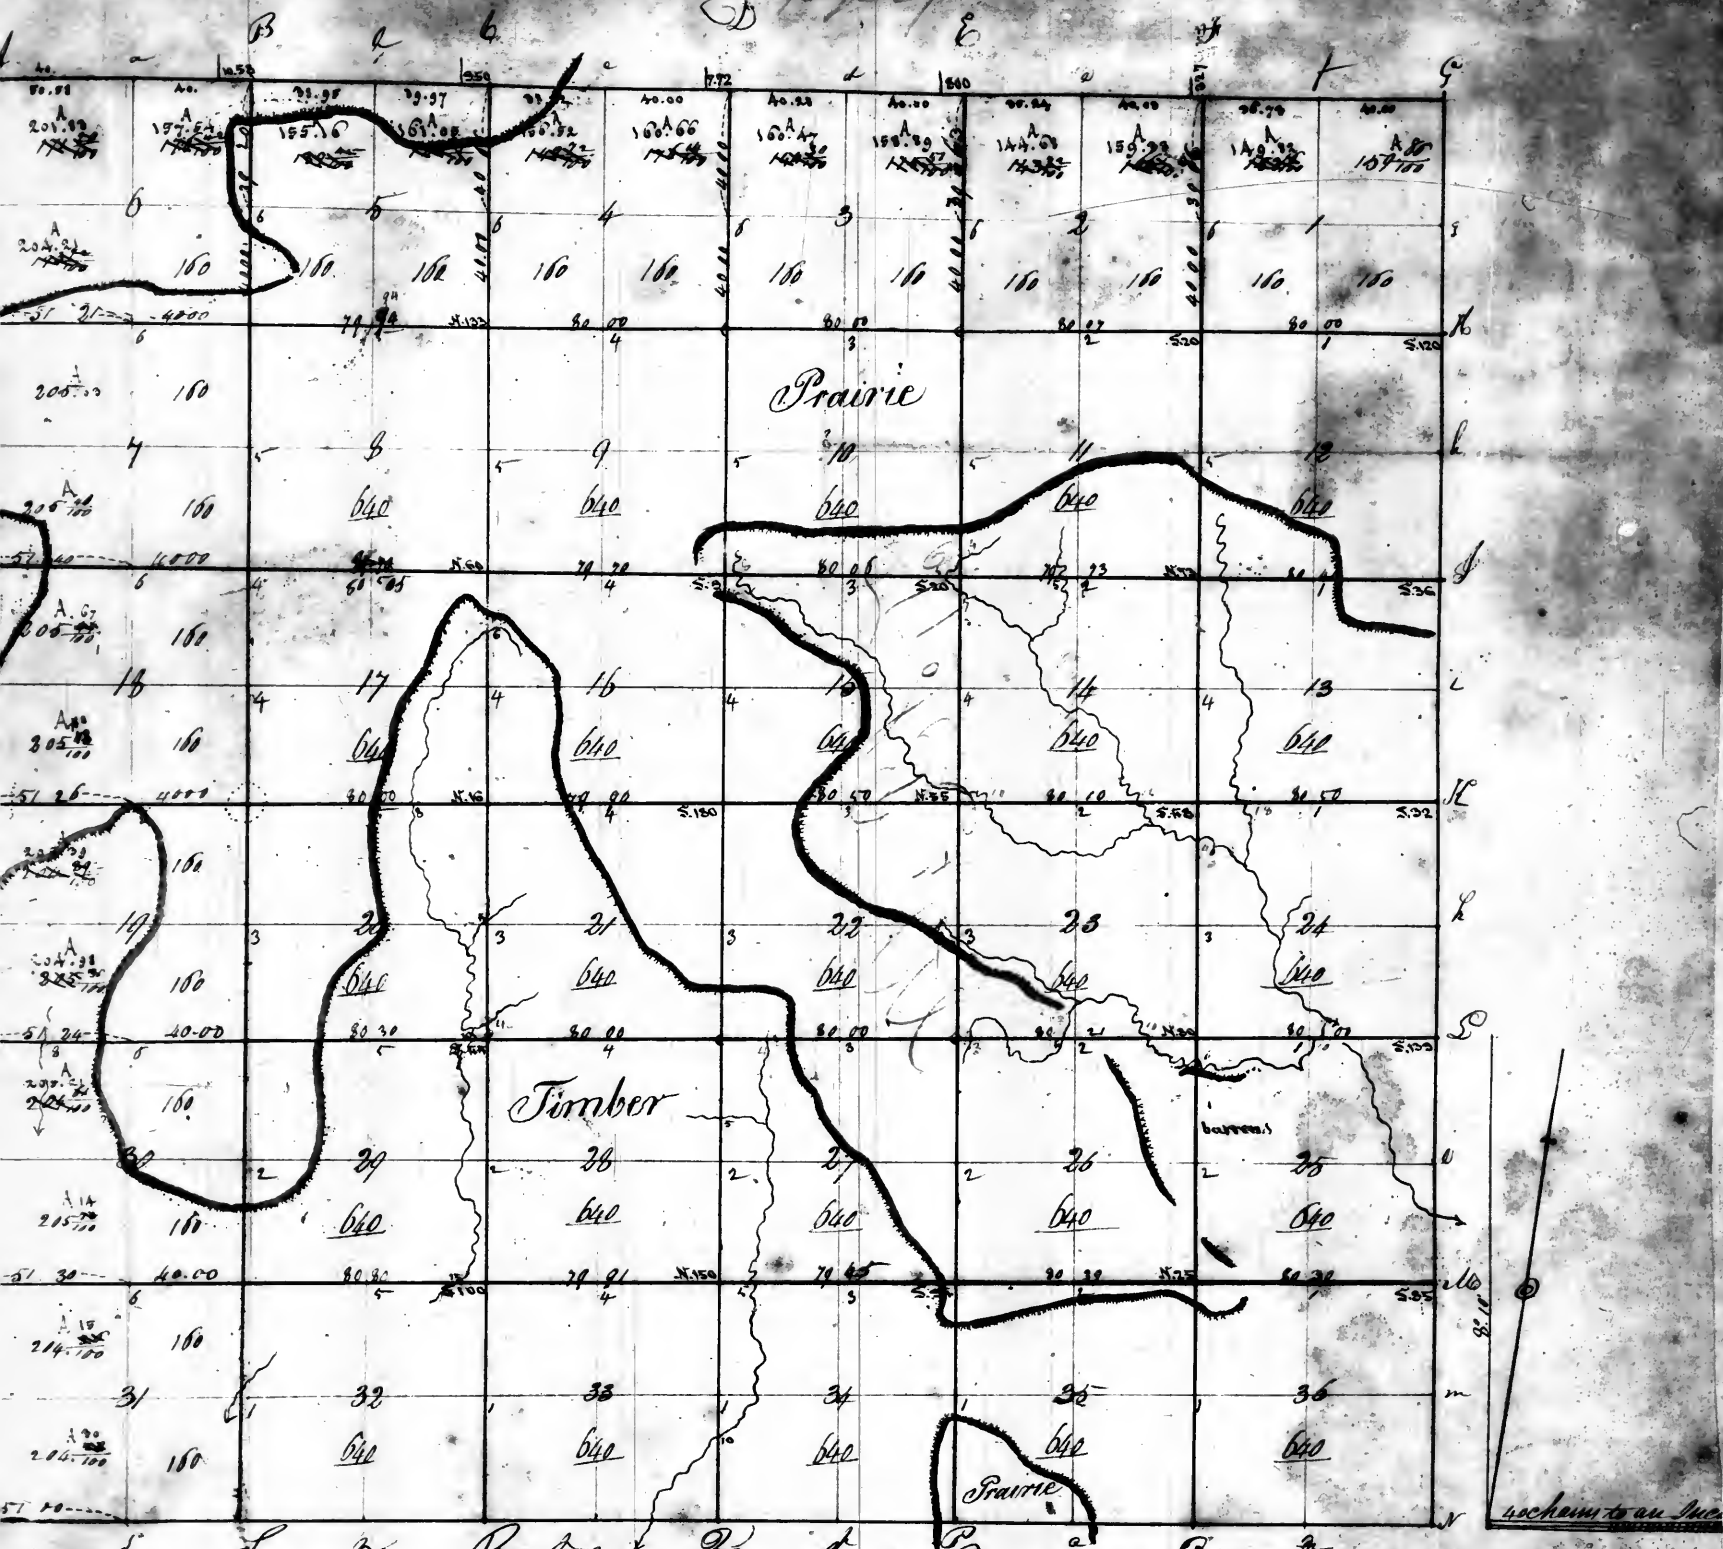


Township 1 South Range 4 West of the 4th Principal Meridian

See new plat Vol. 25. pag. 30


31

page 28 psl 20

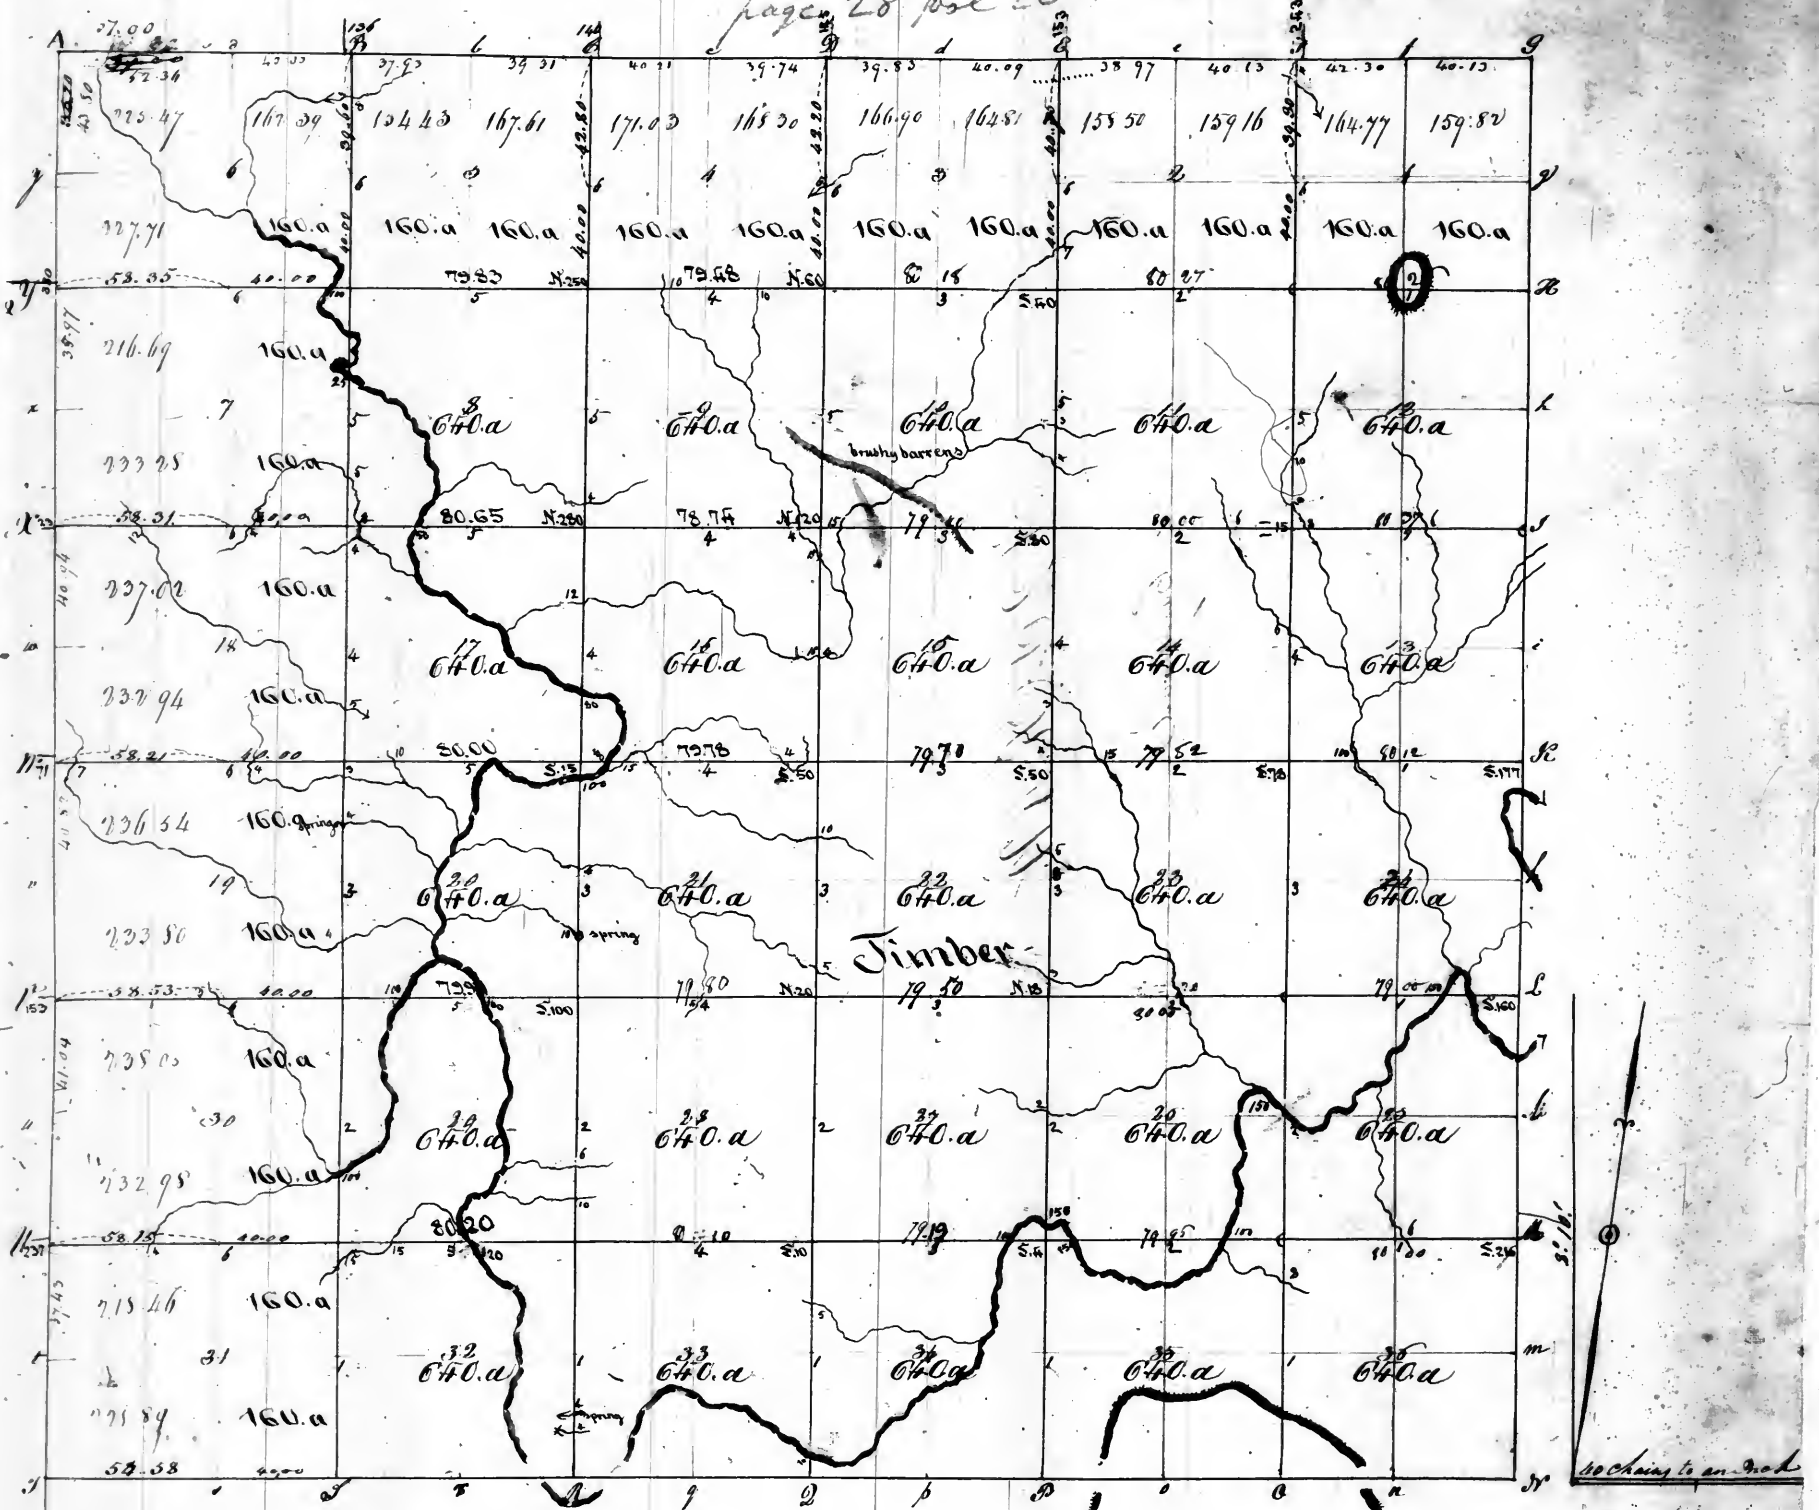


Township 2. S. Range 4 West — 4th Principal Meridian

Townships 3 South Range 11 West page 29 vol 20

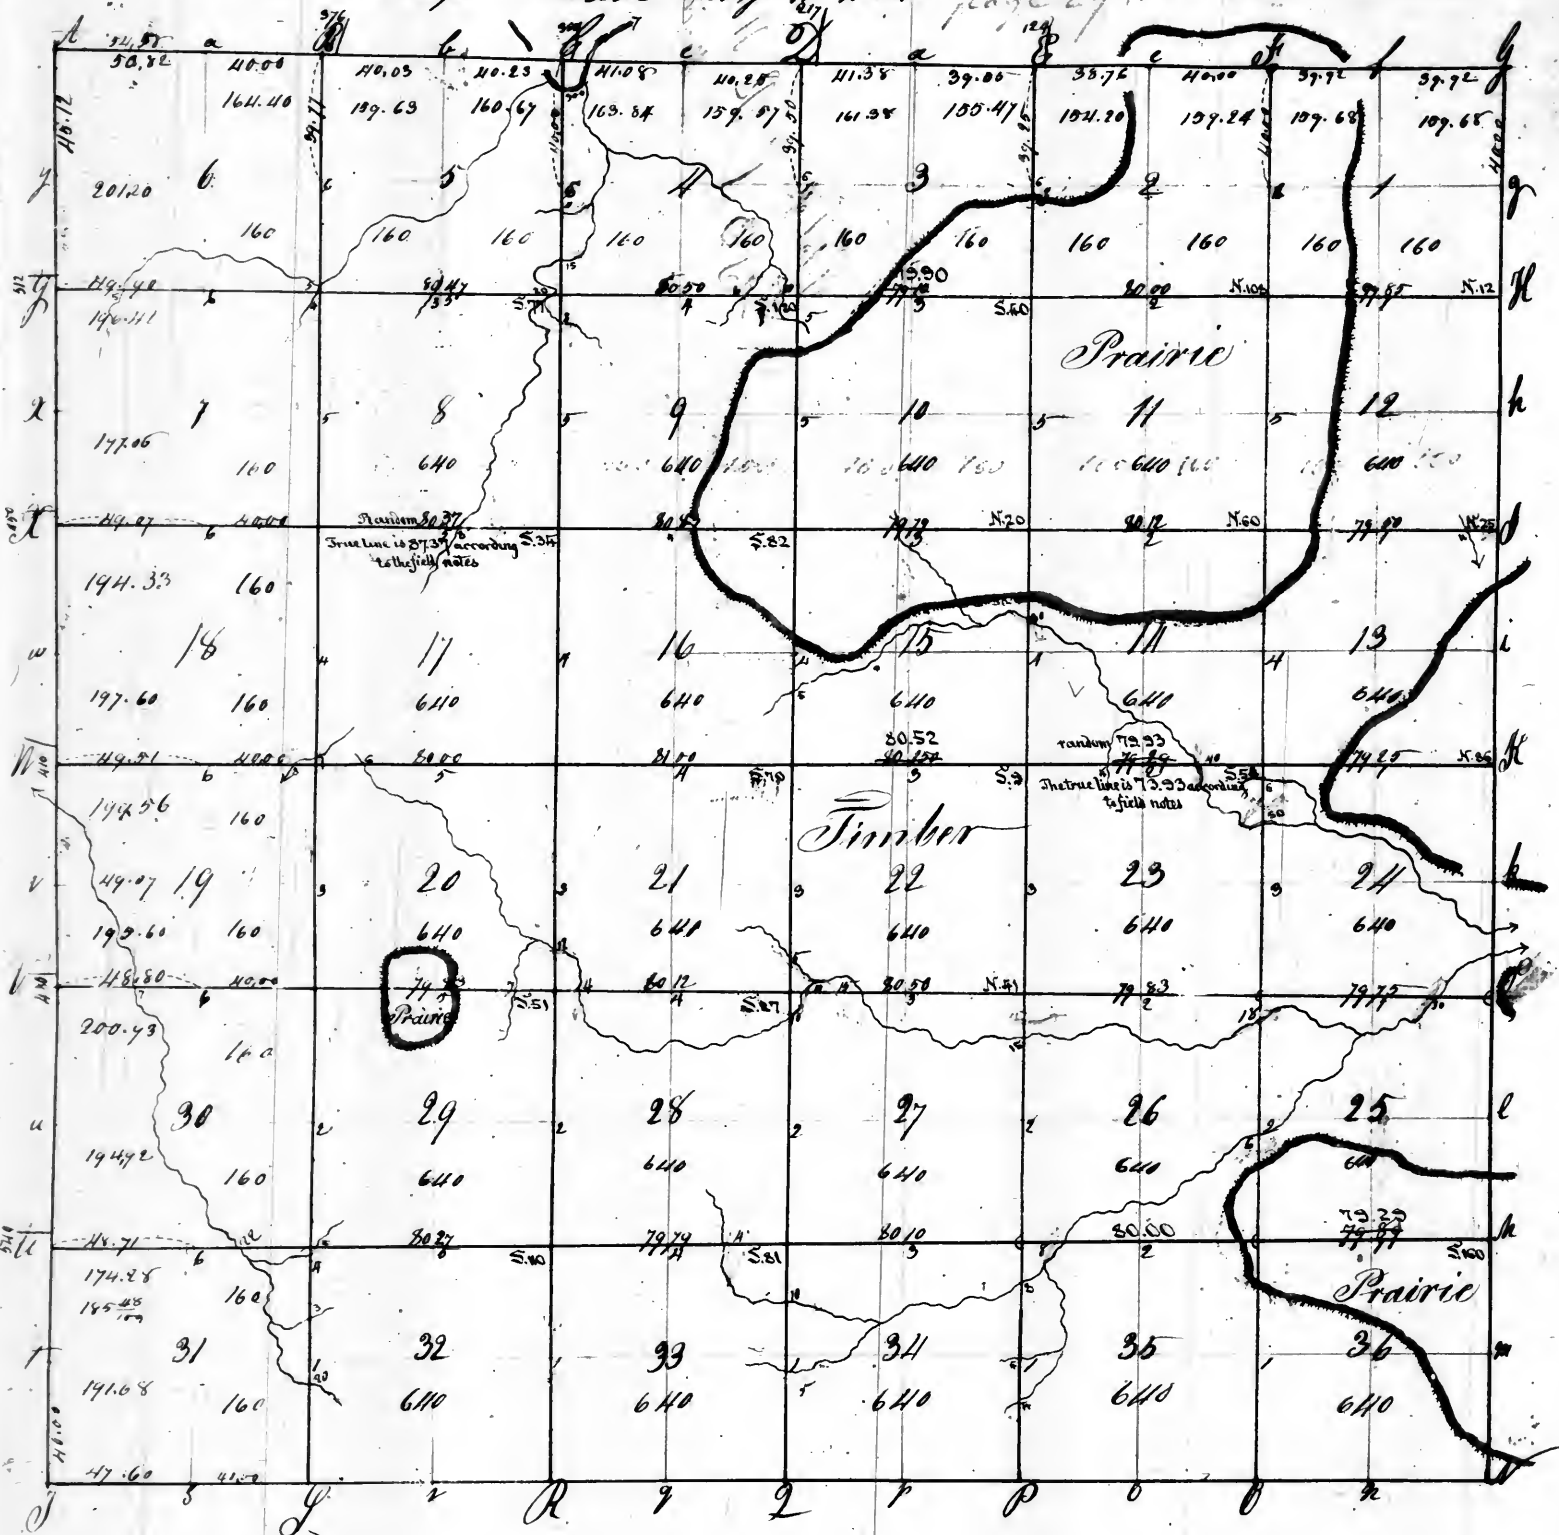

33

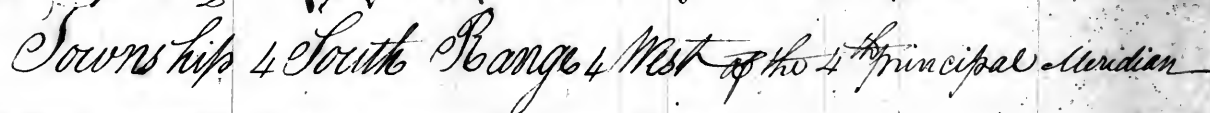


See the following plat on page 35
and for a new plat See Vol. 25 page 33

34

Town 5 South Range 4 West of the 1st principal Meridian

page 24 vol 20

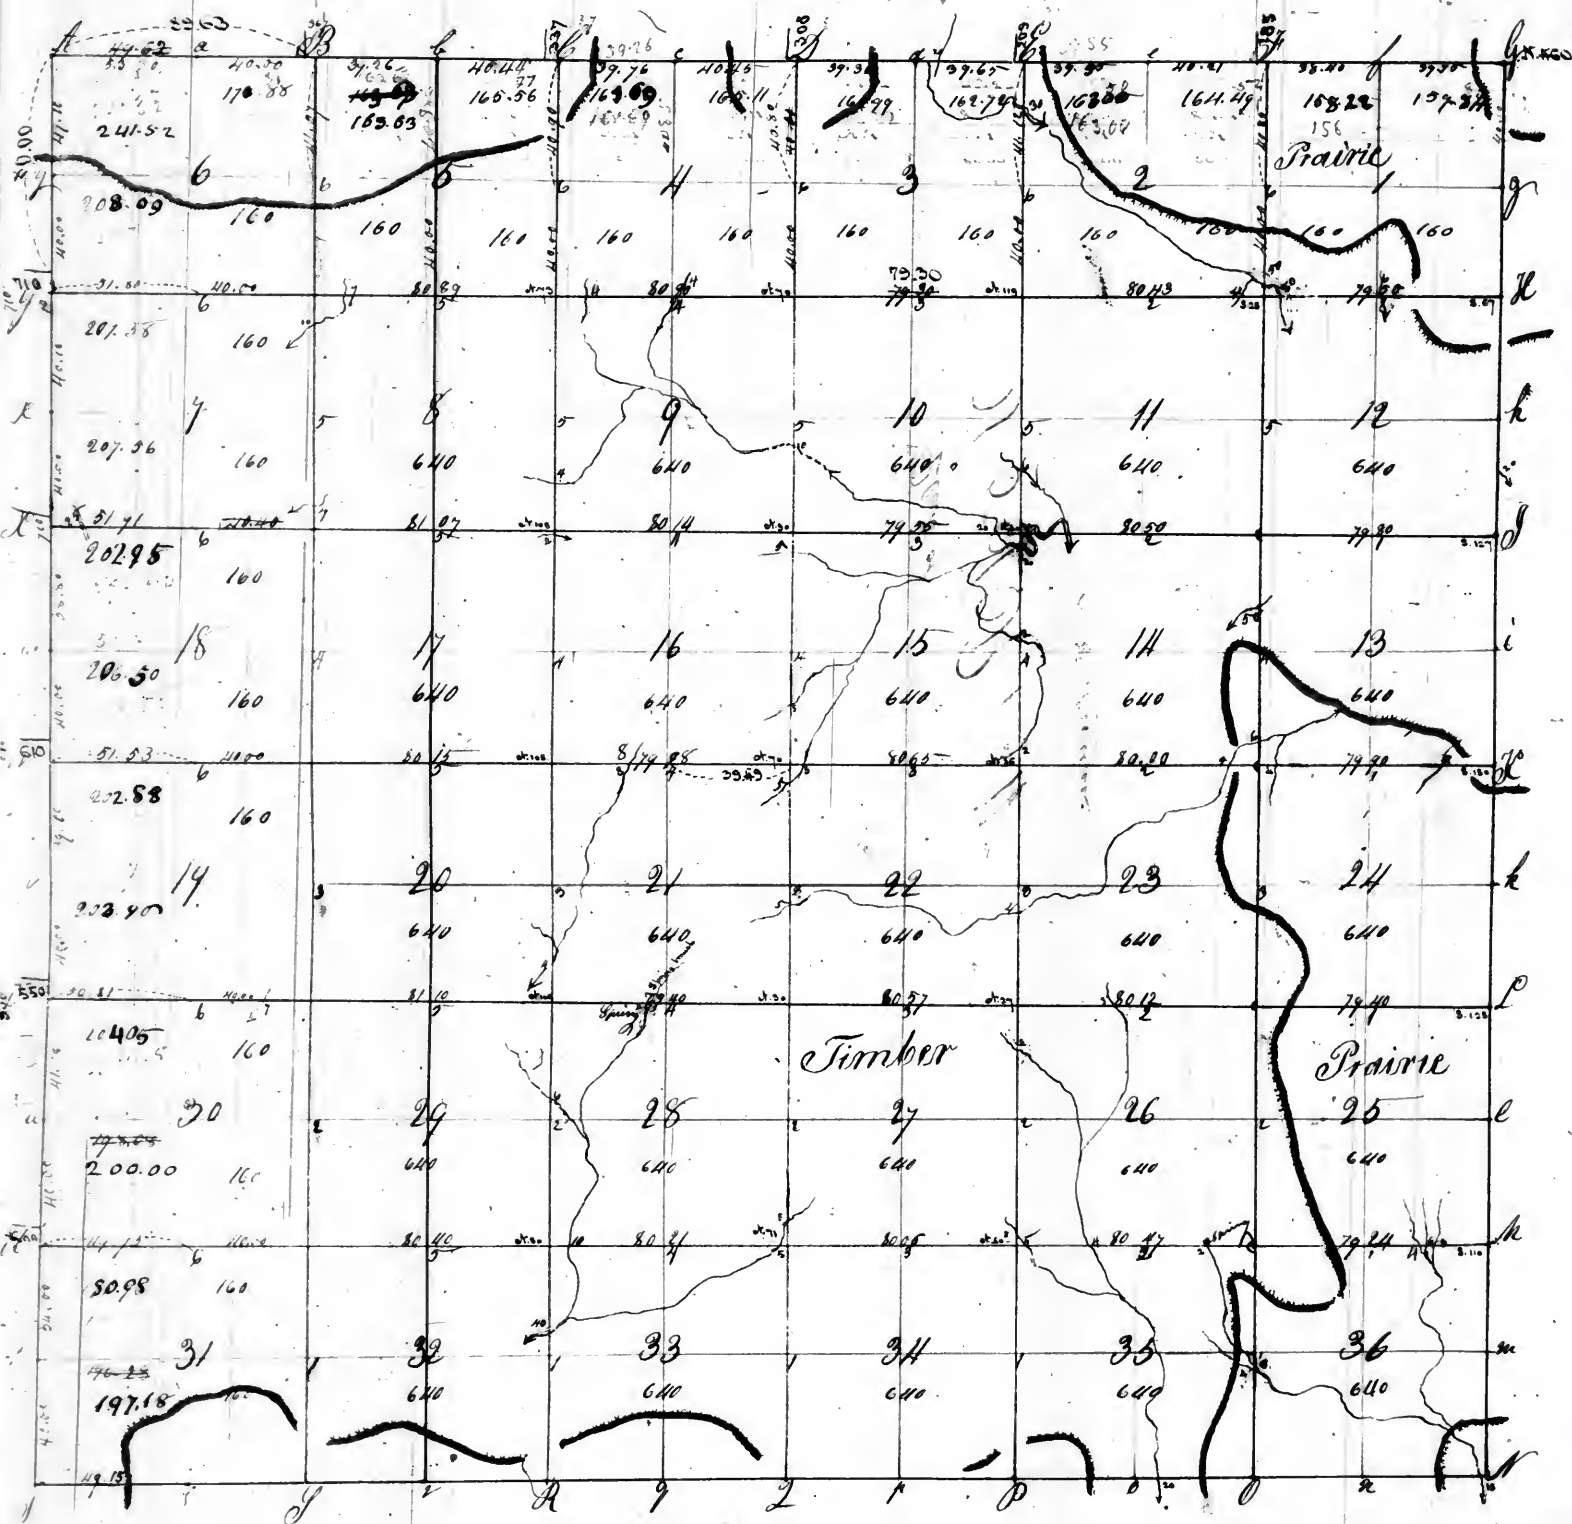


For new Plat see Vol. 35. page 33

1863


35

Page 31 vol. 20

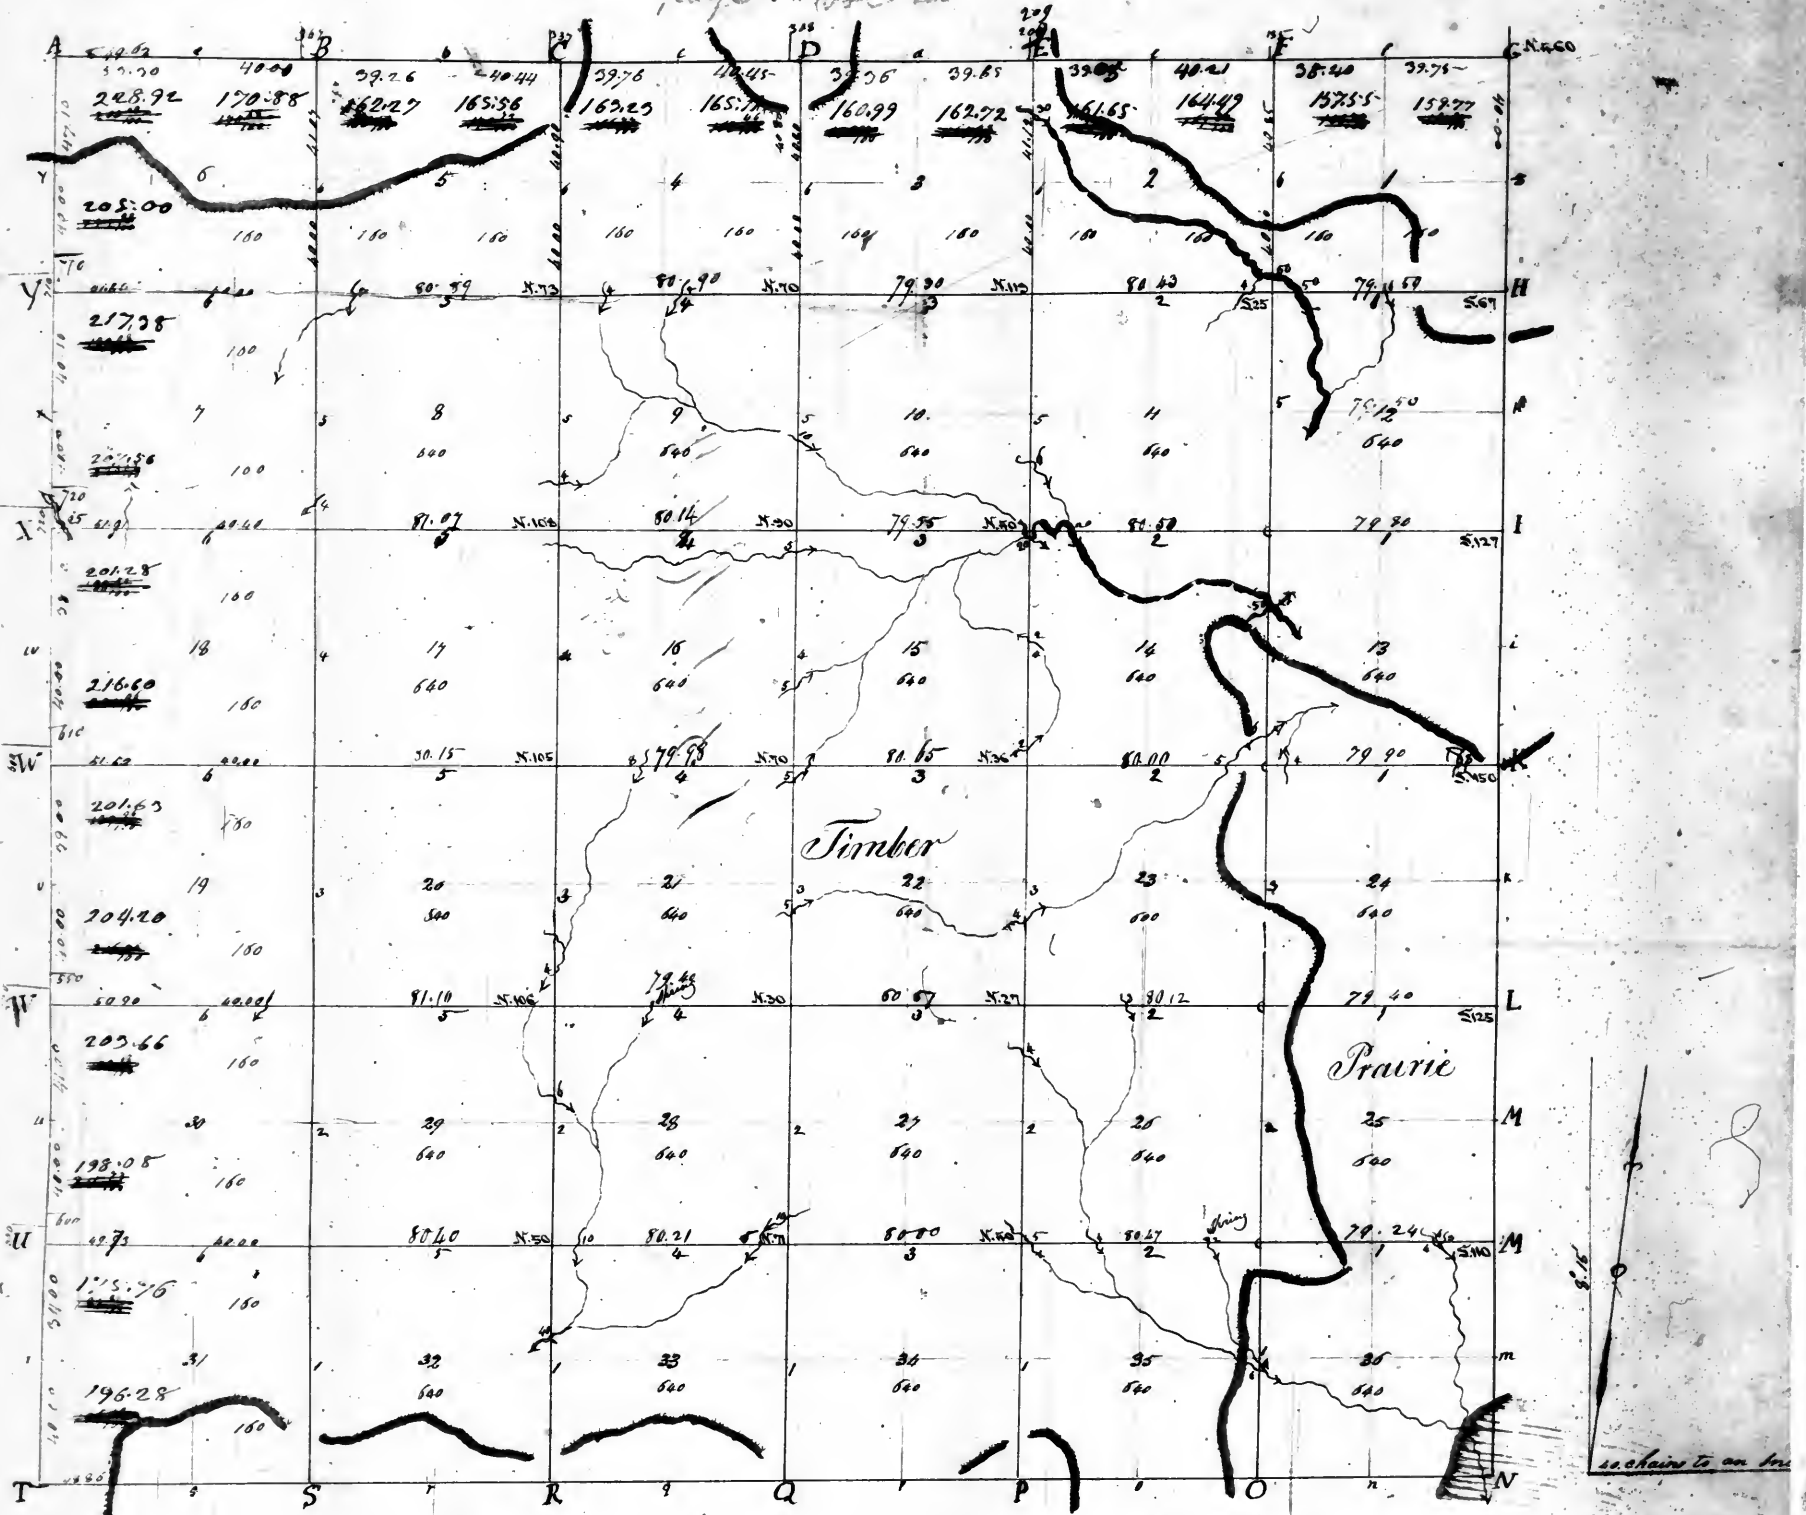


Town 5 South Range 4 West of the 11th pl. meridian

page 32 vol 20

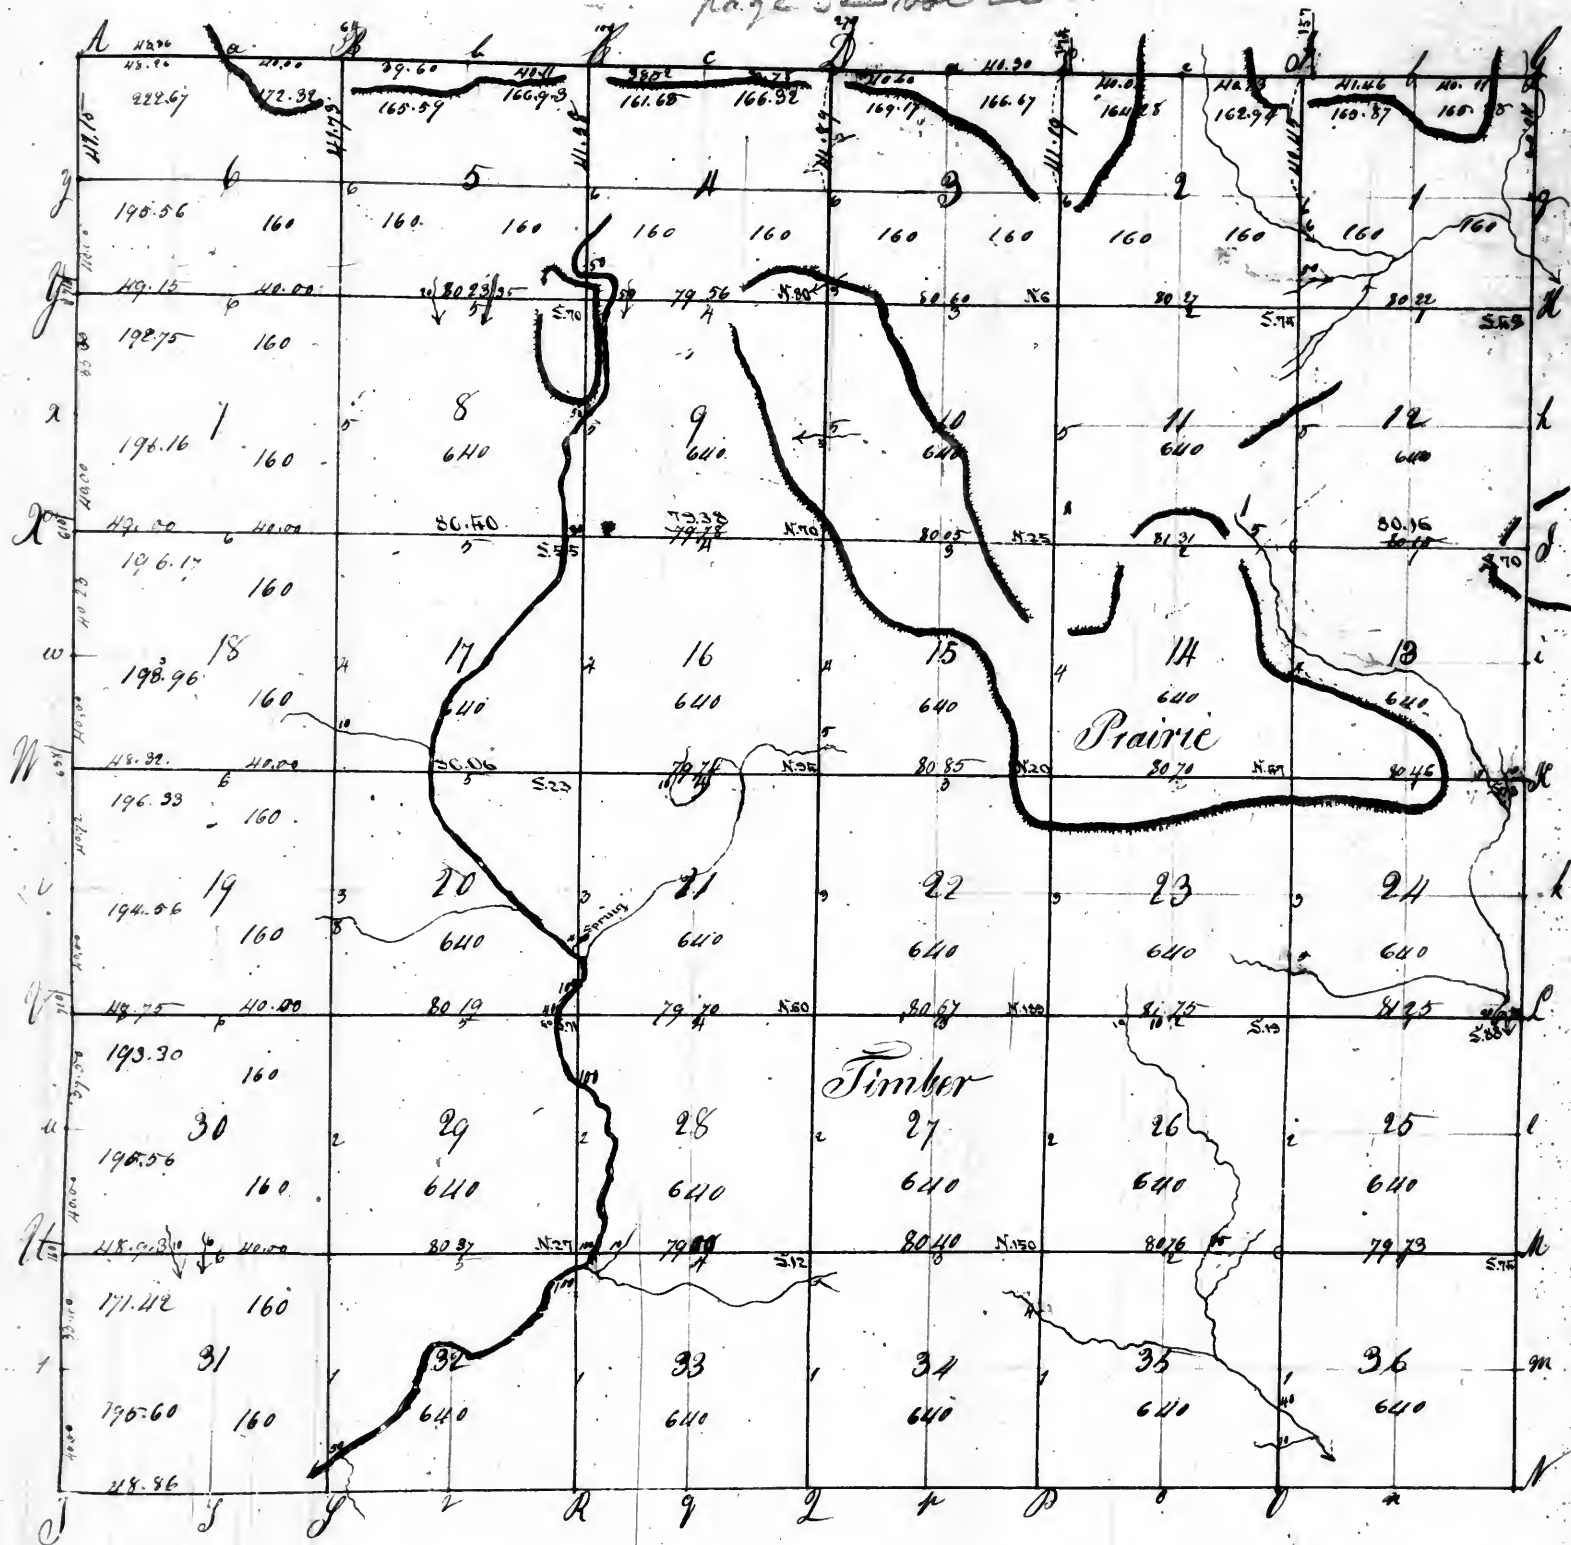


For new plat see Vol. 25 pag 36

page 33 vol 20

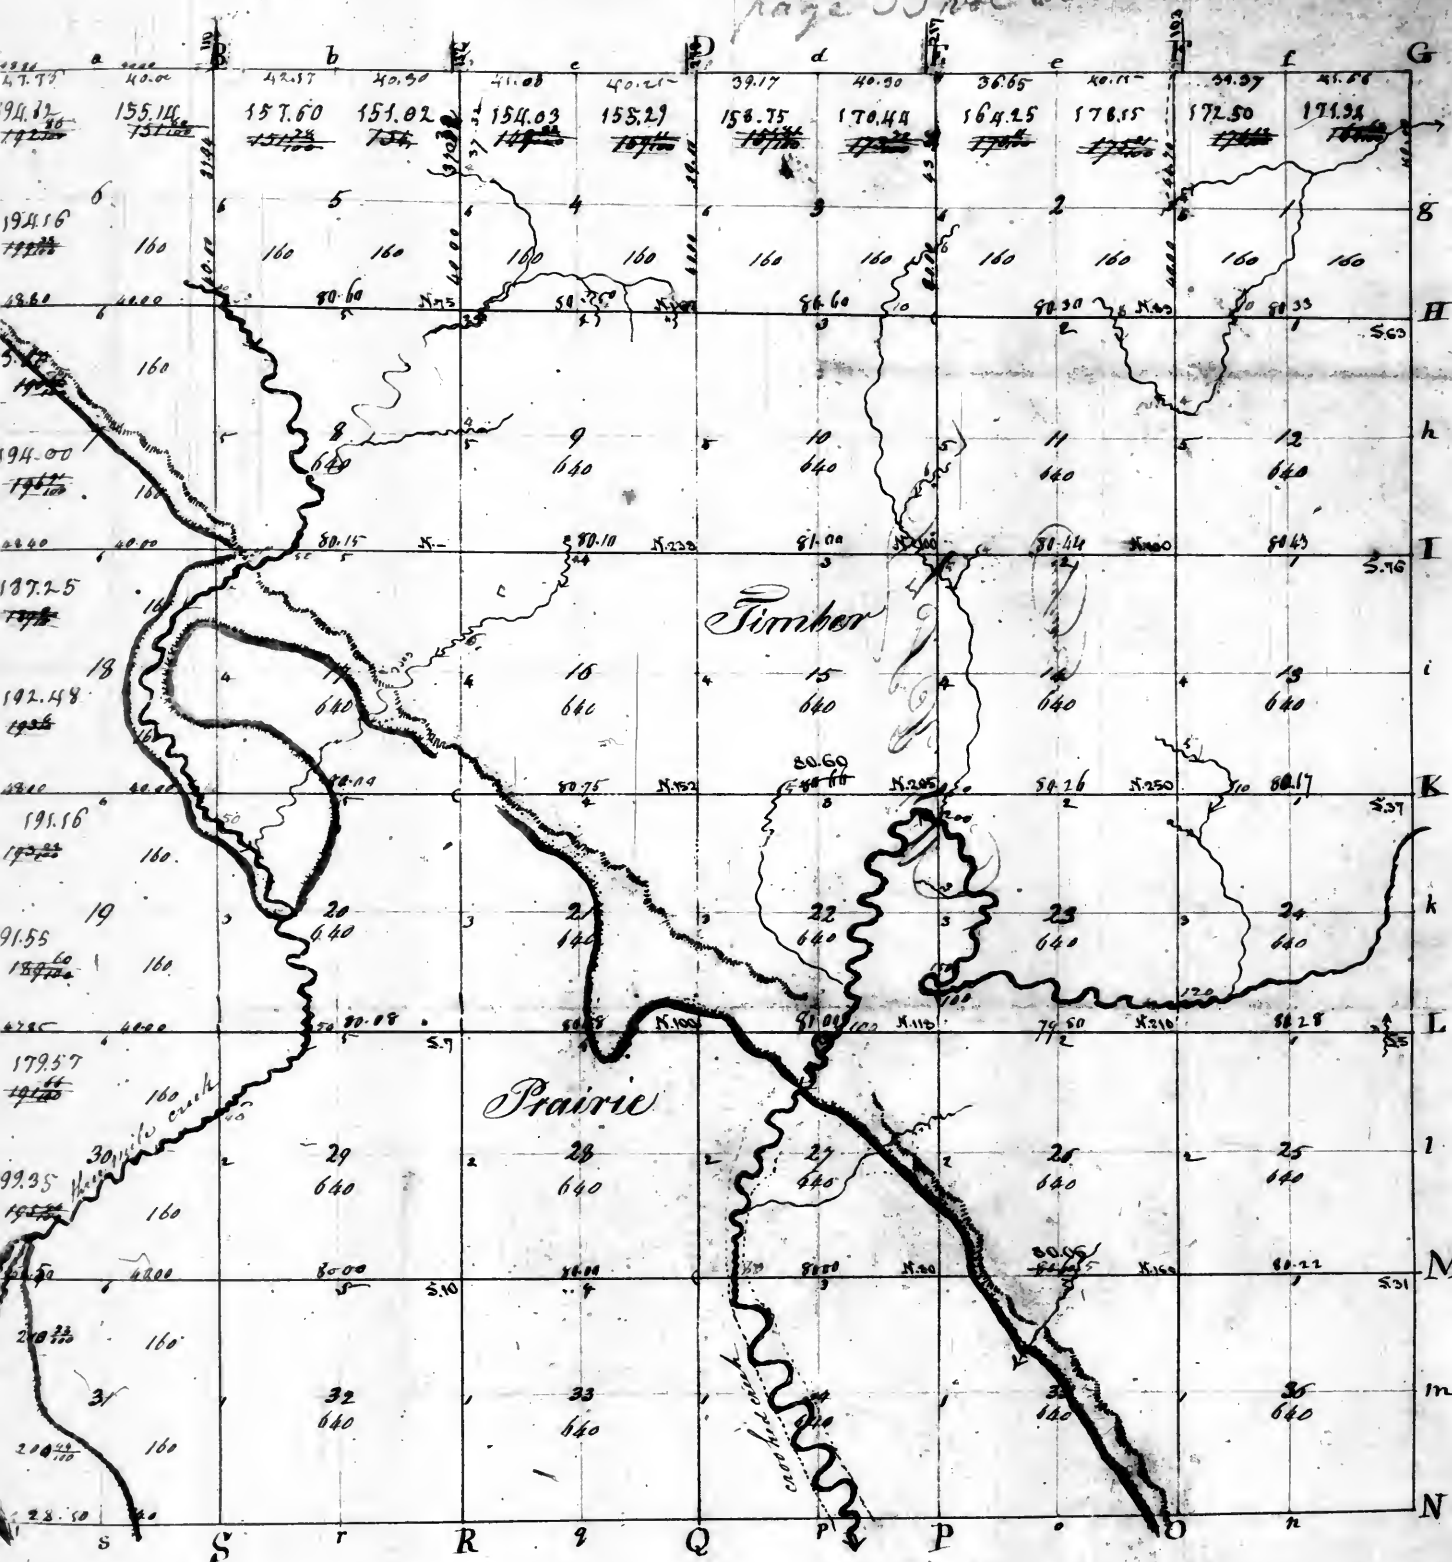

Township 1 South Range 4 West

Page 34 vol 20

 

Continued this 9th day of June 1817

$$\begin{array}{r} 20 \overline{) 160} \\ \underline{40} \\ 120 \\ \underline{120} \\ 0 \end{array}$$

follow page 34
 No 20



Land on Island No. 23

Rich soil timber Elm maple by owner 16

Land on Island No. 24

Rich soil timber Elm maple Mulberry Hackberry

Pecan W.G. Vines & Spice bushes 16

Land on Island No. 25

Principally rich soil timber Elm Hackberry & maple

Land on Island No. 26

Rich soil timber Cottonwood mulberry & Elm 16

Land on Island No. 27

First rate rich soil timber Elm Hackberry Maple 16

For new plat see Vol. 25. pag. 37

Township N. 1 South Range N. 8 West of the 4th Principal Meridian
Page 35 Vol 20




15

[illegible]

52-8.25 West of the ^H 1st Monician

Page 34 vol 20

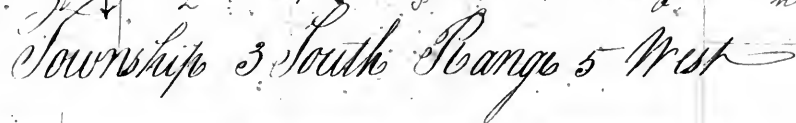

John McDonald Ds.

420


1



14

John McDonald Dr.

For new plat see Vol. 25. page 42.

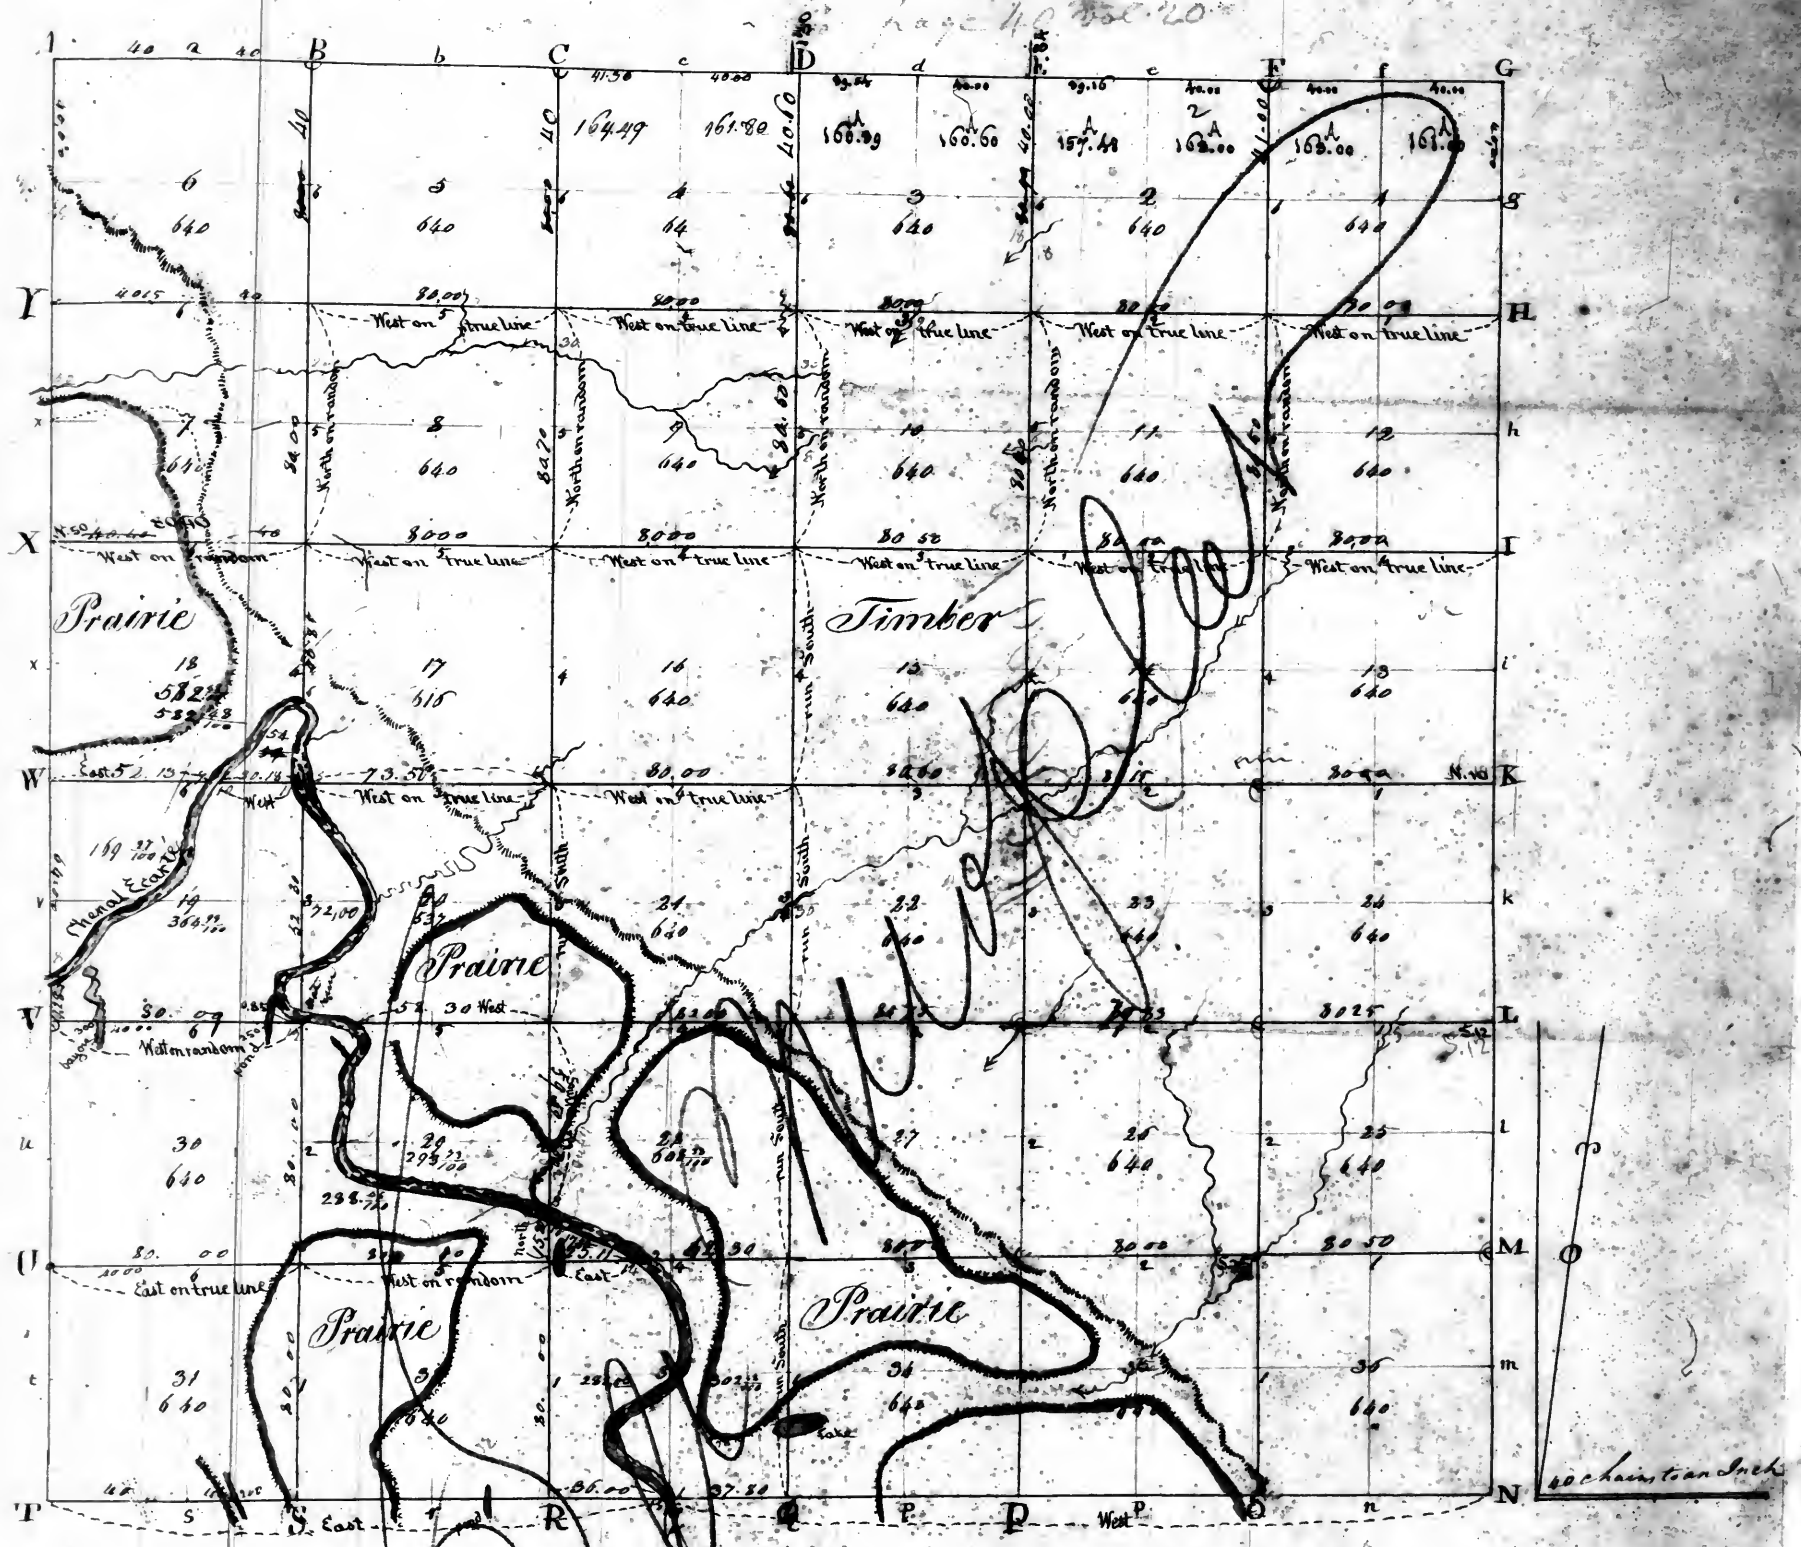


Township 6 South Range 5 West 1st Meridian

For new plat see Vol. 25 pag. 43.

Township N. 7. South Range T. 5 West of the 4th P. Meridian

Page 41 of 20

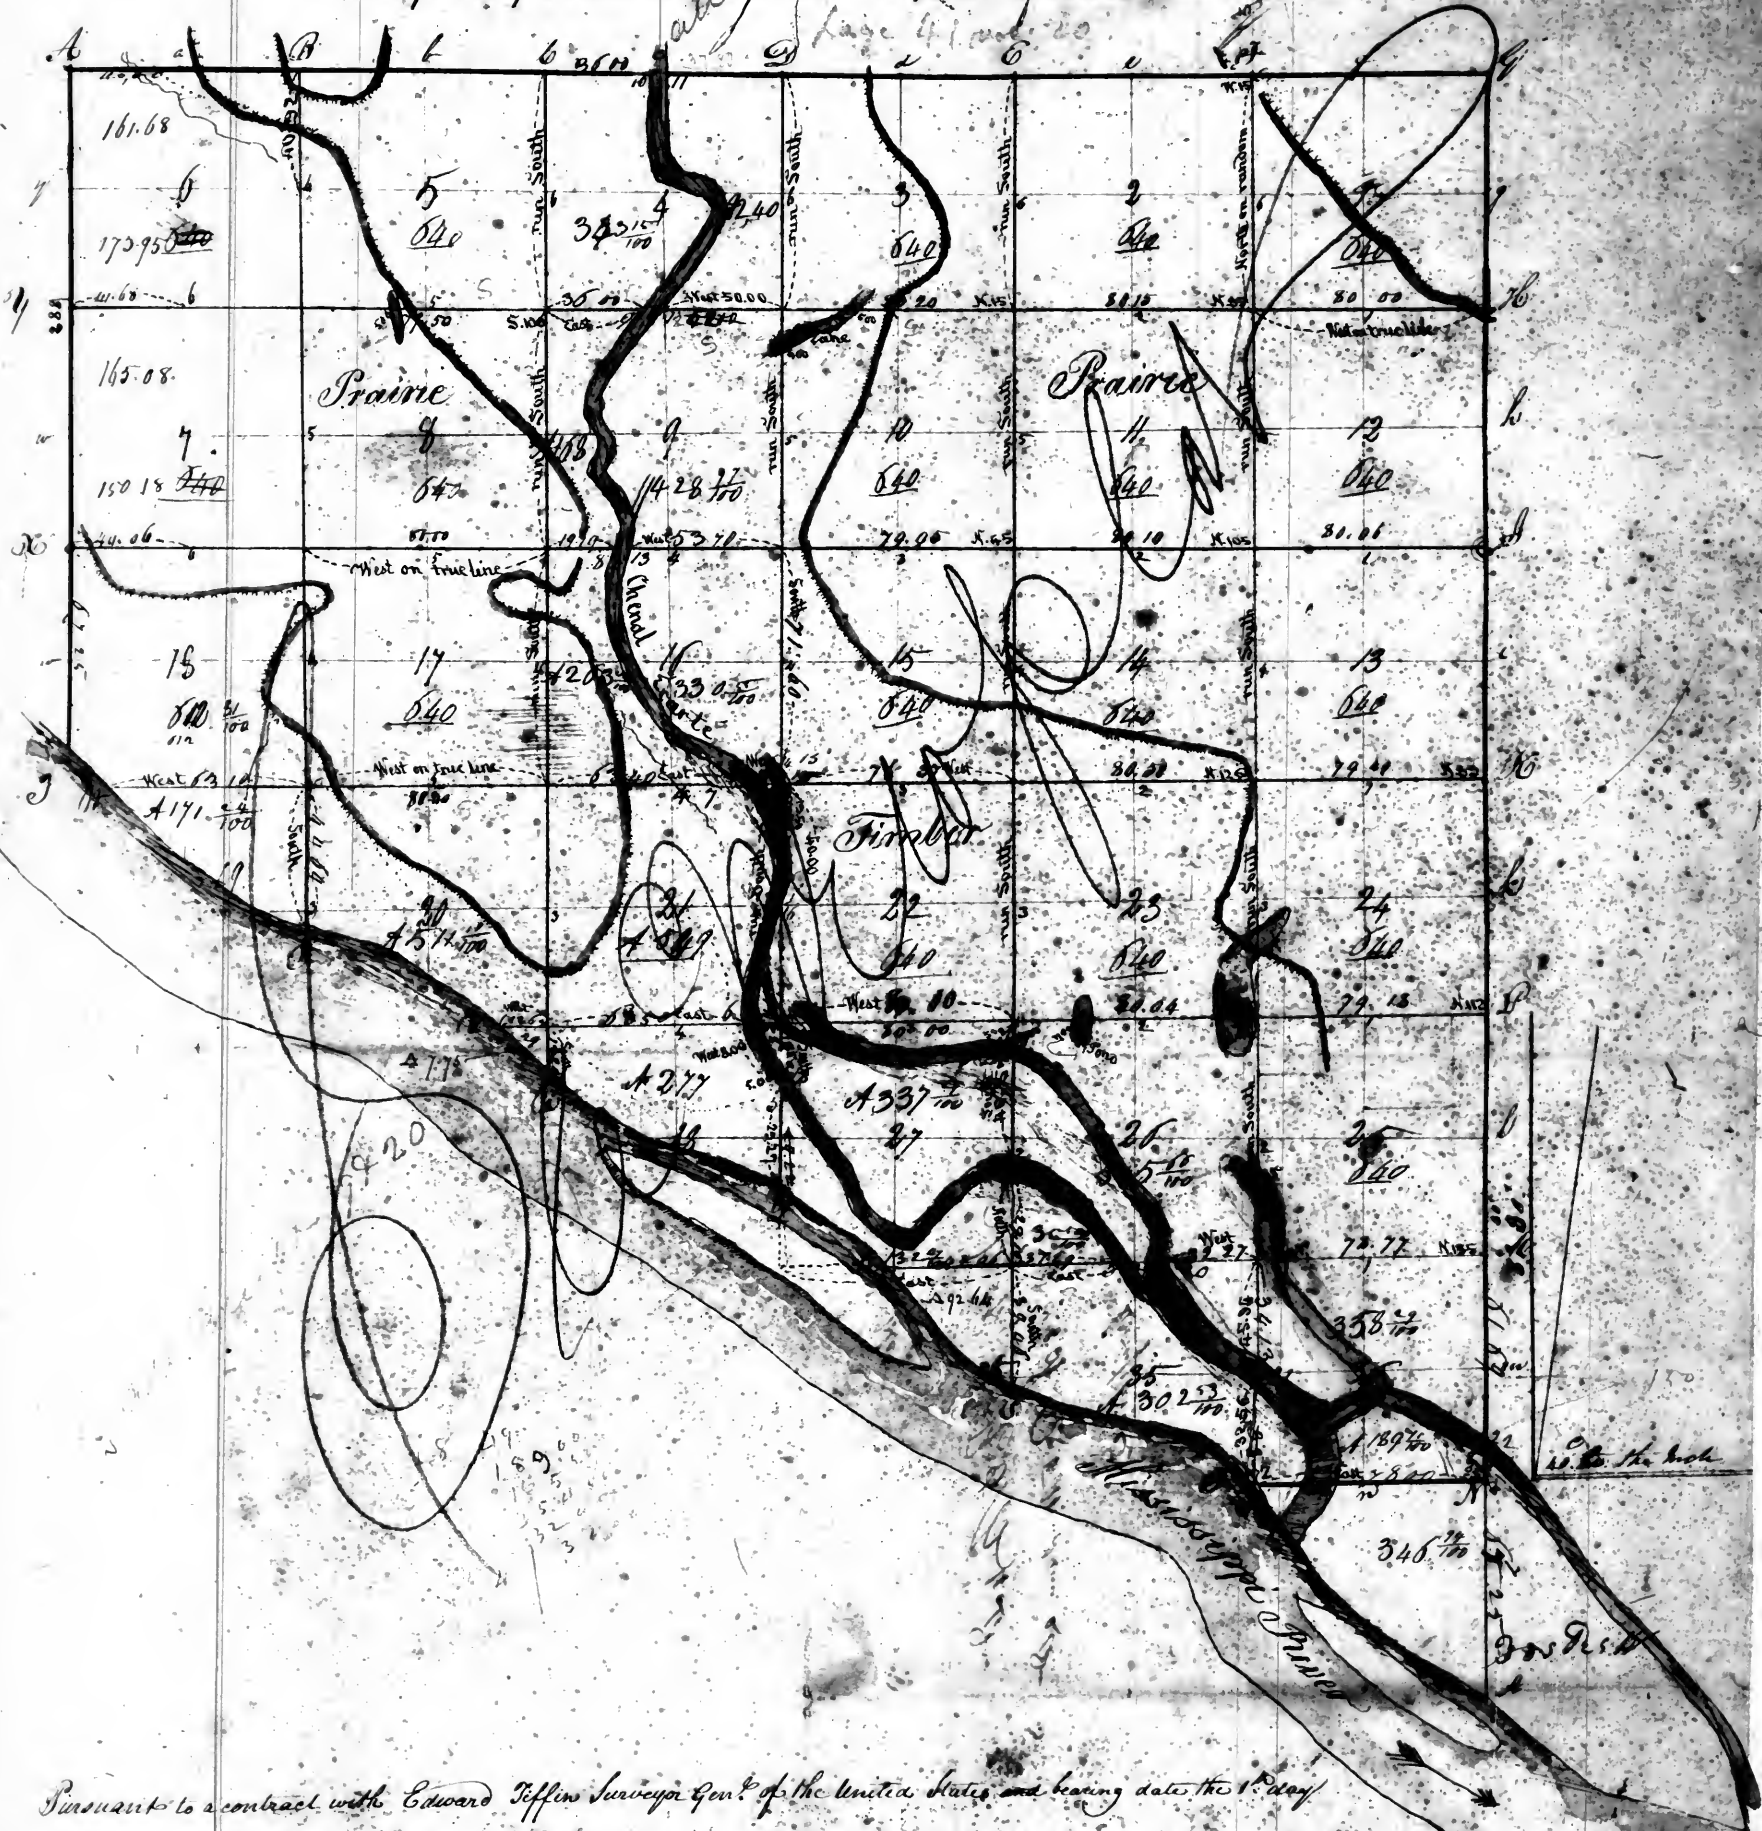


Pursuant to a contract with Edward Tiffin Surveyor Genl. of the United States and bearing date the 1st day of March in the year 1815, and instructions from William B. Rector Surveyor of the United States in the Illinois & Missouri Territories I have admeasured ~~and~~ laid out & surveyed the above described Tract Township and do hereby certify that it had such Marks and Bounds both Natural & Artificial as are ^{represented} on said plat and Described in the field notes made thereof and returned into the Office of the Surveyor of the Lands of the United States of the Territories of Illinois & Missouri


certified this 9th day of June 1817

John McDonald, D.S.


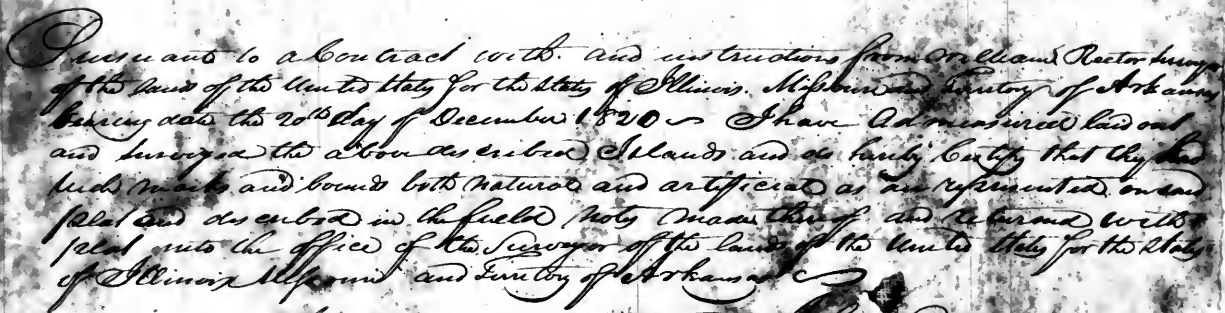


John H. Steel Surveyor.

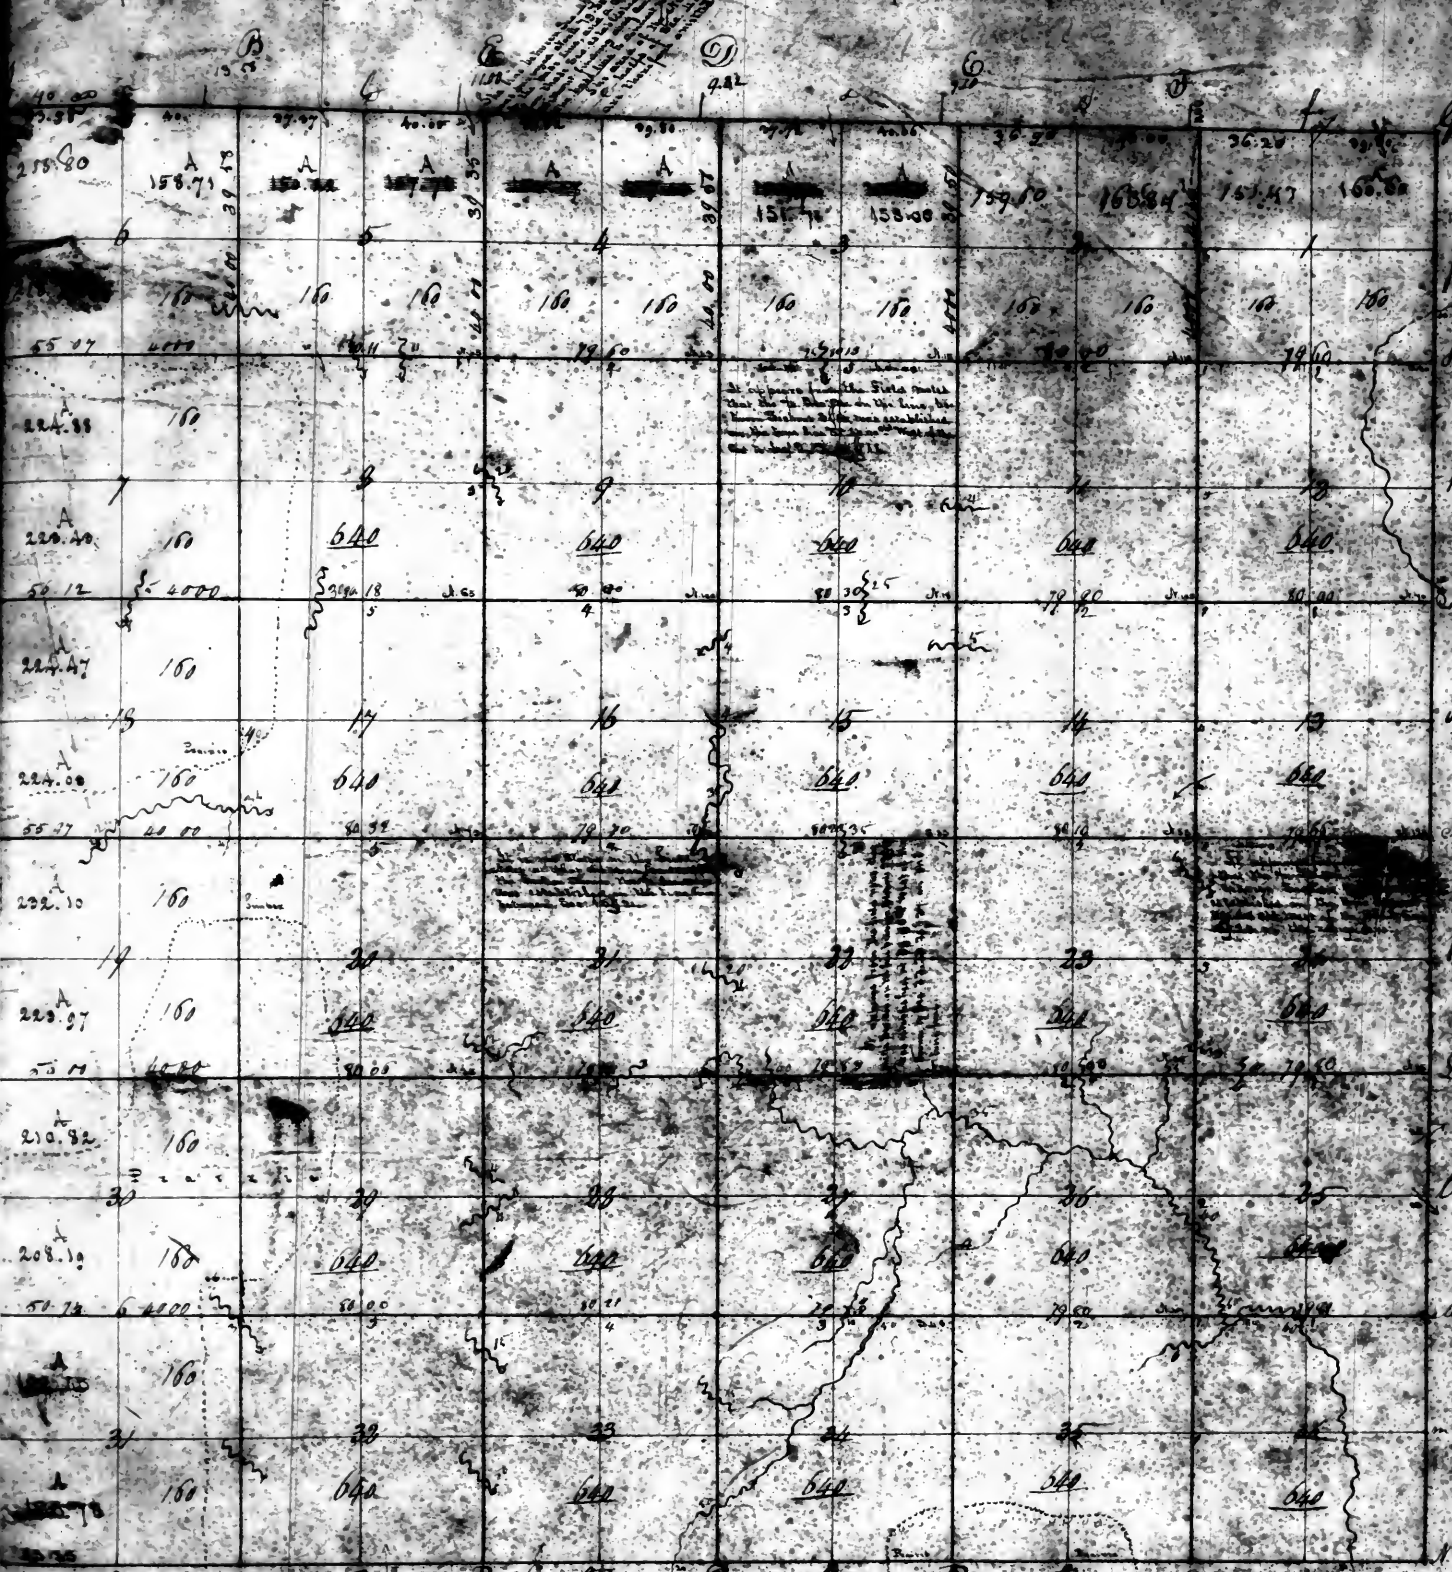[illegible]

Township 1 South Range 6 West


John McDonald Jr

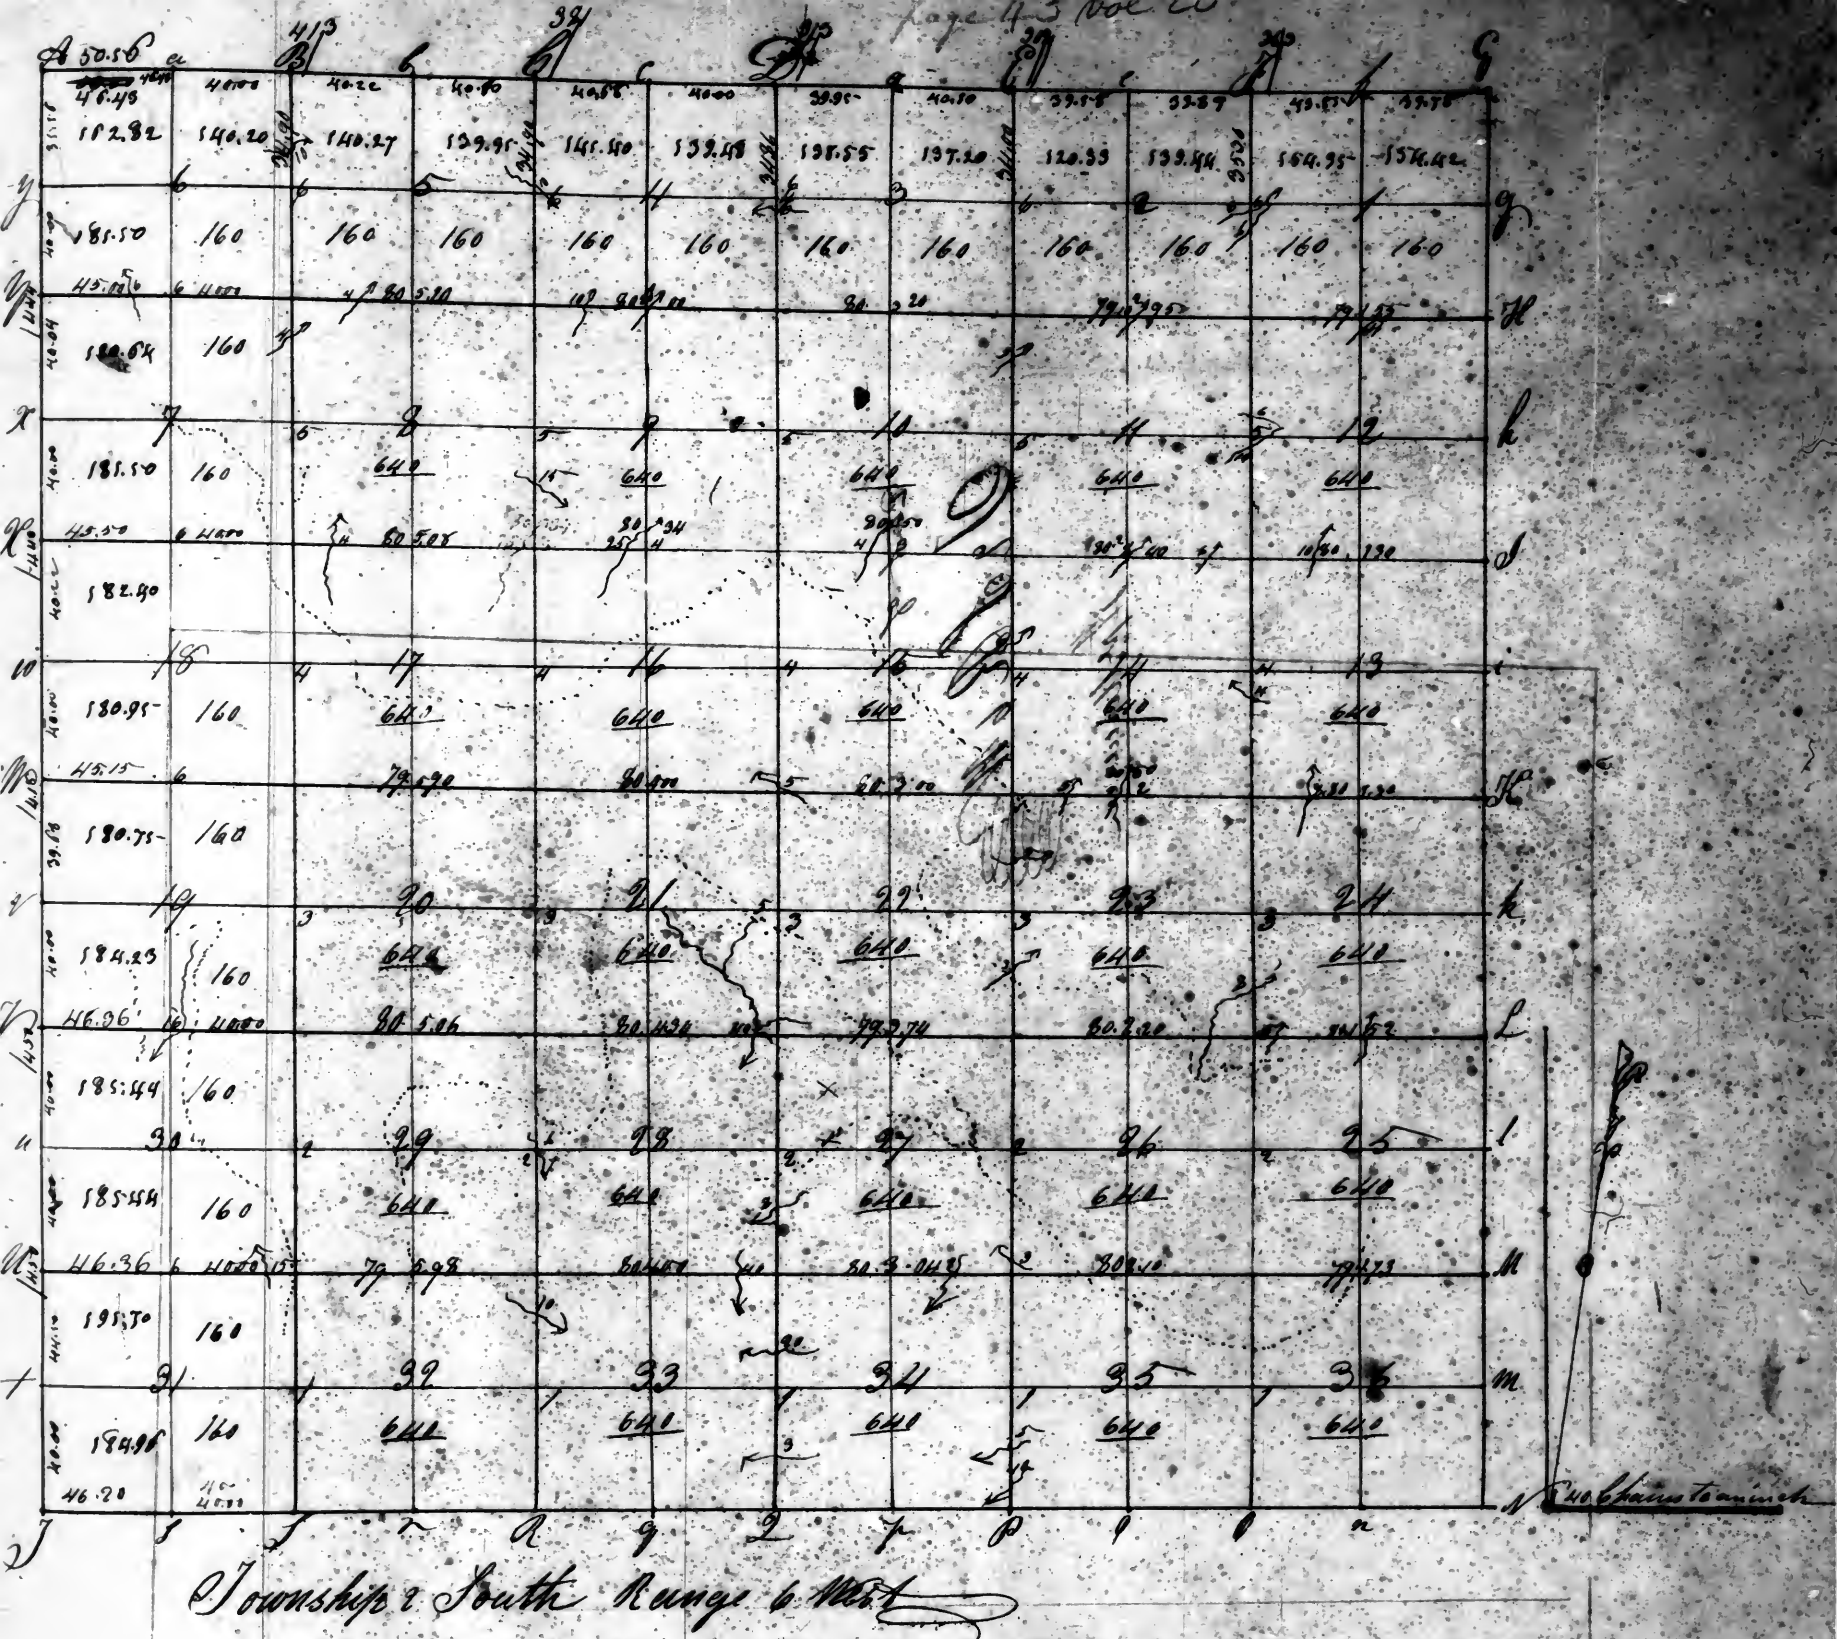


Page 44 vol 20

[illegible]




John McDonald Del

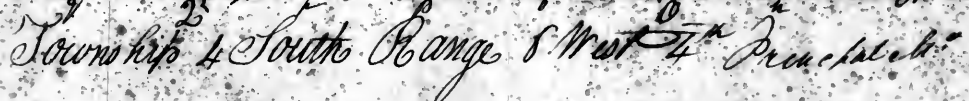


John McDonald S.S.

100

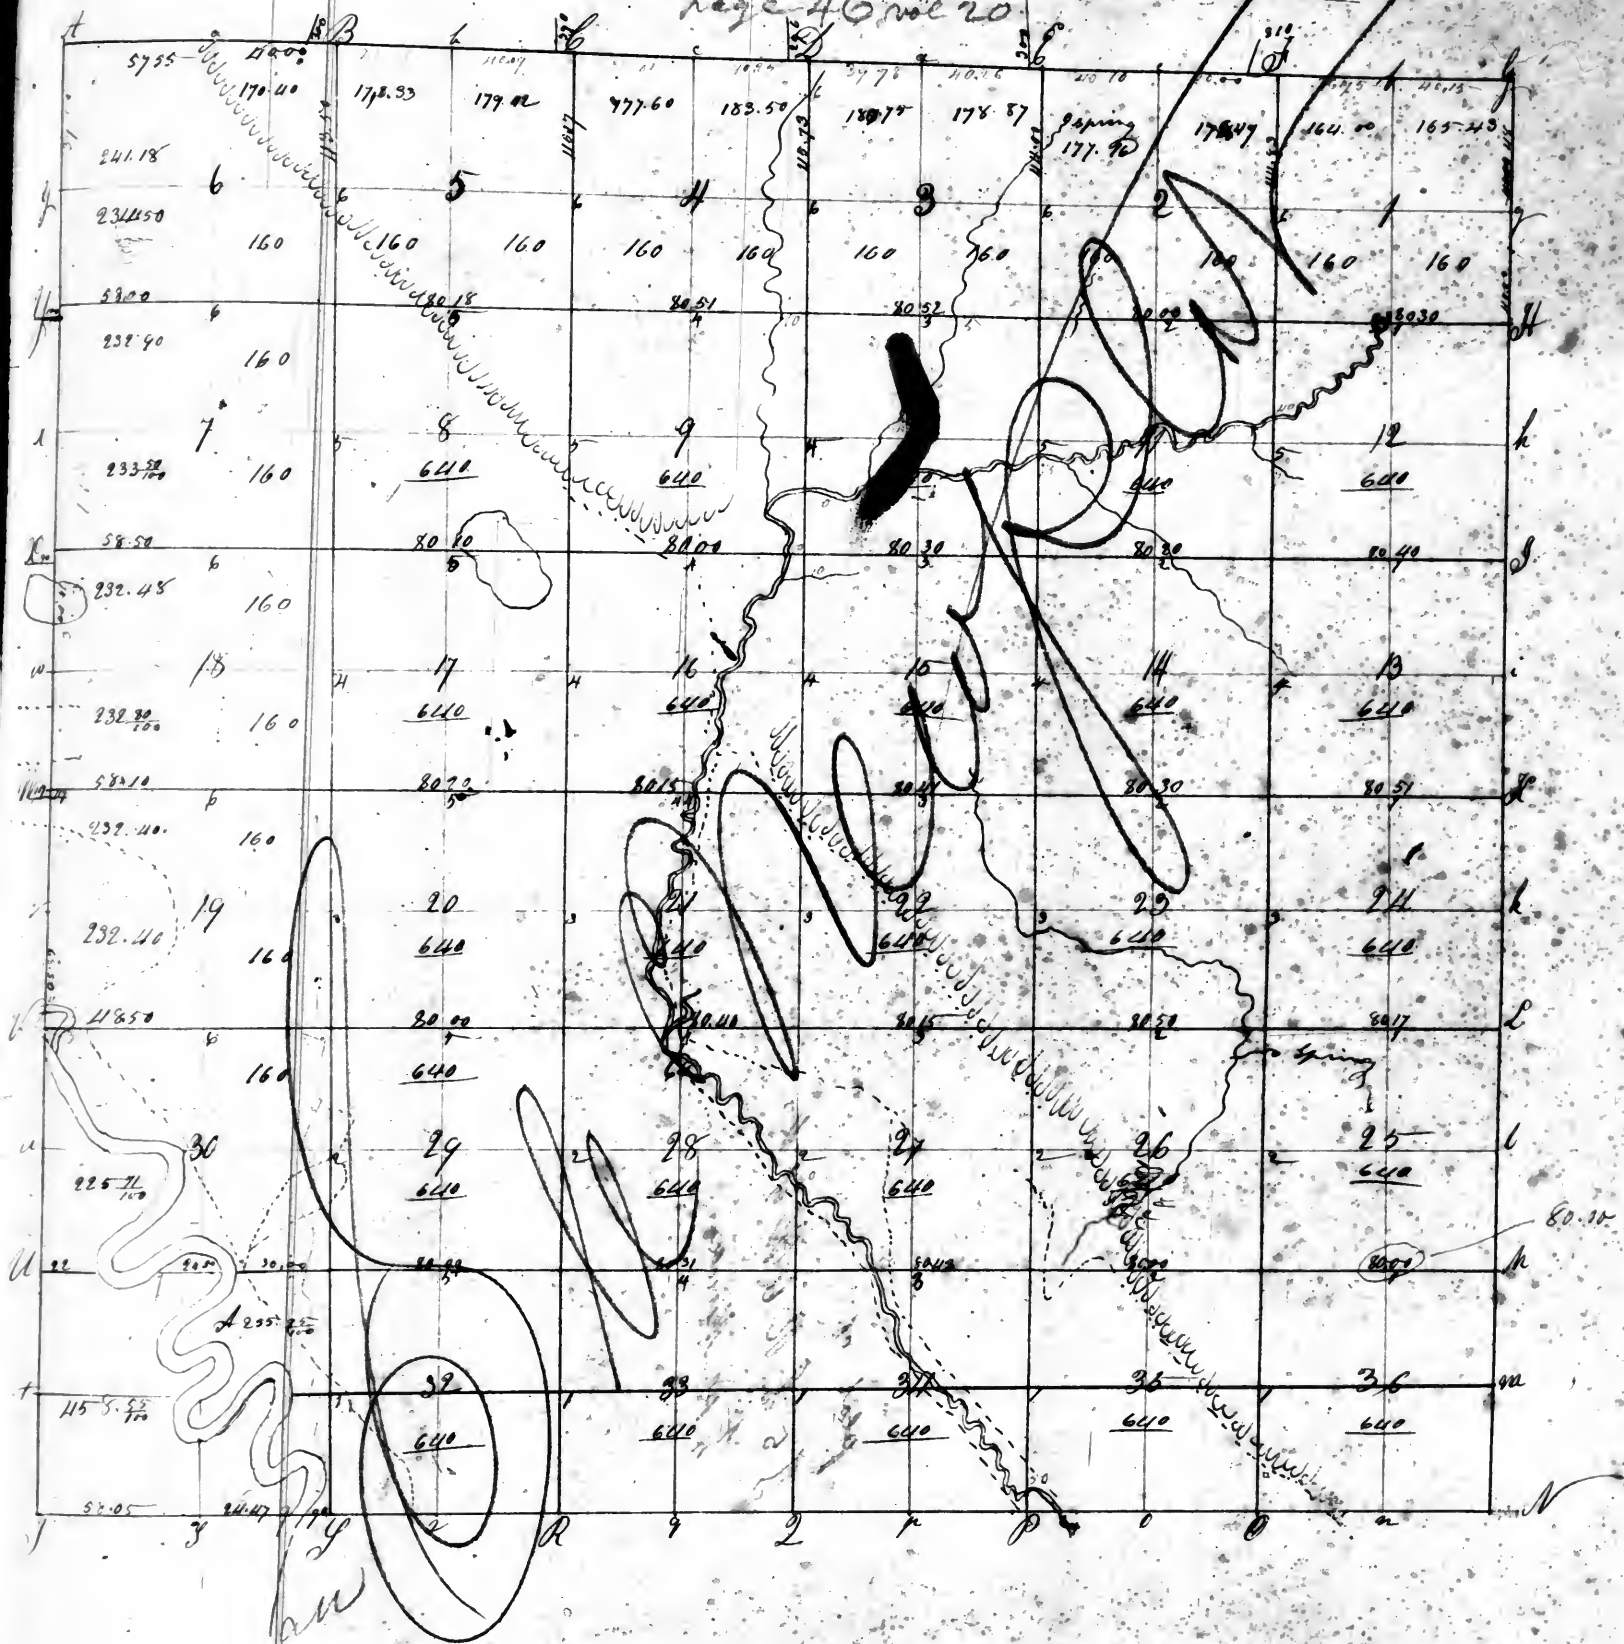

page 47 no C 20

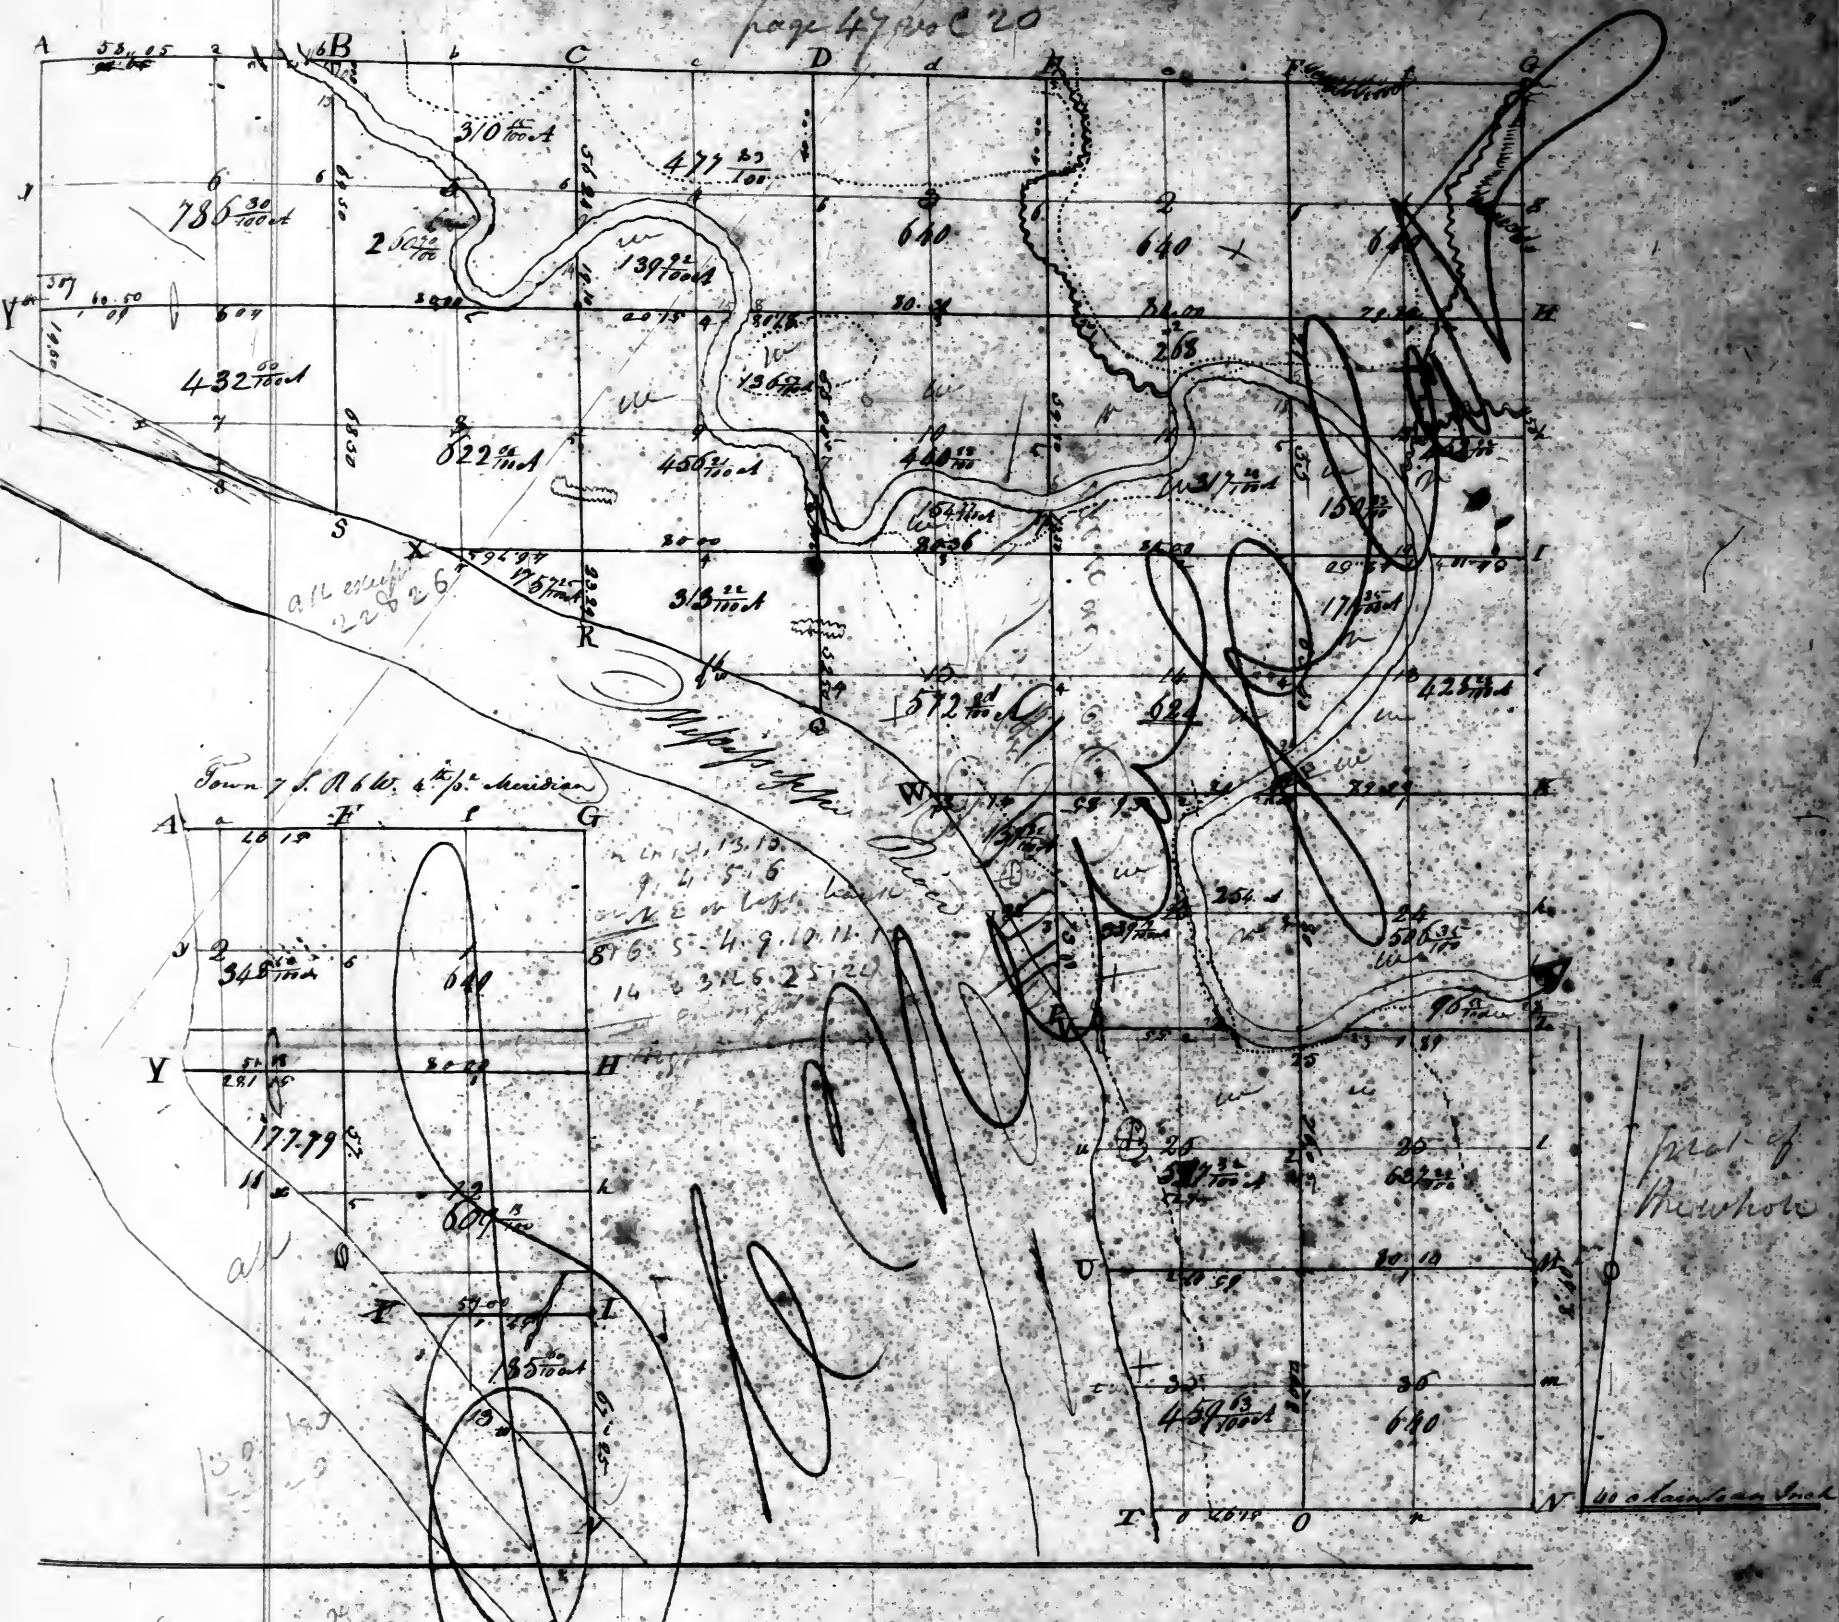

Fractional Townships 6 & 7 S. Range 6 W.

Witnessed to a contract with Edward Tiffin, Surveyor General of the United States, bearing date the 1 day March 1866, and
Instructions from William P. Foster, Surveyor of the Lands of the United States in the Territories of Illinois & Missouri, I have
admeasured and surveyed the above described Fractional Townships - whereby I certify that they had been marked & having
been returned and deposited as is required by law in the office of the Surveyor of the Lands of the United States for the Territories of Illinois & Missouri.

[illegible]

follow page 41
Nov 20


Land on Island No 35
Rich sandy soil Timber Elm Maple Hackberry
Mulberry & Cottonwood
Land on Island No 36
first rate soil. Timber Elm Hackberry mulberry
ash & cotton wood
Land on Island No 38
Rich soil Timber cotton wood & maple
Land on Island No 39
Rich soil Timber Elm Maple
cotton wood Hackberry &c

Pursuant to a contract with and instructions from
William Rector Surveyor of the land of the United States
for the States of Illinois, Missouri and Territory of Arkansas
bearing date the 20th December 1808, I have measured
laid out and surveyed the above described lands, and
do hereby certify that they have such marks and bounds
both natural and artificial as are represented on
said plat and described in the field notes made
thereof, and returned with this plat into the office
of the Surveyor of the land of the United States for
the States of Illinois, Missouri and Territory of
Arkansas


John B. Clark Surveyor

certified 11th Jan 1852

Page 48 vol. 20

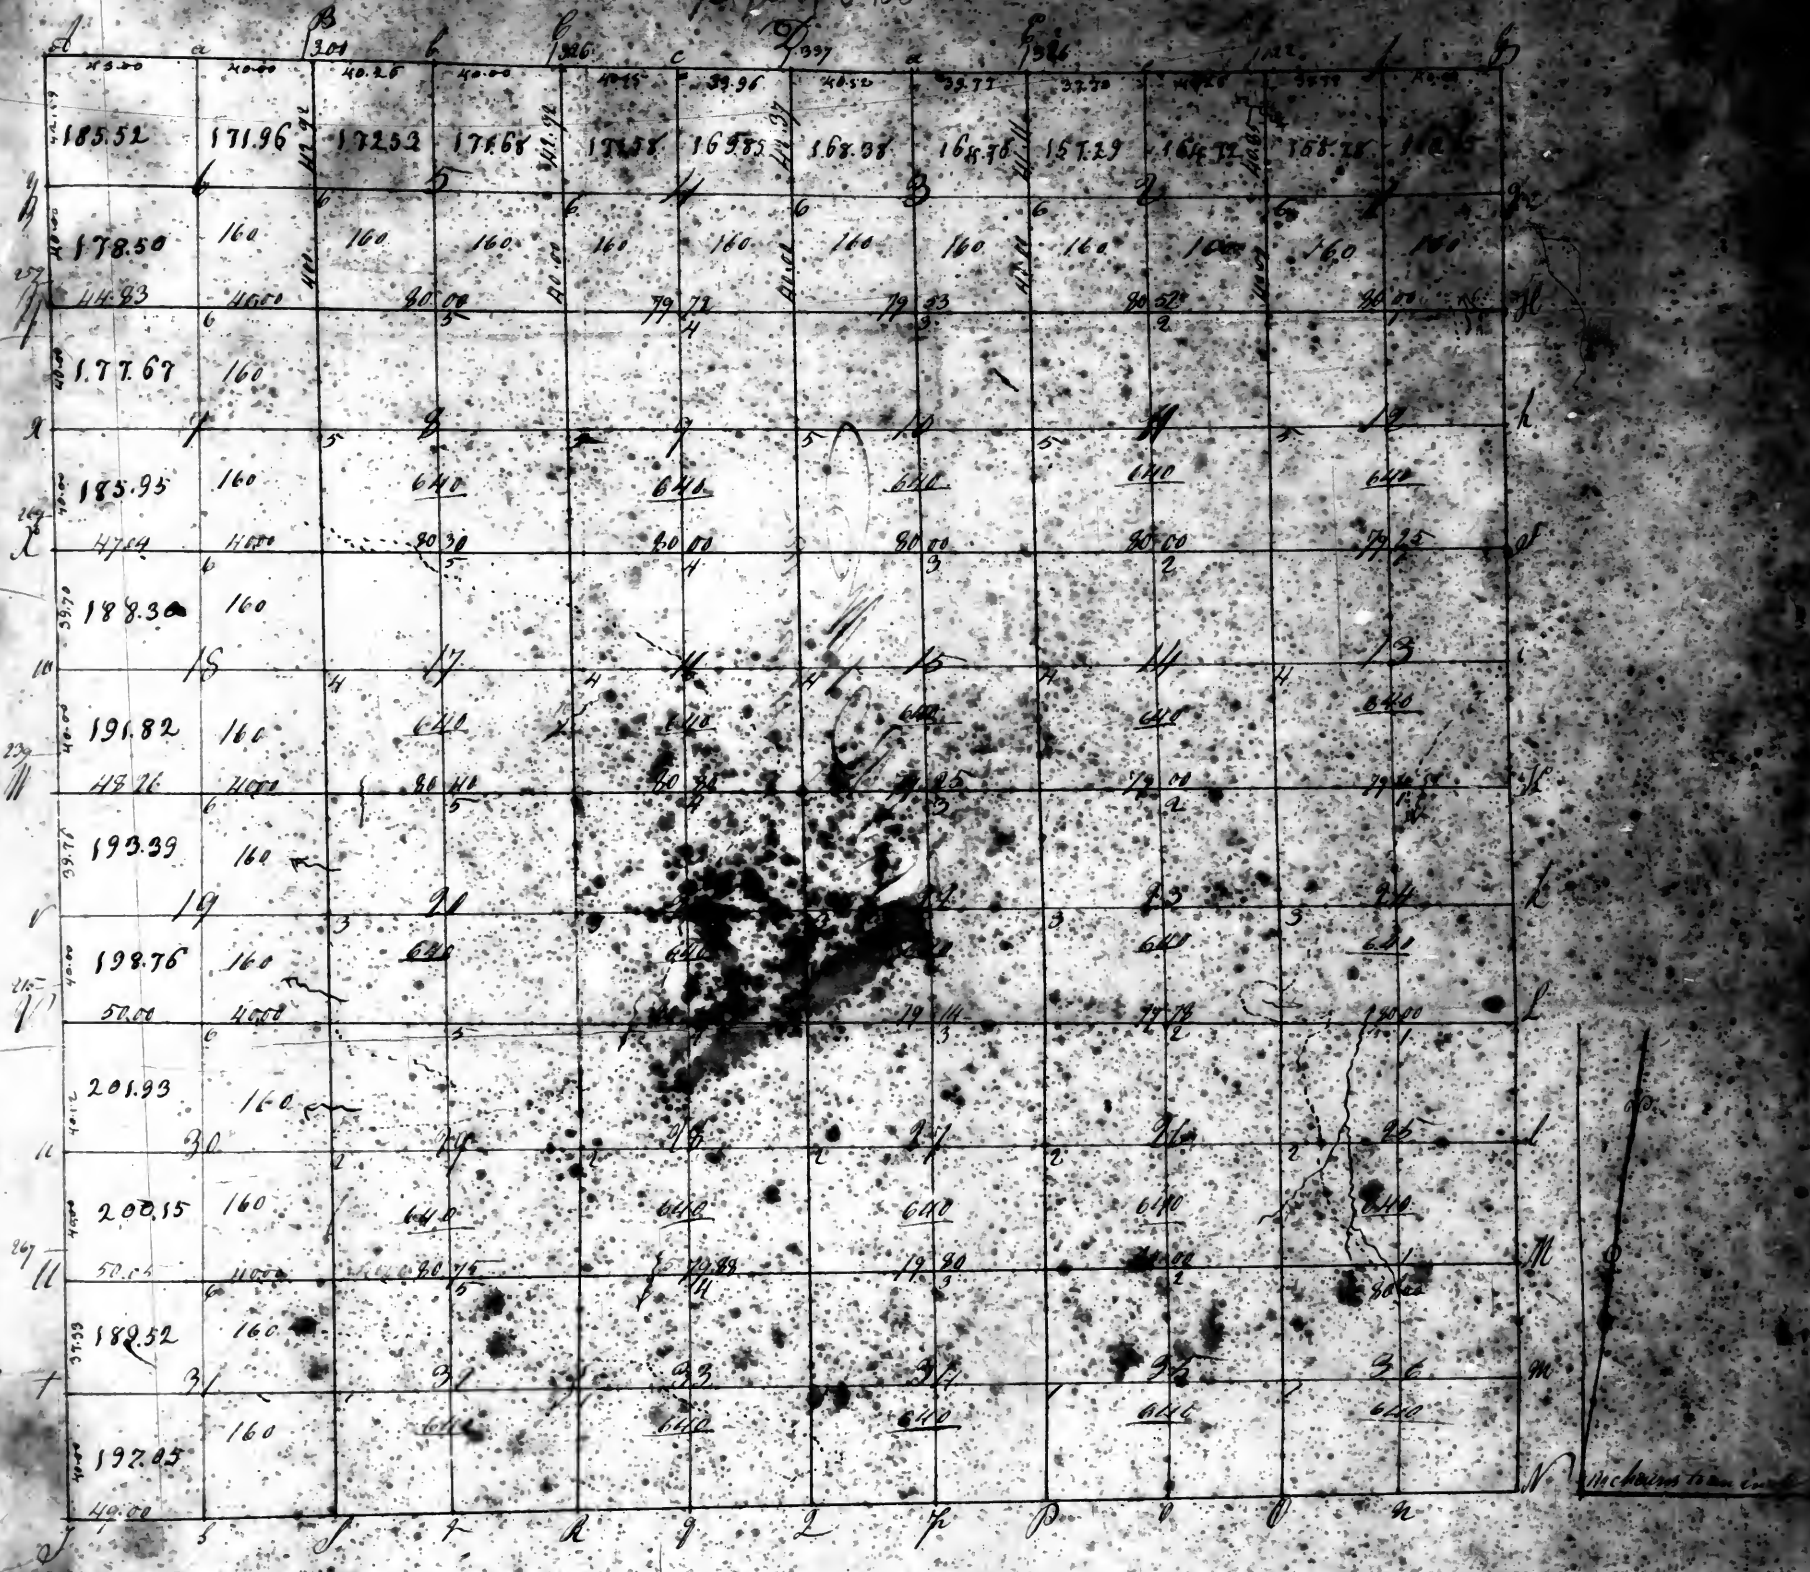

Township 4 South Range 7 West

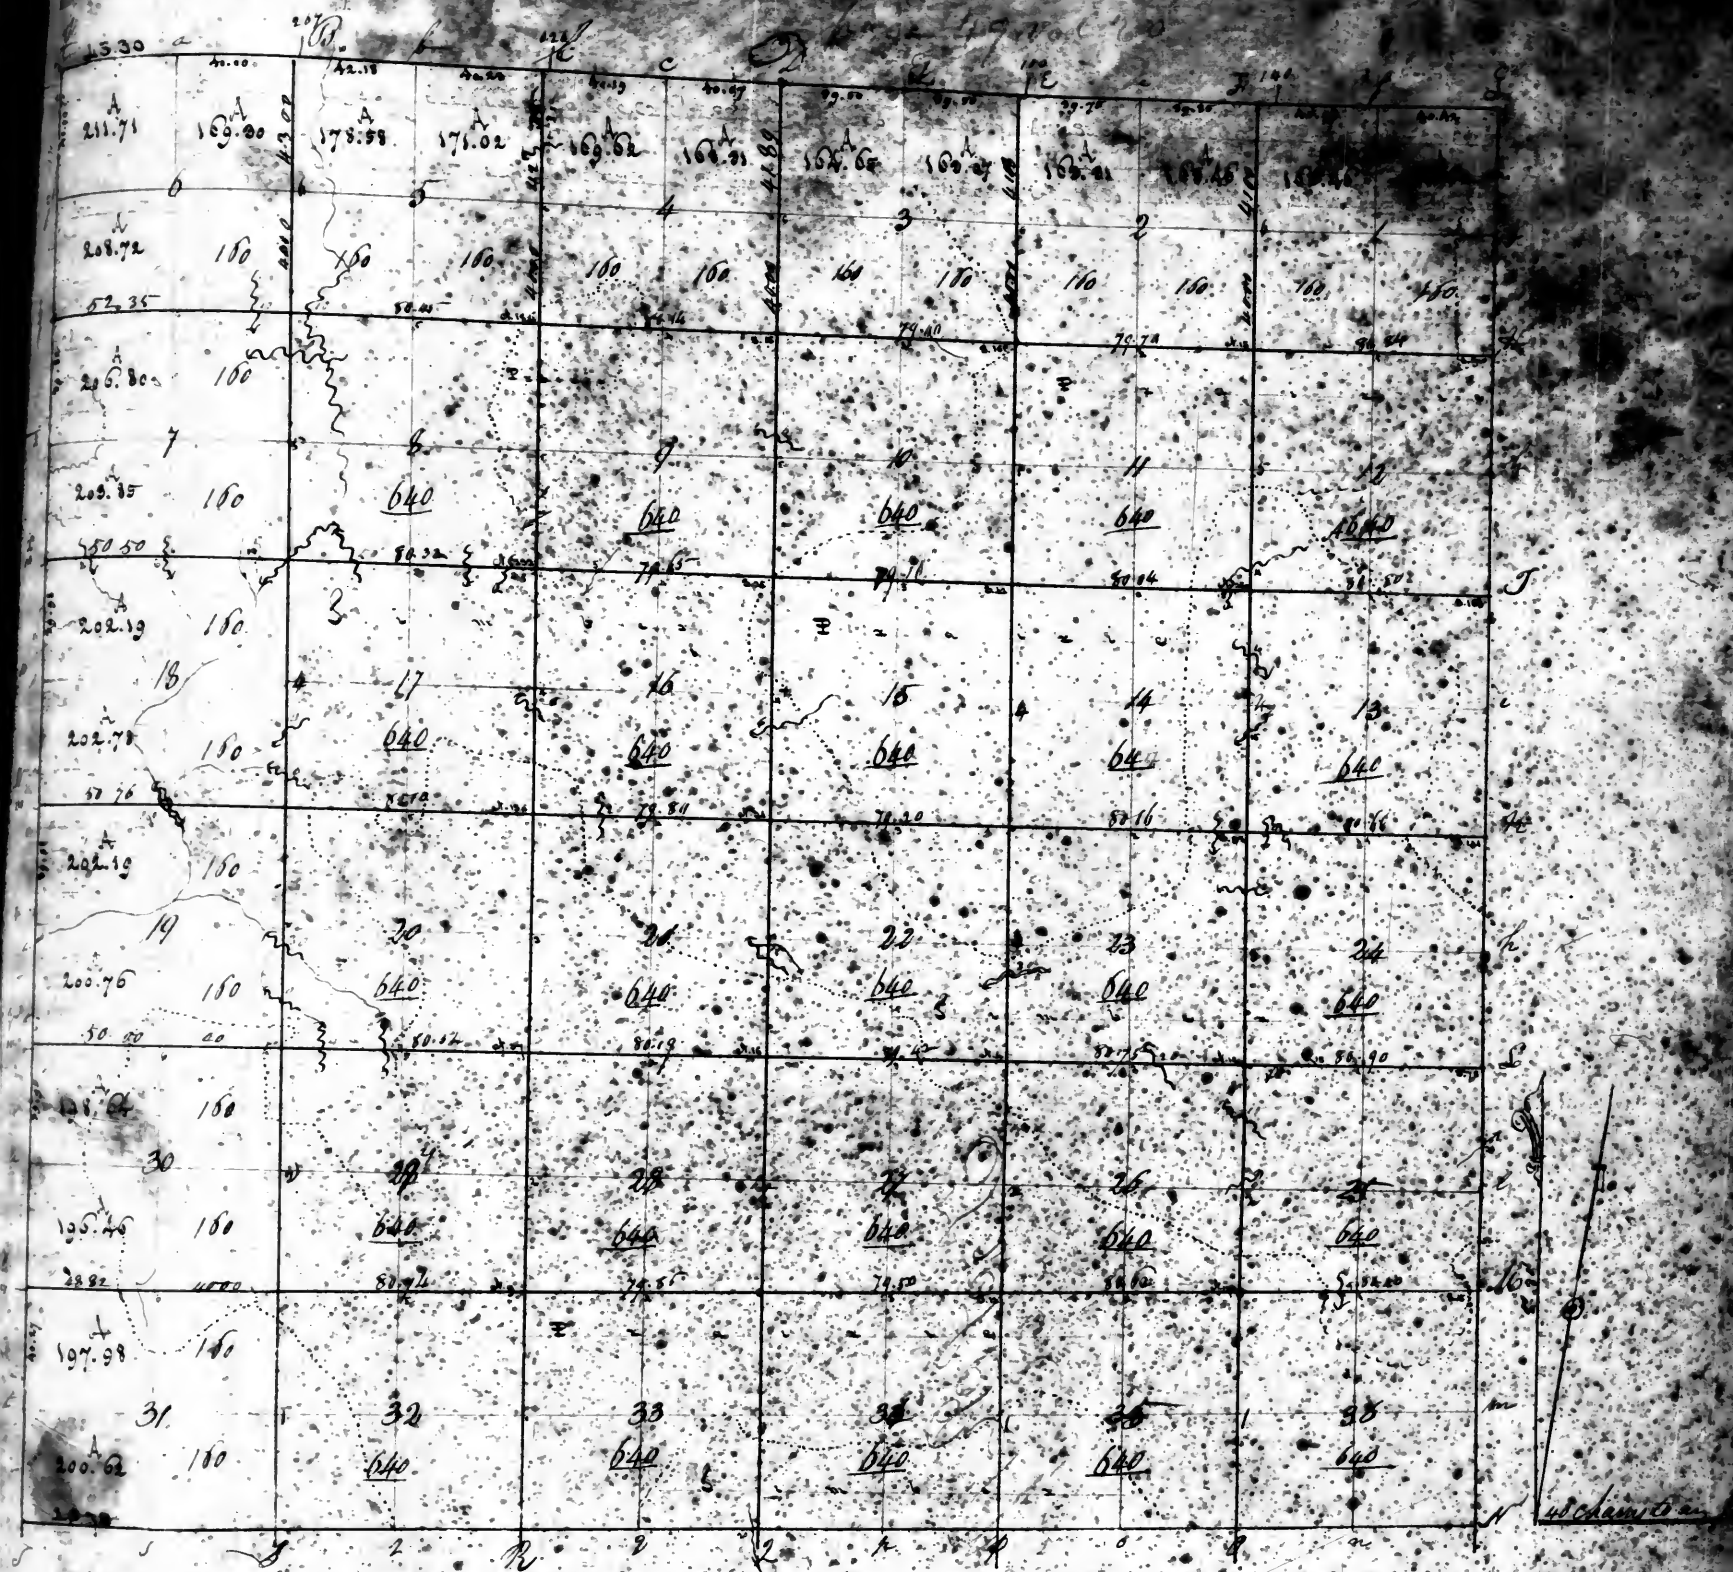


Township 2 South Range 7 West of the 4th Principal Meridian




1000

page 50 no 20

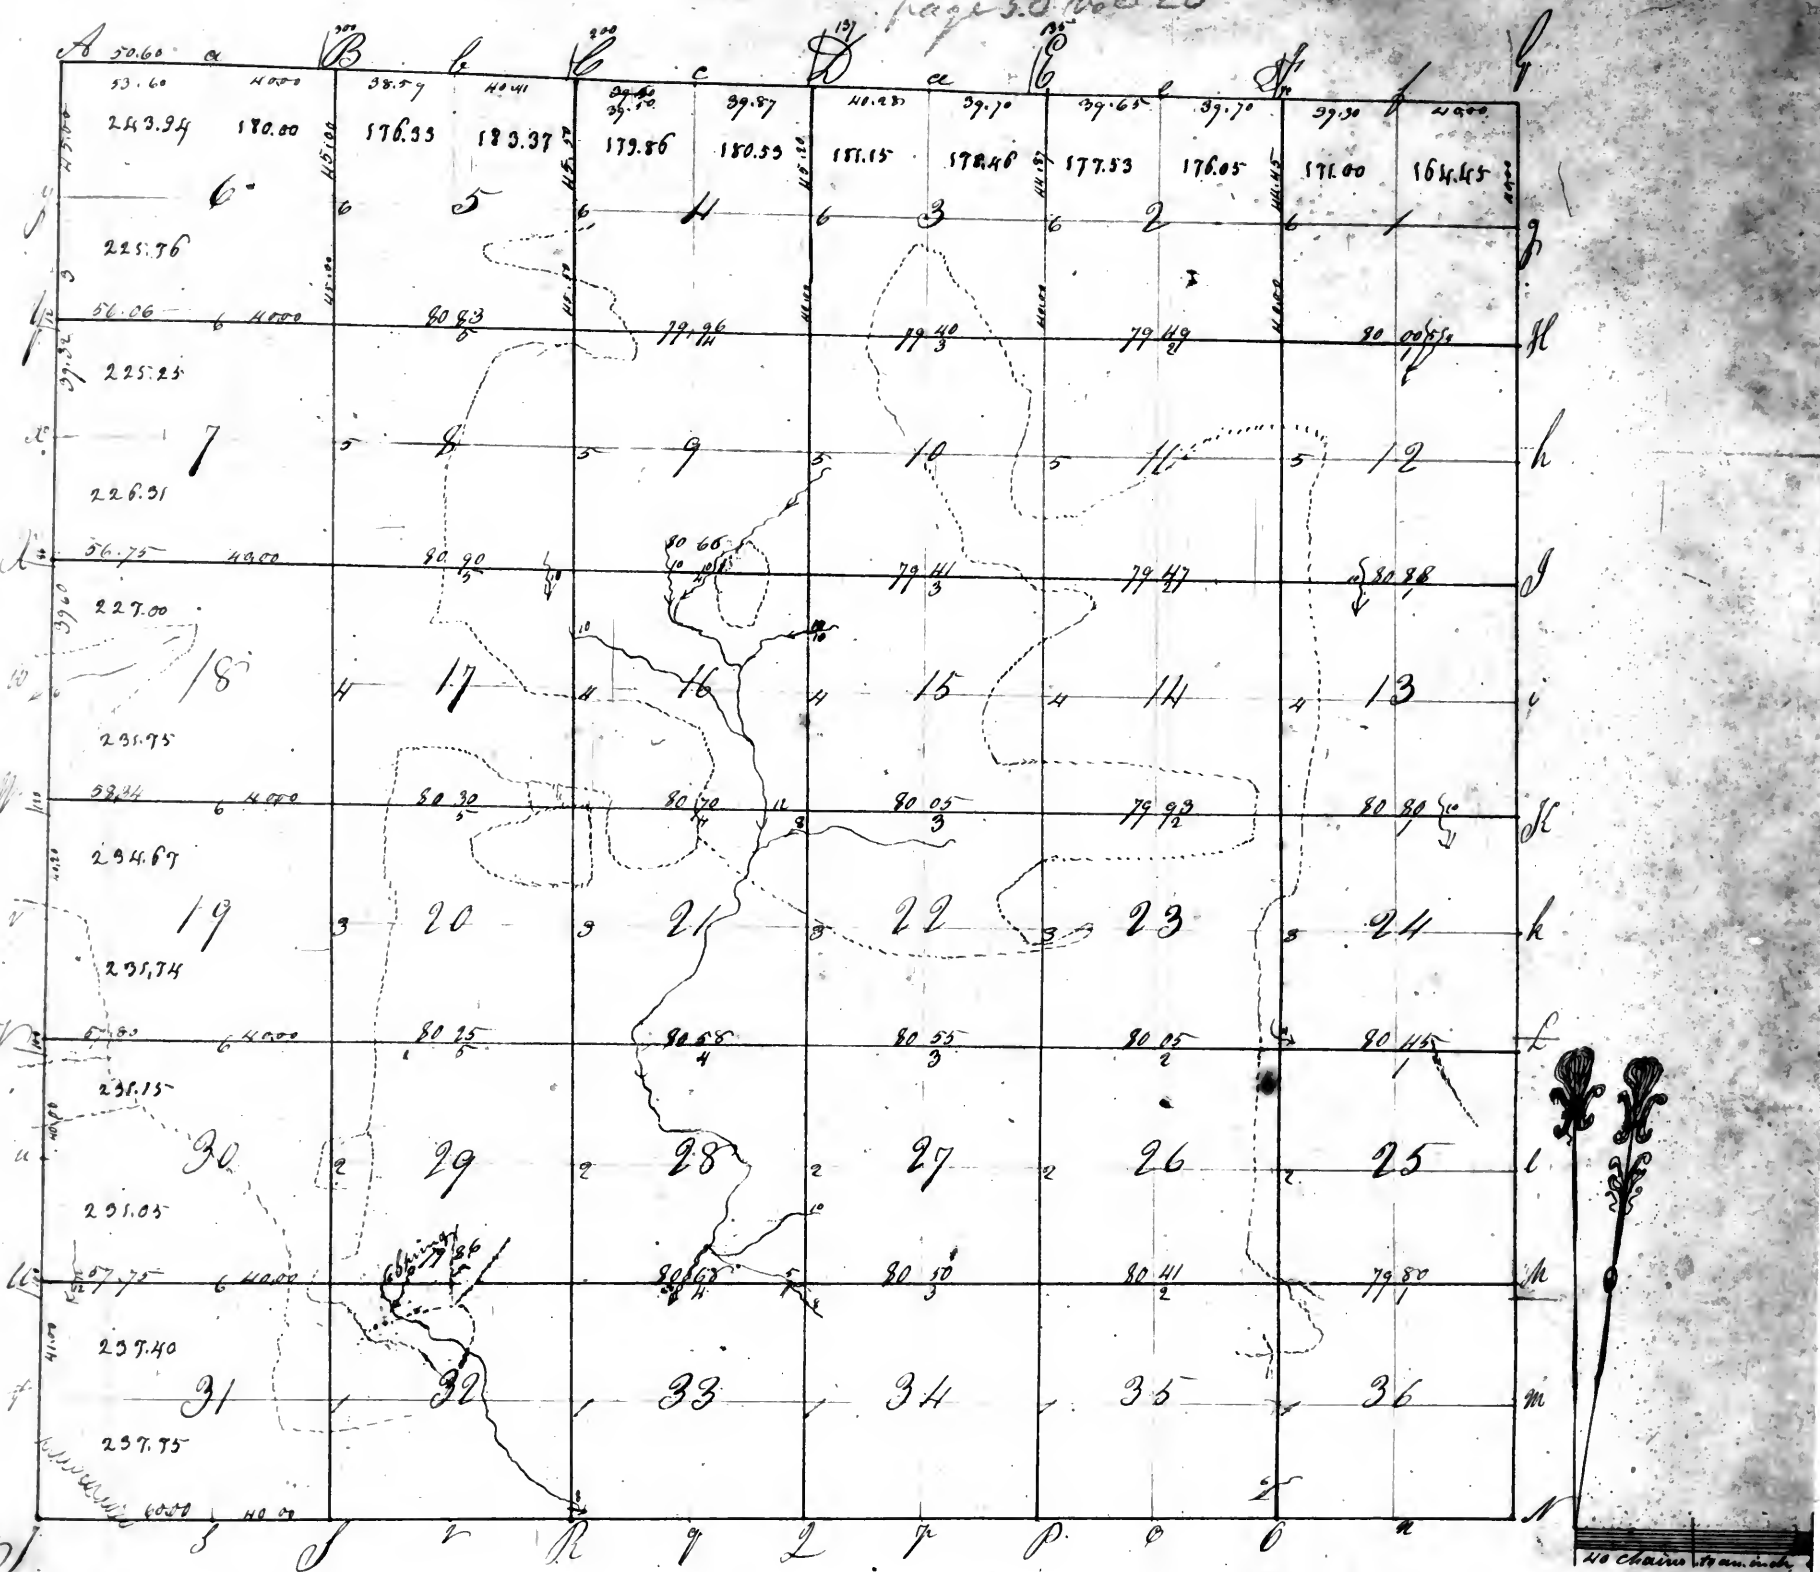

Township 3 South Range 7 West of the 11th principal Meridian

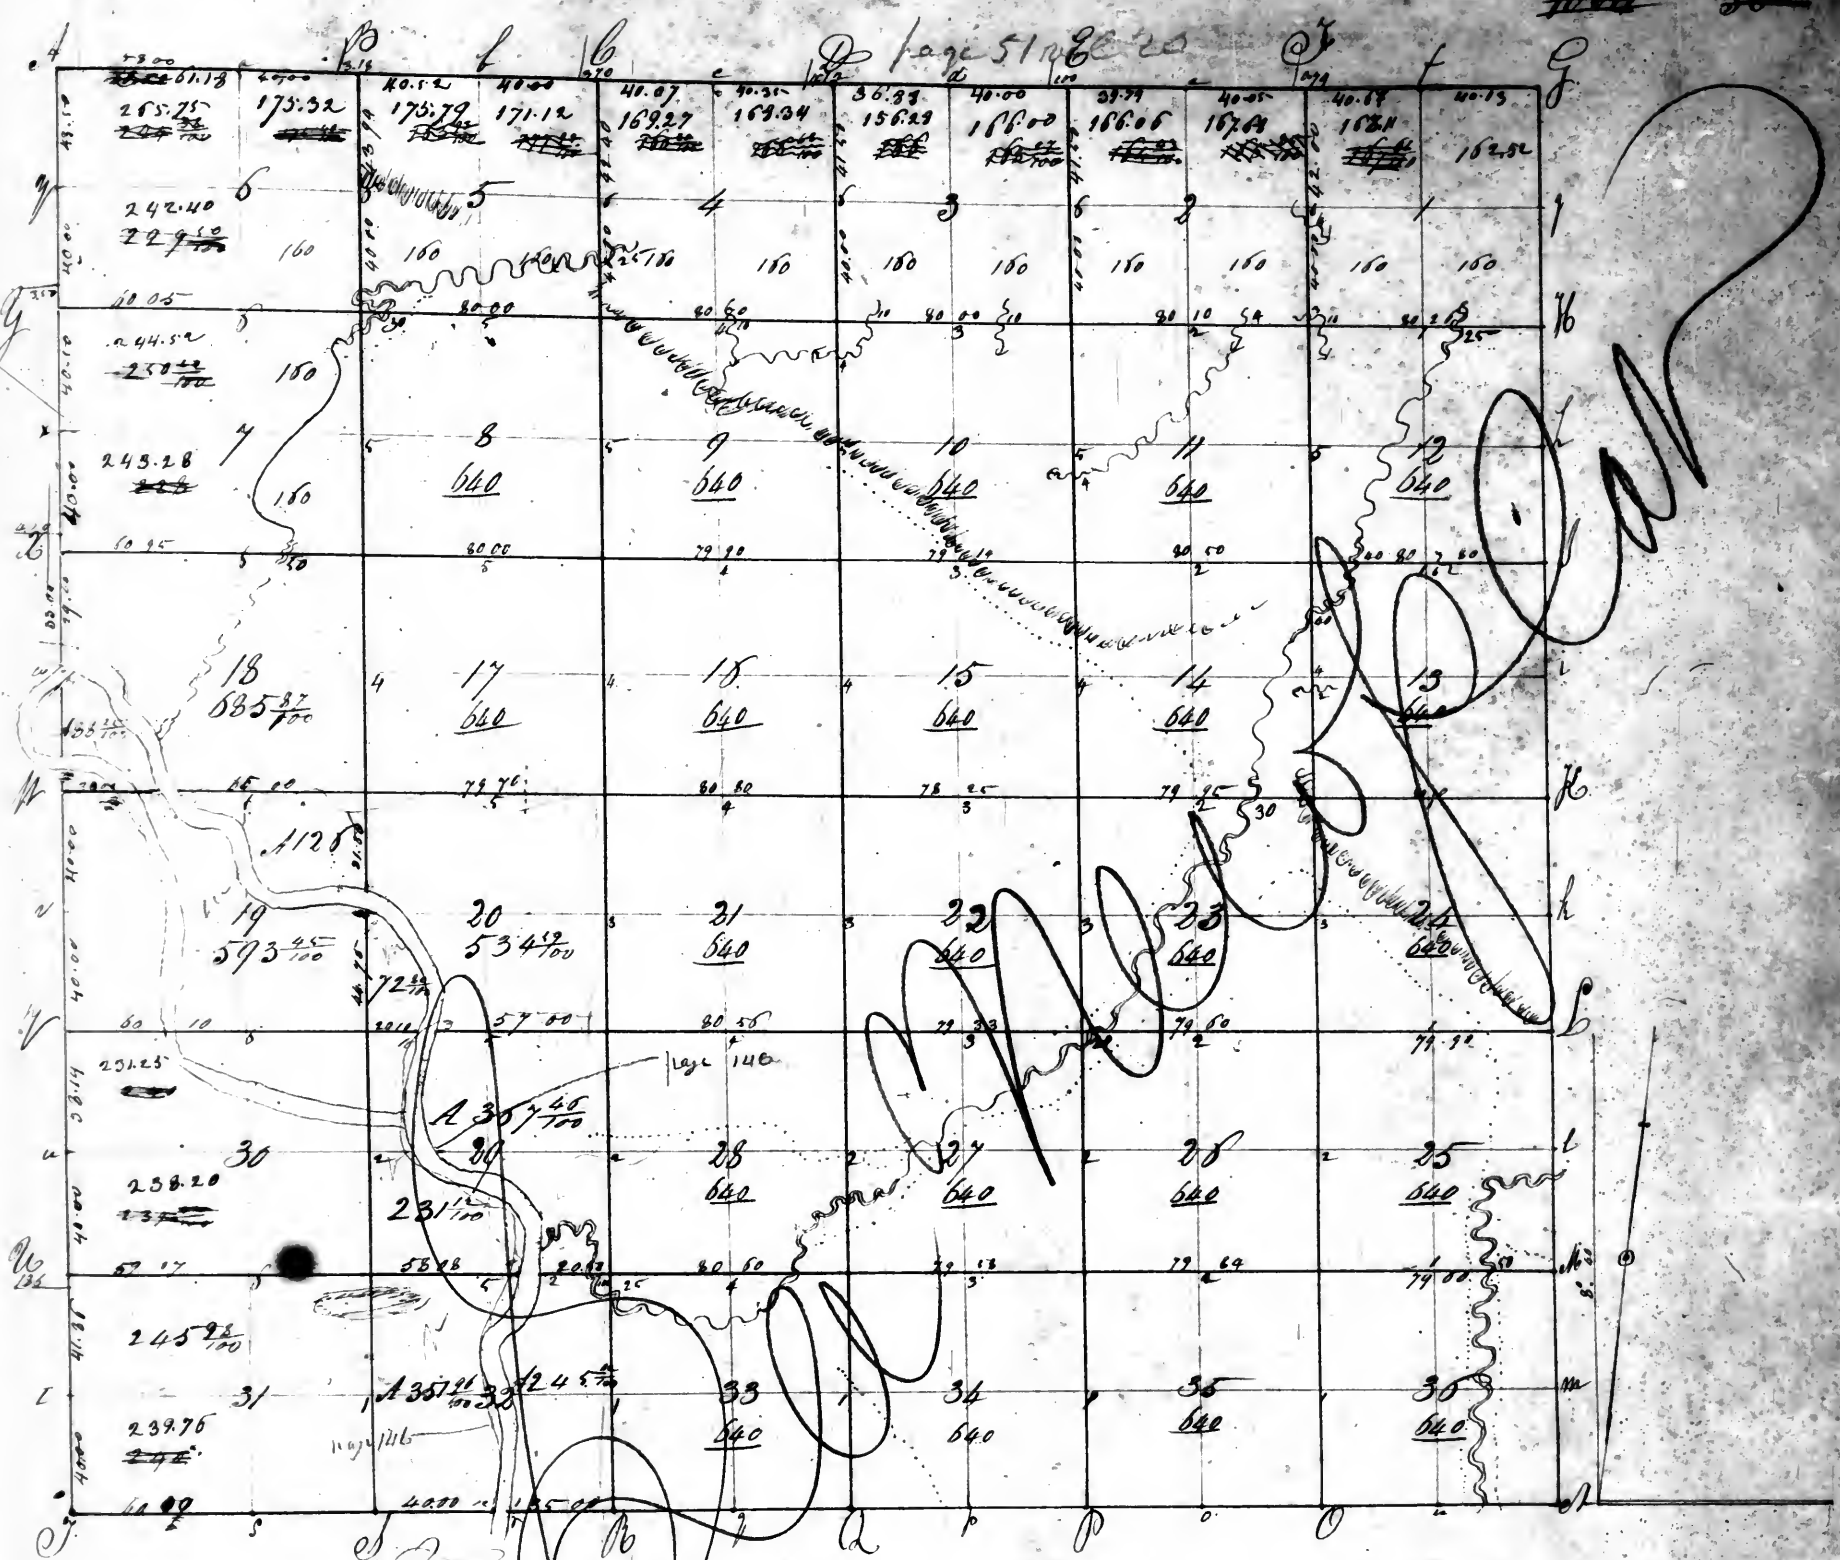

Township 4 South Range 7 West 4th Principal Meridian

Pursuant to a Contract with Edward Tiffin Surveyor General of the United States, bearing date 1st day March 1818, and Instructions from William Pector Surveyor of the lands of the United States in the Territories of Illinois & Missouri I have measured, laid out & surveyed the above described Township & do hereby Certify that it has such Marks & Boundaries both natural & artificial as are represented on said plat & described in the field notes made thereof & returned with this plat into the Office of the Surveyor of the Lands of the United States for the Territories of Illinois & Missouri

John McDonald SS

By right hand all
next day 19th 20

Witnessed the 10th day of June 1817

1817
John A. Donald D.S.


Sec 1

Sec 6

Sec 12

Sec 7

Mississippi River

Sec 18

follow page 52

Vol 20

Course of Section on Balance No 20 1/2

Tree	Size	Species	Value
1. 12. 6. 7 Willow	8	1/2 w 18	
do	8	1/2 w 12	
2. Cottonwood	8	1/2 w 12	
do	7	1/2 w 52	
3. Elm	6	1/2 w 10	
Maple	10	1/2 w 22	
do	12	1/2 w 28	
4. Elm	4	1/2 w 27	
5. Cottonwood	8	1/2 w 48	
do	10	1/2 w 110	
Shackby	10	1/2 w 17	
Elm	8	1/2 w 77	
Maple	8	1/2 w 91	
Willow	10	1/2 w 25	

Loc 21

Land on Island No 33
 third bed Timber Maple Elm Cottonwood 16
 Land on Island No 34
 Rich Soil 2nd bed Maple Elm Blackberry Mulberry 16
 Land on Island No 35
 Rich Soil 2nd bed Cottonwood Elm 16

Pursuant to a contract with and instructions from William B. Ewing
of the lands of the United States for the State of Missouri, Michigan and Territory of
Arkansas - bearing date the 20th day of December 1820 - I have
admeasured laid out and surveyed the above described Islands and do
hereby certify that they have lots, marks and bounds both natural and
artificial and do hereby certify that they are as represented on said
plot and described in the field notes made by me and returned
with this plat into the office of the Surveyor of the lands of the United
States for the State of Missouri, Michigan and Territory of Arkansas.

Birthd. N^o. Oct. 1821


Township 1 South of the base line, Range 8 West of the 1st principal meridian
 pages 53 vol 20





Township 1 South Range 8 West

I warrant to a contract with Edward Tiffin Surveyor General of the United States, bearing date the 10th day of March 1816, & Instructions from William Butler Surveyor of the Lands of the United States in the Territories of Illinois & Missouri, I have accompanied, laid out & surveyed the above described Township, & do hereby certify, that I have such marks & boundaries both natural & artificial, as are represented on said plat & described in the field notes in proof, & returned with this plat into the office of the Surveyor of the Lands of the United States for the Territories of Illinois & Missouri

John McDonald D.S.

Township N. 2 South Range N. 8 West of the 4th Principal Meridian
 page 54-1110

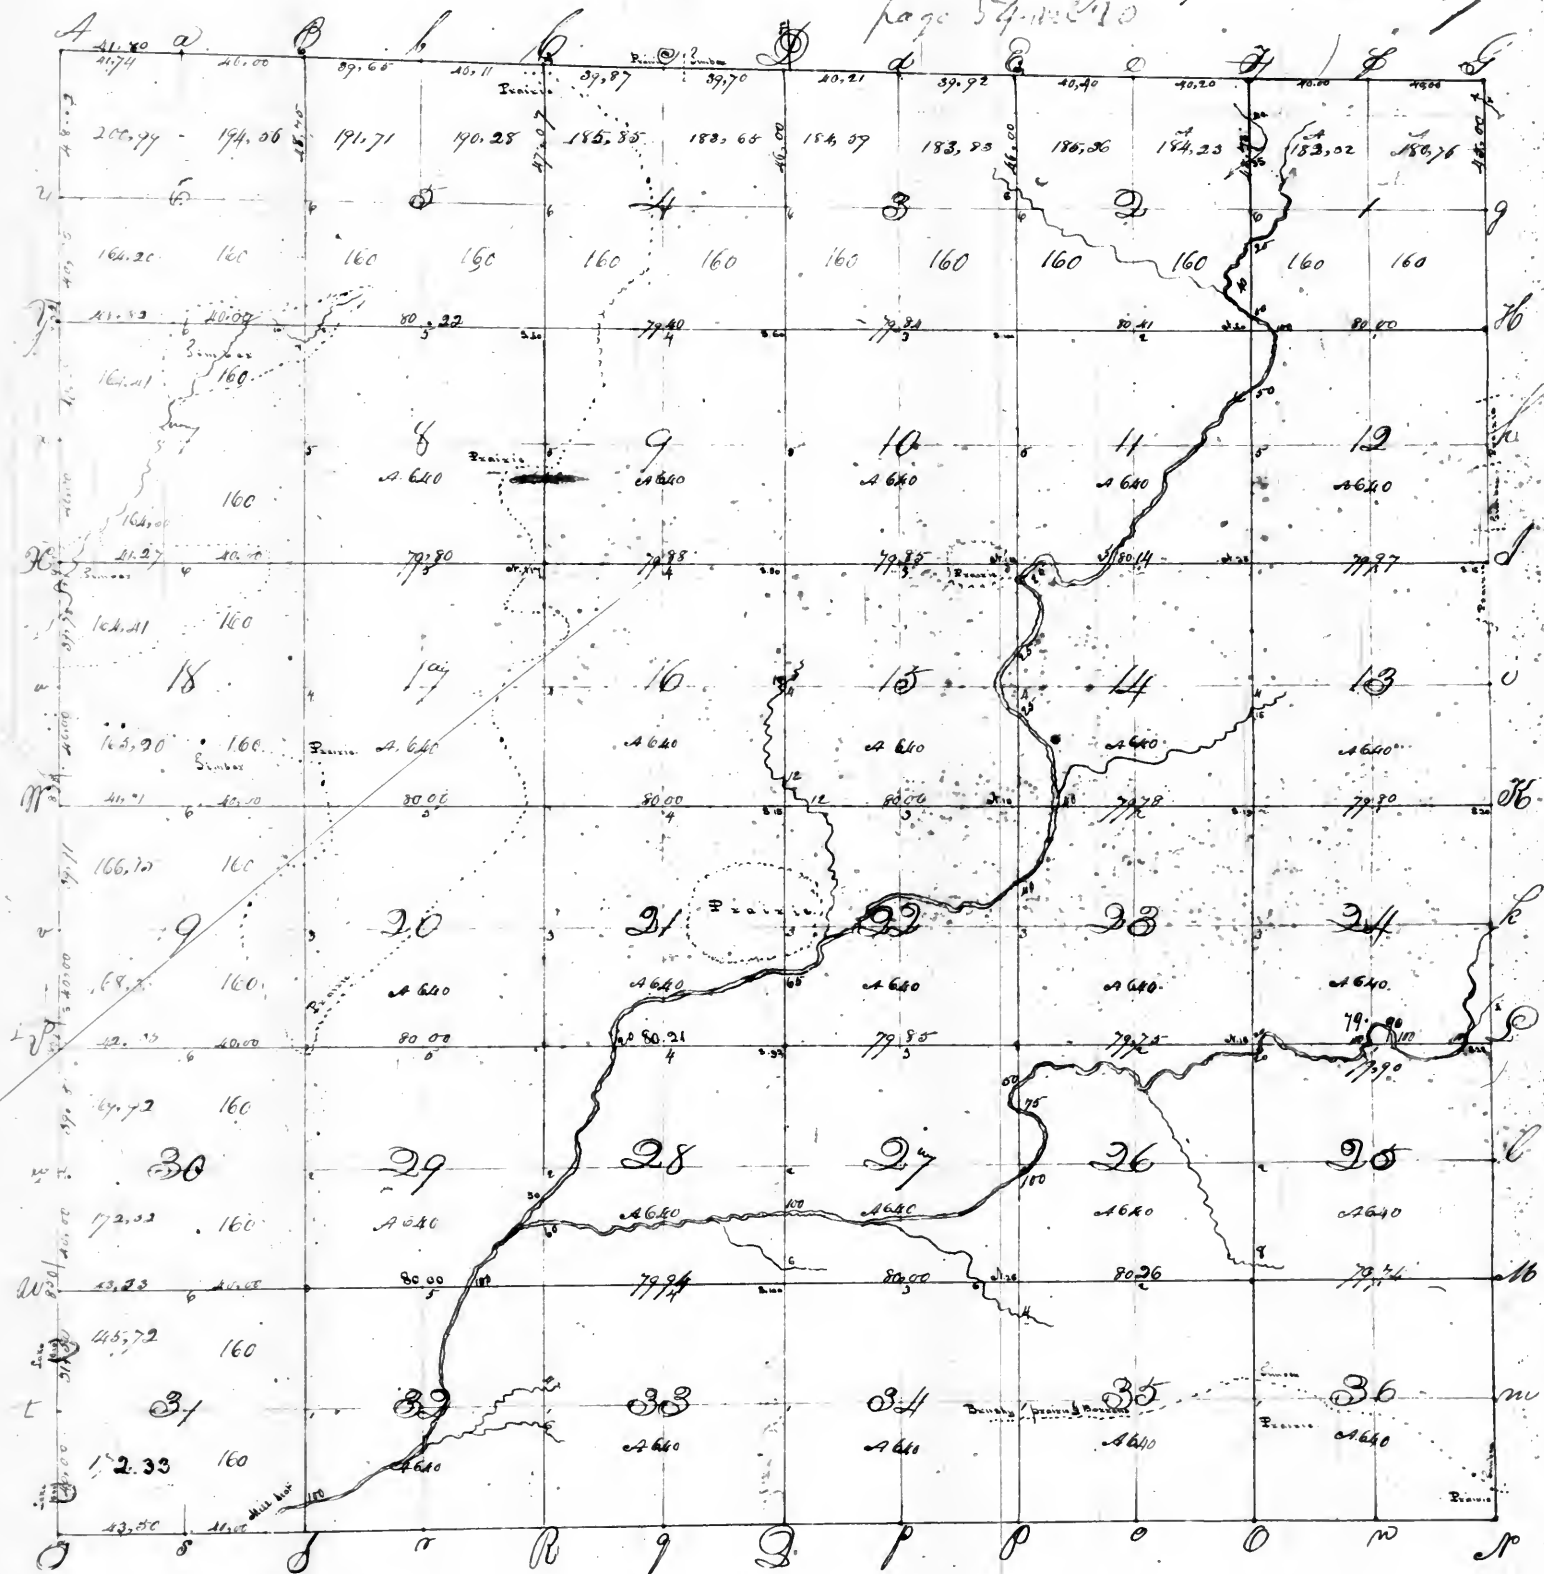

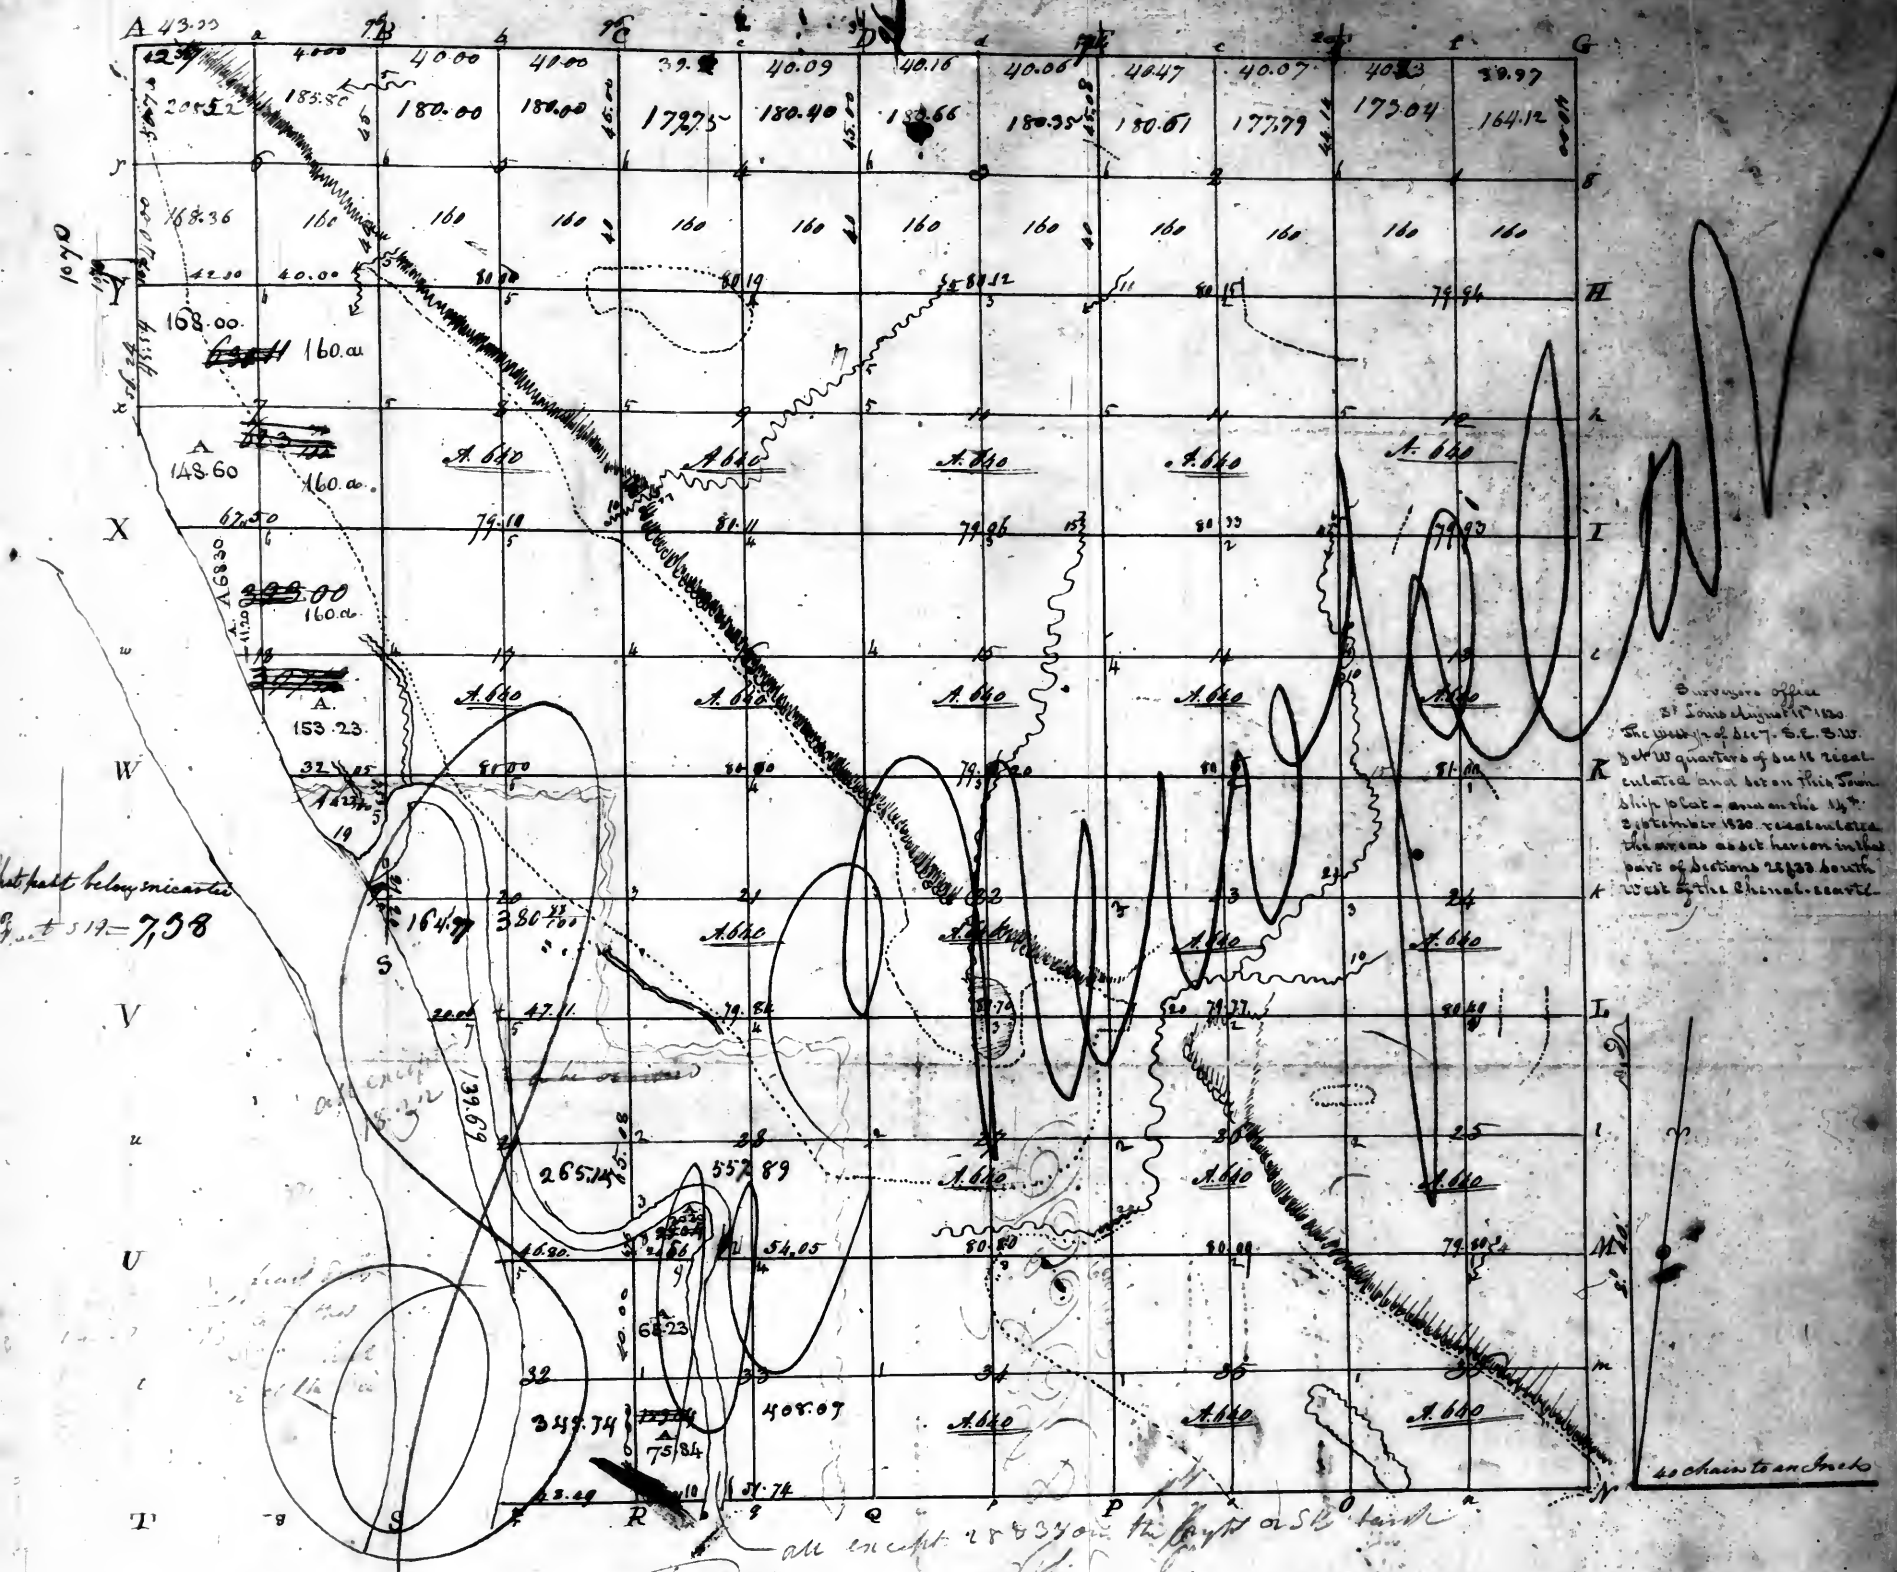


Township 3 South Range 8 West of the 4th Meridian



all except 28430 on right hand

John McDonald D.S.

Township North Range No 8 East of the 1st Principal Meridian

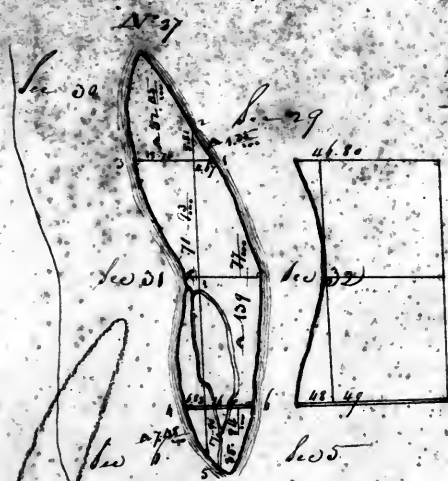

Section No 27

Section No 27

Section	Measure	Value
39 30 31 32	Mellor 8	11.5 6 27
	Maple 8	17.8 49
5 6 31 32	Mellor 7	11.5 6 44
	do 10	17.8 126
39 30 31 32	at 1. Hasky	11.5 6 30
	Maple 8	11.5 6 31
No 1	do	11.5 6 35

follow page 5
No 27


Land No 27
Low water level maple cottonwood and willow



certified 11 Oct. 1881

John D. Stewart Surveyor

followed by
Vol 20

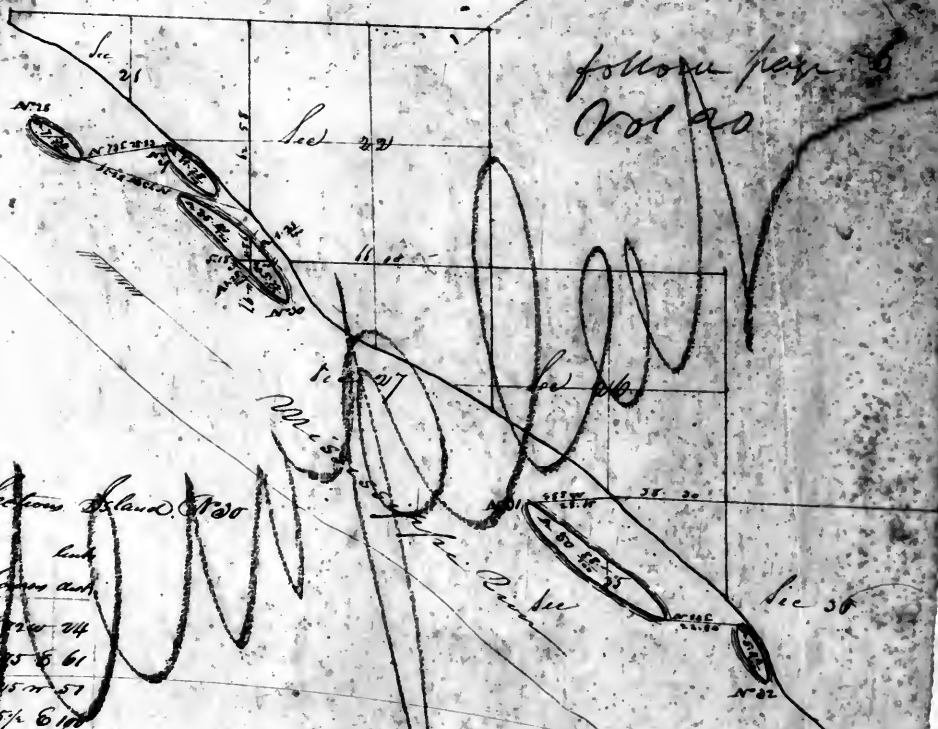


Apple 10. 25. 5. 61
 (K. 1 *Apple* 7. 25. 11. 57
 do 10. 25. 11. 61
 2 *Apple* 12. 26. 11. 6
 do 10. 25. 11. 57
Apple 6. 25. 11. 19
 do 6. 25. 11. 27
 4 *Willow* 7. 1. 11. 19
bottom 10. 25. 11. 24

Rich soil Timber cottonwood and mallow

rich soil. Pine, elm, Hackberry, Sycamore, Cottonwood &c.


Rich Soil Timber Maple Hackberry Elm Sycamore Cottonwood & willows

Nick has rather wet timber Elm & C. & other wood

rich with hard timber Elm & Cottonwood

Pursuant to a Contract with, and instructions from William Bevier Surveyor of the
lands of the United States for the States of Illinois, Missouri and Territory of Arkansas bearing date
the 20th day of December 1834. I have admirably laid out and surveyed the above
described tract of land, and do hereby certify that it has been made and found
both natural and artificial as represented on said plat and described in the file
made therefor, and (continued) with this plat into the Office of the Surveyor of the
lands of the United States for the States of Illinois, Missouri and Territory of Arkansas
Certified Nov 1834

John D. West, Secretary

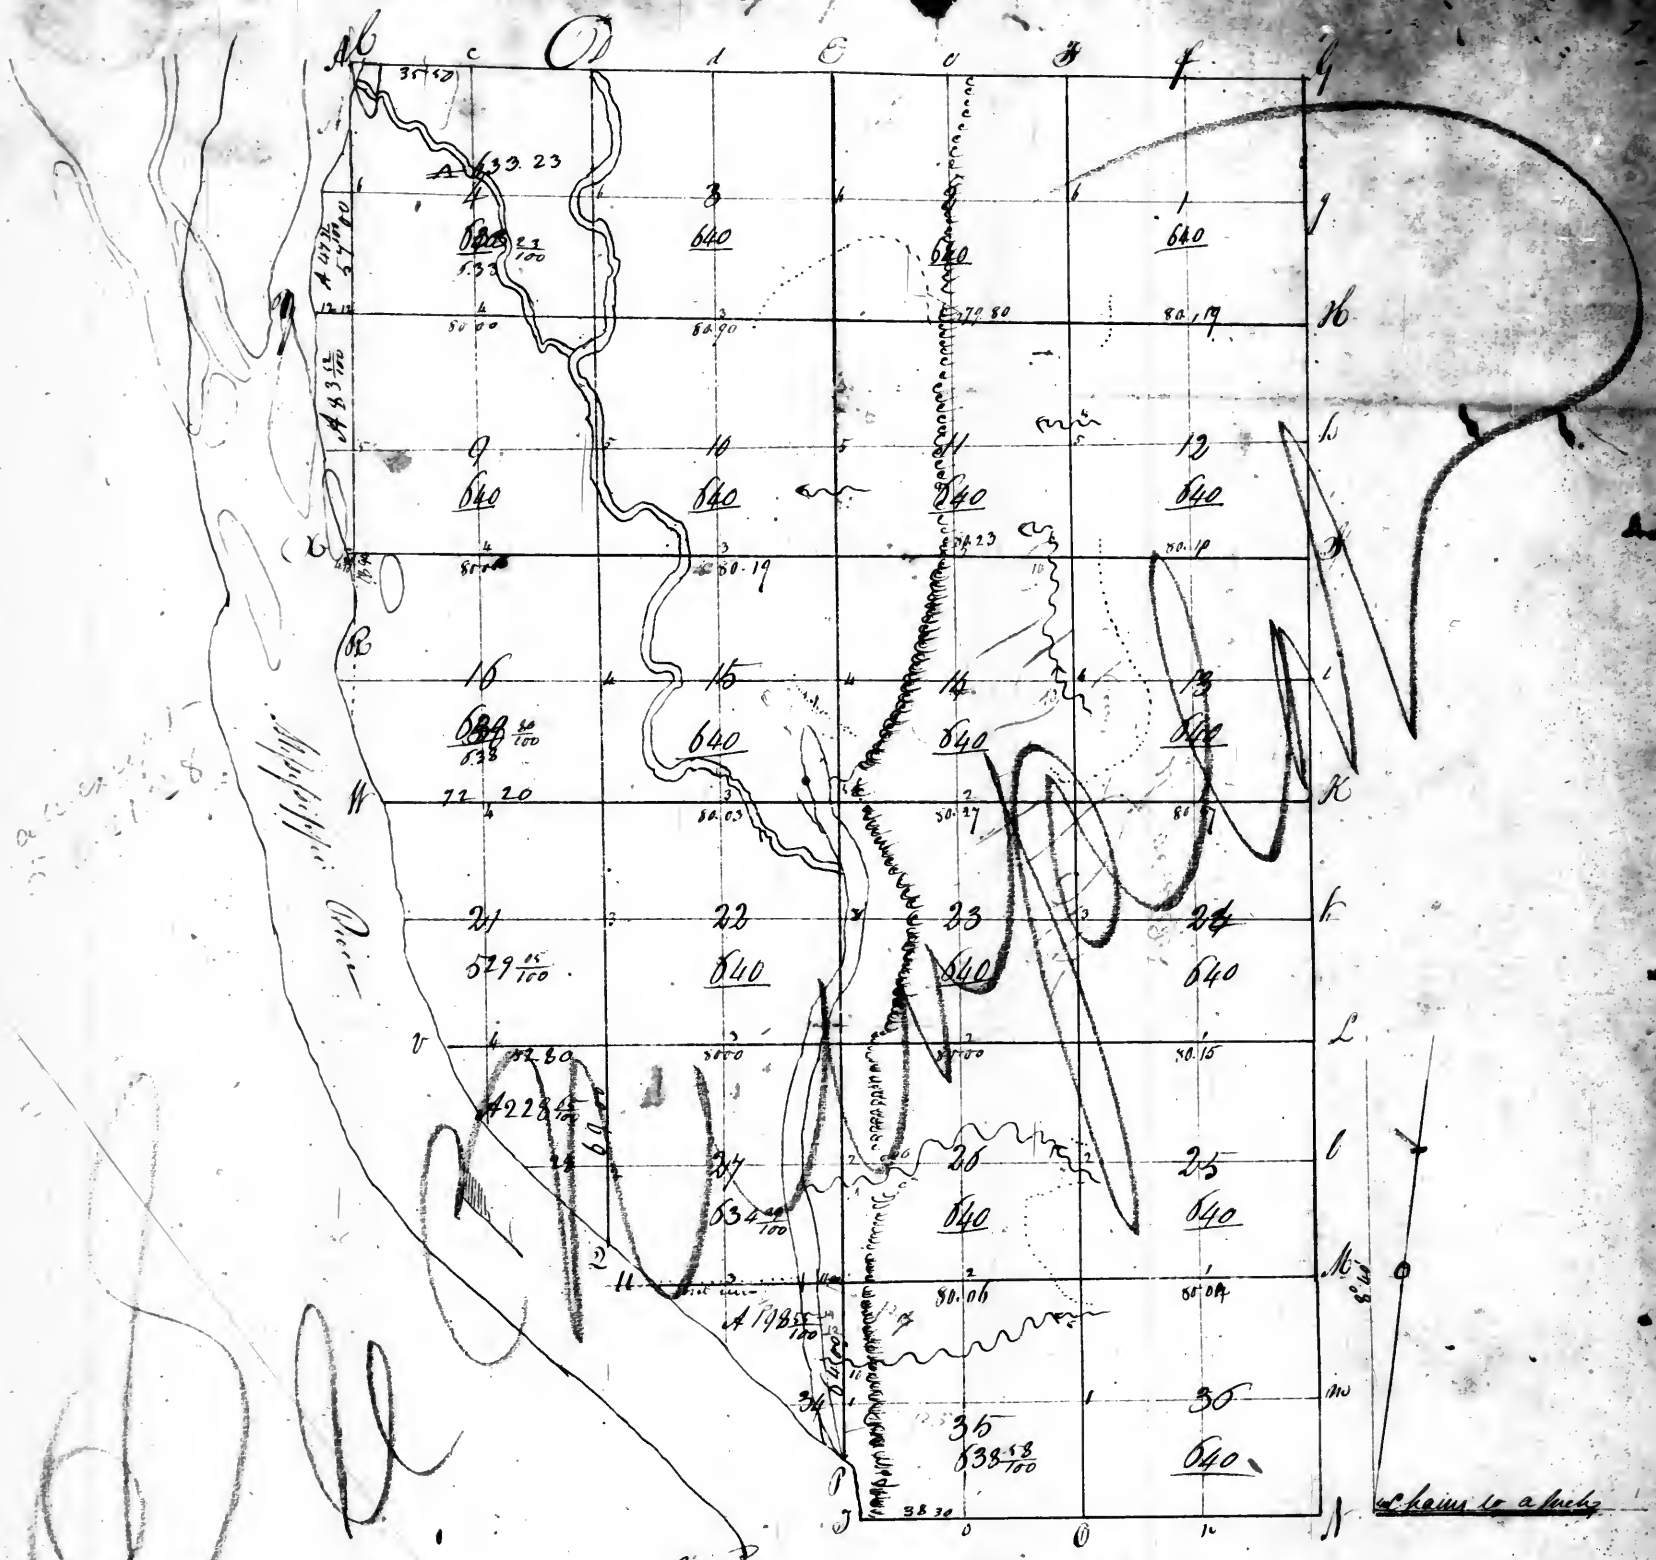

Township 1 South Range 1 West 1/2 mile


Pursuant to a contract with Colonel Jefferson Snodgrass General of the United States, bearing date the 11 day March 1816, and
instructions from William Peter Snodgrass of the lands of the United States in the Territories of Illinois & Missouri, I have
examined, laid out & surveyed the above described Township, and do hereby certify that it has been made & laid out both water
& artificial as are represented on said plat & described in the field notes made thereon & returned with this plat
to the Office of the Surveyor of the lands of the United States for the Territories of Illinois & Missouri.

John McDonald SS.

Township N. 14 South of the Base line Range N. 14 West of the 2nd Meridian

Section 51 - Vol 20

Corners for 1st Section

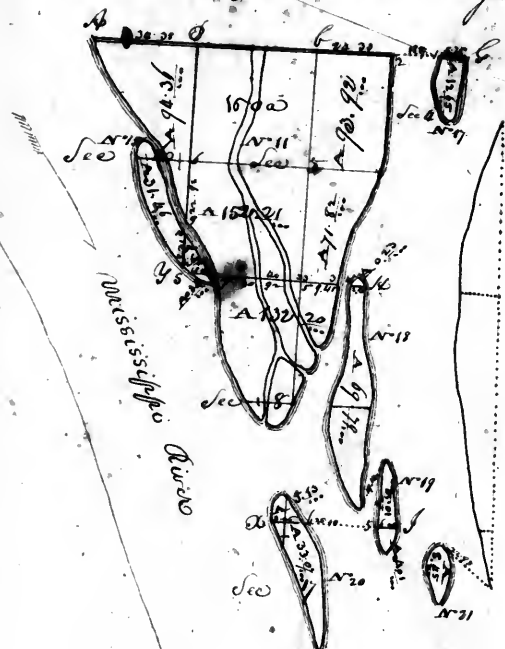

Post	Range	Sec.	Course	Length
A	Maple	12	N 66 E 58	
B	Elm	10	S 55 E 45	
C	Hickory	12	S 22 W 26	
D	Brown	30	S 40 E 17	
E	Rubus	7	S 39 W 28	
F	Cottonwood	7	S 48 W 15	
G	do	6	S 10 W 17	
H	Maple	8	Course	
I	Cottonwood	8	S 76 W 22	
J	do	7	S 58 W 24	
K	Black Elm	8	S 50 E 20	
L	do	11	S 77 W 29	
M	Cottonwood	7	S 79 W 52	
N	do	6	S 77 E 40	
O	do	5	S 55 E 27	
P	do	6	S 73 W 14	
Q	Maple	10	S 48 W 5	
R	Black Elm	40	S 4 E 09	
S	Hickory	8	S 76 E 11	
T	Elm	12	S 43 W 35	
U	Maple	8	S 19 E 23	
V	do	6	S 41 E 40	
W	Cottonwood	7	S 86 E 90	
X	do	6	S 67 E 72	
Y	Hickory	9	S 41 W 71	
Z	Cottonwood	9	S 15 W 70	
1	do	20	S 44 E 49	
2	Maple	8	N 2 E 35	
3	Cottonwood	8	S 89 W 70	
4	Willow	7	S 61 E 03	
5	Cottonwood	6	S 57 W 69	

Quarter Section Corners



From	Bearing	to	Course	Length
To	Tree	70		
N. 1/2 S. 1/2 E.	Maple	6	S 10 E	9
do	do	8	S 7 W	25
S. 1/2 S. 1/2 W.	Maple	10	S 67 W	55
do	do	10	S 49 E	39

Land on Island N. 11 has been surveyed (rich and timber)
 Elm Hickory Mulberry Hickory & Cottonwood —
 Land on Island N. 15 has been surveyed and timbered cottonwood
 Land on Island N. 17 same as N. 15
 Land on Island N. 18 same as N. 17
 Land on Island N. 19 same as N. 18
 Land on Island N. 20 same as N. 19
 Land on Island N. 21 same as N. 20

Pursuant to a contract made and instructions from William A. Rector Surveyor of the lands of the United States for the State of Illinois, Missouri, and Territory of Arkansas, bearing date the 20th day of Dec. 1820. I have had measured and laid out and surveyed the above described fractional part of Township N. 14 South of the Base line Range N. 14 West of the 2nd Meridian and as hereby being that is had, such marks and bounds both natural and artificial as are represented on said plat and described in the field notes made through and returned with this plat into the office of the Surveyor of the lands of the United States for the State of Illinois, Missouri and Territory of Arkansas.

Witness my hand and seal this 15th day of Oct. 1821


John D. Rector Surveyor

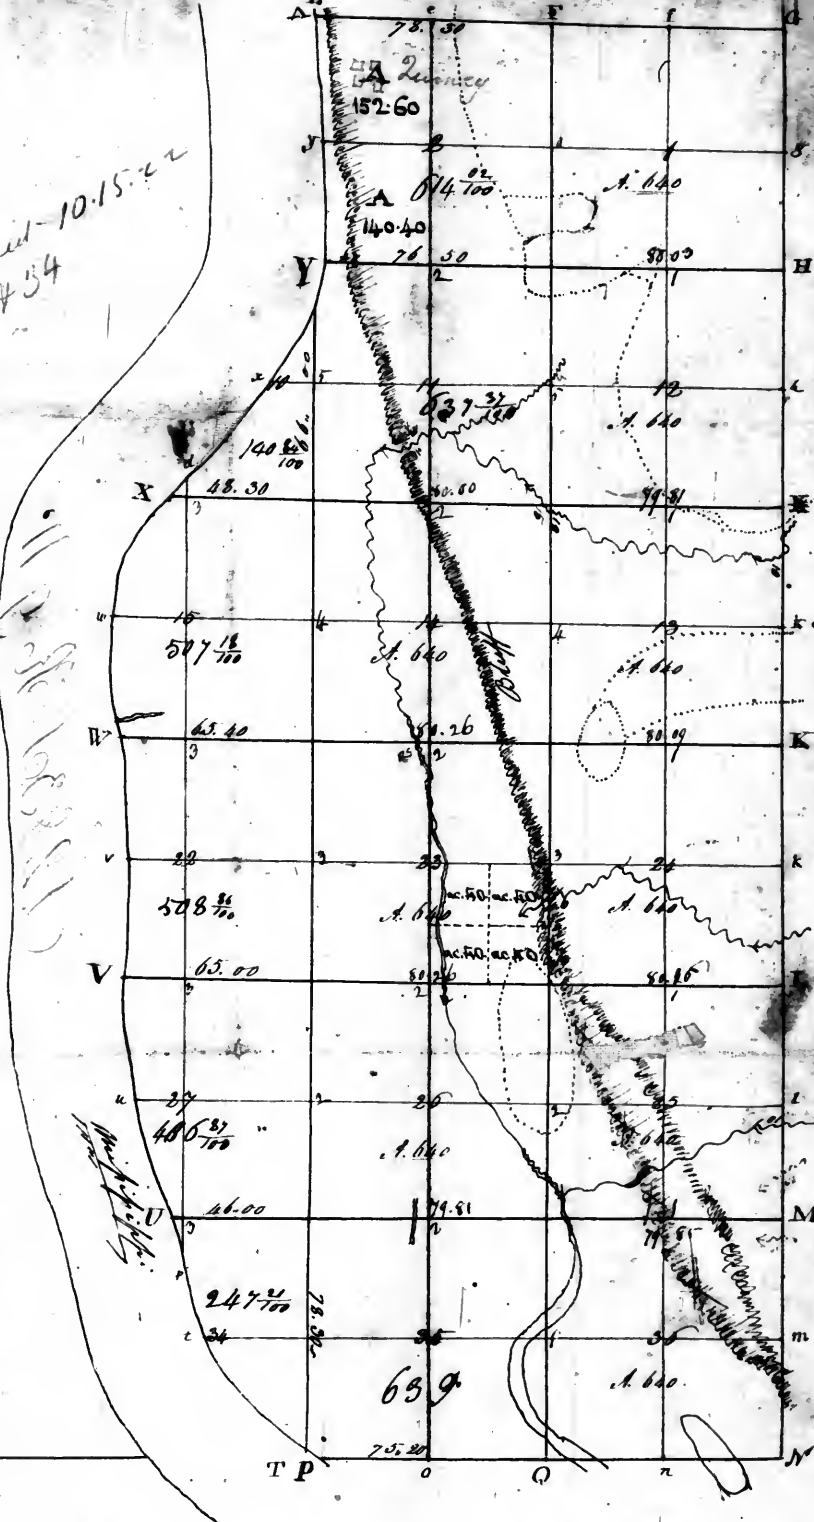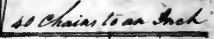

Pursuant to a Contract with Edward Tiffin Surveyor General of the United States bearing date the 1st day of March 1816, and
 testimony from William Wells, Survivor of the Lands of the United States in the Territories of Illinois & Missouri, I have care-
 fully examined, laid out & surveyed the above described ^{fractional} townships, and do hereby certify that they had such marks & bound-
 aries as are represented on said plat & depicted in the field notes made thereof & returned with them
 into the Office of the Surveyor of the Lands of the United States for the Territories of Illinois & Missouri.

300. 41-

Township N. 23 South of the Arkansas Range N. 9 West of the 1st Meridian
 folio 1 30 58
 Vol. 20

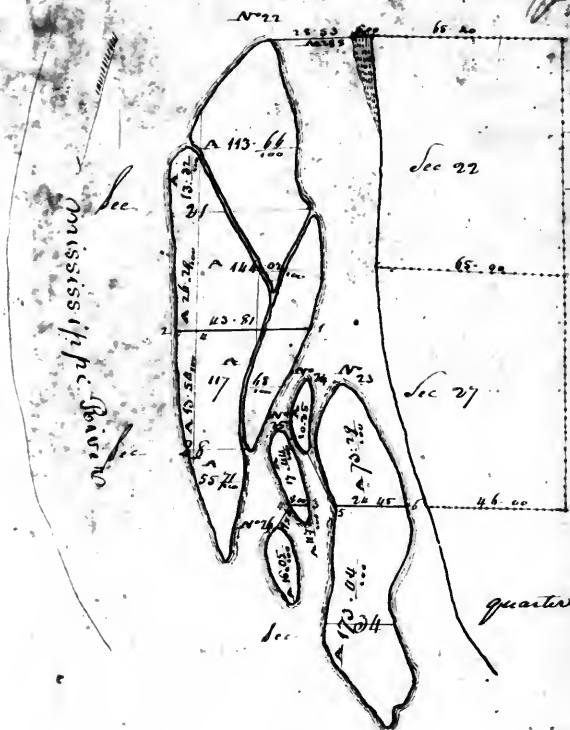

Corners of the Sections

Section	Tree	7th Corner	8th Corner
N. 1 Cottonwood	7	170 W	20
do	6	177 E	29
2 Hickory	8	125 E	20
3 Elm	8	170 E	9
4 Cottonwood	8	160 W	25
Maple	7	150 W	21
4 Maple	14	155 E	38
do	6	161 E	28
5 Maple	6	150 W	9
do	6	168 E	29
6 Cottonwood	7	180 W	38
do	8	180 W	33
Quarter Section N. 4 Hickory	6	174 E	28
Elm	6	176 E	32

Land on Island N. 23

East of the River this sandy soil Timber Cottonwood &c
 West of the River first water Timber Hickory Hickory Elm Elm &c

Land on Island N. 23

Low wet soil Timber Elm maple and Cottonwood

Land on Island N. 24

This soil Cottonwood & willow

Land on Island N. 25


Low wet soil Timber Elm maple Cottonwood &c

Land on Island N. 26

Low wet soil Timber Elm maple Cottonwood & willow

VOL 25

1956

 

Non.





Note. A plot of sections 1, 2, 3, 16, 17, 20
24, 25, 26, sent to the Commissioner of the
Genl Land Office in Wash^g Jan'y 11, 1854, with
a copy thereof to the Register on same day.

Duration in St. Andrews

Surveyors office.
Saint Louis 20th of January 1844.

on this basis, in 1880
which was paid for in the
500 miles of engineering
basis, the plot

This place
January 1

Township 12 South of the base line, Range 1 West of the 4th principal meridian










Silas Reed
Surveyor of the public land in
the State of Illinois

Plat of Fractional Townships in Township 12 S. Range 11 W. of the 6th principal Meridian


See for Mr. Spaulding's work on the N. 1/4 of Sec. 36 of this township, the plat of T. 12 S. R. 11 W.

Statement referred to in the certificate to this plat of 28 January 1844

Designation of line	in miles
Lines between 10th & 11th	1.00.00
1. 10	23.70
2. 3	21.70
3. 9	79.87
4. 5	66.00
4. 5	46.37
5. 8	79.24
6. 2	39.62
5. 6	78.63
Boundaries along Sec. 34 S. 210	2.59.19
	9.19.22

Variation in Mr. Spaulding's surveying: 7° 30' East.

Surveyor's Office
St. Louis 11 Sept. 1842.
Plat of 1/4 Sec. 36 in Township 12 S. of the base line R. 11 W. of the 6th principal Meridian, 1/4 Sec. 11, 12 & 13 on Main shore and of Islands No. 57 & 58, all in T. 12 S. of the base line R. 11 W. of the 6th principal Meridian, and of 1/4 Sec. 5 in T. 12 S. of the base line R. 11 W. of the 6th principal Meridian, sent this day to the Commissioner of the General Land Office.

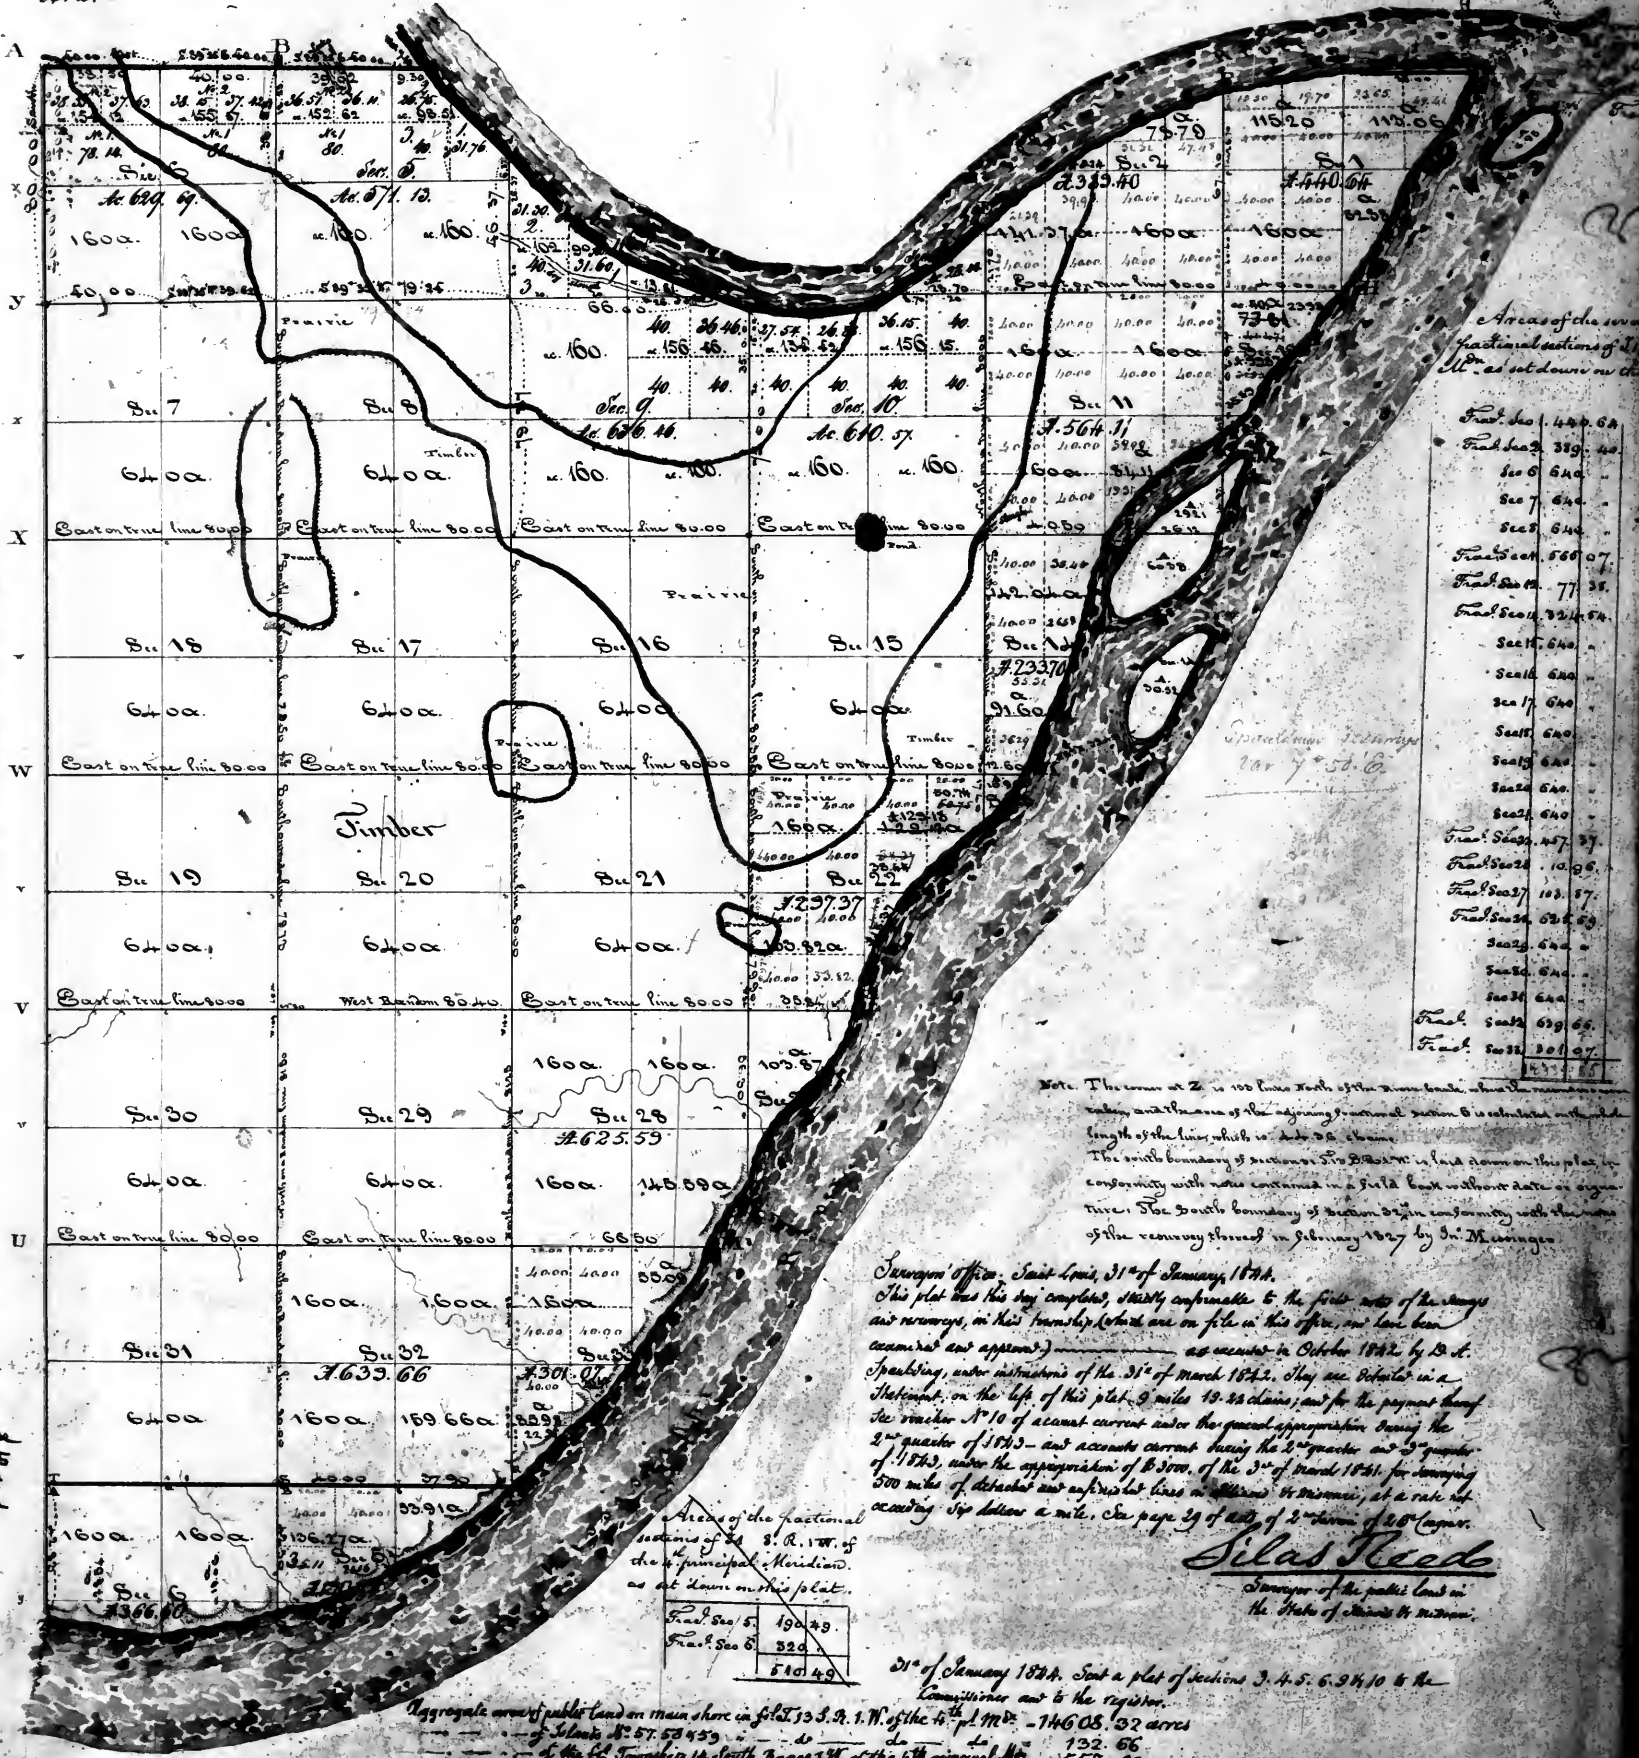

Areas of the several fractional sections of T. 12 S. as set down on this plat.

Fract. Sec. 1	144.64
Fract. Sec. 2	289.28
Sec. 3	640.00
Sec. 4	640.00
Fract. Sec. 5	560.07
Fract. Sec. 6	77.38
Fract. Sec. 7	92.64
Sec. 8	640.00
Sec. 9	640.00
Note. The corner at Z is 100 lines South of the same base line as the corner at Y, and the line between Y and Z is calculated on the length of the line which is 100 lines. The small boundary of section 27 is laid down on this plat in conformity with notes contained in a field book without date or signature. The South boundary of section 27 is in conformity with the notes of the survey closed in February 1827 by Dr. McManis.

Surveyor's Office, Saint Louis, 31st of January, 1844.
This plat was this day completed, strictly conformable to the first notes of the survey and surveys, in this township, (which are on file in this office, and have been examined and approved) as executed in October 1842, by Dr. Spaulding, under instructions of the 31st of March 1842. They are detailed in a statement, on the left of this plat, 3 miles 19.33 chains; and for the payment thereof see voucher No. 10 of account current under the general appropriation during the 2nd quarter of 1843 - and accounts current during the 2nd quarter and 3rd quarter of 1843, under the appropriation of \$3,000, of the 3rd of March 1841, for surveying 500 miles of detached and unimproved lands in Illinois & Missouri, at a rate not exceeding 10¢ per acre. See page 29 of Act of 2nd session of 26 Congress.

Silas Reed
Surveyor of the public land in the State of Missouri.


Fract. Sec. 5	194.49
Fract. Sec. 6	520.11
	714.60

Aggregate amount of public land on main shore in plat 13 S. 2. 1. N. of the 6th principal Meridian - 7146.08.92 acres
of Islands No. 57, 58 & 59 - 132.66
of the 1/4 Sec. 5 in Township 12 S. Range 11 W. of the 6th principal Meridian - 557.09
Total - 7835.74 acres

Surveyor's Office
St. Louis 18 Sept. 1843
The above plat of fractional Twp. 13 S. (except 1/4 Sec. 3, 4, 5, 9 & 10, & 1/4 Sec. 11, 12, 13, 14, 15, 16, 17, 18, 19, 20, 21, 22, 23, 24, 25, 26, 27, 28, 29, 30, 31, 32) of Range 1 West, also off Sec. 36 Twp. 12 S. R. 11 West, of the 4th Meridian, is confirmed to the files of surveying being on file in this office - Wm. H. Bee
St. of Pub. Land

except fractional Sections 2 & 3. Sh 10 of fractional Township N. 20. which are omitted on account of error in the Survey, shown in New Survey, showing

1112

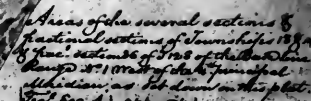

(Note) The corner at T₁ is 100 feet South of the Riverbank, where the meanders
were taken, and the area of the adjoining tract of Section 10 is calculated
with whole length of the line, which is 2.100 chains.
The South boundary of Section 10, T₁ S. 22. W. is laid down on this plat
in conformity with notes contained in a field book with notes or signatures
The North boundary of Section 10 is in conformity with the notes of the
survey thereof, in February 1827, by the Messengers.


St. Louis, 25th of August 1836. East half of fractional
Section 22 Township 13 South, has been subdivided and laid
down on this Plat, and a copy thereof has been sent to the Register.

Bureau of the Office
 St. Louis, 1st Feb 1895.
 Cash for half of rec. of 1st Feb 1895. Paid down
 on this date, and a copy thereof sent to the Register, & all
 other to the Comptroller of the Cash & Office.

Surveyors Office
St. Louis 18th September 1830
The above plat, of fractional Trp 13 S. R. 1 W. (containing
sec 3 4, 5, 9, and 10, and with half of sec 6), — Tract Trp
14. S. R. 1, and also of pt. sec 36 in Trp 12 S. Range 1. West
of the 4th P. Mer. is conformable to field notes of same
then on file in this Office. —

Office. —
Wm. C. Rice
St. of Pub. Lands

Township 1 South of the base line. Range 2 West of the 1st principal meridian.

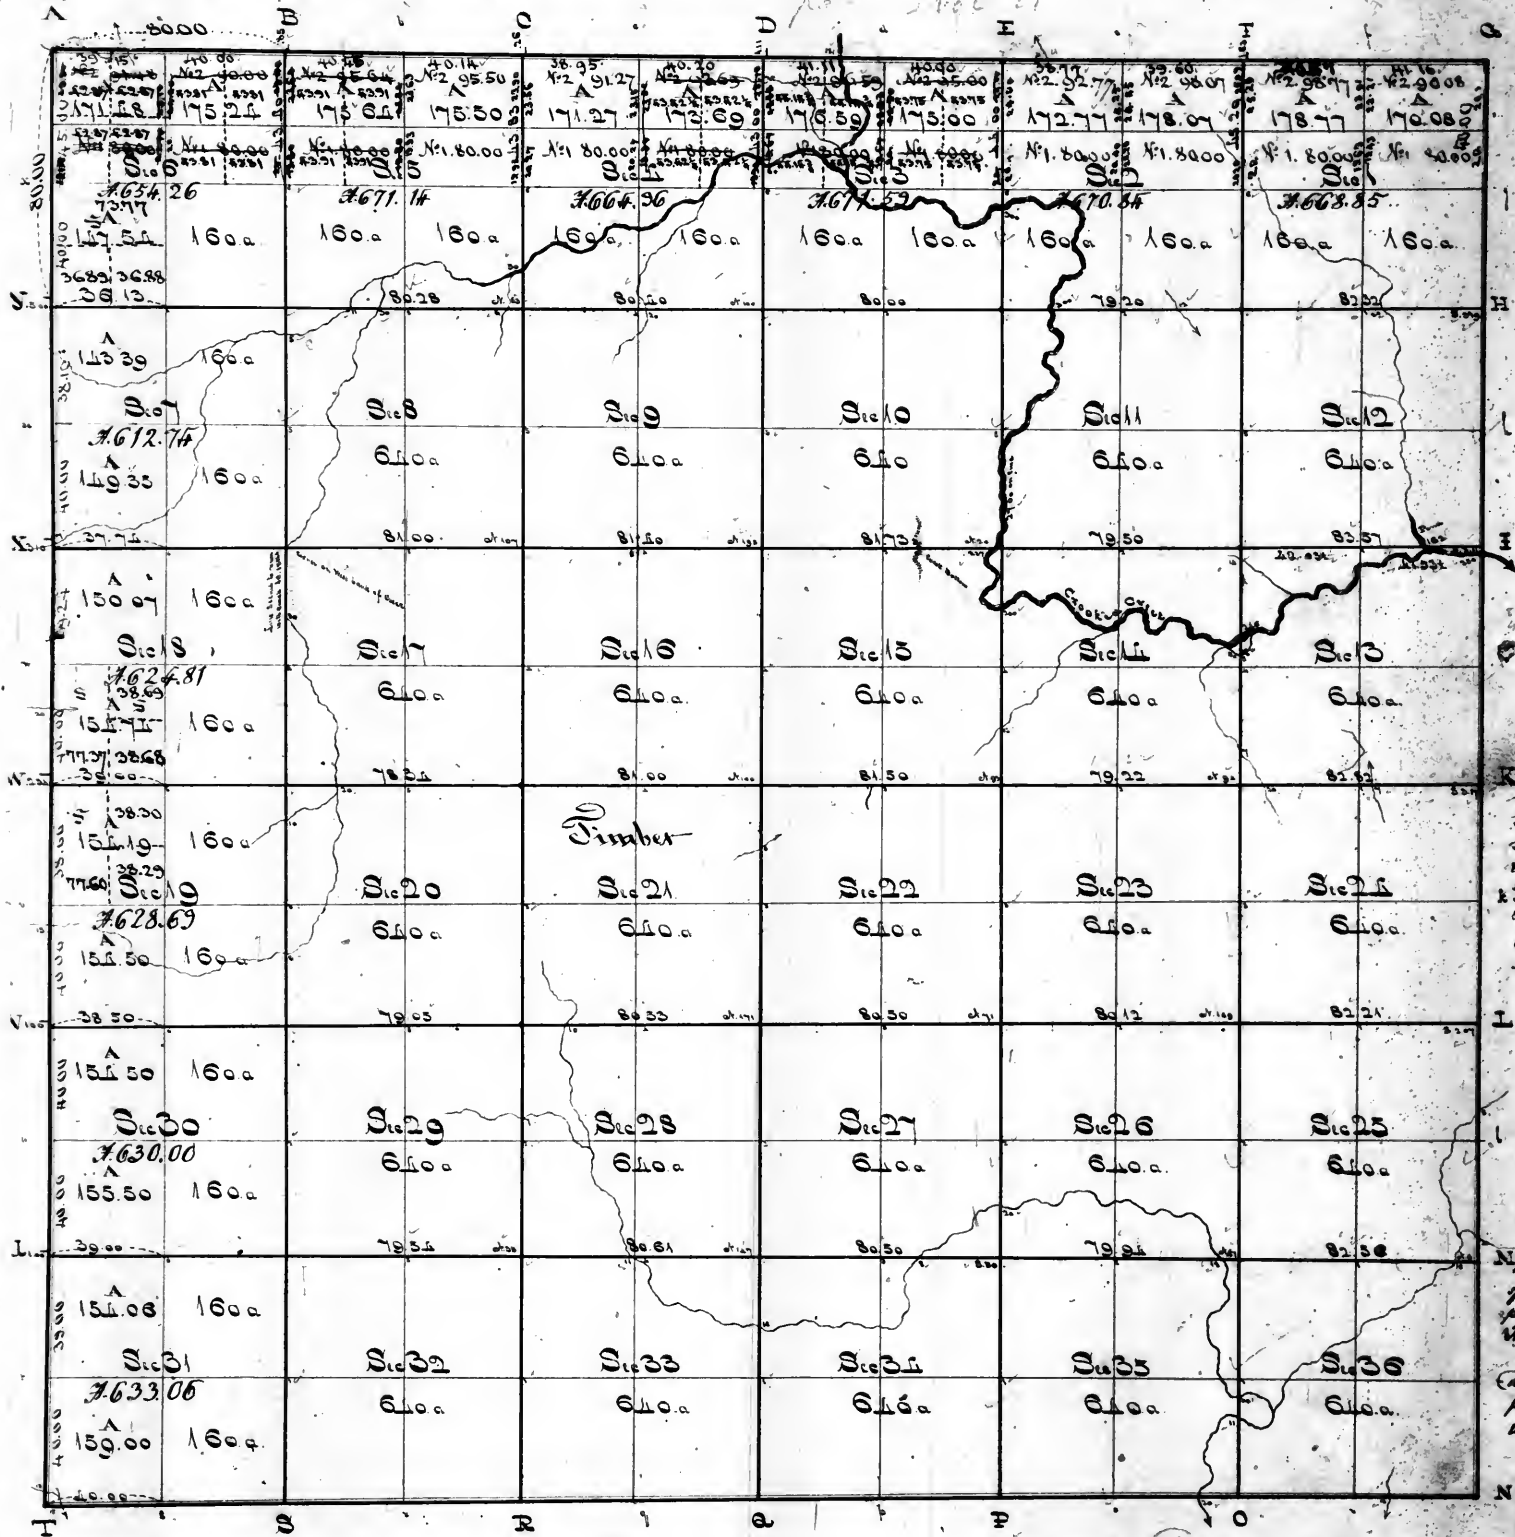

Surveyor's Office
St. Louis 15 January 1847.
Subdivided the S.W. q. of Sec. 1 & the N.W. q. of Sec. 15, so as to conform to previous sales (made) & sent a copy to the Register & another copy to the Commr. of the Genl. Land Office.

Surveyor's Office
St. Louis 10 Sept. 1847.
Plat of the North half of Sec. 1 & 2, 3, 4, 5 & 6 sent today to the Commr. of the Genl. Land Office.

St. Louis 21st March 1848
Subdivided under the Act of Congress of the 4th April 1832 so as to conform to previous sales as reported by the Register on the 15th Aug. 1843: the N.W. q. of sec. 8 (and sent to-day, copies of the plat, one to the Reg^r & another to the Genl. Land Office.
Also submitted also the North 1/2 of Sec. 2 the N.E. q. of Sec. 4 & 6, and the S.E. q. of Sec. 5, as to conform to previous sales & sent copies one to the Reg^r & another to the Commr. of the Genl. Land Office.

Note. The field notes of the survey of the East, South, and West boundaries of T. 1 S. R. 2 W. are without any signature but are apparently by John or James M. Donald.

Surveyor's Office
St. Louis 18th September 1850


The above plat is conformable to the field notes of the survey on file in the Office of Insp. L. & R. 2 W. of (the Beland) of the 4th P. M. Meridian.

Wm. H. Hall
Surf. Pub. Lands.

Aggregate area of public land - 23130.95 acres

Plat of Fractional Township 2 South of the Base Line Range 2 West of the 2nd Principal Meridian.

except fractional Sections 18, 24, 25 & 36 which are omitted on account of errors in the Survey thereof.

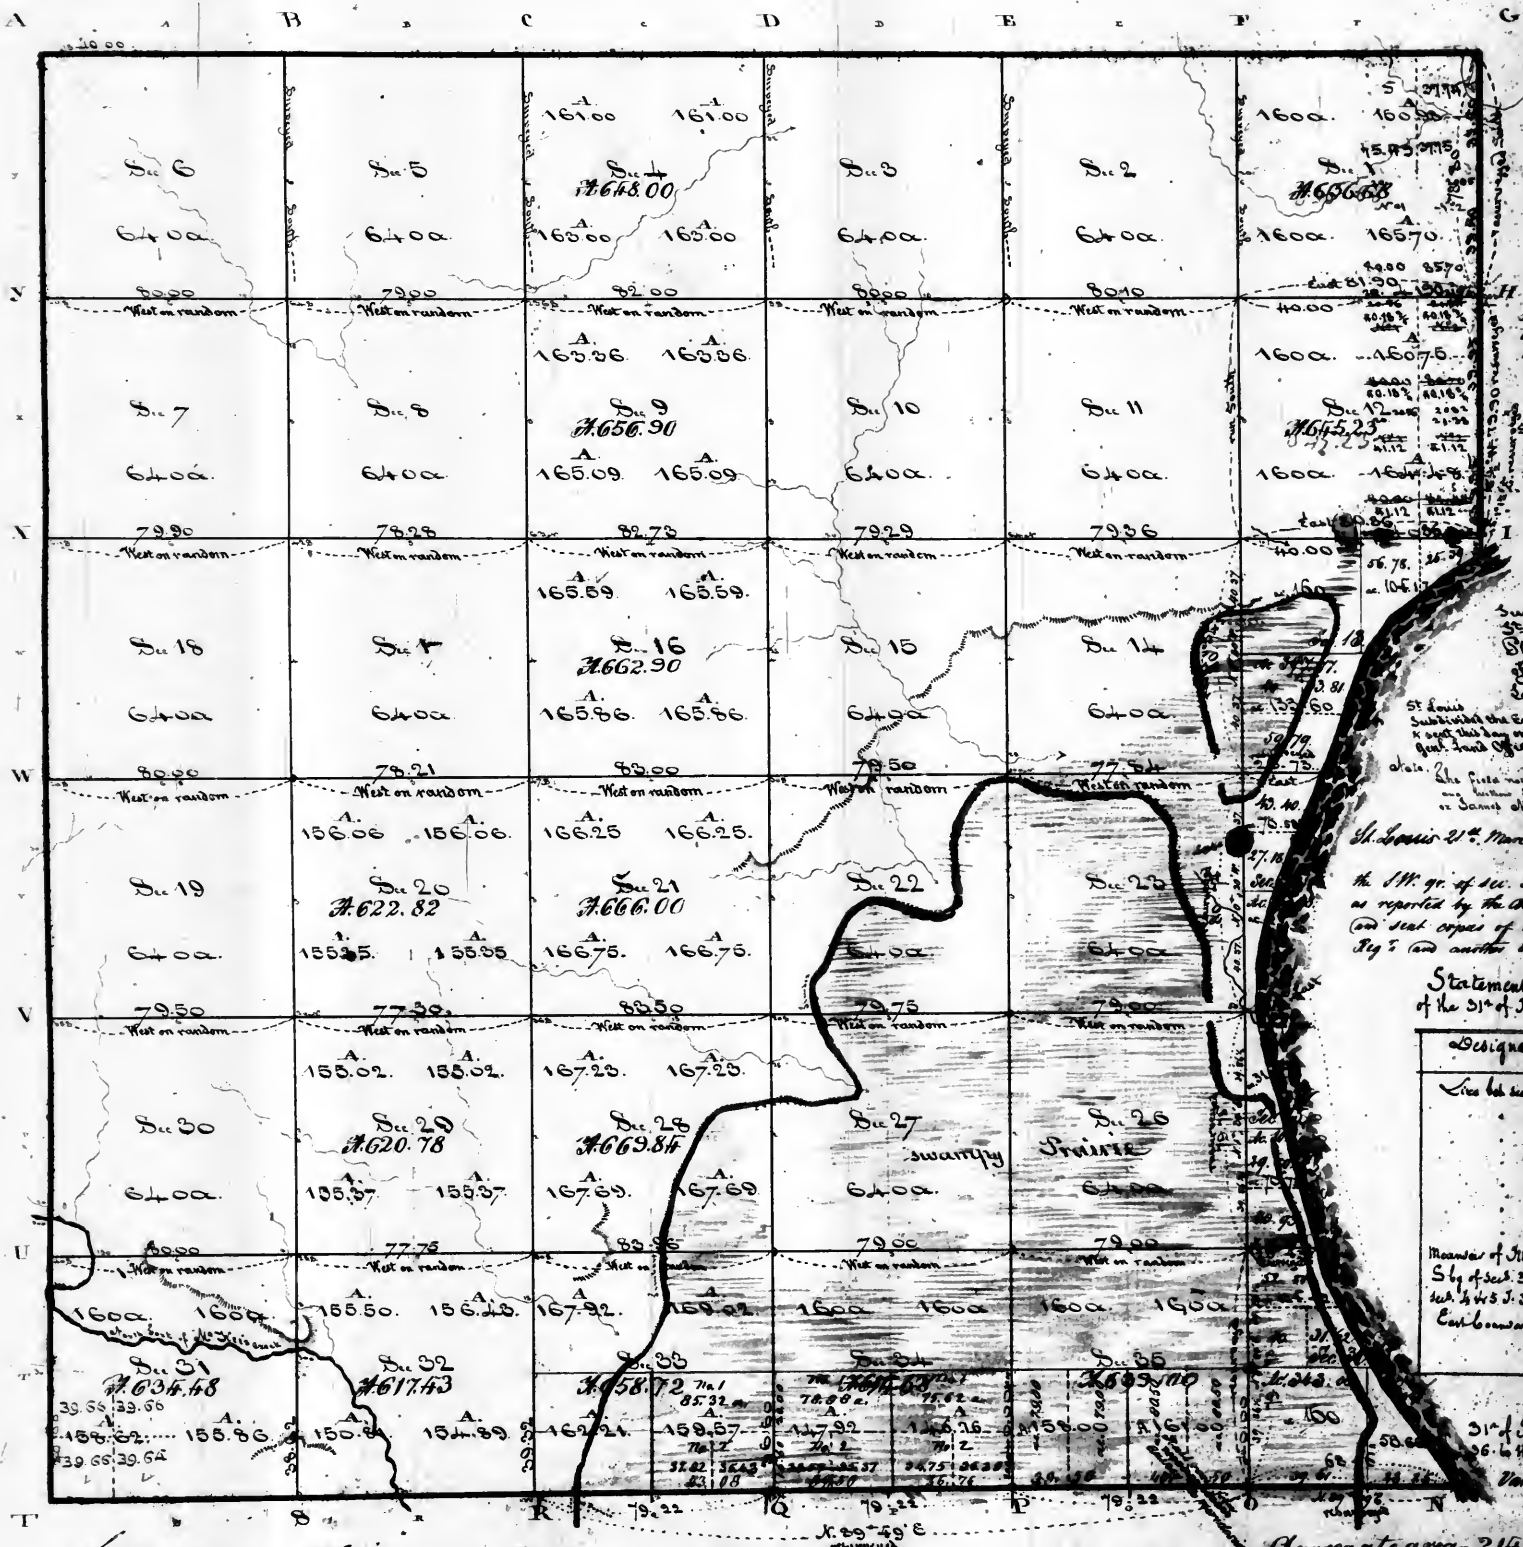

St. Louis 18 Sept 1844
Subdivided Sec. 35, 36 as to previous sales, also under the law of 1832 the S.E. 33 and S.E. 34 and to the Register of Deeds & the Commissioner of the Surveyor's Office.
St. Louis 16 January 1847.
Subdivided the N.E. 1/4 of Sec. 1, 2, 3, 36 conform to a previous sale (marked) sent a copy to the Register & another to the Comm'r of the Gen'l Land Office.

Surveyor's Office
St. Louis 10 Sept 1842.
Plat of the S.E. 1/4 of Sec. 1 and of the S.E. 1/4 of Sec. 12, as to conform to a previous sale (marked) sent a copy to the Register & another to the Comm'r of the Gen'l Land Office.
St. Louis 21 March 1844.
Subdivided under the law of 1832 the N.E. 1/4 of Sec. 31 as to conform to previous as reported by the District Register on the 15th August (and sent copies of the plat thereof to each one to Sec. 1 and another to the Gen'l Land Office.)

Statement referred to in the certificate to this of the 31st of January 1844.

Designation of lines.		
Line bet Secs 35 & 36	25. 36	75

Meander of Illinois river along sections 18, 20, 25, 30, 35, 36 from the corner to Sec. 34 & 35 S. 2 W. East to the river
Cont. boundary of Sec. 3.

31st of January 1844. Sent a plat of Sec. 13, 24, 25 & 36 to the Commissioner, and the Register.
Variation in Mr. Spaulding's survey.

Surveyor's Office -
St. Louis 10 Sept 1842.
The above plat of Fractional Twp. 2 S. R. 2 W. of the 2nd Principal Meridian (except pt. Sec. 13, 24, 25 & 36) is conformable to file notes showing township in file in this office.
J. M. Rice
Sr. of Pub. Land


Surveyor's Office. Saint Louis 31st of January 1844.
This plat was this day completed, strictly conformable to the file notes on file in this office, which have been examined and approved of the surveys and returns, executed in this township on the 18th of 1843, by J. A. Spaulding, under instructions of the 31st of March 1842. The area run by Mr. Spaulding on details in a statement in the right of this plat, lay amount to 13 miles 740 of chains, which were paid for in the 3rd quarter of 1843, and charged in the account current of the Surveyor General during the said quarter, under the appropriation of \$3,000, of the 3rd March 1841, for 500 miles of detached and unfinished lines in Illinois & Missouri, at a rate not exceeding six dollars a mile. See page 23 of acts and resolutions of the 28th Congress.

Silas R.

Fractional Township 3 South. of N. Sec. line. Range 6 West of the 1st principal meridian

See for Mr. Spaulding's work on the N. by
of this township, the plot of t. 2 S. R. 2 W.

Designation of lines	n	chr	HT
Line bet sec 10 & 1A	1	20	08
" 22. 20	1	01	74
" 1A. 25	1	A1	00
" 1A. 15	1	01	74
" 11. 1A	1	02	84
" 10. 11	1	01	74
" 2. 3	1	01	74
measuring from a main line			
along sec. 23 & 1A	2	16	08
measuring around island	2	3	74

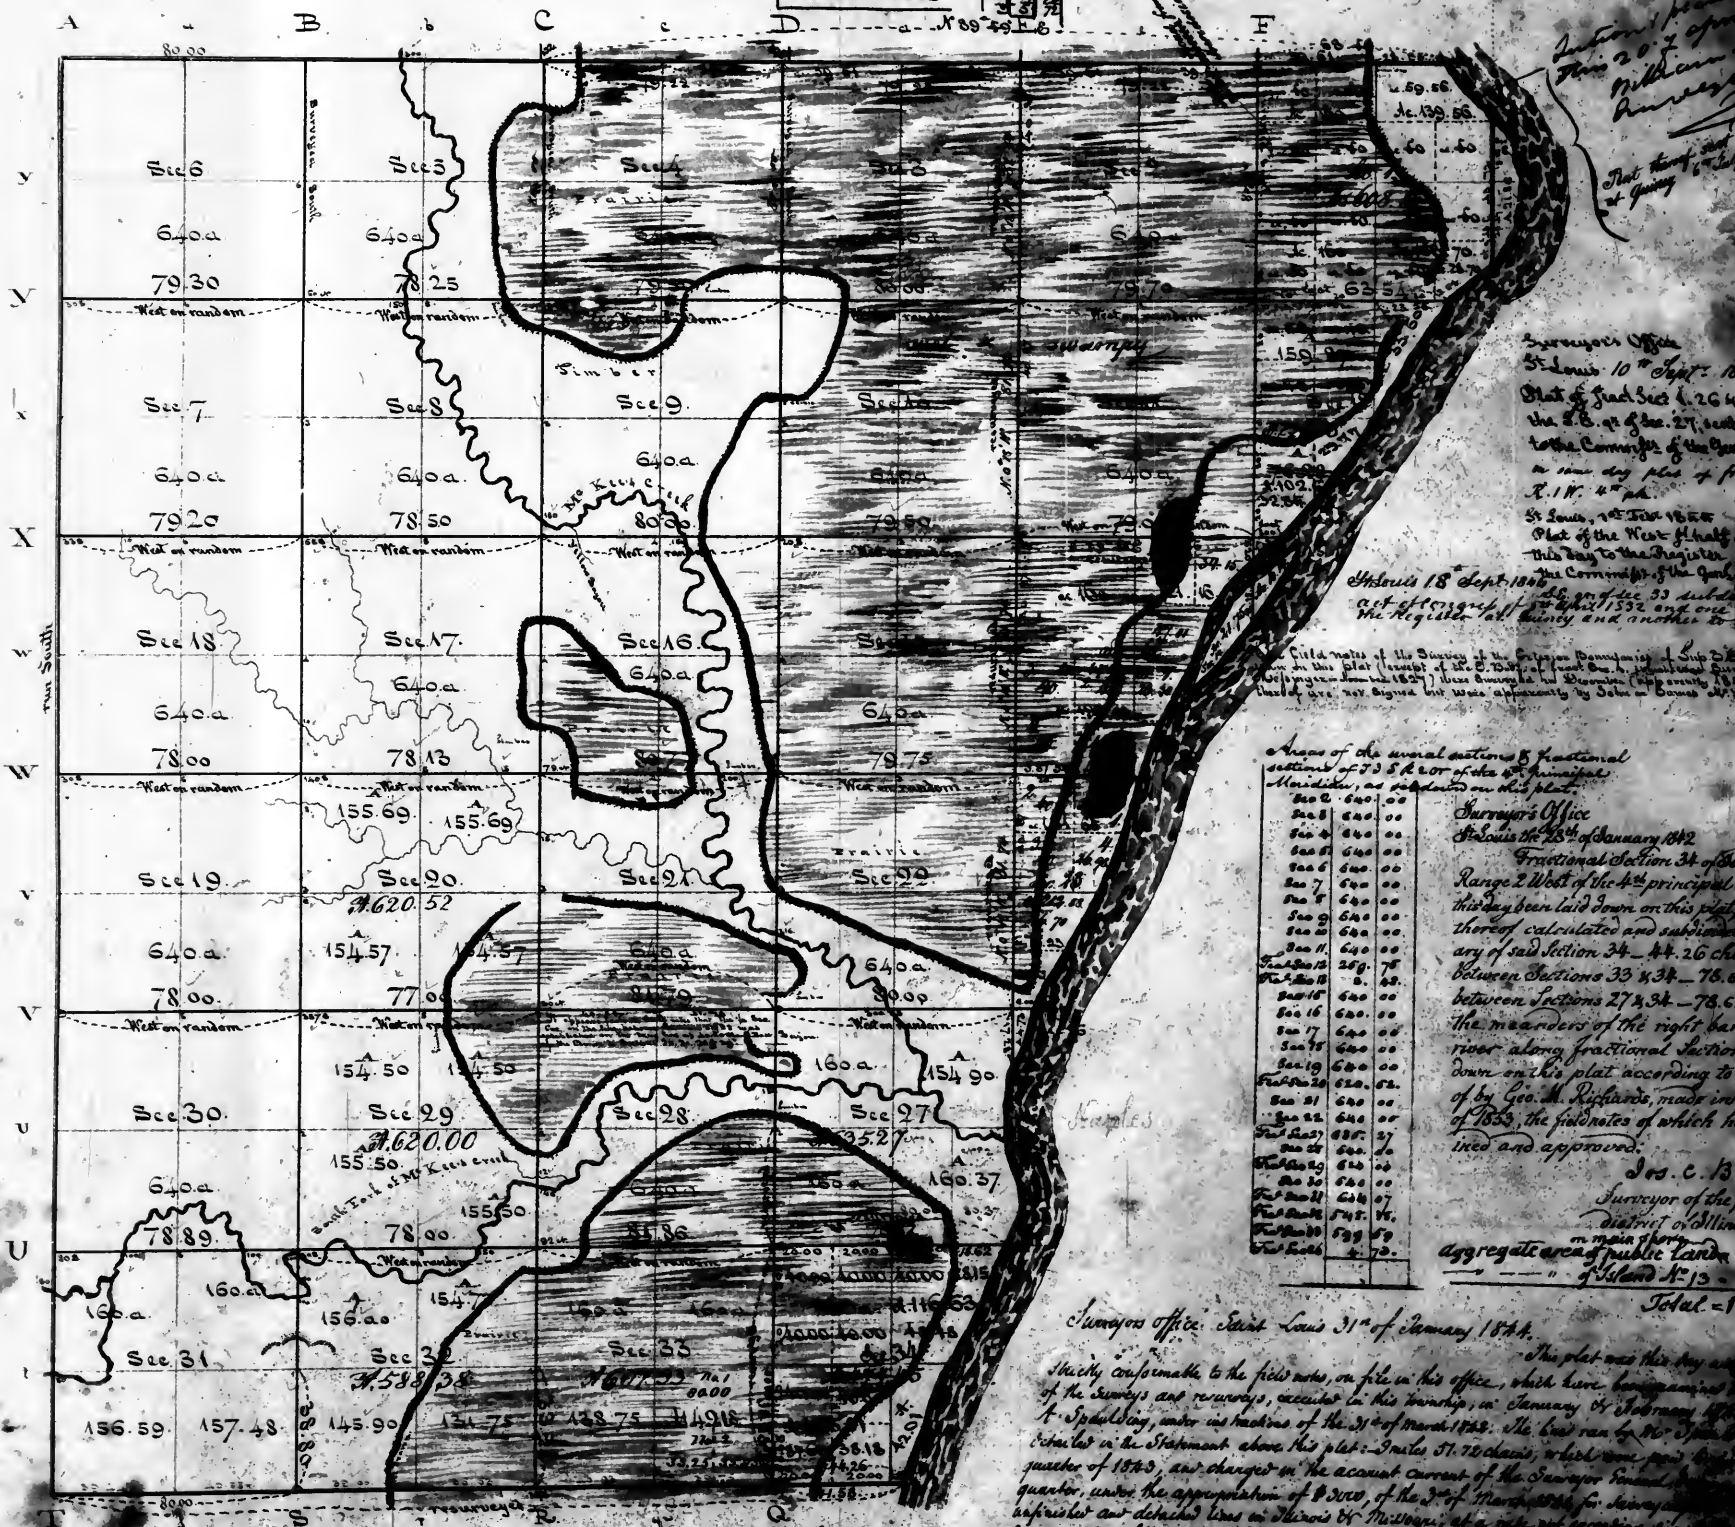

Inventory Office

St. Louis 18th September 1830


the above plot of Pac^e Inp. 3^d R. 2 West (except pt. 6 1/4, 23, & 34)
and of pt. Inp. 3^d R. 1 West of the 4th R. Main. as C. R. for a mile to full
notes of survey thereon on file in the office -

Variation on Mr. Spaulding's surveying $7^{\circ}35'$ East.

Silas R.

31st of January 1884. A
and of certain matters
the Registrar.

page 6 vol. 21

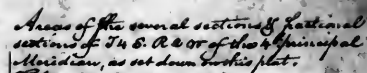

Feb 28	167.	30.
Dec 4	640.	00
Dec 5	640.	00
Dec 6	640.	00
Dec 7	640.	00
Dec 8	640.	00
Feb 10	5.	11
Dec 15	640.	00
Dec 19	640.	00
Feb 23.	3.	30
Feb Dec 25.	161.	19
Dec 26	640.	00
Dec 30	640.	00
Dec 31	643.	94.
Dec 32.	644.	45.
Feb Dec 33.	420.	45.

24th Feb^r 1834. A copy of the plat of the $1\frac{1}{2}$ sec. 25 sent
this day to the Reg^r. at Albany.




Surveyor's Office
St. Louis 10th Sept. 1842

Plot of July Dec. 3, 10, 16, 21, 28 & 30, of the South Great half and N.E. quarter of Sec. 9
of the S.E. quarter of Sec. 17, of the East Great half of Sec. 20, and of the South halves of Sec. 24
& 30, next the bay to the Corner of the Q. 1. & O.

Saint Louis 21.st March 1844.

Subdivided under the Act of 1832 so as to conform to previous sales as reported by the Reg^y in the 15th Aug. 1843, viz. the 1st quarter of section 31 (and sent, to day, one copy to the S. Reg^y and another to the Gen^l Land Office.

— Subscribed the S.W. qr. of Sec. 32, so as to conform to a previous sale & sent one copy to the Registrar and another to the Commissioner of the General Land Office.

But divided under the Act of 1832 so as to conform to a previous sale, viz the 1/8 quarter of section 31 and sent to day one copy to the Register and another to the Commissioner of the Genl Land Office

Aggregate area of public land = 9585.63 ac.

Surveyors Office

St. Louis 28th August 1830

St. Louis 25th August 1834. The above plat of pt. Imp. 1st 4. S. R. 2 W. of the 4th Pth ellidan, (except pt. Sec. 9, 17, and 20) is conformable to the field notes of the surveys thereof, on file in this office. —

Wm Bee

Dr. J. P. L. L.

in the clip in the 3rd


Plat of Township No. 5 South of the Base line in Range No. 2 West, 4th Principal Meridian.

except fractional sections 4 & 35 which are omitted on account of errors in the survey thereof

page 7 vol 21

applied for land by
petition this 28th day of
November 1833

28th May 1836
first to the Register at St. Louis
for fractional sections 3
23 & 26 last survey

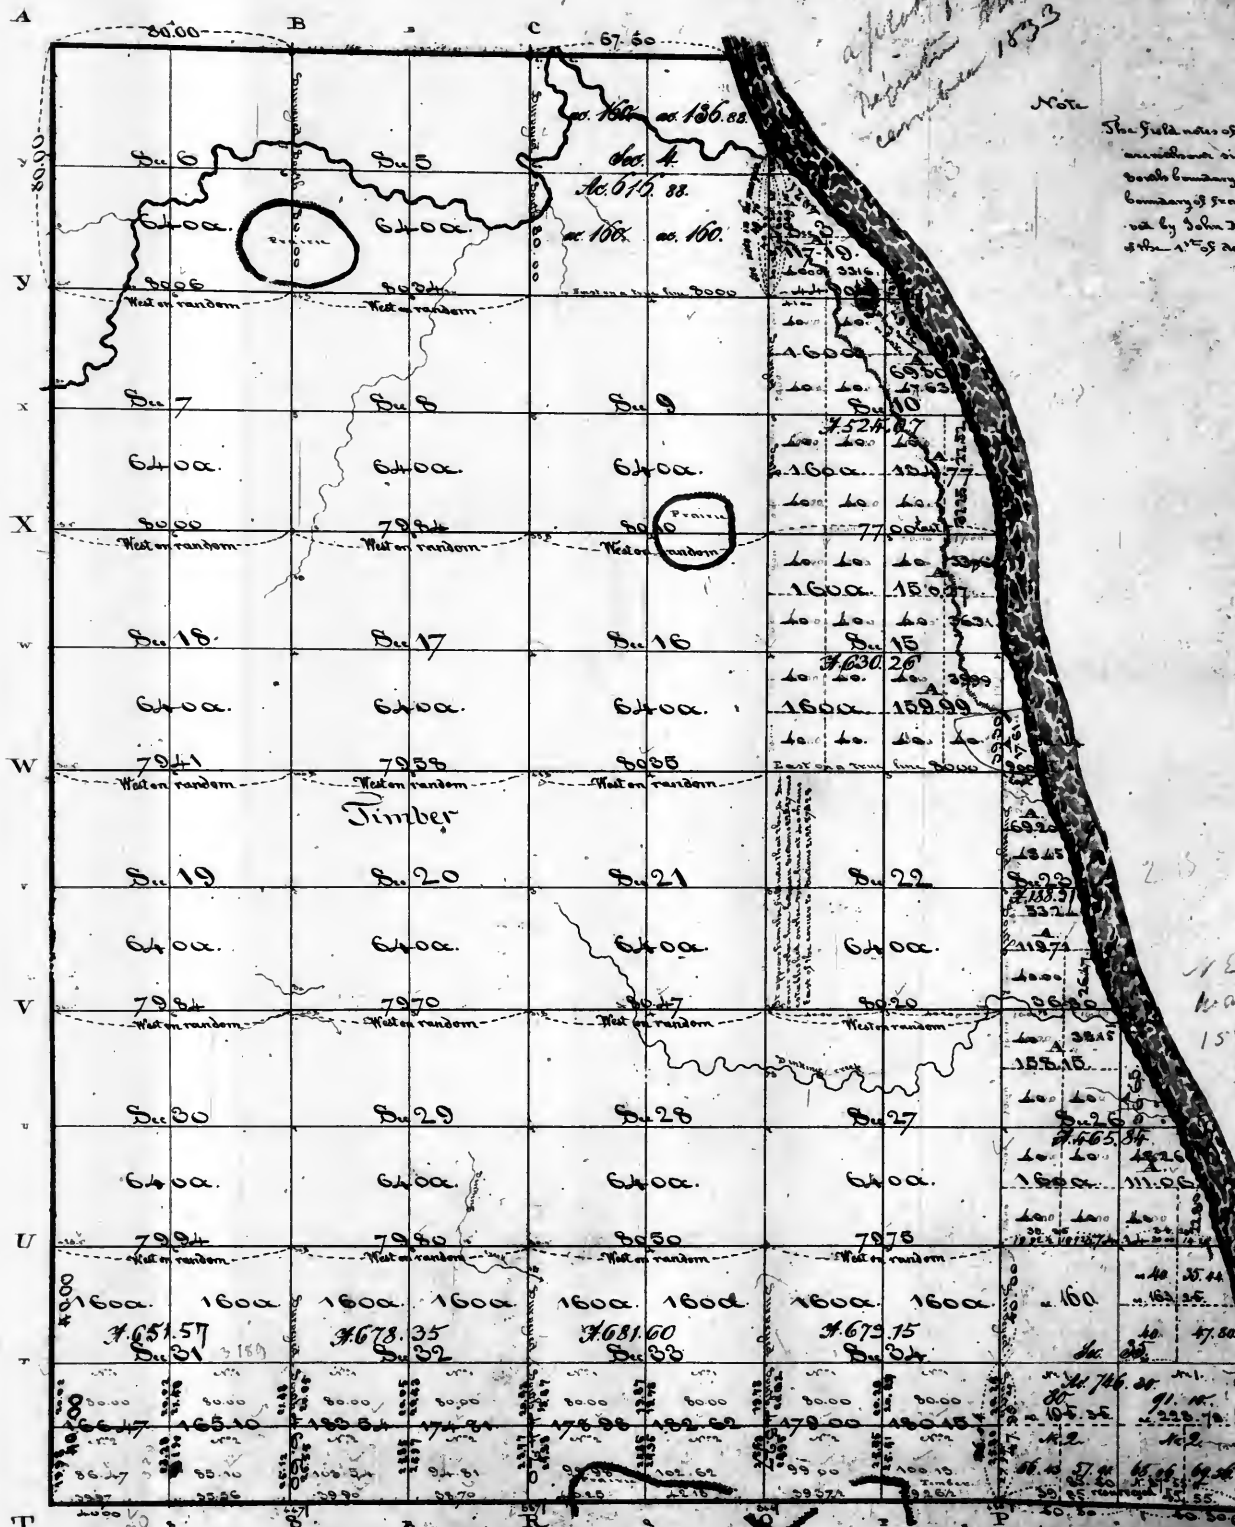

Note
The field notes of the exterior line of this Township
and the original signatures of the Surveyors and the
boundary of fractional sections 4, and the south
boundary of fractional sections 3, which were ver-
ified by John H. Essinger D. S. under his contract
of the 1st of December 1836.

Areas of the several sections of fractional
sections of T. 5 S. R. 2 W. of the 4th Principal
Meridian, as set down on this plat.

Section 3	117.	19
Section 4	640.	00
Section 5	640.	00
area of the
NE 1/4 of Sec 15
was altered from
155.3 to 150.27

Surveyor General's Office
Saint Louis 27th August 1837

This line between sec-
tions 3 & 4 of the 1st of January 1836 by
John H. Essinger D. S. Grant and others in the
survey thereof 36 to 49 of chains (and at
of the corner to sections 3 & 4, 95.00 was the
corner established. — J. H. Essinger D. S. Grant
for 1827 in resurveying and measuring the
contract of John H. Essinger of the 1st of
January 1836 found the old quarter section corner at
point of the old corner to sections 3 & 4, 95.00
intersection of the line with the height of
corner at 49.15 chains being 8.65 chains
the section corner he established a new
quarter section corner at 95.00 chains
of the old corner. — The area of the
quarter of section 4 is calculated
on this plat according to the corner
8.65 chains north of the 1/4 section
a copy of the plat of fractional
sections 3 & 4 was sent to the Register of
at Quincy in the present day

Aggregate area - 16288.63 acres

Surveyor's Office
St. Louis 28th August 1837

The above plat of tract Twp. No. 5 S. R. 2 W. of the 4th P. Mer.
(except sec. 4 & 35) is conformable to the field notes of the
Survey thereof on file in this office.

Wm. C. Rice
W. of Public Lands
- Sec. 4 & 35 -


31st of January 1844, A plat of sections 35 & 36, sent to the
Commissioner and the Register.

Surveyor's Office, Saint Louis 31st of January 1844.

This plat was this day completed, mostly conformable
to the field notes, on file in this office, which have been examined and approved, of the Surveyors and returned, as
in this township, in February and April 1843, by D. A. Spaulding, under instructions of the 31st of March 1843. —
Note: The S. by of sec. 35, 7 miles and 60 links — the line between sections 34 & 35, 1 mile, 7.95 chains — and the
measures along sec. 35, 31.18 chains — in all, 2 miles 51.83 chains, which were paid for in the 6th quarter of 1843
and charged in the account current of the Surveyor General, during the said quarter, under the appropriation of
\$3000, of the 3rd March 1841, for surveying 500 miles of surveyed and detached lines in Missouri and Arkansas
at a rate not exceeding six dollars a mile. See page 28, acts of 2^d session of 26th Congress.

John Reed
Surveyor of the Public Lands
in St. Louis

T. 6. S. R. 2. W. of the 4th p^l M^o

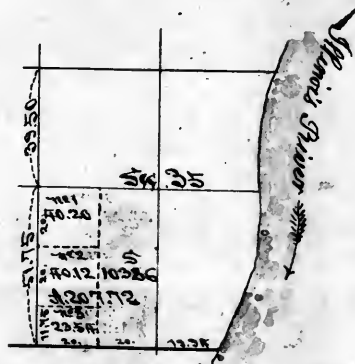

Scale of 40 chains to an inch


Surveyor's Office
St. Louis Aug 29 1848

The above Plot of the S. W. q^r of Sect. 35 in Township 6 South of the base line Range 2 West of the 4th p^l M^o, has been constructed in strict conformity with the field notes ^{of the survey} thereof on file in this Office, and the subdivisions have been made as to conform to a previous sale (marked thereon)

J. R. Conway
Surveyor of the public lands in the
States of Illinois & Missouri.

Expt. Stations and Fractional Stations 1, 2, 11, 12, 13, 24, 25, 26, 27, 28. -- which are omitted on account of errors in the Survey thereof.


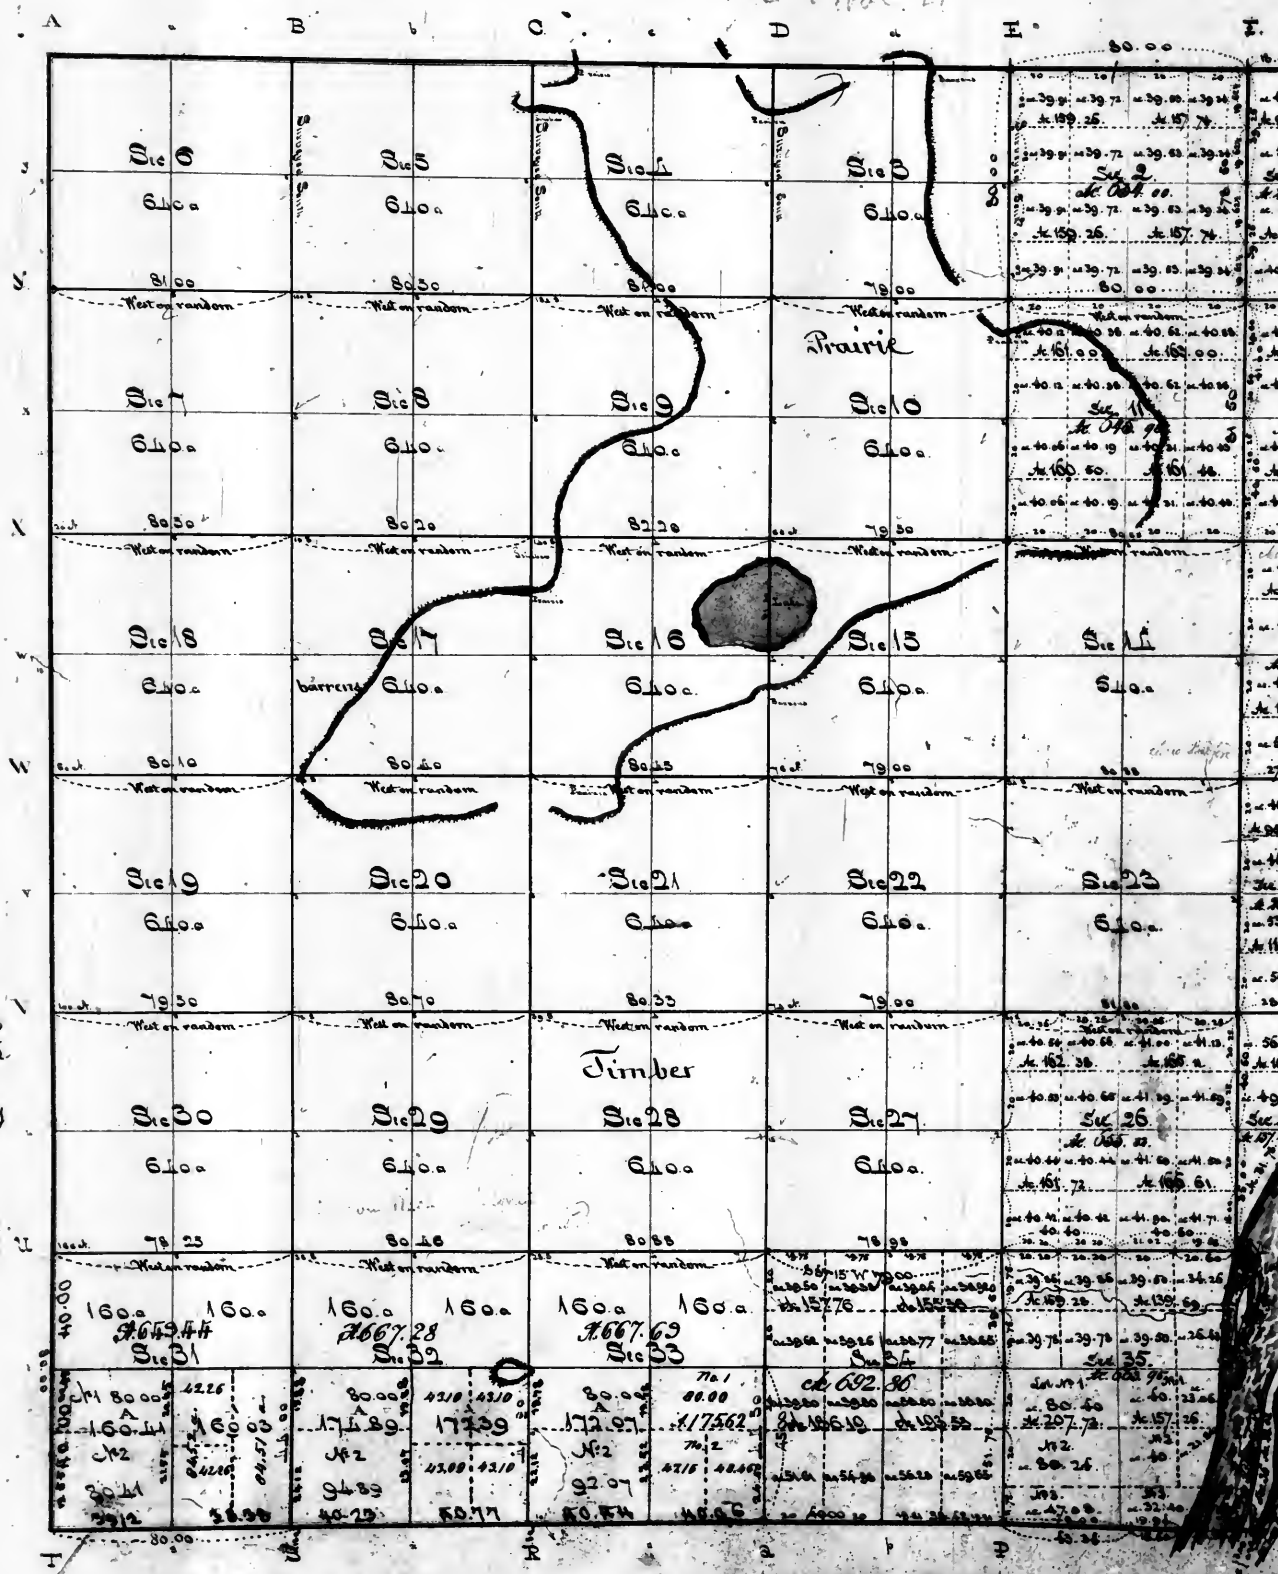

Note for the Subdivision of
the S.W. 1/4 of Sec. 3
see the annexed plan

Aggregate area of public land on main shore - 20,027
on the Islands - 9
Total - 20,106

Surveyor's Office
 Lewis 10th Sept 1842.
 List of jobs done 1. 12. 13. 24. 25. 26. 27.
 28. 29. 30. and of the South halves of both 31.
 32. 33. and the day to the Commence-
 ment of the next L. O.
 At Lewis 15th Sept 1842

The Tlb. of Dec 31. S. E. of Dec 32.
S. E. of Dec 33. (The two former so
as to conform to previous sales) and
sent 1 copy to the Registrar of Land
another to the Comr. of the Land
Surveyors Gen.
Donec Louis N^o 2nd Jan^y 1899

2. 11. 12. 13. 24. 25. 26. 27. were this day
 down on this plat according to the
 note thereon as filed in this office.
 of sections 11, 24, 25, and 26 of
 T⁴ N¹⁴ E. 3. R¹⁰ W. — 4. copy
 was sent today to the Register at
 10 "day of April: 1882.
 Commissioner of the Gen^l Land Office,
 also a copy sent to the Register
 Quincy a plat
 23^d April 1882.

Variation in Mr. Spaulding's surveying
in 1843, 7° 35' East.

Statement referred to in the certificate to the
the 20th January 1844.

Disposition of the trees.

Line between sections 35 & 36.

SS #36 on island A.

Mountain on New Island.

B

S. by of sec. 35. E of the bend of river.

South by of sec 36

A plat of island A. H. B. in
 one of them Island is the
 the Commission on the Hth Jan
 a copy thereof to the Register

Surveyor's Office
St. Louis, Aug. 29th 1848
Sent this day a copy of the
S. E. q. Sec. 35 to the
Register & another copy
to the Commfr.


Surveyors Office
St. Louis 28th August 1830³
The above plat & file 2nd p. 10. 11. 12. 13. 24. 25. 26. 34 and 35. is
excepted out of the file 1. 2. 11. 12. 13. 24. 25. 26. 34 and 35. is
conformable to the field notes of the Surveyor General, on file
in this office — Wm. R. R.
Wm. R. R.
in the Sup. & 3rd p. 10. 11. 12. 13. 24. 25. 26. 34 and 35.

Surveyors' office. Saint Louis, 20th January, 1884.

This plat was this day completed, strictly conformable to the field notes on file in this office, which have been examined and approved, of the survey and bearings, recorded in this township, in February 1865 by W. A. Spaulding, under instructions of the D.P. of March 1862. The lines run by W. A. Spaulding, are defined in the Metewment on the right margin of this plat. 200-50 acres, which were paid for at the 3rd quarter of 1865, and changed in the account current of the Surveyor General during that quarter, under the appropriation of \$ 2000. 

Map of Sections 4, 5, 6, 1000

page 9 vol 21

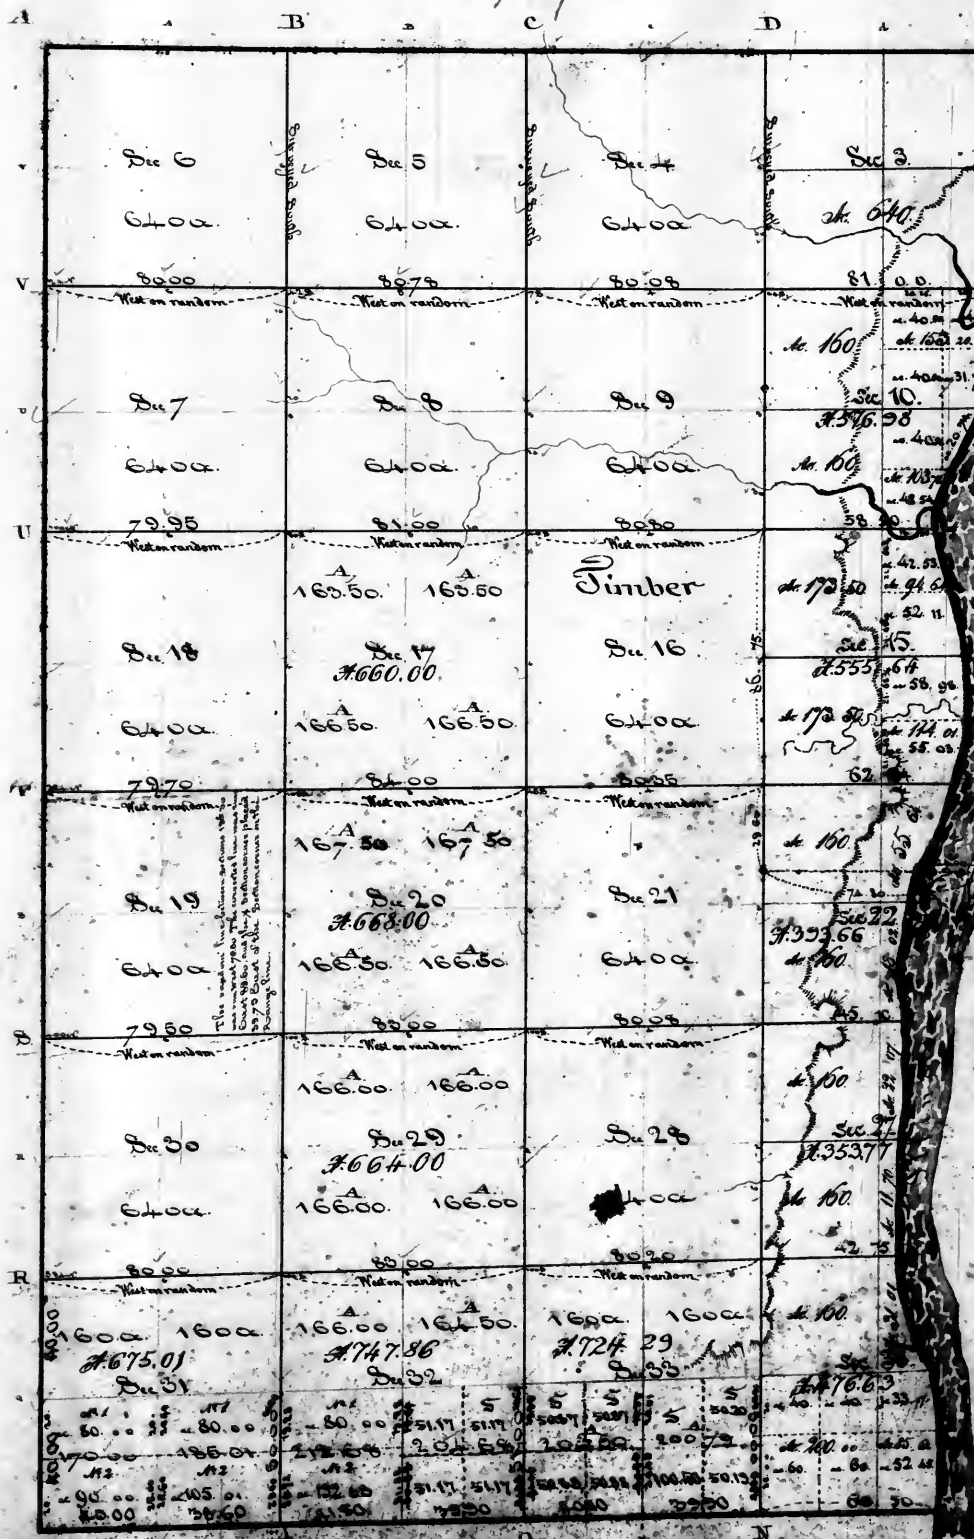

See for survey & survey on
L. S. of the 18th of 1842

13.90 acres

Surveyor's Office
St. Louis April 24th 1847
Subdivided the S. E. 1/4 of Sec. 32 and the South half of Sec. 33,
into conform to previous sales (marked & thereon) and sent a
copy to the Register & another copy to the Comptroller on the 30th of April

Note:
The eastern boundaries of Township 7 S. R. 2 W. were
surveyed in December (approximately 1840) the field notes of
said boundaries are not signed, but were apparently
taken by James or John M. Donald.

Aggregate area of public land in main shore = 15084.63 acres
on islands = 14.56
Total = 15099.19 acres

Surveyor's Office - St. Louis

Today laid down on this plat a correction between the
surveys made from the 2^d of 4th of 1842 conformable to
the field notes of the survey thereof contained in said
in file in this office vol. 107 - page 26

St. Louis 1st of May 1848

A copy of the plat of sections 3, 4, 10, 11, 12,
23, 27 & 28 was this day sent to the Register at
St. Louis

Surveyor's Office
St. Louis 1st of May 1848
Plat of sections 3, 4, 10, 11, 12, 23, 27 & 28, out of the
South half of Sec. 32 & 33, and this day to the
Comptroller of the Public Land

Surveyor's Office, Saint Louis 31st of January 1849.
The plat in section 3, and that part of section 4, which was in sections 3
was this day laid down on this plat, the plat conformable to the plat made of
Survey thereof on file in this office, which have been examined and approved
on October 1848, by W. A. Spradling, Commissioner of the Land
1842 - to wit the line between Sec. 1 & 2, 1/4 Sec. 1, the western of the upper
1841 claim - and the western of the lower claim, North 7. 6. 5 chains - as plat
19. 17 chains, which were paid for in the 1st quarter of 1843, and changed to the
Survey of the Surveyor General, during the same quarter, under the appropriation
of \$3000, of the 3^d of March 1841, the surveying 500 miles of public land
lines in Illinois & Missouri, at a rate not exceeding \$1000 a mile. See
29 Act of March 3^d 1847

Silas Rice

Surveyor of the public land in
of Missouri

31st January 1849, sent to the Comptroller & Register a plat of the land referred
above and plat.

Surveyor's Office
St. Louis 18th of September 1850
The above plat of the three western Range & sections
first Sup. N. of S. R. 2 W. of the 1st of May is conformable
to the notes of survey on file in this office.

Wm. Rice


Office of the Surveyor
St. Louis

A plat of the south half
sections 32 & 33, was sent
to the Register at St. Louis

Fractional Township 8 South of the base line, Range 2 West of the 4th principal meridian.

page 10 v. 21


Each - Sec 14 - (offhand P.S. - 2
and apparently by A. B. Brown

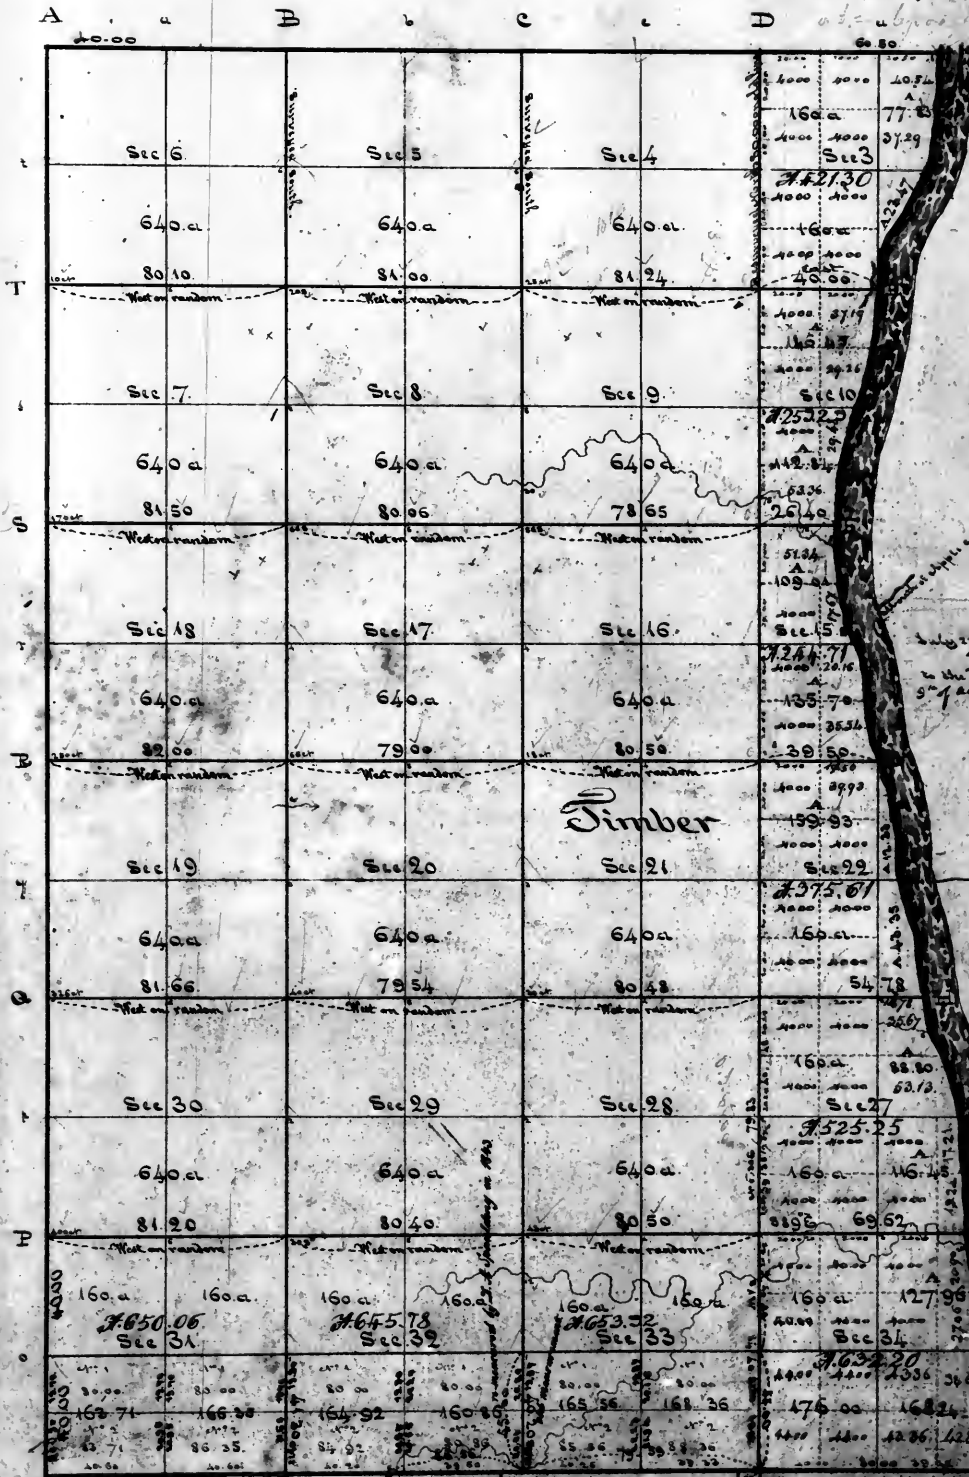

The following is a copy of the original survey of the fractional boundaries of this Township (which boundary is 27.5 miles long) as not signed in 1854, but one (apparently) by James H. Brown. The survey was executed (apparently) in December, 1854.
The south boundary of sections 14, 15 and 16 North boundary of sections 34, 35 and 36 as laid down on this plat were resurveyed by John H. Brown on 2^d of July 1857. The southern line of the Township comprises the line between sections 14, 15, 16, 34, 35, 36, 17, 18, 19,

Plot of fractional townships 29 South of the Duncan Range 2 West of the 4th principal Meridian

Sec 10	640.00
Sec 11	640.00
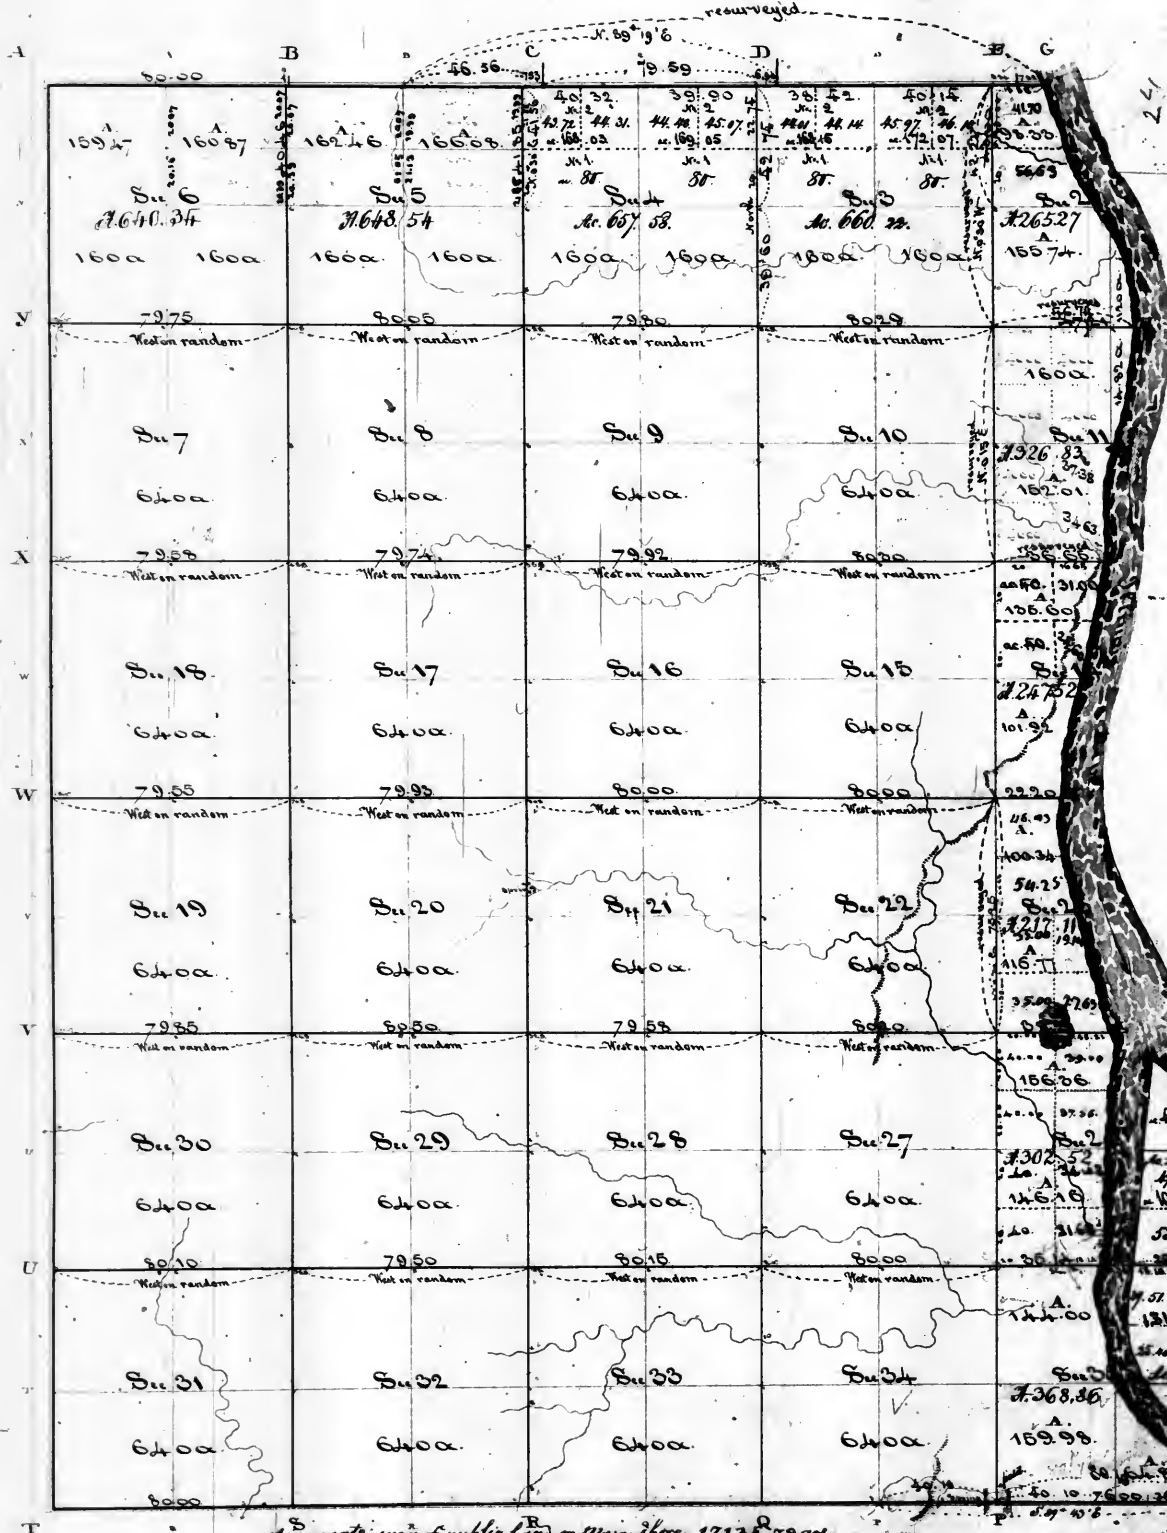


Statement of the certificate to this plot taken 31st January 1844

Designation of lines

Between Sec 24 & 25	1/2 Sec 24
Between Sec 24 & 25	1/2 Sec 25
The North boundary of Sec 2, 25, is laid down on this plot as originally surveyed by Daniel Mc Donald, between (apparently) the 26th and 27th of January 1844, and the North boundary of Sec 25, according to the surveying done by Daniel Mc Donald, in January 1844. (See plot of 1844, 25, 26, 27,

A a B b C c D d E e F f

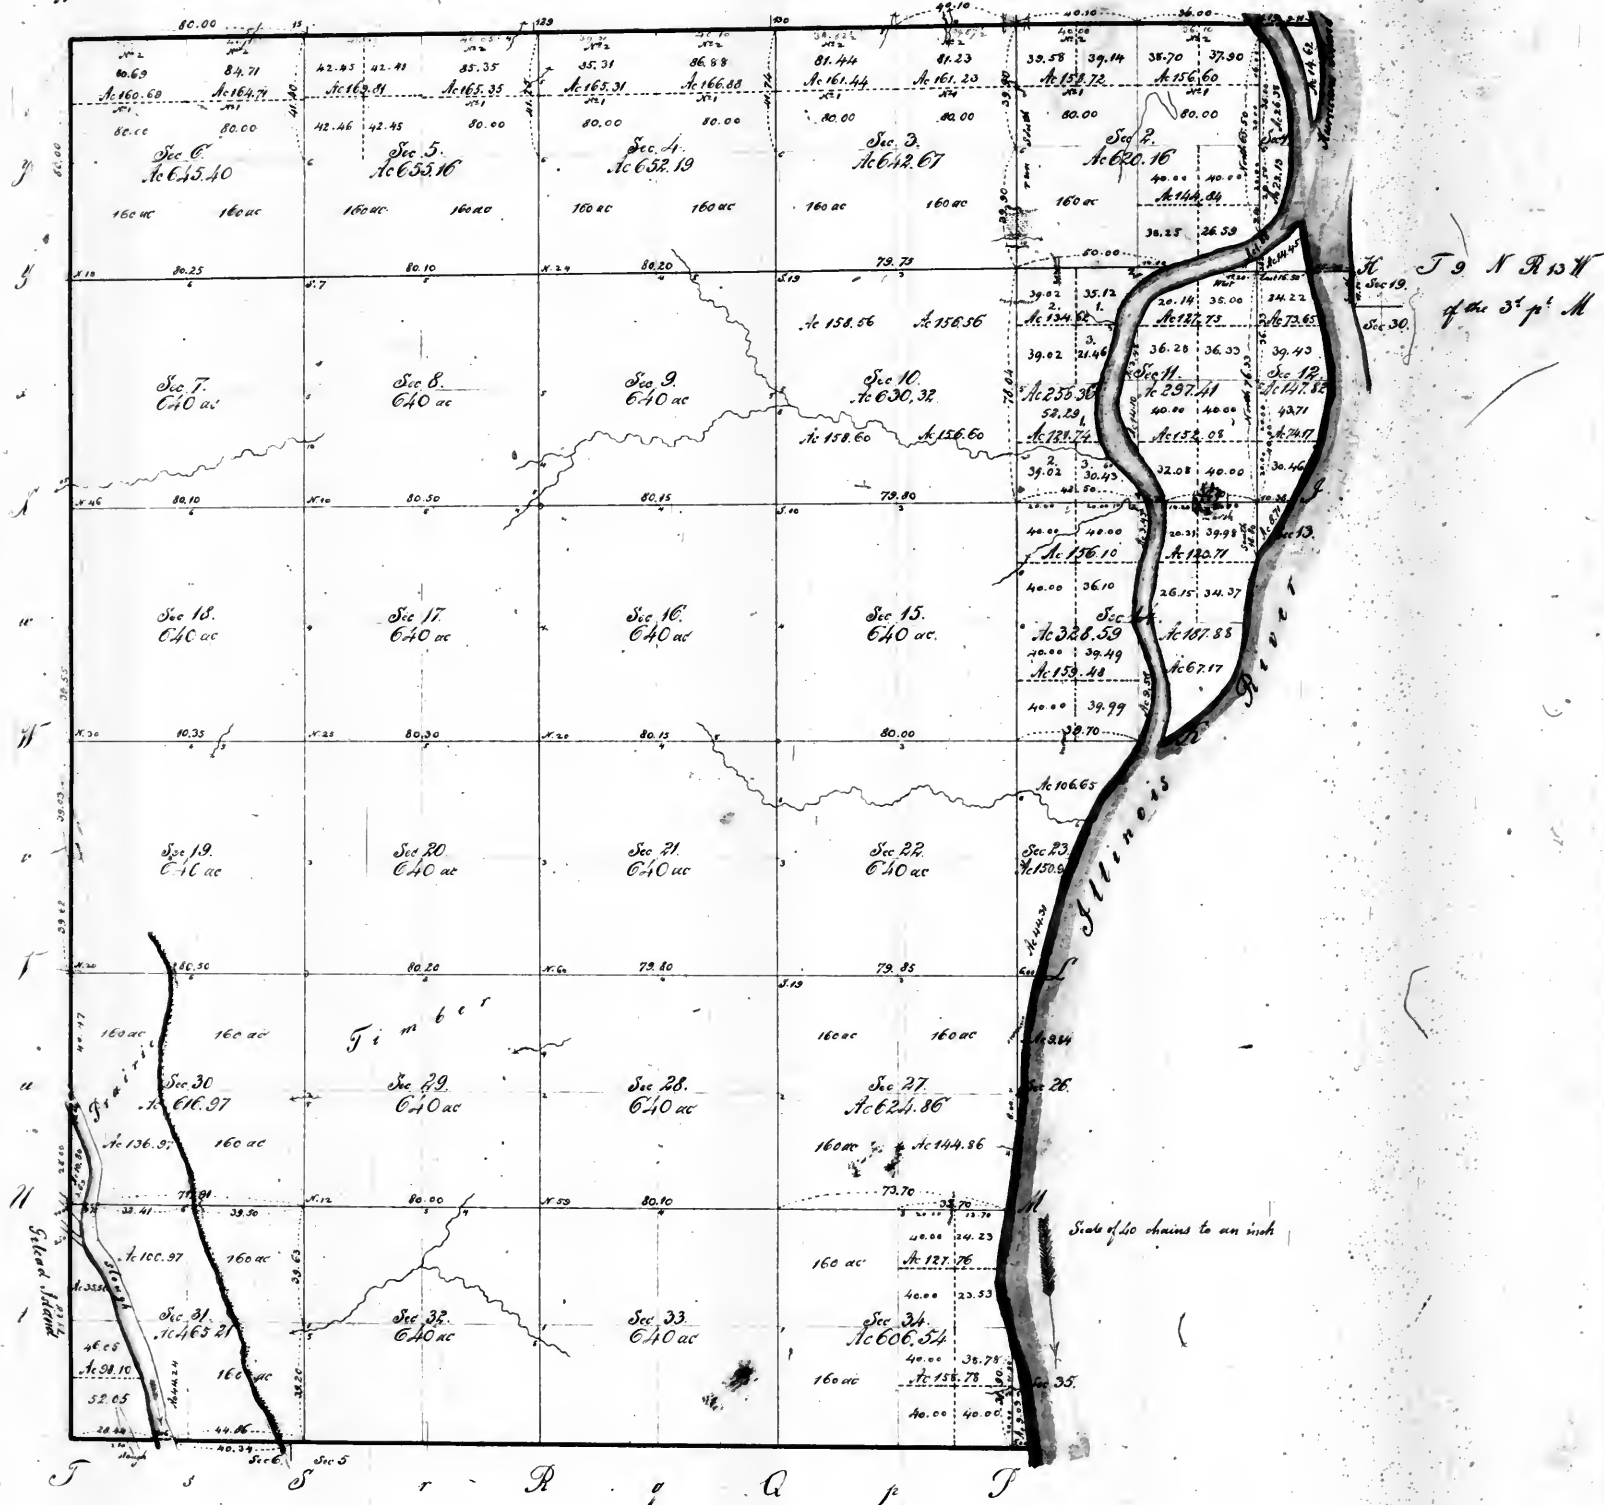

The above plat of township 10 South of the base line and Range 2 West of the 4th principal meridian is strictly conformable to the field notes of the Survey thereof on file in this office which have been examined and approved. That part of fractional sections 30 and 31, west of the slough, and which is designated as "Pileas Island" was surveyed in October 1856, by Joseph Burnap, under instructions of 2d April 1856. The surveying, 2 miles .37.43 chains, is embraced in an account approved by me, received for by Burnap, and transmitted this day to the Commissioner of the General Land Office, as per his instructions of the 11 March 1856, for a direct settlement with the Deputy, out of the appropriation for the corrections of erroneous and defective lines of the public and private surveys in Illinois & Missouri; at a rate not exceeding six dollars per mile.


A copy of the plat of sec^s 30 & 31 West of
Trough was sent to the Commissioner & Register
on 25 February 1857.

John Loughborough
Surveyor General.

except those parts of fractional Sections 1, 2 & 11 which lay on the main bank of the Illinois River

The South boundary of Sup. 10 S. 1. as laid down on this plat, viz: along Sec. 32, 33, and 34, is in conformity with the above mentioned field notes of resurvey, without date or signature (except the copy to Dist. 33, registered by Messinger and which is considered to be virtually in the same position given to it in the aforesaid notes of 22. subvency) and along Station 34 1/2 33, is in conformity with the field notes of the resurvey thereof by Messinger.

for runways on the N. by of this township, the plat. of T. 9 S R. 28 E

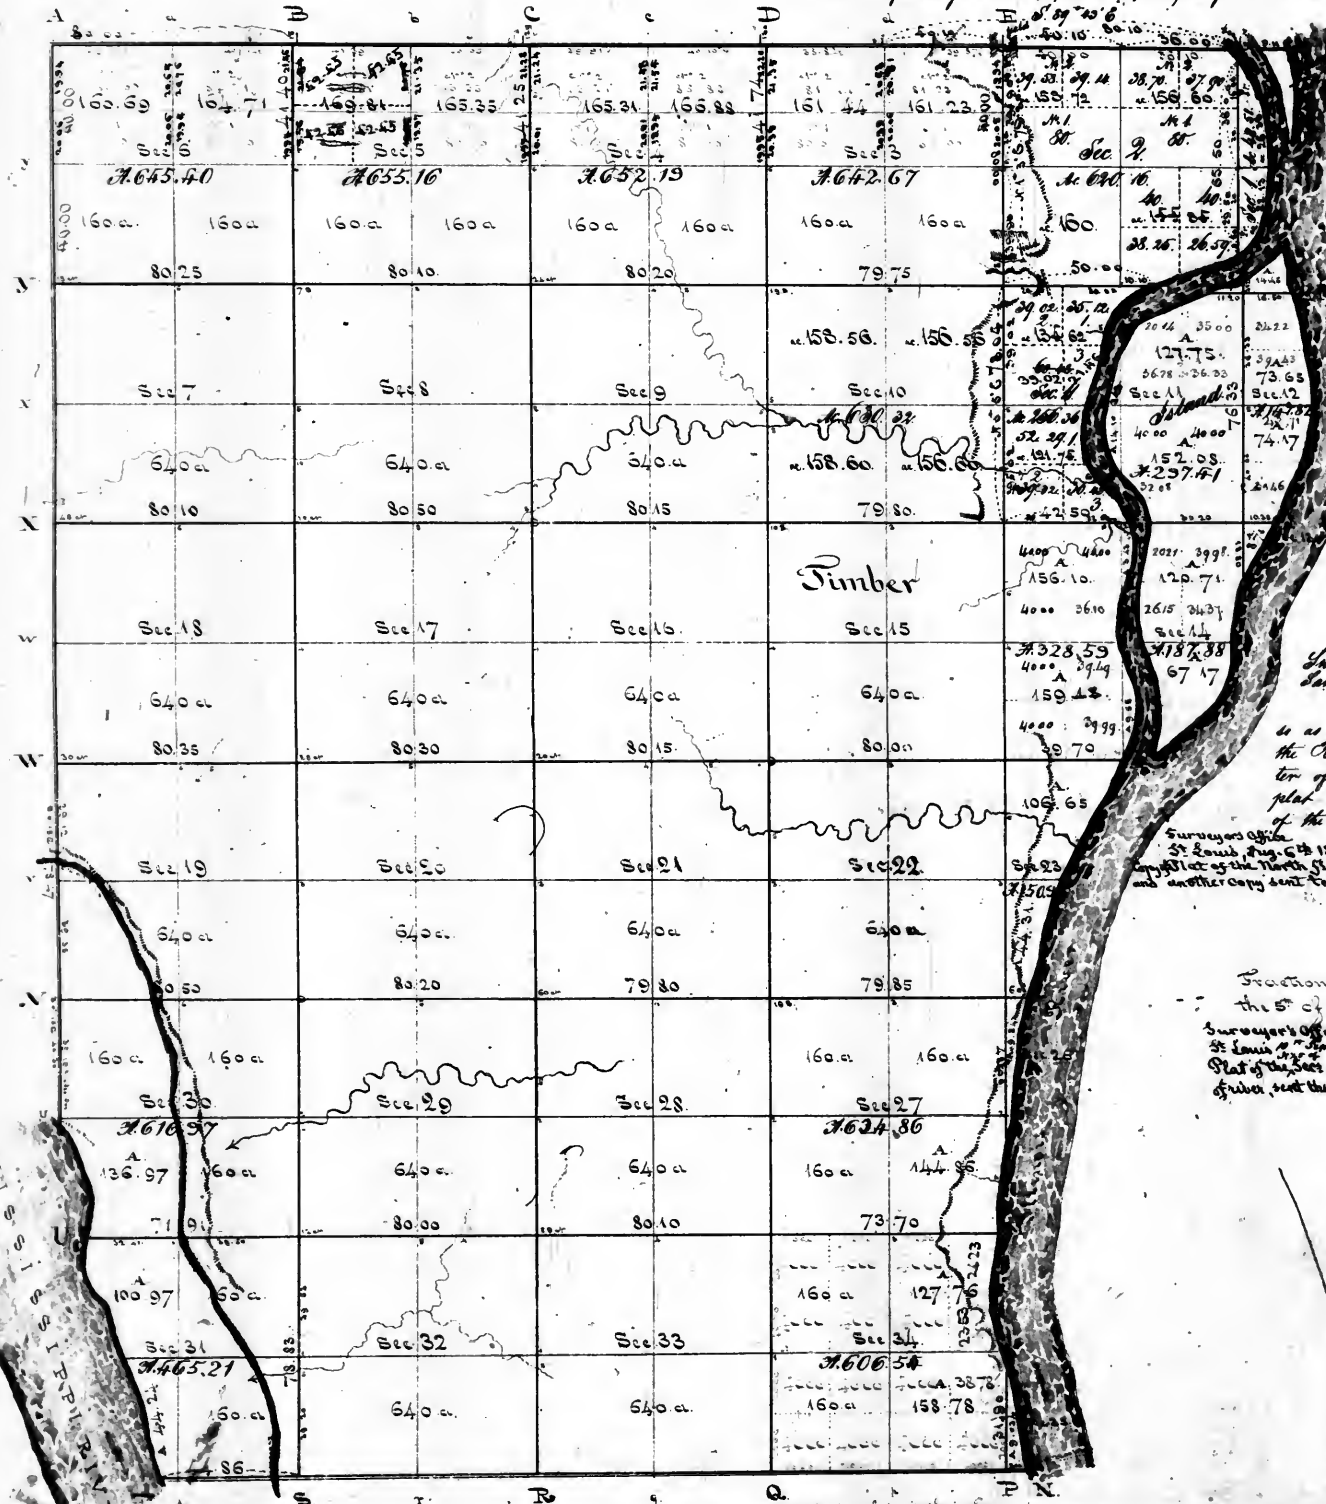

Aggregate area of public lands on Main shore = 16672.77 acres
on the Islands = 672.77

Total = 17345.54 acres

Notarys Office
St. Louis 18th September 1830

The above class of radiations Expt. No. S. P. 2 N. of the 4th pe
 (Expt. No. 10 - Expt. Report of 28th M. last) has been
 confirmed to full notes of such things as are
 in this office; and to put said notes, no other, and explained
 above.

Wm. R. R.
S. of J. R. R.

Statement referred to in certificate below

Designation of the lines

Line better set 152.

10. 11.

2. 11

2. 3.

Records in main field along set 2. 1. 11

Records on island.

3rd of January. Set a plot of Sect. 1, 2, 11 on main shore, of Sec. 10, and of that part of island in Sec. 1. to the Gov^t of the Register.
Donation on N^o. Spaulding's surveying: 7th 30th E.

Surveyor's Office, Lae, Louisi^a 31st of January, 1844. This plot was this day completed, by laying down Noron, sections 1, 2, 10 & 11, & the main stream on that part of Mexican island, which lies in between, & thereby completed the first work of the Survey, and returned myself on file in this office, where they have been examined and approved & they were executed on January 18th, 1844.

C. A. Spaulding, Interior Minister of the 31st of March 1845, in the report is detailed in the statement above, and amounts to 50 miles which were paid for in the 3^d quarter of 1843, and charged in the account.


John C. Frick

Silas Koca
Surveyor of the public lands
State of Illinois at Madison

Note. On account of a supposed error in the line between Sections 10 & 11 in this Township, the area of Section 10 is not set down on the Map, the said Section will therefore not be affected by and will not require any conveyance shall be made, of which the Register will be duly notified.

Surgeon's Office
Saint Louis 21st March 1844

Subscribed under the seal of 1822
as is to conform to a previous sale as reported by
the Register on the 15th day 1825, viz: the N.W. quar-
ter of section 5 and sent to day, copies of the
plat one to the Reg^r and another to the Comm^r
of the Gen^l Land Office.

Surveyors Office
St Louis, Aug. 6th 1846
Copy of Act of the North Pl. half of Sec. 11 (West of Illinois river) sent this day to
and another copy sent to the Commiss of the Genl Land Office on the 26th of 1846

Surveyors Office

St. Louis January 20th 1833

Fractional section 36, subdivided under the act Cong.
the 5th of April 1832.


Surveyor's Office

Plat of the lots 3, 4, 5, 6, of the 1st sec 1, 2, 12, 13, 14, 15, 16, and of 1st sec
of river, sent this day to the Commisr of the 2nd L.O.

Areas of the several sections & fractional
sections of Tio S. R. 20 N. of the 4th pth
alluvial as set down on this plat.

Final Dec 1	14.	45.
Final Dec 2	1.	35.
Final Dec 3	542.	07.
Dec 4	692.	19
Dec 5.	655.	16
Dec 6	645.	40.
Dec 7	644.	40
Dec 8	640.	00
Dec 9	640.	00
Dec 10.	640.	00
Dec 11.	207.	72
Final Dec 12.	147.	52.
Final Dec 13	8.	71.
Final Dec 14	502.	45.
Dec 15.	640.	00
Dec 16	640.	00
Dec 17.	640.	00
Dec 18.	640.	00
Dec 19	600.	40
Dec 20	640.	00
Dec 21	640.	00
Dec 22.	640.	
Final Dec 23	150.	32.
Final Dec 24	19.	84
Final Dec 25	150.	32.

Township 11 South of the base line Range 2 West of the 4th principal Meridian

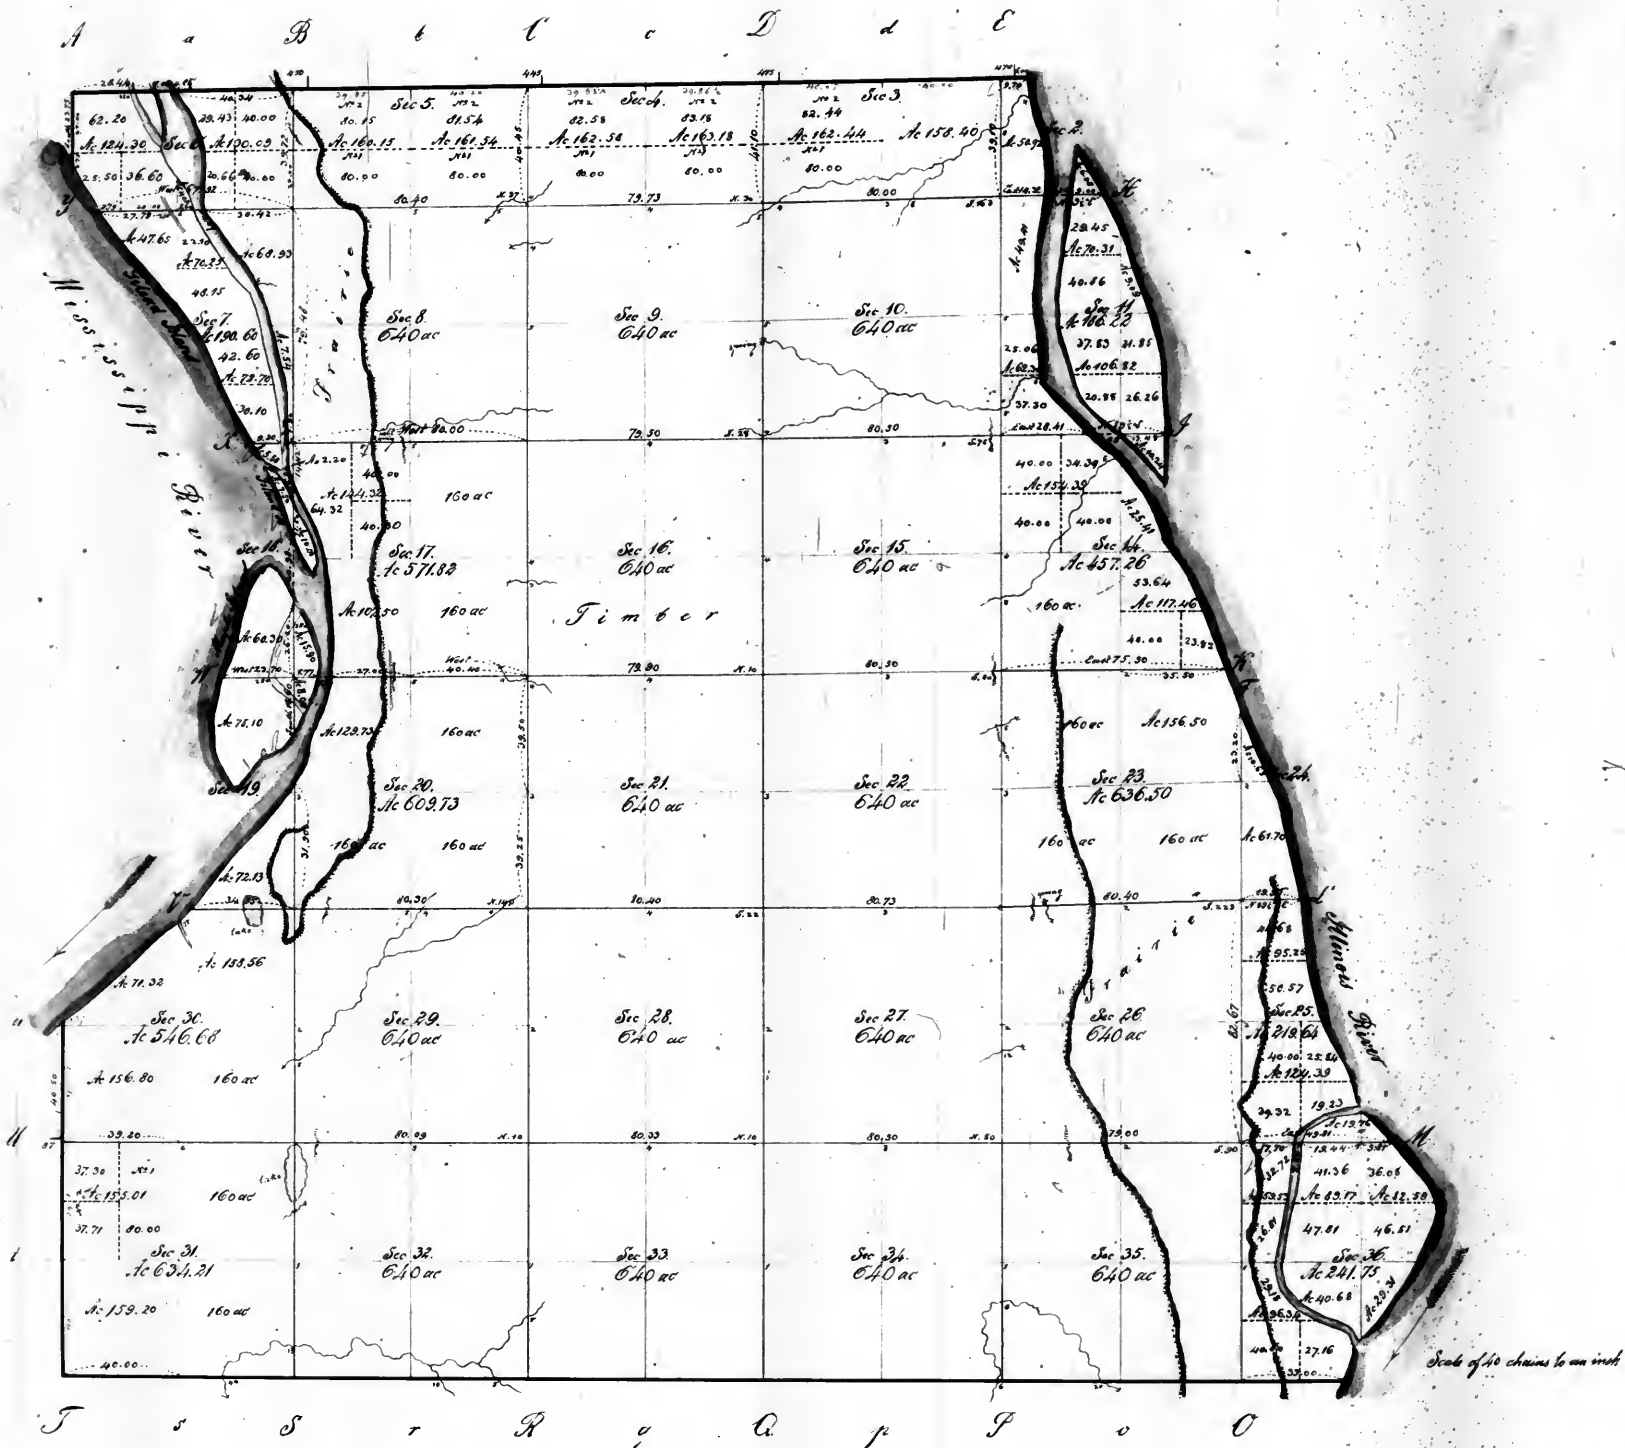

Office of the Surveyor General for Illinois & Missouri.
St Louis 25th February 1857.


The above plat of Township 11 South of the base line and range 2 West of the 4th principal meridian is strictly conformable to the field notes of the survey thereof on file in this office which have been examined and approved. Kappa Island in sections 17, 18, 19 & 20 - A island in sections 17 & 18, and part of Pileat Island in sections 18, 19 & 20 were surveyed in October 1856, by Joseph Duranap, under instructions of the 24th April 1856. The Survey amounts to 18 miles 10.28 chains, which is enclosed in an account, approved by me, receipted for by Duranap, and transmitted this day to the Commissioner of the General Land Office, as per his instructions of the 11th March 1856, for a direct settlement at the Treasury Department, with the Deputy out of the appropriation for the correction of erroneous and defective lines of the public and private surveys in Illinois & Missouri, at a rate not exceeding ten dollars per mile.

A plat of the islands mentioned in the above statement was sent to the Commissioner and another to the Register on the 25th February 1857.

Jno Loughborough
Surveyor General

See new plat

Page 13 no C5

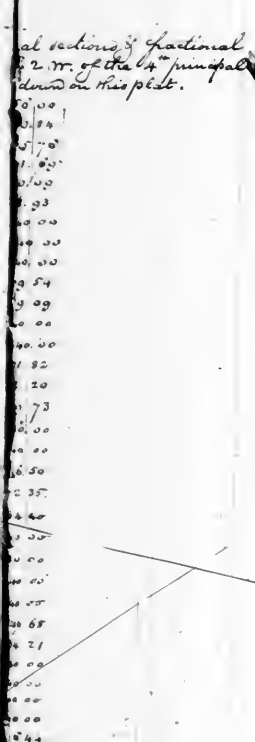

Sumner's Office
St. Louis, 10 Sept. 1844.
Plat of West front half of lot 2, and of Gil. Sects 6, 5 & 11.
26. 254 & 6, and West day to the Corner of the Gal. & O.
St. Louis 27th March 1844
Sold divided under the Act of
1832 the NW. quarter of Sec. 31 on the
line of the plat, on to the City: and another
the Commissioner.

Aggregate area: 15359.22 acres


The above plac is fractional as Imp. 11. S. R. 2. W. of the 4th P. 11. S. R. 2. W. is, conformable to full notes of the Survey, then of (and is a portion of same notes, as stated and explained above), which are now on file in this office.

Wm. Reed
Sr. & Jas. L.

The area of the S.E. of Section 14 has been
from 156.31 to 156.32 Sept 10 1883

page 14

corner in pond witness point
points the rats and 245 lbs
north to another 100% the
call. share

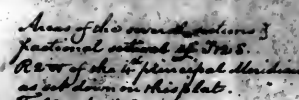

Surveyor's Office
St. Louis, 10th Sept. 1842.
Plat of the Northwest halves of Secs 2, 3, 4
and of the gl. sections 1 & 12 sent this day
the Comr of the Genl & O.

Notes: The distance 9.25 on the line between Sections 19 & 20 is not the true length of that part of land which lies East of the Dayton, but is the distance from the corner of Section 19 to the E. 1/4 of Sec. 20, West to the north-east point on the top of the bluff. To the nearest measurement the distance is 1/4 mi. to the East, east of the Dayton, and to the North, the distance is 200 links West of said bluffs, on the top of the bluff, making the whole length of that part of land here between Sections 19 & 20, which lies East of the Dayton 1/4 of a mile, and on which the area of the flowing fractional Section 19 is

[illegible]

Statement referred to in the receipt
N^o January 1884.



Surveyors Office
St Louis 28th August 1930

The above plat of pt Sup. r. 12 S R. 2 W. of the 4th P.M.
except pt sec 18, - 29, + 32, and the West half of sec 7, and
W half and E 1/4 of sec 6. is conformable to the
field notes of the Survey thereof on file in this office.

Saint Louis 21st of January 1883. This plat was this day completed, by laying down thereon, the tract complete
and, strictly conformable to the field notes of the surveys and ranges recorded as this township, on Nov 1882, by
two co-trustees of the 2^d of March of the same year. They are detailed on the statement on the right, which
being's purview on the 6-ly of the 1st of Jan. 1883 - in all 5 miles x 17 1/2 miles. See for department. Relief, transfer
under the present appropriation for surveying, the whole land of the 2^d quarter of 1883 - and accounts amount
appropriation of \$2000 of the 3^d of March 1881, for surveying, 309 miles of detached and unpatented lands
here (p. 23) also of 2^d Feb. 1866 Congress during the 2^d 15 1/2 miles of 1883.

Aggregated area - { 208852 acres
except Island No 56 }

Deeds of this State to a certain

V McRee
S. J. Paul & Co
J. H. Clifton & Co

Silas Bee

Fractional Townships 13 & 14 South of the Base line Range 2 West of the 4th Principal Meridian;

except fractional Section 2 of Township 14 South which is omitted on account of errors in the survey thereof.


Areas of the several sections of fractional sections of Townships 13 & 14 S. R. 2 W. of the 4th Principal Meridian, as set down on this plat.

Sec 1	640.00
Sec 2	640.00
Sec 3	640.00
Sec 4	640.00
Sec 5	553.22
Sec 6	328.25
Sec 7	640.00
Sec 8	640.00
Sec 9	640.00
Sec 10	640.00
Sec 11	640.00
Sec 12	640.00
Sec 13	640.00
Sec 14	640.00
Sec 15	640.00
Sec 16	604.54
Sec 17	192.68
Sec 18	640.00
Sec 19	640.00
Sec 20	640.00
Sec 21	640.00
Sec 22	459.39
Sec 23	56.49
Sec 24	498.08
Sec 25	642.00
Sec 26	241.14
Sec 27	714.5

Aggregate area of public land in S. 13 & 14 S. R. 2 W. of 4th P.M. = 248.9 ac.
 Aggregate area of public land in S. 13 & 14 S. R. 2 E. of 4th P.M. = 13697.90 ac.
 Total = 13946.28 ac.

Note: The North boundaries of sections 12 & 14 Township 13 South are laid down on this plat according to field notes of the survey thereof, but on without date or signature. The North boundary of section 2 is laid down according to the survey thereof in February 1827 by Dr. Messinger, D.S. The subdivision lines of Townships 13 & 14 S. R. 2 W. are laid down on this plat in conformity with the field notes without signature that are dated 20th March and 1st April 1816; except the lines between sections 21 & 22, 23 & 24, 25 & 26, and 27 & 28 Township 13 South, which are laid down agreeably to the notes of the survey thereof in 1827 by Dr. Messinger who also meandered the Mississippi River along both of these fractional Townships. The several distances on the following named lines, viz. 37.50 on the line between sections 5 & 8, and 50 on the line between sections 1 & 4, 19.24 on the line between sections 27 & 30, 18.66 on the line between sections 21 & 24, and 18.51 on the South boundary of section 35 of Township 14 South, 18.50 on the line between sections 1 & 2 and 22.50 on the East boundary of section 1 of Township 14 S. R. 2 W. are not the whole lengths of said lines respectively, but are the distances on the lines from the proper section corners to the several corner points established on the bluff, to the true places of the fractional section corners on the margin of the River, and to where the meanders were taken, the true places of the corners at the intersections of the before enumerated lines with the Mississippi being the following distances from the several witness points in the direction of the lines towards the River, in the order which the said lines are above enumerated, viz. 0.40 chains, 3.60 chains, 0.70 chains, 2.00 chains, 4.20 chains, 2.00 chains, and 1.00 chains, making the whole length of each of said lines as follows: viz. the line between sections 5 & 8, 97.50 chains; the line between sections 1 & 4, 44.18 chains; the line between sections 27 & 30, 50.00 chains; the line between sections 21 & 24, 50.56 chains; the South boundary of section 35, 20.59 chains; the line between 1 & 2, 72 chains; and the East boundary of section 1, 44.56 chains, and on which the areas of the several adjoining fractional sections were estimated.

Surveyors Office
 St. Louis 13th September 1830
 The above plat of fractional Townships 13 & 14 S. R. 2 W. of the 4th P.M. is made in conformity with the notes of the survey thereof, as explained in the foregoing notice.
 Wm. Rice
 Dr. of Pub. Land

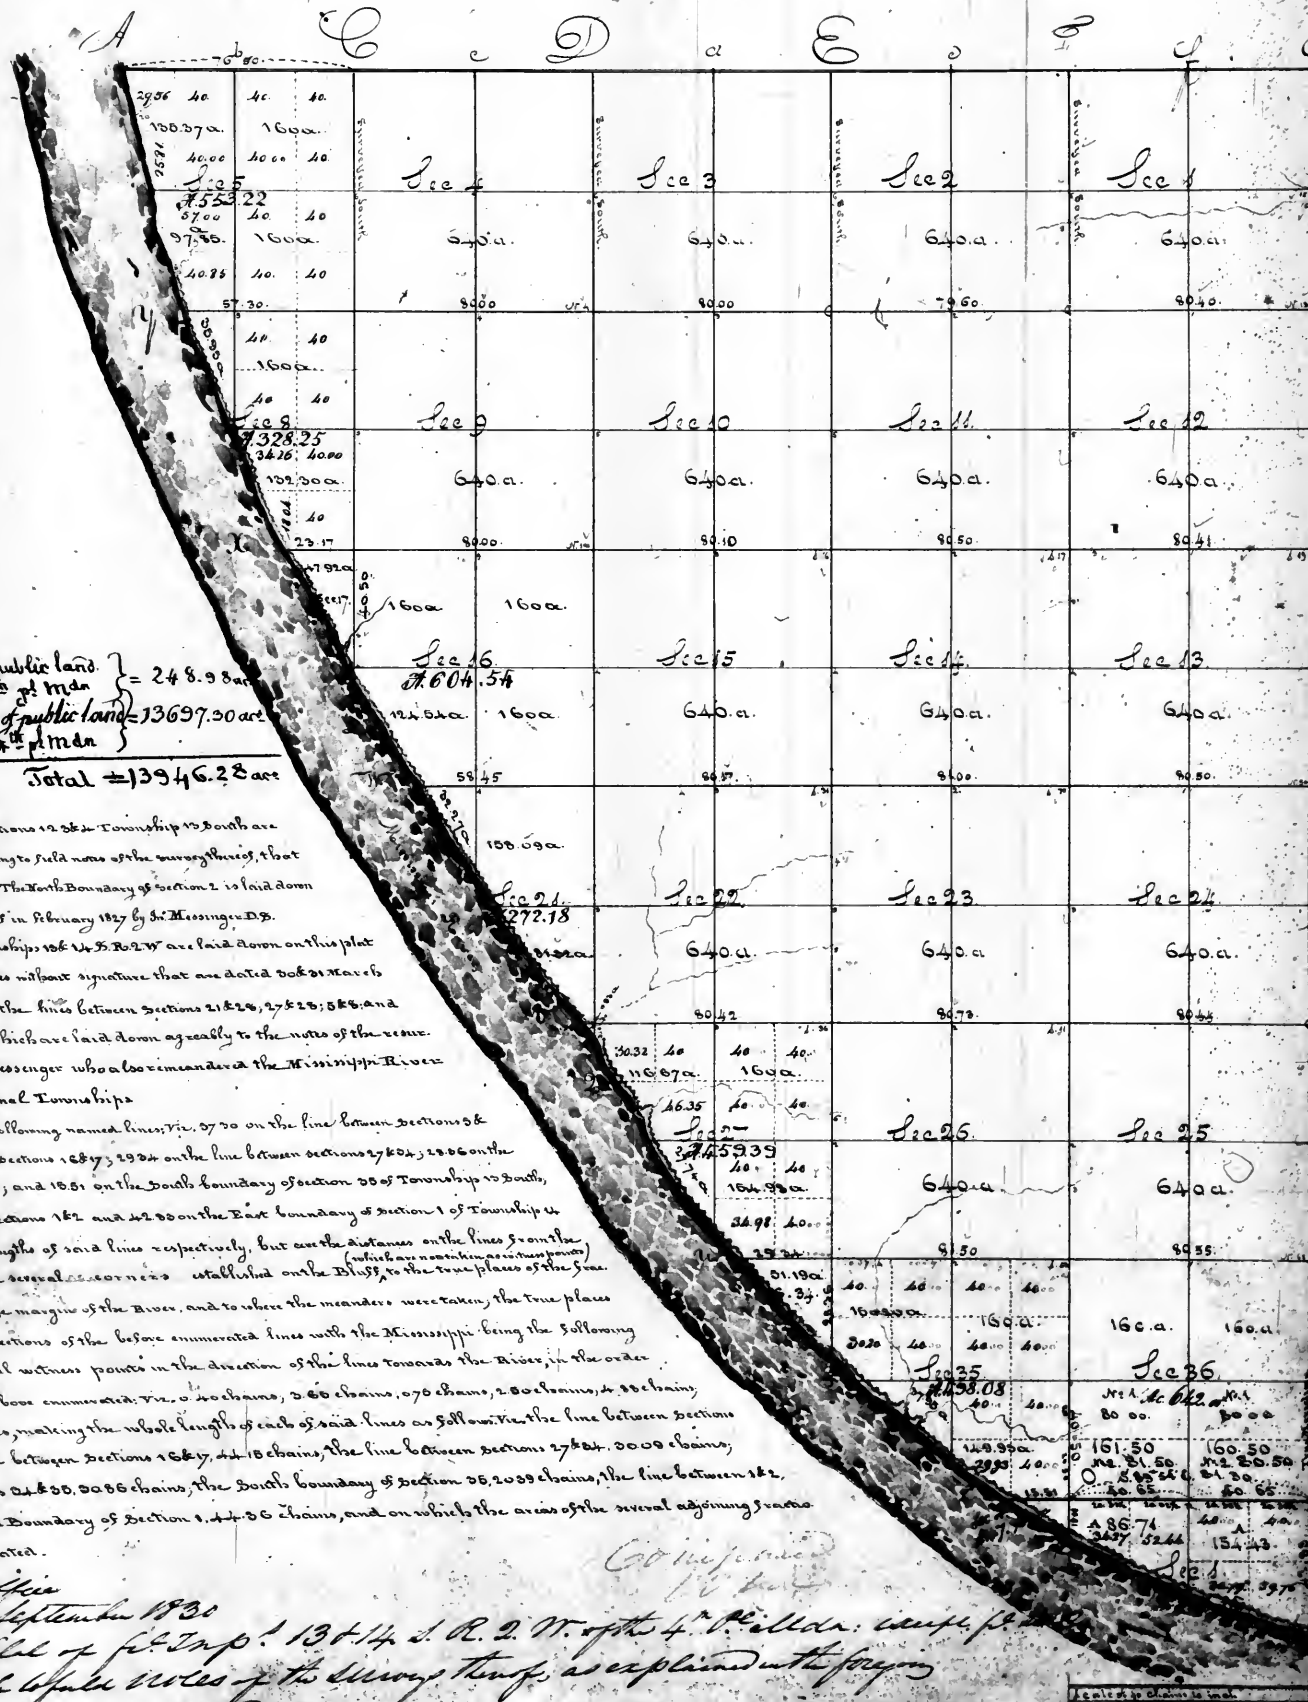


Surveyor's Office
 St. Louis 10th May 1842
 Plat of fractional sections 5 & 17, 23 & 24, 25 & 26, and 27 & 28 of the 4th P.M.


Lines referred to in the Statement below
 S. 13 & 14 S. R. 2 W. of 4th P.M. 1816
 S. 13 & 14 S. R. 2 E. of 4th P.M. 1827
 Number of Sec. 2, 3, 14, 15, 16,

The East Boundary of the Strip (according to the field notes on file) Surveyed South 6 miles and intersected at the S. E. Corner. — The West Boundary (East Boundary of the Strip) was Surveyed South 6 miles, and also intersected at the S. E. Corner.

The field notes of the Survey of the East, West, and South boundary are not signed — but were apparently taken in Nov. & Dec. 1815 by John, or James Mc. Donald.

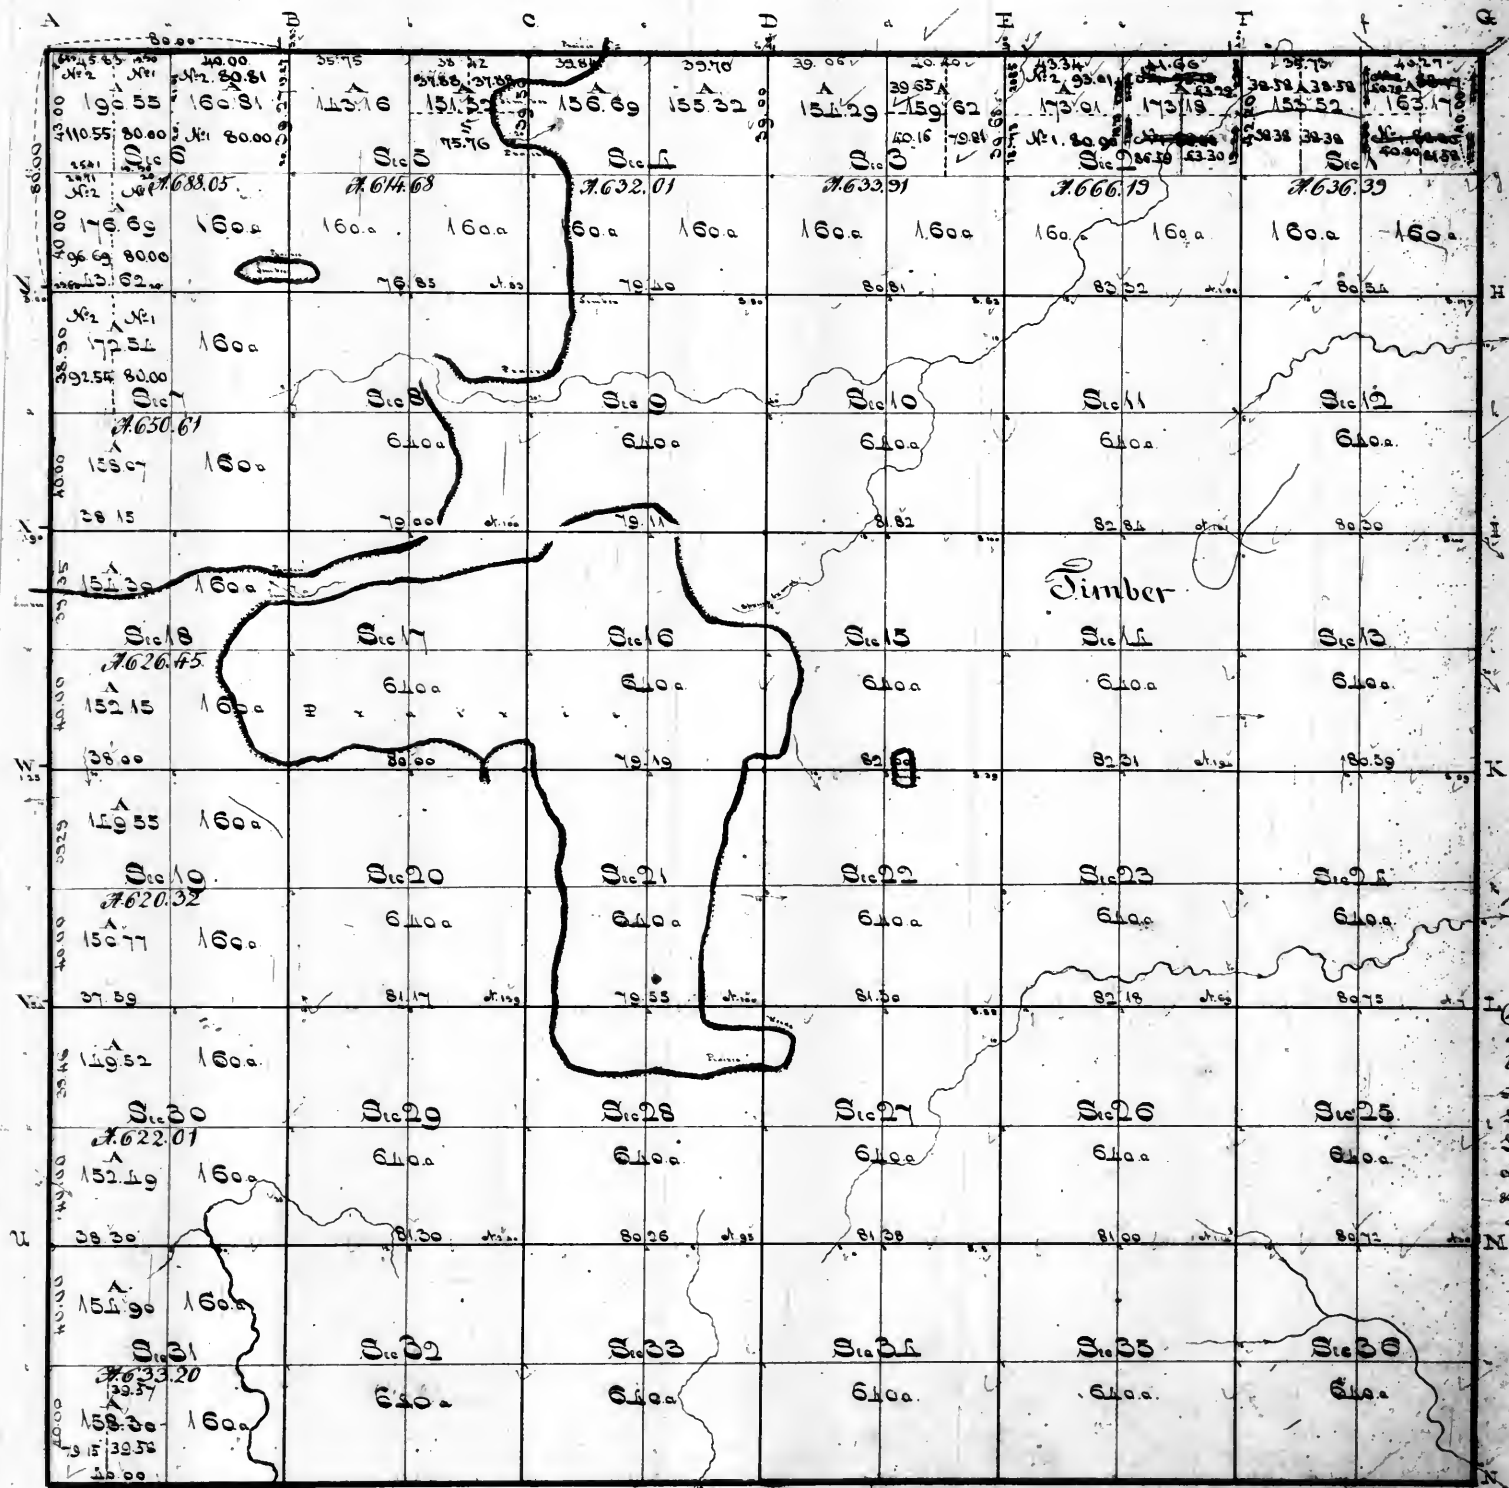


Surveyor's Office
St. Louis 10th Sept. 1862.
Plat of the N.E. q. of Sec. 1, the North
half of Sec. 2, the West half of E
of Sec. 6, 4 of the N.W. q. of Sec. 7,
sent this day to the Comm^{rs} of the
Land O. -

Saint Louis 21.st March 1844.
 Subdivided
 the Oct. of 1832, "as is to conform
 previous sales as reported by
 Register on the 15th August 1843
 art. the Nth of section 31
 . 16 grs. of sub 2 & 3
 and . 111. gr. of section 31
 (and sent to day, copies of the
 one to the Reg^r and another to
 Comm^r?
 Surveyor's office
 St. Louis 15. January 1847
 Subdivided the N. E. q. sec. 5, so as
 conform to a previous sale (marked
 & sent a copy to the Register and
 another copy to the Comm^r and
 the Saint Louis Office

Surveyor's Office
St. Louis 18th September 1830
The above plat, is conformable to field notes & surveys of Township N. 4. E. R. 3 West. (of the 4th P. M. as it is believed), now on file in this office
Wm. Rice
St. J. Pub. Lds.

Township 2 South of the Base line, Range 3 West of the 1st Principal Meridian.

Page 1 of Vol 11

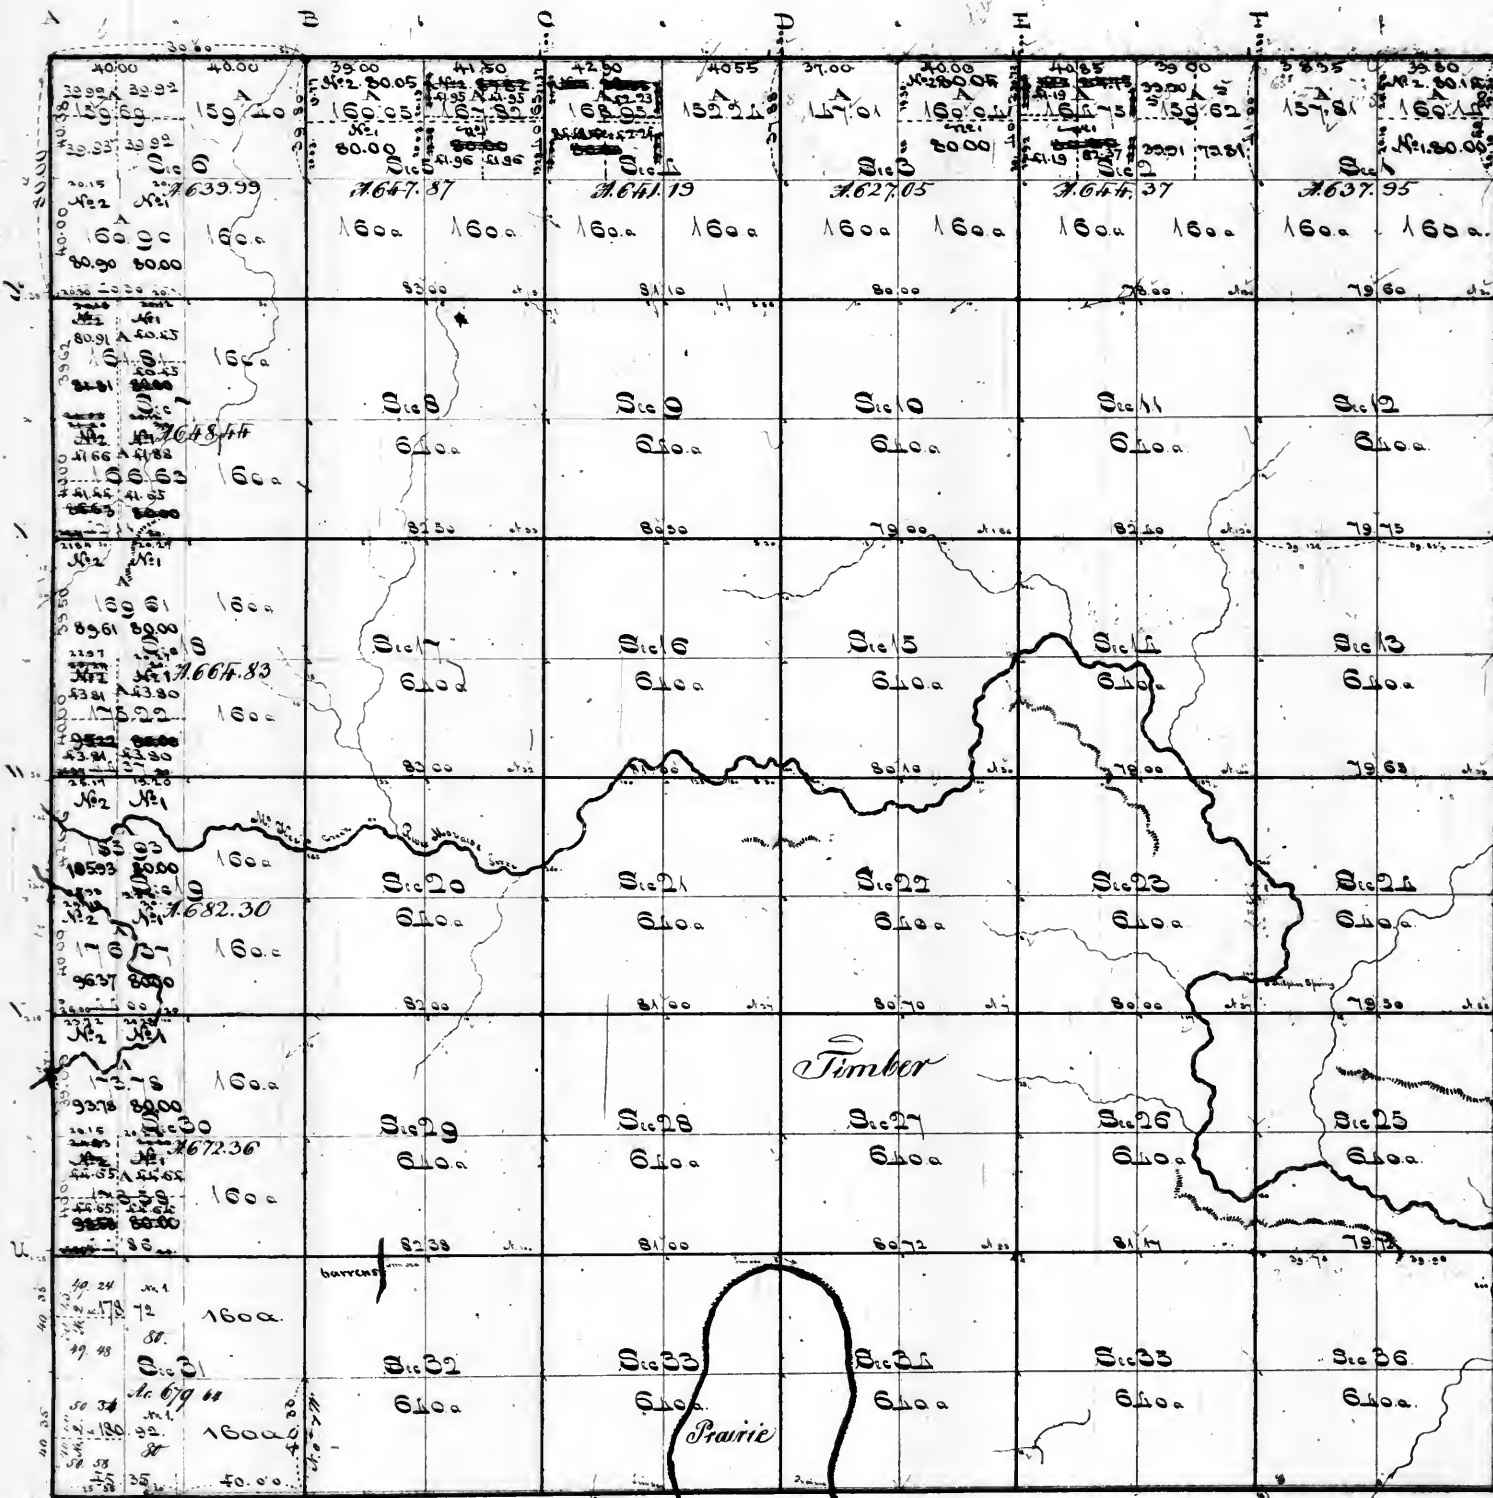

Aggregate area of public land = 23185.99 acres

Surveyor's Office

St. Louis 18th Sept. 1840

The above plat is conformable to field notes of surveys of Imp. No. 2 S. R. 3 West (pts 4th & 5th of Sec. 31) on file in this office. — Wm. M. Rice

Dr. of Pub. Lands

Surveyor's Office, Saint Louis 31st of January 1841.

The above plat was this day completed, strictly conformable to the field notes of the surveys and remeasures in section 31, which are on file in this office, and have been examined and approved. They were executed on April 1843, by J. A. Spaulding, under instructions of the 31st of March 1843; to wit: 40.33 chains on the line between sections 31 & 32, and 1 mile 5.35 chains on the South boundary of section 31, to wit: 1 mile 15.67 chains, which were paid for in the 4th quarter of 1843, and charged to the account current of the Surveyor General, during the same quarter, under the appropriation of \$3000 of the 3rd of March 1841, for surveying 500 miles of unpatented and detached lines in Illinois & Missouri, at a rate not exceeding 60¢ dollars at note. See page 29 acts of the 26th session of the 26th Congress.

Surveyor of the public land in the State of Missouri

The field notes of the North East boundary of the 31st section, were not signed, but were apparently taken by John M. Donald. The West boundary (6.25 S. 2.25 W.) was surveyed South 8 miles & a corner established thereon to Sec. 

St. Louis 21st March 1841. Subdivided under the act of 15th Aug. 1833, to wit: the 1st of section 2, 4 & 6 of act of 18th Sept. 1840, sec. 7 of the 2nd quarter of act of 18th Sept. 1840, the plat was by the Reg. Com. to the Chief of the Genl. & Ind. Office.

Surveyor's Office St. Louis 18th Sept. 1842. Plat of the N.E. quarter of Sec. 14 S. of the N.W. quarter of Sec. 24 S. of the North half of Sec. 5 of the S.W. quarter of Sec. 6 and the West halves of Sec. 7 & 16 1840 sent this day to the Comptroller of the Genl. & Ind. Office.

31st of January 1841. Sent a copy of the plat of section 31 to the Commissioner and the Register at Quincy.

For the money of the West boundary of section 31, the plat of S. 2.25 S. 2.25 W.


Surveyor's Office St. Louis 15 January 1847. Subdivided the N.E. & S.E. 1/4 of Sec. 2, 4 & 6 to conform to previous sales (marked S. 2.25 S. 2.25 W.) sent a copy to the Register & another copy to the Comptroller of the Genl. & Ind. Office.

Township 3 South of the base line, Range 3 West of the 1st Principal Meridian.

Page 18 vol 21

Here. For statements concerning the field notes, and situation, of the survey of the North boundary of this Township, and the establishment of two separate corners to Townships 2 & 3, & 3 & 4, see marginal note on plat of Township 2 S. 3. W. In consequence of the facts, there set forth, the areas of section 6, and the areas of its legal subdivisions cannot be correctly calculated except the south-east quarter. The field notes of the East and West boundaries of this Township are not signed, but those of the East boundary were taken apparently by John McDonald and those of the South and West boundaries apparently by John McDonald.

See for the survey on the N. of sec 6, the plat of T. 2 S. 3. W. The N. 1/2 sec 6 on the W. by of sec 6 (to by sec 1 & 3 R. 4) was paid for by B. A. Spaulding, as the survey on the S. line of sec 32 & 33 of this Township, detached in the Statement of 31st Jan'y 1844.

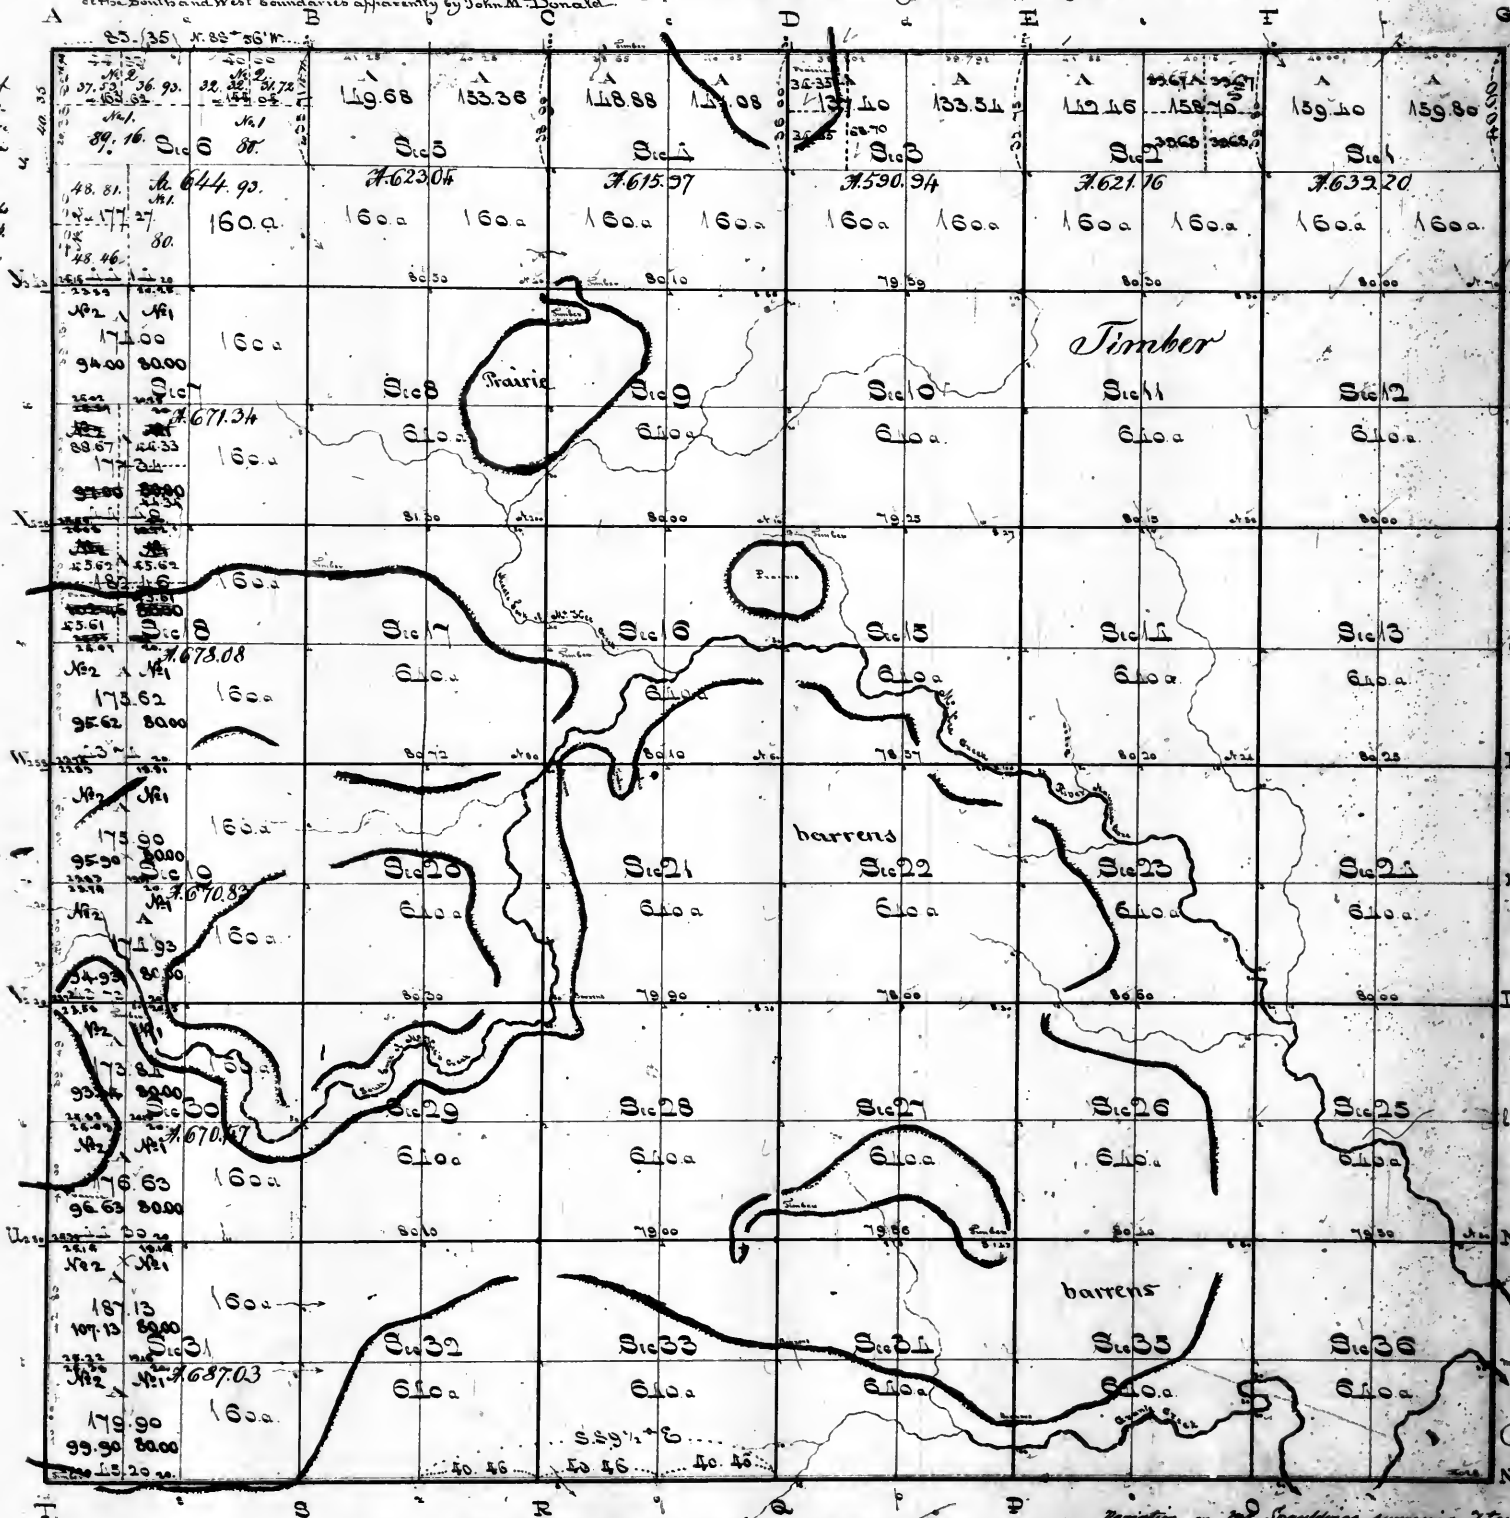

Surveyor's Office Aggregate area of public land - 23112.99 ac

St. Louis 18th September 1830

The above plat, is, (with the exception of the North half, and 1/2 S.W. 1/4 of sec 6,) conformable to the notes of Survey of Twp. 3 S. R. 3 West. (of the 4th pl. Eldon, as is believed), & is filed in this office.

Wm. C. Rice

St. of Pub. Lands

Surveyor's Office. Saint Louis, 21st of January, 1844.


This plat was this day completed, by laying down section 6, strictly conformable to the field notes of the survey and surveys thereof on file in this office, which have been examined and approved. The distance set down on the S. boundary of sections 32 & 33, T. 3 S. R. 3 W., was surveyed by B. A. Spaulding, in April, 1843, under instructions of the 31st of March, 1843. It was paid for in the 4th quarter of 1843, and changed in the account current of the Surveyor General during the same quarter under the appropriation of 500 dollars of the 3rd March, 1844, for completing the surveying of 500 miles of unfinished and detached lines in Missouri & Arkansas, at a rate not exceeding the Dollars a mile. See p. 24 and 25 of the 46th Congress.

Silas Reed

St. Louis, 21st of January, 1844.

S 4 S. R. 3 W. of the 4th p. 16.

See for runways on the north boundary of sec 4 & 5, the plot of S 3 S. R. 3 W.

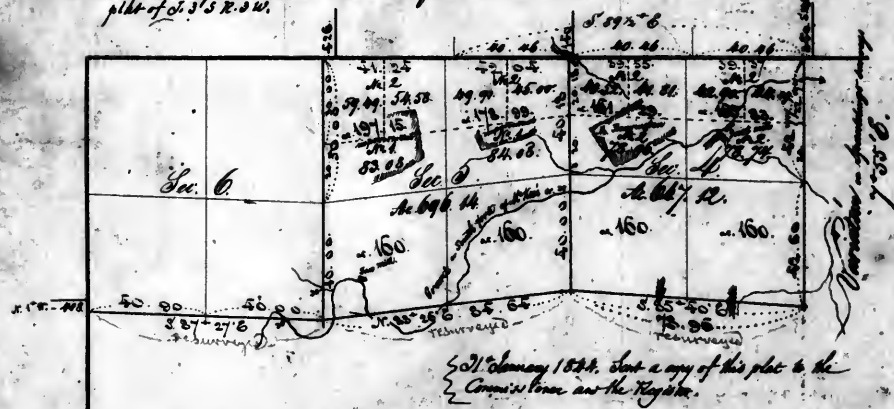

50th January 1844. Sent a copy of this plot to the Commissioner and the Register.

Surveyors' office. Saint Louis, 31st of January, 1844.

The above plot of sections 4 & 5, in Township 4 South of the base line, range 3 West of the 4th principal meridian, is partly conformable to the field notes of the Survey, thereof on file in this office, which have been examined and approved. The said runways were executed in April 1843, by B. A. Spaulding, under instructions of the 31st of March 1842 - to wit: the line between sec. 3 & 4 R. 1. S. 35 - 24.8, 75.35 chs - 1.45 - 1 mile 4.18 chs - 54.2, 1 m. 4.64 chs - 64.7, 1 m. and 30 chs - and 54.6 - 1 m. and 10 chs - in all, 6 miles 20 chs 45 links, which were paid for in the 4th quarter of 1843, and charged in the account current of the Surveyor General, during the same quarter, under the appropriation of \$2000, made on the 3rd of March 1841, for surveying 500 miles of unfinished and detached lines in Illinois & Missouri, at a rate not exceeding 6 dollars a mile. See p. 23 Act 3rd Term 25th Congress.


Silas Reed

Surveyor of the public land in the State of Illinois & Missouri.

Township 4 South of the base line, Range 3 West of the 4th Principal Meridian.

Log 181 100 21

Note

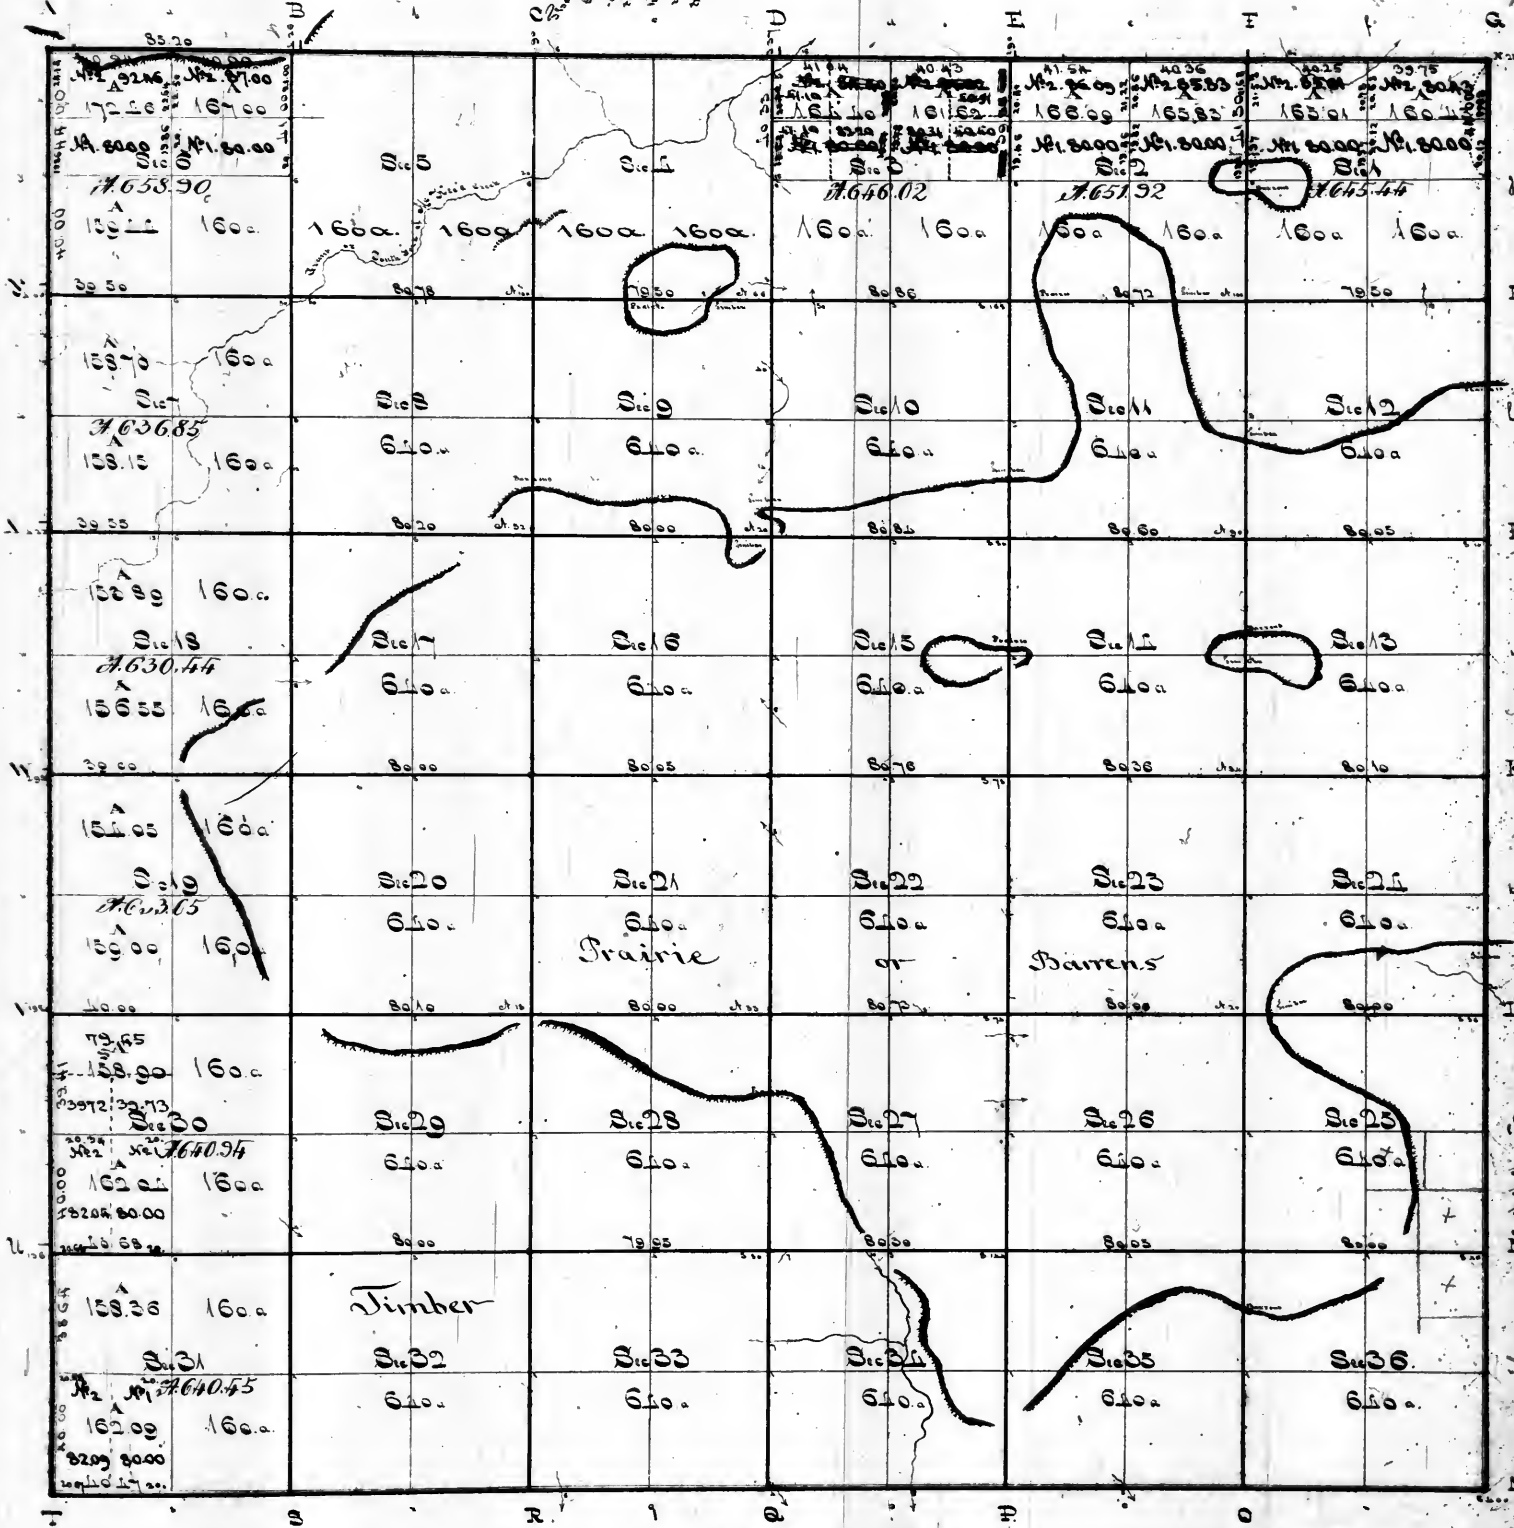

Note.
The field notes of the exterior boundary lines of this Township are not signed, but the last book diary was apparently by John M. Donald, and the North West & South boundaries by John M. Donald.

Scale of 100 chains to an inch
10

Surveyor's Office
St. Louis 11th Sept. 1842
Plat of the North halves of Sec. 1, 2, and this day to the Comptroller of the Genl. Land Office.

Genl. Land Office 21st March 1844
Subdivided under the Act of 1832 so as to conform to previous sales as reported by the Regr. on the 11th May 1843, to wit: the N. W. 1/4 of Sec. 1, 2, 3, and sent to-day copies of the plat to the Regr. and another to the Comptroller of the Genl. Land Office.
Surveyor's Office
St. Louis 15th March 1847
Subdivided the N. W. 1/4 of Sec. 30, so as to conform to a previous sale (marked S) and a copy to the Register & another copy to the Comptroller of the Genl. Land Office.


Examined
W. M. Red

Aggregate area = 23127.27 acres

Scale of 100 chains to an inch

Surveyor's Office
St. Louis 18th September 1830
The above plat, is (with the exception of the North halves of Sec. 4 & 5), conformable to the notes of survey of Twp. N. 4, R. 3, West of the 4th Principal Meridian, as is shown by the original notes on file in this office.
W. M. Red
Sr. of Dist. Sur.

page 20 vol 21

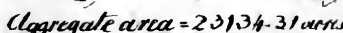


Examined
10. 11. 50.

Surveyors Office
St. Louis 29th September 1830
The above plat, of Twp. N. 5. S. R. 3. W. (of the 4th section as is believed)
is conformable to the field notes of the survey thereof on file in this
office. — W. M. Rice
Sr. of pub. Lands }

Township 6 South of the base line Range 3 West of the 4th principal Meridian.

Page 21 vol 21

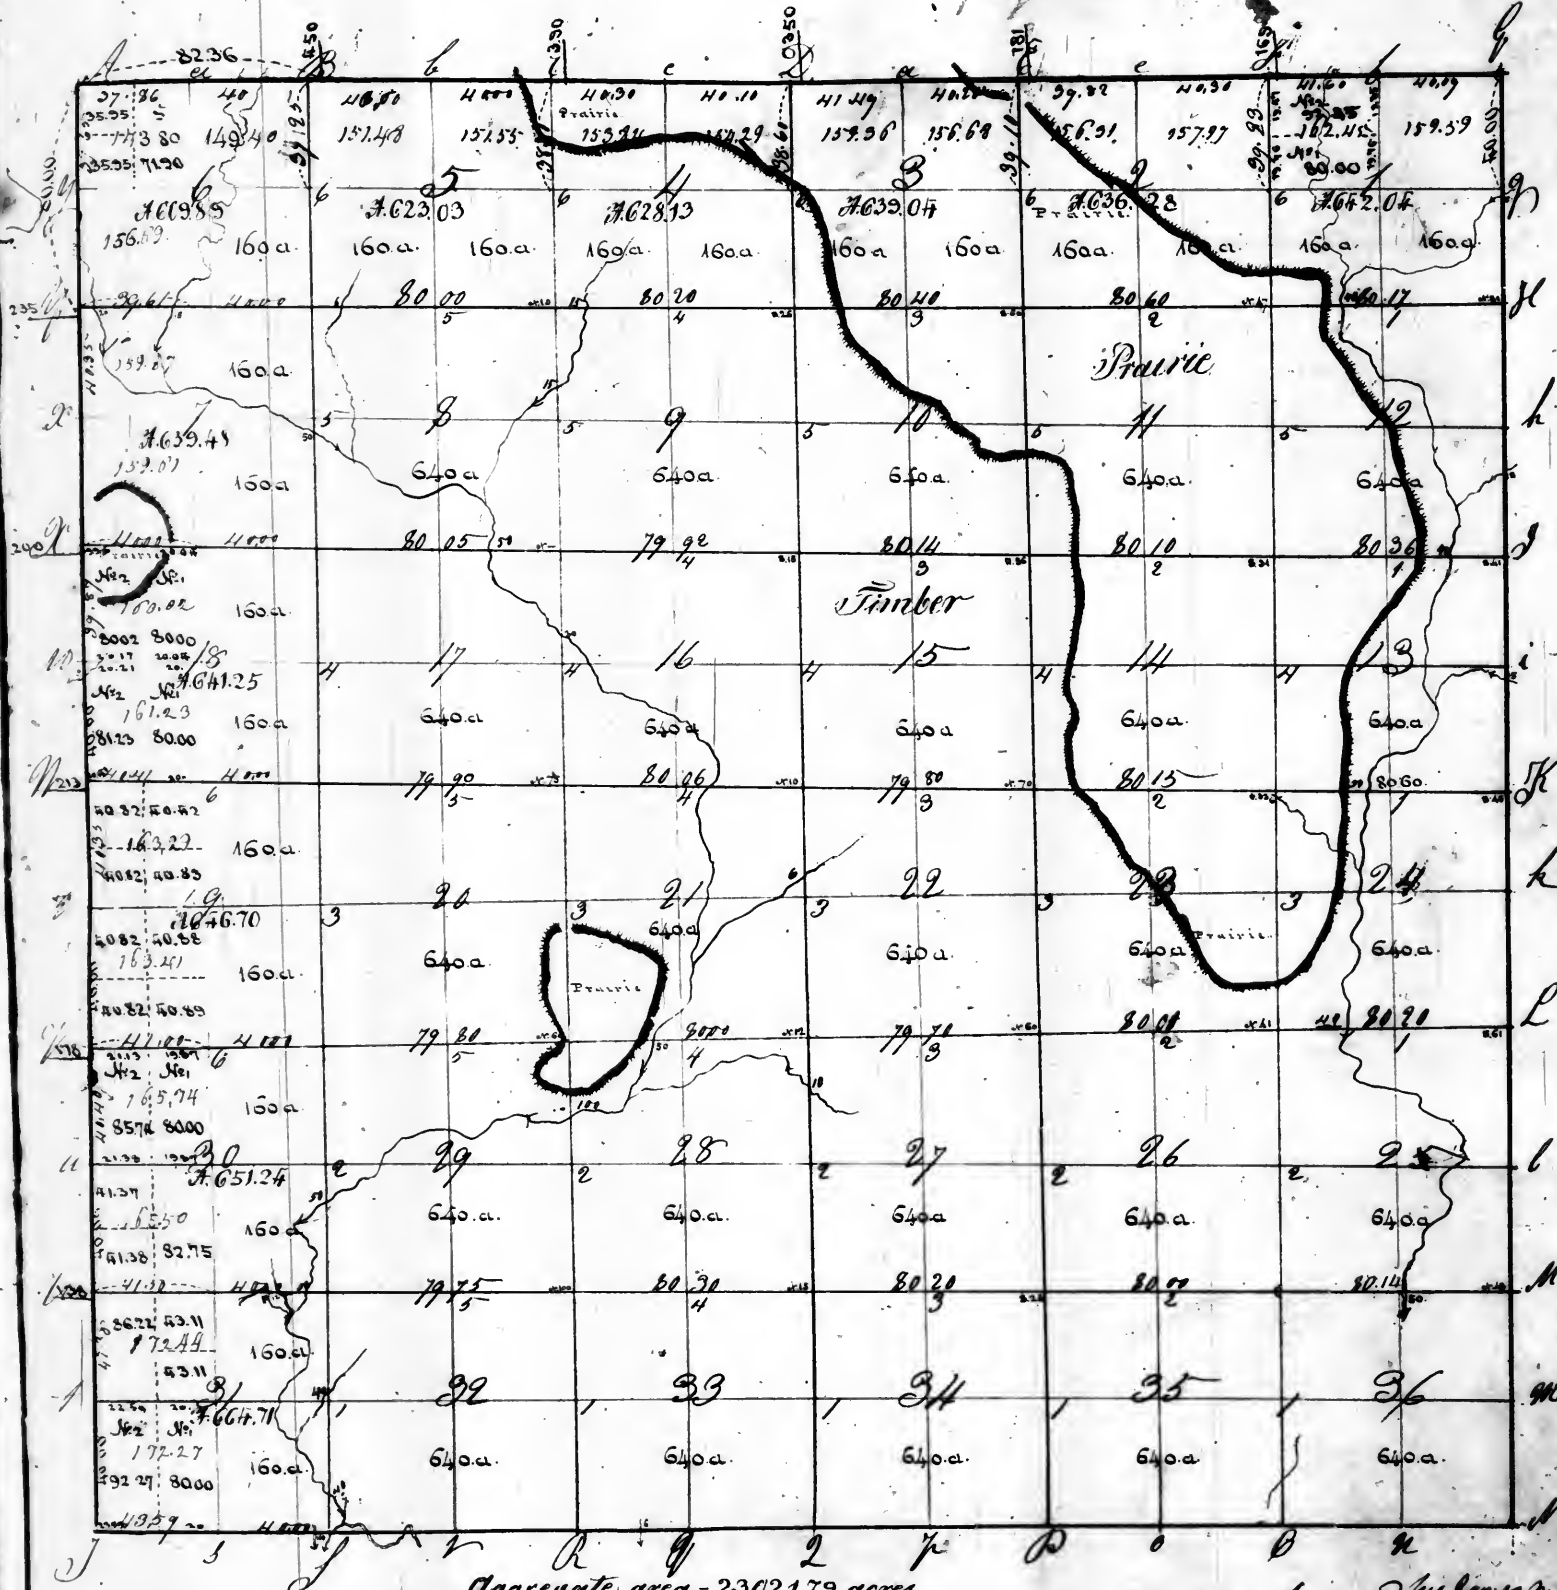

See plat No. 22

Surveyed by James McDonald
 Plat of the N. W. 1/4 of section 15, 16, 17, 1000.

Aggregate area = 23021.79 acres


Township 6 South Range 3 West

Examined by M. Rector

Township 6 South of the base line, Range 3 West of the 4th Principal Meridian.


page 22 vol 21

350
181
2169.

80 60.

11.67-

80/7

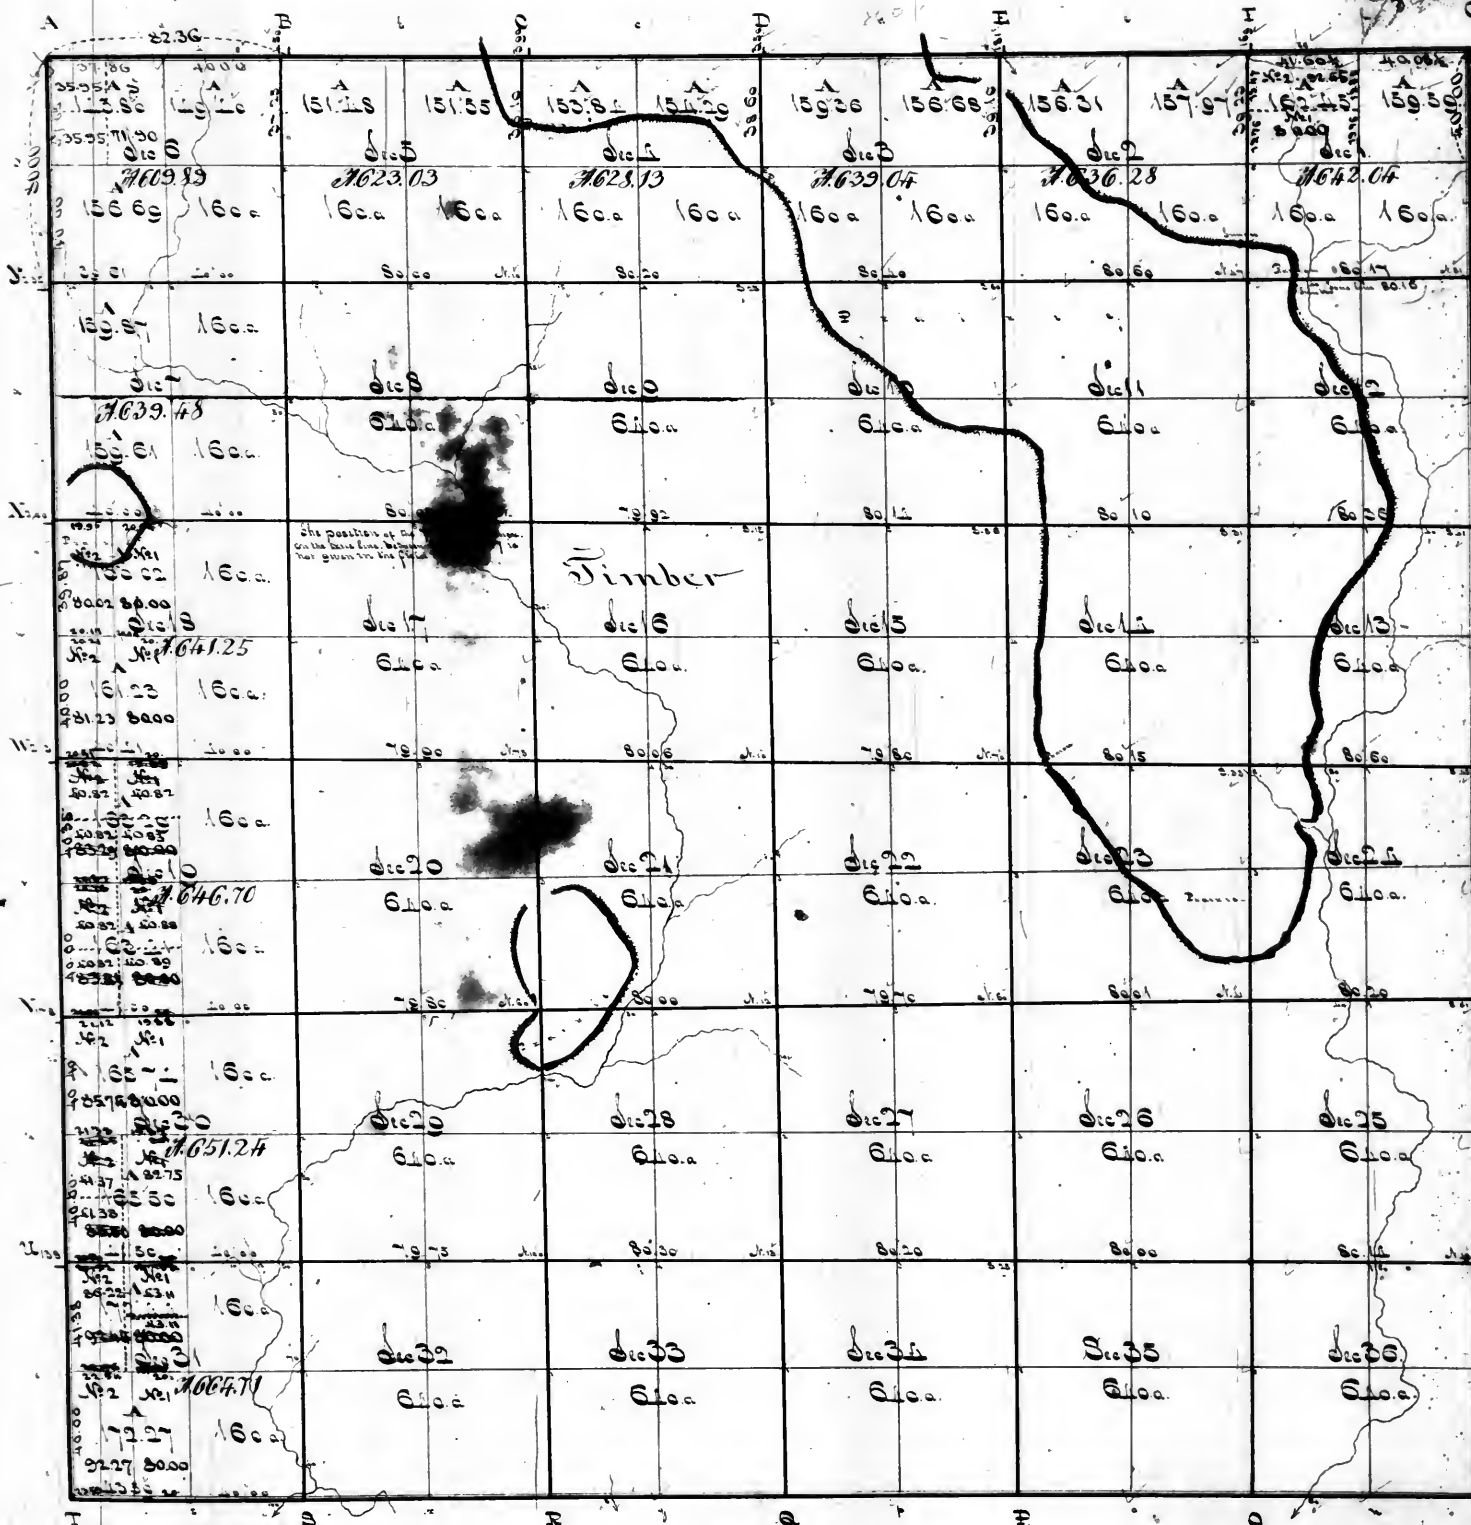

The field notes of the survey of this Township, do not indicate what principal Meridian it is bounded by, and the field notes of the boundary lines are without signature, but those of the East boundary are apparently by Henry Conrad, and those of the West boundary are apparently by John W. Conrad.

Surveyor's Office
St. Louis 15 January 1847.
Subdivided the NW. 1/4 of Sec. 6 as to conform to a previous sale (marked S) & sent a copy to the Register & another copy to the Commr. of the General Land Office.

Surveyor's Office
St. Louis 10th Sept. 1842
A copy of the plat of NW. 1/4 of sec. 1 and of the NW. 1/4 of sec. 18, 19, 30 and 31 was this day sent to the Commr. of the Genl. Land Office.

St. Louis 21st March 1844
Subdivided the NW. 1/4 of 1832 so as to conform to previous sales as reported by the Reg. on the 15th Aug. 1843 to wit the NW. 1/4 of section 19, the NW. 1/4 of sec. 30 and the NW. 1/4 of sec. 31 and sent to-day copies of the plan on to the Reg. and another to the Commr.

Aggregate area = 23021.79 acres

Surveyor's Office
St. Louis 31st September 1830
The above plat of Township T. 6 S. R. 3. W. 4th Principal Meridian, as is supposed, is conformable to the field notes of the survey thereof on file in this Office. — W. W. Conrad
Sr. & J. H. Lee

23.00 21





Surveyor's Office
St. Louis 10th Sept. 1842.
Plot of the North halves of Secs 1, 2, 3, 4, 5,
of the West half N.E. quarter of Section 6, and
of the West halves of Secs 7, 10, 15, 20, 24, 27, 28
this day to the Comr of the Genl L.O.

Saint Louis 2^d March 1844.
 Subdivided under the
 of 1832 so as to conform to previous sales
 reported by the Reg^y on the 15th of Aug.
 to wit: The NW. q^r. of Sth 7. 14 & 20
 the SE. q^r. of Sth 6 and 7
 and, to-day, copies of the plat, one to
 Reg^y and another to the Comm^r.

St. Louis Office —
St. Louis 30th September 1880

The above plat is conformable to the field notes of the Survey of Twp. 22 N. 7. S. R. 3 W. by the 4.th P. Meridian as is supposed on file in this Office. —

Wm. R. R.

Dr. J. Post. Leds. 3

Plat of fractional Township 8 South of the Base line Range 2 West of the 4th principal Meridian.

Page 24 vol 21

8000
775

8775

2


Survey of
St Louis 18th Sept 1842
Plat of the North halves of Secs 1, 2 & 3
North half 4 & 1/4 quarter of section 6 of the
halves of Sec 7 & 8. 4 1/2 acres of the lot Sec 20
21, 22 & 23 sent this day to the Comm.
of the Genl. L.O.

7775

Note
The East boundary of Township 8 S
8000⁰⁰ is laid down on this plat accord-
ing to field notes without any signature
but which are (apparently) by John
James M. Donahoe. The North and
South boundaries of the Township are
laid down in conformity with the field
notes that are without signature except
the South boundary of sections 10, 11 & 12
which is represented on this plat according
to the field notes of John James M. Donahoe
who established a new corner to Section
10 between the Township 8 S and
Township 9 S. The line between
sections 10, 11 & 12 of the Township 8 S
at the intersection of the line between
sections 10, 11 & 12 of the Township 8 S
line in consequence of not finding the
old corner to said sections and there-
fore the said Township line was
run to the Mississippi River in March 1842
The subdivision lines of the Township
are represented on this plat according
to field notes that are without signa-
ture, except the line between sections
10, 11 & 12 and that part
of each of the lines between sections 10
11, and 12 & 13 which lies south of the
North or left bank of Bay creek near
the mouth of the Mississippi River along
sections 10, 11 & 12 and of both banks
of Bay creek through sections 10, 11
12 & 13 which are laid down in conform-
ity with notes of the reconnoissance
made in March 1842 by John
James M. Donahoe.
The figures are set between the 10
on the line between sections 10
11 and 12 Bay creek is not the dis-
tance between the corners represented
by said figures 215 but is the width
of the Bay creek from the corner
represented by the figure 215 between
which and the corner represented by
the figure 2 there is no direct con-
nection - the corner of that part of the
line between sections 10 11 & 12 which lies East
of Bay creek according to estimation
by John James M. Donahoe in 1842 is
at 85.50.2000

St Louis 25th March 1844
Subscribed under the seal of the
to confirm to previous sales as reported by
15th Aug. 1843, N. E. Sec. 19th and today
plat for the Reg^y and another to the
Acres of the several sections of fractional
sections 10 11 & 12 of the 4th principal
meridian as sold on this plat.


| | |
|--------|--------|
| Sec 1 | 696.64 |
| Sec 2 | 765.81 |
| Sec 3 | 755.65 |
| Sec 4 | 811.43 |
| Sec 5 | 891.43 |
| Sec 6 | 926.95 |
| Sec 7 | 715.33 |
| Sec 8 | 640.00 |
| Sec 9 | 640.00 |
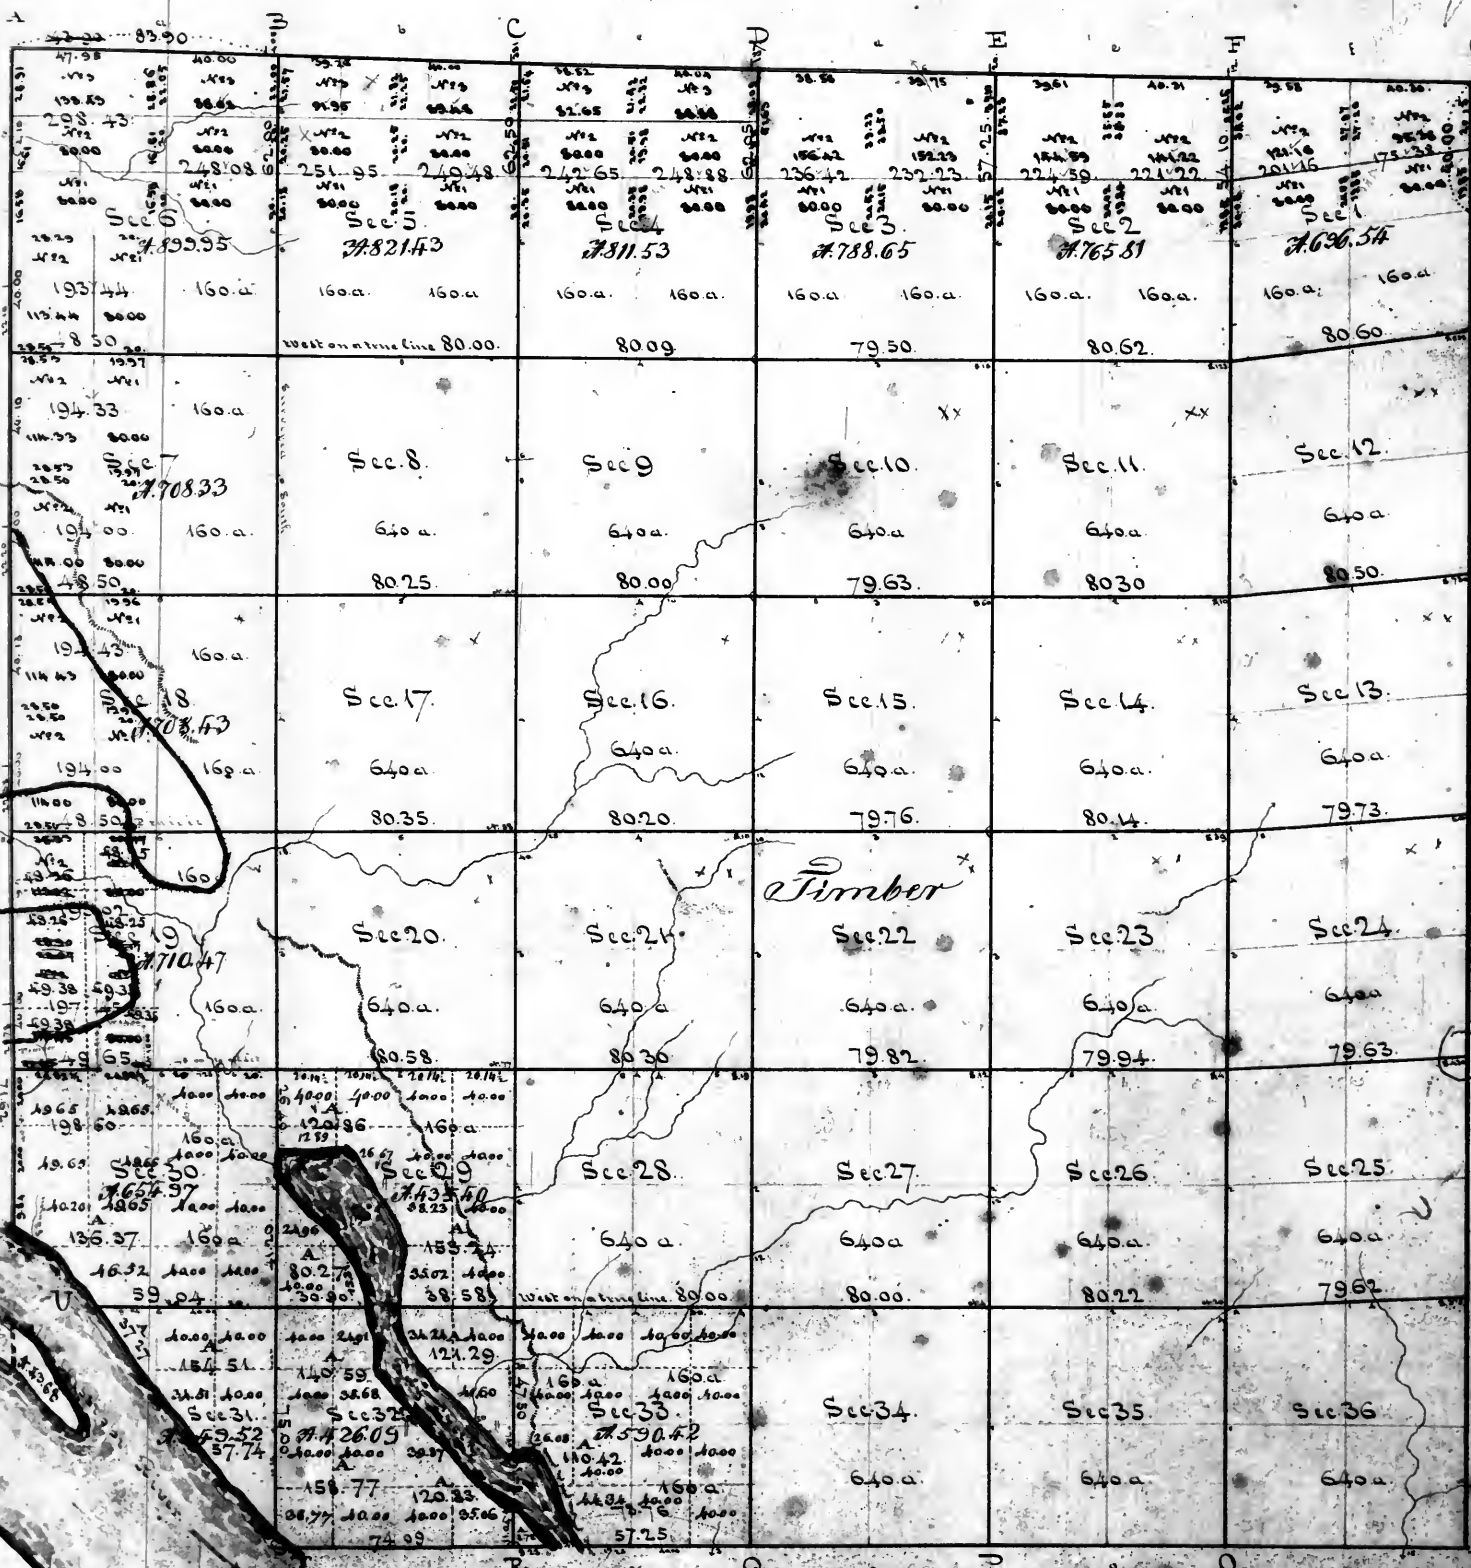

Aggregate area: 23538.56 acres

Surveyors Office
St Louis 18th September 1840
The above plat of 1/2 Trp. 8 S. R. 2 W. of the 4th Meridian is conformable
to the notes & plan of this office in this Office.
Wm. Bee
Sr. of Pub. Land.

T. 9 S. R. 3 W. of the 4th pr. Mer.

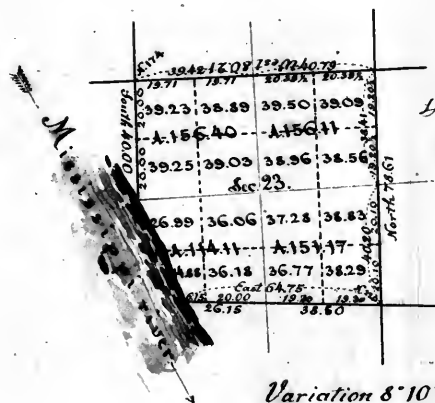

At Louis 18 Sept. 1844 Sent copy of Subdivision
of the S. M. gr. of Sec. 23 to H. J. at Survey at his
request - See list of 29 July 1844

Variation 8° 10' East
Scale of 40 chains to one inch.

Surveyor General's Office
St. Louis, the 20th May 1839

The line between Sections 23 & 26 - 64.76 chains-, and the
line between Sections 23 & 24 - 78.61 chains-, and the line between Sections 14 & 23 - 1 mile and
0.25 chains- and the line between Sections 22 & 23 - 40.00 chains- and the meanders of the
left bank of Mississippi river along fractional Section 23 - 38.07 chains- all in
Township 9 South, Range 3 West of the 4th principal Meridian, are correctly de-
lineated on the above plat, according to the field notes of the resurvey thereof
file in this office, which have been examined and approved. - The said lines were
resurveyed in the 4th quarter of 1836 by Silas Hurd, under instructions from the
Surveyor General, dated the 12th of August 1836, and were paid for in the 4th quar-
ter of 1838, and charged in the account of the Surveyor General for that quar-
ter - Voucher N^o 3. -

William H. Miller
Surveyor General

Note: The line between Sections 14 & 23 - being 1 mile and 0.25 chains - is erroneously stated in the
account to be 1 mile and 0.25 chains. -

Townships 10 & 11 South of the base line Range 3 West of the 4th principal Meridian

T 4 R 3

Note. The dotted line through sections 13, 24 & 25 represents the line of meanders along the slough and the Mississippi river, according to the first survey of the township. That line is retained on this plat as a boundary between the several tracts on the East and those on the West thereof.

Office of the Surveyor General for Illinois & Missouri
St Louis 25 February 1857.

This plat of townships 10 and 11 South of the base line and range 3 west of the 4th principal meridian is strictly conformable to the field notes of the survey thereof on file in this office which have been examined and approved. That part of the two townships which lies south of the dotted line described in the above note is designated as Pileas island, and was surveyed in October 1856, by Joseph Burnap, under instructions of 24 April 1856. The surveying amount in Township 10 to 10 miles 37.48 chains - and in Township 11 to 50.53 chains. It is enclosed in an account approved by me, received for by Burnap, and this day transmitted to the Commissioner of the General Land office, as per his instructions of the 11 March 1856, for a direct settlement at the Treasury Department, out of the appropriation for the correction of erroneous and defective lines of the public and private surveys in Illinois & Missouri at a rate not exceeding \$100 dollar per mile.

Jno Loughborough
Surveyor General.

A copy of this plat was sent to the Commissioner and Register on 25 February 1857



J
H
I
H
K
L
M
N

Scale of 40 chains to an mile

See next plat

Fractional Sections 10, 11, 12, 100

Area of the several sections of fractional sections 10 to 30 of the 4 principal meridians, as contained in this plat.

| | |
|---------------|--------|
| Frac. Sec. 10 | 655.43 |
| Frac. Sec. 11 | 93.78 |
| Frac. Sec. 12 | 60.42 |
| Frac. Sec. 13 | 609.76 |
| Frac. Sec. 14 | 400.51 |
| Frac. Sec. 15 | 127.11 |
| Frac. Sec. 16 | 42.30 |

In consequence of errors in the survey of fractional sections 11 on the main shore of the Mississippi, and of fractional section 12, the area of that part of said fractional section 11 which lies on the main shore of said river, and of the legal subdivisions of fractional section 12 have not been computed and set down on this plat; no part therefore of fractional section 12, nor of section 11 except the Island No. 54 will be offered for sale until the necessary corrections shall have been made of which the Register will be duly notified.

The boundaries of the survey of the exterior lines of the Township are without date or signature except the recovery of the East boundary of sections 10 to 20. And the field notes of the subdivisions are without signature except the recovery of the line between fractional sections 10 to 20.

Surveyors Office
St. Louis 20th August 1853

The above plat of fractional sections 10, 11, 12, 100 is conformable to the field notes of the survey thereof on file in this office.

Wm. C. Rice
Surveyor of the Public Land in the State of Missouri, St. Louis.



Subdivided under the Act of Congress of the 5th of April 1852, and sent copies one to the Register of the District, and another to the Commissioner of the General Land Office.

| Designation of State | Register | Commissioner |
|---|---------------|-----------------|
| Dist. No. 10 | 10th May 1851 | 5th Aug 1851 |
| Frac. Sec. 1, 2, 100 | | 10th Sept. 1851 |
| Island No. 54 | 10th May 1851 | 10th Sept. 1851 |
| Island No. 55 | 10th May 1851 | 10th Sept. 1851 |
31st January 1854. A copy of the plat of sections 10 to 30, sent to the Commissioner of the General Land Office.

Variation on N. 54, Spaulding's surveying 7th East. Aggregate area of public land on main shore 2185. Area on Island No. 54 22. Total 2207.

Surveyors Office, Saint Louis, 31st of January, 1854.

The above plat was this day completed, by laying down, Sections 11 & 12, strictly conformable to the field notes of the surveyors thereof on file in this office, which have been examined and approved, as shown by B. A. Spaulding, on the north of April 1853, under instructions of the 31st of March 1853; to wit: the line between sections 11 & 12, 24 chains, and the meanders of the main shore of the Mississippi river, along sections 11 & 12, 1 mile 6.79 chains in all, 1 mile 50.59 chains. See, for the payment thereof, Voucher No. 10 of account current under the general appropriation, during the 3rd quarter of 1853, and accounts current, during the 3rd and 4th quarters of 1853, under the appropriation of \$3000, of the 3rd of March 1851, for surveying 500 miles of unfinished and detached lines in Missouri by Mississippi, at a rate not exceeding ten dollars a mile. See p. 23 acts of 3rd Sec. 25 Congress.

Wm. C. Rice
Surveyor of the Public Land in the State of Missouri, St. Louis.

Fractional Township 11 South of the Base line Range 3 West of the 4th Principal Meridian

See
on preceding page
New plat



Field notes of Captain Spence
and his detach. Section 25 & 26
signatures and dates of the
surveyors without date.

Surveyor's Office
St. Louis 10th Sept. 1842
Plat of frac. Secs. 25 & 26 sent this day
to the Commr of the Genl. L. O.


Scale of 4000 feet to an inch

Aggregate area = 344.81 acres

Surveyor's Office
St. Louis 28th August 1830³
The above plat of frac. T. 11. S. R. 3. W. of the
4th P. Mer. is conformable to the field
notes of the Survey. Then on file in this
Office. — Wm. Ree
St. Louis 10th Sept. 1842
— St. Louis 10th Sept. 1842

Page 28 of 31

Page 20 Dec 27.
 Plat of Fractional Township 24-12 South of the Base Line Range 1-3 West of the 4th principal Meridian.

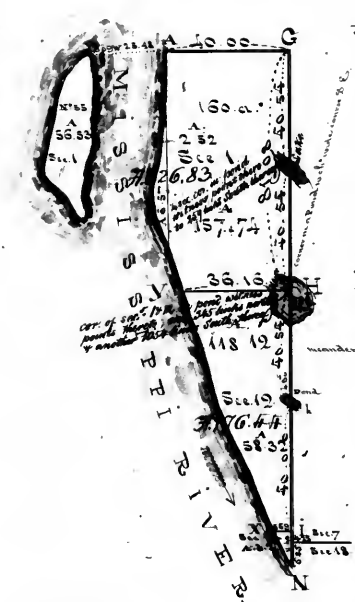

Note
 The East Boundary of this Township was originally surveyed (from a corner established on the River bank) North to 68 chains along the East boundary of Section 16, (commonly called between sections 16 & 18, in ^{the} ~~land~~ ^{lot} 16 & 18 N. E. R. & E. W.) thence it was continued North 2 miles, to where a ^{new} corner was established, but the sections are erroneously called D. 16, 18 & 12, instead of D. 16, 16 & 16, & on the corner the North boundary was surveyed West 5 1/2 ch. to the Mississippi river. The field notes of this ^{original} survey contain no date or signature, and in consequence the said lines are laid down on this plat, except the East boundary of section 16, which is - according to the survey made in 1827 by John Messinger D.S. who did not find the old corner on the River bank, nor did he establish one because the bank was falling fast, and there was no living timber near that place.

The line between sections 12 & 15, was originally surveyed West 5 1/2 ch. to the Mississippi river, where a corner was established, the notes are without date or signature, it is laid down on this plat according to the survey by John Messinger D.S. in 1827 who found no old corner on the River bank nor did he establish one because the River bank was falling in fast and there was no timber near the line between sections 12 & 15, (including the Island N. 56) are laid down according to the survey thereof by John D. Poteet in March 1821.

Areas of the fractional sections
of T12S R3W of the 4th principal
Meridian, as set down on this plat.

| | | |
|--------------|-----|----|
| Final Sec 1 | 328 | 84 |
| Final Sec 12 | 176 | 44 |
| Final Sec 13 | 3 | 24 |
| | 526 | 52 |

Aggregate area of public land on main shore = 326.83 acres
Island No. 55 = 56.53


Total = 383.36 ac.

Surveyor's Office
St. Louis 15 January 1847.
A copy of this plat was
sent to the Commissioner of the
Land Office.

Surveyors Office — 4
 Boston 1 October 1890
 The above plat of lot 12, S. 12. S. R. 3 W. of T. 1 N. is conformable to
 the field notes of the survey thereof (referred to in the marginal notation above),
 and on file in this office. — W. M. Rice

Surveyors' office. Saint Louis 31st of January 1844.
The east boundary of this township, was reserved as a reservation on the above plat; on the 11th of November 1842, by L. A. Spaulding, under instructions of the 31st of March of the same year; on the 1st mile 46.87 chains, &c. See for the payment thereof, Voucher No 10 of account Current, during the 2nd quarter of 1843, and the accounts current during the 2nd and 3rd quarters of 1843, and the special appropriation of \$34000, of the 3rd of March 1841, for ranging 500 miles of detached and encroached areas in Illinois & Missouri.

Silas Reed
Surveyor of the public land in the
State of Illinois & Missouri.

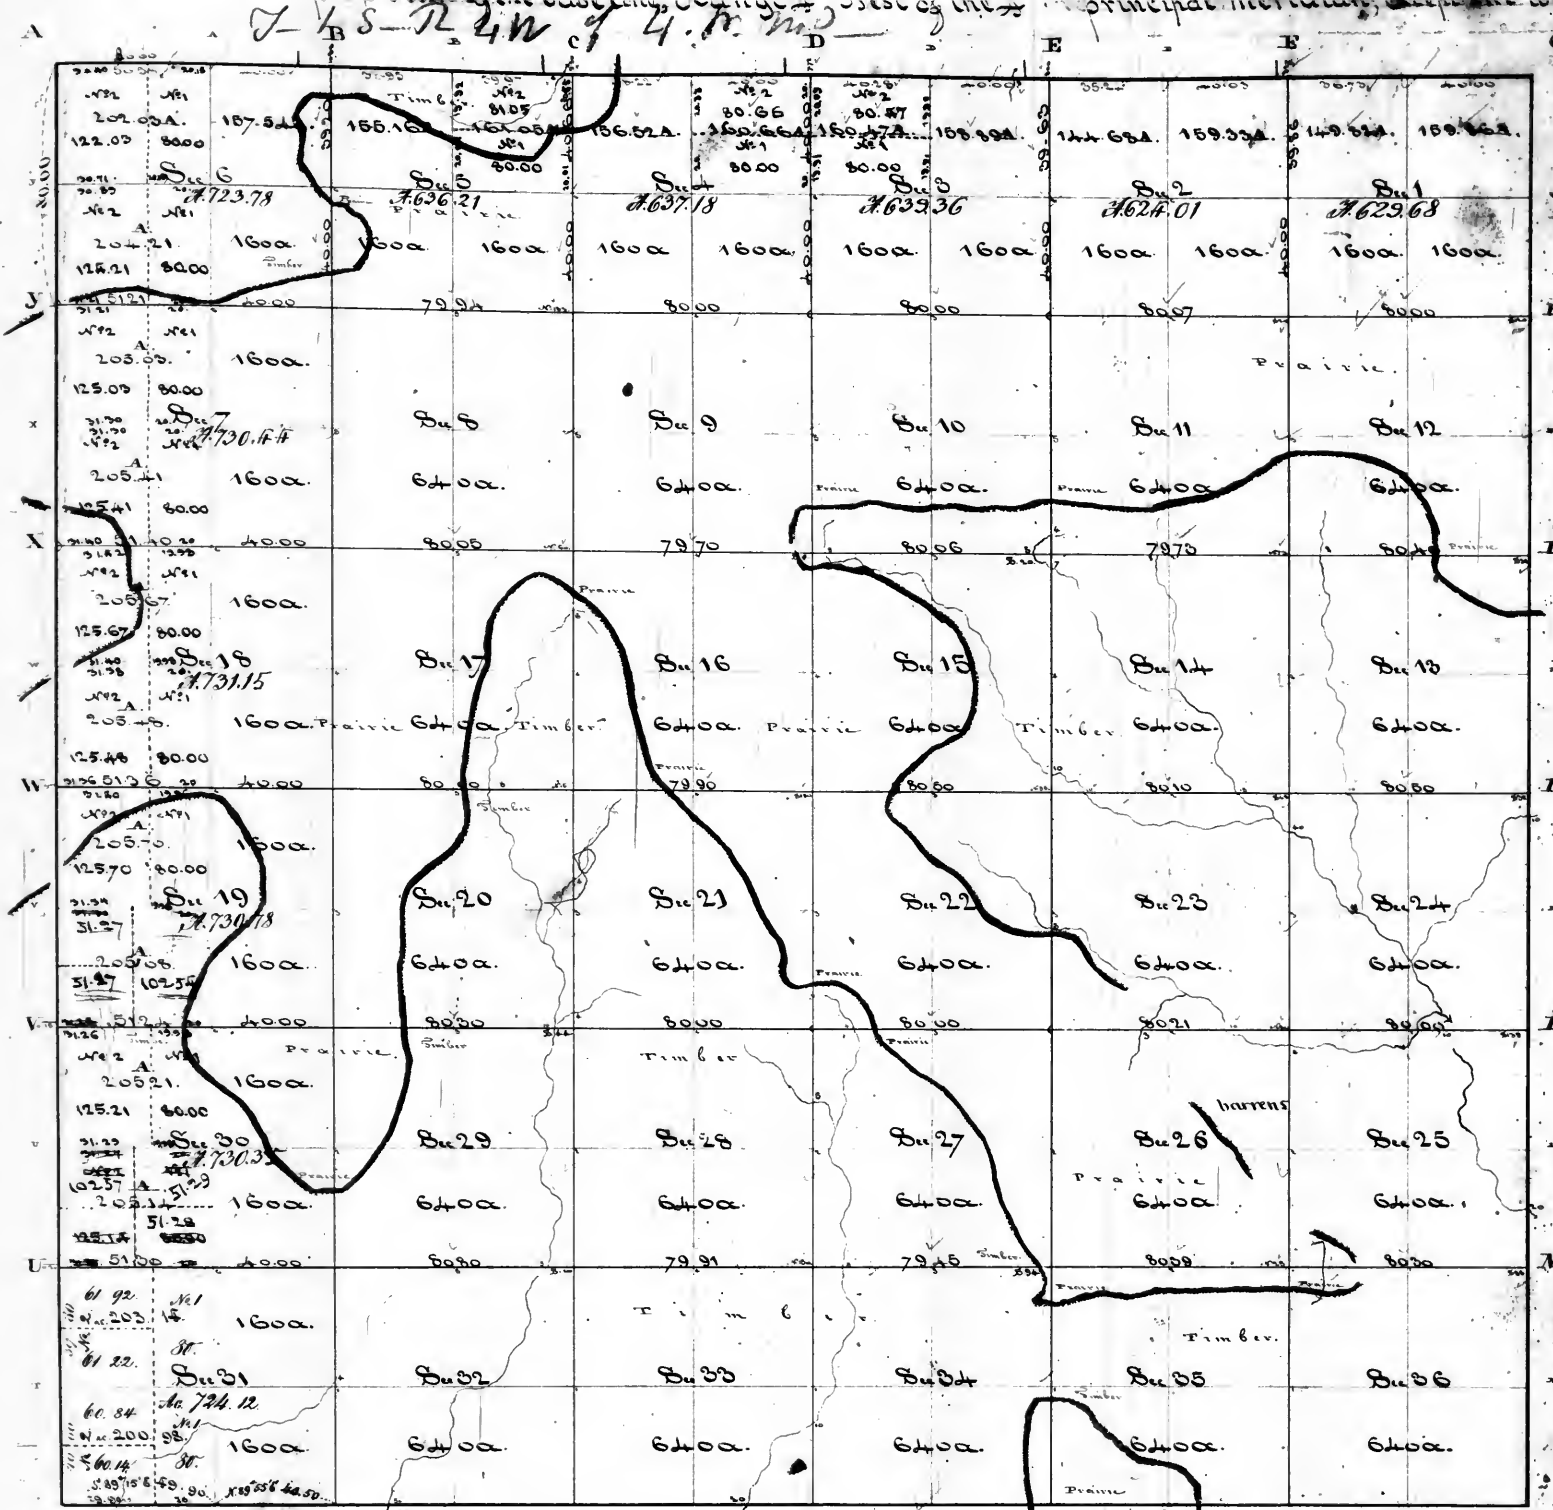

Aggregate area = 23537.06 acres

Surveyors Office
St. Louis 31st October 1830

The Exterior Boundaries and subdivision lines of Township 1 South, Range 4 West, are laid down on the above plat as surveyed according to the following mentioned notes on file in this Office viz

The North Boundary, surveyed West on a true (Bear) line, and the Trip corner established at the end of six miles, the 22nd November 1815, according to notes that are without signature, in Book No 218 of Exterior boundary lines of Townships in Illinois.

The East Boundary, surveyed South, 6 miles, where it intersects the line between Sec 132 South at the corner, according to notes that are without date or signature, but apparently, by John or James C. Donald in Nov^r or December 1815, in Book No 211 B of Exterior boundary lines of Townships in Illinois.

The South Boundary, surveyed West and the Trip corner established thereon at the end of six miles (laid down on the plat only as far West as the 14th Sec. cor on the South side of Sec 31) according to notes that are without date or signature, but apparently by John or James C. Donald in November or December 1815. The Township corner established at the West end of this Boundary, differs materially from the description given of the cor. established at the South end of the West Boundary of the Trip; there is no ascertained connection therefore between the two lines.

The West Boundary, surveyed South, and Trip corner established thereon at the end of six miles the 30th January 1817; is laid down on the above plat (only as far South as the intersection therewith, of the line between Sections 30 & 31) according to the notes of John C. Donald. For further particulars concerning this Boundary, see statement on the plat of Township 1 South Range 5 West.

The Subdivision lines, surveyed in Dec^r 1816 and January 1817, according to notes that are apparently by two or more persons and are irregularly dated, and entered in a field Book, signed by James C. Donald. The latest date, in the book is January 5th 1817 and occurs at the end of the notes of the line between Sec 5 & 6. But the survey or re-survey of the West Boundary of the Trip as above stated, was not made according to the notes until the 30th January of the same year. more than three weeks after the surveys of the East & West Sec lines in the Western tier of Sections; hence it would appear that the said East and West section lines, must have intersected and been connected with a prior survey (there having been two previous surveys made) of the Range line, and not with the survey thereof made on the 30th January, as laid down on this plat, and on the plat of Trip 1 South, Range 5 West. - nevertheless, as the distances on the East & West section lines before mentioned, have all been evidently altered in the field notes, as also, the descriptions of the corners established at their respective intersections with the Range line, except of the corner to Sec 18 & 19 which is "a mound" and is left unaltered in the notes - and except that the intersections with the Range line, of the lines between Sec 7 & 8 and 6 & 7, are also left as originally described. each of said lines intersecting "at the corner" It is probable that subsequent to the re-survey of the Range line, the previously surveyed section lines, were extended to their respective intersections with the new line, and that instead of taking separate notes of these corrections, the Deputy Surveyor had contented himself with altering the original entries in his notes of the said section lines, where ever the new connections made it necessary to do so; It is upon the strength of this hypothesis that the said section lines, where ever the halves of the Western tier of Sections (except of the West half of Sec 31) have been recalculated, are left, as found upon two unauthenticated plats on file in this Office which were probably returned by the Deputy Surveyor, with the field notes of the Trip surveys; one of said plats after having been corrected, was this day issued to the Register with the foregoing statement of facts for the purpose of obviating misconception, and for the special information of purchasers, the other remaining on file in this Office. The survey of Trip 1 S. R. 4 W (except the North boundary) are not in the field notes, and are referred to any printed map, and the old plat on file (which is without date or signature) refers to the principal meridian.

Surveyors Office
St. Louis 10th Sept. 1831.
Plat of the N. W. 1/4 of Sec. 3, of the N. E. quarter of Sec. 145, and of the West halves of Secs 6, 7, 10, 15 & 20, this day to the Comm^r of the Gen^l.

St. Louis 21st March 1834.
Subscribed
the Act of 1832, so as to provide for the sale, reported by in 1835, Aug. 1833 viz:
the N. W. quarter of Sec. 14, and said copies of the plat, are to the Reg^r, and under the Commission^r of the Gen^l Land Office.

31st January 1834, Sent a copy of plat of Sec 31 to the Com^r of the Register.

Variation in the plat of Sec 31, surveyed by J. C. Donald.


Surveyors Office, St. Louis 31st of January 1834.

The above plat of Township 1 South of the line line range 4 West of the 4th principal meridian, was this day completed, by laying down Section 31, the only conformable to the field notes of the survey of the South boundary of the said section, which are on file in this Office, and have been examined and approved. This survey, 1 mile 10 1/2 chains, was executed in April 1833, by B. A. Spaulding under instructions of the 31st of March 1832 - it was paid for in the 3rd quarter of 1833, and charged in the account current of the Surveyor General, during the same quarter, under the appropriation of \$3000, made on the 3rd of March 1831, for surveying 300 miles of detached and unprized lines in Illinois to measure, at a rate not exceeding 50 dollars a mile. See page 20 of acts and resolutions of the 3rd session of 36th Congress.

Wm. H. R. Lee
J. C. Donald

Silas Reed

S. 2. S. R. 4 W. of the 4th p. M.

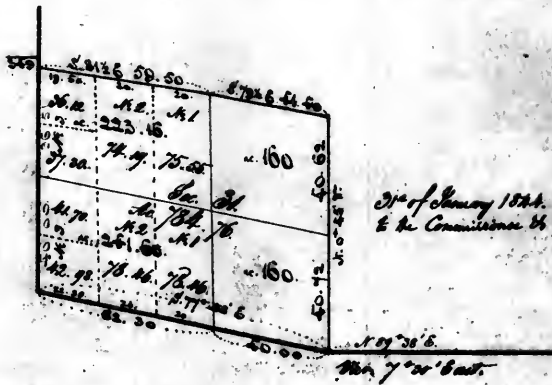

31st of January 1844. Sent a copy of this plan to the Commissioner of the Register.


Surveyor's office, Saint Louis, 31st of January, 1844.

The above plat of Section 31 Township 2 South of the base line, range 4 west of the 4th principal meridian, is mostly conformable to the field notes of the survey and returns thereof, on file in this office, which have been examined and approved. The said surveys were executed in April 1843, by D. A. Spaulding, under instructions of the 31st of March 1842. to wit: the line between sections 31 & 32, S. of 1/4 sec. corner to 12 chains - the line between sections 31 & 32, 1 mile 20 3/4 chains and the South boundary of section 31, 1 mile 22 3/4 chains, - in all, 3 miles 3 3/4 chains, which were paid for in the 4th quarter of 1843, and charged in the account current of the Surveyor General, during the same quarter, under the appropriation of \$5,000, of the 3rd of March 1841, for surveying 500 miles of unfinished and detached lines in Illinois & Missouri, at a rate not exceeding five dollars a mile. See page 29 of act of regulations of the 2nd session of the 26th Congress.

Silas Reed

Surveyor of the public lands in the State of Illinois & Mo.

S. 19° 16' E. 49.90' N. 89° 55' E. 40.50'

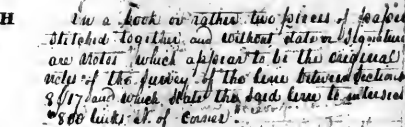

The 30.70 chains on the E. by of the S.E.
were surveyed in April 1843, by D. A. Spaulding
and our teachers of the 3rd of March 1842. See
for the payment thereof, account current paying
the 4th of 1843, under the appropriation of
\$3000. of the 3rd March 1841.

Surveyor's Office
St. Louis 10th Sept: 1842

Plots of the N.W. q. of Sec. 1, of the North halves of
Secs 34 & 35, of the N.E. q. of Secs 5 & 6, and of the
West halves of Secs 7, 10, 13 & 15 sent this day to
the Comptroller of the Genl. Land Office.

St Louis 24th March 1844.

Published under the Act
1832 so as to conform to former sales,
by the Reg^t on the 15th Aug. 1848, viz:
the N.W. gr. of sec. 4.
the N.E. gr. . . . 5 (am)
the W² of section 30.
(am) sent to-day copies of the plat on to
Genl. & another to the Comr.

Aggregate area = 23901.35 acres

Surveyor's Office, New, October 7, 1886

The North boundary of Township 2 N. R. 1 W. as far West as the 1/2 Sec. E. on the South side of Sec. 31 is laid down on the above plat, according to the field notes of a survey thereof, without date or signature, but apparently by John McDonald in Sept. 

The South boundary of J. & C. D. W. is therefore laid down according to the field notes as just above stated, leaving the line West of the 1/2 Sec. E. on the South side of Sec. 31 undetermined.

The point of intersection of the North with the West boundary of the Tract, is also problematical, and is not set down on the above plat: the areas of the North halves of Sec. 31, 32, 33, 

31st January 1844. Sent to the Commissioner and the Registrar a plat of section 6.


Surgeon's office.
31 January 1864. Saint Louis.
Section C was this day laid down, strictly conforming
the field notes of the surveyors of its North and East
sides are on file in this office and have been examined
and approved. It was executed in April 1863, by
Hawling under the instructions of the St. Louis Board.

Silas Reed

Variation of
 land in the
 Or. M. H.
 Variation in Mr. Spaulding's survey
 Or. M. H.

Surveyor of the
Lands in the State
of Michigan

See for runways on this northern line, the plot
of Section 31. & 23. 24.

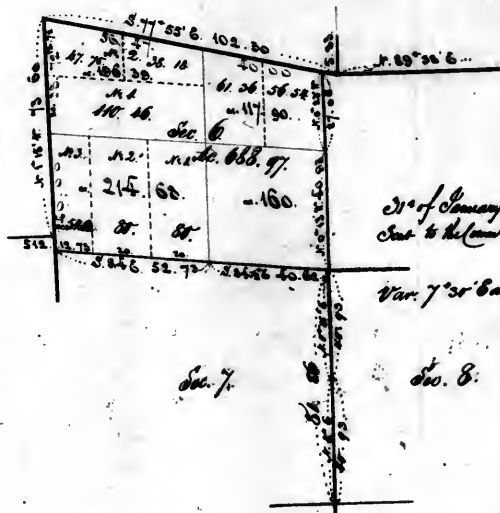

See plat of I. S. S. R.
S. W. for rearrangement
this western line.

21st of January 1844. a copy of this plan
sent to the Commr. and the Register.

Var. 7°35' East

Sec. 7.

Dec. 8.

Surveyors' office. Saint Louis, 31st of January, 1844.


The above plat of section 6, Township 3 South of the base line, range A west of the 4th principal meridian, is strictly conformable to the field notes of the surveys and runways thereof on file in this office, which have been examined and approved. The said runways were executed in April 1843, by D. A. Spaulding, under his directions of the 31st of March 1842. to wit: the line between sections 6 and 7 - 1 mile 13.35 chains - the line between sections 5 & 6 - 67.33 chains - and also the line between sections 7 & 8, 1 mile 1.86 chains - in all, 2 miles 3.20 chains, which were paid for in the 4th quarter of 1843, and charged to the account current of the Surveyor General, during the same quarter, under the appropriation of \$3000 of the 3rd of March 1834, for clearing 500 miles of detached and unimproved lines in Illinois & Missouri, at a rate not exceeding ten dollars a mile. Two pages of acts and resolutions of the 2^d session of the 26th Congress.

S. J. Reed

Silas Reed
Surveyor of the public land in the
State of Illinois and Missouri.

Lat of Township 3 South at the Base Line Range 4 West at the Principal Meridian.

Page 31 of 41

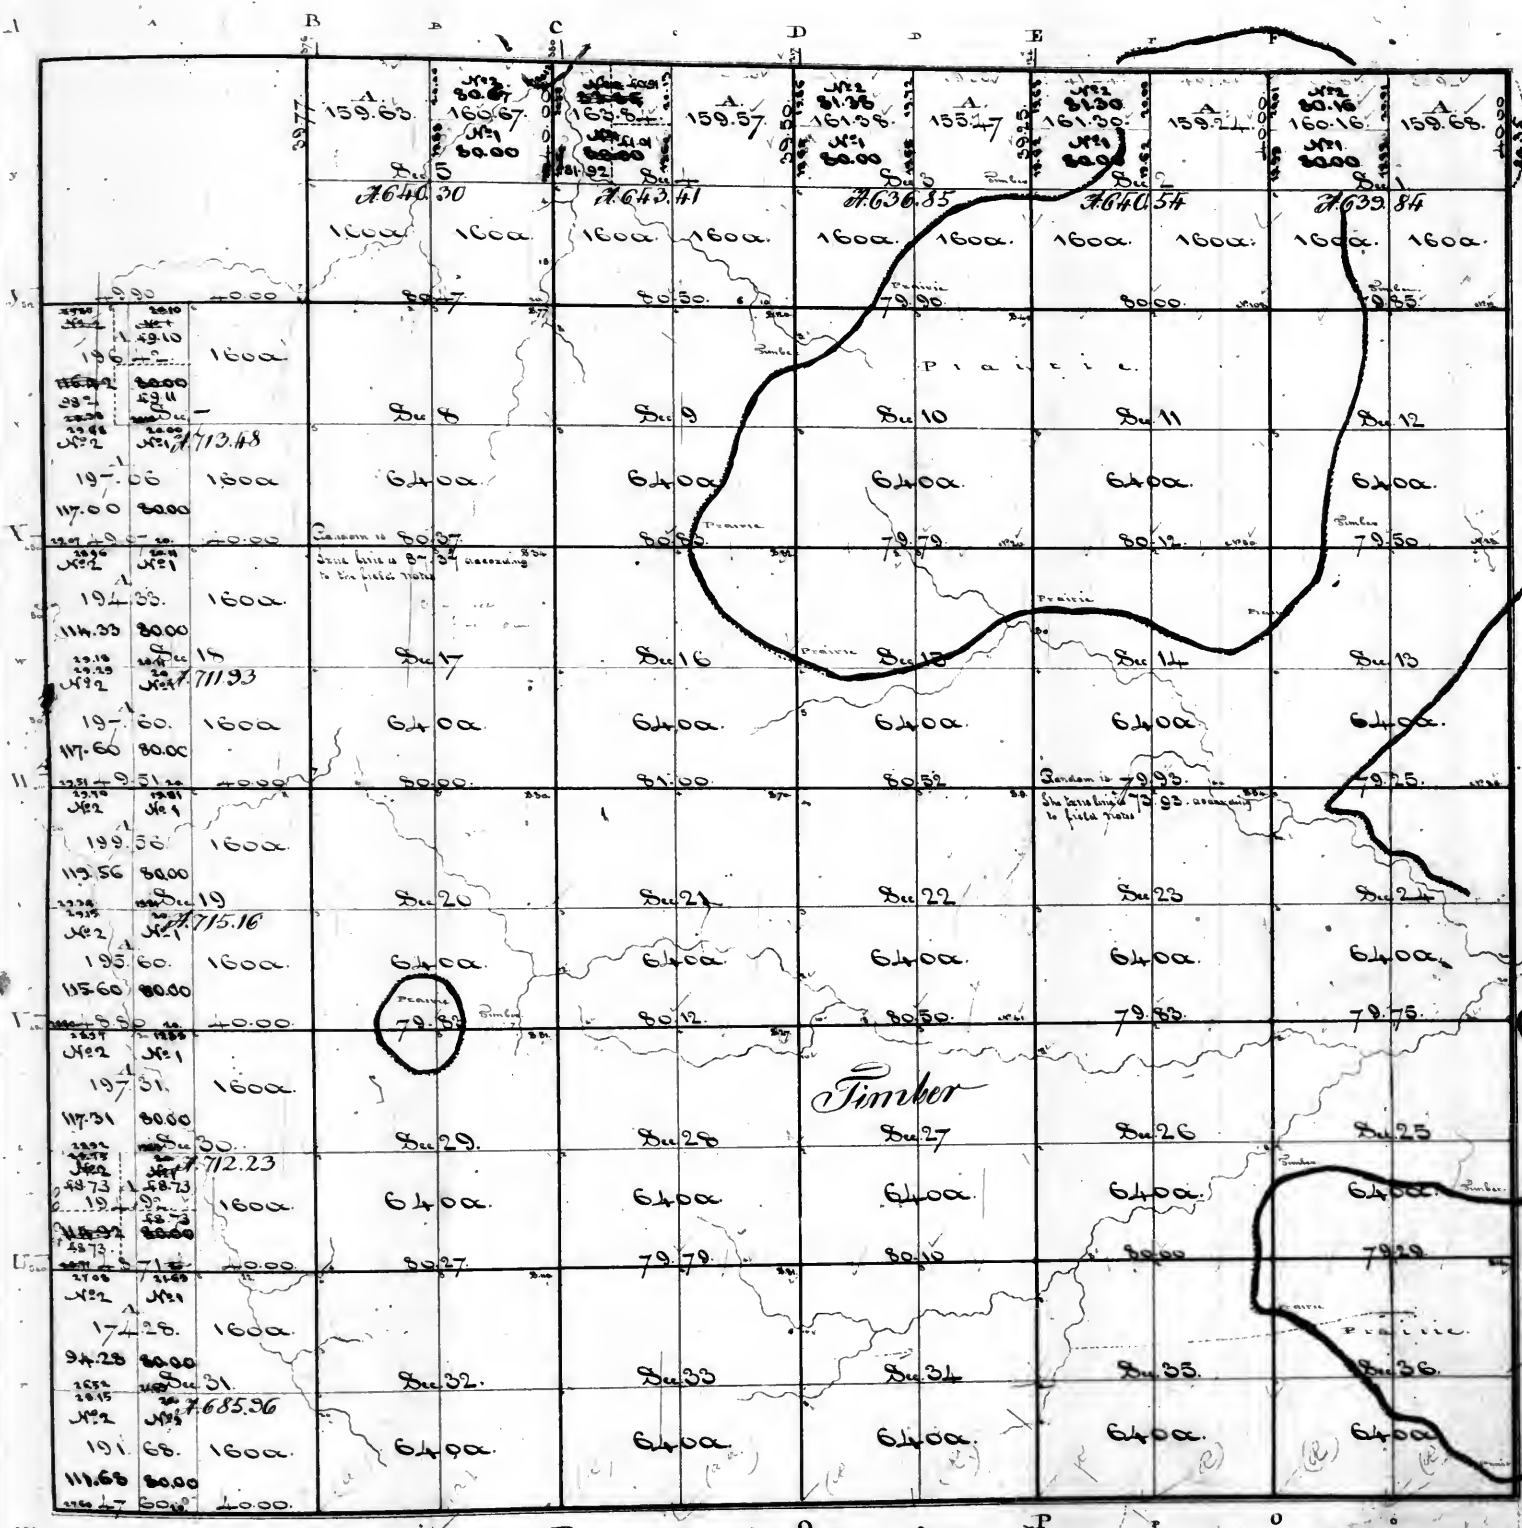

See for this survey by D. L. 3
Spreading the plat of J. S. 23

Note: The length of the line between sections 7 & 16 is not plain in the field notes - the distance set down on this plat is conformable to the old plat on file.

Surveyor's Office
St. Louis, 10th Sept. 1842.
Plat of the N. W. quarter of Sec. 1, 2, 3, 4 of the N. E. of Sec. 5, and of the West halves of Sec. 7, 8, 9, 10, 11, 12, and 13, to the Company of the Land & O.

James Jones 21st March 1844.
Subscribed under the
of 1832 so as to conform to previous sales
reported by the Register on the 15th day
1843, viz:
the N. W. qr. of sec. 4 & 7
the S. W. qr. of sec. 30
and sent today, copies of the plat
to the Reg^r & another to the Comm^r

Aggregate area = 23428.67 acres.


Surveyor's Office, St. Louis 5th October 1840

The North Boundary of S. D. & D. W. (East of the 1/4 Sec. line on the South side of Sec. 18) is laid down on the above plat according to notes that are without date a signature of which represent the entry boundary to have been surveyed West, 6 miles 2.65 ch, without establishing a deep corner, or intersecting at Cor. or intersecting at Cor. with any change line. (See plat of S. D. & D. W. for further particulars.)
The East Boundary surveyed South and West for established Union at the end of 16 miles, (apparently by John A. Donald in Dec. 1815) (see 1815)
The South Boundary - This line appears to have been originally surveyed in 1815 - and again surveyed, or resurveyed, in Dec. 1816. It is laid down on the above plat according to notes signed by John A. Donald; which represent it to have been surveyed West, and at 6 miles 1/2 to show to have intersected at the deep Cor. (which is a second set of notes on file, without date, a signature which extends the line no farther West than the 1/4 Sec. line on the South side of Sec. 18, and which differs from those signed by John A. Donald in the direction given of some of the corners - a third set of notes, on file, but without date a signature conclusively of disagreement, of corners at that boundary, again, with the 1/4 Sec. line of Survey but mentions: there is also, a description of the 1/4 Sec. line on the South side of Sec. 18, and of the corner to Sec. 18 & 19, which does not agree with any of the before mentioned notes.
The West Boundary surveyed North, Dec. 29th (apparently in 1815) and laid down on the above plat, (except the West side of Sec. 6) according to notes, with out signature, (but apparently by John A. Donald): for further particulars concerning this boundary, see plat of S. D. & D. W. 610
The subdivisions lines, surveyed in Dec. 1816, and (with the exception stated on the margin) laid down, according to notes by three different hands, and signed James A. Donald.

Wm. R. Lee
St. Louis

State & Township 4 South of the Baseline Range 4 West of the 4th Principal Meridian.

Page 32 vol 21.

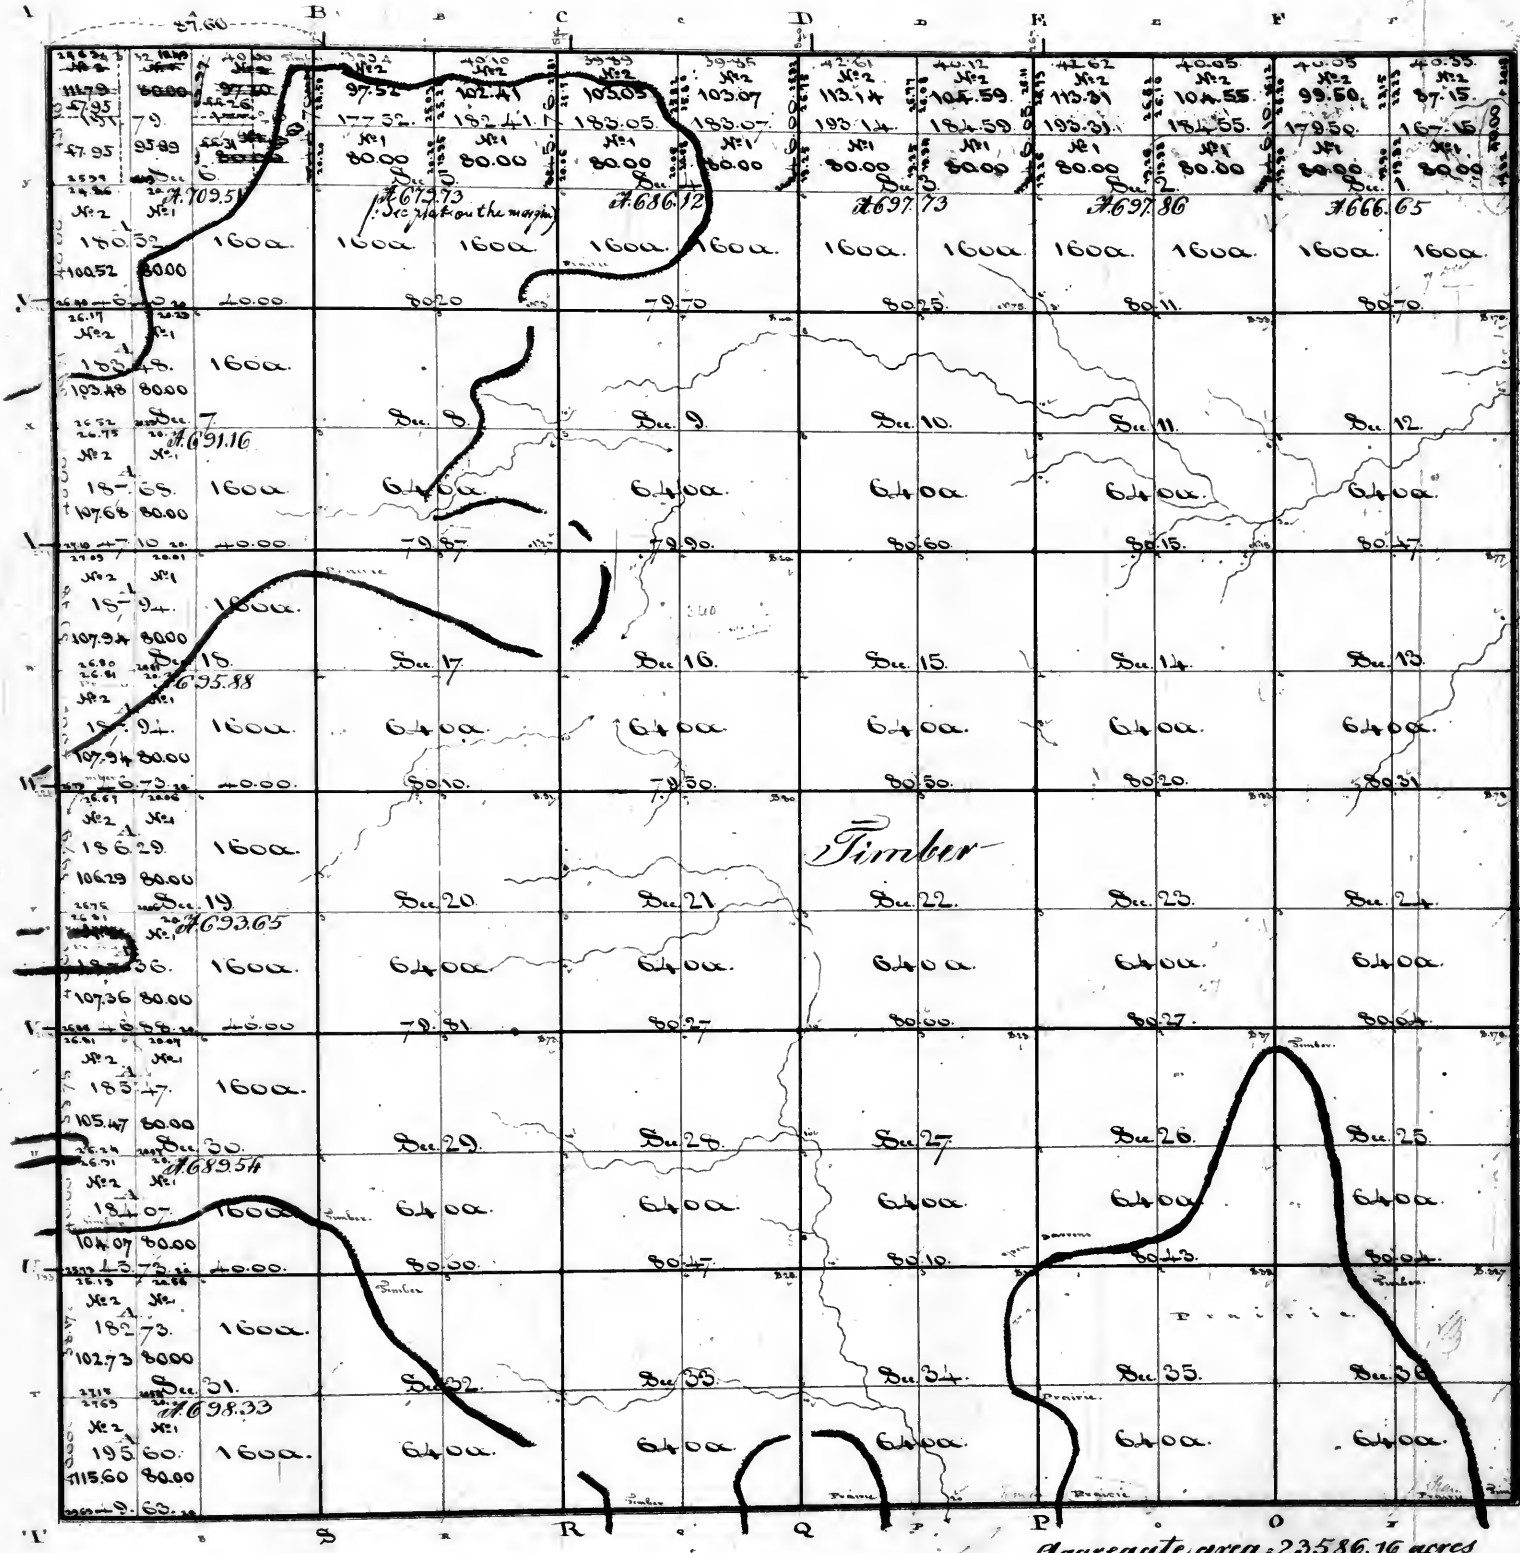

Surveyor's Office
St. Louis 15 January 1837.
The N.E. of Sec. 5 was
added so as to conform to
previous sale (marked S with
plat on margin) & sent
the Register & another
the Commissioner of the
Land Office.

St. Louis 21st March 1844.
Subdivided
the land of 1832 so as to conform
to previous sales as reported
in the Reg. & in the 15th
to wit
the N.E. of section
and sent to day copies of
plat one to the Reg. &
another to the Commr.

Surveyor's Office
St. Louis 10th April 1842.
Plat of the North halves of Secs
4, 2, 3, & 4, 5 of the West half and
N.E. quarter of Sec. 6, and of
the West halves of Secs 7, 12, 13, 30,
& 31, sent this day to the Com-
missioner of the Land O.


Aggregate area 23586.16 acres

Surveyor's Office
St. Louis 8th October 1837.
The above plat of Twp. 4 S. R. 4 W. is conformable to the Notes on file
in this office, which however do not refer the survey to any Principal
Meridian. — W. M. Rice
Asst. Prof. —

Examined
18th Nov.

Downship 5 South of the Base line, Range 4 West of the 4th Principal Meridian.

page 1

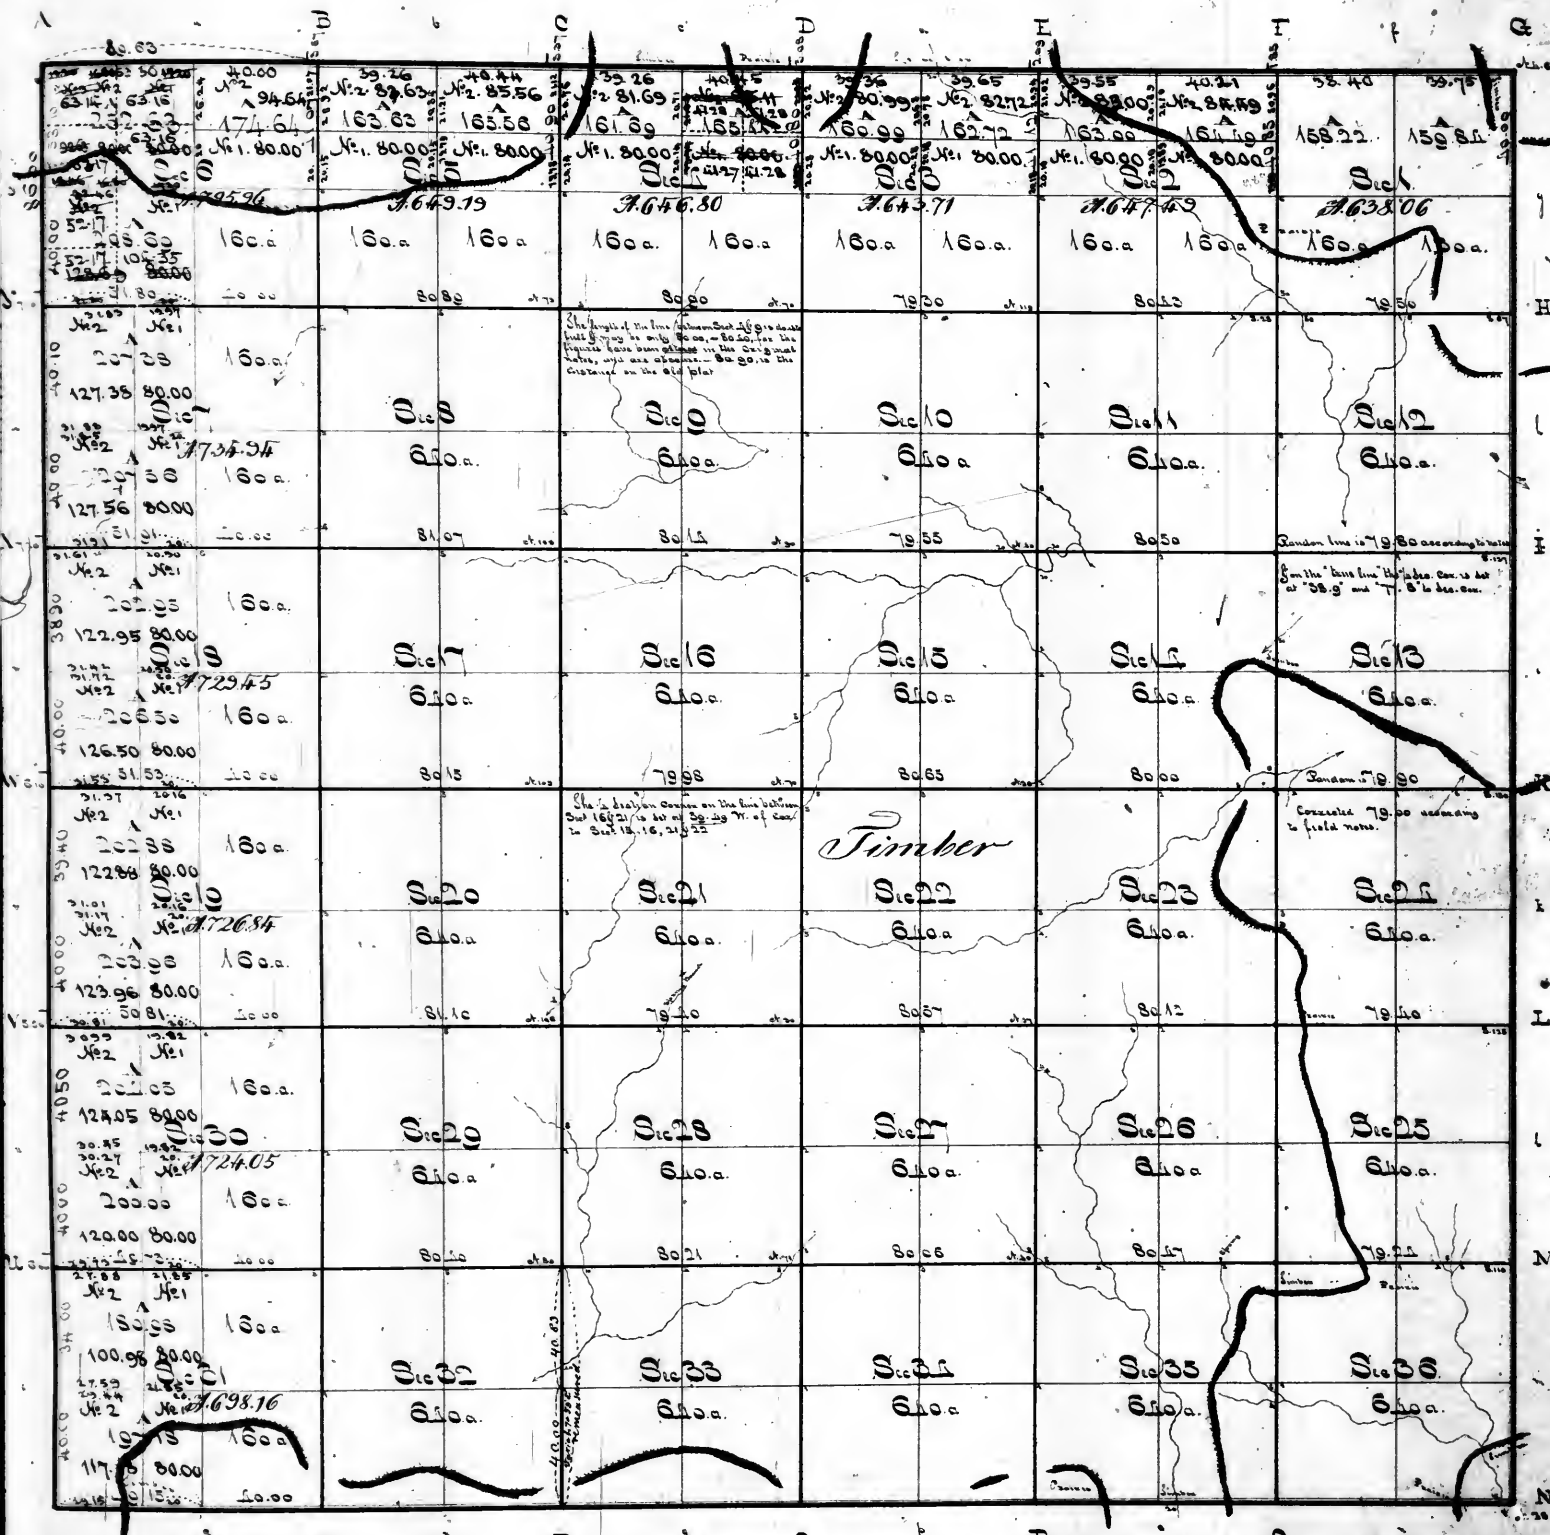

Notes:
The intersection of the line between Sect 455, is rendered doubtful in the field notes, from the situation of the entry; the entry is corroborated however by the old line plat.
The length of the line between Sect 714 is set down on this plat, according to one reading of the field notes - and according to the old unauthenticated line plat - the notes however may be read differently.

Saint Louis 21st March 1894.

Subdivided under the Act of 1832, so as to conform to previous sales, reported by the Reg^r in the 15th May, 1894, to wit: the NE. quarter of Section 2, the NW. of Section 6, and sent to-day, copies of the plat, to the Reg^r's Com. another to the Com^r.

Notes:
The length of the East Boundary of Section 1, Sect 5 S. 25 W. is laid down on this plat 86.00 from the field notes (in Book of 211 D) of said line; the entry of that distance however had the appearance of having originally been written 80.00, and altered to 86.00. On the plat of Township 5 S. 25 W.

Surveyor's Office
St. Louis 11th Sept. 1892
Plat of the North halves of Sect 2, 3, 4, 5, of the West half of NE. quarter of Sec 6, and of the West halves of Sect 7, 13, 15, 20, 21, sent this day to the Com^r of the Public Land Office.

See for correctness of line between sections 32 & 33, the plat of T. 6 S. R. 4 West.

Aggregate area = 23634.65 acres


Surveyors Office
St. Louis 8th October 1890
The exterior boundaries and subdivision lines of Twp 5 South, Range 4 West, are (with the exceptions stated in the marginal notes) represented on the above plat according to the field notes thereof on file in this office, mentioned below, but which do not refer the surveys to any principal Meridian. Very
Notes of the North, South, West Boundaries apparently by John or James M. Donald in Dec^r 1815 but not signed.
Notes of the East Boundary dated Dec^r 1815 apparently by John M. Donald.
Notes & subdivision (in three different hands written) put together in a Book signed James M. Donald.

W. M. Rice
Sr. & J. P. Put. Esq.

Downship 6 South of the base line. Range 1 West of the 1st principal meridian.

See letter from the Regt
at Quimby of the 30 of Oct
1847 in which he gives a list
of Colos. See also his
of the 16th Novr 1847. When
Genl. Kearney arrived in 1847
of the November 1847 the 17th
instructions of W. Rich
Novr 1847 L. J. W. Rich

According to some loose notes, in the
office not used in the construction of this
plot, the line between sections 24 &
25 is 81.75 chains, and the line between
sections 26 & 35 is 24.00 chains.

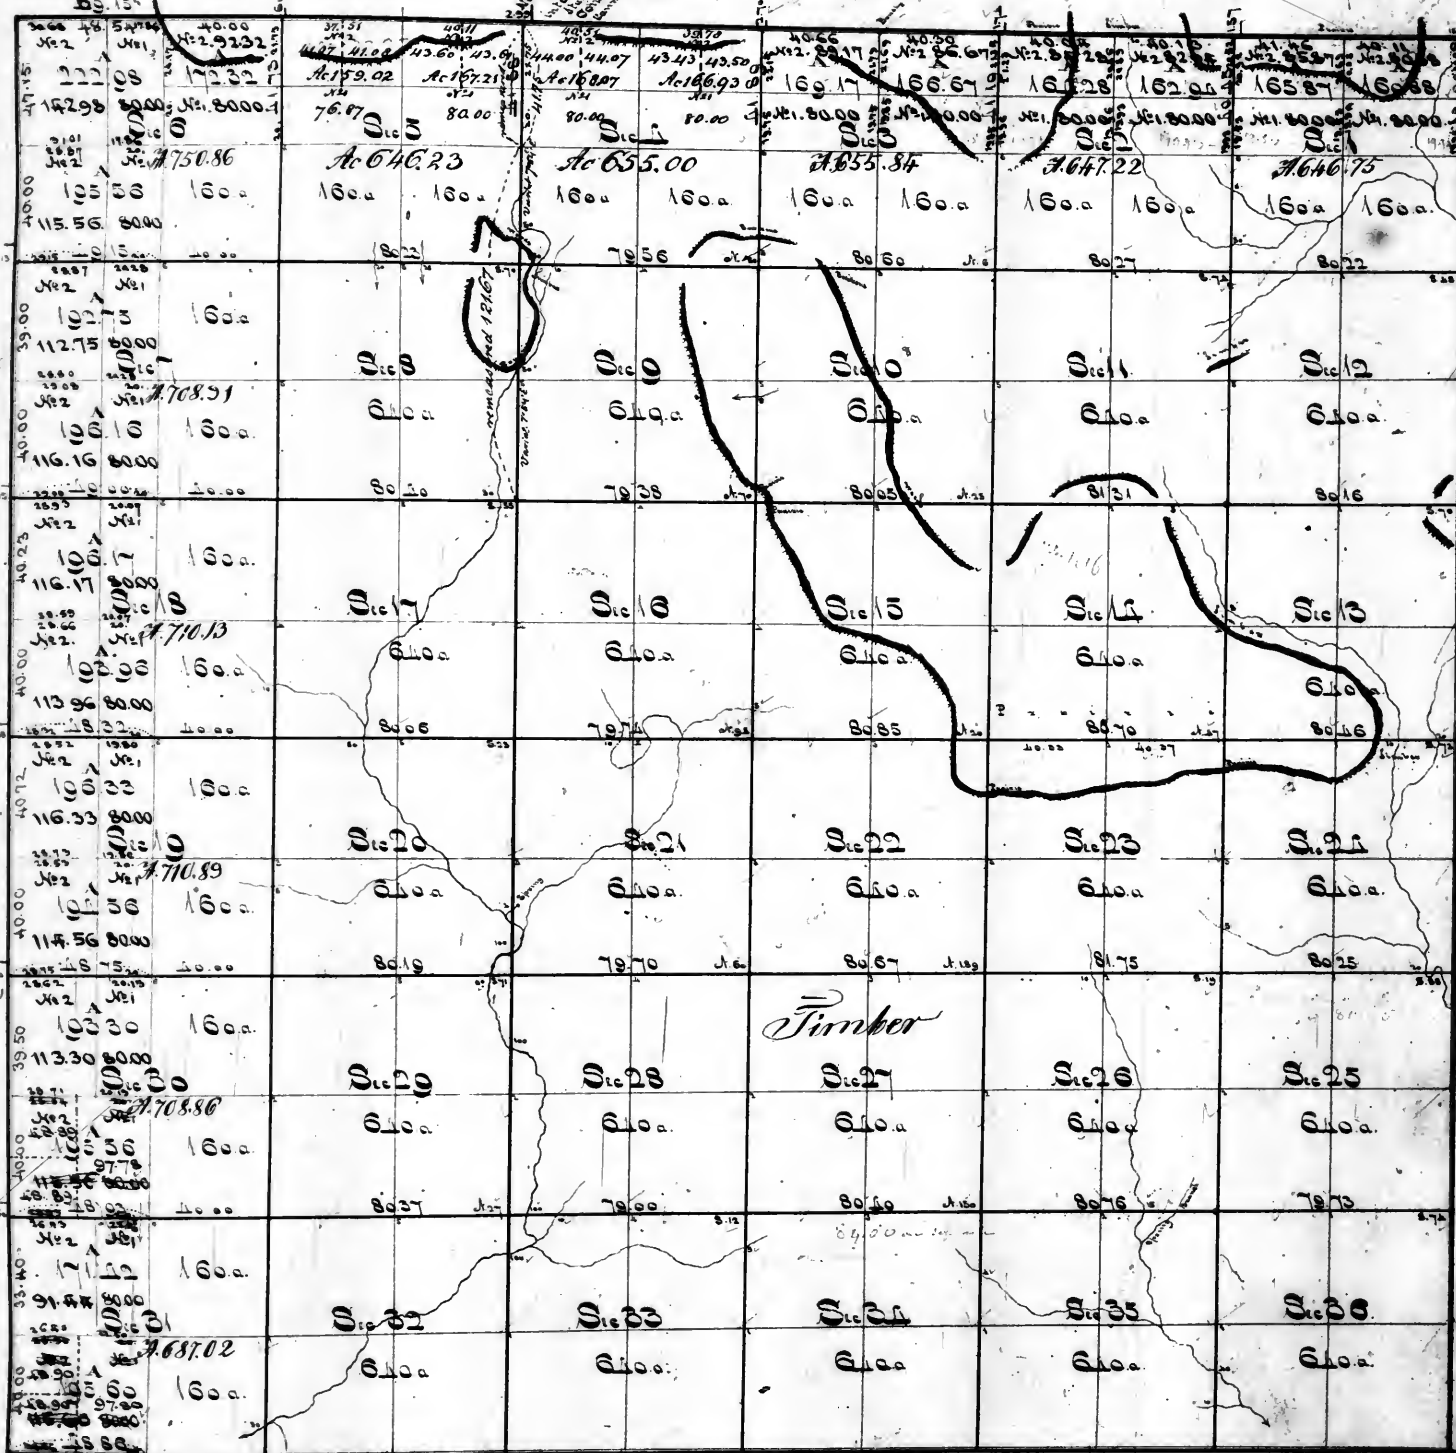

A copy of the plat of land 485 was
sent to the Commissioner and Register on
24 March 1848.

Surgeon's Office. St Louis 24 March

X. The areas of the 87 ft. of sections 444, 445, & 446. R. 140. on this day laid down on the plan in conformity with the survey of the lines between sections 849, and 445 and the connection these latter sections with the corner to section 845. 

J. R. Bonney
Surveyor General

Surveyor's Office
St. Louis 10th Sept. 1882.
Plot of the North halves of sections 1, 2, 3, 4
the West half of N.E. quarter of Sec. 5, and
the West halves of Secs. 7, 10, 15, 20, 21, 22,

St. Louis 21st March 1844.

of 1832 so as to conform to
reported by the Register on the
1843, viz:

1843, viz:
Examined the S.W. gr. of sec. 34 &
sent to day, copies of the papers
to the Pky. & another to the Com.

Surveyors Office
St. Louis 8th March 1890^m
The above plat of Twp. N. 6. S. R. 4 West: is conformable to certain notes
on file in this Office, which do not however, refer to Survey of said Township
to any Principle Meridian: - Those of the Subdivision lines, being written
(apparently by three different hands) in a book signed James McDonald.
Wm. C. Rice
Sr. of Pub. Lands

Hand-drawn survey map showing land parcels, measurements, and features. The map includes the following details:

- Measurements:**
 - Top left: 50.50, 22.00, 22.00, 40.00
 - Top right: 80.00, 5.10
 - Left side (from top): 61.96, 60.96, 34.01, 46.97, 26.34
 - Right side (from top): 160.2, 160.2, 160.2
 - Bottom left: 26.18, 26.00, 26.00, 26.00
 - Bottom right: 80.00
- Parcel Labels:**
 - Top left: A. 21.96
 - Center: Sec 31, A. 62.15
 - Bottom left: A. 40.19
 - Bottom right: Sec 32
- Features:**
 - Slough (multiple locations)
 - Creek bed
 - Road
 - Line from Clark
- Scale:** Scale of 40 chains to one inch.

| | |
|---|------------------|
| Lines referred to in certificate below. | m. 16. 182. |
| South boundary of sections 31 & 32. | 2. 11. 24 |
| Measures of Choral clocks and of island | 1. 75. 07 |
| Total | <u>4. 06. 31</u> |

Surveyors' Office.

Saint Louis 10th of October 1844.

The above plot of sections 31 & 32, Township 7 South of the base line, range 4 west of the 4th principal meridian, is strictly conformable to the field notes of the survey thereof on file in this office, which have been examined and approved. In 1862 & 1863, Amos R. Parker, under instructions of the 12th of March 1842, surveyed the line detailed in the above statement, 4 miles 6 furlongs, which were paid for, in the 2nd quarter of 1844, and charged in the account current of the Surveyor General during the same quarter under the appropriation of \$3000, of the 3rd of March 1843 (page 95 Acts of 31st Janu. 27th Congress) for the survey of detached and unfinished lines in Illinois & Missouri. *S. L. B.*


Silas Reed
Surveyor of the public lands

Map of Township No. 7 South of the Base line in Range No. 4 West of the 4th Principal Meridian, upper part.

Section 31, which is omitted on account of errors in the Survey thereof.

22. Dec. 1845 - not signed

vol 21

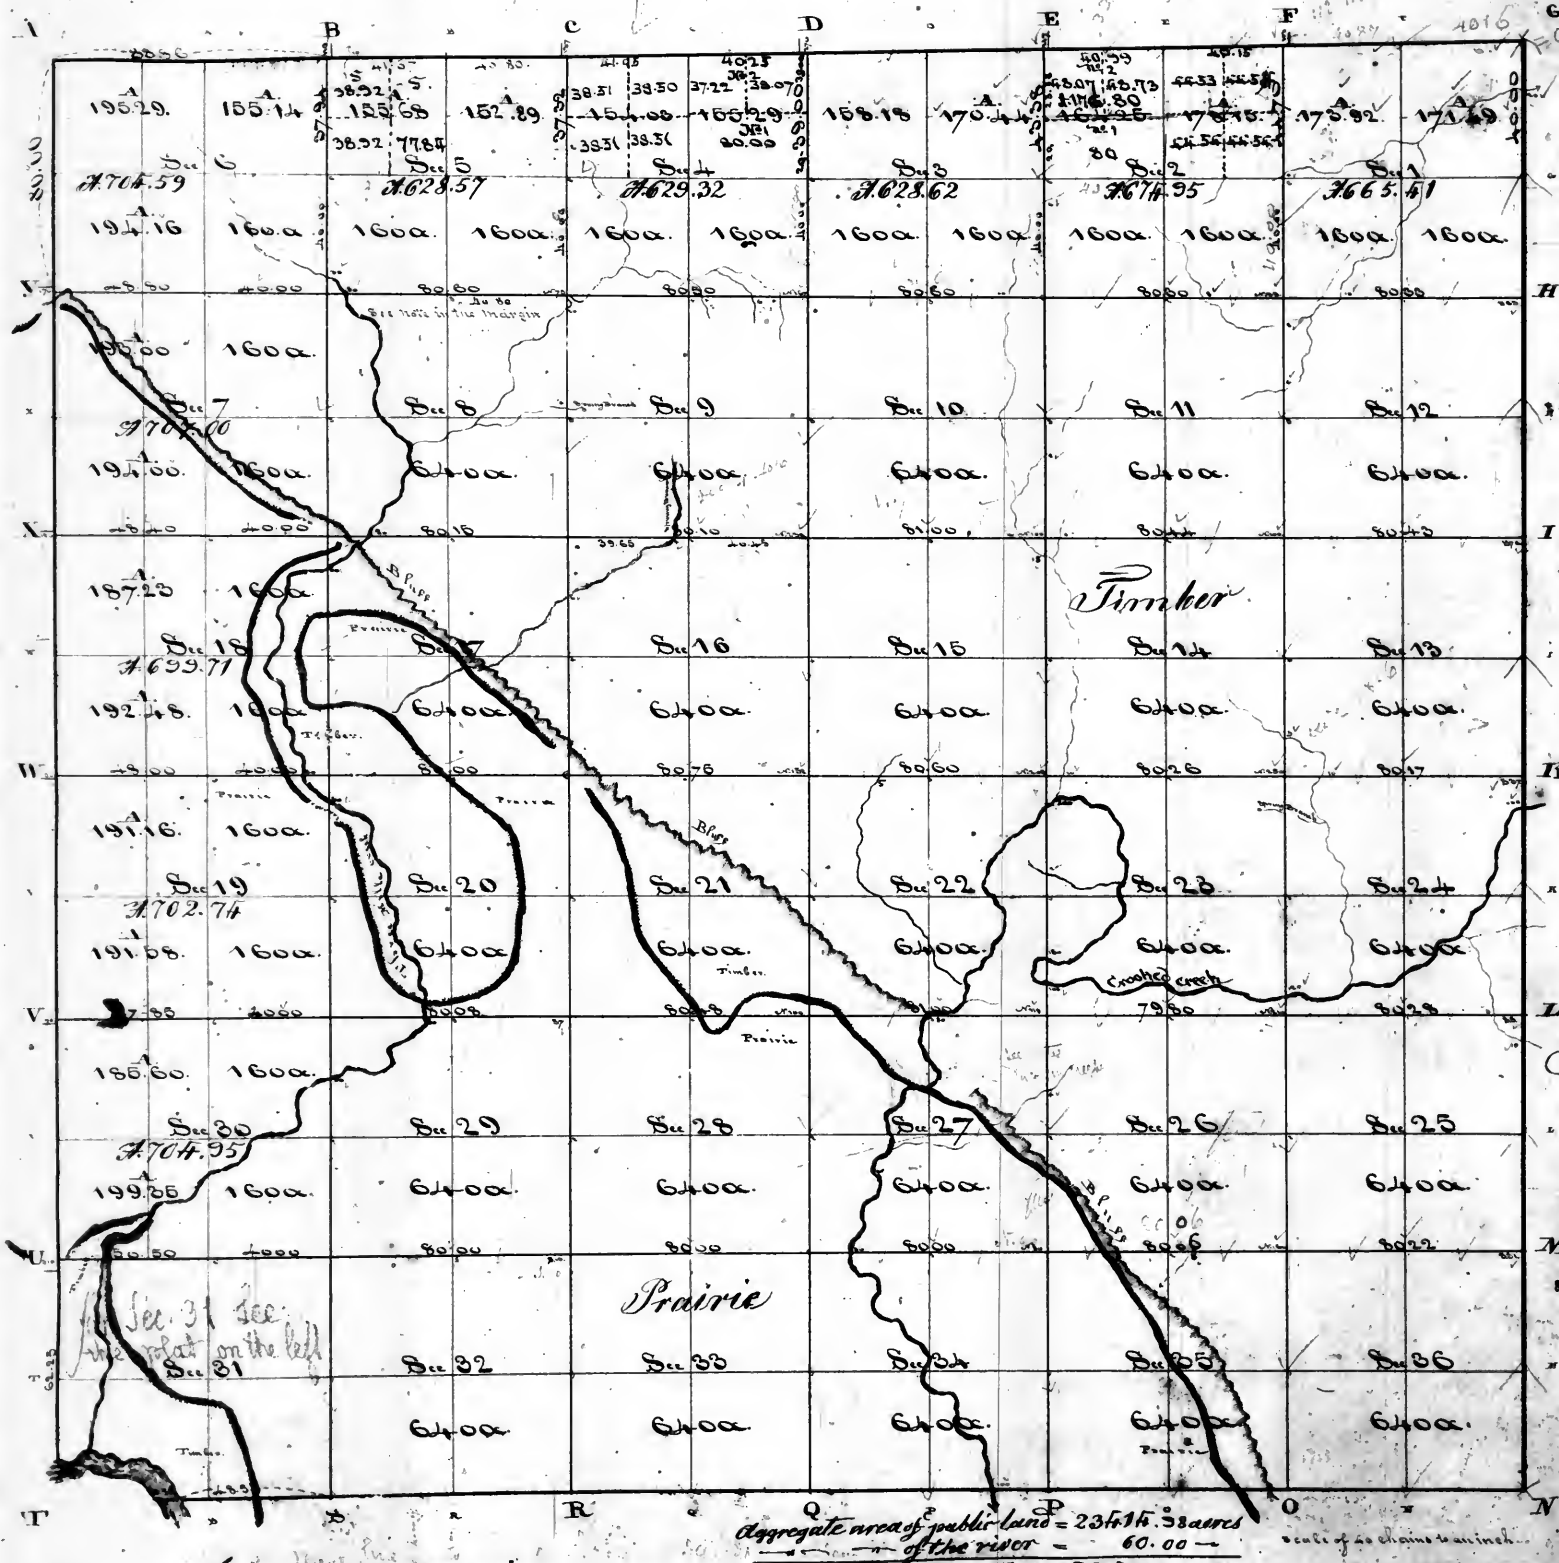

Note: The field notes of the Survey of the Township were deposited of the Subdivision of the Township on the 16th day of Dec. 1845. It appears from the field notes that the corner on the line between Sec. 2 & 3 was established on the line at 40.50 to the west of the corner to Sec. 4 & 5.

Sub. South Dec. 16, 1845
not signed

Surveyor's Office
St. Louis 21st March 1846
Subdivided
the Act of 1832, viz:
the NW quarter of section 2
also as to conform to previous
sales reported by the Reg. on
August 1843, viz:
the NW qr. of section 2
the NW qr. of section 4
and sent to-day, copies of the
map to the Reg. and another to
Commr.

Surveyor's Office
St. Louis 15 January 1847.
Subdivided the NW qr. of Sec. 2 under the
act of Congress of 1832, and the NW qr. of
Sec. 5 to conform to previous sales
and sent a copy to the Register & another copy to
Commr. of the Genl. Land Office.


Erasmus

Aggregate area of public land = 23616.38 acres
of the river = 60.00
Total = 23676.38 acres

Surveyor's Office
St. Louis 25th Sept. 1850
The above plat of Sup. No. 1 R. 4 W. of the 4th P.M. (except Sec. 31)
is conformable to field notes & survey thereof on file in the
office. - Wm. R. New
Sr. of pub. Land

T 8 S. R 4 W of the 4th p. M

The areas of lots 6, 10, 14, 15, 16, 17, 18 recalculated 2^d p.

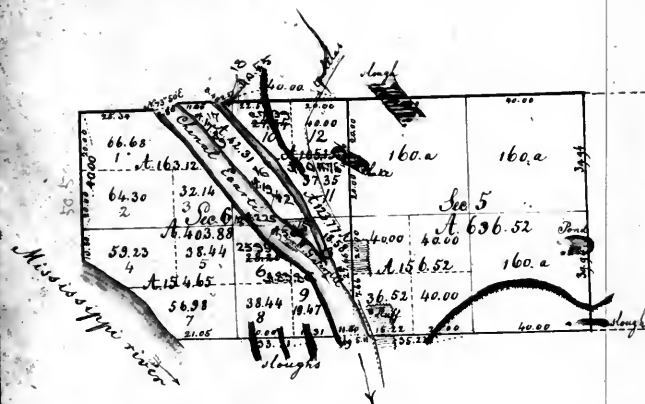

3331
2109
5436

Town of
Clarksville

Surveyor's Office
St Louis, August 29th 1848
The areas of lots 6, 10, 14, 15, 16, 17 & 18 recalculated this day, and a plat of Sect. 6 was sent this day to the Register and another to the Commissioner of the Genl Land Office.

Statement referred to in the certificate below.

| Lines | A. (Acres) |
|---|------------|
| E. by of sec. 24 T. 8 S. R. 4 W. | 40.04 |
| E. by of sec. 25 T. 8 S. R. 4 W. | 40.04 |
| Line betw. sec. 24 & 25 | 78.33 |

A copy of this plat sent to the Commissioner & Register on the 23rd of Oct. 1844.



Variation 7° 33' East
Scale of 40 chains to one inch.


Surveyor's Office, St. Louis, 10th of October 1844.

The above plat of sections 5, 6, 24 & 25 Township 8 South of the base line, range 4 West of the 4th principal meridian, is strictly conformable to the field notes of the Survey hereof on file in this office which have been examined and approved. On 18th of March 1842, Surveyor the lines, described in the above statement, 11 miles 50.27 chains, which were paid for in the 2^d quarter of 1844, and charged in the account Current of the Surveyor General, during the same quarter, under the appropriation of \$2000. of the 3rd of March 1842, (page 95 Act of Session 27th Congress) for the survey of railways and detached lines in Illinois & Missouri at a rate not exceeding 50 dollars a mile.

Silas Reed
Surveyor of the public land in
the State of Missouri &c.

Plot of fractional Township N. 8 South & the Danlimin Range N. 4 West of the 1st principal Meridian

Page 36 vol 21

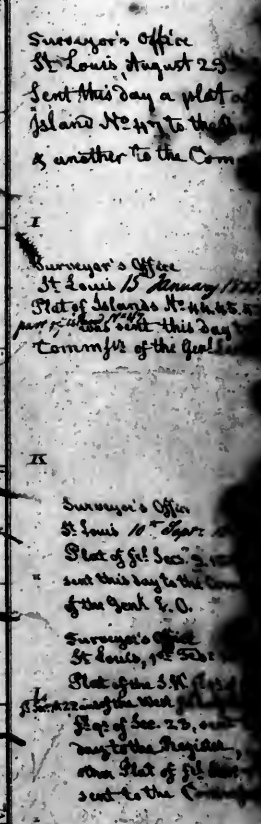

The notes of the surveyors of the exterior lines of said Township filed in constructing this plat are, without date or signature, but are apparently by John Ellis Donald. In 1815 they are in a field book of exterior lines of Township with no numbers. The notes of the original subdivision of the land of said Township in 1815, as far as the meanders of the left bank of the river are concerned, are by John D. Beale in March 1815, and the meanders of the right bank of the river are apparently by three or four different persons, in a Book, No. 1060 signed John Mc Donald.

The subdivision lines on the plat of said Township are laid down in the plat according to the notes in said Book of Subdivision lines, No. 1060, except the line between sections 577 and 578, which is laid down according to the meanders of the left bank of the river, and both banks of the Chenoweths, and the meanders of the right bank of the river, and both banks of the Chenoweths, according to the re-survey thereof by John Ellifinger in March 1827.

Wm. Bee
Dr. J. P. Lee


Res
L. L.

Plat of Township 1 South of the Base line in Range 5 West of the Principal Meridian.

page 37 vol 21

1530

uncalculated

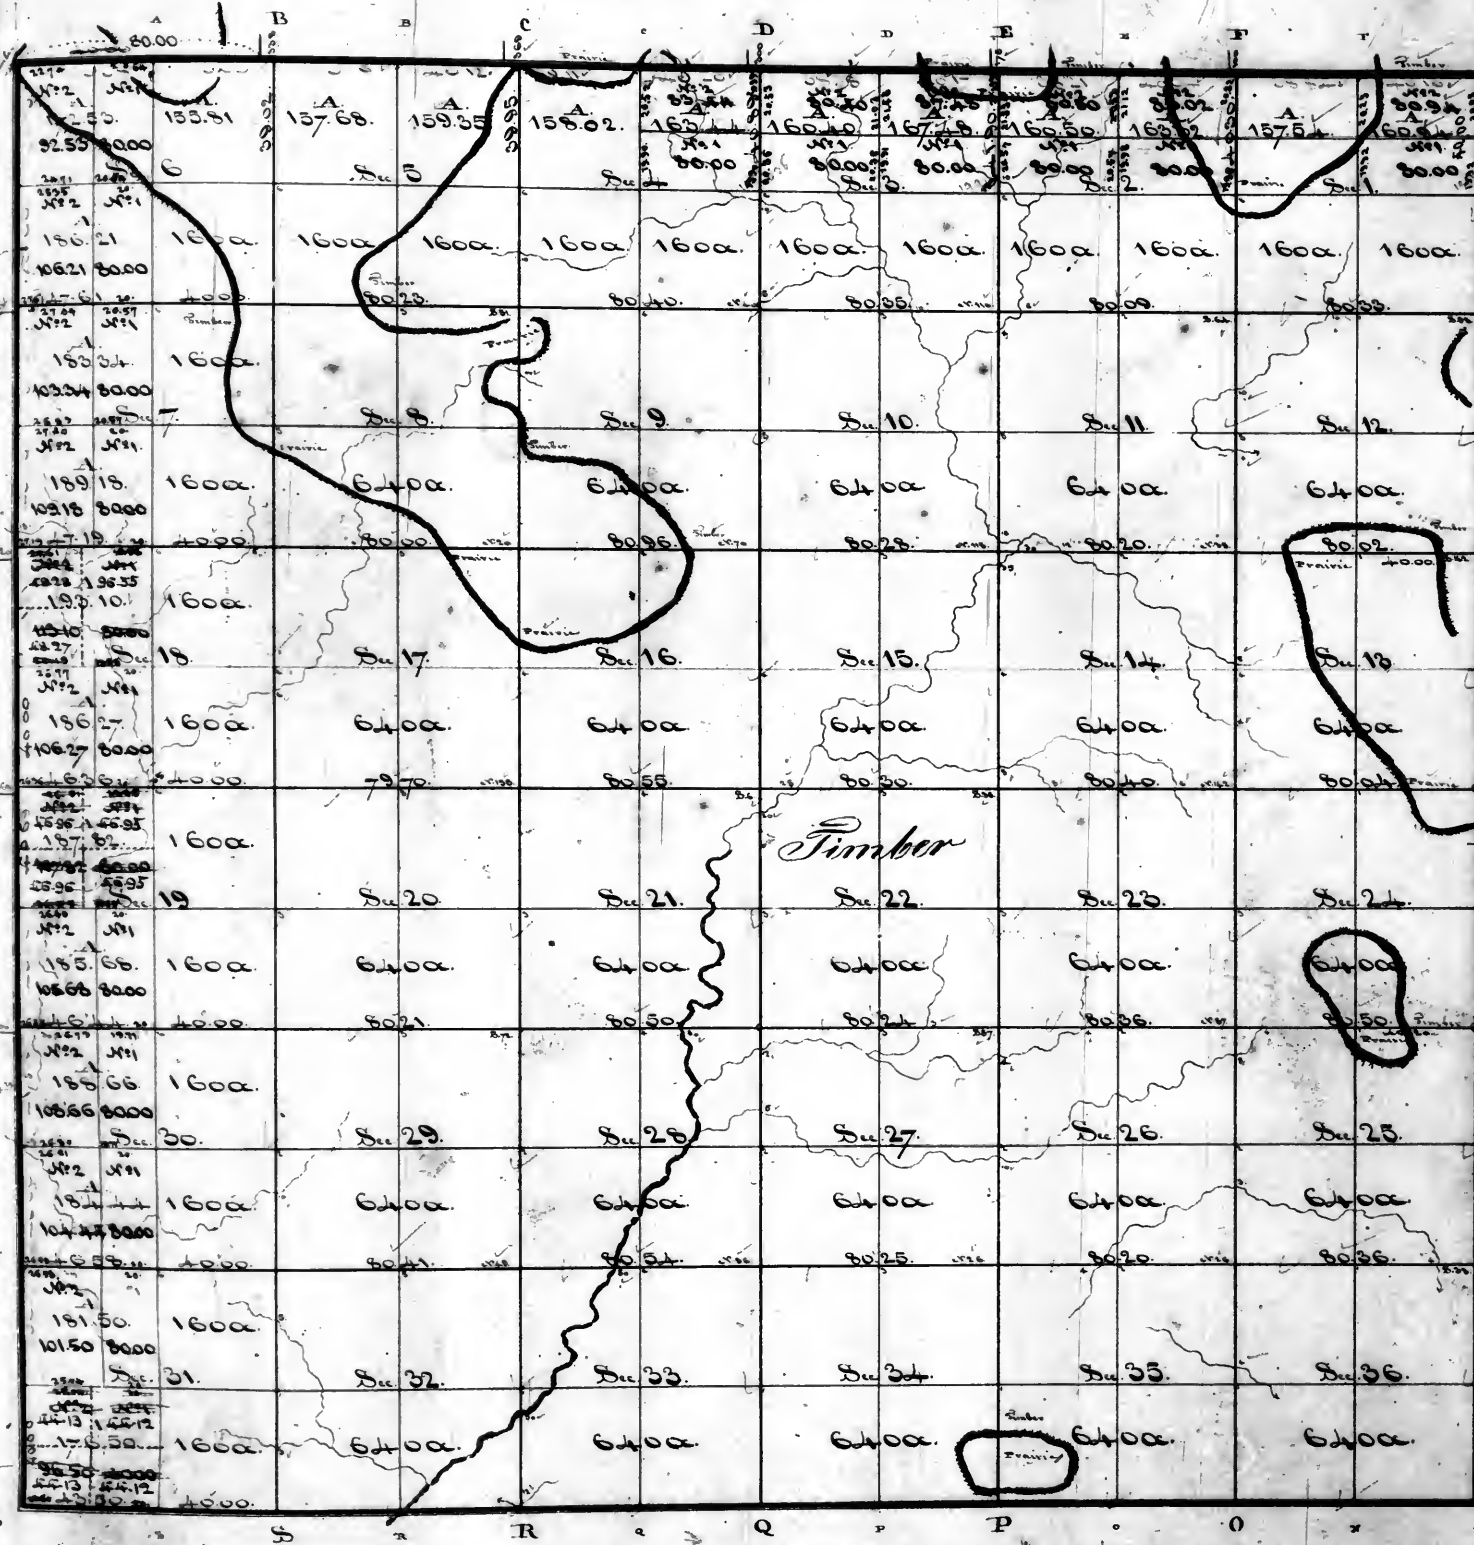

The East Boundary of the Township appears from notes in this office to have been originally surveyed about 6 miles and intersected at the first corner, at present, by John M. Donald, at Donald's, probably in 1815.

It was surveyed apparently a second time, in 1816, by the same surveyor, when it again intersected at the first corner, by John M. Donald, Jan. 5, 1817. The notes of this survey have been examined and found correct, and each of the proper things, of one of them crossed out.

The line was surveyed a third time (as laid down in this plat) south, and a line corner established there at the end of six miles, Jan. 20, 1817, by John M. Donald, Jr.

There is also a file of south set (or collection) of notes (without date or signature) containing descriptions of corners, by which, describes all the corners on the line, south of the base line. These descriptions agree with those given in the notes of the 1st survey of the 20th Jan. but above mentioned.

Surveyor's Office
St. Louis 10th Sept. 1842.

Plat of NE quarter of Sec 14, of the N. 1/2 of Sec 24, and of the West halves of Sec 6, 7, 18, 19, 30, 31 and this day to the Commr of the General Land Office.


Saint Louis, 10th March 1844

Subdivided
of 1832 as is to conform to
reported by the Reg. on the 15th
of the N. 1/2 of Sec. 31
the 20th of Jan. 31.
and to-day, copies of the
the Reg. and another to the

Surveyor's Office, St. Louis, 11th October 1840.

The Eastern boundary & subdivision lines of Township 1 South, Range 5 West, as shown on the above plat according to field notes taken, or file in this office, and mentioned below, but which (except the East boundary) do not refer to the survey thereof to any Principal Meridian.
The notes of the survey of the East boundary are in a field book of Exterior lines of Townships in Illinois numbered 218, they are dated December 1815, but are not signed.
The notes of the East boundary are in field books of Exterior of 216, those of the East body are signed John M. Donald, and dated January 10th 1817, those of the West body are without date or signature.
The notes of the survey of the West body are in field books of Exterior lines in Illinois numbered 212, they are apparently by James M. Donald, in March 1816.
The notes of the subdivision are in field books of 1043 A. of subdivisions of Townships in Illinois, they are dated in January 1817, and have the names of John & James M. Donald on the outside.

Page 38 vol. 21

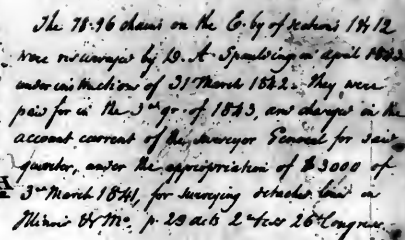


The East Boundary of Township 2 S.
R. 30 W. appears from notes on file to have been
originally surveyed North 6 miles, where it inter-
sected at the Township corner, in March 1816,
by Samuel H. Donald. It was a return survey
at 600 yds; as either comes out at 560 to
the East side of Section 1, a corner established
to sections 1 & 2, at 76.50 and at the end
the fifth mile following, the Township corner
was established by John M. Donald. D. S.
The notes of this survey are not dated, but follow
in the same book (N. 216), immediately after
the notes of the East boundary of S. 3, R. 20 W.,
and laid down on the Plat at that Township.

Date of origl. Submis. of Ser. 7418, the 18th July 1941

St. Louis 21st March 1844

1832 to wit:
 1. the N.E. q^r. of sec. 1 (containing)
 also so as to conform to previous subdivi-
 sion by the Reg^y on the 15th August 1832
 2. the N.W. q^r. of sec. 1 (containing) — the N.E. q^r.
 — the N.E. q^r. of sec. 3 (containing) the N.W. q^r. of sec. 3
 — and to-day, copies of the plat sent
 to the Reg^y (and another to the Comm^r),
 and to the Reg^y on the same day a copy
 of the plat of the N.E. q^r. of sec. 7 & 8
 were originally subdivided on the 15th August
 Surveyor's Office
 St Louis 11th Sept: 1842.
 Plat of the N.W. quarter of Section 1 and
 the West halves of Sects 2, 7 & 18, sent this day
 to the Comm^r for the Genl L. O.

Examiné
- 1771

Surveyor's Office
Saint Louis 11th October.

The exterior boundary and subdivision lines of Township 2 South Range 5 West, are represented on the above plat according to field notes thereof on file in this office (but which do not refer the Surveys to any principal Meridian &c.)


The notes of the survey of the West boundary, in book of partitions in Illinois numbered 212, signed by John M. Donald in March 1816.

The notes of the Survey of the North, East & South boundaries on a field book of sections in Illinois number 216, those of the East Boundary are signed John Mc Donald, and those of the North and South are without signature, but are apparently by John Mc Donald, they are all three without date.

The notes of the Subdivision Taxes of the Township are without date, they are in field book of Subdivision in Illinois numbered 10 & 11, signed John M. Donah.

Wm. Bee
Co. of Publishers

page 39 vol 21

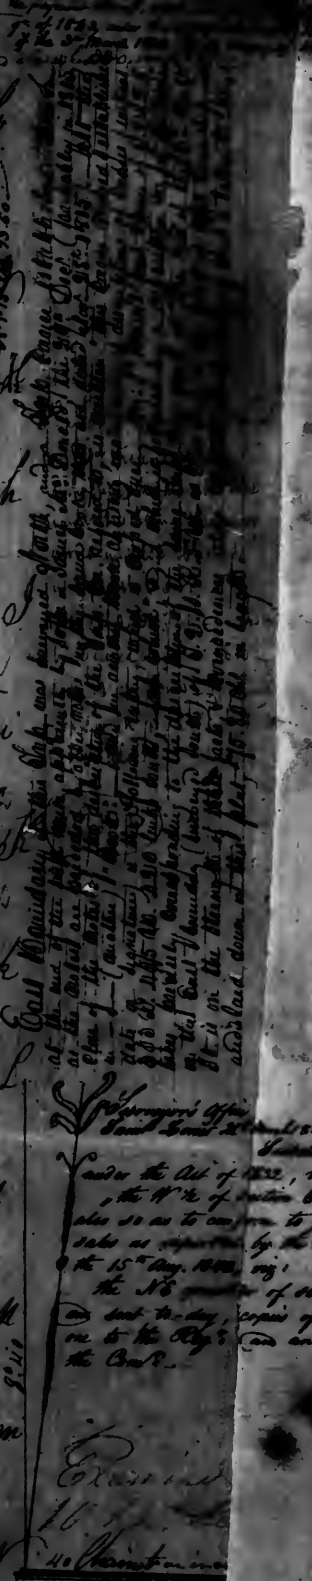

Payer's Office
 Saint Louis 22nd April 1844.
 Under the Act of 1832, viz:
 "the 11th of section 1,
 sales so as to compare to
 sales as reported by the City
 on the 15th day, 1844, viz:
 the 18th of Dec. 3
 one week to-day, copies of the
 one to the City, and another
 the Comr.

Expressed

The External Subdivision lines of Twp. 3 South, Range 5 West are represented in the above plat among the first notes thereof in this office, but which do not refer the survey to any former plat or subdivision.

The North Boundary according to notes, apparently of John M. Donald, in book C. 216, of Township lines of ships in Illinois, which run west only, as far as the quarter section corner on the North End of Section 31, Twp. 3 S., R. 5 W., the line of the W. of Section 31 is omitted on this plat.

The West & South Boundary according to notes, apparently, of John M. Donald in book C. 216, of Township lines of ships in Illinois, in December 1815, is shown.


The East Boundary, according to notes apparently, of John M. Donald in book C. 216, of Township lines of ships in Illinois, in December apparently 1816, (with the quarter states in the margin of the plat).

The Subdivision lines according to notes of (apparently) John M. Donald in book C. 216, of Township lines of ships in Illinois, in December 1817.

ending to note of (apparently) 1884.
Wm. & Rec
St. of Pub. Law }

Lat & Township N. 4 South of the Base line in Range 5 West of the 4th Principal Meridian.

page 400 of 21

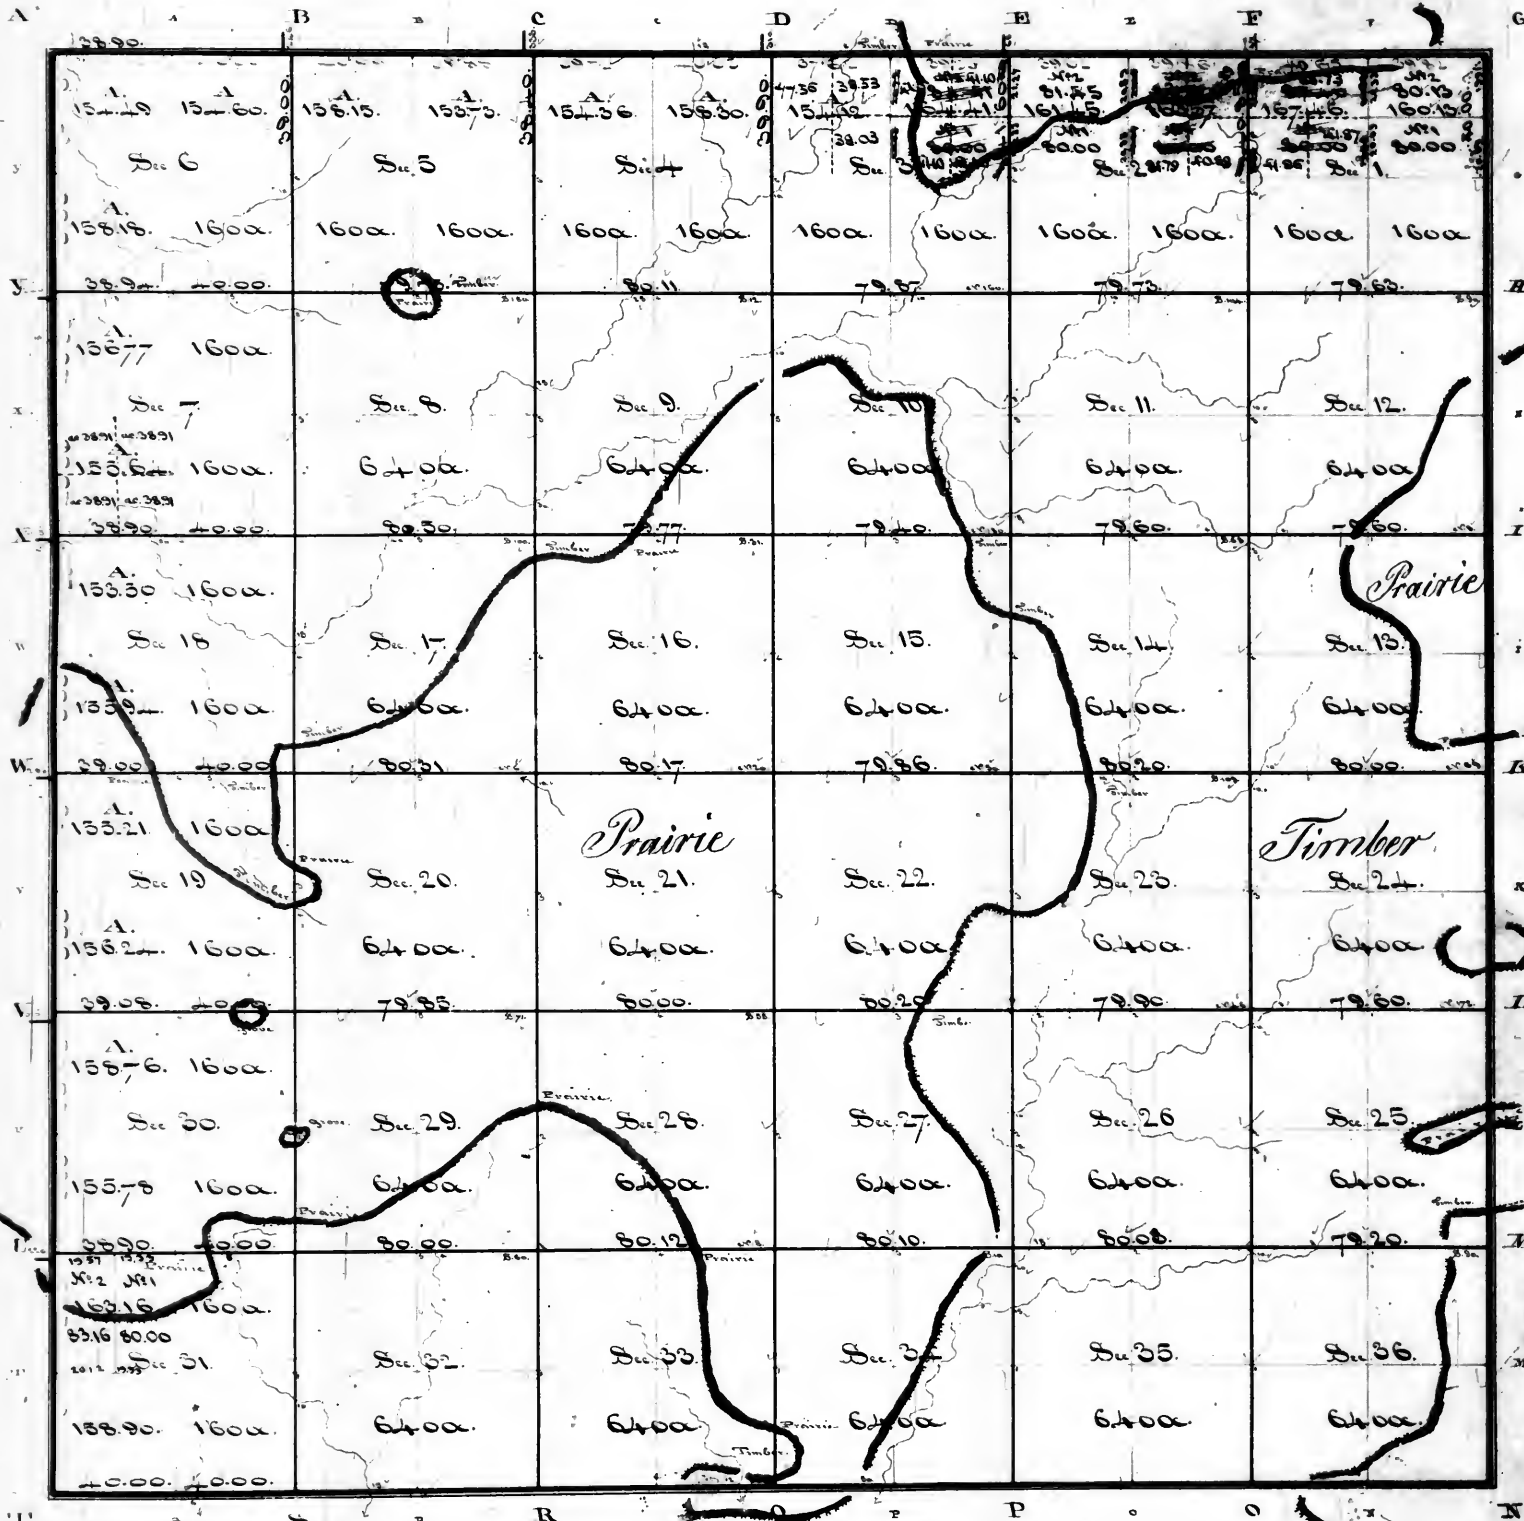

Surveyor's Office
St. Louis 11th March 1844.
Subdivided
Act of 1832 is as to conform to previous
as reported by the Reg. on the 15th day
1843, viz: "the NW. qr. of section
16, the SE. qr. sec 2 & NW. qr. sec 3
and sent to Reg. copies of the plat
to the Reg. & another to the Commr."

Surveyor's Office
St. Louis 10th Sept. 1842.
Plat of the North halves of Sec 14 & 2
of the N.E. quarter of Sec. 3, and of the
NW. qr. of Sec. 31 sent this day to the
Commr. of the Genl. L.O.

Surveyor's Office
St. Louis 6th April 1845.
Subdivided the S.W. qr. of Sec. 7, as to conform to previous
sales, as reported by the Register on the 23rd January 1845, &
sent to day copies of the plat to the Register & another to
the Commr.

Surveyor's Office
St. Louis 11th October 1850.
This plat is for 4 S. R. 5 N.
is conformable to the plat
surveyed & filed in this office
which will however do not
refer said survey to any
Meridian
Wm. McRee
Sr. of Put. Co.


Comptroller
1870

Surveyor's Office
St. Louis October 11th 1830.

The exterior boundary and subdivision lines of Township 4 South, Range 5 West, are represented on the above plat according to the following notes thereon on file in this office, but which do not refer the surveys to any principal meridian viz:
The notes of the survey of the East boundary—apparently by John or James M. Donald in December 1815.
The notes of the survey of the North, West and South boundaries—dated in December 1815, in a book signed by John M. Donald
The length of the East boundary of Sec. one Township 4 South Range 5 West, has been altered, and is rendered obscure, it appears to be intended for 8000. The old Township plat however signed by John M. Donald represents the line between those sections as of the proper length or 8000 and under the uncertainty of the above stated notes, the said old plat is taken as explanatory thereof, and the line set down on this plat as 8000 chains.
The notes of the subdivision—in three or four different hand-writes—put together in a book signed John M. Donald. The said book is numbered 1039 of subdivision book of Townships in Illinois.
The notes of the East boundary are in a book numbered 2113, and those of the West North and South boundaries are in a book numbered 2114 of Exterior Lines of Townships in Illinois.

Notes in a Book No. 211A signed John M. Donald - 5 - 18 March 1844

Township 5 South of the baseline. Range 5 West of the 4th principal meridian

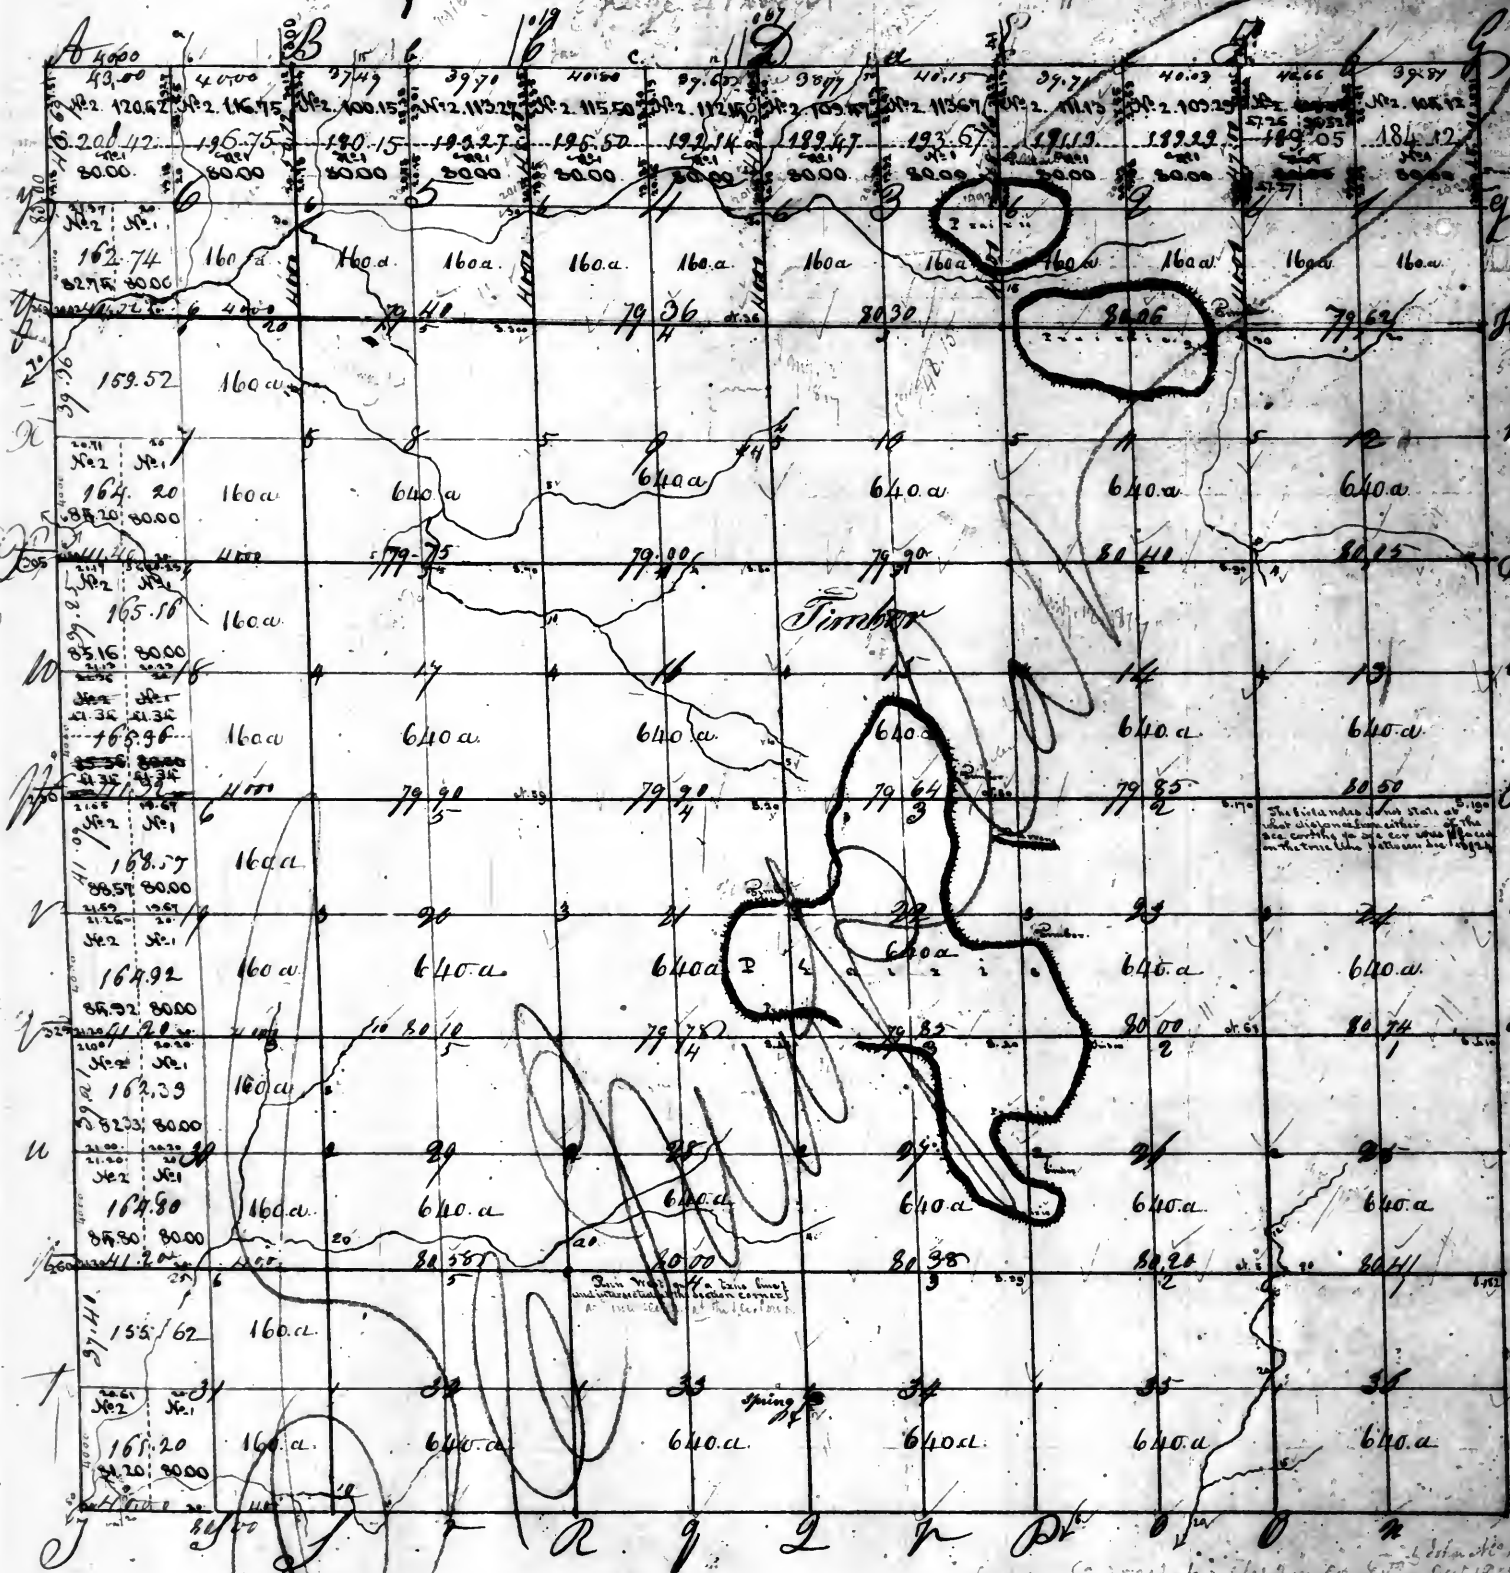

Note
The length of the East boundary of section 4, as laid down on the plat is 86.00 from the full note for Book No. 211B of said line, the survey of that distance having been the appearance of having originally been written 80.00 and altered to 86.00 in the plat of Township 5. S. R. 5. W.

Note
The entry of said distance has been written 80.00 and altered to 86.00 in the plat of Township 5. S. R. 5. W.

The full note does not state at what distance from either of the two corners the line was laid out on the line like the yellow line in the plat.

Surveyor's Office
St. Louis 10th Sept 1844.
Plat of the North halves of Secs 1, 2, of the North half of Sec. 34, of the West half of Sec. 35, of the West half of Sec. 36, 19. 30. from this day to the Commence of the Plat. 4.0.

St. Louis 21st March 1844.
Subdivided under Act of 1832 as to conform to provisions as reported by the Reg^r on the 15th August 1843, viz:
the N.W. qr. of sec. 1 (cont)
the N.W. qr. of sec. 13
and sent to day, copies of the plat on to the Reg^r and another to the Comm.

Township 5 South Range 5 West

Surveyor's Office
Saint Louis 11th October 1850.

The exterior and subdivision lines of T. 5. S. R. 5. W. are represented on the above plat according to notes of the survey thereof on file in this office (but which do not refer the survey to any principal Meridian) and the North, West and South boundaries according to notes in book 211A, signed John M. Donald, in December 1845. The East boundary according to notes in Book 211B apparently by John or James M. Donald in December 1845. The subdivision lines by these persons, in a book numbered 1038, with the signature of John M. Donald on the outer leaf thereof.

Wm. R. C.
Dr. J. P. L.

T 6 S. R 5. W. of the 4th p. M.

Stationed reference to a north from below

| Line | Acres |
|---|------------|
| Line before 1834 38 | 1 01 66 |
| • 27. 38 | 1 01 67 |
| • 28. 38 | 1 00 04 |
| • 28. 38 E. of Chenal creek | 30 49 |
| • do and do | 2 36 |
| • do West of do | 29 04 |
| • 38. 38 | 73 10 |
| • 21. 21 | 1 01 13 |
| • 20. 21 | 1 00 66 |
| • 29. 30 | 70 32 |
| • 20. 20 E. of Chenal creek | 53 33 |
| • do and do | 13 05 |
| • do West do | 3 20 |
| • 19. 4. 30 | 1 00 08 |
| • 19. 4. 30 | 62 70 |
| • 17. 4. 20 E. of Chenal creek | 73 20 |
| • 13. 4. 10 W. of do | 20 30 |
| • do and do | 7 26 |
| • do in East of do | 16 20 |
| • do from corner to pt. within 17 | |
| • 4. 20 and Chenal creek to corner to pt. | 7 48 |
| Sections 17 18 19 | |
| Line between sections 17 18 19, including 7. 60 | 63 29 |
| and Chenal creek | 13 35 25 |
| All corners of Right bank of Chenal creek along | |
| Sec. 17. 18. 19. 20. 21. 22. 23. | 6 57 22 |
| Measures of left bank along same sections | 7 36 53 |
| South boundary of Sec. 31 | 1 00 24 |
| South boundary of Sec. 23, 20. 4. E. of Chenal | |
| creek and across it | 1 03 65 |
| | 30, 08, 79 |




Surveyor's Office, Saint Louis 10th of October 1844.

The above plat of sections 17, 18, 19, 20, 21, 22, 23, 24, 25, 26, 27, 28, 29, 30, 31, 32, of Township 6 South of the base line range 5 West of the 1st principal meridian is hereby confirmed to the first lot of the survey thereof on file in this office which have been examined and approved, on the 18th 22nd & 18th 43, Anna T. Butler, and
attestations of the 12th March 1844, through the lines situated in the original plat, 30 miles, 37.75 miles, which was paid for in the 2nd quarter of 1844, and
changed in the second quarter of the Surveyor General, being the same quarter, under the appropriation of \$2000, of the 3rd March 1842, for the 1st and 2nd
sections of the 37th Congress for the survey of detached and unperfected land in Illinois 4th section, at a rate not exceeding ten dollars a mile.

Silas Reed
Surveyor of the public land,
St. Louis of Illinois 1844

page 42 vol 21
Township 6 South of the base line. Range 5 West of the 1st Principal Meridian.
except sections 17 18 19 20 21 22 23 24 which are omitted on account of error in the survey thereof.

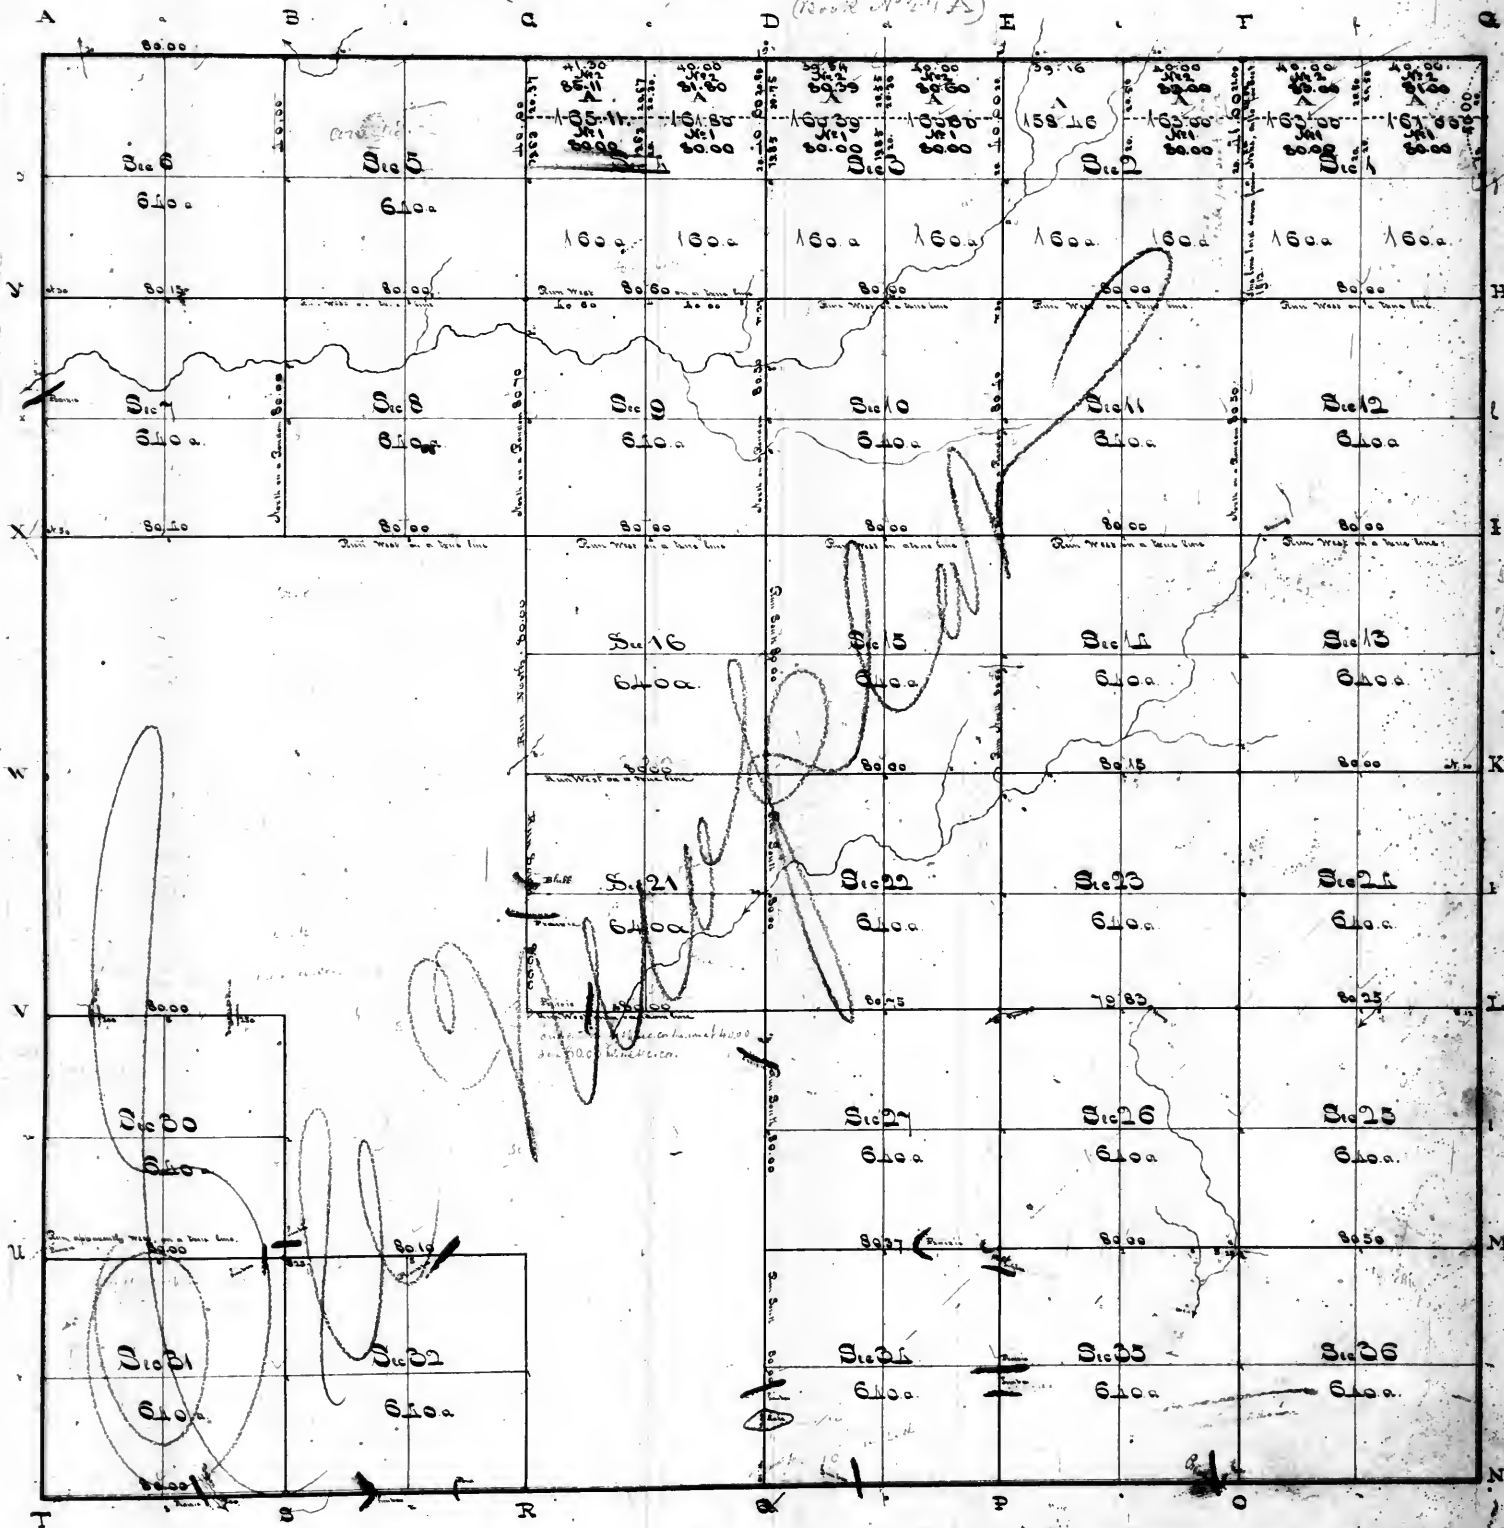

Surveyor's Office
St. Louis Mo.
Plat of the North half
of Sec. 17 & 18 & 19 & 20
quarter of Sec. 21 and 22
to the Commr of the Genl
Land Office.

Surveyor's Office
St. Louis October 11th 1830

The exterior boundary and subdivision line of Township 6 South Range 5 West, are (with the exceptions stated above) represented on the above plat according to field notes thereof on file in this Office mentioned below, but which do not refer the surveys thereof to any principal Meridian viz.

The notes of the survey of the north boundary by John Mc Donald in December 1815 in book numbered 211A.

The notes of the survey of the east boundary apparently by John or James Mc Donald in December 1815 in book numbered 211B.

The notes of the South boundary, east of the Chapel Creek or a channel of the Mississippi (which was run West 3 miles 27 rods) are apparently by John Mc Donald in December 1817; and the notes of the survey of that part of the South boundary West of the Church Creek (which was run East 2 miles 36 rods) signed James Mc Donald and dated November 1816 in book numbered 216.

The notes of the survey of the West boundary are apparently by John Mc Donald in November 1816 in book numbered 215 except the West boundary of Sec. 6 which is a book numbered 214 apparently by John Mc Donald in December 1816.

The notes of the subdivision line in three different hand written put together in a book and dated January 1817, without signature but has the name of Charles Mc Lure in the margin.

W. M. Rice
Asst. Pub. Sec.

T 8. S. R. 5 W. of the 4th p. M.



Copy sent to the Comr. &
Register on 23rd Oct. 1844.

Scale of 40 chains to one inch.

Surveyor's Office.

First Survey 10th of October 1844.

The above plat of township 8 North of the base line, range 5 West of the 4th principal meridian is strictly conformable to the field notes of the survey thereof on file in this office which have been examined and approved. The east boundary of said township 50-50 chains, and the measures of the Mississippi river, 77.20 chains, were surveyed in 1842 & 1843, by A. T. Parker under instructions of the 13th of March 1842. They were paid for on the 29th of June 1844, and charged in the account current of the Surveyor General during the 2nd quarter of that year, under the appropriation of \$3000, of the 3rd of March 1843 (see page 35, of the 4th resolutions of 37th Congress) for the survey of detached and unperfected lines in Illinois & Missouri.


Silas Reed

Surveyor of the public lands
in Illinois & Missouri.

St. Louis

This day recalculated Sec. 1, and sent a copy of the plat
to the Register & another copy to the Comptroller of the Land Office

Fractional Township 7 South of the baseline, Range 3 West of the 4th principal Meridian, except sections and fractional sections 2, 5, 6, 9, 10, 16, 21, 22, 26, 29, 35, 36; and except also fractional sections 27, 28, 34 on the main shore of the Mississippi River, which are omitted on account of errors in the survey thereof. And also a Plat of fractional sections 1, 12, 13, 14, 15, 17, 19, 20, 23, 24, 25, 33, 34, in T. Township 8 South of the baseline, Range 3 West of the 4th principal Meridian.

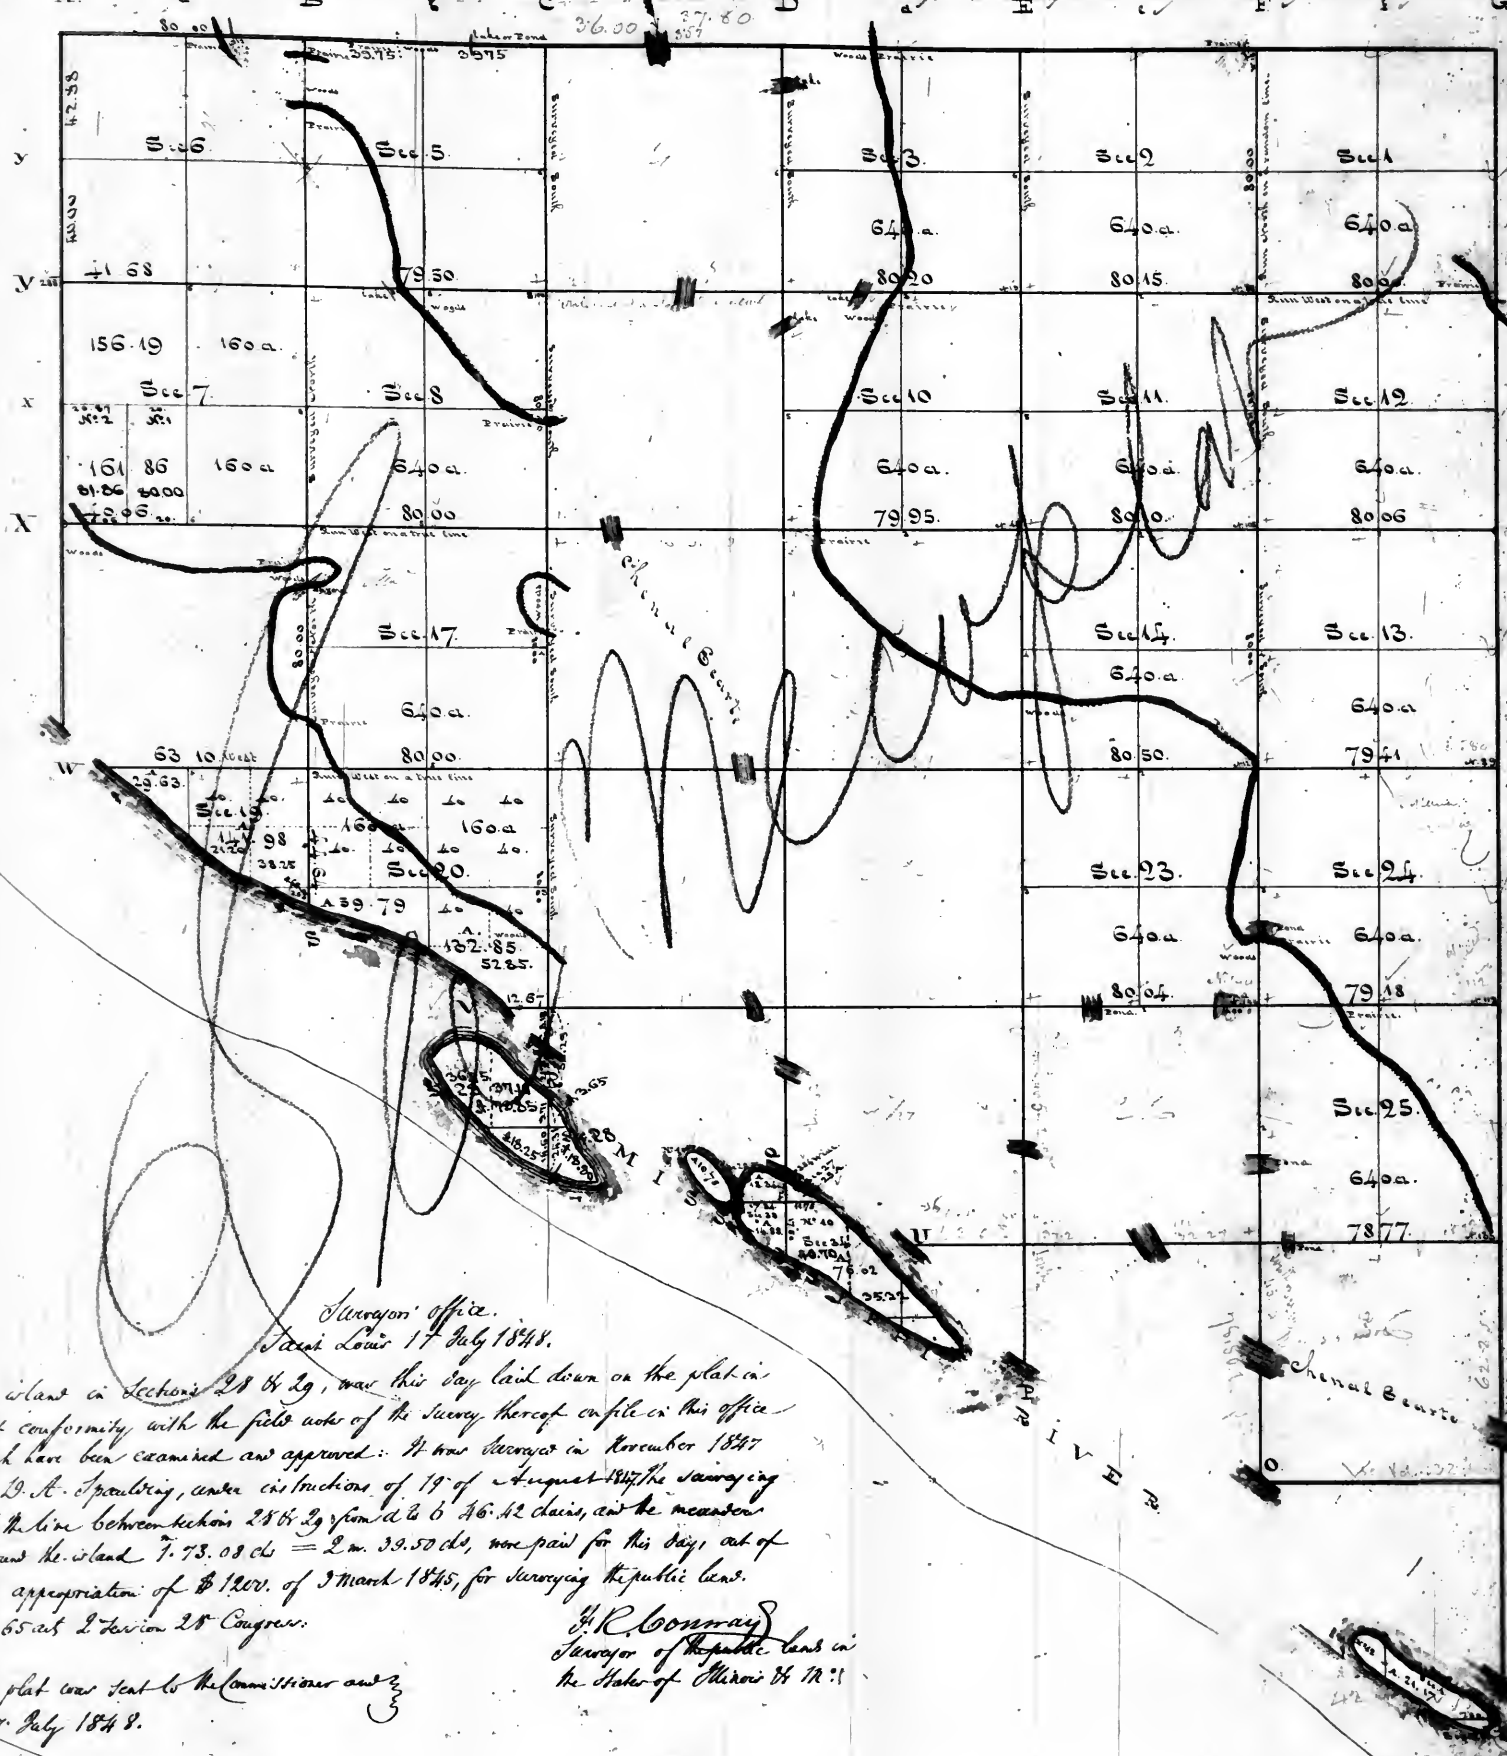

Surveyor's Office
St. Louis 17th July 1848.
Plat of the S.W. quarter of Sec.
4 of T. 8 S. R. 3 W. 420 acres
to the Commissioner of the Land

M
Subdivided under the Act of
the 5th of April 1832, & sent
to the Register of the District
other to the Commissioner of the

| Designation of land | When |
|--|------|
| fil. Sec. 13 & 14 of T. 8 S. R. 3 W. 420 acres | 1848 |

Surveyor's Office.
St. Louis 17th July 1848.

The island in sections 28 & 29, was this day laid down on the plat in strict conformity with the field notes of the survey thereof on file in this office which have been examined and approved. It was discovered in November 1847 by D. A. Spaulding, under instructions of 19th of August 1847 the surveying of the line between sections 28 & 29 from d. 6 46.42 chains, and the measure around the island 7.73.08 chs = 2 m. 39.50 chs, was paid for this day, out of the appropriation of \$1200. of 3 March 1845, for surveying the public lands. p. 65 art. 2 session 28 Congress.

H. R. Conway

A copy of this plat was sent to the Commissioner and
Registered on 17th July 1848.

Surveyor's Office - 2
St. Louis 11. October 1830

The above plat, of sec. 1 & part sections, 1, 2, 3, 7, 8, 10, 11, 12, 13, 14, 17, 19, 20, 23, 24, 25, on the main shore of the Mississippi River; of sec. 27, 28, 33, 34, on islands, 2nd Imp. N. 7. S. R. 5. W. also, of fil. Sec. 1 & 2 (on Island N. 42) of 1st Imp. & S. R. 5. W. is conformable to the following mentioned Notes of survey thereof on file in this office: viz.

Notes of E. B. Borden, (except along sec. 36) in Book of Exp. N. 211. apparently by John - James
of the North Boundary - (east of the vicinity), in Book N. 21, - apparently by John McDonald
of the West Boundary (along sec. 7), in Book N. 216 - apparently by John McDonald
of the Sub-division lines, (by three different hands) in Book N. 1036 without signature and
except lines & measures on Island N. 40 41, and 42, which are by John D. Pratt -
March 1821. - W. M. Ree
St. of Public Lands.


downship 1 South of the base line. Range 6 West of the 1st Principal Meridian.

Subdivided under the Act of Congress of April 1850, and sent copies to the Register of the District and another to the Commissioner of the Land Office.


Page 44 vol 71

The note dated 13 April 1850.

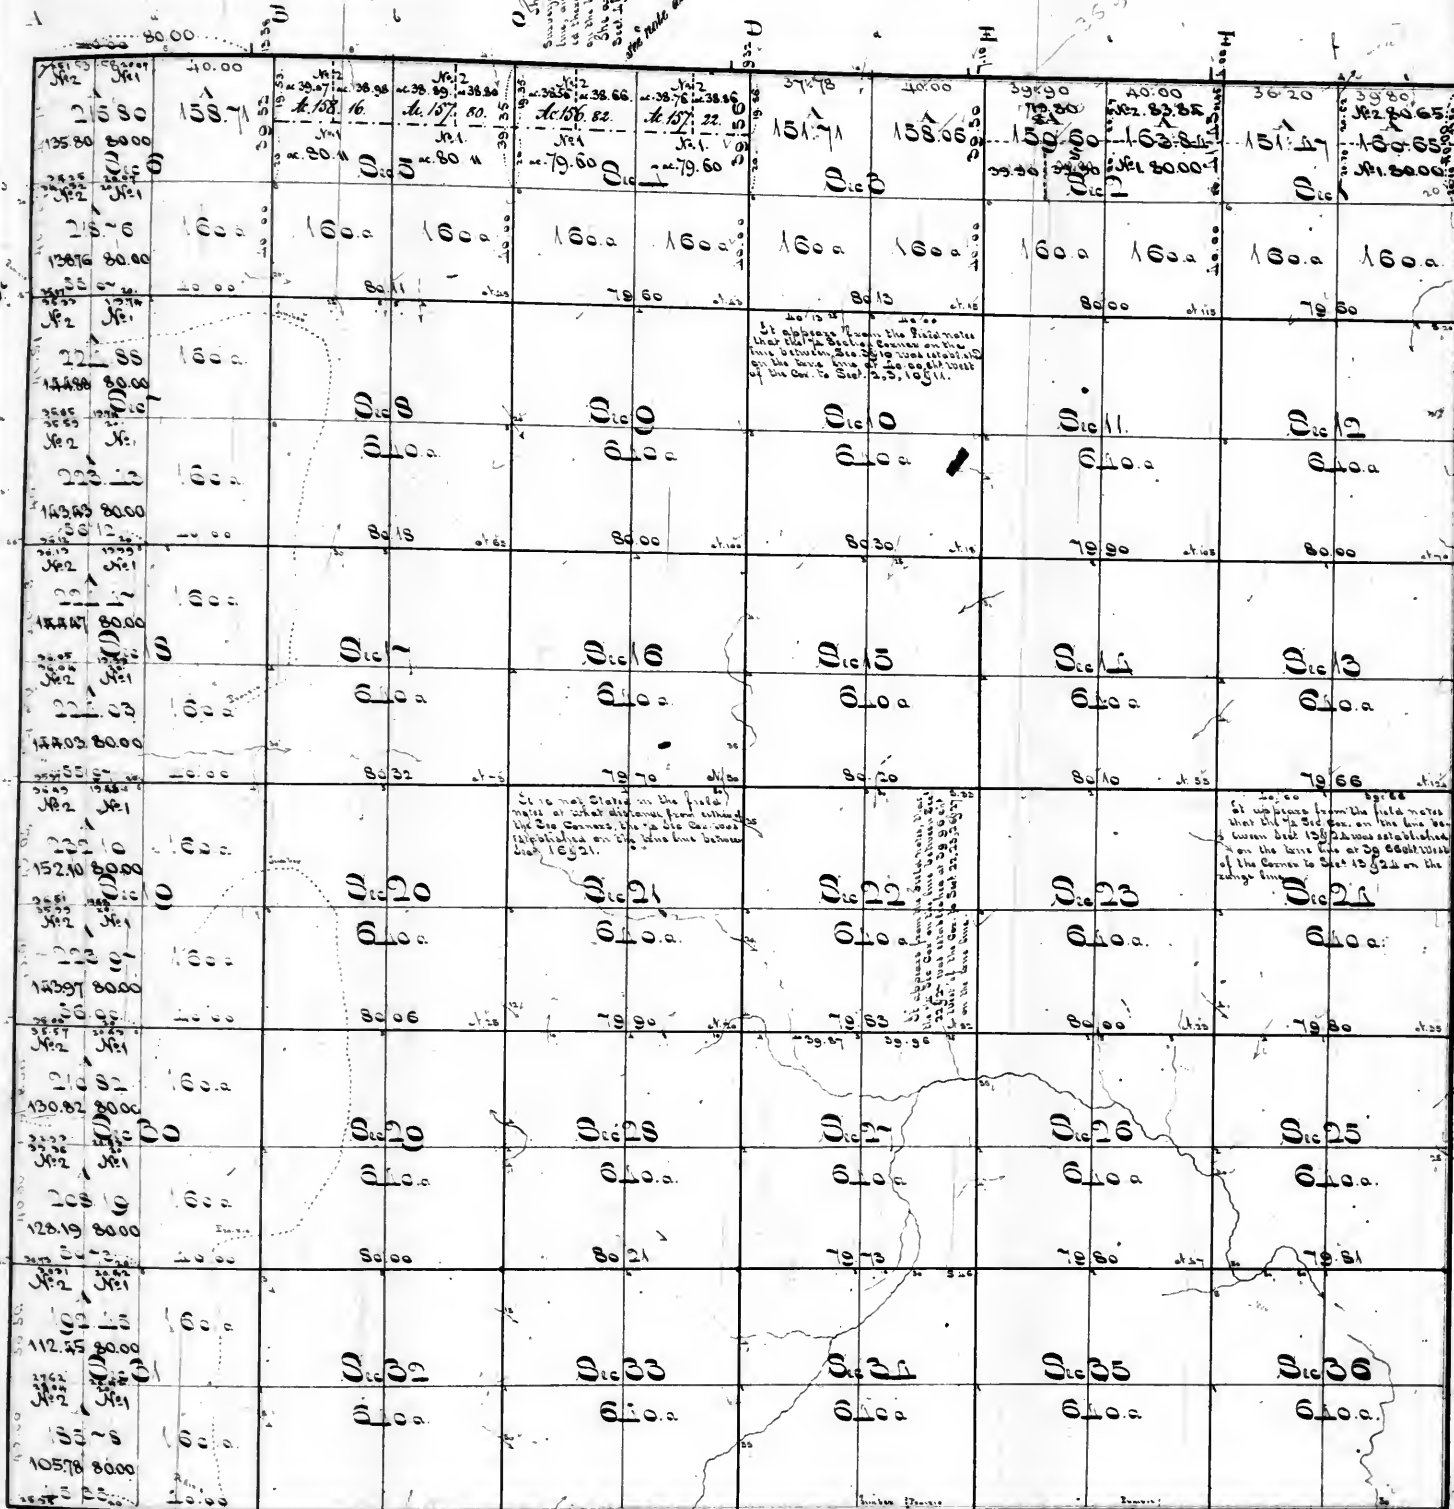

| Designation of tract. | When surveyed. | By whom. |
|-------------------------------|-----------------|-----------------------|
| North halves of sec. 4 and 5. | 13 April 1850. | 1 st April |
| West halves of sec. 4 and 5. | 15 January 1847 | 15 Jan |

Surveyor's Office
St. Louis, October 1850.





Surveyor's Office
Saint Louis 13 April 1850.

Sections 4 and 5 of this township have been plotted and the areas of the 16 1/2 and 17 1/2 quarters thereof have this day been calculated upon the assumption that the boundary lines which purport to be meridians are parallel to each other, which makes north boundary of section 4 - 79.66 chains and the north boundary of section 5, 80.11 chains.

Surveyor's Office
Saint Louis 12th October 1850.

William Miller
Surveyor of the public lands in the State of Missouri

The exterior boundary and subdivision lines of T. 1. S. R. 6. W. are represented on the above plot, according to the notes thereof mentioned below, which do not refer the Surveyor (except of the North boundary) to any principal Meridian.

The North boundary from notes in Book of Exterior N. 218, without signature and dated in November 1816.

The East boundary from notes, apparently of James M. Donald in March 1816, in book of Exterior numbered 212.

The South boundary from notes, apparently of James M. Donald in March 1816, in a book of Exterior lines of Township numbered 212 and signed "John M. Donald".

The West boundary from notes (apparently of James M. Donald in March 1816) in book of Exterior numbered 212 signed John M. Donald.

The Subdivision lines from notes dated in January 1817, without signature (and apparently by 3 or 4 different persons) put together in a book numbered 1024.


St. Louis 10 April 1850.

A copy of the plot of the 16 1/2 and 17 1/2 quarters of sec. 4 and 5 of the W. 1/2 of T. 1. S. R. 6. 7. 18. 19. 30 and 31 sent this day to the Comr. of the Genl. Land Office.

Township 2 South of the base line, Range 6 West of the 4th Principal Meridian.

page 45 vol 21

6570
7285

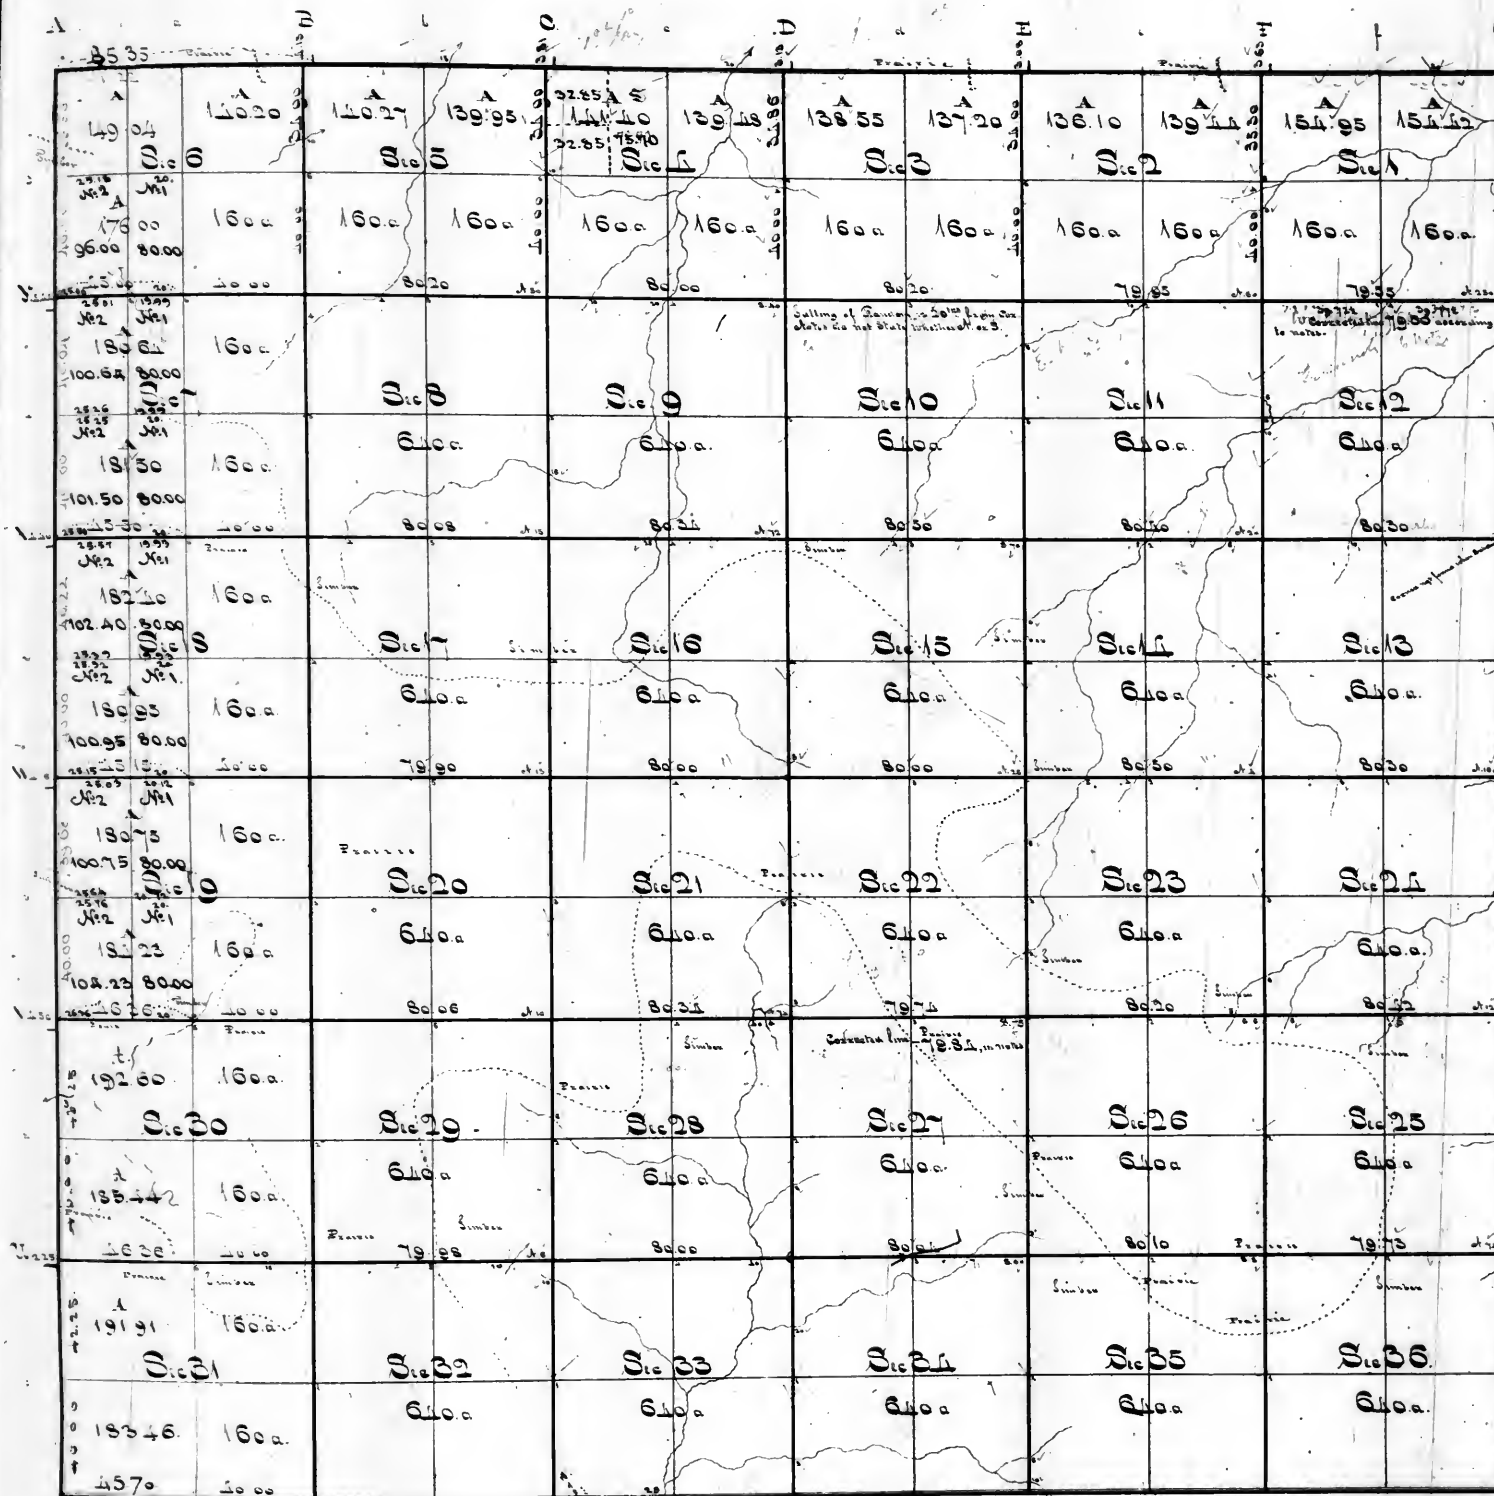

At the intersection of the random line between sections 12 and 13, with the range line, the corner was not found, consequently the falling line from could not be determined, said line between sections 12 & 13 was corrected, West on the supposition of the falling being the same as that of the line between sections 2 & 3, viz. 12.3 links North of the corner. In the description of the corner to sections 12, 22, 27 & 28, it is erroneously called "boundary 2 South."

The intersection of the line between sections 30 & 31 with the range line is not given in the field notes, the areas therefore of the West halves of sections 30 & 31 are omitted on this plat.

Surveyor's Office

Saint Louis 21 May 1836.

The areas of the N.W. and S.W. quarters of sections 30 & 31 which were originally omitted on this plat for the reasons stated above have this day been calculated as if the line between said sections had intersected the Range line at half the distance between the corner thence for sections 29 and 30 and the Townships corner. The said line between sections 30 and 31 will therefore be surveyed on accordance herewith from the quarter section corner already established thence.

Surveyor's Office

Saint Louis 10 Sept. 1842.

Plat of the S.W. quarter of Sec. 6 and of the West halves of Secs 7, 12 & 13 sent this day to the Comptroller of the Genl. Land Office.

Surveyor's Office

Saint Louis 16 January 1847.

Subdivided the N.W. q. of Sec. 6 conform to a previous sale (marked S) & sent a copy to the Register & a copy to the Comptroller of the Genl. Land Office.

Surveyor's Office

Saint Louis 12th October 1850.

The exterior boundary and subdivision lines of T. 2 S. R. 6 W. are represented on the above plat according to the notes thereof mentioned below, which do not refer the surveys to any principal Meridian viz:


The North, East, South & West boundaries, from notes apparently of James M. Donald, in March 1816, in Book of entries of Townships numbered 212, and signed "John M. Donald."

The subdivision lines from notes dated in December 1816, and in January 1817, without signature (and apparently by 3 or 4 different persons) put together in Book number 1020. —

Wm. C. Rice
St. of Pub. Lands

Map of Township 3 South of the Base Line Range 6 West of the 4th Principal Meridian.

page 46 vol 21

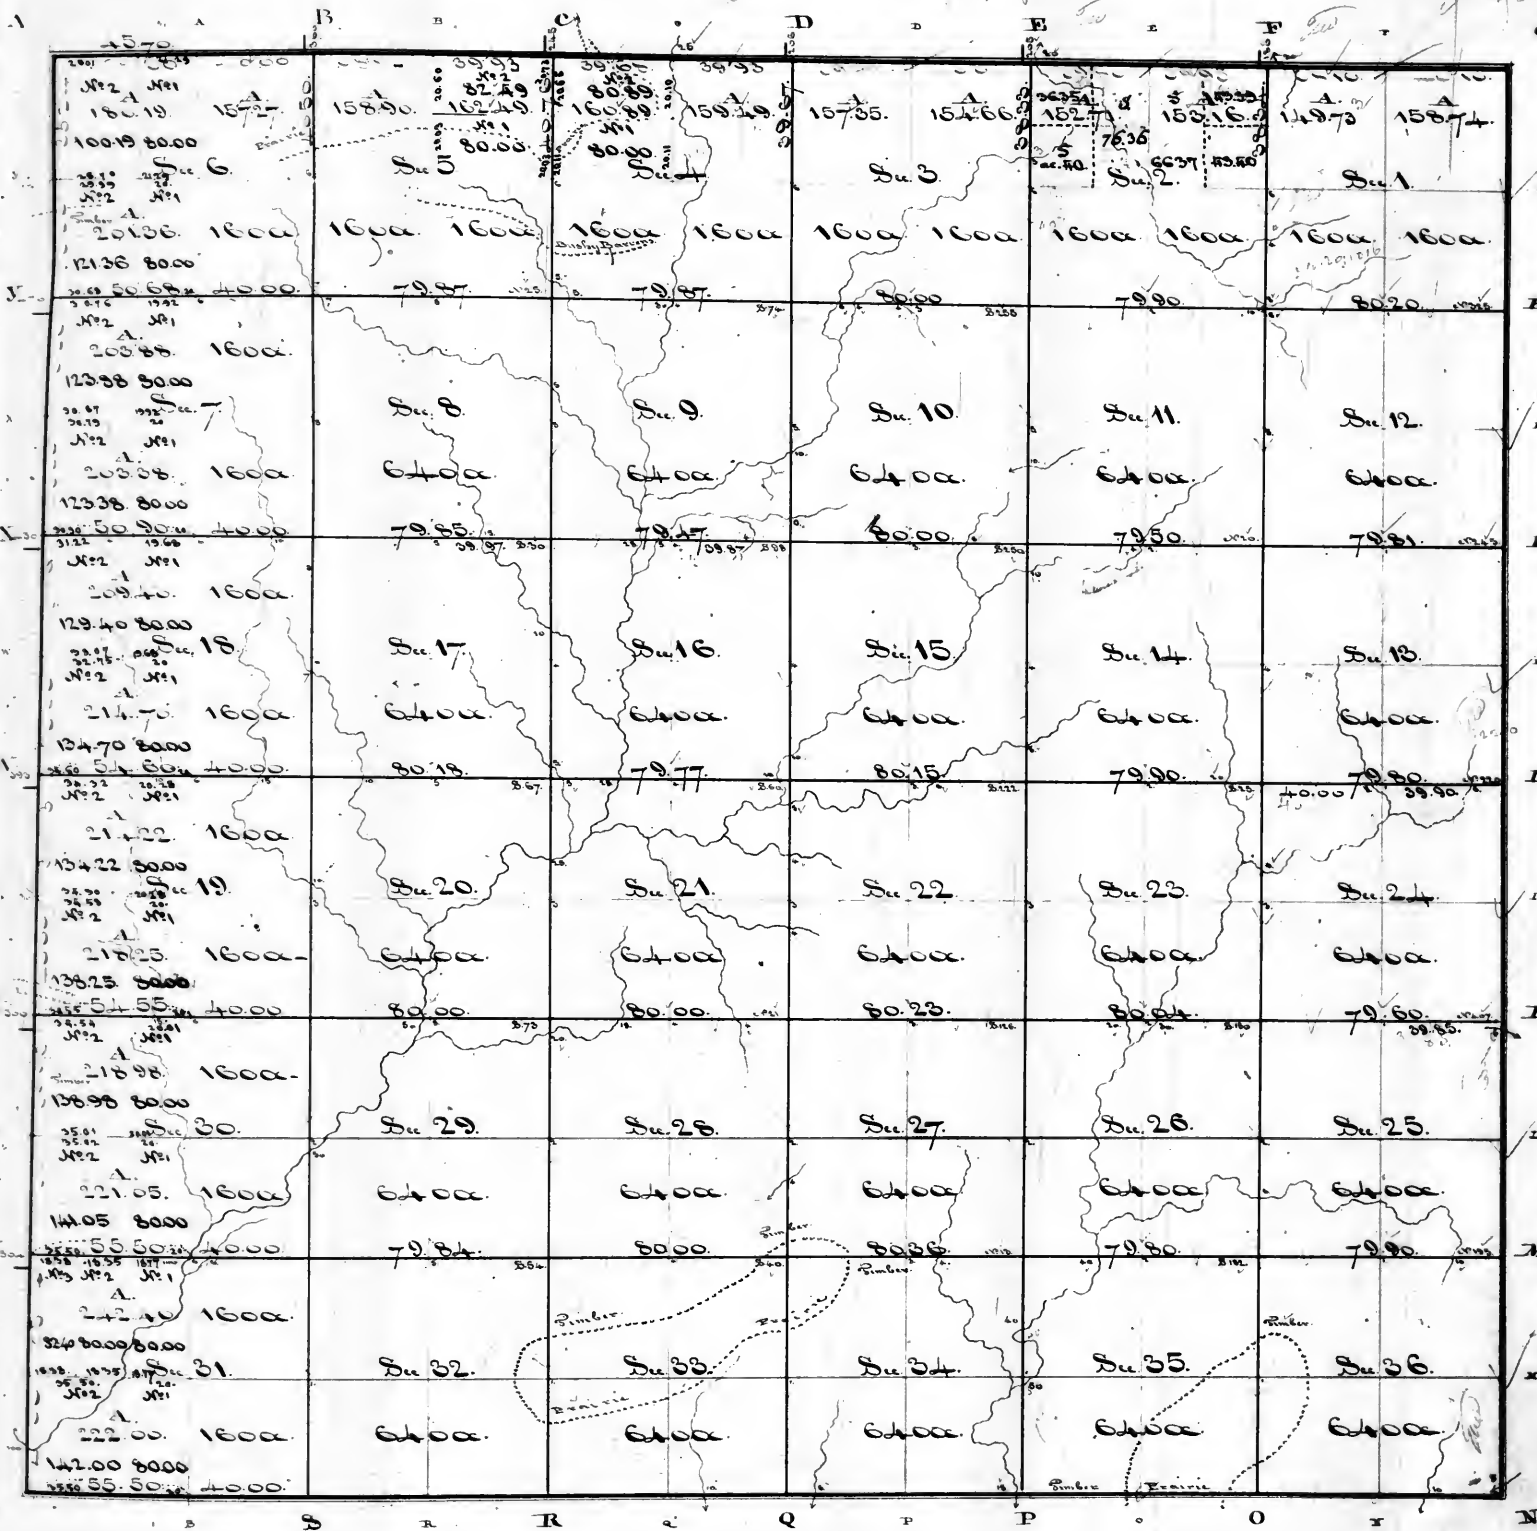

Note:
The distance of the intersection of the line between Sections 19 & 20 of this Township South of the corner of Sections 24 & 25 in T. 3 S. R. 6 W. is doubtful in the field notes, and is set down on this plat in conformity with the old plat on file signed "John M. Donald".

142.77
66.37
66.36

157.71
116.36
36.35

5

142.25

Surveyor's Office
St. Louis 10th Sept. 1847.
Part of the N.W. quarter of Sec. 16, of the N.E. quarter of Sec. 5, and of the West halves of Secs. 6, 7, 10, 15, 20 & 31, sent this day to the Commr of the Genl. L. O.

Surveyor's Office
St. Louis 15th January 1847.
Subdivided the North half of Sect. 2, so as to conform to previous sale (marked S.) & sent a copy to the Register & another copy to the Commr of the Genl. Land Office.

Examined

Surveyor's Office
St. Louis 12th October 1850.


The entire boundary and subdivision lines of T. 3 S. R. 6 W. are with the exception stated in the margin represented on the above plat according to the notes thereof mentioned below and which do not refer the surveys to any principal Meridian viz. the North and West boundaries from notes apparently of James M. Donald in March 1816 in Book of Entries signed "John M. Donald".

The East boundary from notes apparently of John M. Donald in December 1815 in Book of entries N^o 211 A.
The South boundary from notes apparently of John M. Donald in December 1816 in Book of entries numbered 216.
The subdivision lines from notes without signature (and apparently by 3 or 4 different persons) put together in Book having the name of John M. Donald written on a page preceding the notes.

W. H. R. Rev
Sr. of Pub. Lds

Map of Township No. 4 South in the Dickinson Range No. 6 West about the Principal Meridian

page 47 vol 21

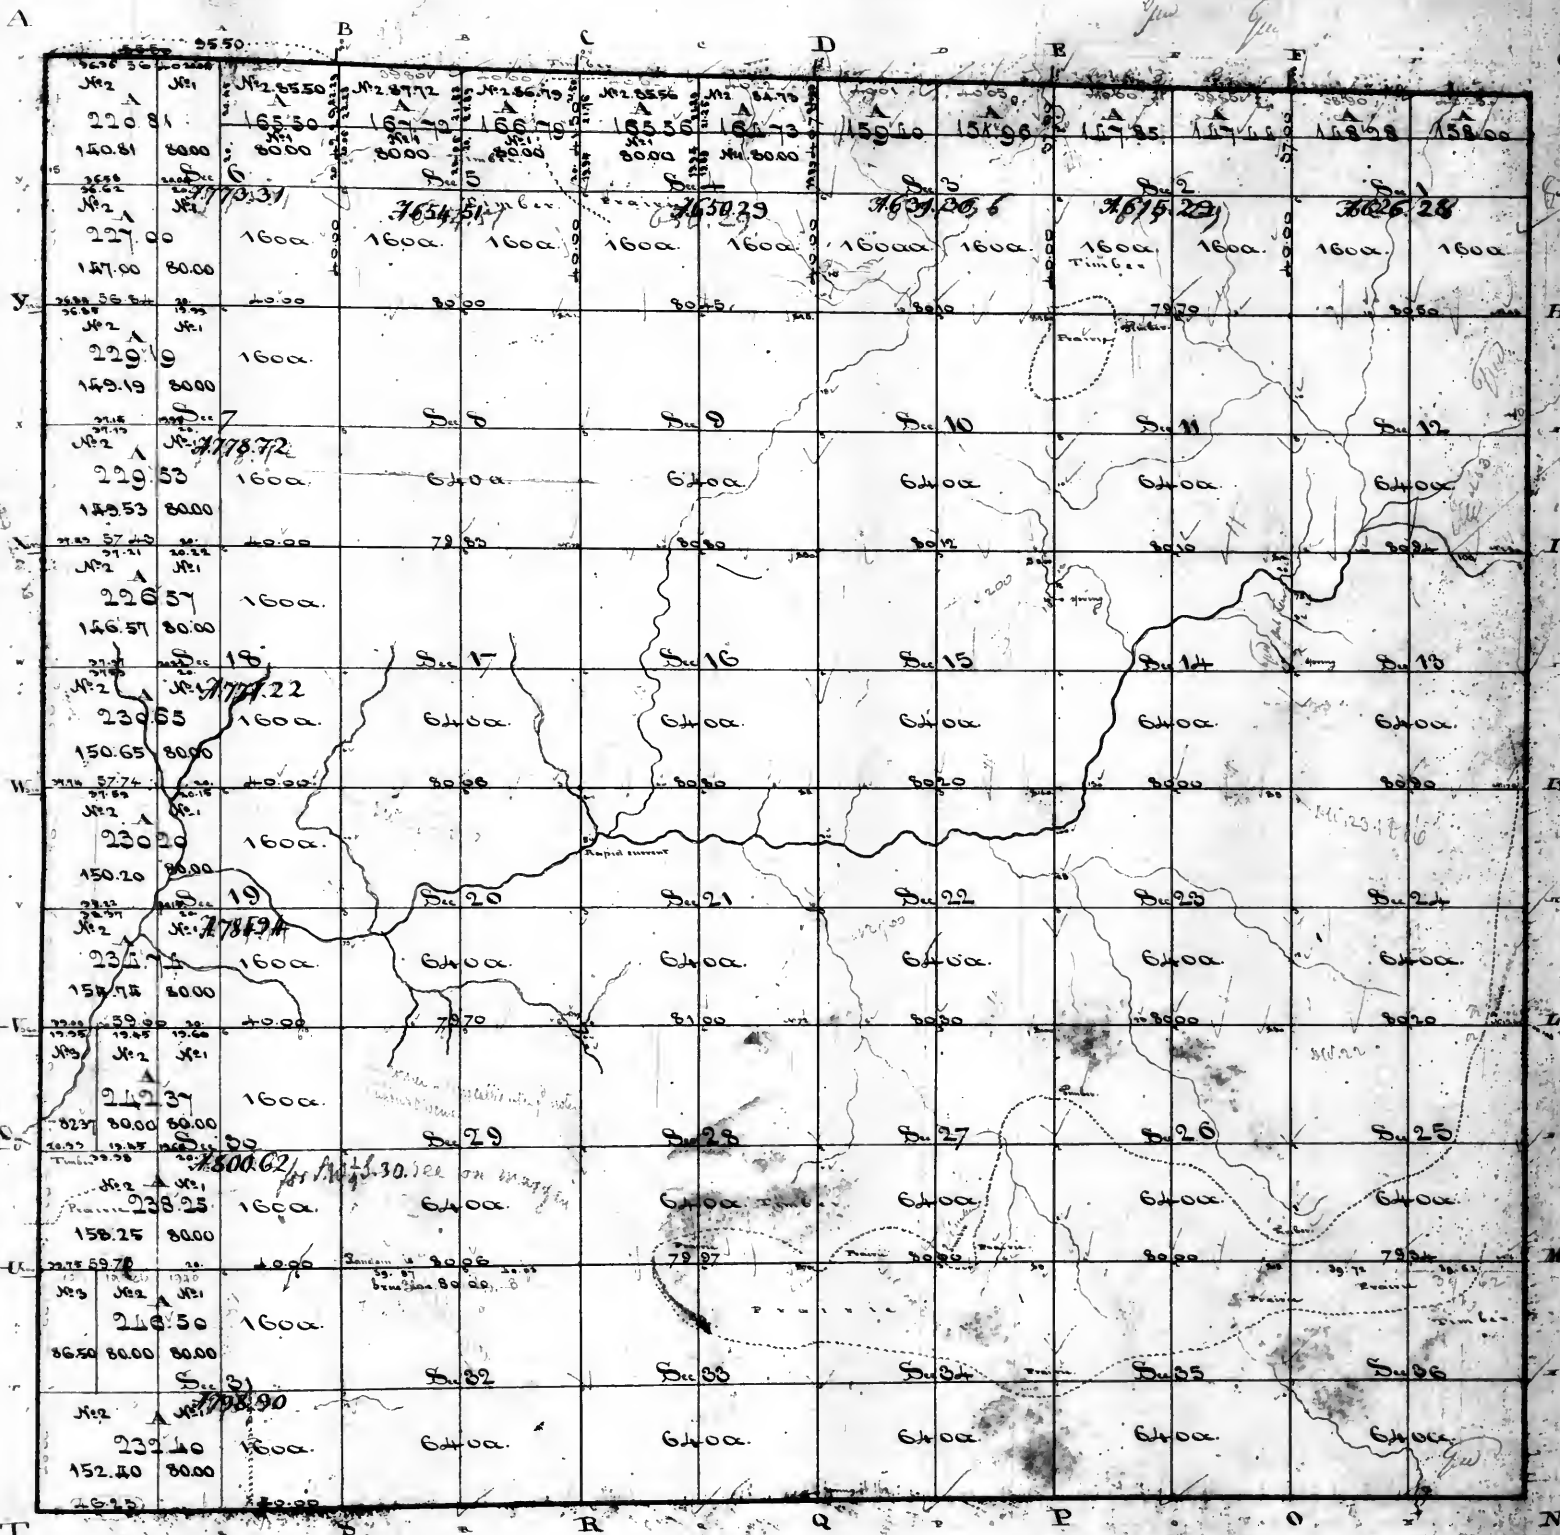


Surveyor's Office
St. Louis 10th Sept. 1842.
Plat of the North halves of Sec
of the West half of N.E. 1/4 of Sec
in file West half of Sec
1/2, and this plat is
of the said Sec 1/2.

Surveyor's Office
St. Louis, Sept. 17th 1852
Subdivided this land
S.W. 1/4 Sec 30, so as
conform to a previous
plat sent a copy to the
and another copy to the
of the General Land

The Exterior Boundary and subdivision lines of Twp. 4 S. R. 6 W. are represented on the above plat according to the following notes:
The North Boundary from notes apparently of John G. Donald in December 1816 in book of Entries numbered 216.
The East Boundary from notes apparently of John G. Donald in December 1816 in book of Entries numbered 216.
The South and West Boundaries from notes (apparently of James G. Donald in March 1816) in book of Entries numbered 212, signed
— John G. Donald.
The Subdivision lines, from notes without signature, (and apparently by 3 or 4 different persons) put together in a Book Numbered 1018.
W. M. Rice
S. J. J. J. J.

Me 28
T 5 S R. 6 W. of the 4th p. M.

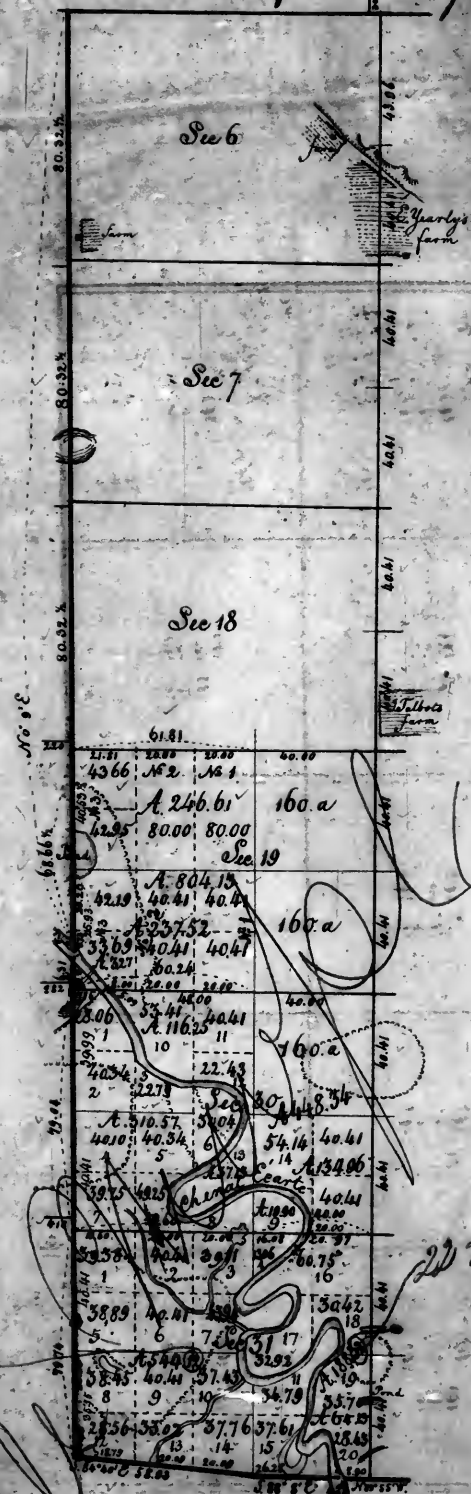

Statement refers to in
the next field below

| Line | Ac. Ch. Lk. |
|--|-------------|
| South by Sec. 34 | 1 18 38 |
| Sec. 34 to 31 | 1 40 32 |
| 31 to 30 | 1 19 56 |
| 30 to 29 | 1 00 22 |
| 29 to 30 | 1 20 36 |
| 29 to 28 | 1 00 22 |
| 28 to 19 | 1 21 31 |
| 19 to 18 | 1 00 22 |
| 18 to 7 | 1 00 22 |
| 7 to 8 | 1 00 22 |
| 8 to 5 | 1 04 37 |
| Amount of land
containing along said 34 | 9 56 52 |
| 30 to 31 | 20 65 02 |

A copy of this plat sent to the Commissioner of
Registers on 23rd of October 1844.

Variation:
on West boundary 8° 23' East
all the other lines 7° 30' East.
Scale of 40 chains to one inch.

Surveyor's Office, Saint Louis 18th of October 1844.

The above plat of section 19, 30 431 Township 5 South of the base line
range 6 West of the A¹ principal meridian, is strictly conformable to the field notes of the survey made on file in this office
which have been examined and approved in 1842 & 1843. James R. Parker, under instructions of the 12th March
1843, surveys the lines described in the above statement, 20 miles 65.02 chains, which were paid for in the 3rd quarter
of 1844 and charges in the account current of the Surveyor General during that quarter, under the appropriation of
\$3000. of the 3rd of March 1843, (p. 95 act 3rd session 27th Congress) for the survey of unfinished and selected lines in
Missouri & Arkansas.


Silas Reed
Surveyor of the public lands in
the State of Missouri & Arkansas.

Township 5 South of the base line, Range 6 West of the 1st principal meridian.

48

except Sections 19, 20 & 31 which are omitted on account of errors in the surveys.

48 vol 21

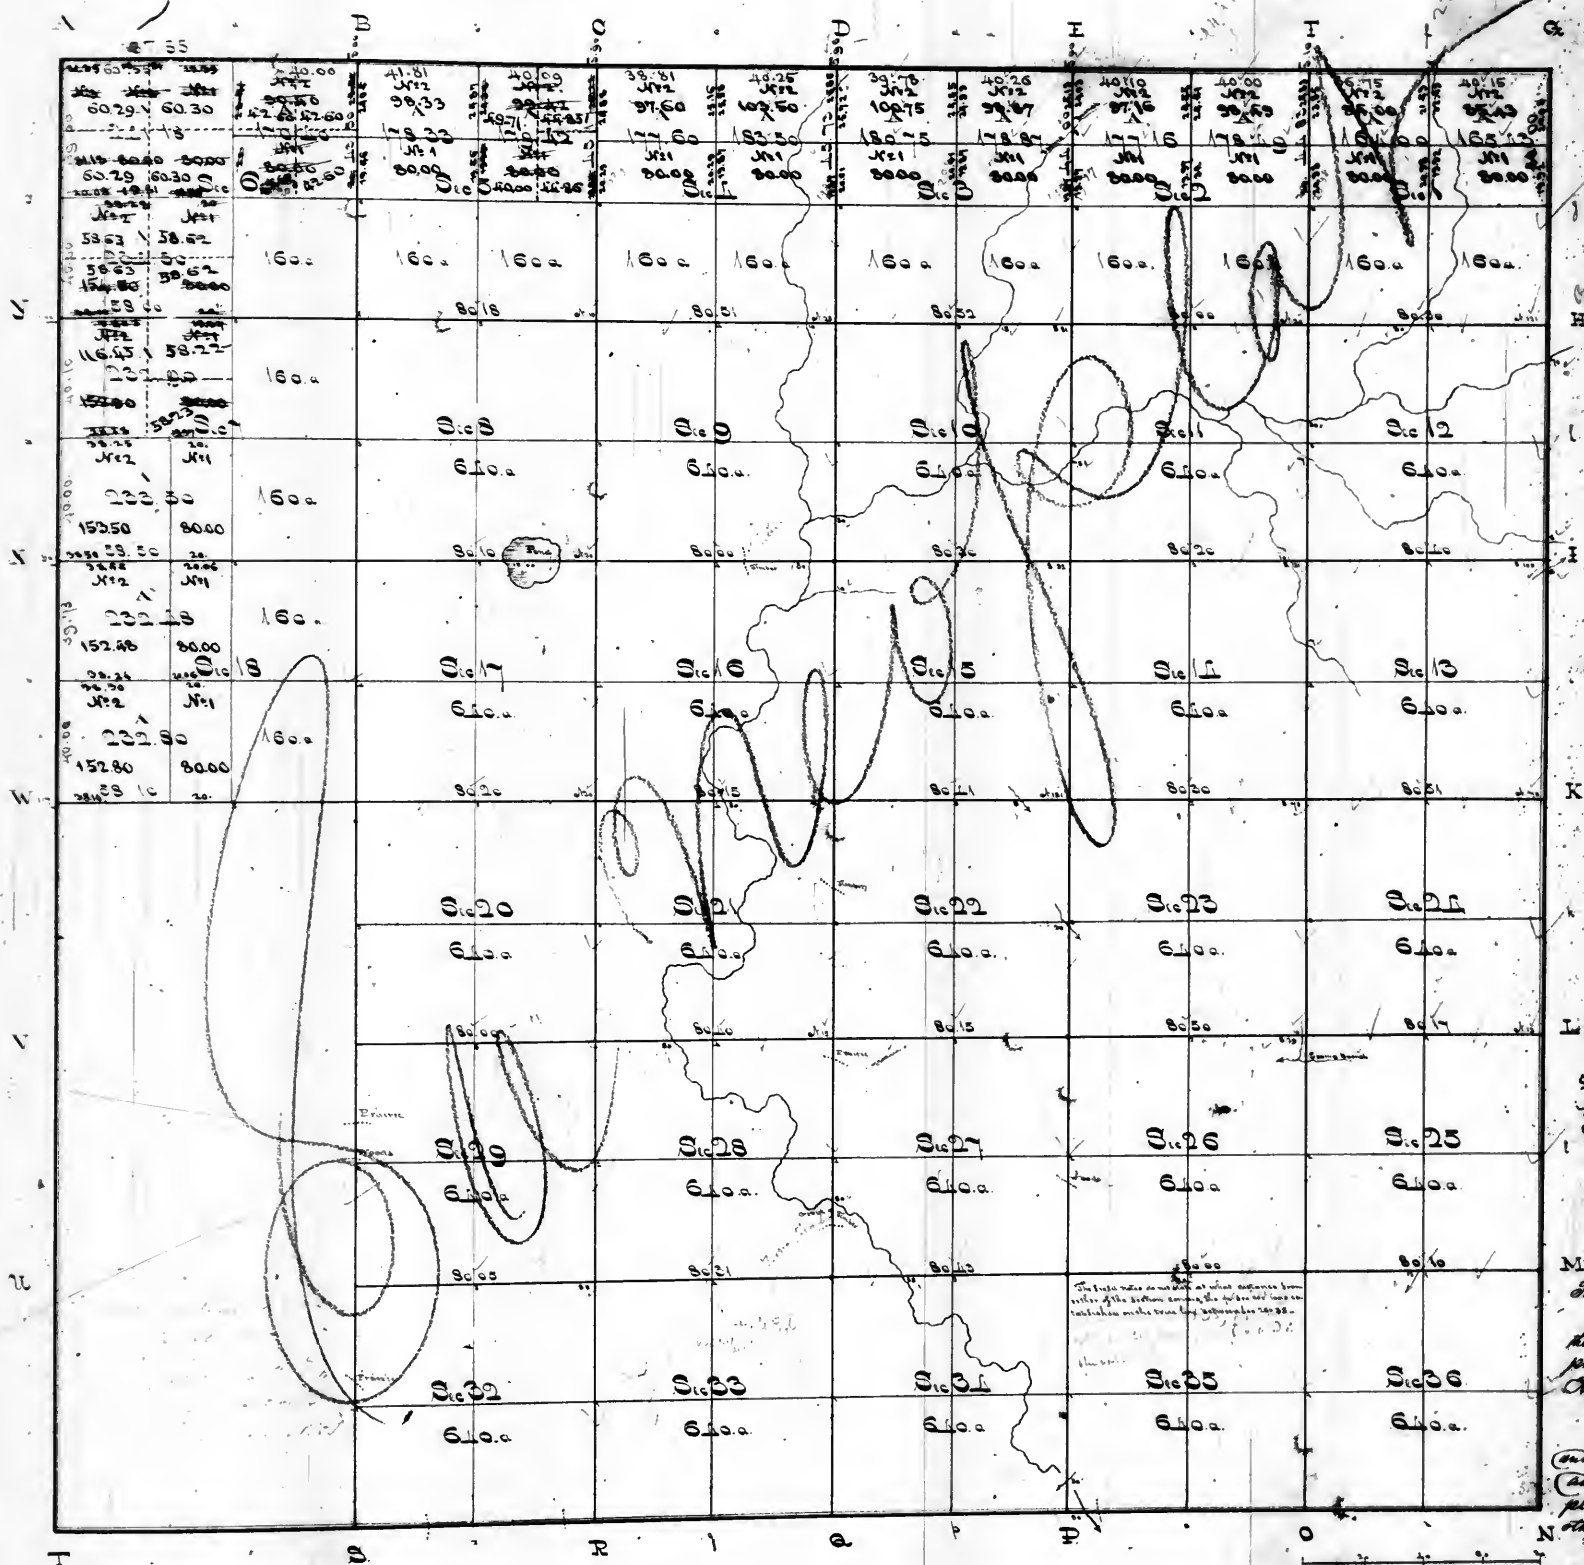


Notes of the Surveyor
The original length of the line was
what was first written, to 80.00.
1. Plot of exp. 5. S. & 5. W. signed
the distance is represented by
on the old plot of J. S. & R. G.
not signed. - the line is

1 in 11 Miles
St. Louis 6 in 30 when established
25, sec. 15, 16, 17, 2

Fractional Township 6 South of the base line, Range 6 West of the 4th principal Meridian, except sections and fractional sections, 4, 9, 10, 13, 14, 15, 24 — 26; that part of sections 5 & 6 on the E. or left bank of the Chenal Beavie; and of sections 11, 12 & 23 on the S.W. or right bank of the Chenal Beavie, and of section 8 & 17 on the main shore of the Mississippi — and except also the north half of sec. 25.

page 49 vol 21

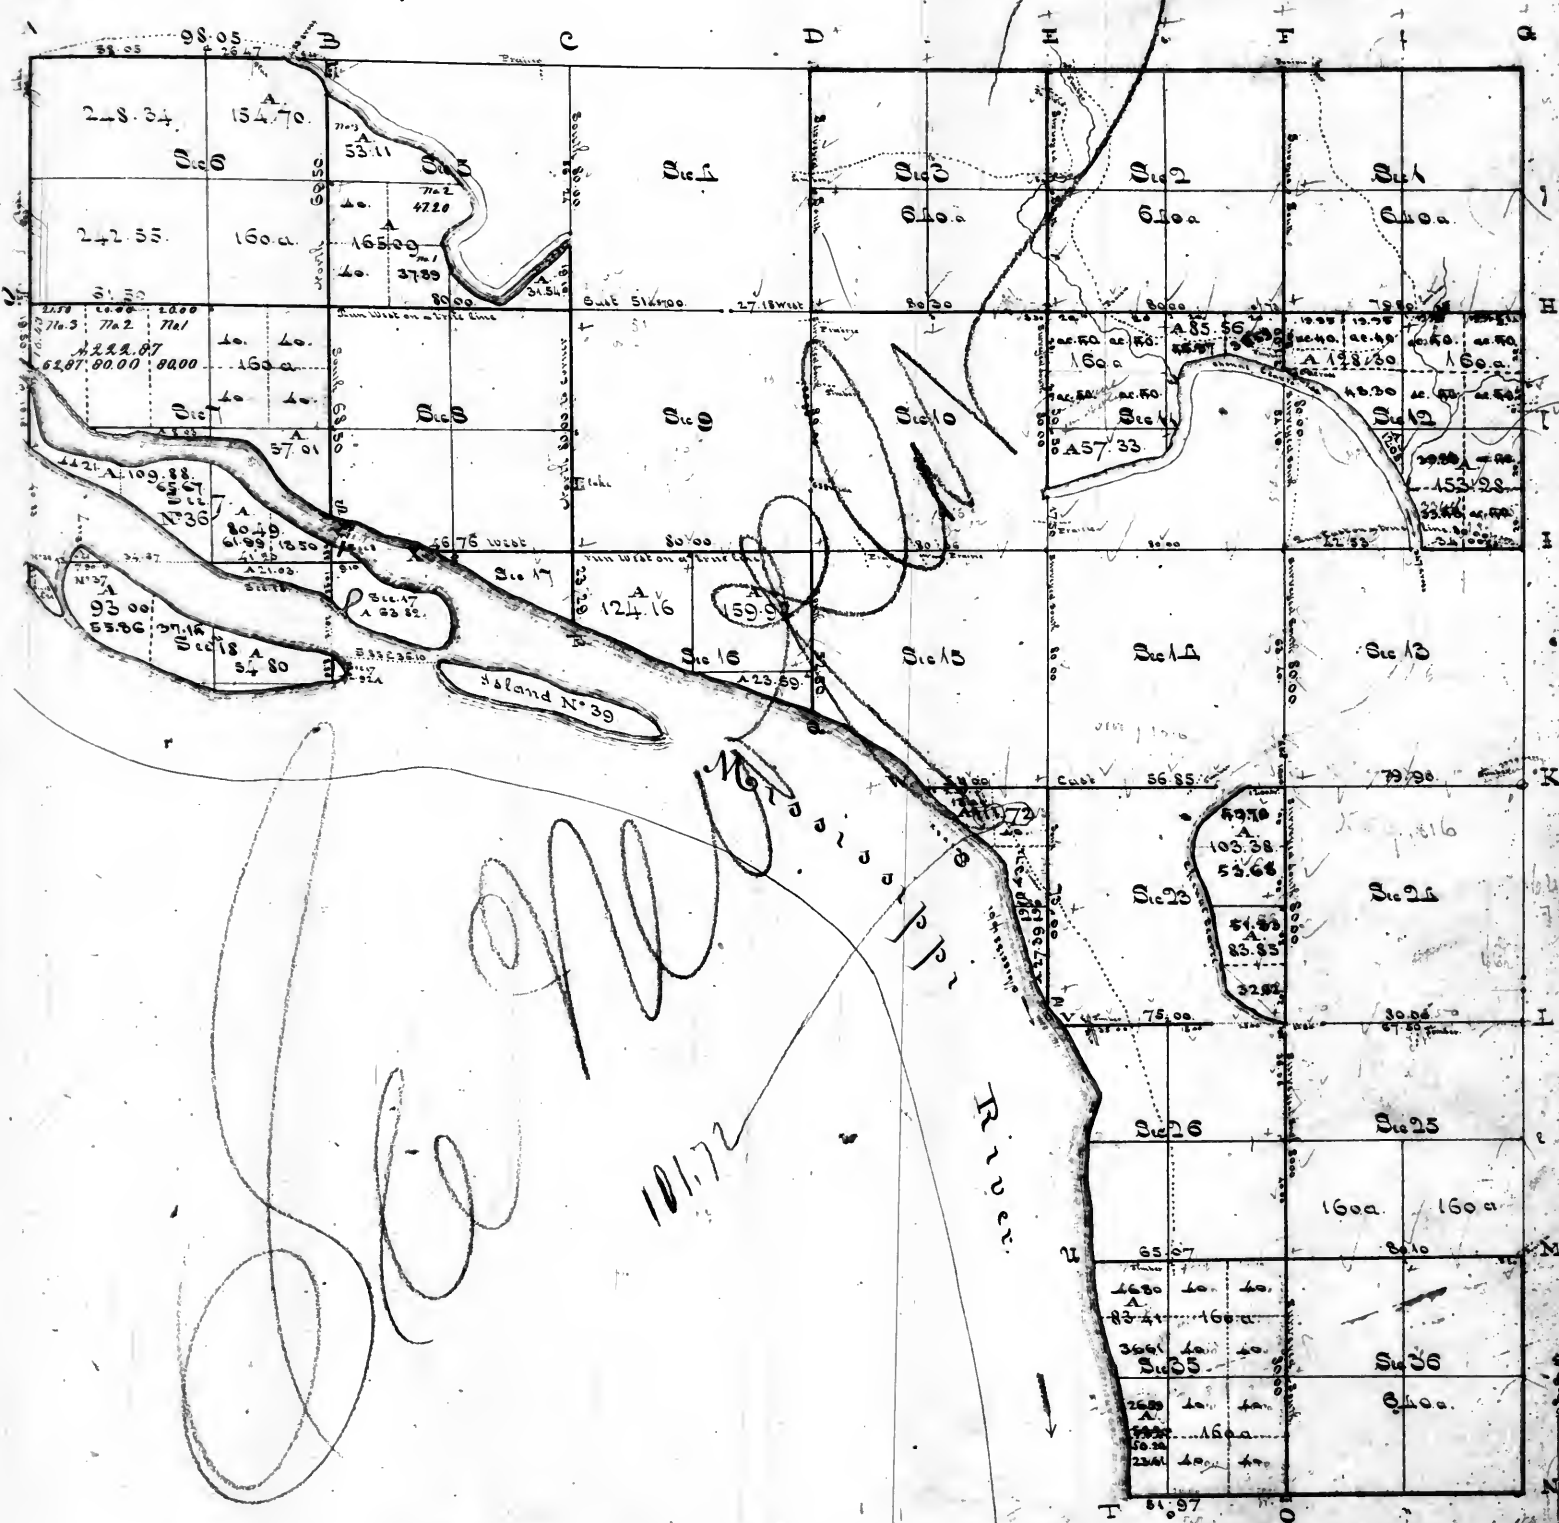

Surveyor's Office
St. Louis, Mo. 1842
Plat of fractional sections 5 (west of
of fractional section 7 (on main shore
land N° 36 in Mississippi
and of fractional sections 22 & 23
this day to the Comptroller of the
General Land Office

Subdivided under the Act of Congress
of the 5th of April 1820, passed to the
of the District, to the Comptroller of the
General Land Office

| Designation of tracts | Acres |
|---|--------|

Surveyors Office

St. Louis, October 14th 1830

The Exterior Boundary and Subdivision lines of Township 6 South, Range 6 West of the 4th principal Meridian, including the meanders of the left bank of the Mississippi and of Island number 37 and part of Islands numbered 36 & 38; and the meanders of the Chenal Beavie, are laid down on the above plat according to the field notes of the survey thereof mentioned below.

The North, South and West boundaries, except on Islands N° 36 & 38, from notes (apparently of John M^{rs} Donald in November 1816) in book of exteriors numbered 216.

The East boundary, from notes (apparently of John M^{rs} Donald in November 1816) in book of exteriors numbered 216, except the East boundary of sec. one, which is from notes (apparently of John M^{rs} Donald in December 1815) in book of exterior boundaries numbered 211A.

The Subdivision lines and meanders (except of the Islands numbered 36, 37 & 38) are from notes of the survey thereof in books numbered 1016A & 1016B, signed John M^{rs} Donald, and 1016C, without signature, all in November 1816.

Island N° 37, and that part of Islands numbered 36 & 38 which lies in this Township, are from notes of the survey thereof by John S. Potter in March 1821.


Wm. H. Potter
Surveyor General

T. 7. S. Pr. 6. W. of the 7th pt. M^o

Surveyor's Office

St. Louis, August 13th 1845

Note. The Register at Quincy in his letter to this Office, of the 15th of November 1844 reported all the whole quarter sections of this Township as potential for military purposes, and the fractional sections were divided 5, as sold. On this Plat the fractional sections are divided in to tracts, to suit these sales, except such the areas, which are set down in conformity with the instructions of the Commissioner of the General Land Office, dated the 25th of April 1845.

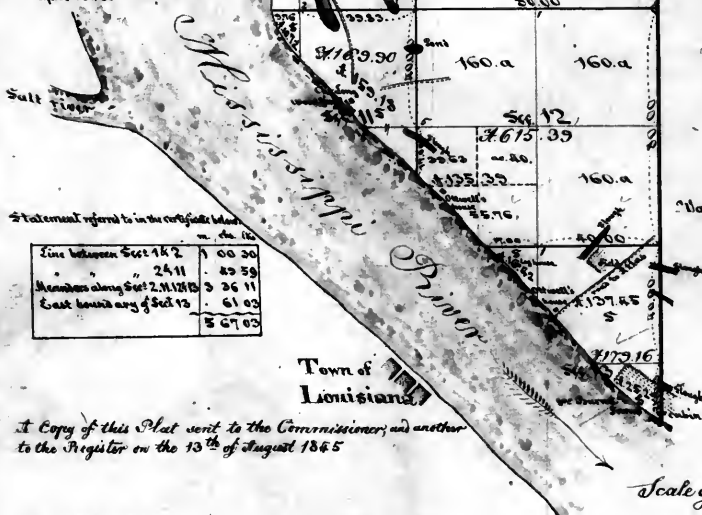

A Copy of this Plat sent to the Commissioner; and another to the Register on the 13th of August 1845

Surveyor's Office

St. Louis, August 13th 1845


The above Plat of Township 7 South of the base line, Range 6 West of the 7th principal Meridian, is strictly conformable to the field notes of the survey thereof on file in this Office, which have been examined and approved.

In 1842 & 1843, Amasa D. Parker, under instructions of the 12th of March 1842, surveyed the lines detailed in the Marginal Statement, 5 miles 67.63 chains, which were paid for in the 2^d quarter of 1844, and charged in the account current of the Surveyor General during the same quarter under the appropriation of \$3000 of the 3^d of March 1843, for the survey of ungranted and detached lines in Illinois & Missouri, at a rate not exceeding six dollars a mile.

See p. 35 arts 3^d Session, 27th Congress.

J. K. Courney
Surveyor of the public lands in the
States of Illinois & Missouri.

Page 50, vol 21

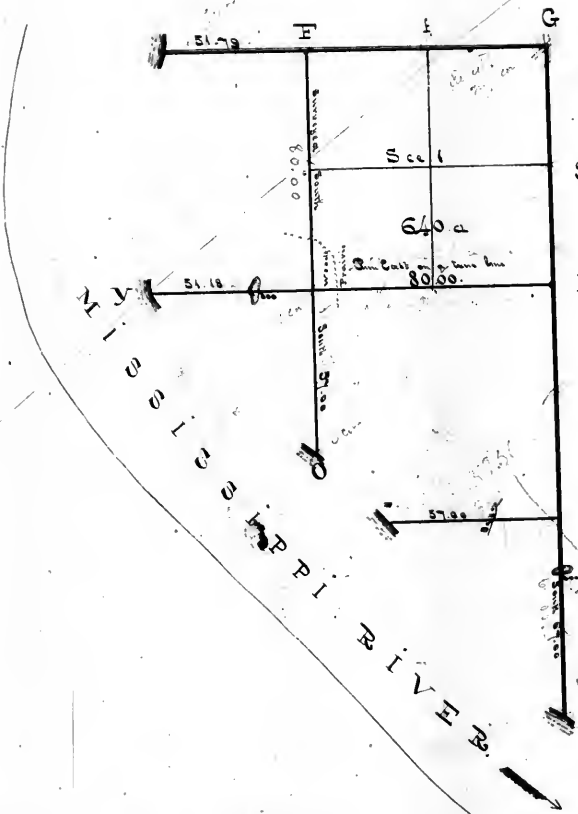

Note. The consequence of the inaccuracy of the bearings of
 Jack's Look 2. — 11. 12. 13. 14. this cannot be possibly deter-
 mined as they are omitted on this Plate.
 The Original Notes of the Survey of the East Ind. Co.
 of 1761. call for running South between Oct. 15. 5. 1761.
 S. West. 12. 15. 16. the top of the note however calls for the


See Steamers by Parker 26
Commissioner Letter of the
Shore 1845
Letter of 15 Nov 1846
Not on file
There are two plates of
on file ~~original~~ and unbound
is cancelled - 1845
13 August 1845
See also to

Surveyors Office
St. Louis 29th Septem-ber 1830
The above plat of section No. 1 - pt. 2 p. 7 S. R. 6
west of the 4th Meridian is confirmed
with the notes of the survey thereof on file in this
office - Wm. Reed
Sr. Asst. Secy

Map of Township 1 South of the baseline in Range 7 West of the 4th Principal Meridian.

Notes: The survey was made by John McDonald in 1815. The notes are in a book numbered 218. The survey was made by John McDonald in 1815. The notes are in a book numbered 218.


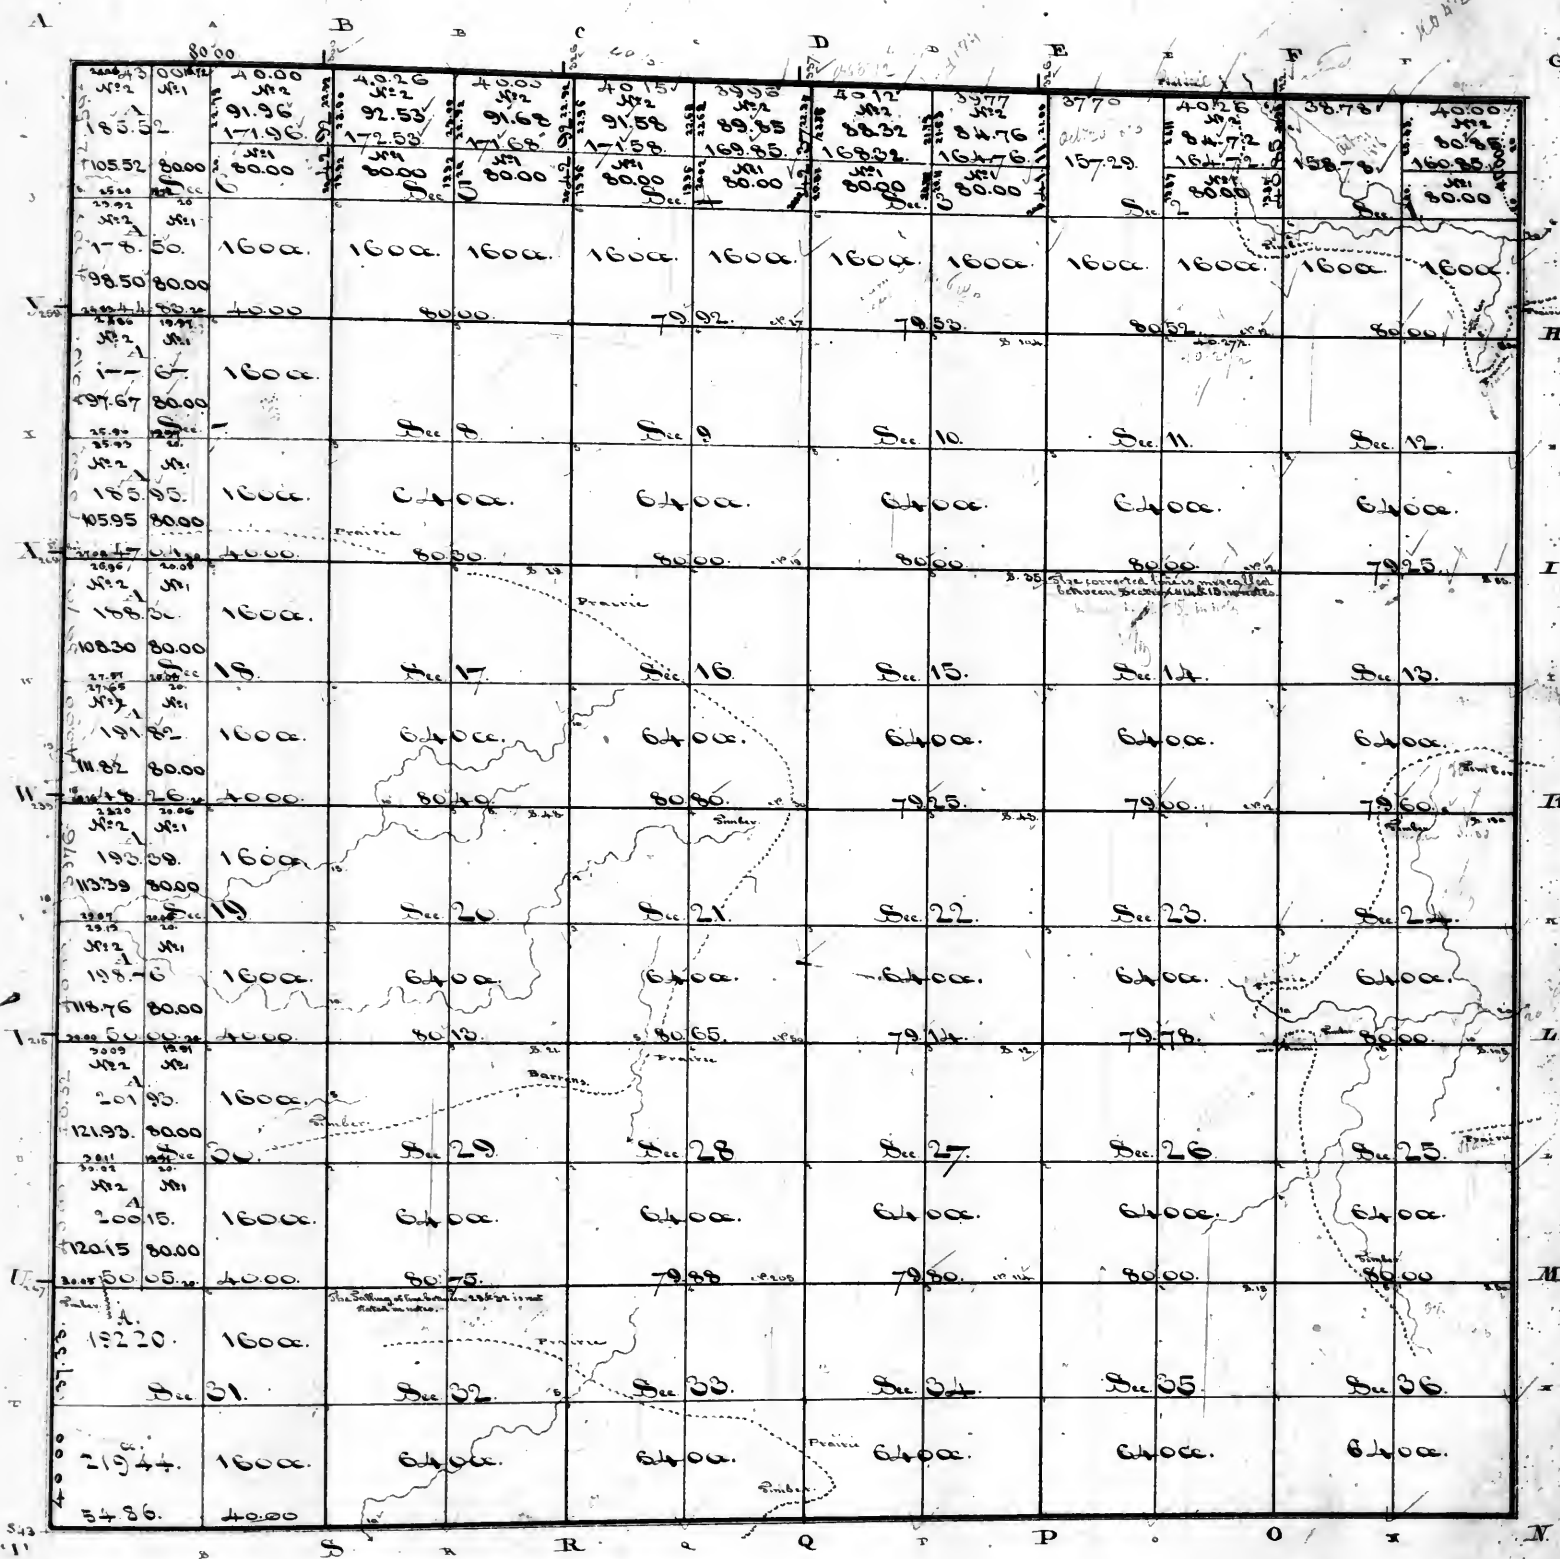

Notes: According to the field notes used in constructing this plat there is no connection between the West & South boundaries of the Township. The area of the West half of Section 1 is therefore omitted, as is also the West boundary and the West half of the South boundary of said Section.

Surveyor's Office St. Louis 14th May 1830. The South boundary of Sec 1 of the Township has been laid down on this plat according to the survey thereof by John McDonald on the 27th day of the present month under the lines of the 16th and the 17th and 18th of said Sec 1 have been calculated in accordance therewith and a plat of the Section transmitted to the Register of the County.

E. J. Simpson

Surveyor's Office St. Louis 14th Apr: 1830. Plat of the N.E. quarter of Sec 1 of the North halves of Sec 2, 3, 4, 5, of West half N.E. quarter of Sec 6, and the West halves of Sec 7, 15, 16, 20, and 21 to the Commr. of the Land O.

Surveyor's Office St. Louis October 14th 1830

The exterior boundary and subdivision lines of Township 1 South Range 7 West are represented on the above plat according to notes of the Survey thereof mentioned below which do not refer the surveys (except the two eastern miles of the North boundary) to any principal Meridian. The East and South boundaries from notes (apparently of James McDonald in March 1815) in book of exterior survey numbered 212 signed John McDonald.

The North boundary from the N.E. corner of the Township West to the corner of Sec 24, 25 of Twp 1 N R 7 West from notes without signature in book of Exterior survey numbered 218, and dated in November 1815. The remainder of said North boundary and the West boundary are from notes which seem to be a copy (and are apparently by John McDonald in October 1816) in book of exterior boundaries numbered 216.

The Subdivision lines are from notes dated in October 1816 without signature (and apparently by three or four different persons), put together in a book numbered 1007.


Wm. McRee Jr. J. J. J. J.

Lat of Township - 2 South of the Baseline Range - 7 West of the 4th Principal Meridian.

Page 52 vol 21

Notes in Book 1816, by James M. Donald

Notes in May 1816

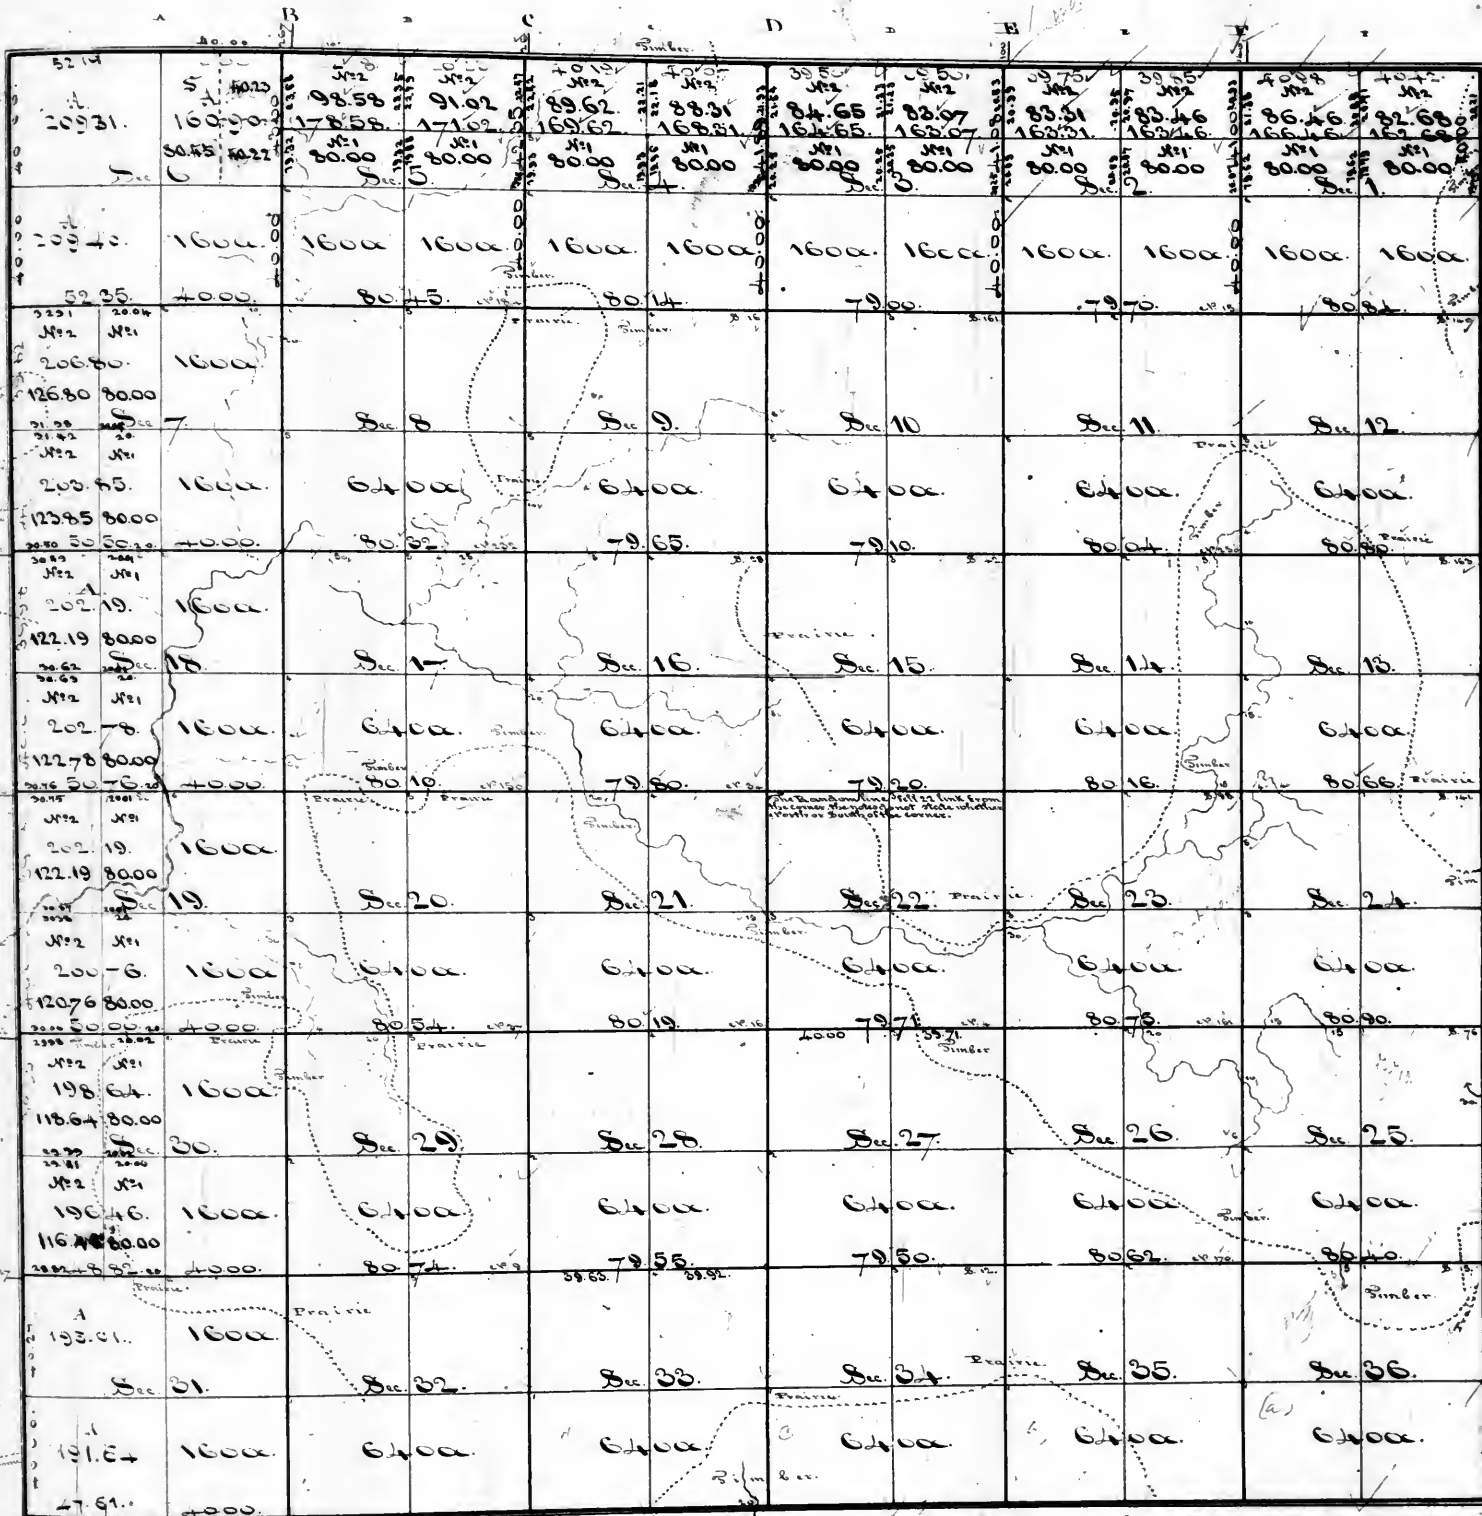

Note
Stations were established at the intersection of the line between Sec. 2 & 3 with the Township line.
According to the notes used in constructing this plat, there is no doubt of the correctness of the West boundary of the Township, and the East and South boundaries thereof, the areas of the West halves of sections 31, 40, and of the S.W. quarter of section 45 are therefore included as is also the West boundary and the West half of the South boundary of said section 31, and the West boundary and West half of the North boundary of said section 45.

Surveyor's Office
St. Louis 31 May 1836.
The South boundary of Sec. 31, Town 18 N Range 7 W has been laid down on this plat according to the survey of the same taken on the 27th day of the present month under instructions of the 16th and the 17th and 18th sections of Section 6 of this Township have been calculated in accordance therewith, and a plat of said Section 6 transmitted to the Register at St. Louis.

E. J. Langhorne

Surveyor's Office
St. Louis 10 Sept 1840.
Plat of the North halves of Secs 12, 13, 14, 15 and of the West halves of Secs 16, 17, 18, 19, 20 and this day to the Commr of the Genl Land Office.

Surveyor's Office
St. Louis 15 January 1847.
Subdivided the N.E. 1/4 of Sec. 6, so as to conform to a previous sale (marked S) and sent a copy to the Register & another copy to the Commr of the Genl Land Office.

Examined
W. M. C.

The exterior Boundary & Subdivision lines of T. 2 S. R. 7 W. are represented on the above plat according to notes of the Survey thereof mentioned below and which do not refer the Survey to any principal Meridian viz.
The North, East and South Boundaries from notes apparently of James M. Donald in March 1816 in book of sections numbered 212 signed "John M. Donald".
The West Boundary from notes which seem to be a copy, and are apparently by John M. Donald in October 1816 in book of sections numbered 216.
The Subdivision lines from notes dated in October 1816, without signature and apparently by 3 or 4 different persons put together in a book numbered 1006. —


W. M. C.
Sr. of Pub. Lands

Surveyor's Office.
Saint Louis 14 October 1850.

Map of Townships South of the Baseline in Range 7 West of the Principal Meridian.

at the Topco. March 9, 1816
- also in Book No. 212 -

3 ml 21

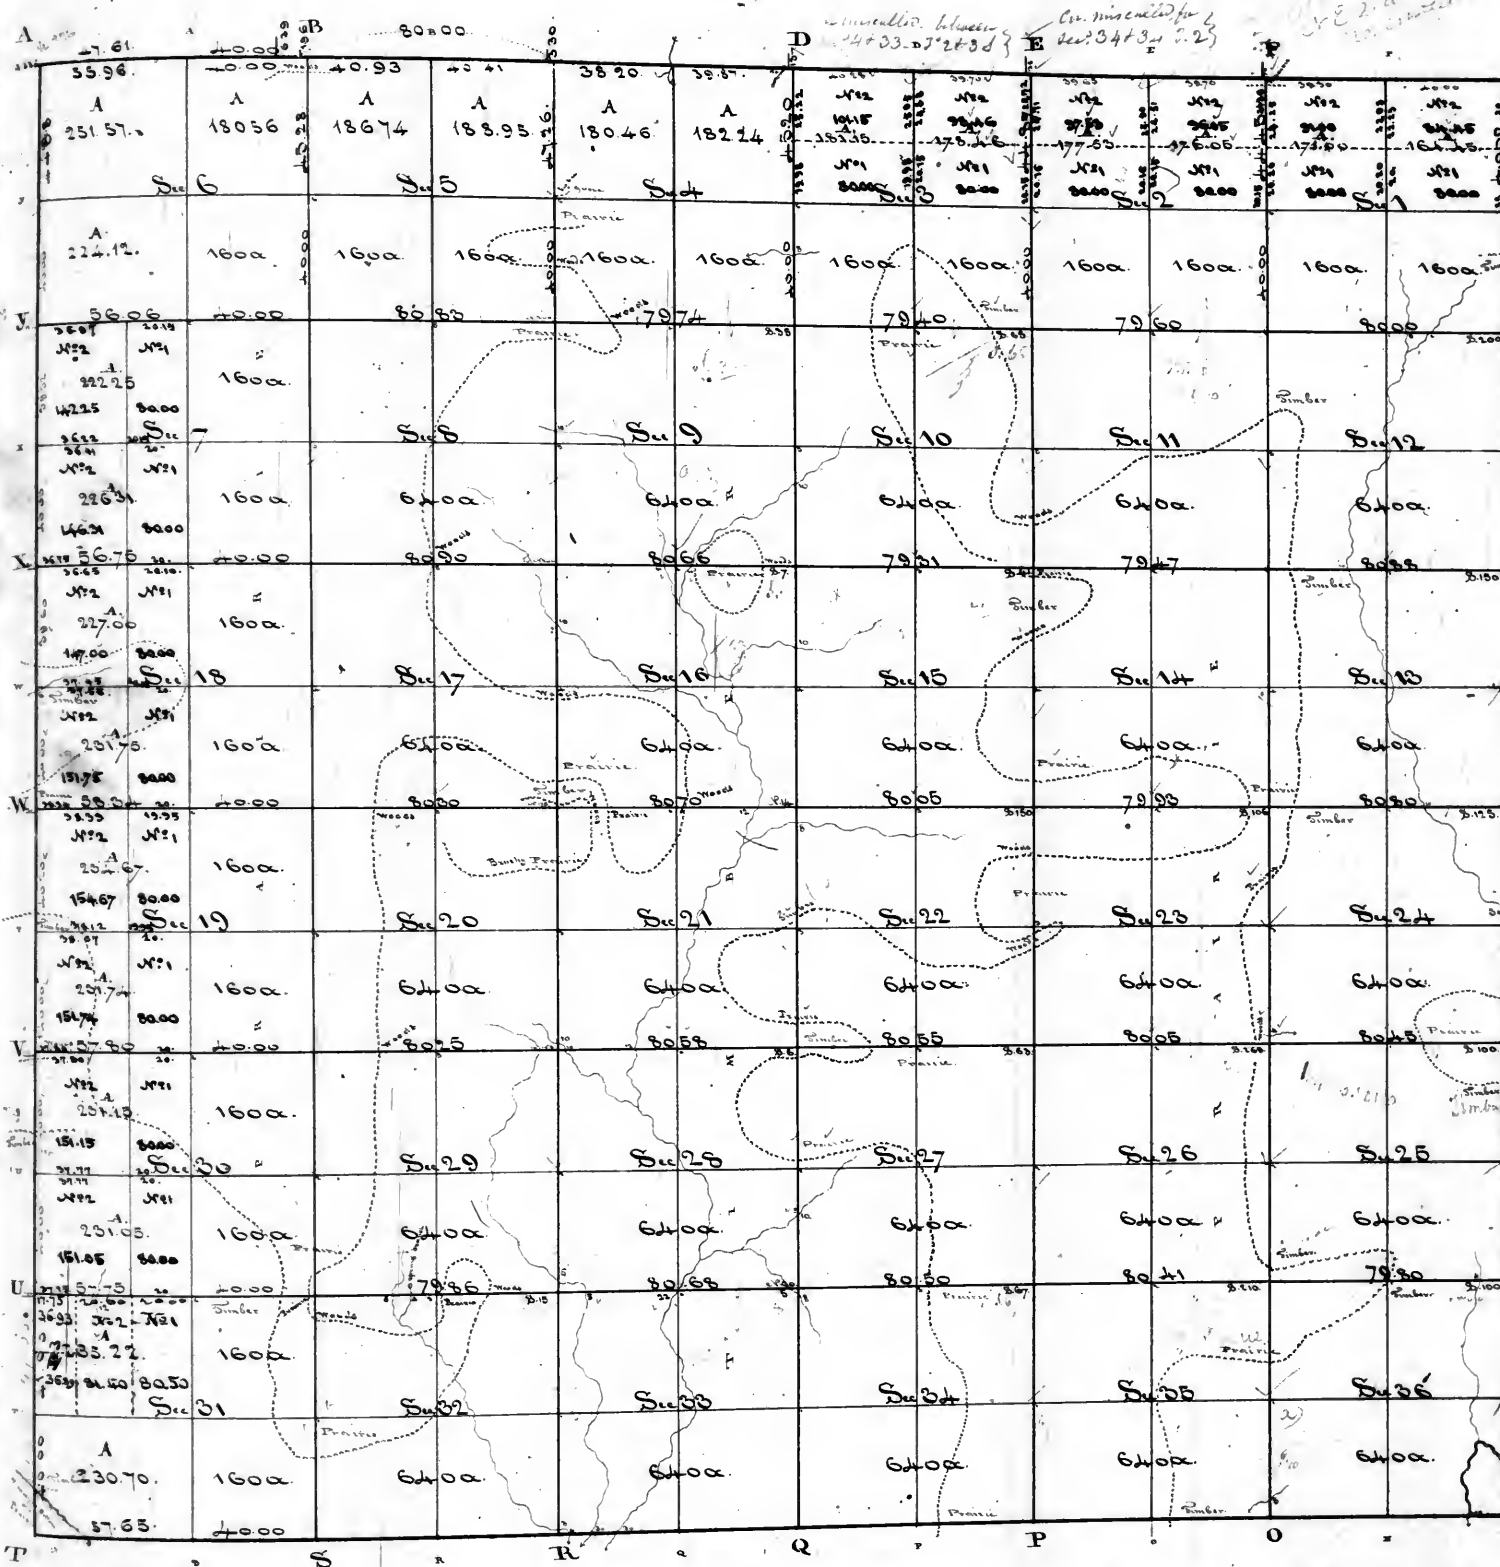

Note.

At the intersection of the line between Sections 1 & 5 with the Township line the falling from the corner to Section 21 & 25 of S. 2. S. is not given the field notes. The areas of the North halves of Sec. 4 & 5 are therefore omitted on this Plat. According to the field notes used in constructing this Plat there is no direct connection between the West boundary of the Township and the North & South boundaries thereof, the areas therefore of the West halves of Sections 21 & 6, and of the N. E. quarter of Section 6 are omitted, as is also the West boundary of the West half of the S. boundary of said Section 21, and the West boundary of West half of the North boundary of said Section 6.

2 per 1816
Harris' plat author, to
connect the line between
Sections 20 & 5 with the
line of the N. E. of Sec. 19 &
31 of this R. & S. 21 & 25
The Survey book contains

Surveyor's Office
St Louis 10th Sept. 1842.
Plat of the North halves of Secs 1, 2, 3, 4, 5
and of the West halves of Secs 6, 7, 8, 9, 10, 11, 12, 13, 14, 15, 16, 17, 18, 19, 20
not this day the year 1840.
Saint Louis 21st March 1844
Subdivided under
Act of 1832
the NW. qr. of sec. 31,
and sent to day, copies of the plat on
to the Dep. Com. another to the Govt.

Surveyed & approved of by General Donald in March 1816.

Surveyor's Office St Louis 11th October 1850.

The Exterior Boundary and Subdivision lines of Twp. 5 & 6 R. 7 W. are laid down on this plat according to the notes thereof made by the surveyors and which do not refer the surveys to any principal Meridian. viz:
The North, East, and South boundaries from notes (apparently of James M. Donald in March 1816) in book of Exterior lines of Townships, numbered 112, signed John M. Donald;
The West Boundary from notes (apparently of John M. Donald in October or November 1816) in books of Exterior lines of Townships, numbered 216.
The Subdivision lines from notes without signature (and apparently by David Persons in October 1816) put together in a book, numbered 1005.


W. W. Wells
Dr. J. P. Pub. Lds

except Sections 19, 20 & 29, the W 1/2 of Section 18 and fractional section 32, East of the Chinal Beach; logs which are omitted on account of errors in the survey thereof.

Page 54 vol 21

Insurgent's Office
 St. Louis 10. Sept. 1862.
 Price of the North hedges of Secs. 1, 2, 3, 4, 5 of the N.E. 1/4
 of Sec. 7, of the West half of Sec. 8, of the S.E. 1/4 of the
 hedges of Secs. 7, 20 & 31, sent this day to the Commr.
 of the General Land Office.

Surveyors Office
St. Louis 26th September 1850.

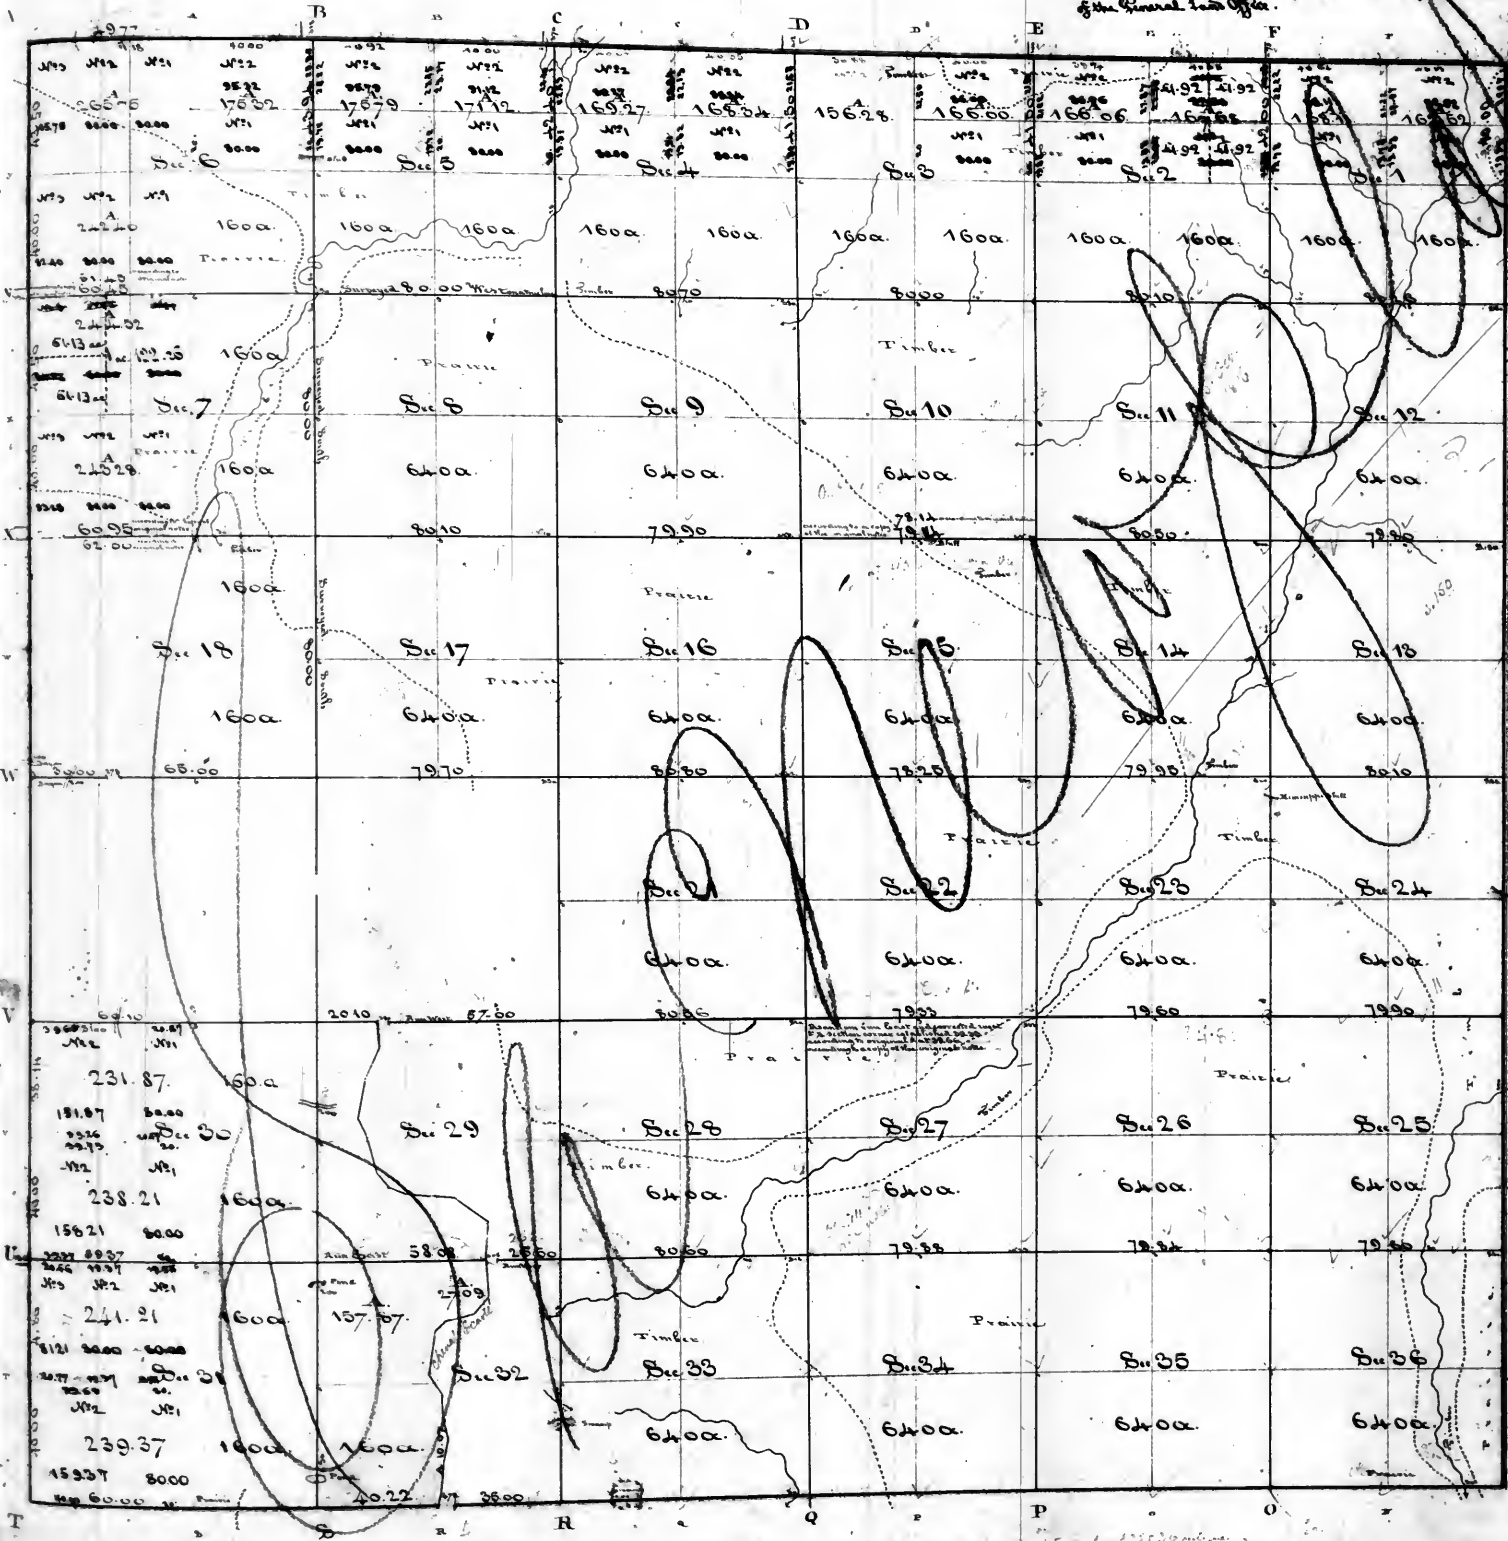

According to the field notes the N. boundary was surveyed W.
5 miles & 77 chains to the corner of ~~S. 7~~ S. 26 7 1/2 N.
by James McDonald, apparently in March 1816.
The East boundary was surveyed 6 miles on the 5
March (apparently 1816) by John McDonald.

H section is established by the Township corner with the woods - post Debang North - intervened between the two first lines of the entry. On a separate leaf or piece of paper and beginning with the date October 14th 1846, we have notes of the S. boundary of Section 20 with Charles H. Clavin signed as surveyor on the back on next line. It appears

copy of the above mentioned paper with their generals, represent-
ing however the line to be continuously West including
the S. boundary of Section 20 as exactly copied from
the original of Charles M. Clure) & must not be mis-
takenly call for interesting at the Townships nor, and
not for establishing one as in the original.

According to what appears to be original field notes with
out date or signature the West boundary was surveyed
from the N. W. corner of the Township South 2 miles
to a chain to the "Smeatic", and thence on the East
boundary of Section 15 to D. H. R. to a corner
3 1/2 miles on the E. boundary of section 2, T. 4 N. R. 10 W.

A corner which seems to have been established by running 1/2 sec above, between sections 18 & 19 of this Township. The said West boundary is laid down on this plat according to what seems to be intended in part as a copy of said apparent original note, which call for running S. 6 miles on the back containing them is signed "John A. Davis &c".

also another apparent copy without signature, of
the notes of the survey of the W. boundary solo, it
agrees with the copy used in constructing this
plot except that it calls for a post and mound to corner
D. 1. 2. 5. 20. 10. 10, where as the copy used describes
it said corner as being a post with two witness trees, and

which agrees with the description of said corner in the apparent original note of the survey of the South boundary, The said Surveyor shows however first - described in the said copy used in constructing this plat as being a post and mound which has been marked over with ink, and the other description written -

underneath. The subdivisions lines are laid down according to notes which are in part apparently copies, at least one other note of some of the lines between which, and the apparent copies the following differences in addition to those noted on the plate are found to exist. viz. the divisions to which the witness refers in the quarter section course on the line between sections 20 & 21 is contained in the original notes, in the original

the original notes call for running West between sections 18 &
19, describe 1/4 quarter section corner, now any fractional
section corner north. I measured and call for intersec-
ting the N 1/2 S line at 102 chains at corner to section 18
N a foot & 1/2, describing two witnesses; one other set
of notes of said line (apparently original) call for

running W. describes a quarter section corner at the
chain, a corner at 66.00 chains on the "Bancroft"
which is stated to be 107 links wide; they then
describe another corner on the W. side of the line; then
the copy which seems to be an inaccurate compound of
the two before described sets of notes describes the
quarter section corner at the chain, a corner at 66.00

on the "Gneiss" which is stated to be 750
wide and has intersecting the N & S line at 778
chains at the corner where is there deviation.

21st March 1844
Subdivided under the Act
to promote sales, reported by the

the 16 quarters of section 2. (C)
the 11th 7
copies of the plat on to the Pkg? (C)
on measures

T. 6 S. R. 7 W. of the 4th p. M.

Statement refers to in the certificate below.

| Lines. | Ac. 100 |
|------------------------------------|---------|
| City to 12 | 41.56 |
| Line beto to 14 12 | 58.74 |
| Measure on island along road 14 12 | 140.59 |
| on main shore along to 12 | 27.77 |
| | 278.66 |



A copy of this plat sent to the
Comm. & Registry on 2nd Oct. 1844.

Variation 7° 30' East
Scale of 400 chains to one inch

Surveyor's Office
Saint Louis 10th of October 1844.

The above plat of section 12, on main shore, and of that part of island No. 36, which lies in fractional Sec 12 & 13, of township 6 South of the base line, range 7 West of the 4th principal meridian is strictly conformable to the field notes of the survey thereof on file in this office which have been examined and approved. On 18th & 19th 1843, Francis T. Parker, under instructions of the 12th of March 1842, surveyed the lines detailed in the statement above, 2 miles 78.08 chains, which were paid for in the 2nd quarter of 1844, and charged in the account current of the Surveyor General during the same quarter, under the appropriation of \$3000, of the 3rd March 1843. (p. 95, act of Congress 27 Congress) for the survey of ungranted and detached lands in Illinois & Missouri, at a rate not exceeding ten dollars a mile.

Silas Reed


Surveyor of the public lands in the
States of Illinois & Missouri.

Plat of fractional townships 5 & 6 South of the baseline in Range 7 West of the Principal Meridian.

except sections and fractional sections, 4.5.6.7.9.10.15.16.21.22.23.24.25.26 & 27 in Twp 5 S. R. 7 W. on the main shore of the Mississippi and of Sec 12 in Twp 6 S. R. 7 W. which are omitted on account of errors in the survey there. Also Sec 13 & 14 on Island # 33 in Twp 5 South of the baseline, Range 7 West of the Principal Meridian.

Notes on Book A 216, containing the signature of John D. Donald in 1816.

page 55 vol 21

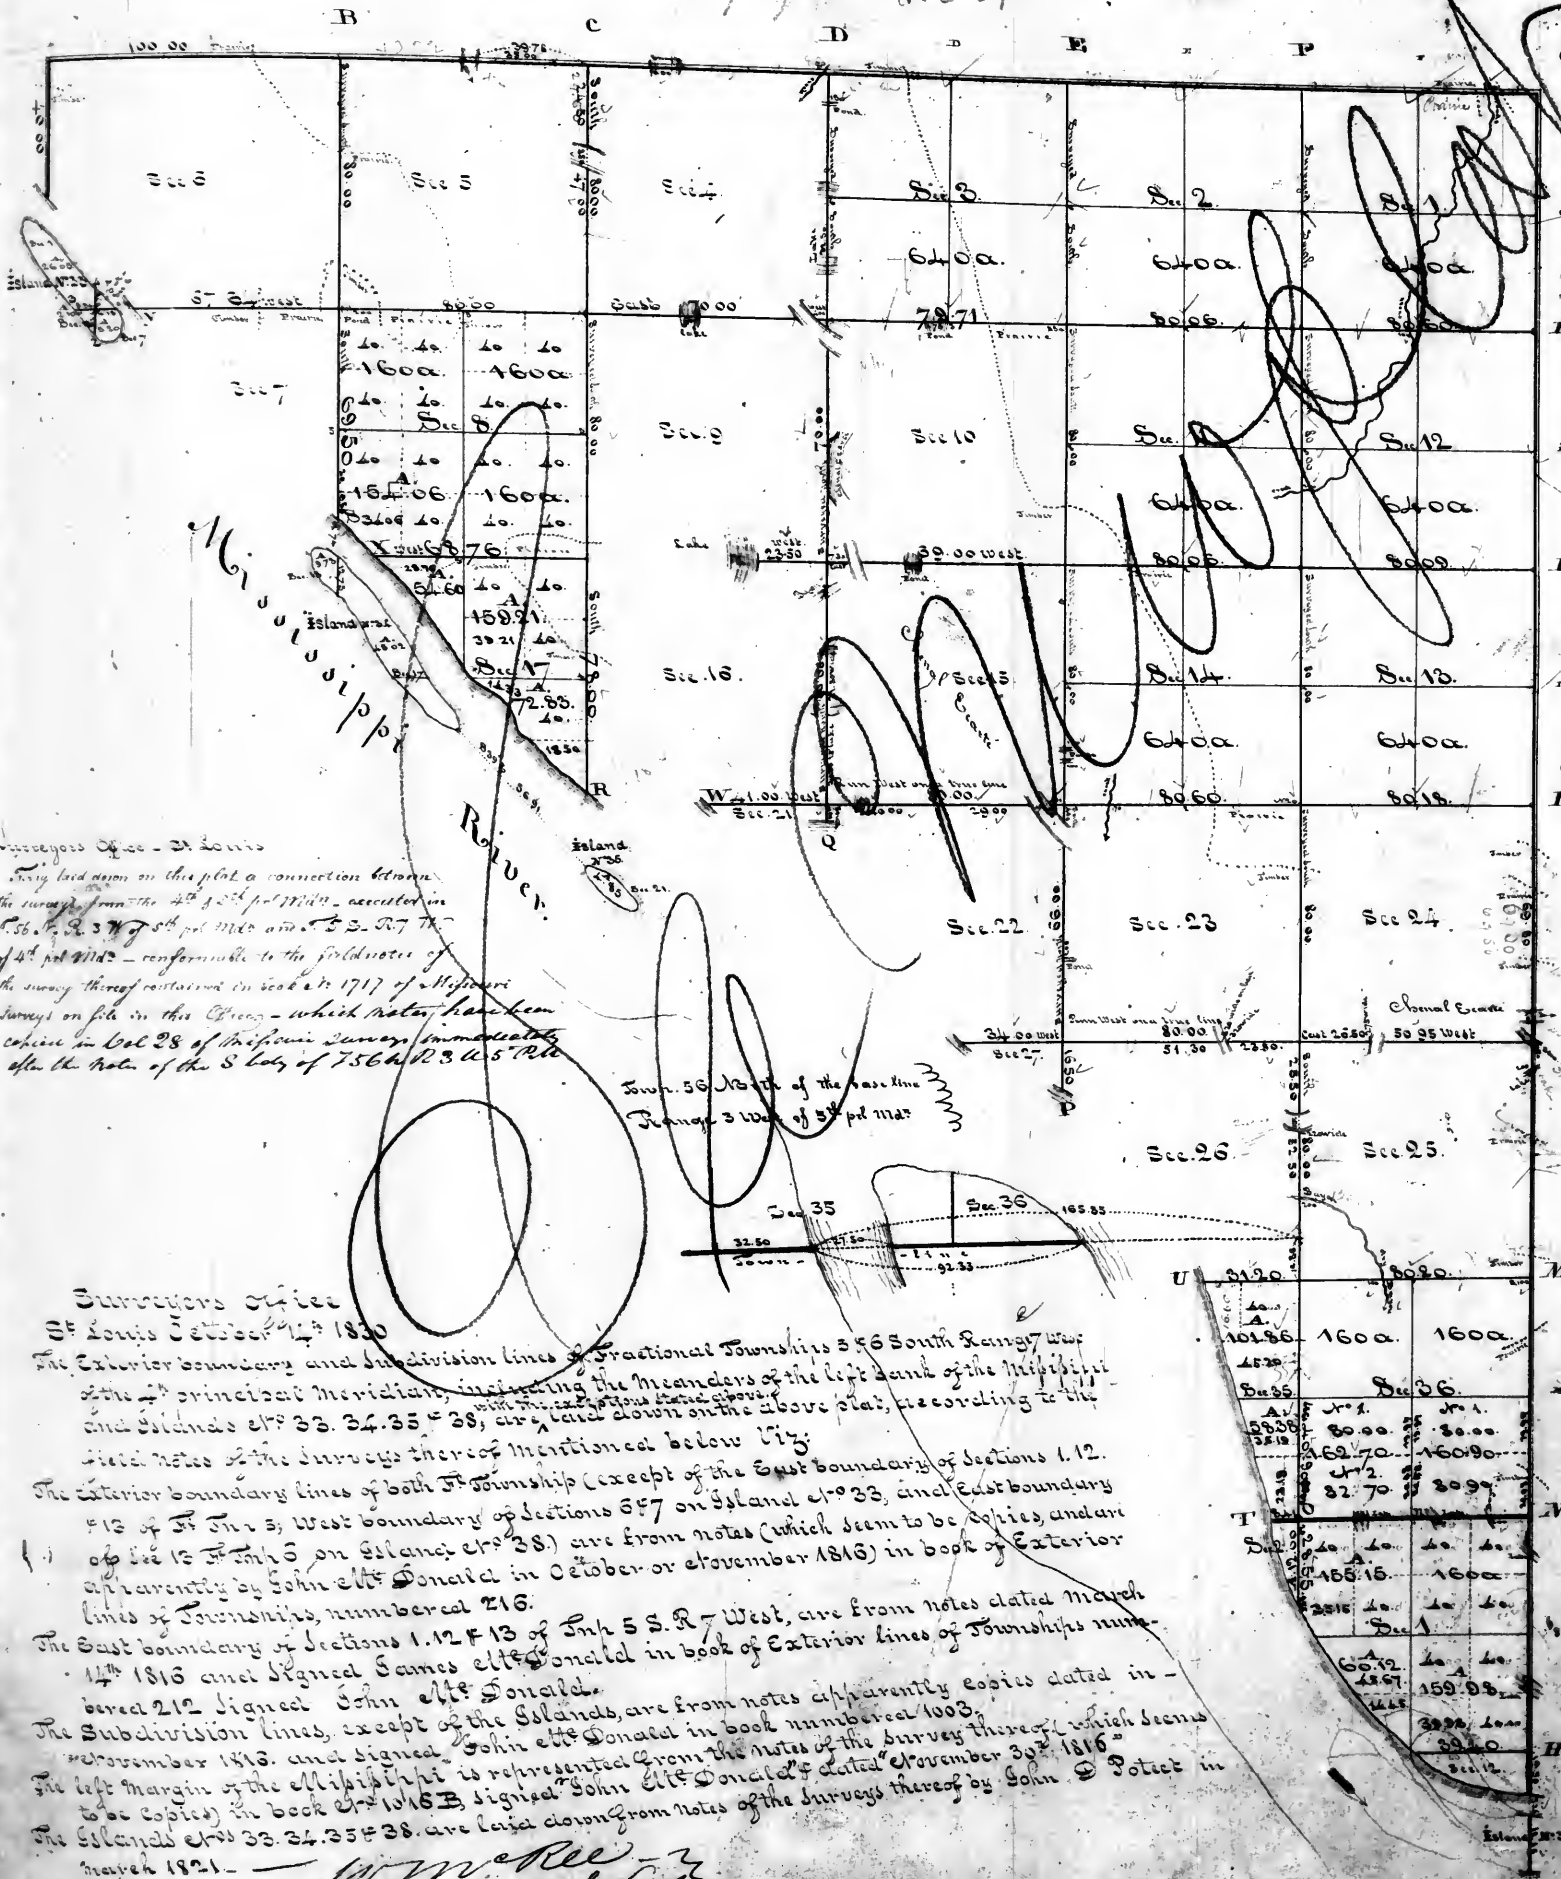

Surveyors Office - St. Louis
They laid down on this plat a connection between the survey from the 4th 1/2 Sec 17th 1812 - accessed in S. 56. R. 3 W. 5th pt 1812 and T. 5 S. R. 7 W. of 4th pt 1812 - conformable to the field notes of the survey thereof contained in book A 1717 of Mississippi Survey on file in this Office - which notes have been copied in Vol 28 of the House Survey immediately after the note of the S. 6th of T. 5 S. R. 3 W. 5th pt 1812

Surveyors Office
St. Louis October 12th 1830
The exterior boundary and subdivision lines of Fractional Townships 5 & 6 South Range 7 West of the Principal Meridian, including the meanders of the left bank of the Mississippi and Islands # 33, 34, 35 & 38, are laid down on the above plat, according to the field notes of the surveys thereof mentioned below viz:
The exterior boundary lines of both Twp 5 & 6 South (except of the East boundary of Sections 1, 12, 13 of Twp 5, West boundary of Sections 6 & 7 on Island # 33, and East boundary of Sec 12 of Twp 6 on Island # 38) are from notes (which seem to be copies, and are apparently by John D. Donald in October or November 1816) in book of Exterior lines of Townships, numbered 216.
The East boundary of Sections 1, 12 & 13 of Twp 5 S. R. 7 West, are from notes dated March 11th 1816 and signed James D. Donald in book of Exterior lines of Townships numbered 212 signed John D. Donald.
The Subdivision lines, except of the Islands, are from notes apparently copied dated in November 1816, and signed John D. Donald in book numbered 1003.
The left margin of the Mississippi is represented from the notes of the survey thereof which seems to be copies in book A 1718, signed John D. Donald dated November 30th 1816.
The Islands # 33, 34, 35 & 38, are laid down from notes of the surveys thereof by John D. Poter in March 1821.

Wm. McRee
Sr. of Poter

Surveyors Office
St. Louis, 11th Sept. 1842
Plat of 5th 1/2 Sec. 8, and fractional Sec. 17, on Main shore and of Island # 33, in S. 5 S. R. 7 W. and of 1/2 Sec. 12, in T. 5 S. R. 7 W. of the 4th pt 1812 sent this day to the Register at Quincy.

Surveyors Office
St. Louis 11th Sept. 1842
Plat of 1/2 Sec. 8, 1/2 Sec. 17, on Main shore and of Island # 33, in T. 5 S. R. 7 W. of the 4th pt 1812, and of 1/2 Sec. 12, in T. 5 S. R. 7 W. of the 4th pt 1812 sent this day to the Commr of the Land Office.


Township 1 South of the base line Range 8 West of the 4th principal meridian.

Page 56 vol 21

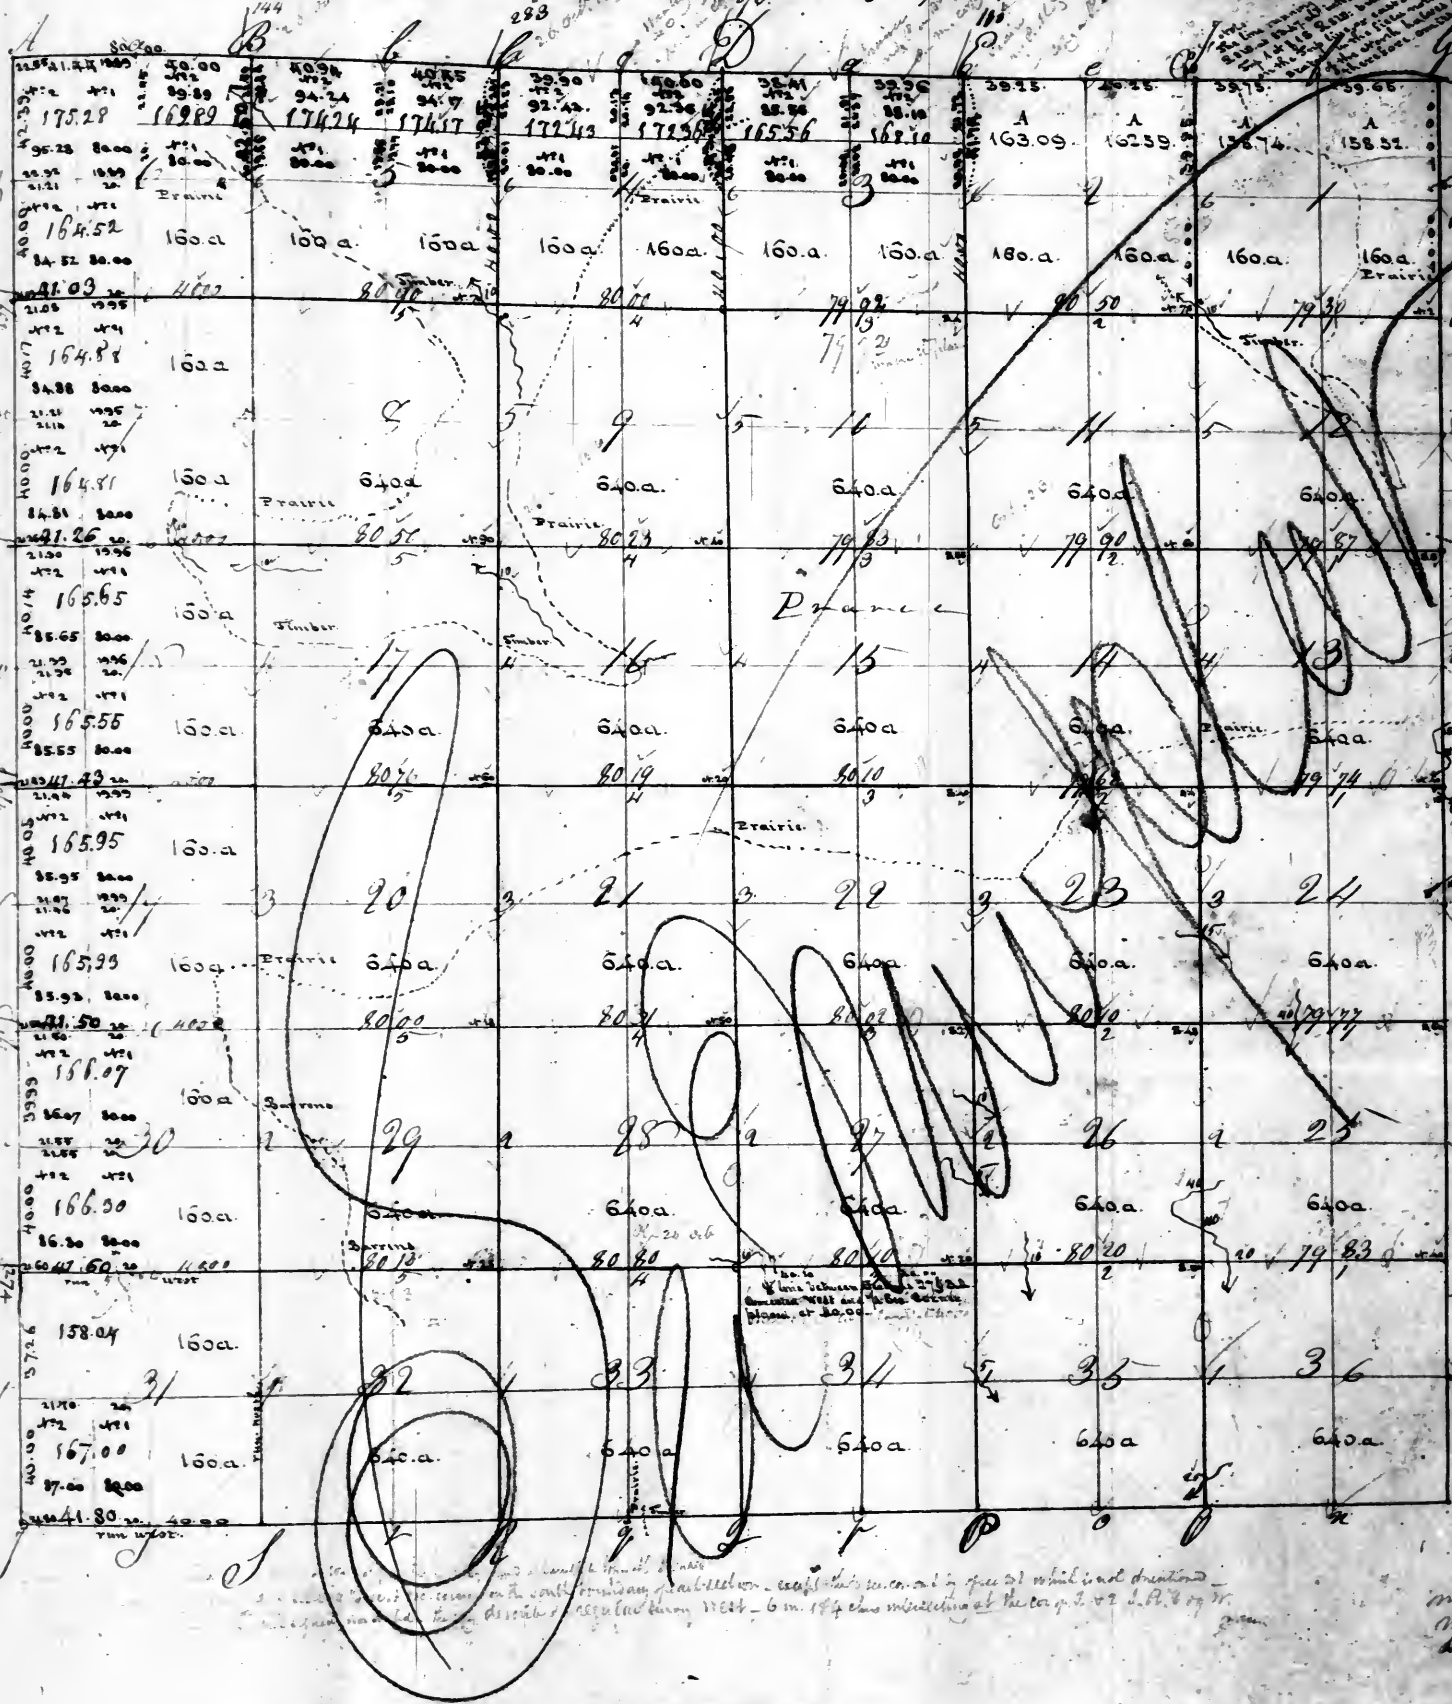

The entire line of this map
was laid down according to the
survey thereof. The original notes
are not signed or dated, the books
containing a copy thereof, original
data with original, and according to
said book the survey was executed
prior to the 21st of October 1816.
The original notes of the survey
of the South Range do not call for
showing regularly on said map but
describe the several corners thereon,
beginning with the quarter
section corner on the South Range
of Sec. 36, and going Westward
along the several section corners
Station corners at Sec. 36, according to
the corner to Station 31, 32, where
they stop, omitting the section
corner on the South Range of Station
31, as the length of the said
South Range is 36 miles.
The original notes there is no quarter
section corner described on the South
Range of Station 31, 32, nor on
the East boundary of Sec. 32, where
the only call for a point in the map
is for a point marked in the survey
that marked corner.
The subdivision lines are laid
down according to the field notes
thereon, which are dated and signed
in October 1816, they seem to be
by two persons but are not signed
by either, nor are the notes of said
survey, which principal meridians
the survey was made from.

Surveyor's Office
St. Louis 11th Sept. 1830
That of the South Range of Sec. 36
of the 1st Range of Sec. 36


Township 1 South Range 8 West

Surveyor's Office
St. Louis 11th September 1830
The above plat is with the exception of the North halves of sections 1 & 2
conformable to full notes of surveys of Trp. T. 1. S. R. 8. West
of the 4th principal meridian as is believed, and which are on file in this office.
Wm. McRob
S. of Pub. Land

Page 57 vol 21


These notes - 4 vols.
 1. 1816
 2. 1817
 3. 1818
 4. 1819

Dr. Rogers's Office
St. Louis 10th Sept. 1842.
Plot of the North quarter of Sec. 12, T. 24 N. E.
North half of 310. quarter of Sec. 6 of the
of Sec. 7, N. 12, 24 S. E. and of Sec. 10. quarter of
sent this day to the Commissioner of the Gen. L. O.

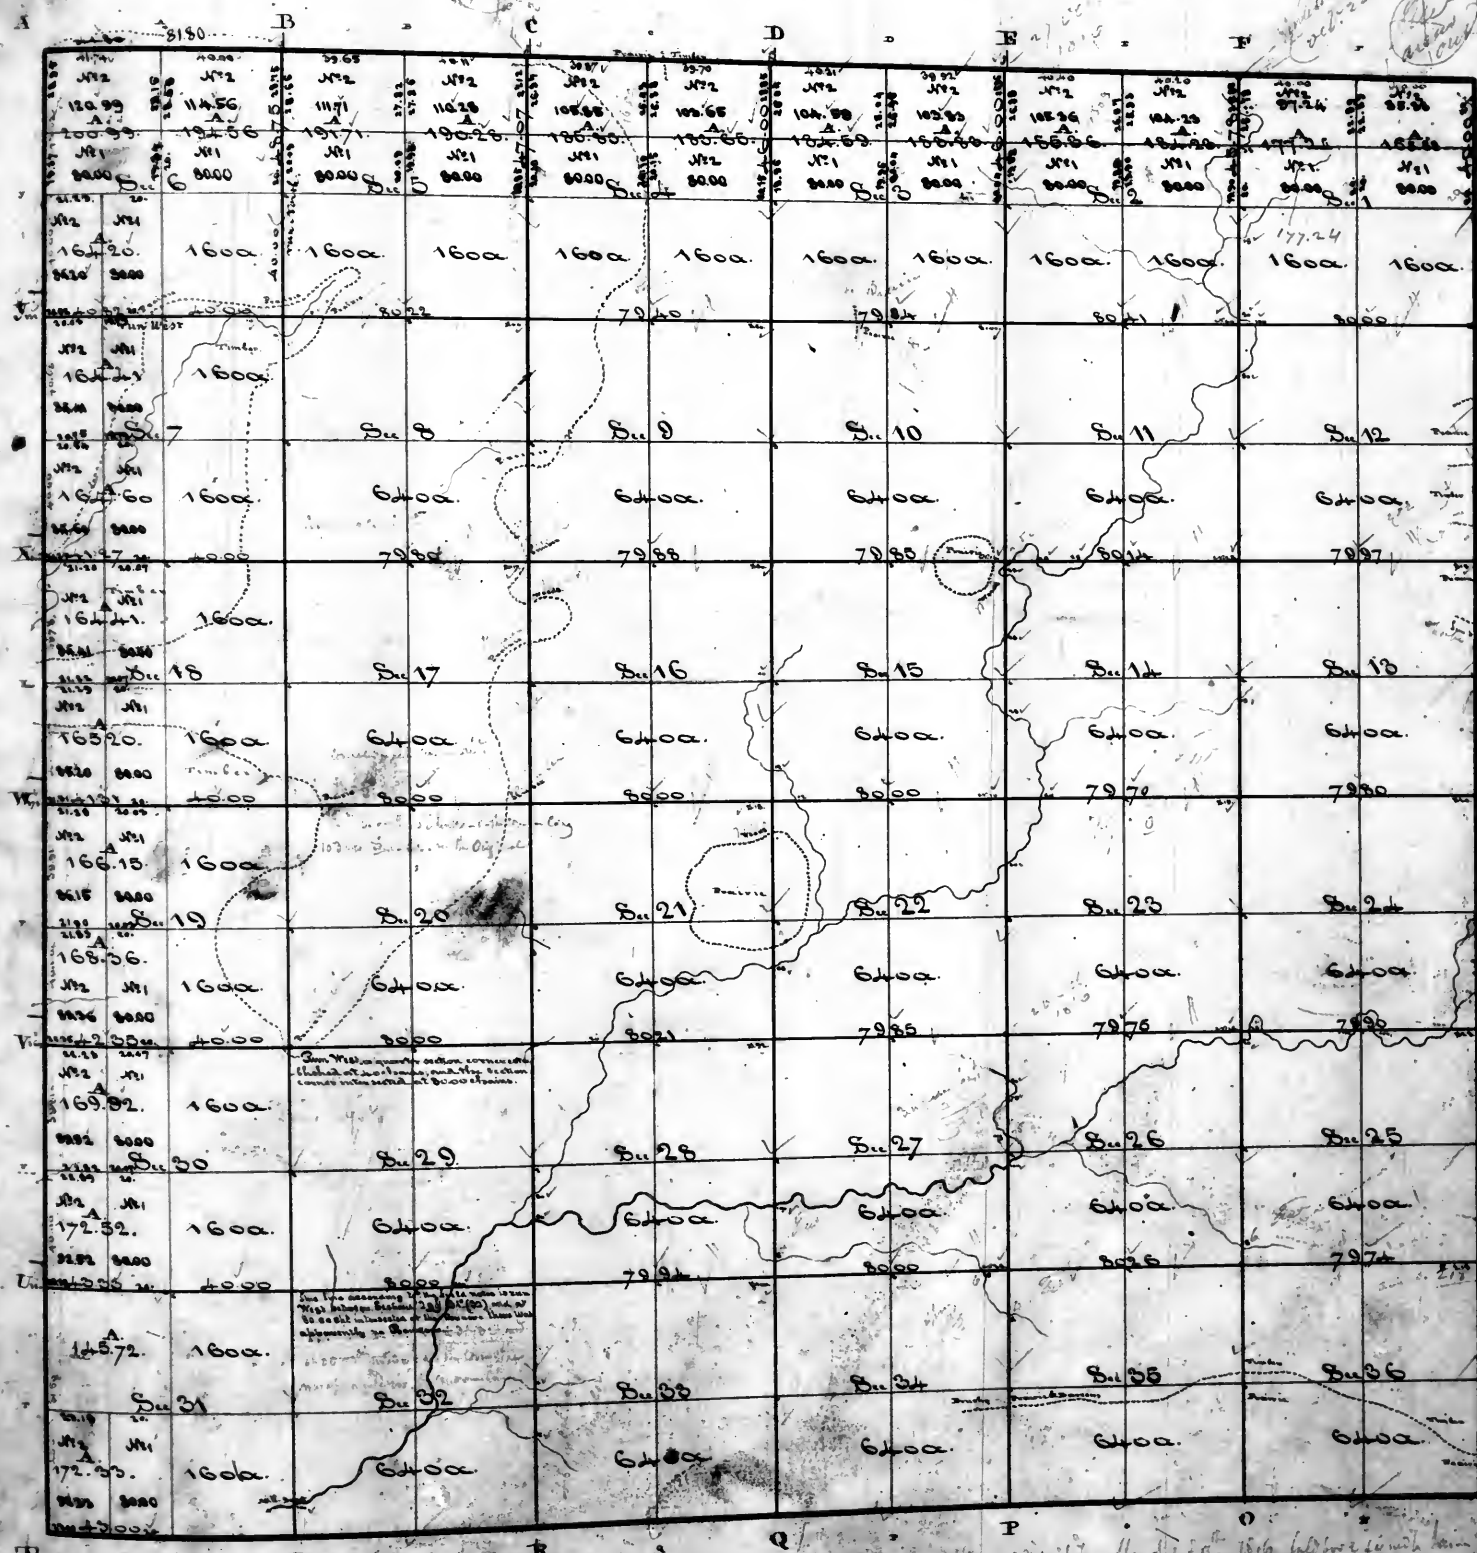[illegible]

S R Q P O N

T. 3 S. R. 8. W. of the 4th p. M.

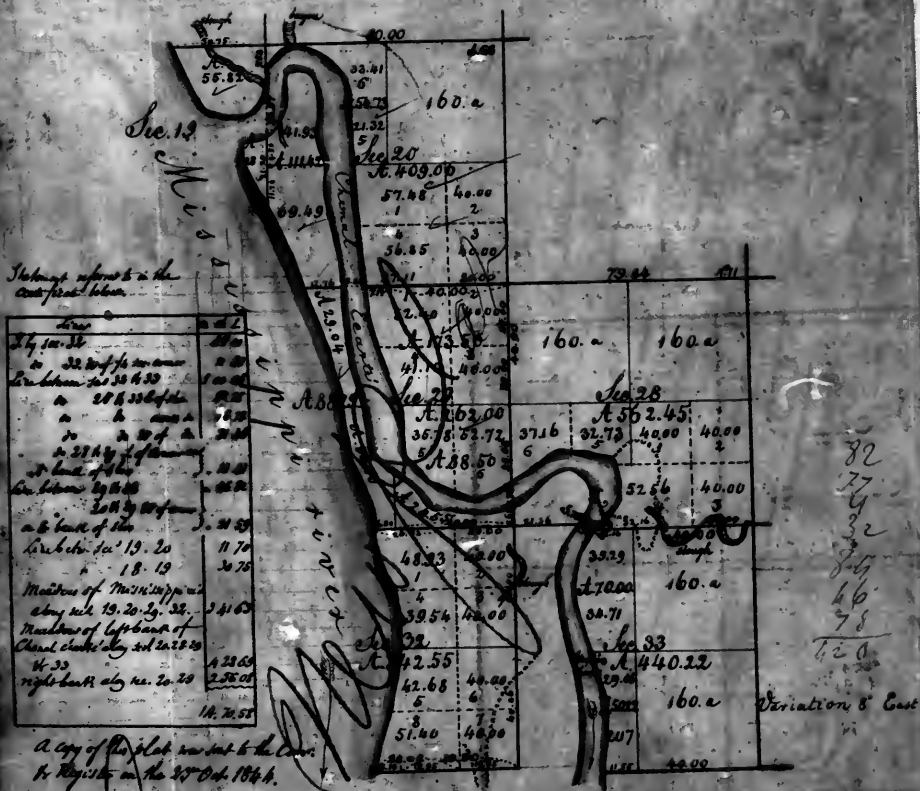

A copy of this plat was sent to the
 Fr. Register on the 25th Oct. 1844.

Scale of 40 chains to one inch

Surgeon's Office. Saint Louis 10th of October 1894

The above plot of fr. putges 19.20. 19 438 - of fr. water
 The line between the original "putges" and 1/8 "putges" is 19 438, which was paid for in the 2nd quarter of 1864
 and charges in the account current of the Surveyor General during the same quarter, upon the appropriation of
 \$3000. of the 3rd fund 1864, (page 35 of Act 3 - Sec. 27 - Comp.) for the survey of unexpired and retained
 claims in Illinois and Wisconsin, at a price not exceeding 1/2 dollar a mile.

S. J. Reed


mile.
Silas Reed

Surveyor of the public lands in
the State of Illinois &c.

Tract Township 3 South of the Base line, Range 8 West of the Principal Meridian.

except Sections and fractional Sections 1, 5, 6, 19, 20, 29 and 32 on the main shore of the Mississippi & fractional Sections 29, 32 on the left or East side of the Chenal Ecarter, which are omitted on account of errors in the Survey thereof.

Handwritten: Hans Partlow's reserve page 58 vol 21

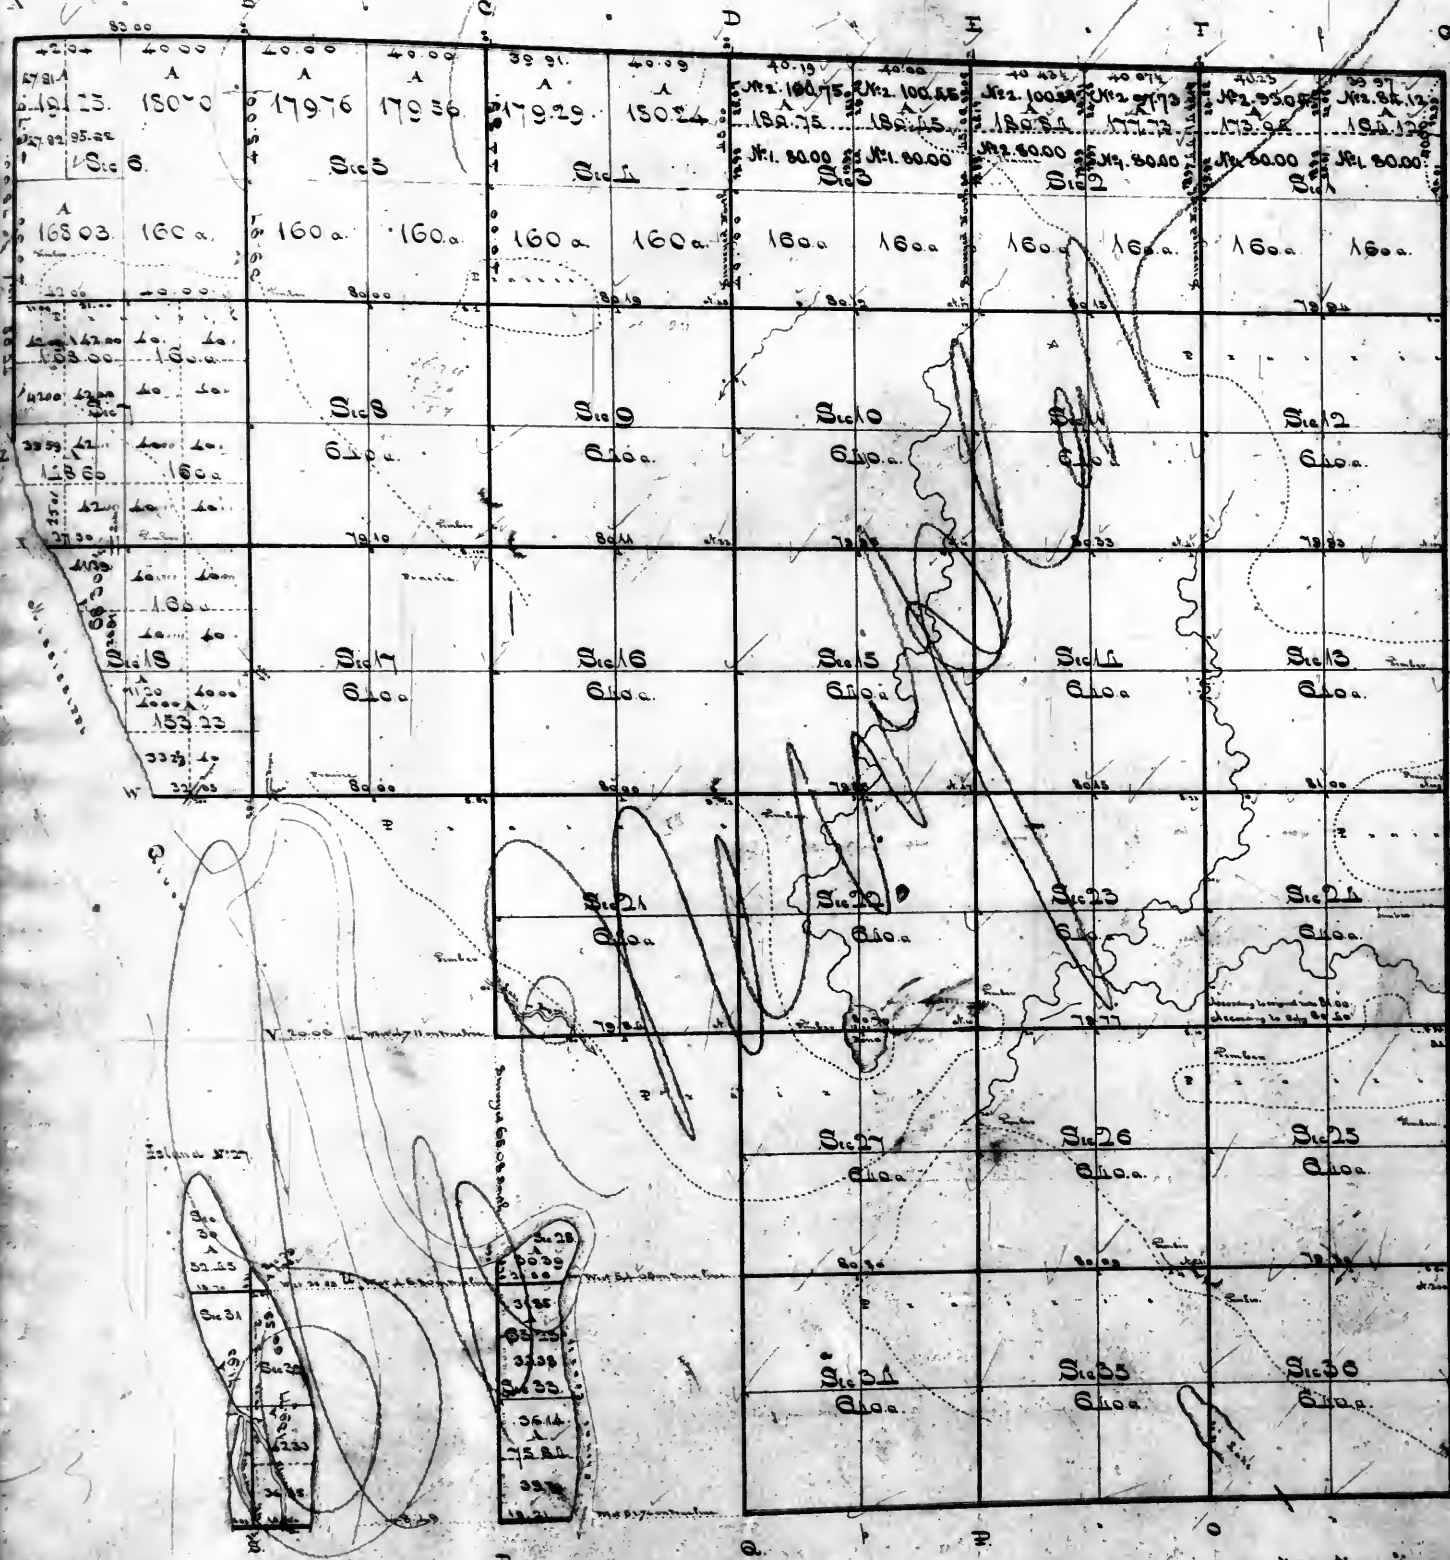


Surveyor's Office
St. Louis, Mo.
Date of final plat, 22 in before 1837, and of final (West of Chenal Ecarter) and this day to the Surveyor of the Land Office.

Note
The North boundary of this Township is laid down according to the survey of 1837, which is particularly described in the marginal note on the left of this plat.
According to the same note in this office the East boundary of this Township appears to have been originally surveyed 6 miles and 12 at March 1816 by James M. Donald, and has been subsequently surveyed.
The same East boundary of this Township is laid down on this plat conformably to original notes and a copy thereof of a survey, the original notes are without signature, and are dated November 1816; the copy is without latitude and signature, but the book is signed John M. Donald. There is also another set of notes (apparently originals) of a survey dated November 1816, in these notes not one corner is recorded, but merely a mile and a half post are stated to be set at 20 and 30 chains on the East boundary of each section.
The South boundary (except that part on Island No. 27) was surveyed according to the notes which have the appearance of being originals and which are without date or signature. West of the Chenal Ecarter to the East of the Chenal Ecarter, the survey of 1816 is shown to be correct, but the survey of 1837 is shown to be incorrect, the said line was run regularly west of the Chenal Ecarter to the Mississippi river, calling for intersecting the River at right angles and bearing it at 60 chains on the South boundary of section 35.
The field notes of the Survey of the East of this Township in the Subdivision book of this Township are apparently copied, there are other notes without signature dated Nov. 2, 1816, apparently originals, of the line between Sections 29, 30, 31, 32, 33, 34, 35, 36, 37, 38, 39, 40, which differ from the copies at 20 chains on the East of the line of the above mentioned line (in the Eastern Range of Sections) in the Subdivision book are dated November 2, 1816, of the notes of the remainder of the line of the Eastern Range are dated "approximately 1816". The remaining notes of the Township are dated from the 2d to the 11th of November 1816, they are apparently by two different persons, but are signed by neither.
According to said notes of Subdivision the line between Sections 31, 32, and that between Sections 33, 34 were each surveyed South of the Section Corners established at 25 chains and Section corners at 30 chains: making that part of said line which lies South of the quarter Section Corners only 35 chains, which is inconsistent with the length of the line between Sections 34, 35 (35 ch) and of the West boundary of Section 6, (30 ch).
Jan. 2, 1836.
A plat of the 7910 a subdivided on this plat has been sent to the Regt also one has been sent to the Ordnance Office.
Said Spirit 21: and 1836.
Subdivided on the 1832 as to conform to the report by the Regt on the 15th of the N.W. quarter of the 34th and to-day copies of the Regt's and another to the Ordnance Office.

Surveyors Office
St. Louis 25th September 1830
The above plat of the Trp. 3 S. R. 8 W. of the Principal Meridian (except sec. 4, 5, 6 - p. 19, 20, - that part of p. 28, and p. 33, lying East of the Chenal Ecarter, and p. 32, West of same Chenal Ecarter, that part of p. 29, on the main shore of the Mississippi, and the part East of Chenal Ecarter), is conformable (as near as may be) to the notes of survey from Trp. on file in this Office.
Note. The area of the N.W. q. of Sec. 7 has been altered from 168.60 to 168.65 & the division of the said N.W. q. into No. 1 & 2 has been erased.

T 5 S R 8 W of the 4th p.M.

Silas Reed

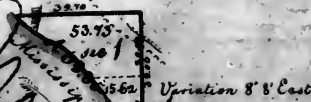


Scale of 40 chains to one inch

Surveyors' Office.
Saint Louis 11th of February 1845.

The above plot of fractional Township 5 South of the base line, range 8 west of the 4th principal meridian is strictly conformable to the field notes of the survey thereof on file in this office which have been examined and approved. The east boundary, 53 rods; the north boundary 53.70 chains, and the measure of the Mississippi river 55.24 chains were all surveyed in the year 1842 & 1843, by Amasa R. Parker, under instructions of the 12th of March 1842. This surveying was ordered on the account of said Parker, transmitted to the Commissioner of the General Land Office, on the 18th of November 1844, in compliance with his instructions of the 20th of Sept. of the same year, for a direct settlement with Parker, from the Treasury Department, under the appropriation of \$3000, of the 17th June 1844 (see page 75 acts of Session of 28th Congress) for surveying the ungranted and detached lands within 94 sections at a rate not exceeding 50 cents a mile.

Silas Reed
Surveyor of the public land in the
State of Missouri & Wisconsin.

A Plat of Sections and Fractional sections 1, 2, 3, 9, 10, 15, 16, 23, 24, 25, on the left or northwest side of Chenal-ecarte, and 5, 6, 21, 22, 27, 28, sections of said Township 4 South of the base line, Range 8 West of the 1st principal Meridian. The survey of the remaining sections of the Chenal-ecarte being incomplete, the areas of said sections and fractional sections are not computed and set down on this Plat; they will be so until the necessary surveys and corrections be made and the Register furnished with a Plat thereof.

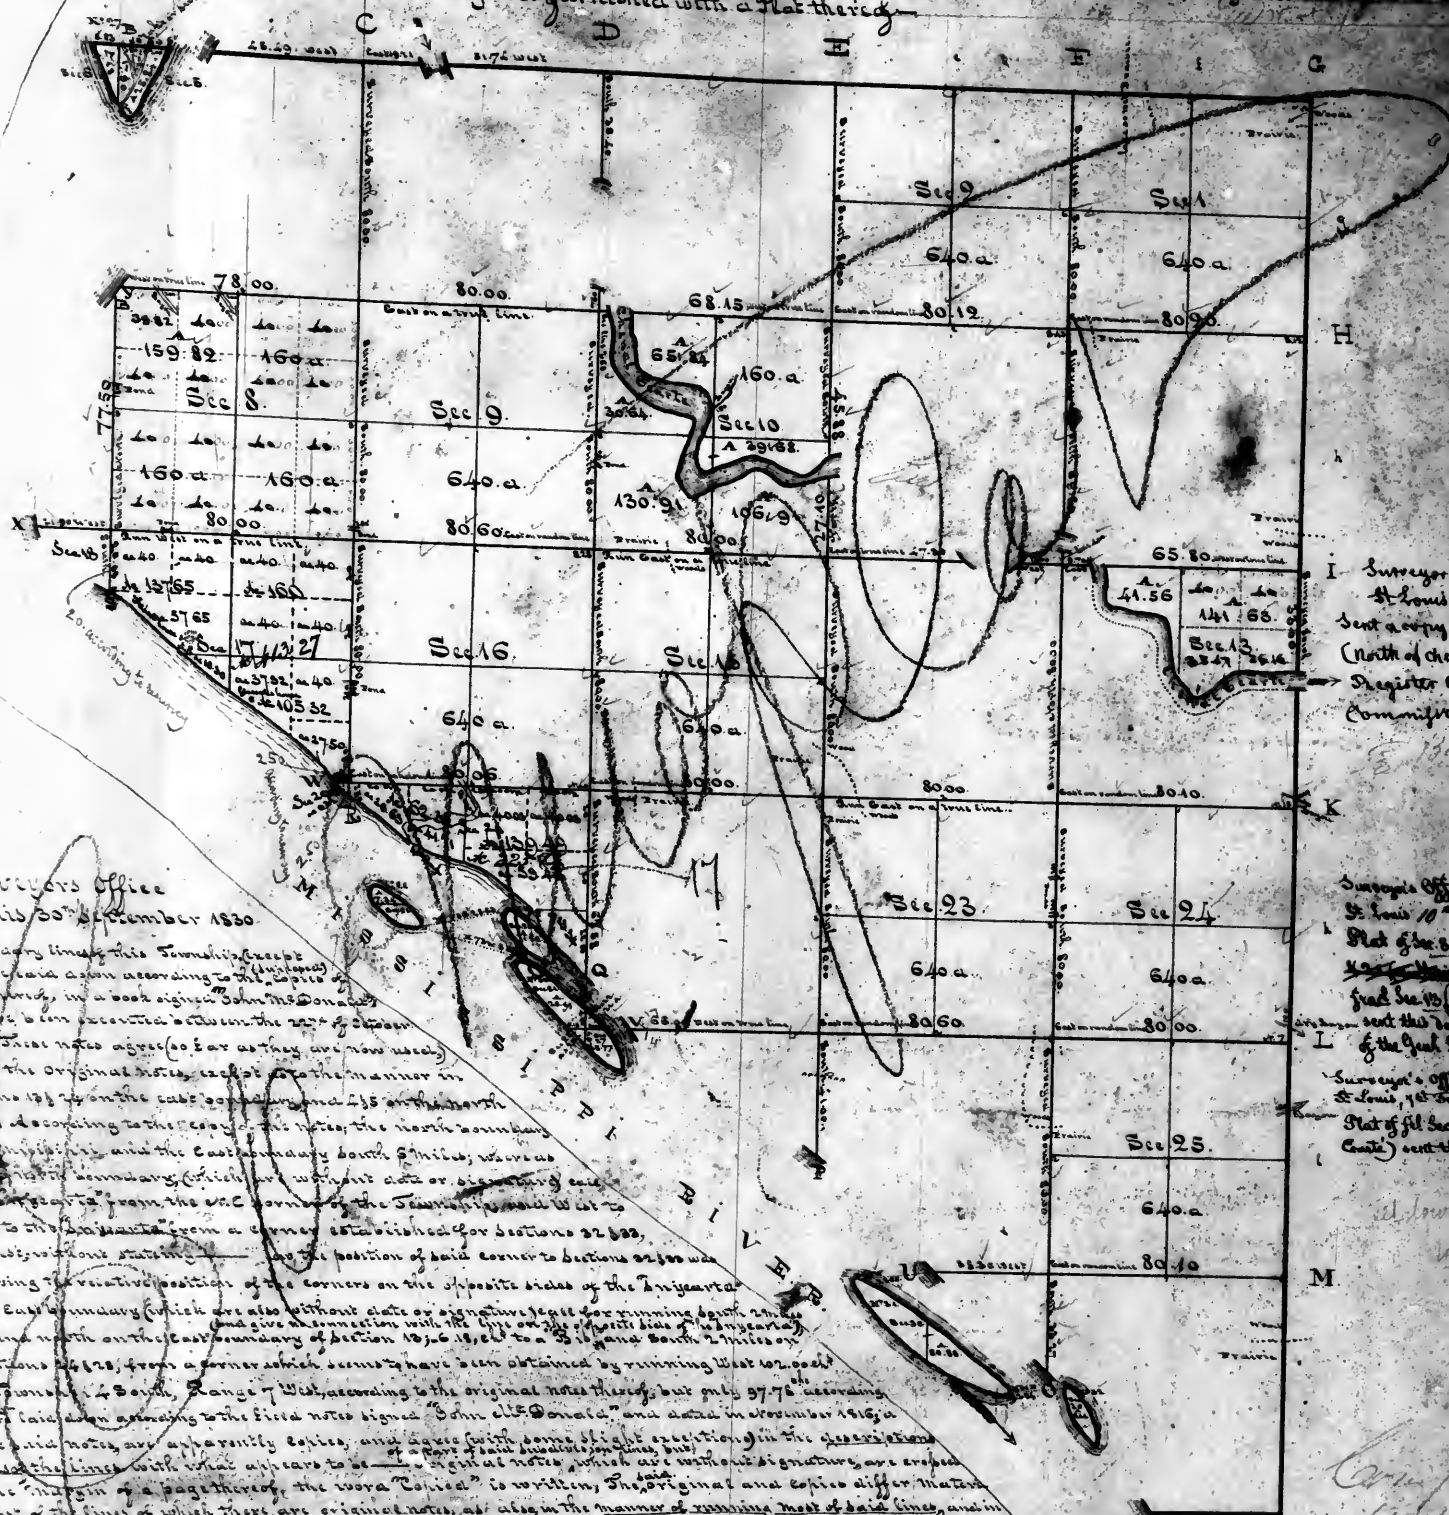

I Surveyor's Office
St. Louis
Sent a copy of plat of Sec. 1
(North of Chenal Earth) to
→ Register & another to
Commissioner.

Surgeon's Office
 St. Louis 10th Sept. 1862.
 Plak of Sec. 8.
~~42nd Mass. Inf.~~, and of
 Fred Sec 15 (North of Canal)
 sent this day to the
 of the Quak. & O.

Surveyor's Office
St. Louis, 7th Dec. 1874
Plat of 1/4 Sec. 15 (North of
County) sent this day to the

Surveyors Office
St. Louis 30th September 1830

The north (East) boundary lines of this Township (except on the 33rd and 34th) are laid down according to the notes of the surveyors, and, in a book signed John McDonald, the surveyors seem to have been satisfied with the way of obtaining and with a former (1812) note agree (so far as they are now used) with what is contained in the original notes, except in the manner in which the corners to sections 18, 19, on the east boundary and 15, 16 on the north boundary were derived according to the copy of the notes; the north boundary was surveyed at the beginning, and the east boundary south 7 miles; of a page thereof, the word "Copied" is written, The original and copy are in the position of most of the lines of which there are original notes, as also in the manner of running most of the lines of obtaining the corners. viz. The original notes call for running between sections 18, 13 West 100 rods intersecting line at 700 West side of

11 1/2 South 22.5000 lat inter^o 21/2 line at the cor. line
 same 30.00 lat established a cor for Dec 11.12.13.14
 21/4 South 30.00 lat inter^o the cor of Dec 14.15.16.17
 21/5 West 30.00 lat inter^o 21/2 line at Dec 18.19.20.21.22
 16 1/2 West 30.00 lat inter^o at cor Dec 18.19.20.21
 15 1/2 North 30.00 lat 21/2 line 21/2 lat of Dec 22
 15 1/6 West 30.00 lat established a cor for Dec 23.24.25
 23 2/5 West 30.00 lat established a cor for Dec 25.26.27.28
 23 2/5 North 30.00 lat established a cor for Dec 26.27.28
 23 2/2 North 30.00 lat inter^o 21/2 line at Dec. cor.
 23 2/6 West 30.00 lat established a cor for Dec 27.28.29.30
 23 2/6 North 30.00 lat inter^o 21/2 line at Dec lat of Dec. cor.
 15 1/2 West 30.00 lat established a cor for Dec 28.29.30
 15 1/7 South 30.00 lat inter^o 21/2 line at Dec lat of Dec. cor.
 15 1/9 South 30.00 lat inter^o 21/2 line at the Dec. cor. line

[illegible]

And from ~~the~~ which it appears, that the survey of the Soil, bordering West of and nearly close, another corner, common with those on the North and East of said place, according to the lines used in constituting the above Plat-

Envoys Office
Saint Louis, May 30 1844.

Fractured sections 17, 20 & 21 have been put to the day in connection with the adjoining sections of this township according to the bill of 1840 which have been examined and approved. The Survey of the following named lines by Ed Campbell in the 2^d quarter 1844 under instructions of the 1st of April 1844:— The line between sections 16 & 17 S. 2. E. 3^d quarter Section Corner (40 chains)— between sections 17 & 18, 20 & 21 chains— between sections 17 & 20 (250 chains)— between sections 20 & 21 (200 ft.)— and between sections 21 & 22 (62 50 chains)— and the meanders of the Mississippi along fractional section 17 (88 02 chains)— along fractional Sec 20 (83 50 chains) and along fractional section 21 (102 05 chains)— in all 4 sides 15 02 chains, which have not yet been paid for.


A handwritten signature in dark ink, appearing to be "L.H." or similar, written over a faint horizontal line. The signature is stylized with a large loop at the end.

T. 1 S. R. 9 W. of the 4th pr. Mer.



Variation 8° East

Scale of 40 chains to one inch.


Surveyor General's Office,
St. Louis the 29th of Dec. 1839

The above plat of fractional Section 27 East of Boston Bay in fractional Township 1 South, Range 9 West of the 4th principal Meridian is strictly conformable to the fieldnotes of the survey thereof on file in this office, which have been examined and approved. The North boundary of said fractional Section 27—6.90 chains—and the meanders of Boston bay along said fractional Section 27, were surveyed in the 2^d quarter of 1836 by Hans Patten under instructions from the Surveyor General dated the 11th June 1836, and were paid for in the 2^d quarter of 1838, and charged in the account of the Surveyor General for that quarter, Voucher No. 6. The fieldnotes of the survey of the East and South boundaries of the said fractional Section 27 are dated October 1816, but are without signature.

William H. Wilson
Surveyor General

sent a copy of this plat
to Rep. ex. 297
Oct. 1839
W. H. Wilson
La

T. 2 S. R. 9 W. of the 4th p. M.

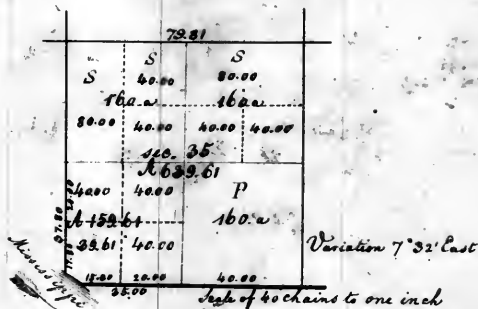

See
The Register of the Land-Office at Quincy with his letter of the 5th December 1844 to the Surveyor of Illinois and Missouri enclosed a report, by which it appears, that the quarter section marked P, has been patented for military services, as containing 160 acres, and that the tracts marked S have been sold by the Register.

Surveyor's Office.

Saint Louis 12th of February 1845.

The above plat of section 35 of Township 2 South of the base line, range 9 West of the 4th principal meridian, is strictly conformable to the field notes of the survey thereon file in his office, which have been examined & approved. In the year 1842 & 1843, Amasa P. Barker, under instructions of the 12th of March 1842, surveyed the line between sections 34 & 35 south of the quarter section corner 37.80 chains, and the meander of the Mississippi river, along sec. 35, 4.15 chains. This surveying was included in the said Barker's account, transmitted to the Commissioner of the General Land Office on the 18th of November 1844, for a direct settlement with him (Barker) from the Treasury Department, in compliance of the said Commissioner's instructions of the 20th of September 1844. The said account to be paid out of the \$3000, appropriated on the 17th of June 1844, (see page 75 of acts of the 1st Session of the 28th Congress) for the survey of detached and unpatented lines in Illinois & Missouri, at a rate not exceeding two dollars a mile.

Silas Reed

Surveyor of the public lands in the
States of Illinois & Missouri.

Plat of fractional townships n. 2 South of the Principal Meridian, Range 9 West,


the 1st Principal Meridian, except fractional Section 35, which is omitted on account of error in the surveying.

Page 61 vol 21.

Note
The field notes of the Survey of the Section lines and meanders of this Township (except of the Island) are without signature.

19 May 1851
The South West 1/4 of SE 9: of section 23 was purchased by Samuel Alexander, former Register at Quincy, on the 25th August 1835, as per Receiver's receipt N^o 456 - and the NW 1/4 of the same quarter was purchased by said Alexander on 13th January 1836, as per Receiver's Receipt N^o 597 - The certificates of purchase by the Surveyor General for the two above tracts, were transmitted this day to the Commissioner for probate. See Register's letter of 7 May 1851 to Surveyor General - and Surveyor General's letters of this day to Commissioner and Register.

also plat at page 69 of Volume XXIV of Illinois plats.

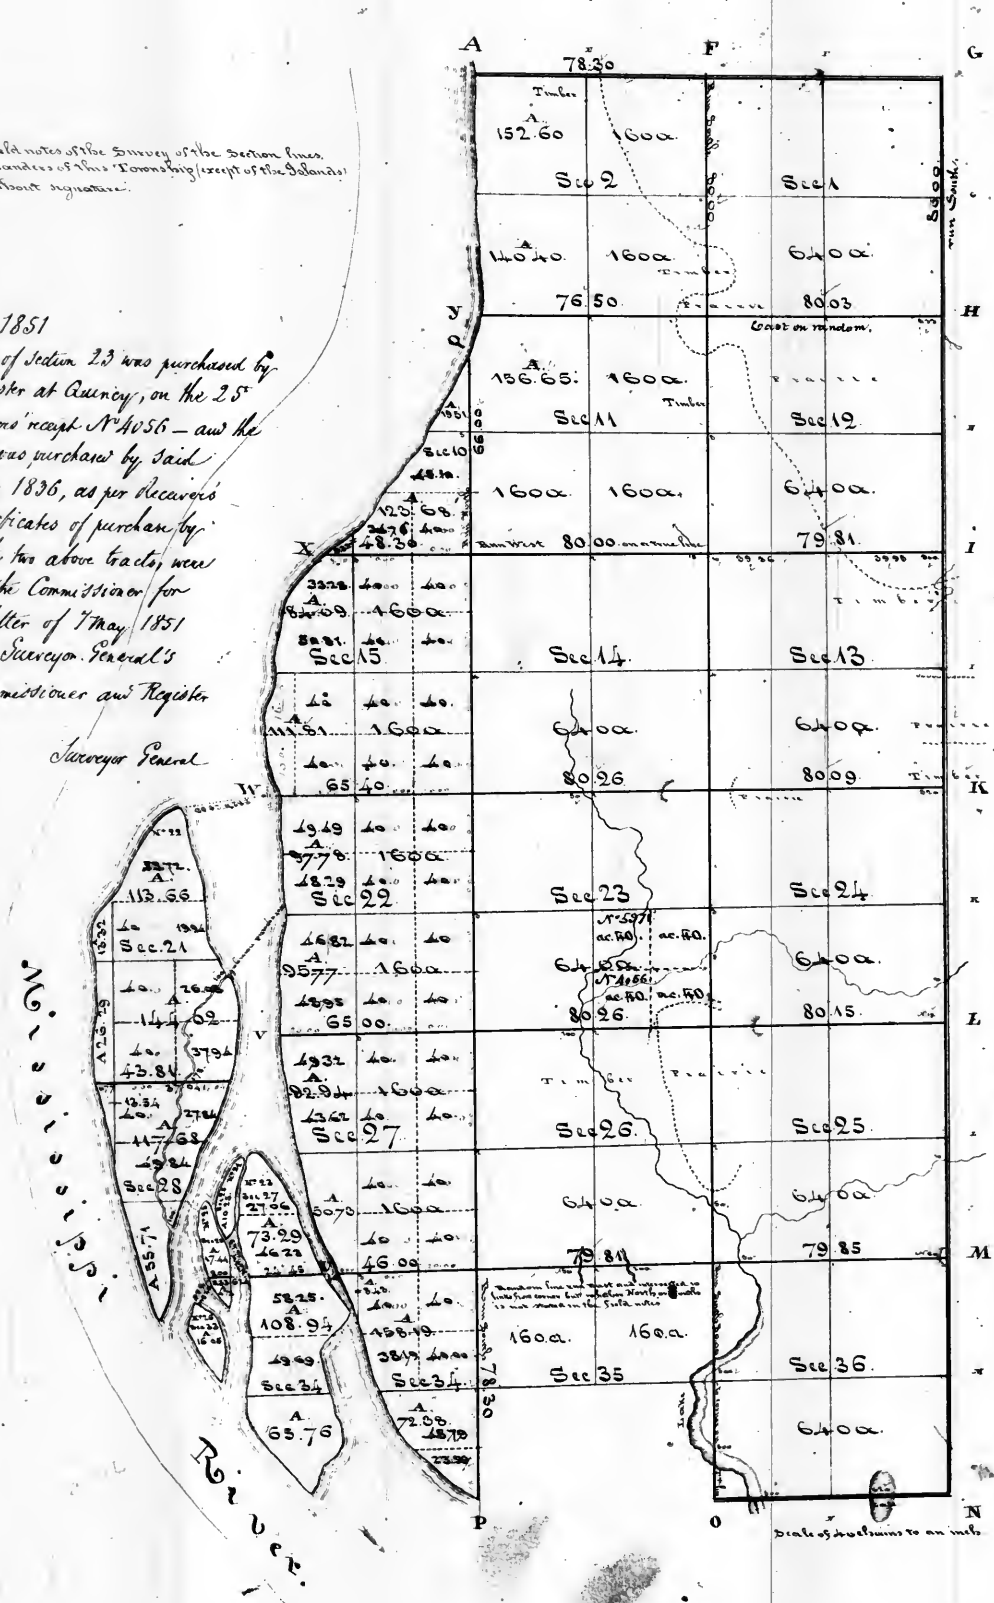


Note
The East boundary of this Township was originally surveyed 30.00 miles further west, 1810, apparently by John or James M. Donald, and then was surveyed 30.00 miles from a corner to Township 21, Range 25, which established apparently 20.00 chains East of the old corner to said Township, apparently by John M. Donald. In what appears to be the original notes of the survey of said boundary (which are dated the 31st October 1815, but are without signature) the length of the East boundary of section 26, seems to have been first written 20.00 chains and the distance to the 1/4 section corner there on 10.00 chains, and the two distances to have been altered to 20.00 chains and 20.00 chains respectively. In what appears to be the copy of said original notes (and which are in a book signed 'John M. Donald') the length of the East boundary of section 26, seems to have been first written 20.00 chains and the distance to the 1/4 section corner there on 10.00 chains, and the two distances to have been altered to 20.00 chains and 20.00 chains respectively. There is also in the office an abstract of field notes of a part of the East boundary of the township of sections 21 to 26, or two separate loose leaves or pieces of paper (with the name of John M. Donald on the back of one of them) and which make the East boundary of section 26 to be 20.00 chains in length, and the distance to the 1/4 section corner there on 20.00 chains. These detached notes agree in other respects with the before mentioned original notes of the survey and with the supposed copy, except that certain recollections of any quarter section corners on the East boundary of sections 21, 23 & 25, and that there is an omission therein of one entry contained in the above said original notes which entry however was evidently interlined in the original notes subsequent to their being first taken or written. Under these circumstances the East boundary of the Township is laid down on this plat as nearly as may be in conformity with the foregoing described notes of the survey of the East boundary of section 26 being set down at 20.00 chains as most probably its true length, and which is corroborated by the old plat of the Township that is on file. It will be found that the line between sections 21 & 22, S. 2, R. 9, W. intersects the range line 30.00 miles South of the corner to sections 21 & 26 in Range 9.
The South boundary of S. 2, R. 9, W. was originally surveyed West 26.60 chains to a part of the Mississippi river on the 20th November 1810 by John or James M. Donald, and was surveyed West 1 mile 75.00 chains to the Mississippi on what appears to be such. The original field notes of the survey are without dated nor signed, another set of notes of the same boundary which have the appearance of being a copy of the originals are in a book signed by John M. Donald and differ from the supposed original notes in the descriptions given of the 1/4 section corner on the South boundary of section 26 and of the Township corner on the river boundary. Differences will be found noted on the general description of the Township.

Subdivided under the Act of Congress of the 5th of April and sent copies on to the Register of the District, and on to the Commissioner of the General Land Office.

| Designation of tracts | When sent to the Register | Comments |
|---|---------------------------|----------|
| Part Sec. 26 on Island N. 22 in the river cut off the main channel thereof | 2 nd May 1851 | |
| Sec. 10, 15, 22, 24, 25, 26, - Sec. 21 on Island N. 22, and Island numbered 23, 24, 25, 26 in the Mississippi river | | |
| Date of orig. subdivision not recorded
E. 1/2 Sec. 21, in Island N. 22, - Sec. 27, 28, 29, 30, 31, 32, 33, 34, 35, 36 (both in Island N. 22), and S. 2, 3, 4, 5, 6, 7, 8, 9, 10, 11, 12, 13, 14, 15, 16, 17, 18, 19, 20, 21, 22, 23, 24, 25, 26, 27, 28, 29, 30, 31, 32, 33, 34, 35, 36 (main shore) | 2 nd Feb 1851 | |

Surveyors Office
St. Louis 18th September 1830
The above plat of part Twp. N. 2, R. 9, W. of the 4th P. M. (except the South half of sec. 31, or within them) is conformable to the field notes - plat of township on file in this office.
J. M. Donald
Sr. of plat Sec

T 3 S. R. 9 W. of the 4th p. M.

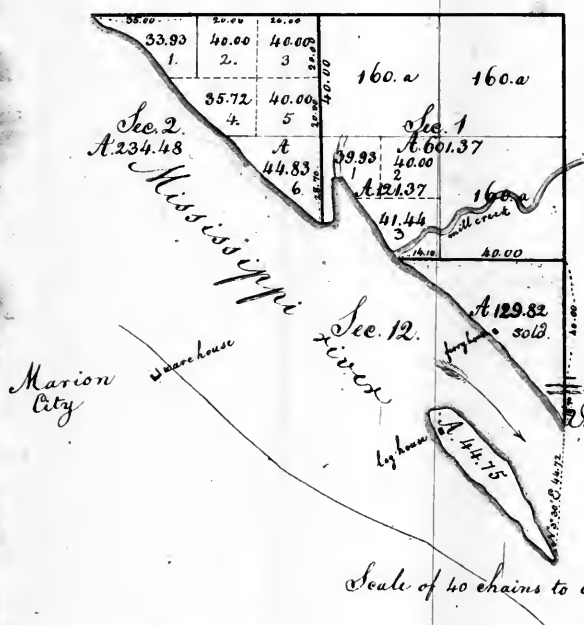

Statement referred to is as follows below.

| Lines | n. ch. 1843 |
|--|------------------|
| 6. by sec. 12. 1/2 of 1/2 sec. corner | 15 70 |
| Line between sec. 12. 1/2 of 1/2 sec. corner | 16 10 |
| Meander of Mississippi along section 12. 1/2 on main shore | 2 77 36 |
| On island | 1 52 35 |
| Connection b/w range line and island | 44 72 |
| Total | 5, 46, 86 |

A copy of this plat sent to the Commissioner of the Register on 23rd of October 1844.

Surveyor's Office.
Saint Louis 10th of October 1844.

The above plat of township 3 south of the base line, of range 9 west of the 4th principal meridian is strictly conformable to the field notes of the survey, heretofore on file in this office, which have been examined and approved. In 1842 to 1843, Amasa R. Barker, under instructions of the 12th of March 1842, surveyed the lines detailed in the marginal statement, 5 miles 46.86 chains, which were paid for in the 2nd quarter of 1844, and charged in the account current of the Surveyor General, during the same quarter, under the appropriation of \$3000, of the 3rd of March 1843 (p. 95 Acts 3rd Session 27th Congress) for surveying, unfringed and chained line in Illinois & Missouri, at a rate not exceeding six dollars a mile.

Silas Reed
Surveyor of the public lands
in Illinois & Missouri.

62



A copy of this plat was sent to the Reg^t. at Quincy on the 11th Sept^r 1838 and another to the Comm^r. of the Gen^l. Land Office on 10th Sept^r 1842.

Aggregate Area 995.22 acres.

VOL 26


L
 Bureau's Office
 St Louis, 11 Sept 1862
 Plot of the North
 123, 5540, from S
 and of the West
 155043, and that
 from the West
 Bureau's Office
 St Louis, 16
 - Subd. the S. of
 of Dec. 1861, S. of
 up to conform to
 in Feb. 1862.
 to the Bureau's Office
 Bureau's Office
 St Louis, 16
 Plot of the N. of
 the S. of
 S. of Dec. 1861 and
 of Dec. 7, 1862
 the Reg.

E. J. Sangham

Township 27 North of the base line Range 1 East of 3^d principal Meridian

3981
4228
8209

2

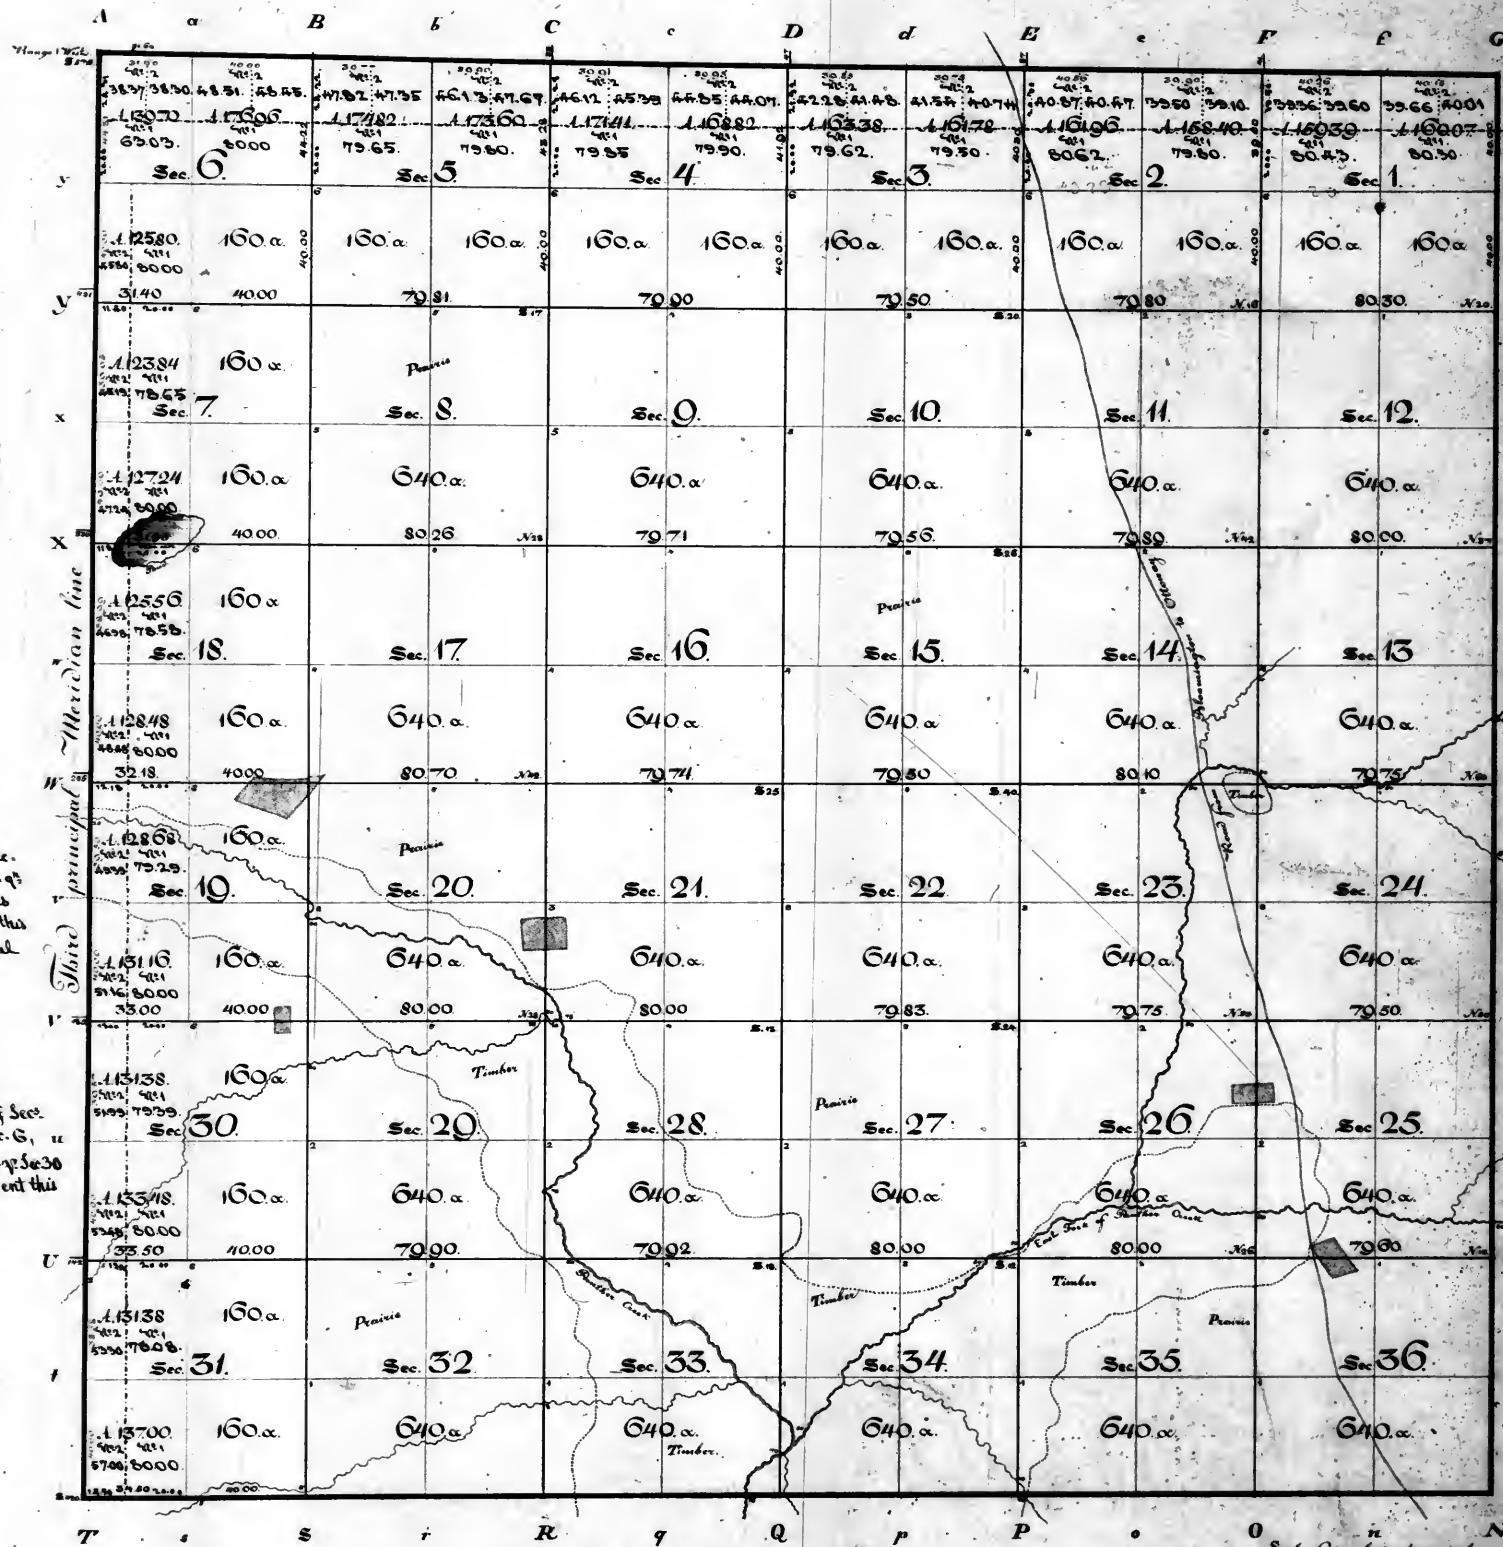

Reference to the field notes used in the construction of this plat of the North boundary by John M. Collins in May 1851, of the North, South & East lines, and a Subdivision line by John M. Collins, under his contract of the 12th of August 1853, as charged for in his account of the 30th of December 1853. The North boundary was run to 15th of October 1853. East boundary was run 15th of October 1853. South boundary was run 15th of October 1853. Subdivision lines were run from October 21st to December 15th 1853.

The South East & North boundaries & the Subdivision lines were surveyed at an assumed variation of 8° East to conform to the 3^d principal Meridian. The field notes of the West boundary do not give the variation at which it was surveyed.

Surveyor's Office
St. Louis 10th Sept. 1852.
At of the North halves of Sec. 1, 2, 3, 4, 5 & 6, of the S.W. q. of Sec. 6, and of the West halves Sec. 7, 18, 19, 30 & 31, sent this to the Commr. of the General Land Office.

Surveyor's Office
St. Louis, 16th February 1857
At of plat of the North halves of Sec. 1, 2, 3, 4, 5 & 6, of the S.W. q. of Sec. 6, of the N.W. q. of Sec. 15, of the S.W. q. of Sec. 30 & of the West half of Sec. 31, sent this to the Register.

Surveyor's Office
St. Louis 19th of June 1858.

This plat of Township 27 North of the base line Range 1 East of 3^d principal Meridian is conformable to the field notes of the survey thereof on file in this Office.

E. J. Langham

Township 28 North of the base line Range 1 East of 3^d principal Meridian.

3989

3


Reference to the field notes and the instructions of the State of Missouri of the 10th of May 1821 by John F. McCallum. North, South & East boundaries and Subdivision lines by John Milton Moore and his associates of the 15th of August 1823 and changed for an amount of the 20th December 1824. The title of the North boundary on the 20th of October 1823. South boundary on the 15th of October 1823. East boundary on the 15th of October 1823. Subdivision lines on the 21st of April 1824.

The field notes of the North boundary to give the variation at which it was surveyed. The North, East & South boundaries of the Subdivision lines were surveyed at an assumed variation of 1° East to conform to the 3^d principal Meridian.




Aggregate Area 22715.60 Acres

Surveyor's Office St. Louis 19th June 1853.

The above Plat of Township 28 North of the base line Range 1 East of 3^d principal Meridian is conformable to the field notes of the survey thereof on file in this Office.

E. J. Langham

4

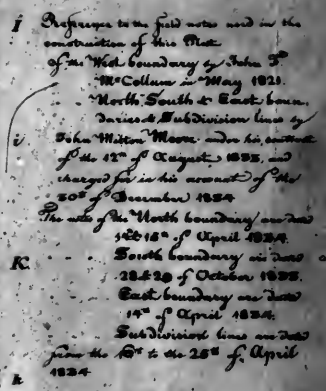

The South East & North boundaries & the Subdivision lines were surveyed at an assumed Position of 8° East to conform to the Principal Meridian. The first section of the West boundary is not given the Meridian at which it was surveyed.


Two random lines in the Subdivision of
this Township were run S. 80° E. parallel
to the random line on the South
boundary thereof.

Surveyor's Office
St. Louis 11th Sept 1842.
Plat of the North halves of sections
1, 2, 3, 4, 5, 6, & of the S. 1/2 of section 6
and of the West halves of sections 1, 2, 3, 4, 5, 6, &
and this day to the Commissioner of the Public Lands
Surveyor's Office
Saint Louis June 15th 1849.
Plat of the North halves of sections 1,
3, 4, 5 & 6 of the East 1/2 of section 36
section 6, and of the West halves
7, 8, 19, 30 & 4, and this day to the
Register of the Land Office at St. Louis

The above Plat of Township 29 North of the base line Range 1 East of 3^d principal Meridian is conformable to the field notes of the survey thereof on file in this Office.

E. J. Sangham

Township 30 North of the base line Range 1 East of 3^d principal Meridian

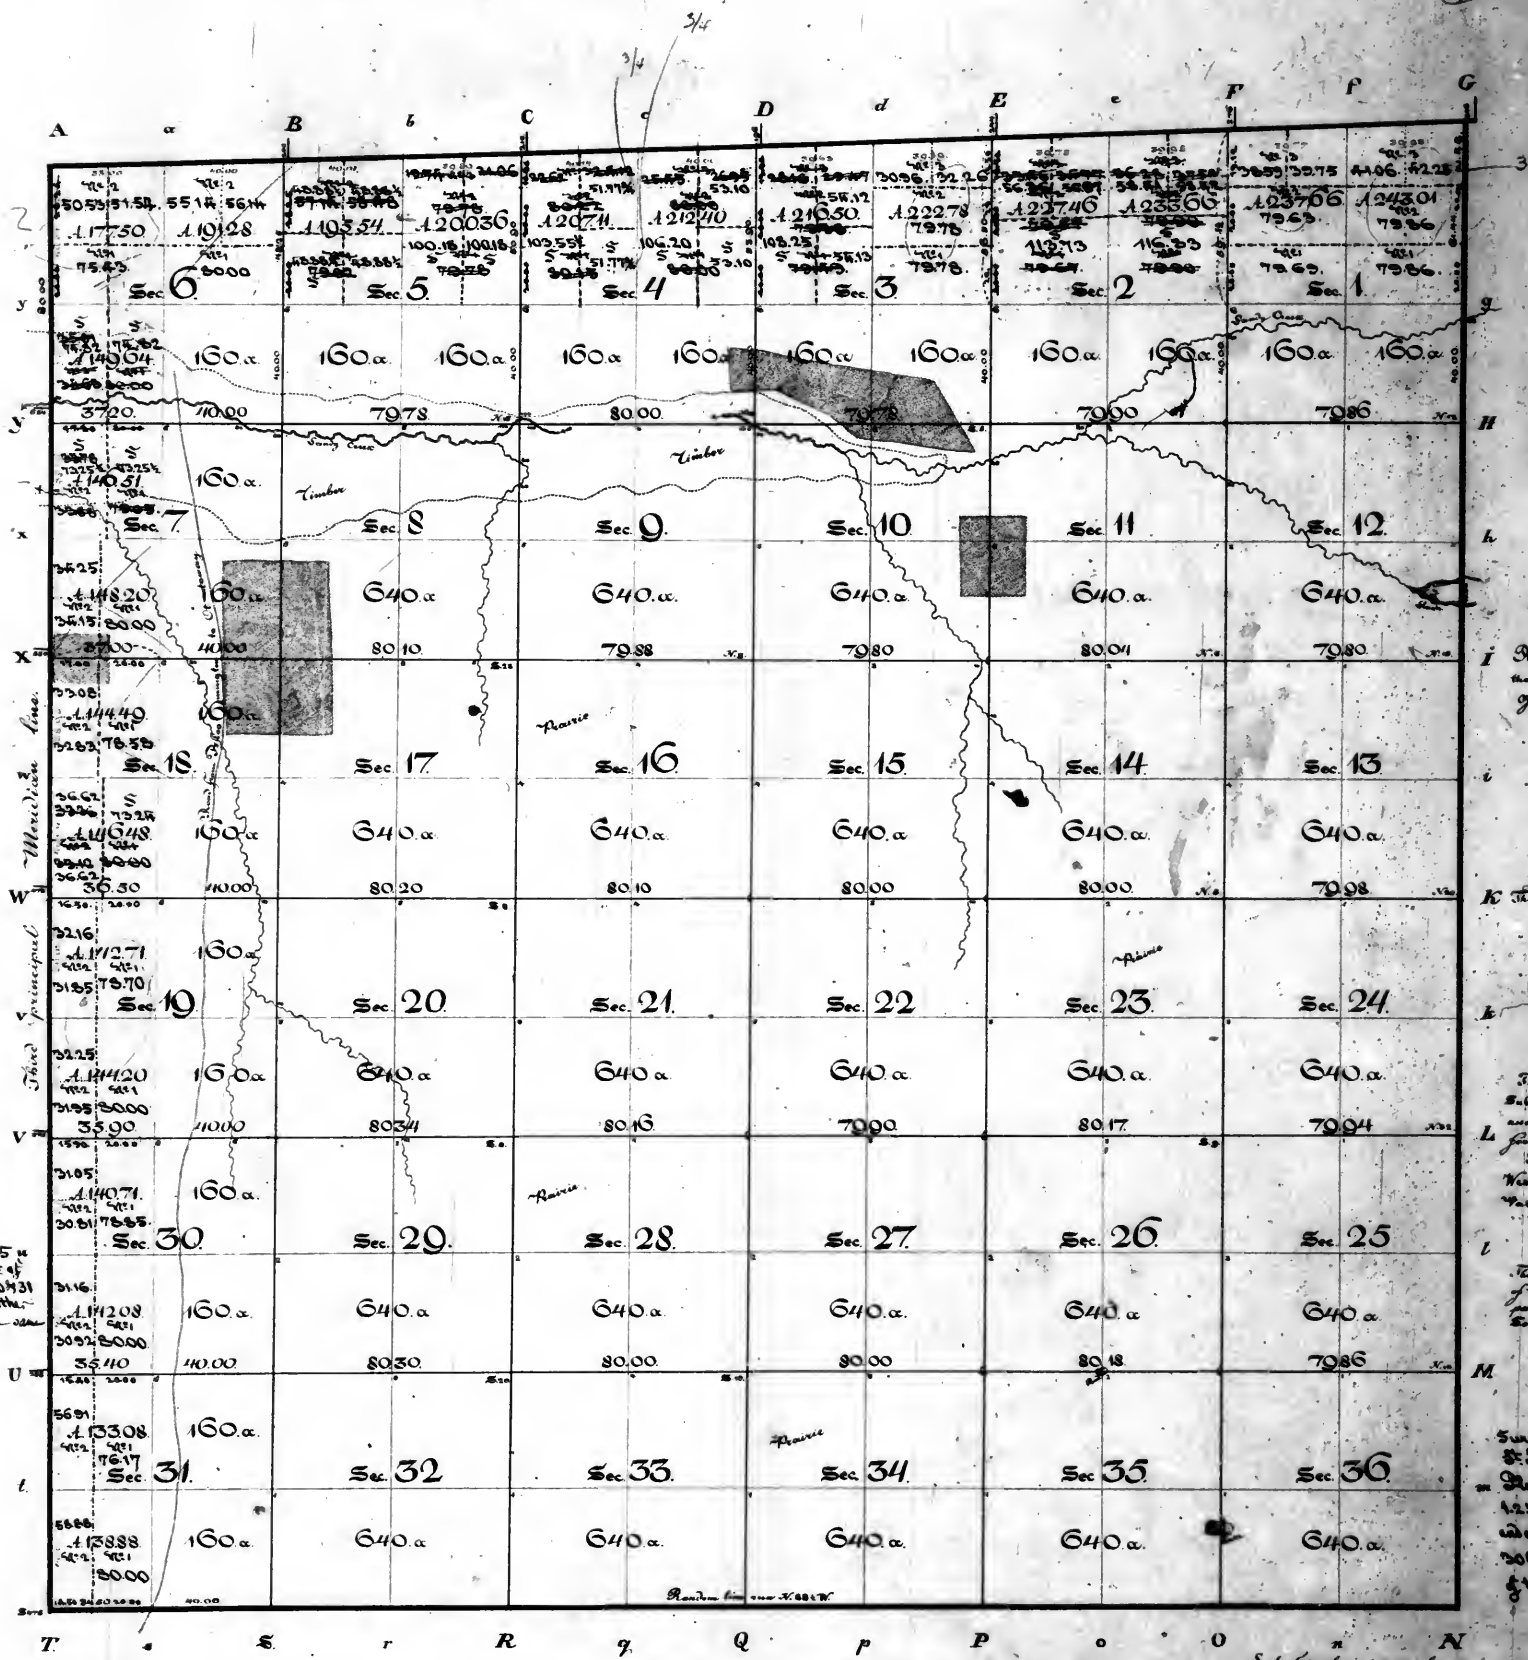

Reference to the field notes used in the construction of this Plat
 of the North boundary by R.D. Mohr
 dated May 1821
 of the West boundary by John L.
 McCallum in May 1821
 of the South & East boundaries
 & Subdivision lines by John
 Milton Moore and his son
 dated the 12th of August 1828
 and changed for his account
 of the 20th of December 1824
 of the 15th of April 1824
 of the 26th of April 1824
 Subdivision lines are dated
 from 15th of April to May 30
 1824

The South & East boundaries of the
 Subdivision lines are surveyed at an
 assumed Variation of 8° East to con-
 form to the 3^d principal Meridian
 The field notes of the North &
 West boundaries do not give the
 Variation at which they were surveyed

The random line in the Subdivision
 of this Township was run 1822 &
 parallel to the random line on the
 South boundary thereof


Surveyors Office
 St Louis 19th Sept 1842
 Plat of the North halves of sections
 1, 2, 3, 4, 5, 6, 7, 8, 9, 10, 11, 12, 13, 14, 15,
 and of the West halves of sections 14, 15,
 20 & 21 not this day to the Comptroller
 of the General Land Office.

Surveyors Office
 St Louis Sept 15th 1846
 Plat of the North halves of Sec 1, 2, 3, 4, 5 &
 the SW. 1/4 of Sec 3 & 15 of the R. 1 E. of
 3^d of the West halves of Sec 15, 20 & 21
 not this day to the Register and another
 sent to the Commissioner on the same
 day

Surveyors Office
 St Louis 18th June 1838
 The above Plat of Township 30 North of the base line Range 1 East of 3^d principal Meridian is conformable to the field notes
 of the survey thereof on file in this Office
 C. J. Sangham

Aggregate Area 23502.24 acres


72-77 of Township 1.31 North of the base line Range 1.1 East of the 3. principal Meridian.

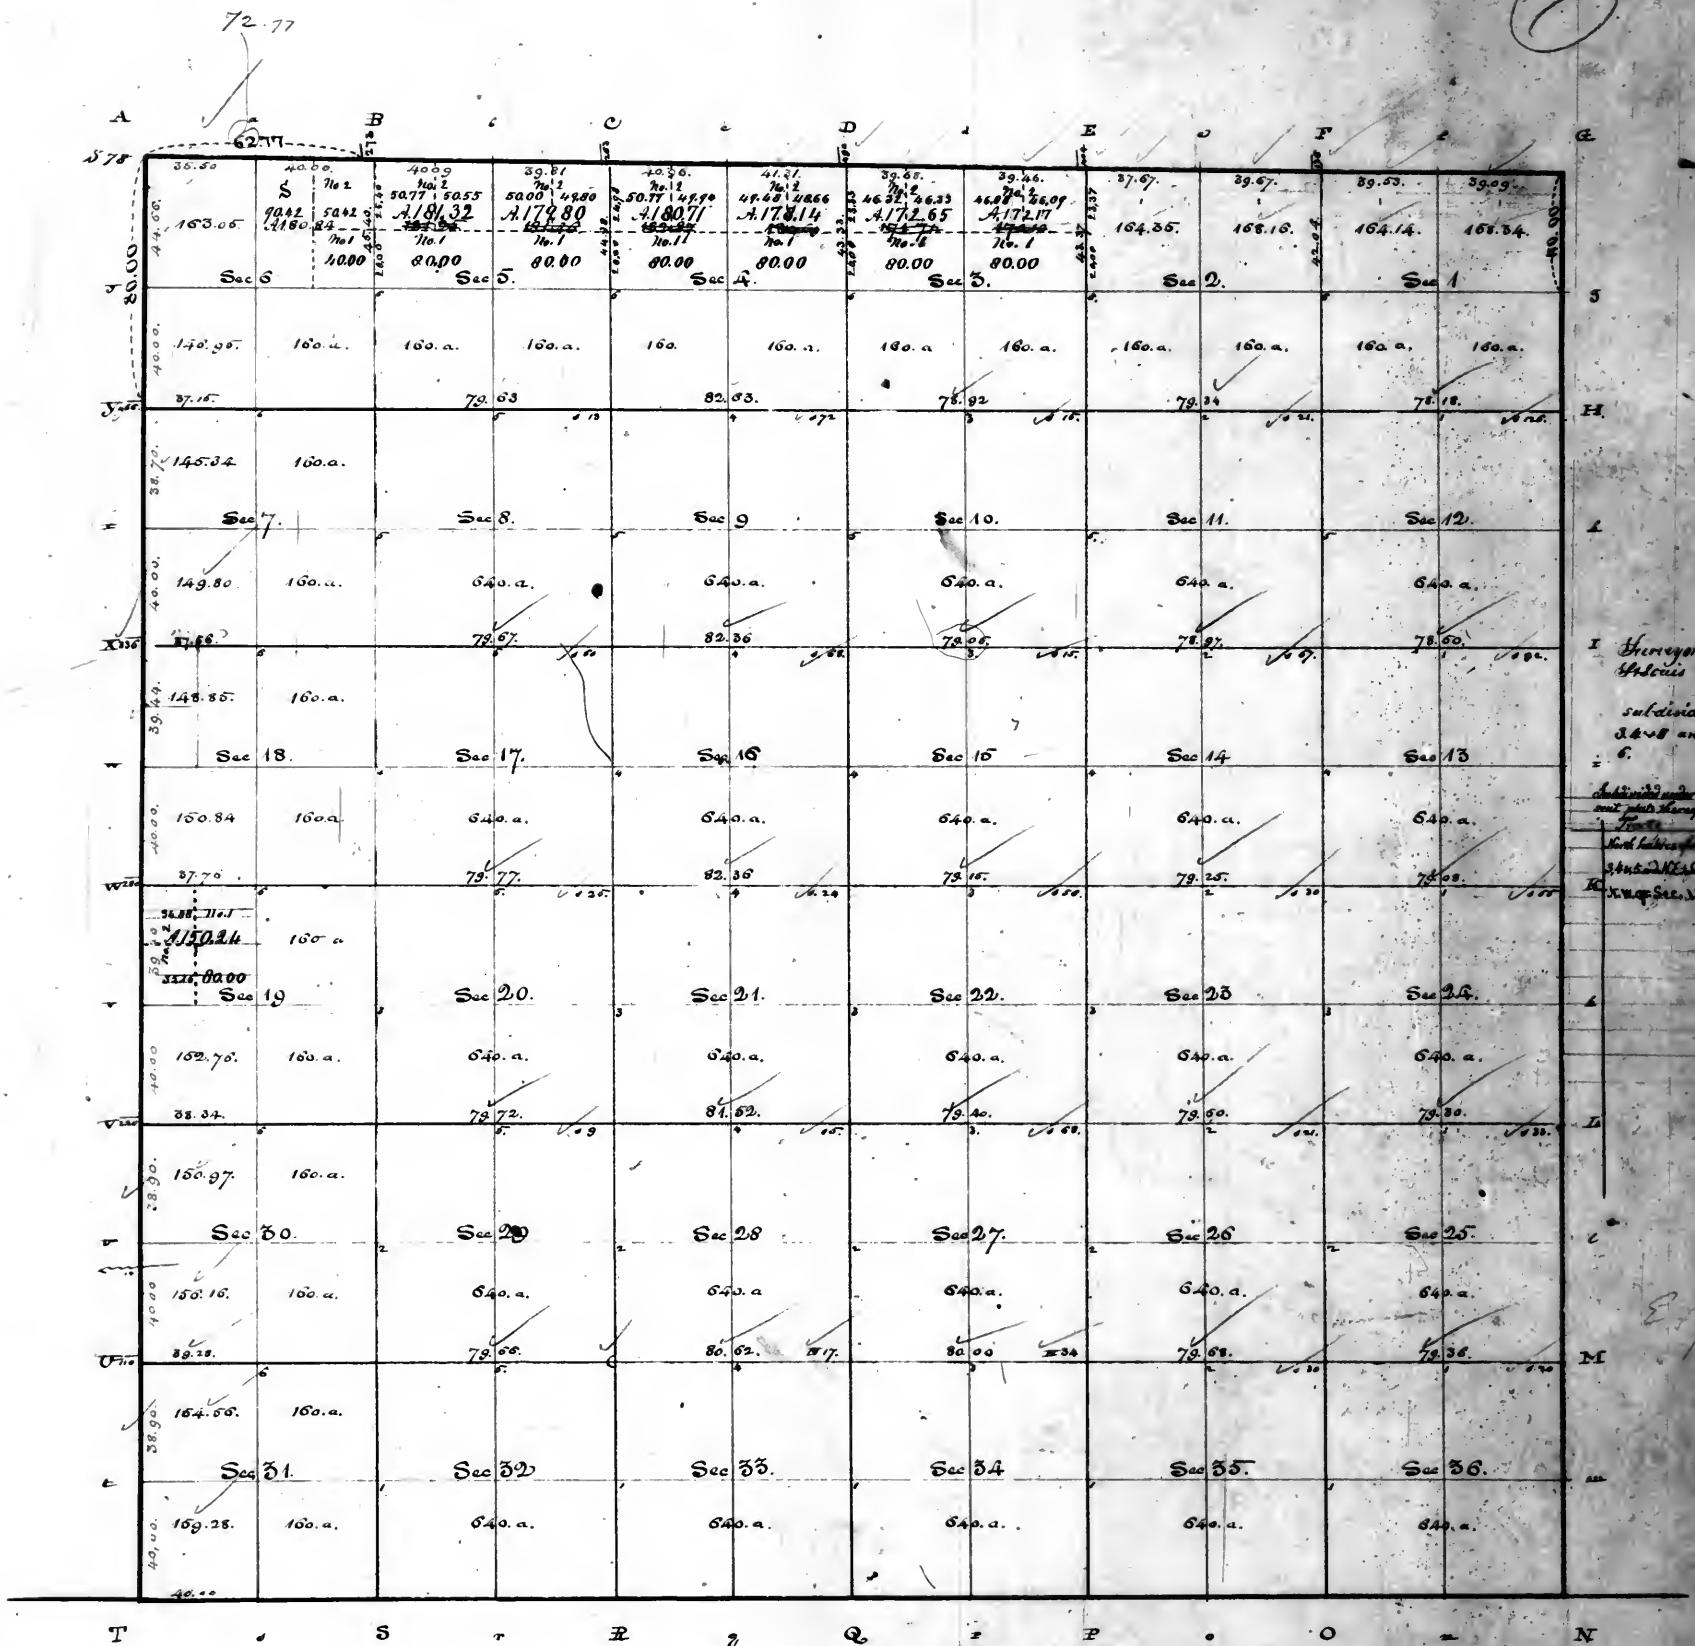

Surveyors Office
St. Louis June 28. 1834.

The above Plat of Township 1.31 North, Range 1.1 East of the 3. principal Meridian is conformable to the field notes of the Survey thereof on file in this Office

E. J. Sanborn

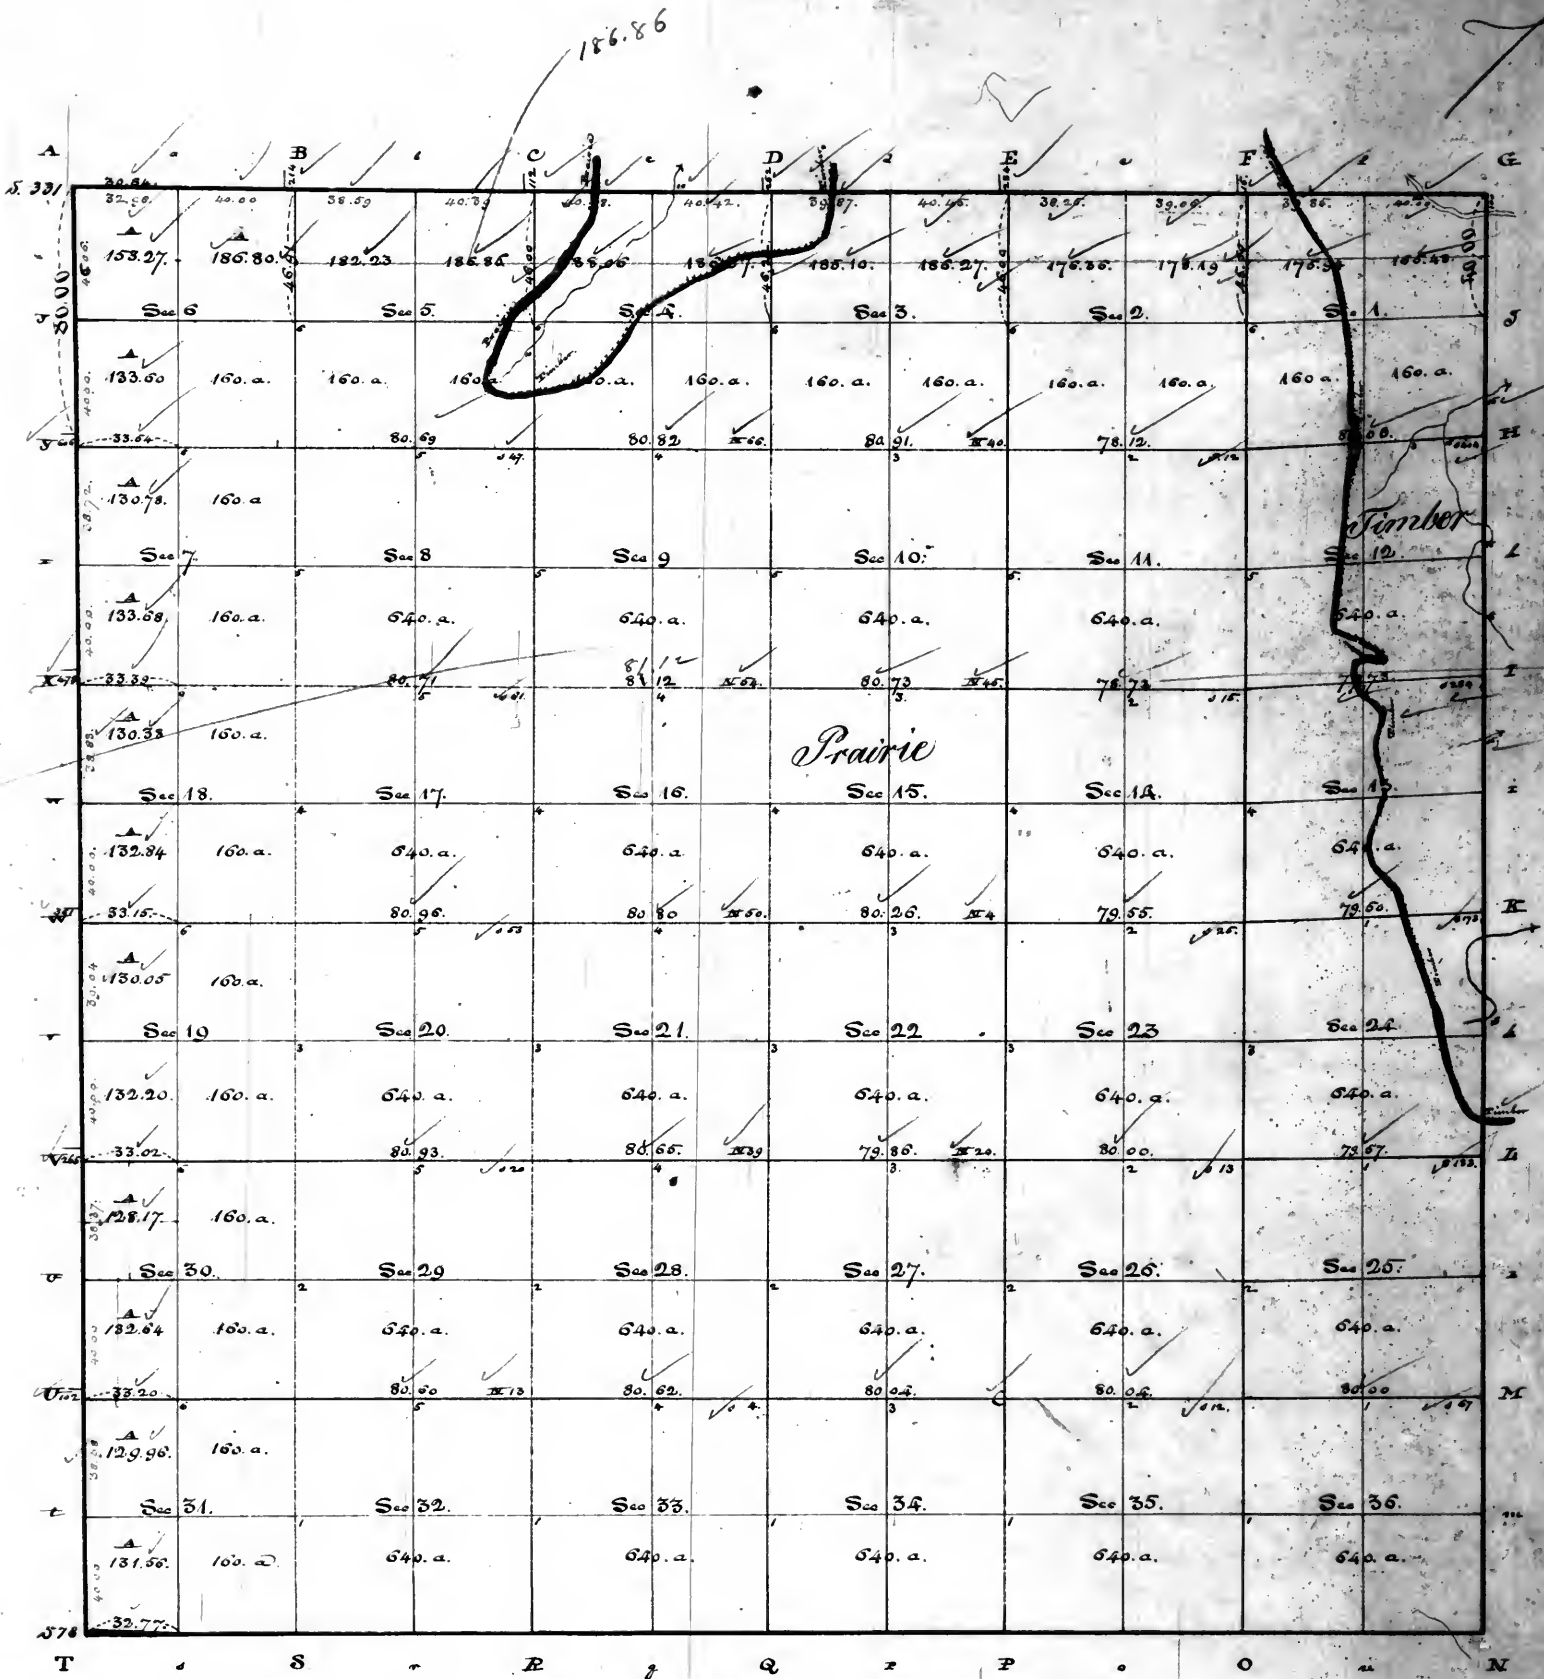


Surveyors Office
St Louis June 27th 1834

The above Plat of Township 32 North, Range N. 1 East of the 5th Principal Meridian is conformable to the field notes of the survey thereof on file in this Office.

E. B. Langham

8

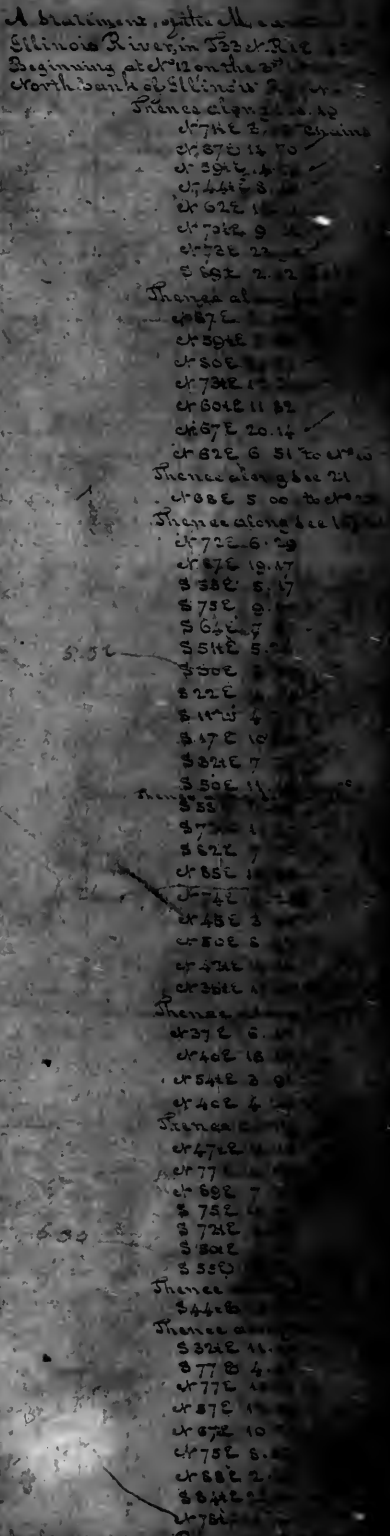

the line between Lane
Beginning at st 1 on
on the South side of
Then
at 6
3
at 2
3
at 1
3
3
at 7
at 6
Thence
at 2
at
at 6
at 2


A statement of the all bearings of Sec.
10, 21, 22 on an Island in Sheet 218
Beginning at a ^{point} on the north side
of the Island at the end of the line be-
tween Sec. 10, 21, 22 and at along Sec-
tion 20 — 218 W. 1857

Scale of 40 chains to an inch.
It extends on the South side of the Illinois
Continued from 1824 along bee 21.


[illegible]

of the several
 fractional sections
 of the plat.
 224.45 acres

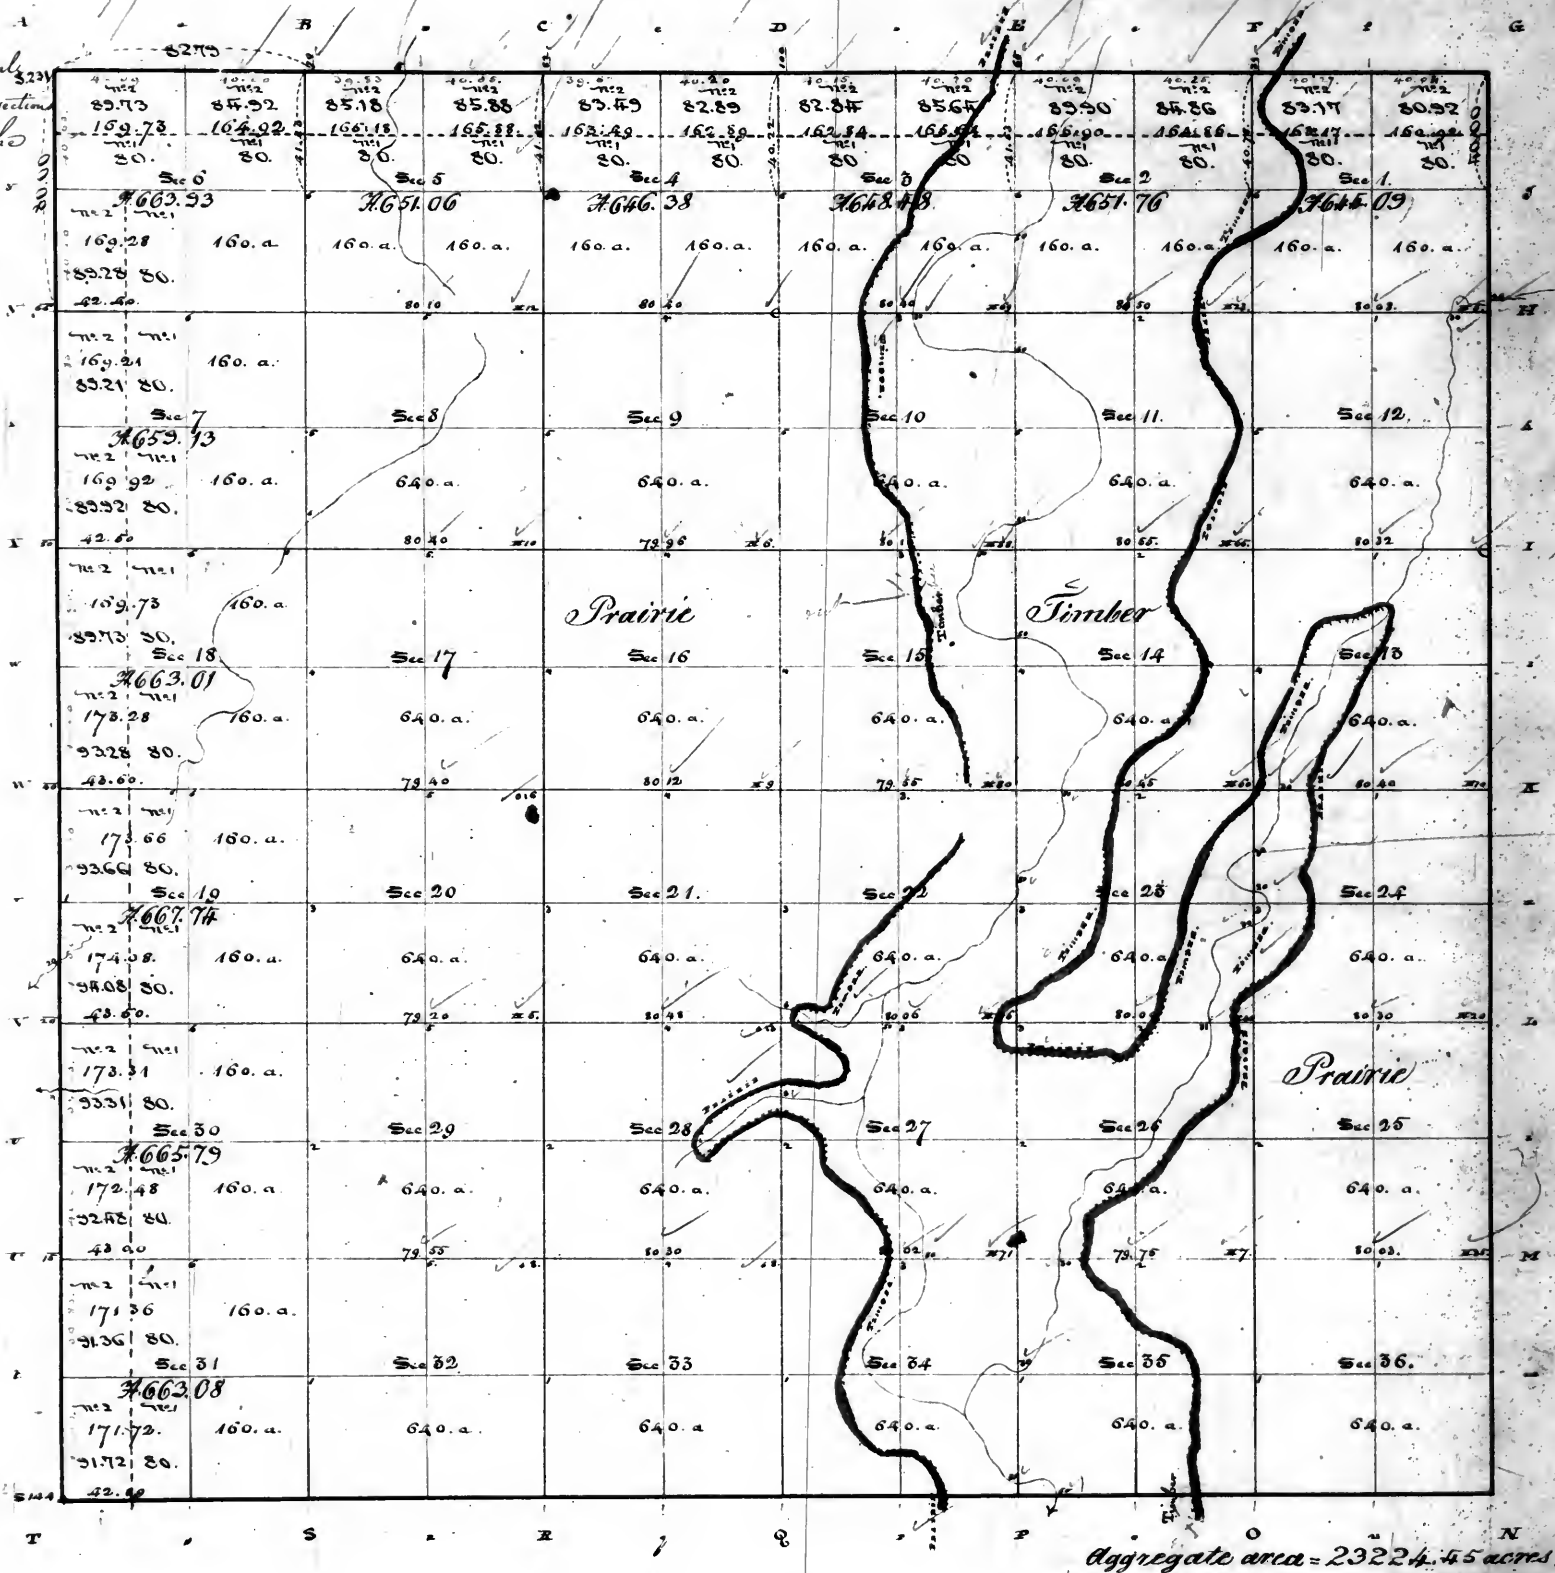

Examined
 12 June 1854

Surveyors Office
 St. Louis June 21 1854.

The above Plat of Township 34 North of the Base Line, Range 1 East of
 the 3rd Principal Meridian, is conformable to the field notes of the Survey thereof on file in this Office.

E. J. Vanham




of Township N. 35 North of the Base Line,



Range 1 East of the 3rd Principal Meridian.



Arrows of the several sections of fractional sections of T. 35 N. Range 1 East of the 3rd principal meridian are set down on this plat.

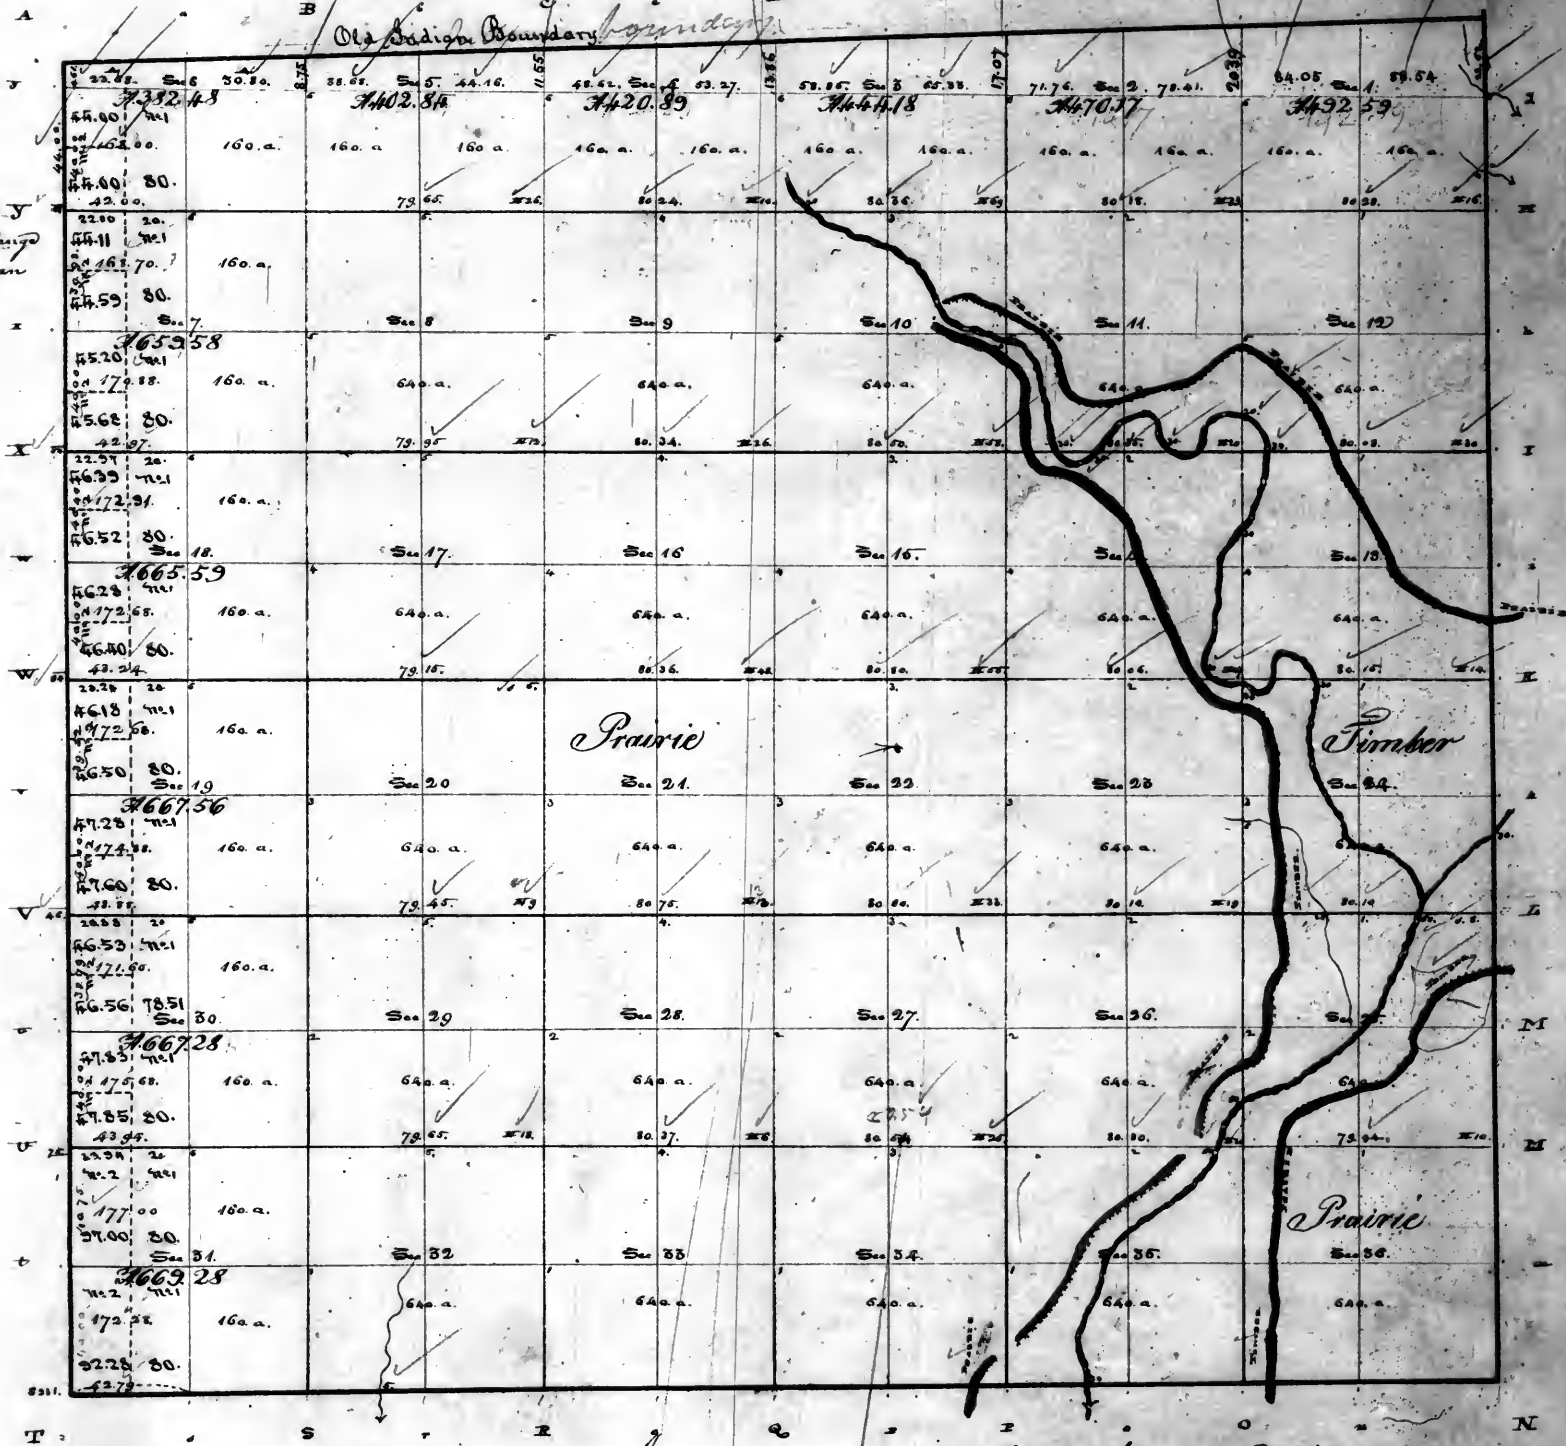


Aggregate area = 21942.44 acres

Surveyors Office
St. Louis June 28th 1854.

The above Plat of Township 35 North of the Base line, Range 1 East of the 3rd principal Meridian, is conformable to the field notes of the survey thereof on file in this Office.

E. J. Humphreys

Fractional Township 35 North of the base line Range 1 East of the 3^d principal Meridian
North of the old Indian boundary line.

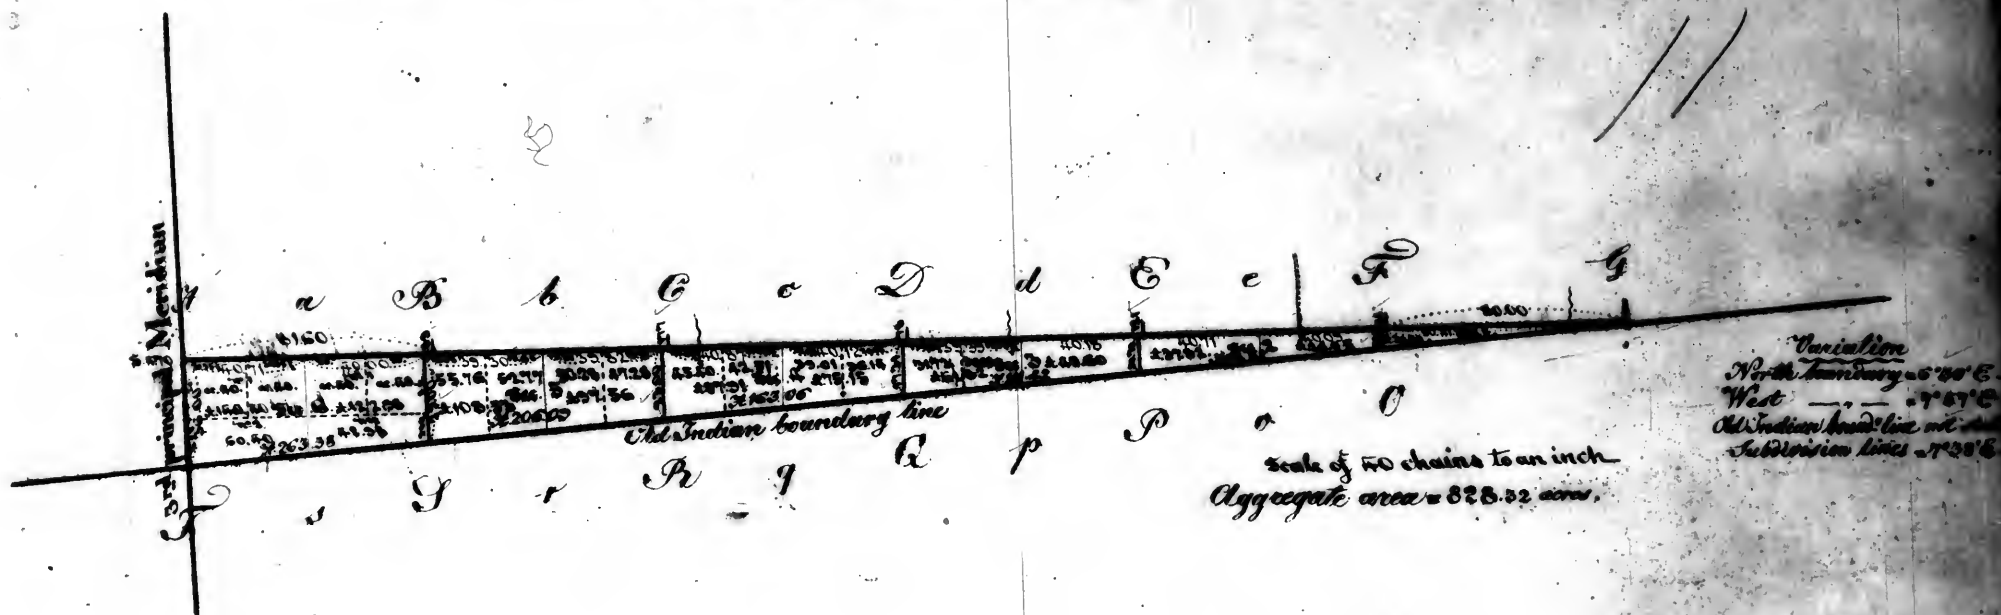

Surveyor's Office.

Saint Louis 30th of May 1843.

The above plat of township 35 north of the base line, range 1 east of the 3^d principal meridian, north of the old indian boundary line, is strictly conformable to the field notes of the survey thereof on file in this office, which have been examined and approved. The South boundary, which is designated 'Old Indian boundary line' was surveyed by John C. Sullivan, assisted by James M. Brainerd, in the 1st quarter of 1819, under the authority of a letter of appointment from William Recker, Surveyor of the lands of the United States in Illinois and Missouri, dated October 18th 1813, authorizing them to survey certain indian boundaries, under the direction of Commissioners Graham and Phelps, appointed by the President of the United States, to run the lines of the tract ceded by the treaty of Saint Louis of the 24th of August 1816, between the United States and the United Nations of Ottawas, Chippewas and Potawatamies - This being the line agreed to be run West to the Mississippi from a point on Fox river one west of the Southern extremity of Lake Michigan - The west boundary 36.00 chains, was surveyed in the 4th quarter of 1835, by Leon Alonzo Spaulding, under contract dated the 9th of June 1835; and it was, with the limitation noted below, paid for in the 3^d quarter of 1837 (Voucher N^o 6) and in the 2^d quarter of 1839 (Voucher N^o 7) - The north boundary 6 miles 1.60 chains, was surveyed in the 2^d quarter of 1838, by Eli S. Prescott, under contract signed by the Surveyor General on the 8th of May, and by Prescott on the 3^d of June 1837, - it was paid for in the 4th quarter of 1838, and charged in the account current of the Surveyor General during that quarter, Voucher N^o 5 - The subdivision lines 1 mile 5.11 chains were surveyed in the 4th quarter of 1842, by G. E. Welder, under contract of the 20th of October 1842 - They were paid for in the 2^d quarter of 1843, and charged in the account current of the Surveyor General, during said quarter, Voucher N^o 5.


Silas Reed

Surveyor of the public lands in the States of Illinois and Missouri.

Note: The accounts in which the west boundary of this township is charged amount to \$2443.95, of which \$2050, were paid on the 20th of July 1837; and \$393.95, on the 20th day of June 1839 - The balance, being \$393.95, having been paid by E. J. Langham, former Surveyor General.

Township 36 North of the base line Range 1 East of the 3rd principal Meridian.

12

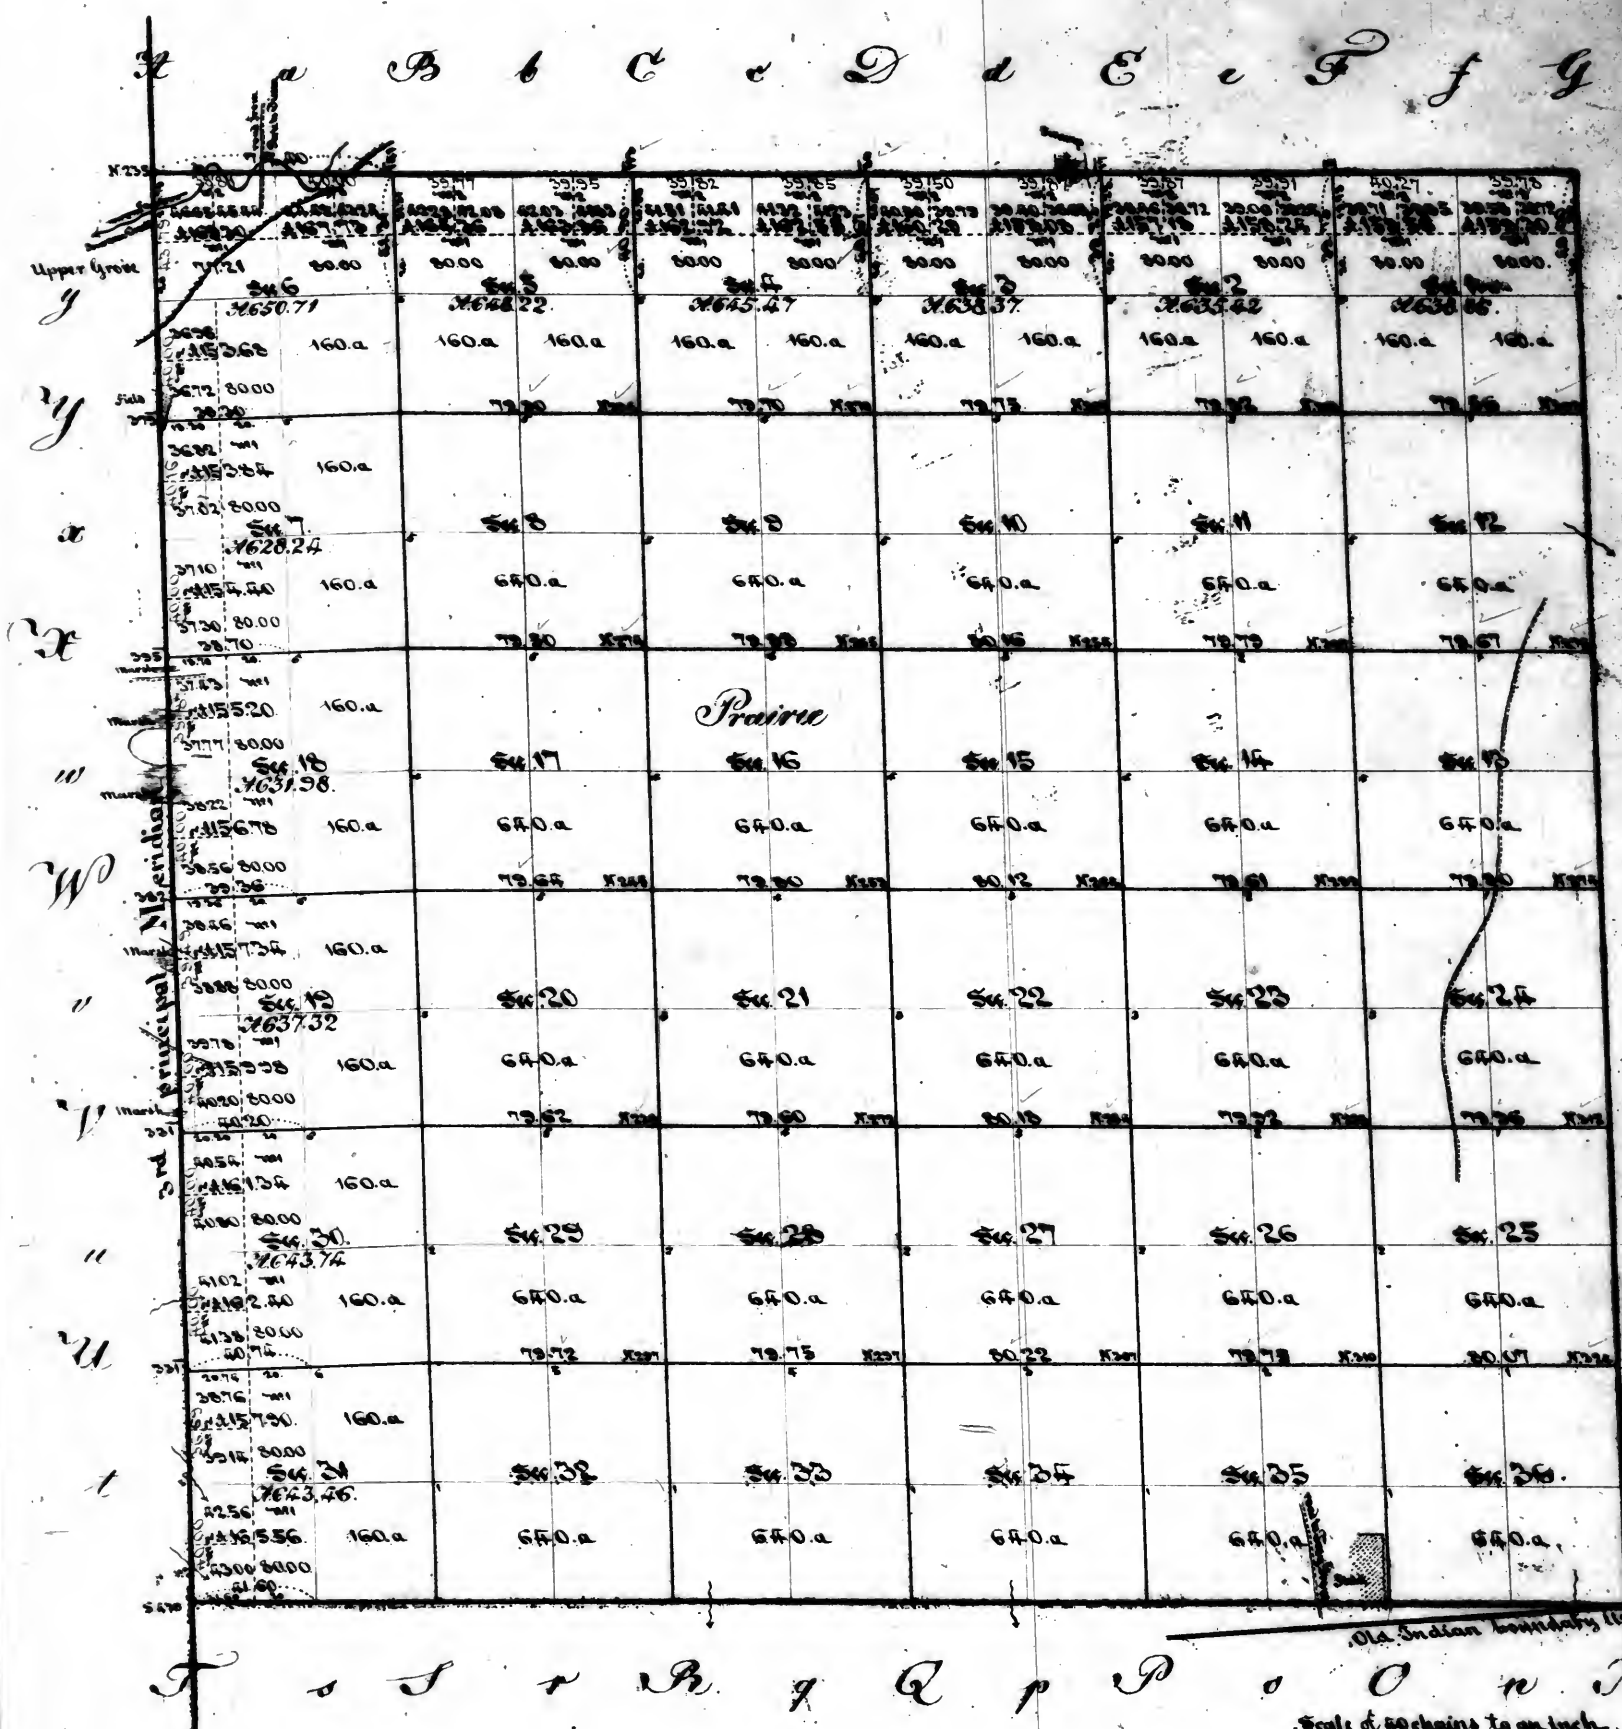

g.
H
k
i
K
K
E
l
M
m

Note. The accounts in which the west boundary of this township is charged amount to \$1250.95, of which \$1250.00 was paid on the 24th of July 1837, and \$93.95 on the 20th of June 1838. The balance of \$93.95 on the 20th of June 1838. former Surveyor General.


Variation
South boundary - 6° 30' E.
East - 8° 15' E.
North - 8° 45' E.
West - 8° 15' E.
Subdivision line - 7° 15' E.

Old Indian boundary line...
Scale of 40 chains to an inch.
Aggregate area - 23041.73 acres.

| Lines designated | By whom Surveyed | Date of Contract | Amount of surveying miles, chains, links | When executed | When paid for | No of vouchers in Sur. Genl's. accounts. | Remarks. |
|-------------------|------------------|---------------------------------------|--|--|------------------------------|---|-----------|
| West boundary | L. A. Spaulding | 9 th June 1835 | 6. 00. 00 | 4 th q ^r of 1835 | 29 th July 1837 | 6 of 8 th q ^r of 1837 | See note. |
| East boundary | Eli S. Prescott | signed by Sur. Genl | 6. 00. 00 | 4 th q ^r of 1837 | 3 rd Decemb. 1838 | 5. 4 th q ^r of 1838 | |
| North boundary | do. | 3 rd May, and by | 5. 77. 40 | 2 nd - 1838 | do | 5. do | |
| South boundary | do. | Prescott on 2 nd June 1837 | 6. 01. 60 | do. | do. | 5. do. | |
| Subdivision lines | G. E. Walker | 20 th Oct. 1842 | 59. 74. 73 | 4 th q ^r of 1842 | 20 th May 1843 | 5. 2 nd q ^r of 1843 | |

Surveyors Office.
Saint Louis 30th of May 1843.
The above plat of township 36 north of the base line, range 1 East of the 3rd principal meridian, is strictly conformable to the field notes of the Survey thereof on file in this office which have been examined and approved.
Silas Reed
Surveyor of the public lands in the State of Illinois.

Township 37 North of the base line Range East of the 3rd principal Meridian

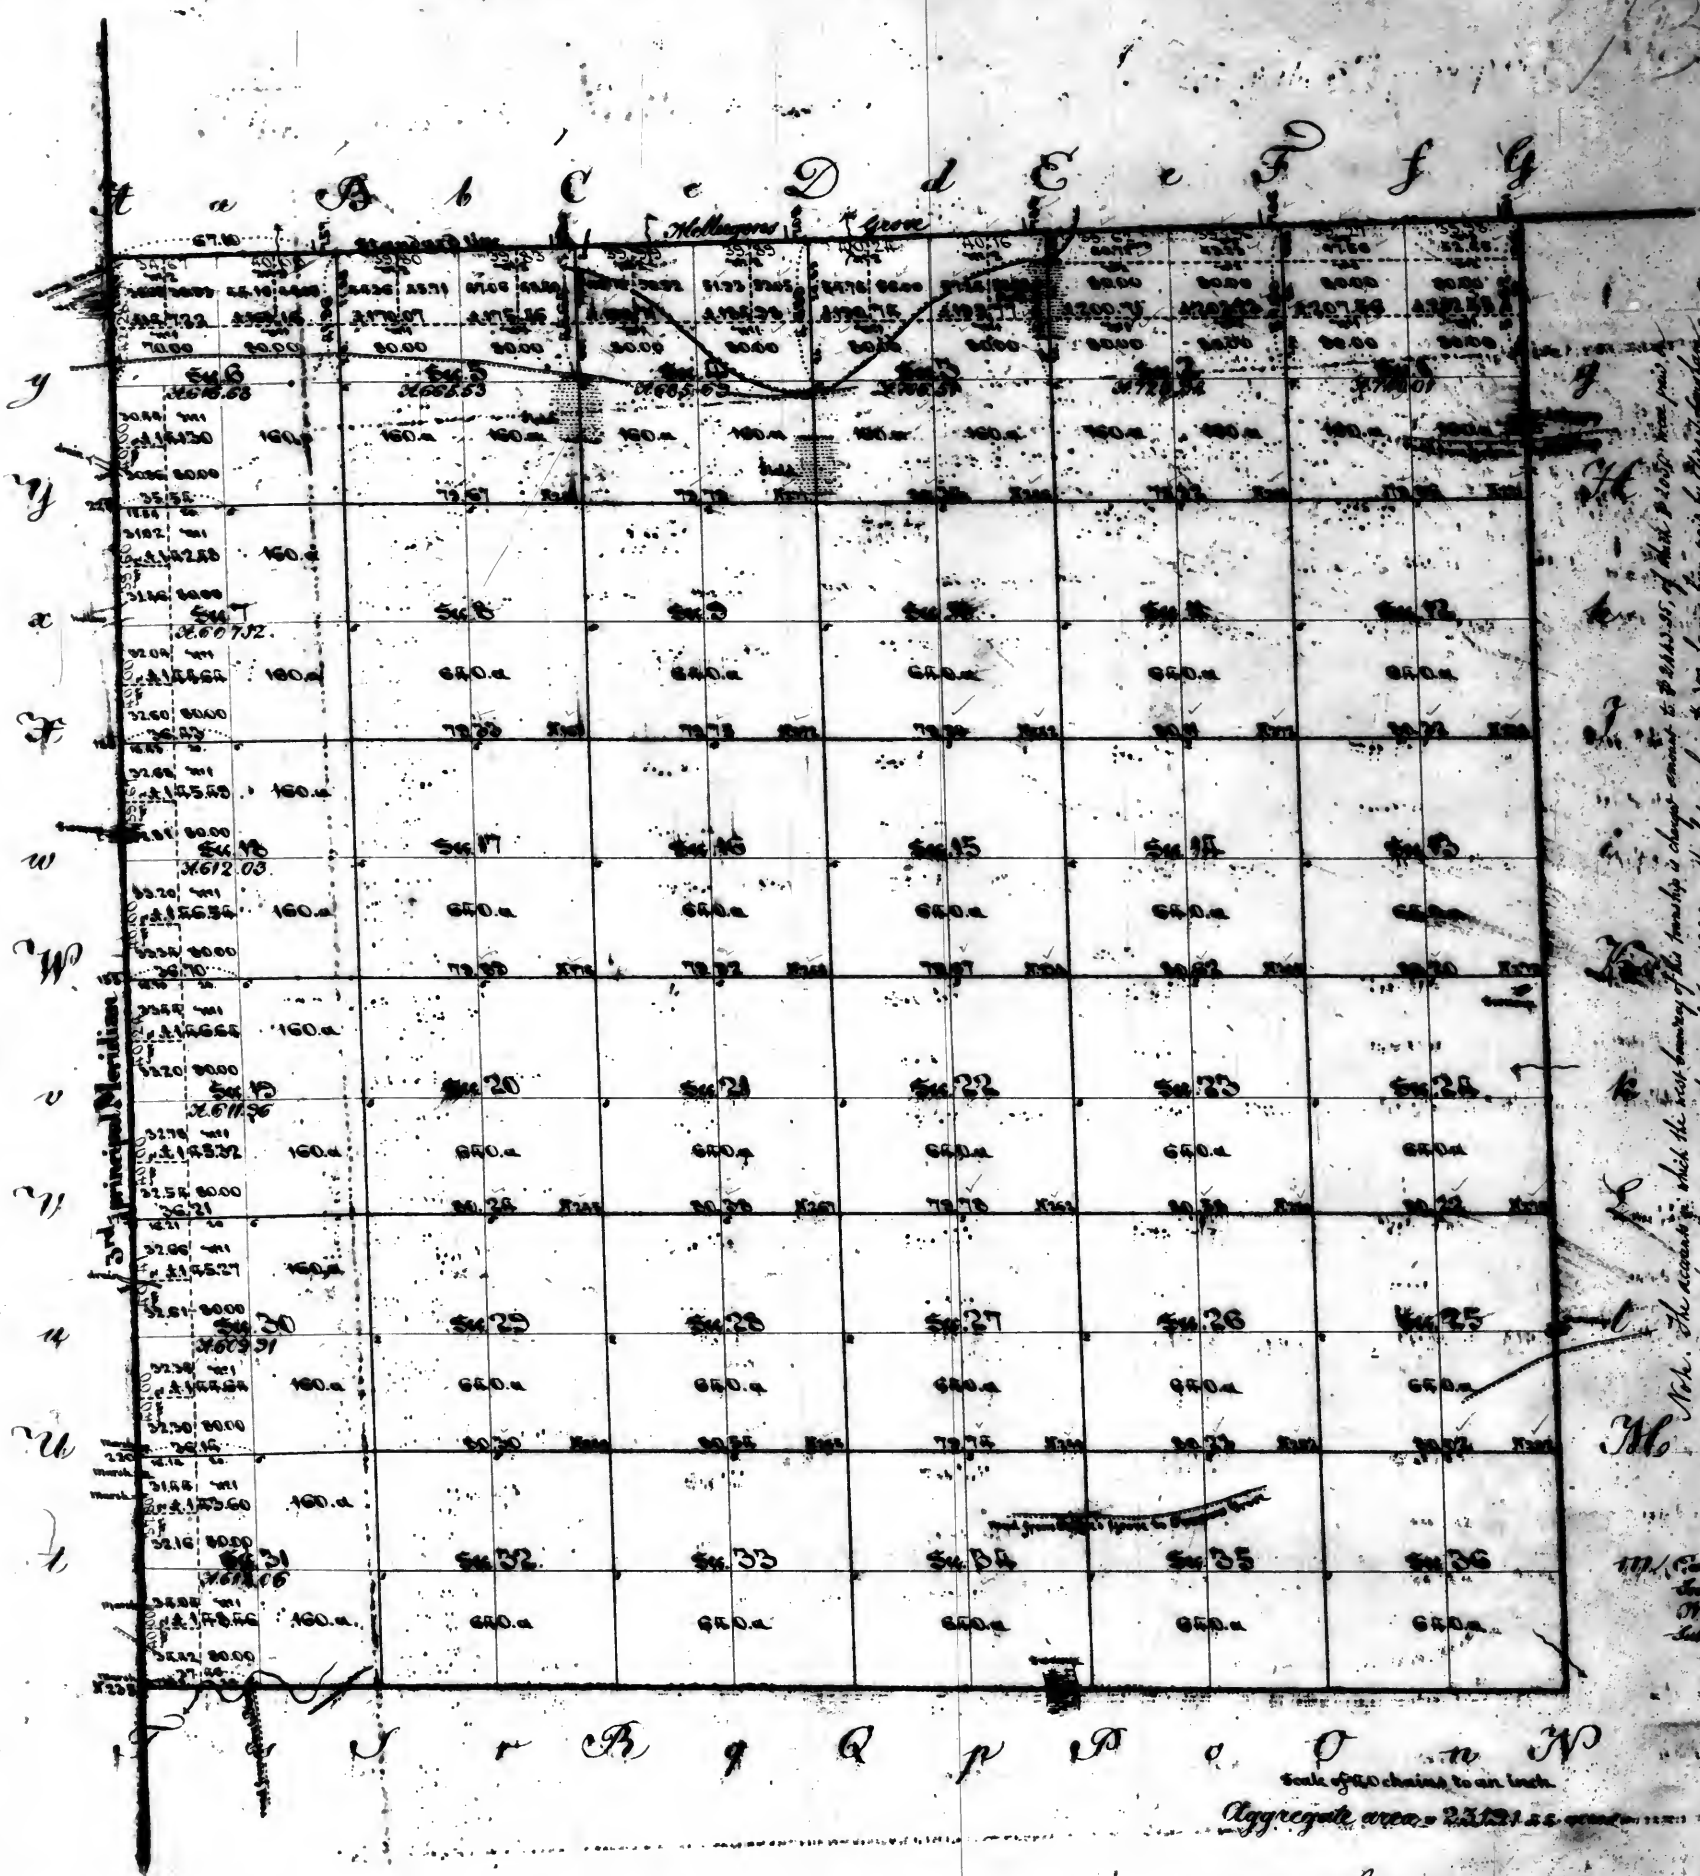



| Lines designated | By whom surveyed | Date of Contract | Amount of surveying miles chains & links | When executed | When paid for | No of vouchers in Sur. Genl. Account | Remarks. |
|-------------------|------------------|----------------------------------|--|--|-------------------------------|--|----------|
| West boundary. | B. A. Spaulding | 9 th June 1835 | 6. 00. 00 | 4 th q ^r of 1835 | 29 th July 1837 | 6 of 3 rd q ^r 1837 | |
| East boundary. | E. S. Prescott | contract signed by Sur. Genl. | 6. 10. 62 | 4 th q ^r of 1837 | 20 th June 1839 | 7 of 2 nd q ^r 1839 | See note |
| South boundary. | do | 2 nd May, 1837 | 5. 67. 10 | 4 th q ^r of 1837 | 3 rd December 1838 | 5 of 4 th q ^r 1838 | |
| South boundary. | do | 2 nd June 1837 | 5. 77. 40 | 2 nd q ^r of 1838 | do | do | |
| Subdivision lines | G. B. Walker | 20 th of October 1842 | 60. 17. 00 | 4 th q ^r of 1842 | 20 th May 1843 | 5 of 2 nd q ^r 1843 | |

Surveyors Office.
Saint Louis 30th of May, 1843.
The above plat of township 37 North of the base line, range East of the 3rd principal meridian, is hereby confirmed to the field notes of the survey thereof on file in this office which have been examined and approved.
Silas Reed
Surveyor of the public lands in the State of Illinois and Missouri.

Township 38 North of the base line Range 1 East of the 3^d principal Meridian

14

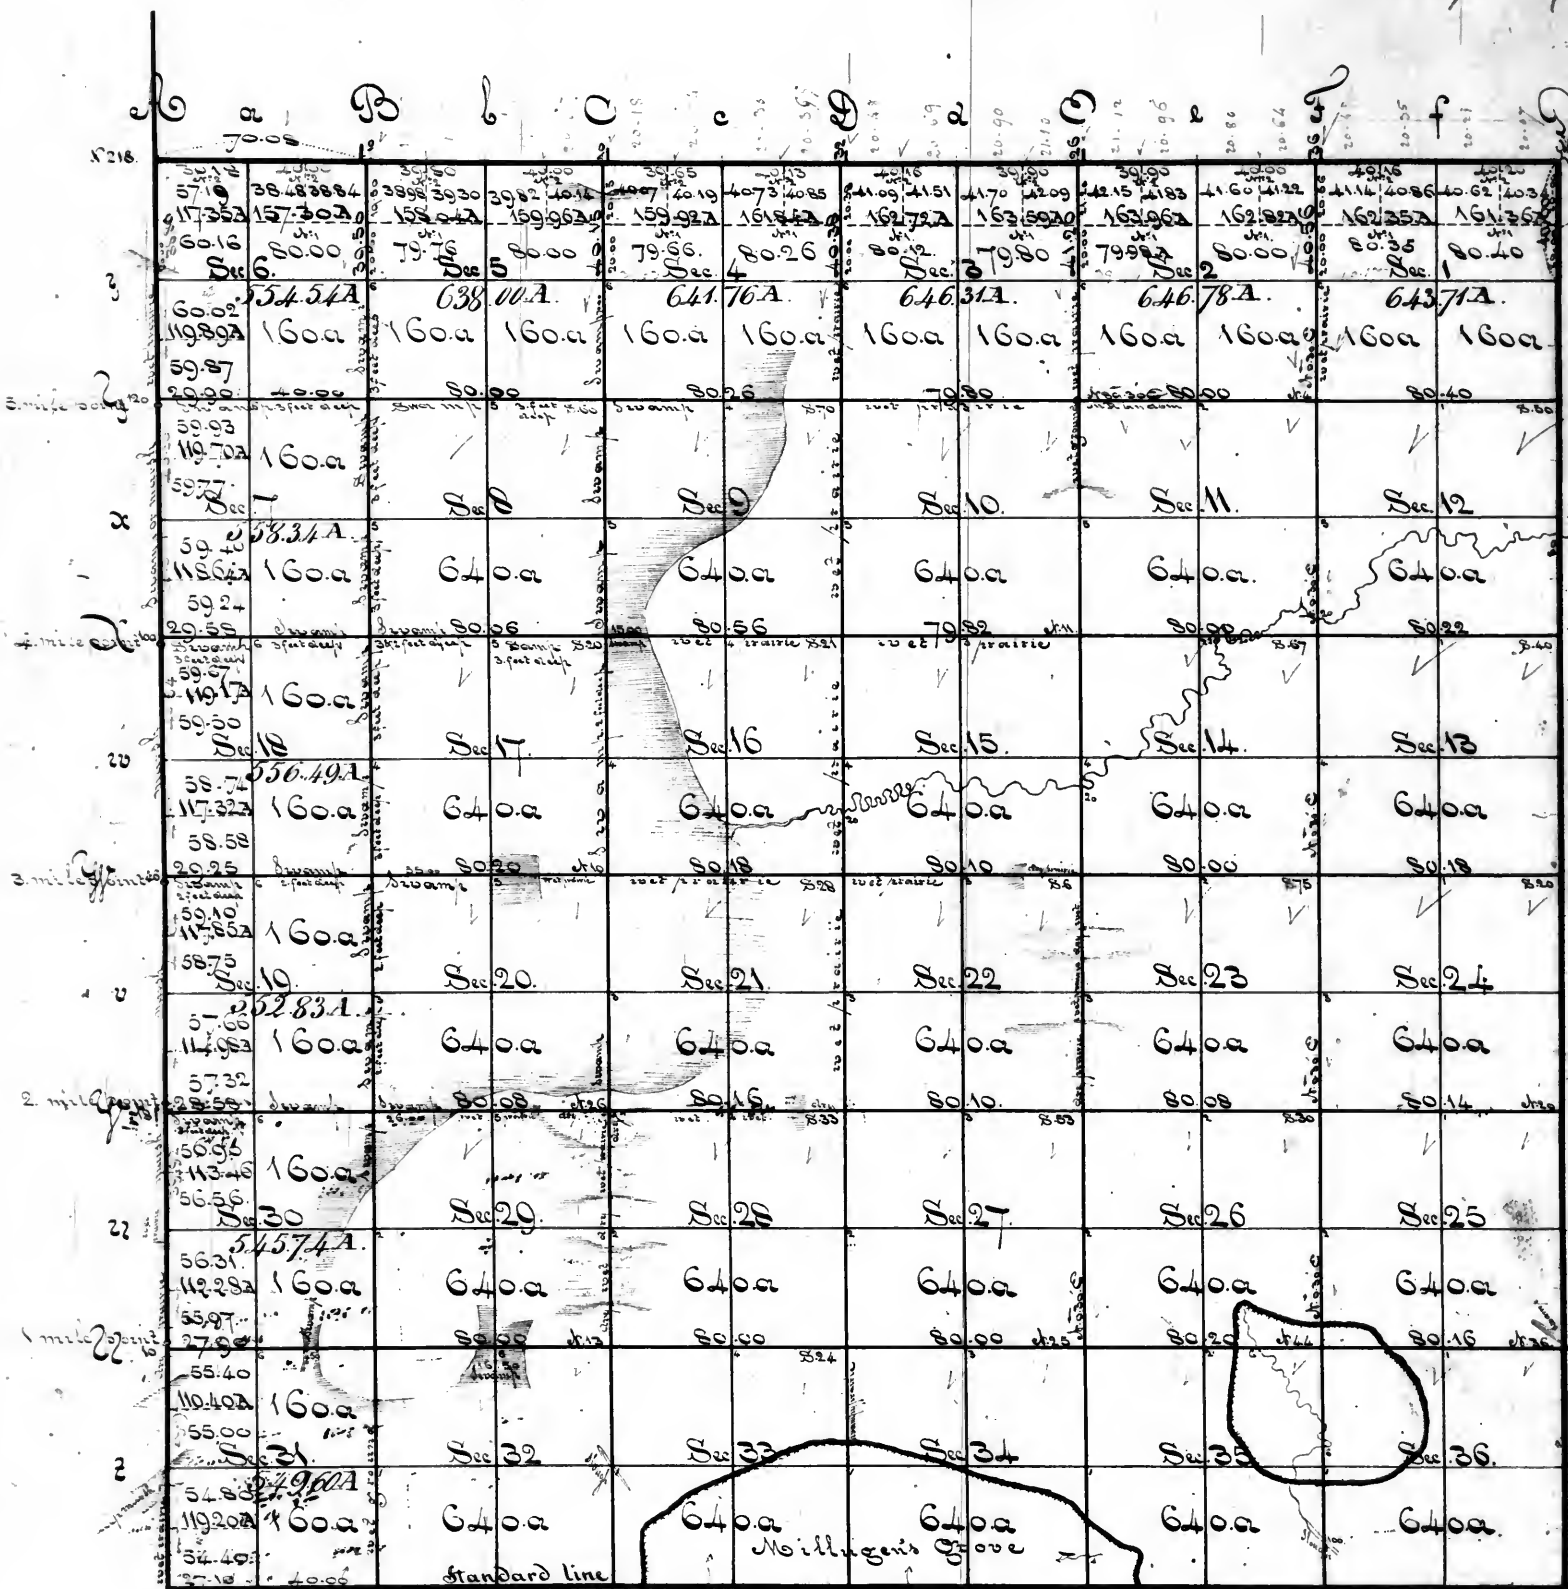

Notes: the accounts in which the surveying of the west boundary of this township is charged amount to \$2,253.10, of which \$1,000.00 was paid on the 20th of July 1837 - and \$1,253.10 on the 20th of June 1839 - The balance being \$253.10, being paid by the J. Langdon's former chargee General - the voucher of the Surveyor General's account for the 3^d quarter of 1837, and voucher of the account for the 3^d quarter of 1839.


Variation: *North*
South boundary according to the statement of Prescott - 7° 52' East
South boundary according to Spaulding - 7° 10' East
West boundary according to Prescott - 7° 10' East
West boundary according to Spaulding - 7° 10' East
all the other lines 7° 10' East

Scale of 40 chains to one inch
Aggregate Area 22534.10 acres

Survey Office, Saint Louis 14th of December 1841.
The above plat of township 38 north of the base line, range 1 east of the 3^d principal meridian, is strictly conformable to the field notes of the survey thereof on file in this office, which have been examined and approved. The west boundary 6 miles, was surveyed in the 4th quarter of 1835, by Ben Alonzo Spaulding, under contract of the 3^d of June of that year: - and with the limitation noted in the margin, it was paid for in the 3^d quarter of 1837, and 2^d quarter of 1839, and charged in the accounts of the Surveyor General for those quarters, Vouchers A⁶ & 7 - The south boundary 5 miles 57.10 chains, was surveyed in the 4th quarter of 1837, by Eli S. Prescott, under contract signed by the Surveyor General on the 8th of May, and by Mr. Prescott on the 3rd of June 1837 - It was paid for in the 4th quarter of 1838, and charged in the account current of the Surveyor General for that quarter, voucher A⁵ - The east boundary 6 miles, and the north boundary 5 miles 50.08 chains were surveyed in the 3^d quarter of 1838, by B. A. Spaulding, under contract signed by the Surveyor General on the 20th of September 1837, and by Mr. Spaulding on the 14th May 1838 - They were paid for in the 2^d quarter of 1839, and charged in the account of the Surveyor General for that quarter Voucher A⁸ - and the subdivision lines 59 miles 28.70 chains, were surveyed in the 4th quarter of 1840, by B. A. Spaulding, under contract of the 1st of September of that year - They were paid for in this 4th quarter of 1841; and they will be charged in the account current of the Surveyor General, during the same quarter, under the general appropriation for surveying the public lands, Voucher A¹³.

Jos. C. Brown
Surveyor of the public lands for
the district of Missouri.

Township 39 North of the baseline Range 1 East of the 3^d principal Meridian.

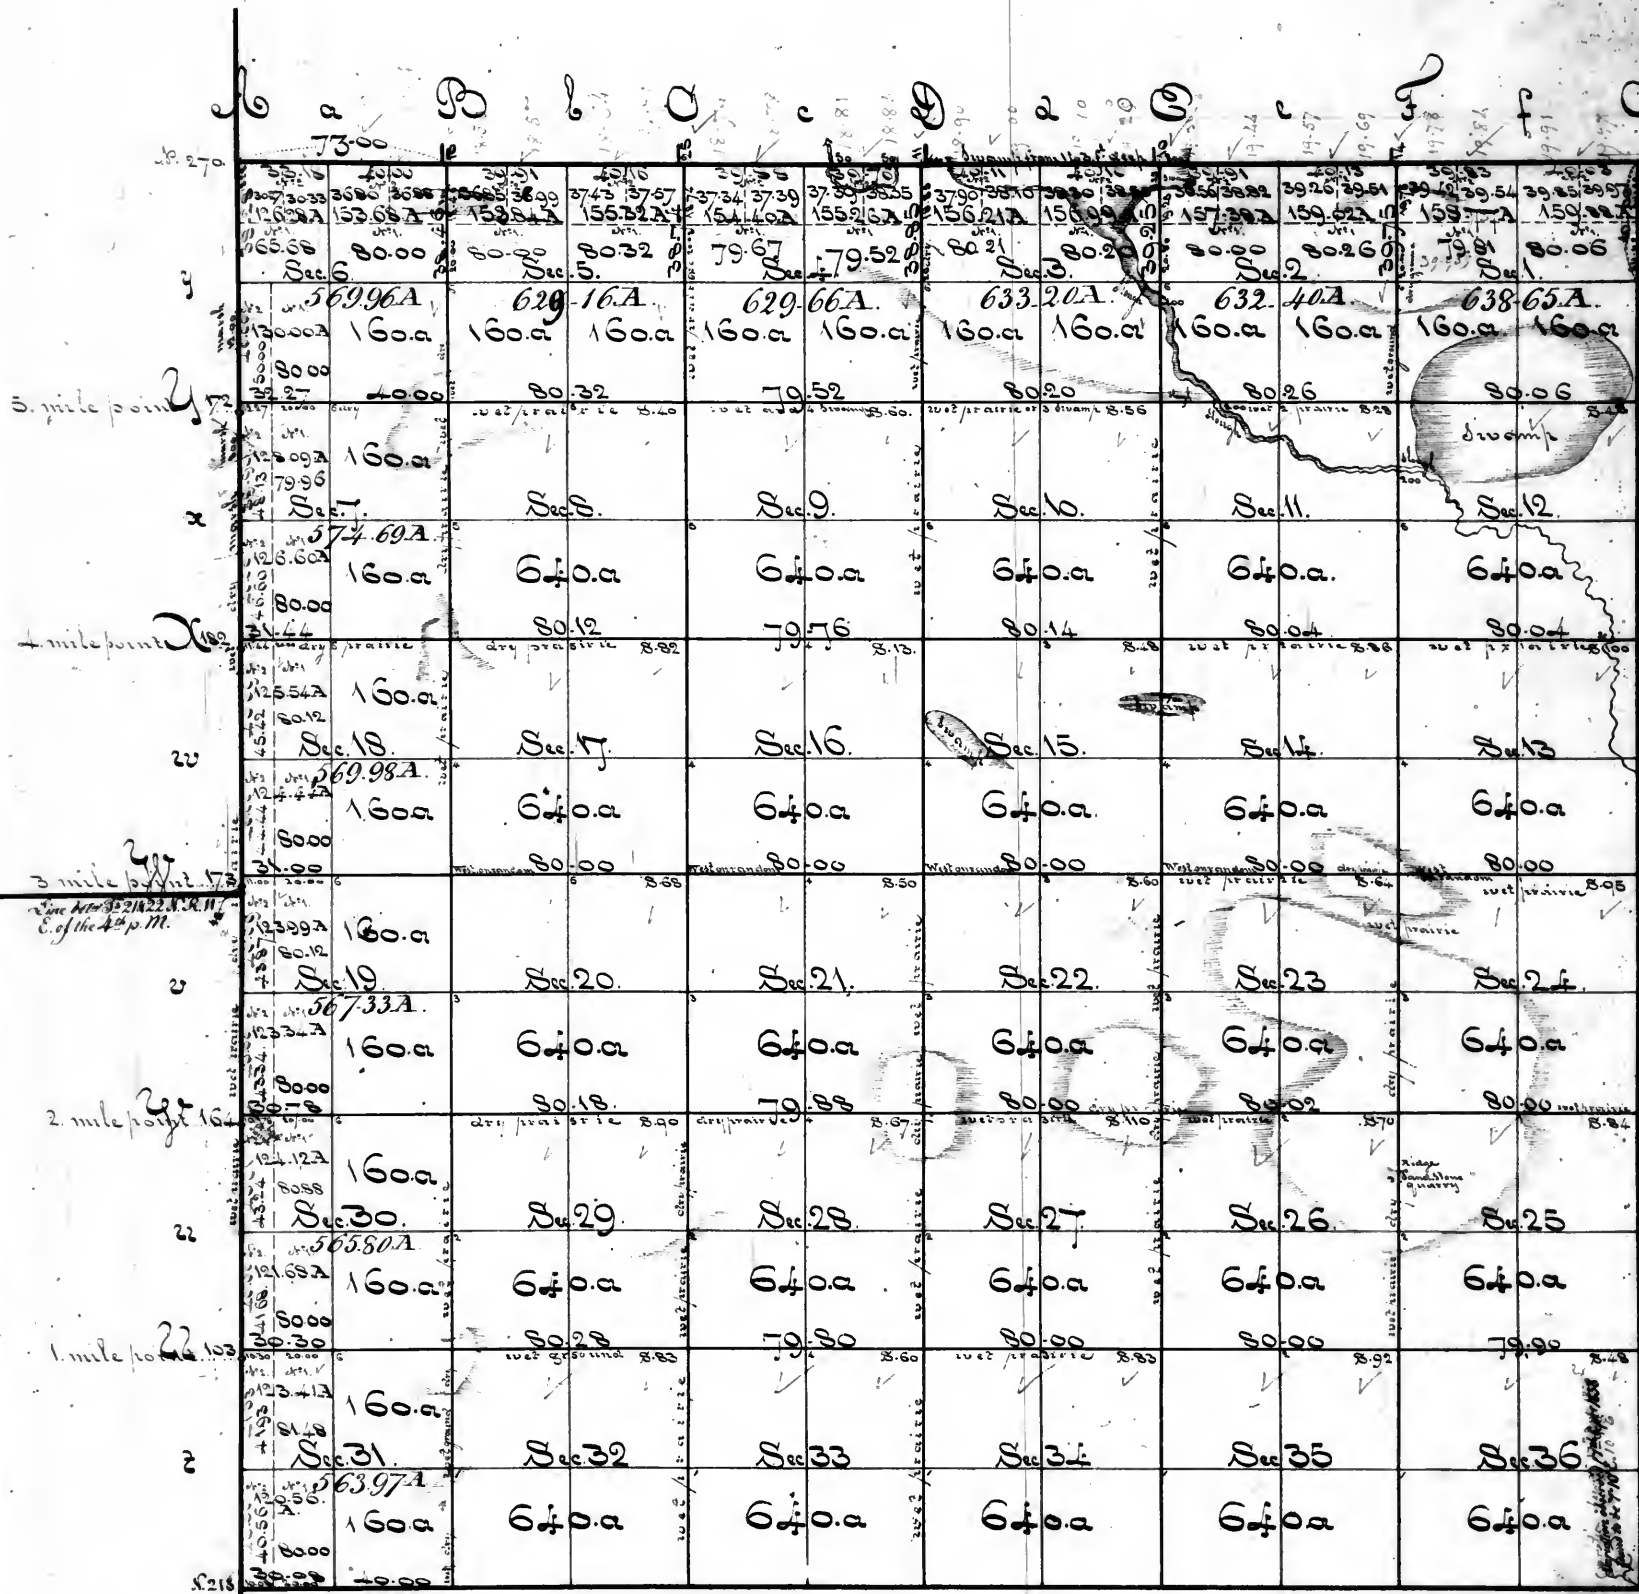

15

3 mile point
4 mile point
Variations, ration
West boundary - 7.57 East
all the other lines 7.10 East
all the other lines

Surveyors Office. Saint Louis 14th of December 1841.


Scale of 40 chains to one inch
Aggregate Area 22574.80 acres.

The above plat of township 39 north of the base line, range 1 east of the 3^d principal meridian is truly conformable to the field notes of the survey thereof on file in this office, which have been examined and approved. The west boundary was surveyed in the 4th quarter of 1835, by John A. Spaulding, under contract of the 9th of June of that year; and with the limitation noted in the margin, it was paid for in the 3^d quarter of 1837 and 2^d quarter of 1839, and charged in the accounts of the Surveyors General for these quarters. Voucher N^o 647 - The south boundary 5 miles 70.08 chains - the east boundary 6 miles; the north boundary 5 miles and seventy-three chains, were surveyed in the 3^d quarter of 1838, by John A. Spaulding, under contract signed by the Surveyor General on the 20th of September 1837, and by M. Spaulding on the 14th May 1838 - They were paid for in the 2^d quarter of 1839, and charged in the account of the Surveyor General for that quarter, Voucher N^o 8 - The subdivision lines 53 miles 31.26 chains, were surveyed in the 4th quarter of 1840, by John A. Spaulding under contract of the 1st of September 1840 - They were paid for in this 4th quarter of 1841, and they will be charged in the account current of the Surveyor General, during the same quarter, under the general Surveying appropriation, Voucher N^o 13.

Jos. C. Brown
Surveyor of the public lands for

Township 40 North of the base line Range 1 East of the 3^d principal Meridian.

16

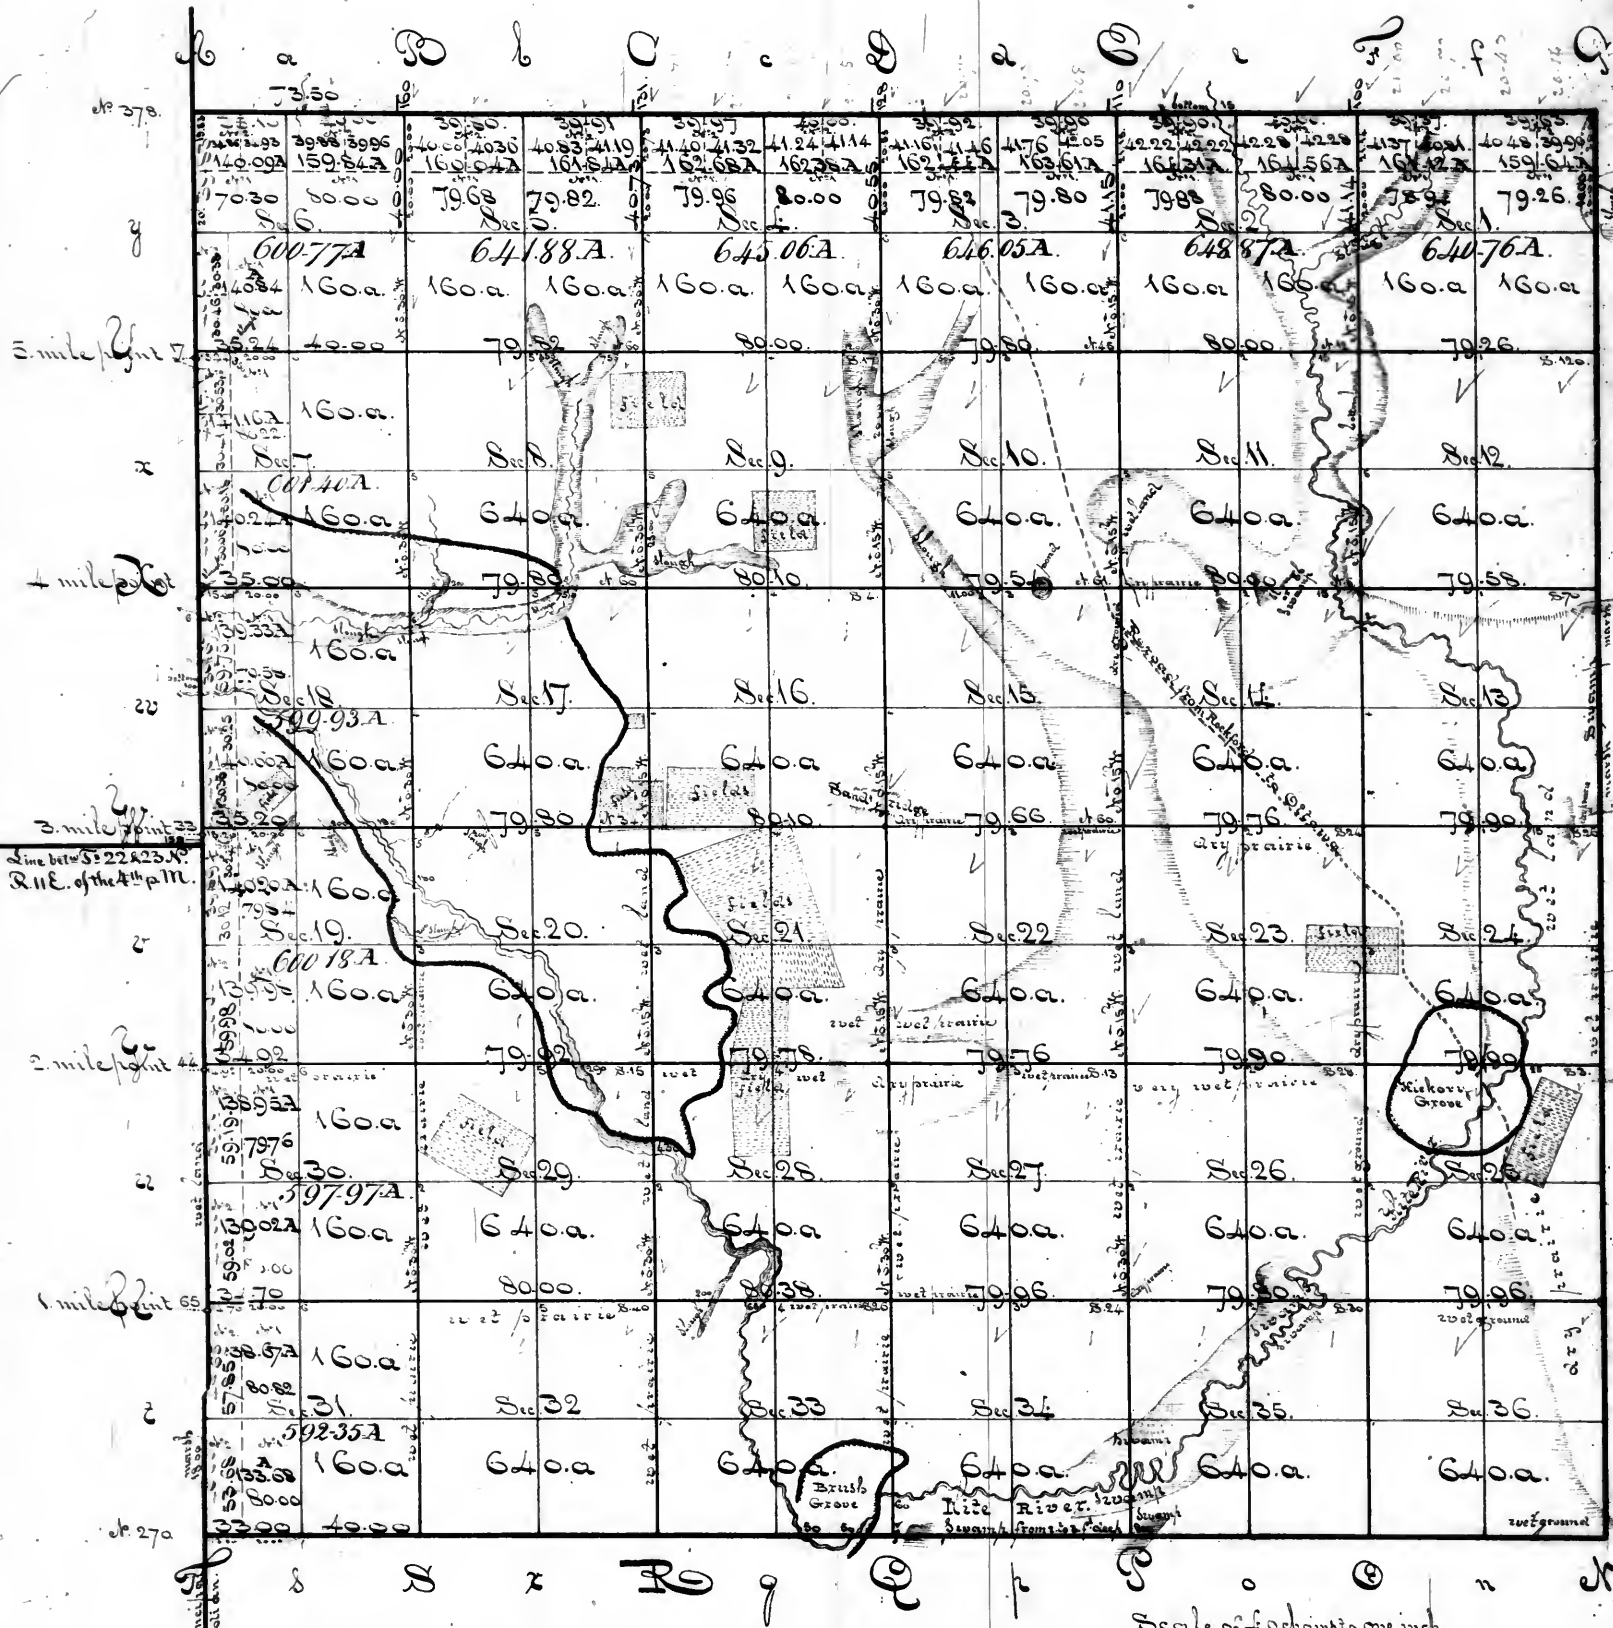

Notes. The accounts in which the surveying of this township is charged amount to \$2442.95 for which \$2000, were paid on the 29th of July 1837, and \$442.95 on the 20th of June 1839. The balance being \$500.00 having been paid by Elias J. Spaulding, former Surveyor General. See volume 106 of the Surveyor General's account for the 3^d of April 1837, and Volume 107 of the account for the 2^d of April 1839.

variation in West boundary 7° 51' 44" the other lines 7° 10' 44" Variation. West boundary 7° 51' East all the other lines 7° 10' East

Surveyor's Office. Saint Louis 14th December 1841.


Scale of 20 chains to one inch
Aggregate Area 22815.22 acres

The above plat of township 40 north of the base line, range 1 east of the 3^d principal meridian, is strictly conformable to the field notes of the survey thereof on file in this office which have been examined and approved. The west boundary 6 miles was surveyed in the 4th quarter of 1835, by D. A. Spaulding, under contract of the 3^d of June 1835, and with the limitation noted in the margin; it was paid for in the 3^d quarter of 1837, and 2^d quarter of 1839, and charged in the accounts of the Surveyor General for those quarters, Voucher 1067. The south boundary 5 miles 73.50 chains - the east boundary 6 miles - and the north boundary 5 miles 73.50 chains, were surveyed in the 3^d quarter of 1838, by D. A. Spaulding, under contract signed by the Surveyor General on the 20th of September 1837, and by W. A. Spaulding on the 14th of May 1838 - They were paid for in the 3^d quarter of 1839, and charged in the account current of the Surveyor General, during the same quarter, Voucher 1088. The subdivision lines 59 miles 55.11 chains, were surveyed in the 4th quarter of 1840, by D. A. Spaulding, under contract of the 1st of September 1840 - They were paid for in this 4th of 1841; and they will be charged in the account current of the Surveyor General during the same quarter, under the general appropriation for surveying the public lands, Voucher 1012.

Jos C. Brown
Surveyor of the public lands for

Township 41 North of the base line Range 1 East of the 3rd principal Meridian

17

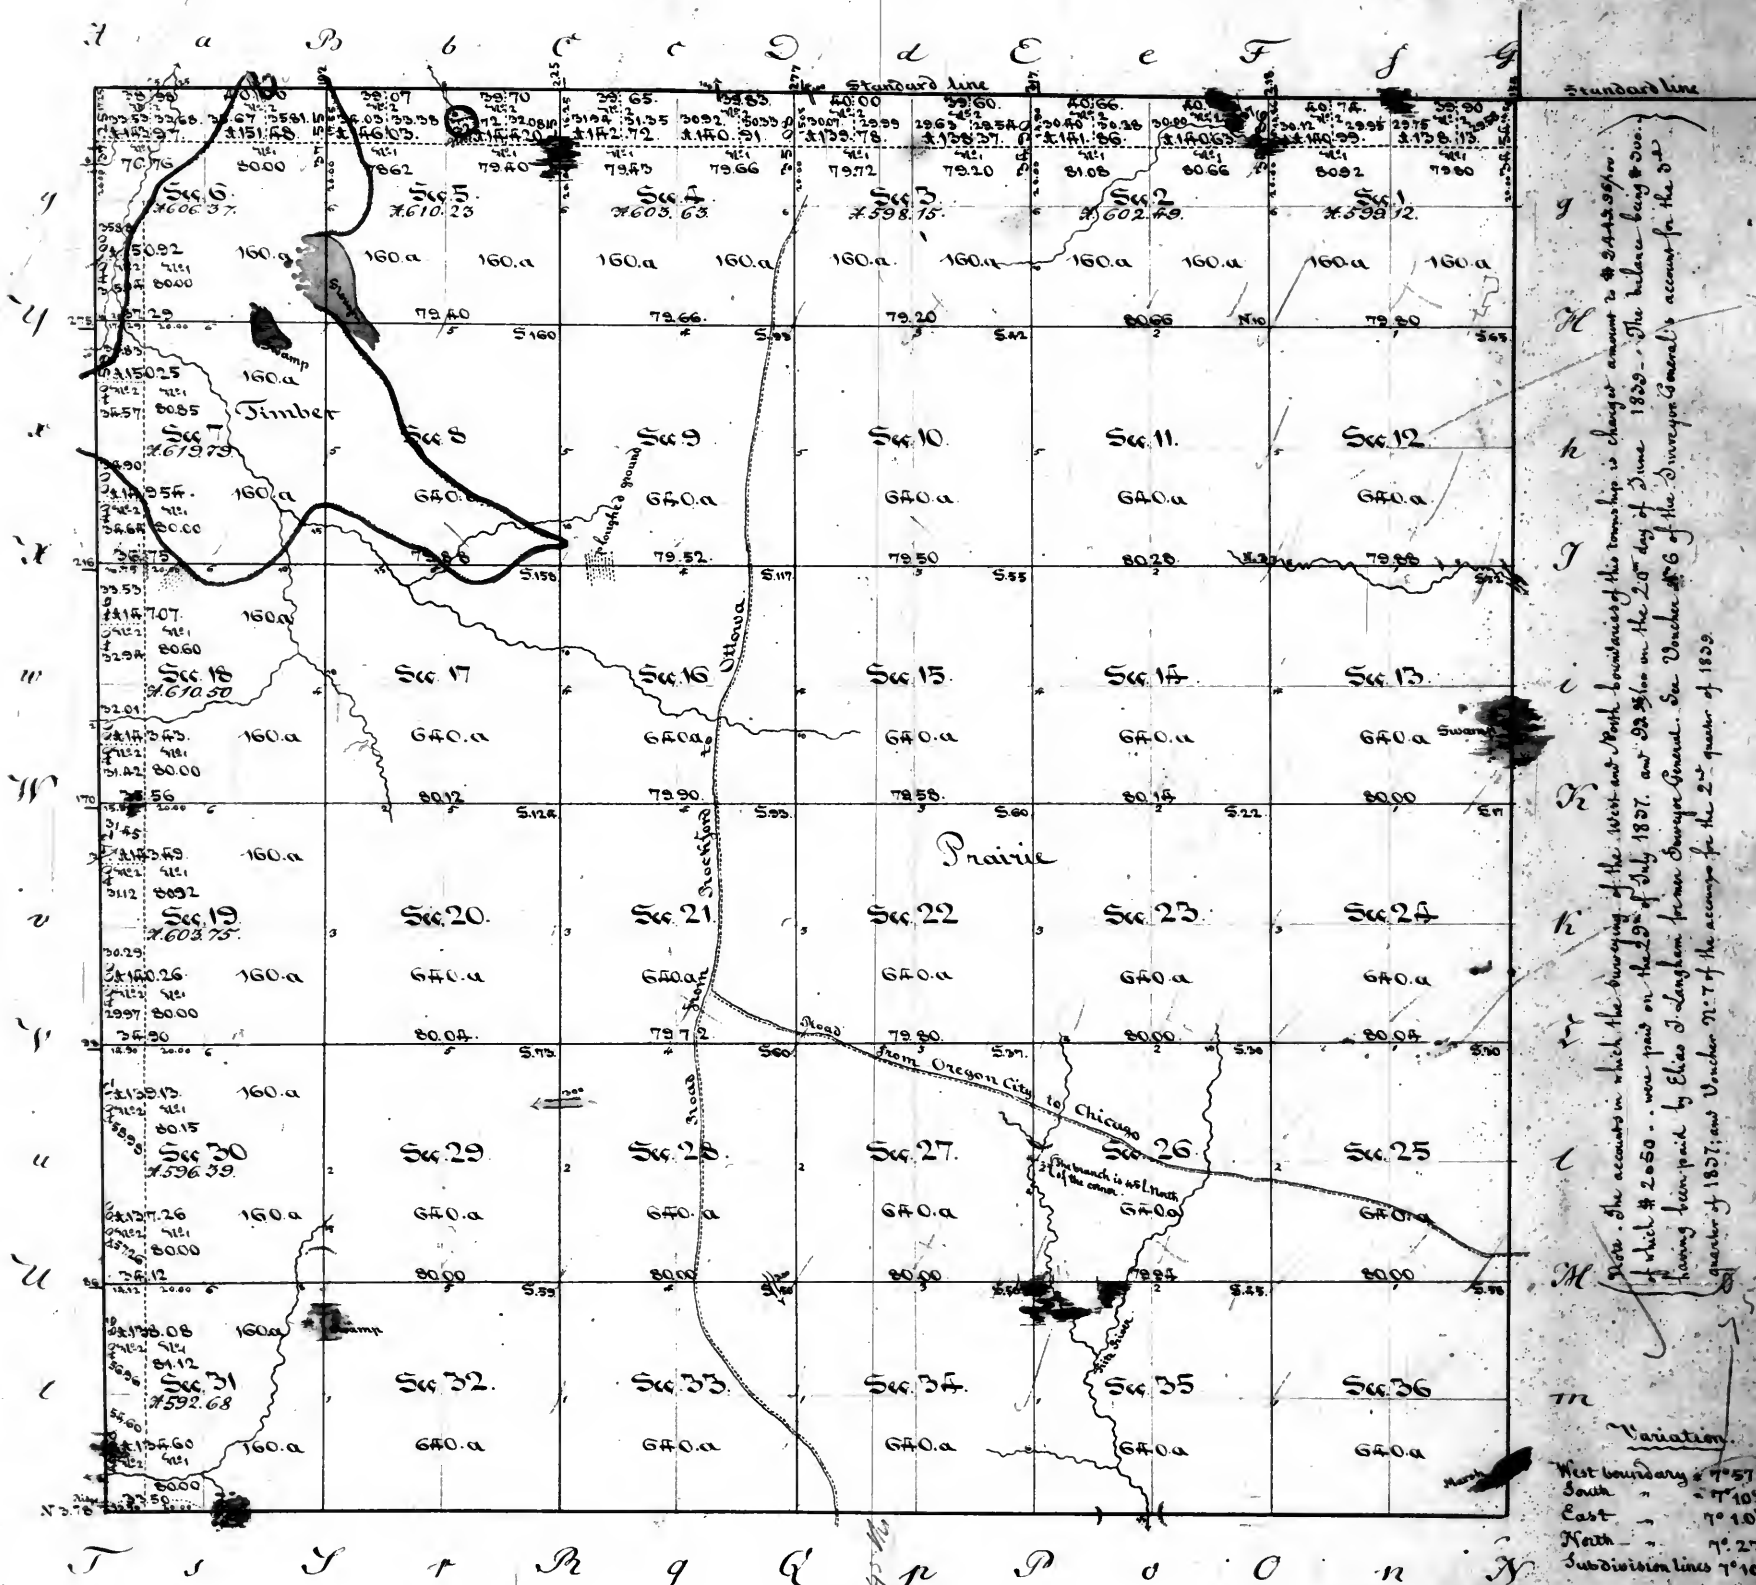

Surveyors Office.
Saint Louis 1st of July 1839.


Scale of 40 chains to an inch.
Aggregate area = 22643.10 acres.

The above plat of Township 41 North of the base line range 1 East of the 3rd principal meridian is strictly conformable to the field notes of the survey thereof on file in this office which have been examined and approved. — The west boundary 6 miles and the north boundary 5 miles 78.46 chains were surveyed in the 4th quarter of 1835 by Don Alonzo Spaulding, under contract of the 9th of June 1835, and with the limitation notes in the margin were paid for in the 2^d quarter of 1837 and 2^d quarter of 1839, and charged in the account of the Surveyor General for those quarters vouchers No. 6 and 7. — The South boundary 5 miles 72.50 chains — and the east boundary 5 miles 74.54 chains, were surveyed in the 3^d quarter of 1838 and the subdivision lines 59 miles 24.32 chains were surveyed in the 3rd & 4th quarters of 1838, all by Don Alonzo Spaulding, under contract signed by the Surveyor General on the 20th of September 1837, and by the said Spaulding on the 14th of May 1838. — They were paid for in the 2^d quarter of 1839 and charged in the account of the Surveyor General for that quarter Voucher No. 8.

William Milburn
Surveyor General

Township 42 North of the base line Range 1 East of the 3rd principal Meridian

18

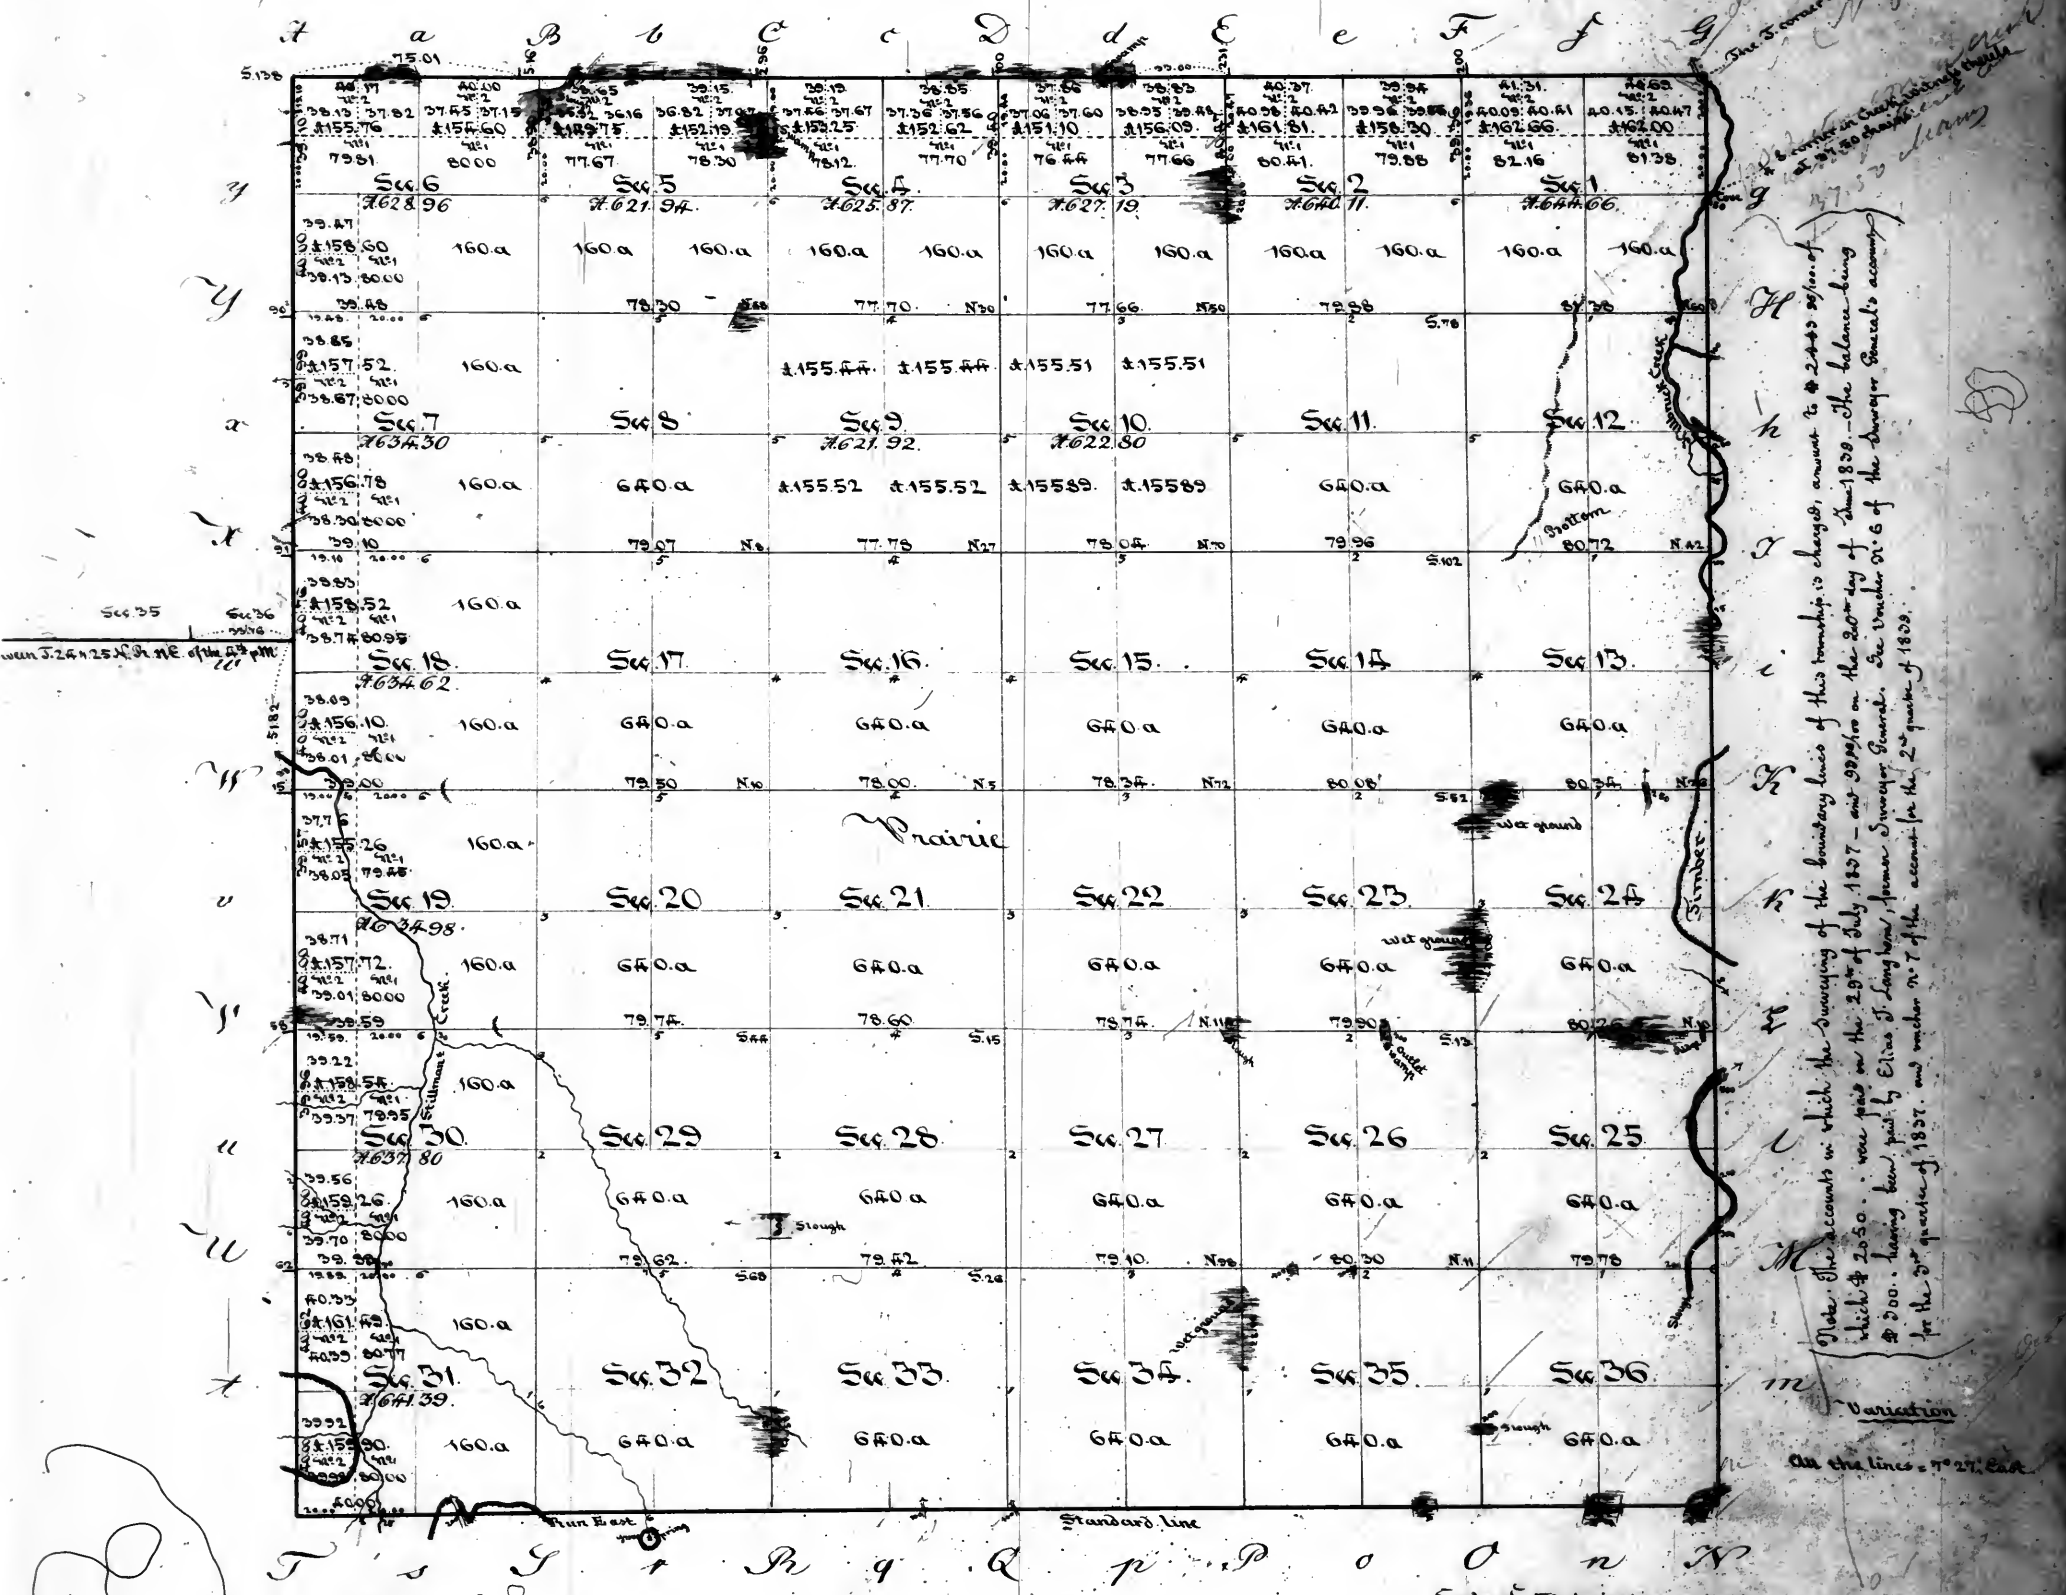


Surveyor General's Office.
Saint Louis 1st of July 1838.

Scale of 40 chains to an inch
Aggregate area = 22936.54 acres.

The above plat of Township 42 north of the base line range 1 east of the 3rd principal meridian is strictly conformable to the field notes of the survey thereof on file in this Office which have been examined and approved. - The west boundary 6 miles - The south boundary 6 miles - The east boundary 6 miles - and the North boundary 5 miles 75.01 chains, were surveyed in the 4th quarter of 1835 by Don Alongo Spaulding, under contract of the 9th of June 1835; and with the limitation noted in the margin, they were paid for in the 2nd quarter of 1837, and 2nd quarter of 1839 and charged in the accounts of the Surveyor General for those quarters Vouchers N^o 6 and 7 - The subdivision lines 3.9 miles 56.00 chains were surveyed in the 3rd quarter of 1838, by Don Alongo Spaulding, under contract signed by the Surveyor General on the 20th of September 1837, and by the said Spaulding on the 14th May 1838 - They were paid for in the 2nd quarter of 1839, and charged in the account of the Surveyor General for that quarter Voucher N^o 8.

William Milburn
Surveyor General

T 13 N R 1 E of the 3^d p^t M

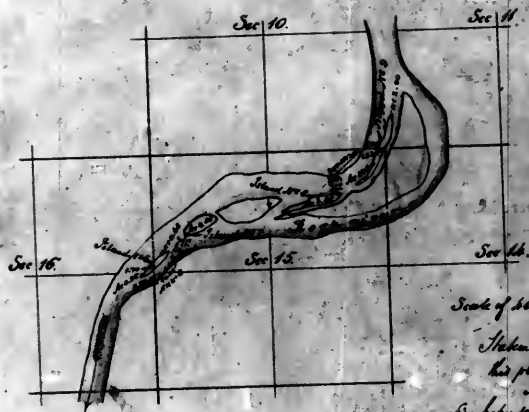

Scale of 50 chains to an inch.

Statement referred to in the last page to this plot.

In island No 6.

Gravel sections 15 & 16.

In island No 7.

Connecting lines

sections.

In island No 8.

Connecting lines

sections.

In island No 9.

Area between sections 10 & 15.

sections.

Surveyor's Office.

Saint Louis 28 April 1848.

The above plot of islands Nos 6, 7, 8 & 9, on Rock River, in Township 13 S north of the base line, range 1 East of the 7th principal meridian, is strictly conformable to the field notes of the surveyor Henry C. Smith, which have been examined and approved by me. They were surveyed in December 1847, and March 1848, by Solomon Parker, and are correct in all respects. The surveying herein, is detailed in the marginal statement. It was paid for on the 1st March 1848, and charged to the United States, in Voucher No 2, of the account of the Surveyor General, being the 1st quarter of 1848, under the appropriation of \$1200, of March 1845, for the correction of erroneous and defective surveys. See page 65 of acts of 2d session of 28 Congress.

Surveyor of the public land in the State of Missouri & Wisconsin.

A copy of this plot was sent to the Commissioner of the General Land Office on the 28 of April 1848.

7.42
38.55
55.97

19.72
32.63
52.41

19.31
44.62
63.93

7.12
56.69
63.81


Township N^o 43 North of the Base line in Range N^o 1 East of the 3^d principal Meridian.

Surveyor's Office. Saint Louis 26th December 1840.

Four islands and the part of another island in Rock river in Township 43 north range 1 east, have this day been laid down on this plat, strictly conformable to the field notes of the survey of said islands, on file in this office, which have been examined and approved:— They are situated as follows:— N^o 1 in sections 10 & 11:— N^o 2 in sections 11, 14 & 15:— N^o 3 in section 15:— N^o 4 in sections 20 & 21:— and the part of N^o 5, in section 18:— They were surveyed in the 4th quarter of 1839, and the 1st quarter of 1840, by G. A. Spaulding, under contract of the 9th of June 1835; the surveying and the lines to connect with the surveys on the main shore amount to 6 miles 1.08 chains, which were paid for in the 3^d quarter of 1840, and charged in the account current of the Surveyor General for that quarter, Voucher N^o 44.

William Milburn
Surveyor of the public lands in
the States of Illinois & Missouri.

Islands 1 to 4, & part of
Edw. Carr
Edw. Carr

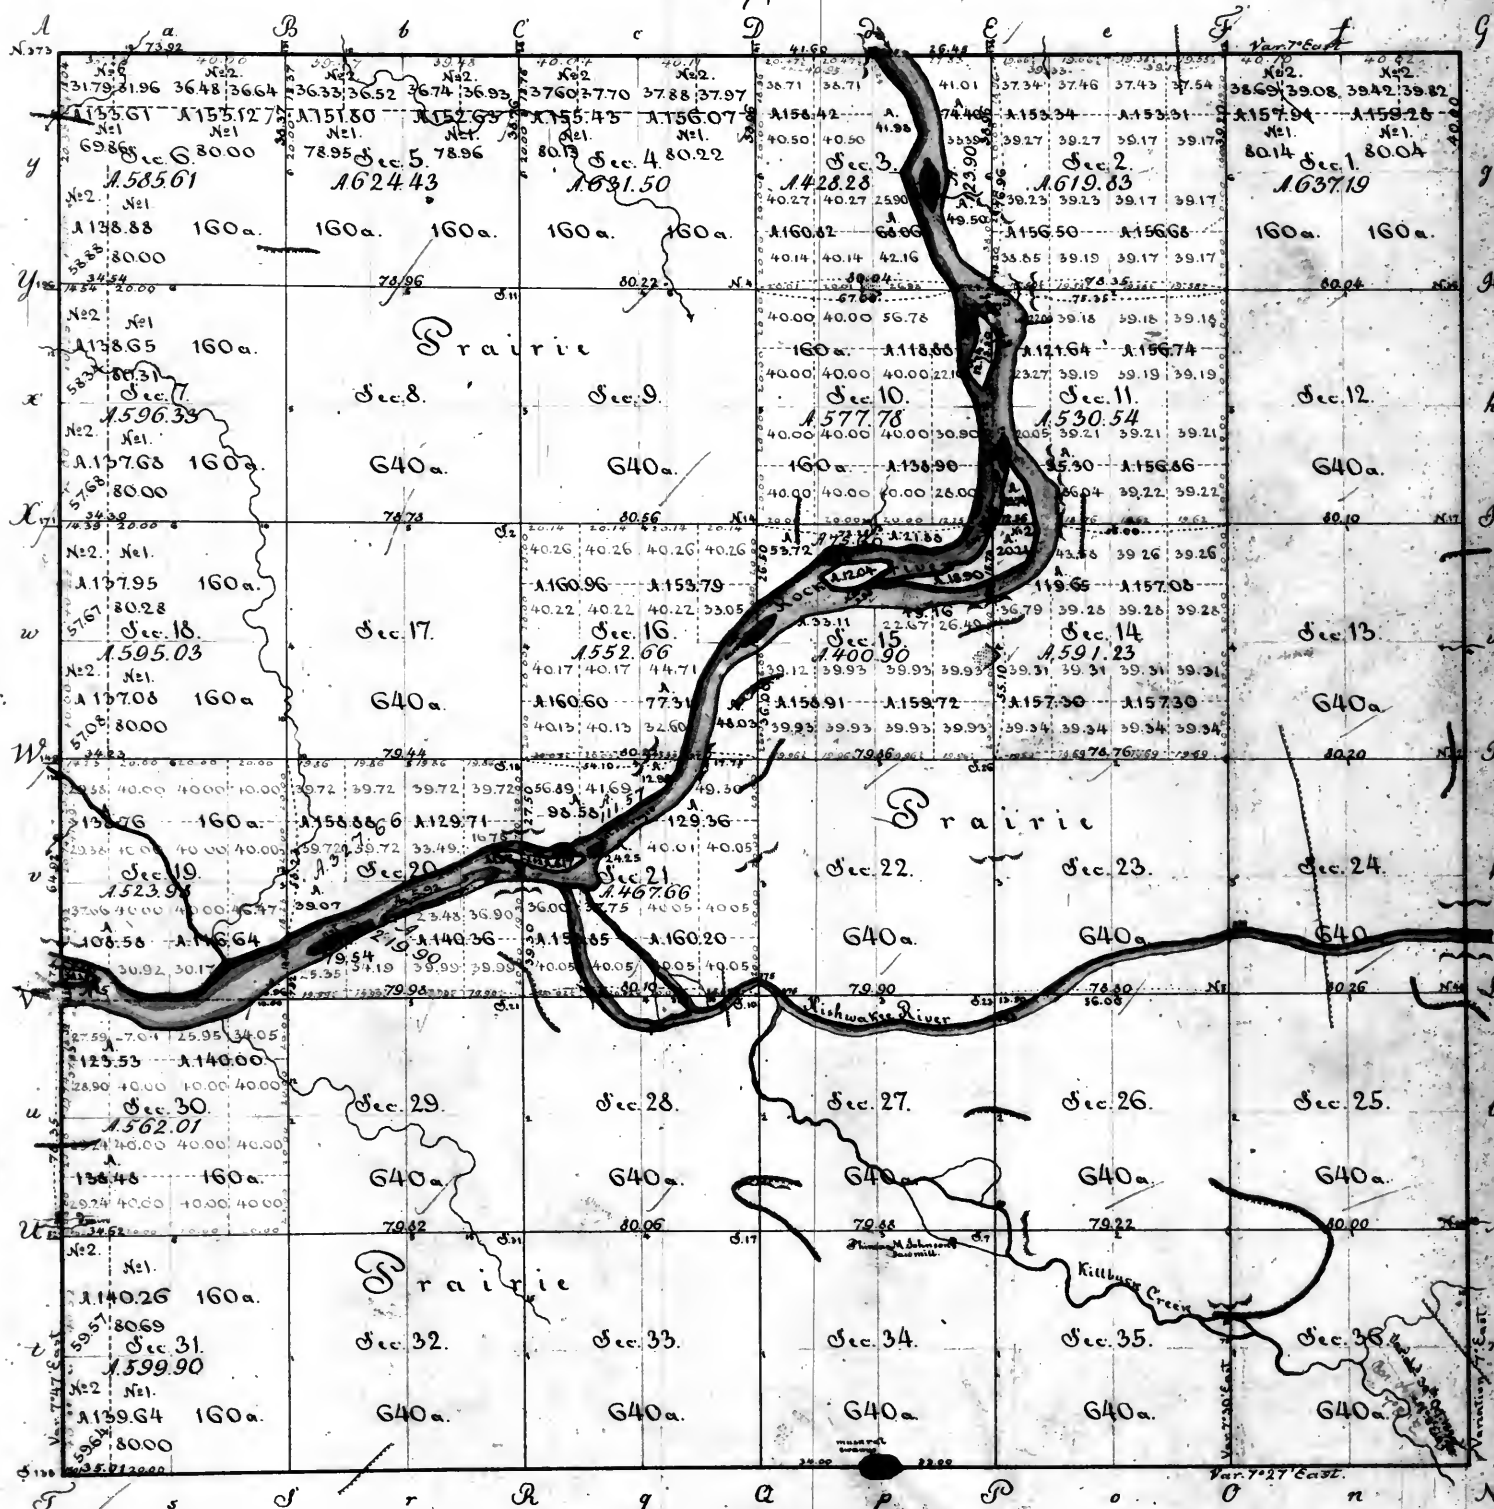

Note:— the accounts in which the surveying of this township is charged amount to \$ 2452.95, of which \$ 2050. were paid on the 20th of July 1837, and \$ 95.95 on the 20th day of June 1839;— the balance being \$ 306.95: having been paid by Elias T. Langham, former Surveyor General:— See Voucher N^o 7 of account for the 2^d quarter of 1839.
1 July 1839
William Milburn
Surveyor General

Surveyor's Office
Saint Louis 1st of July 1839.

Scale of 40 chains to one inch.
Area 21945.43 acres of land on the main shore.

The above plat of Township 43 north of the base line range 1 east of the 3^d principal meridian, is strictly conformable to the field notes of the survey thereof on file in this office which have been examined and approved:— The west and east boundaries 6 miles each— the South boundary 5 miles 75.01 chains— The North boundary 5 miles 73.93 chains, were surveyed in the 4th quarter of 1835— and the subdivision lines 56 miles 57.53 chains, and the meanders of Rock river 14 miles 32.61 chains, were surveyed in the 4th quarter of 1836, — all by Don Alvaro Spaulding under contract of the 9th of June 1835— and with the limitation noted in the margin they were paid for in the 3^d quarter of 1837, and 2^d quarter of 1839— and charged in the accounts of the Surveyor General for those quarters— Vouchers N^o 6 and 7.


William Milburn
Surveyor General

Area of land on main shore 21945.43 acres
area of the surveyed islands 89.84 acres
estimated area of Rock river 741.00 acres
aggregate area of Township 22776.27 acres

Section 15:— N^o 3 in section 15:— N^o 4 in sections 20 & 21:— and the part of N^o 5, in section 18:— They were surveyed in the 4th quarter of 1839, and the 1st quarter of 1840, by G. A. Spaulding, under contract of the 9th of June 1835; the surveying and the lines to connect with the surveys on the main shore amount to 6 miles 1.08 chains, which were paid for in the 3^d quarter of 1840, and charged in the account current of the Surveyor General for that quarter, Voucher N^o 44.

17 Nov. 1840.
Part of island in Sec. 20
sent to Comr. & Register.

Township 44 North of the base line Range 1 East of 3^d principal Meridian

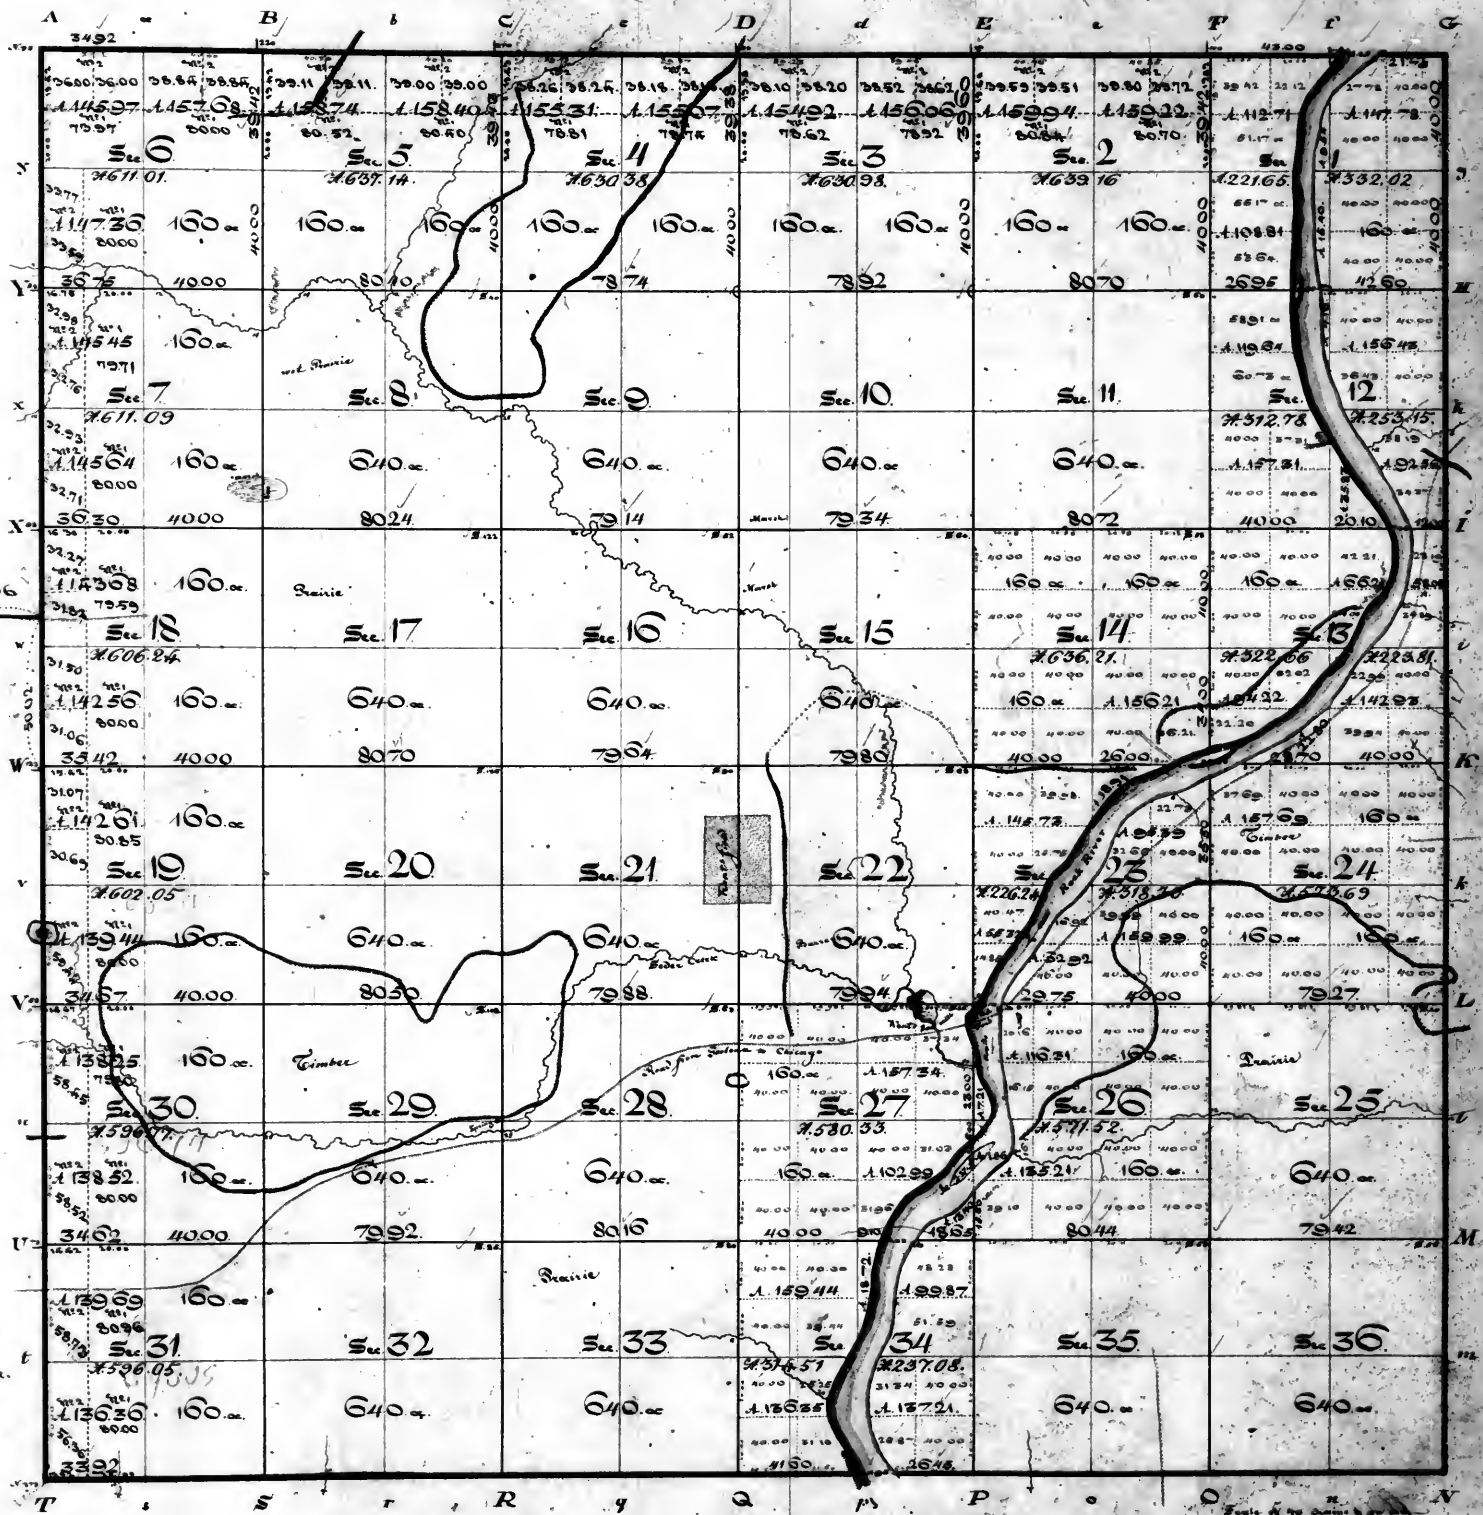

N. & N.E. of 4th p. m.
Sec 35

26 N. & N.E. of 4th p. m.
Sec 36

17 Nov. 1845.

Plat of island in Sec.
26 & 27 sent to the
Comm'r & Register.

Surveyor's Office
St. Louis 2^d Jan. 1846
Plat of the N.E. of Sec. 23
(N. & N.E. of river) sent this day to the
Commissioner of the Gen'l S. Office.

Note - The accounts in which the surveying of this township is charged amount to \$2443.05, of which \$2000.00 was paid on the 29th of July 1837, and \$443.05 on the 25th day of June 1839 - The balance being \$400.00, having been paid by Charles L. Ferguson from the Surveyor General - See voucher No. 6 of the Surveyor General's account for the 3^d quarter of 1837, and voucher No. 7 of the account for the 2^d quarter of 1839.

Surveyor's Office. Saint Louis 1st of July 1839.

The above plat of township 44 north of the base line, range 1 east of the 3^d principal meridian is strictly conformable to the field notes of the survey thereof on file in this office, which have been examined and approved - The west and east boundaries, 6 miles each, the South boundary 5 miles 73.92 chains - the north boundary 5 miles 74.92 chains - the subdivision lines 58 miles 68.33 chains - and the meanders of Rock river 10 miles 53.22 chains, were surveyed in the 4th quarter of 1835, by Don Adams Spaulding, under contract of the 9th of June 1835 - and with the limitation noted in the margin they were paid for in the 2^d quarter of 1837 - and 2^d quarter of 1839 - and charged in the accounts of the Surveyor General for those quarters - Vouchers No. 6 and 7.

Aggregate Area 22187.45 ac.

Surveyor's Office. Saint Louis 17th of November 1845.


The island in sections 26 and 27, was this day laid down on the plat strictly conformable to the field notes of the survey thereof on file in this office, which have been examined and approved. It was surveyed in March 1845, by Duncan Ferguson, under his franchise of 25th January of the same year - The line from the Southern shore of the island, with to the corner to Sec. 26 & 27 on the north bank of Rock river, 10 chains - and the meanders around the island, 37.22 chs. will be paid for to Mr. Ferguson and charged in the account current of the Surveyor Genl, during the 4th q^r 1845, under the appropriation of 2^d March 1843, for surveying the public land.

J. R. Bowman
Surveyor General

William Milburn
Surveyor General

Township 45 North of the Base line in Range 1 East of the 3^d principal Meridian.

21

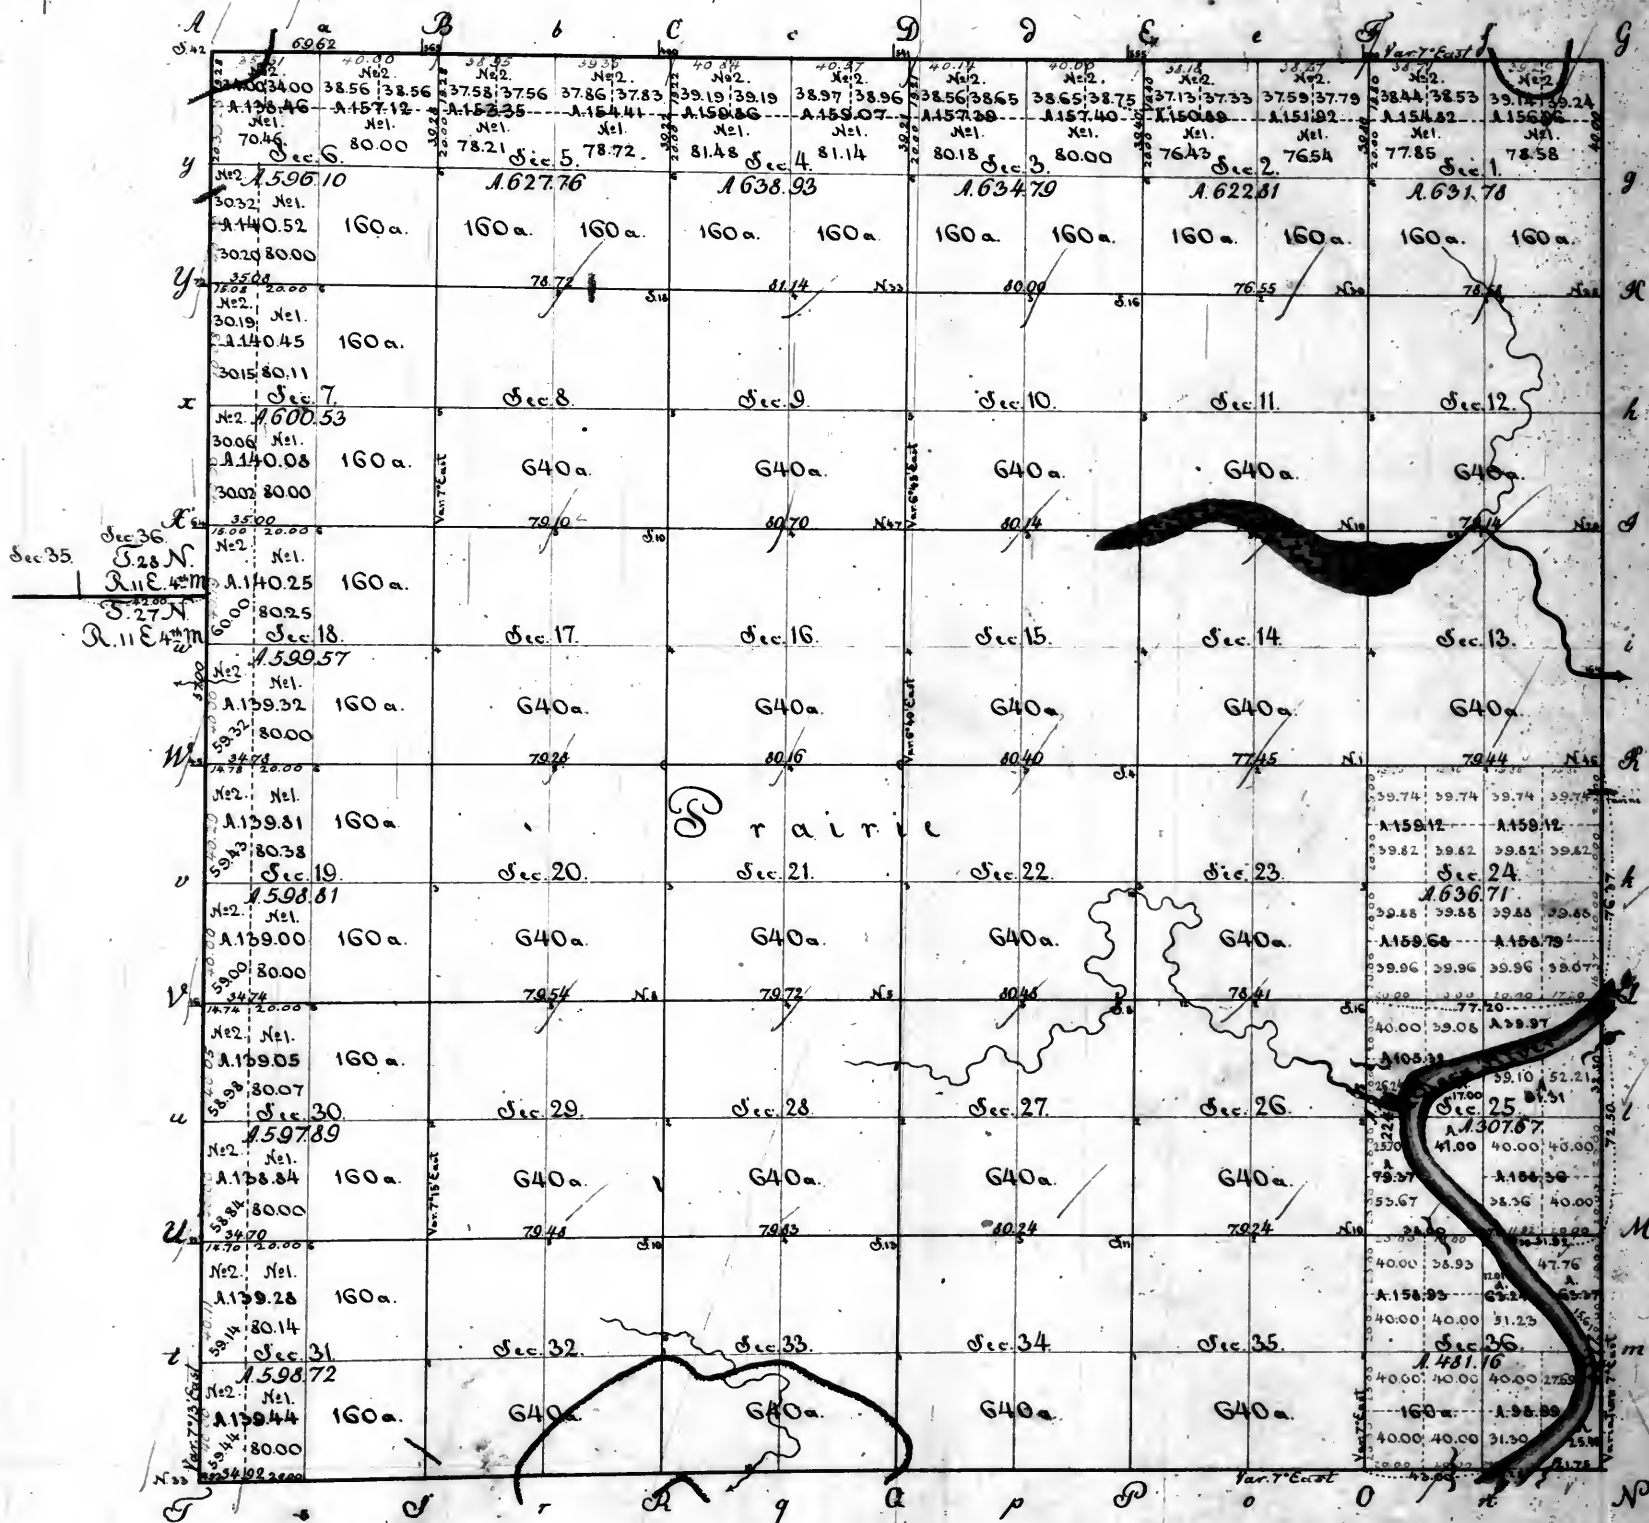

The accounts in which the surveying of this township is charged amount to \$2445.95, of which \$2050.00 were paid on the 20th of July 1837, and \$395.95 on the 20th of June 1839. The balance being \$395.95, being due to the Surveyor General for the 2^d quarter of 1839.


Surveyors Office.
Saint Louis, 1st of July 1839.

Scale of 40 chains to one inch.
Aggregate Area 2256666 acres.

The above plat of Township 45 north of the base line, range 1 east of the 3^d principal meridian is strictly conformable to the field notes of the Survey thereof on file in this office, which have been examined and approved. The west and east boundaries, 6 miles each, - The north boundary 5 miles 74.92 chains, and the north boundary 5 miles 69.62 chains were surveyed in the 4th quarter of 1835 - and the subdivision lines 53 miles 23.09 chains, and meanders of Rock river (except along the left bank through section 25) 4 miles 21.35 chains were surveyed in the 2^d and 4th quarters of 1836, - all by D. A. Spaulding, under contract of the 9th of June 1835, and with the limitation noted in the margin they were paid for in the 3^d quarter of 1837, and 2^d quarter of 1839, and charged in the accounts of the Surveyor General for those quarters Vouchers 76^o 6 and 7. - The left bank of Rock river, was meandered, mile 41.20 chains, through section 25, by D. A. Spaulding in the 4th quarter of 1837, under the above specified contract, and was paid for in the 2^d quarter of 1839, and charged in the account of the Surveyor General for that quarter voucher 76^o 7.

William Milburn
Surveyor General

T. 46. N. R. 1 E. of the 3rd 1st M. 2m

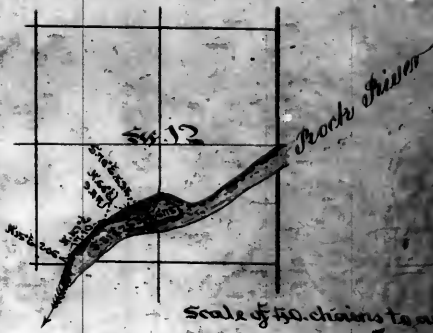

Scale of 40 chains to an inch

Office for the Survey General for Illinois & Missouri.
St. Louis November 1843.

The above plat, an abstract in section 12, of Township 46 north of the base line range 1 East of the Principal Meridian, is strictly conformable to the field notes of the survey made on this office which have been examined and approved. The said survey was completed in October 1843, by John Ferguson under instructions dated the 16th Jan of this year. The value of the survey amounts to 10 claims, which is paid for this day, and charged on the account current of the Surveyor General. During the present quarter, under the appropriation of \$1200 of the 65th act of the 2nd Term of the 30th Congress.


M. Lewis Clerk
Surveyor General.

A copy of this plat was sent to
Commissioner of Registers on 20th Nov 1843.

Downship 46 North of the base line Range 1 East of 3rd principal Meridian

22

St. Louis Nov 20th 1849
The island in section 12
surveyed in September 1849 by
Duncan Ferguson and one copy
of the plat sent to the Commissioner
and another to the Register at
St. Louis this day.

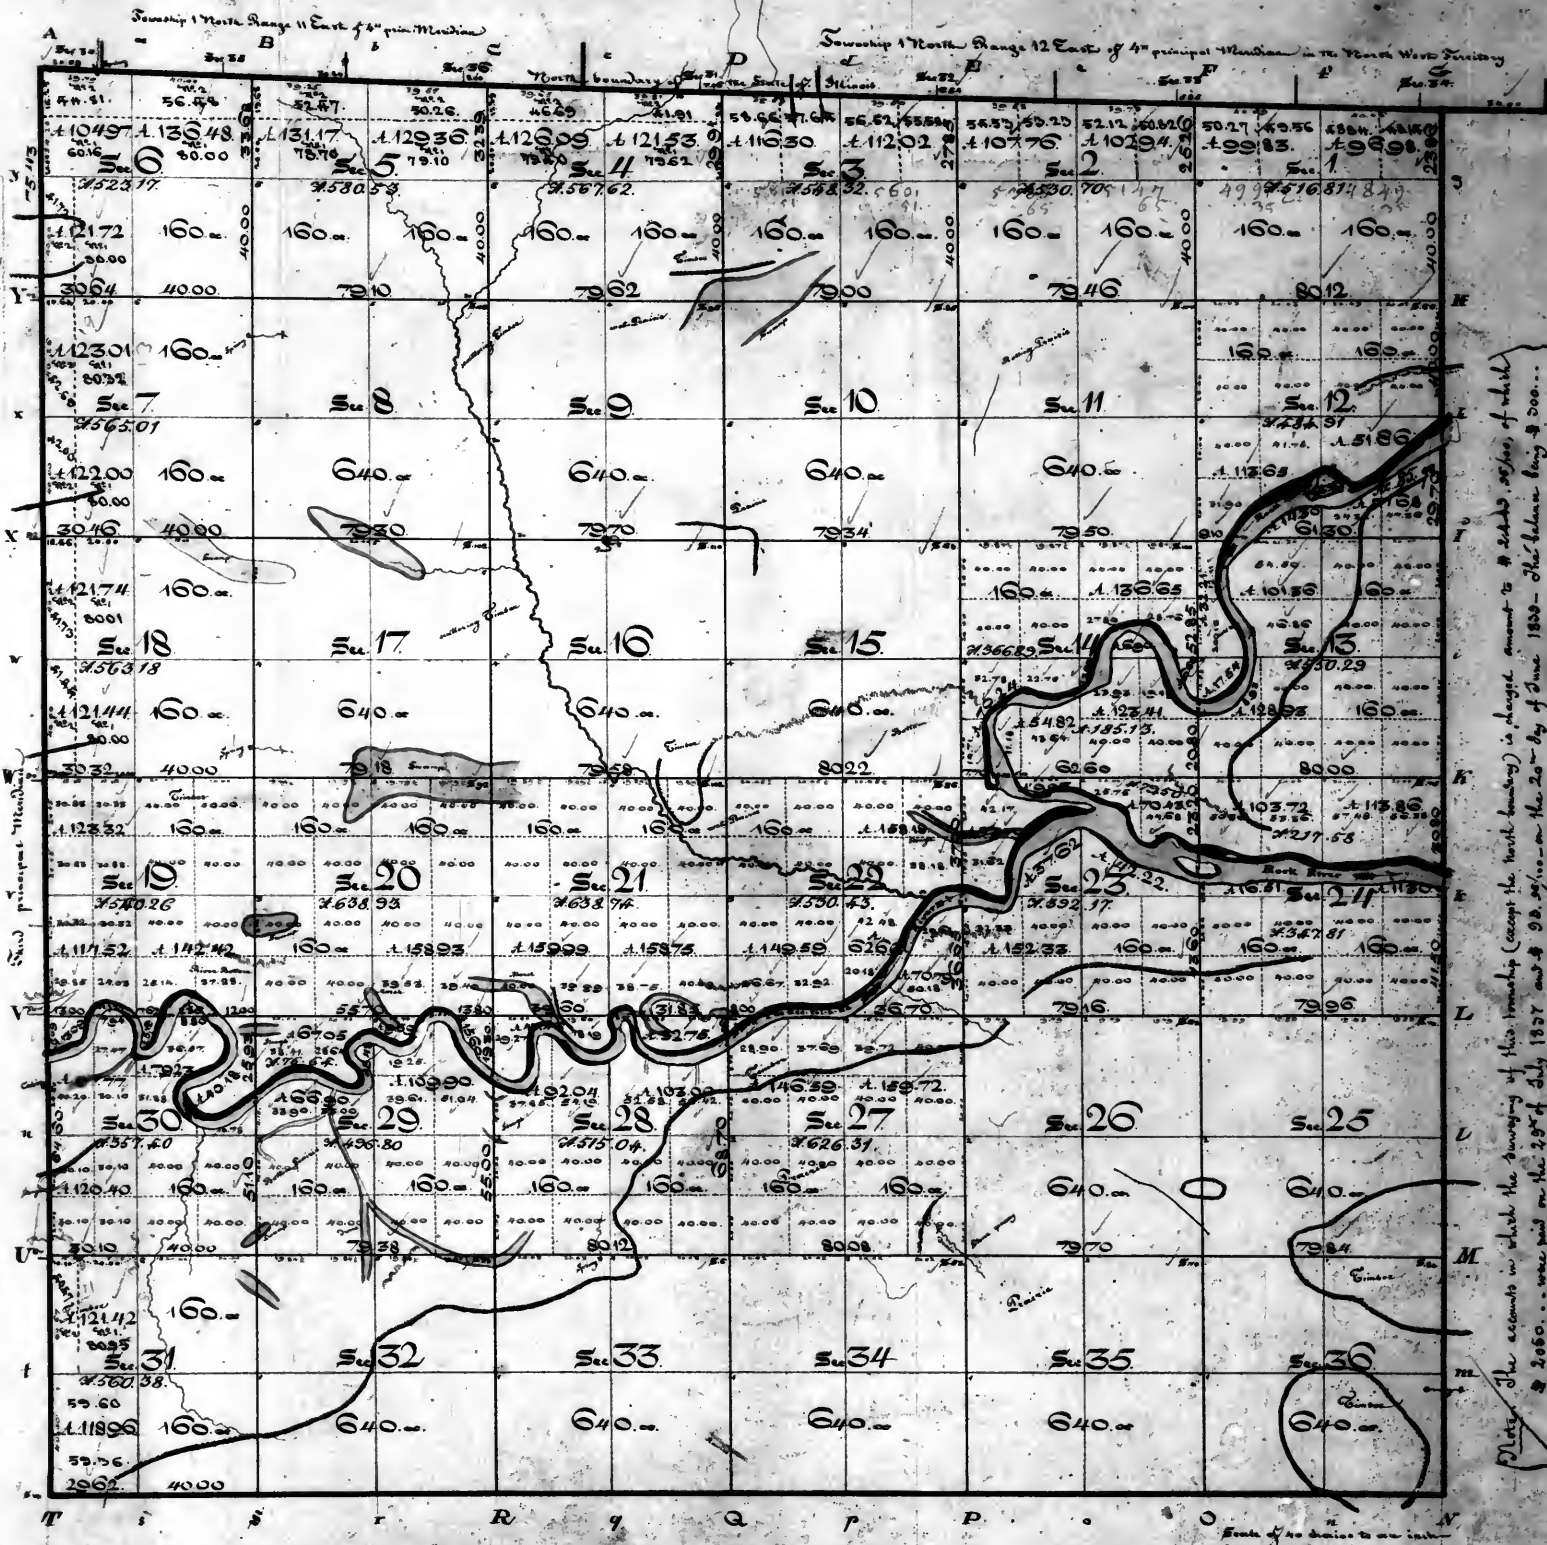

Notes: The accounts in which the surveying of this township (except the north boundary) is charged amount to \$2443.05 for of which \$2060.00 was paid on the 20th of July 1837 and \$383.05 on the 20th of July 1838 - The balance being \$383.05... having been paid by City of St. Louis - James S. Spaulding - Surveyor General - See under 20th of the Surveyor General's accounts for the 2nd quarter of 1837 and under 7th of the account for the 2nd quarter of 1839.

Surveyors Office.
Saint Louis 1st of July 1839.


Aggregate Area 20340.55 acres

The above plat of township 46 north of the base line, range 1 east of the 3rd principal meridian, is strictly conformable to the field notes of the survey thereof on file in this office, which have been examined and approved. The north boundary 5 miles 66.53 chains was surveyed in 1833 and 1835 by Lucius Lyon, Commissioner on the part of the United States as certified to this office on the 6th of August 1835, by Wm. J. Williams, Surveyor General of Ohio, Indiana and Michigan. - The said boundary being a part of the line between Illinois and Michigan now Wisconsin. - The west boundary 5 miles 75.43 chains and the south boundary 5 miles 69.62 chains were surveyed in the 4th quarter of 1833 - and the east boundary 5 miles 62.86 chains - the subdivision lines 5 miles 54.12 chains - and meanders of Pea-Kee-toh-a-Kee and other rivers, 25 miles 30.53 chains were surveyed in the 4th quarter of 1835 and 1st quarter of 1836, by Don Polaris Spaulding under contract of the 9th of June 1835 - The survey by Spaulding, was with the limitation noted in the margin paid for in the 2nd quarter of 1837 and 2nd quarter of 1839 - Vouchers 16th 6 and 7 - of the Surveyor General's accounts for those quarters.

William Milburn
Surveyor General

Examined
W. W.


23

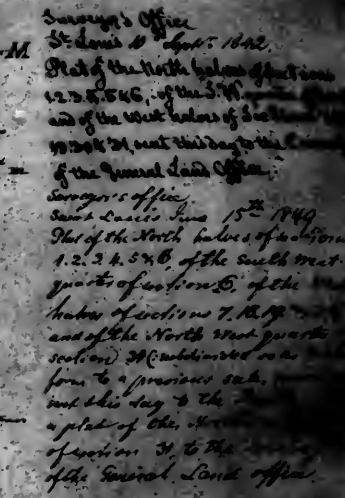

E. J. Langham

Township 27 North of the base line Range 2 East of 3^d principal Meridian.

24

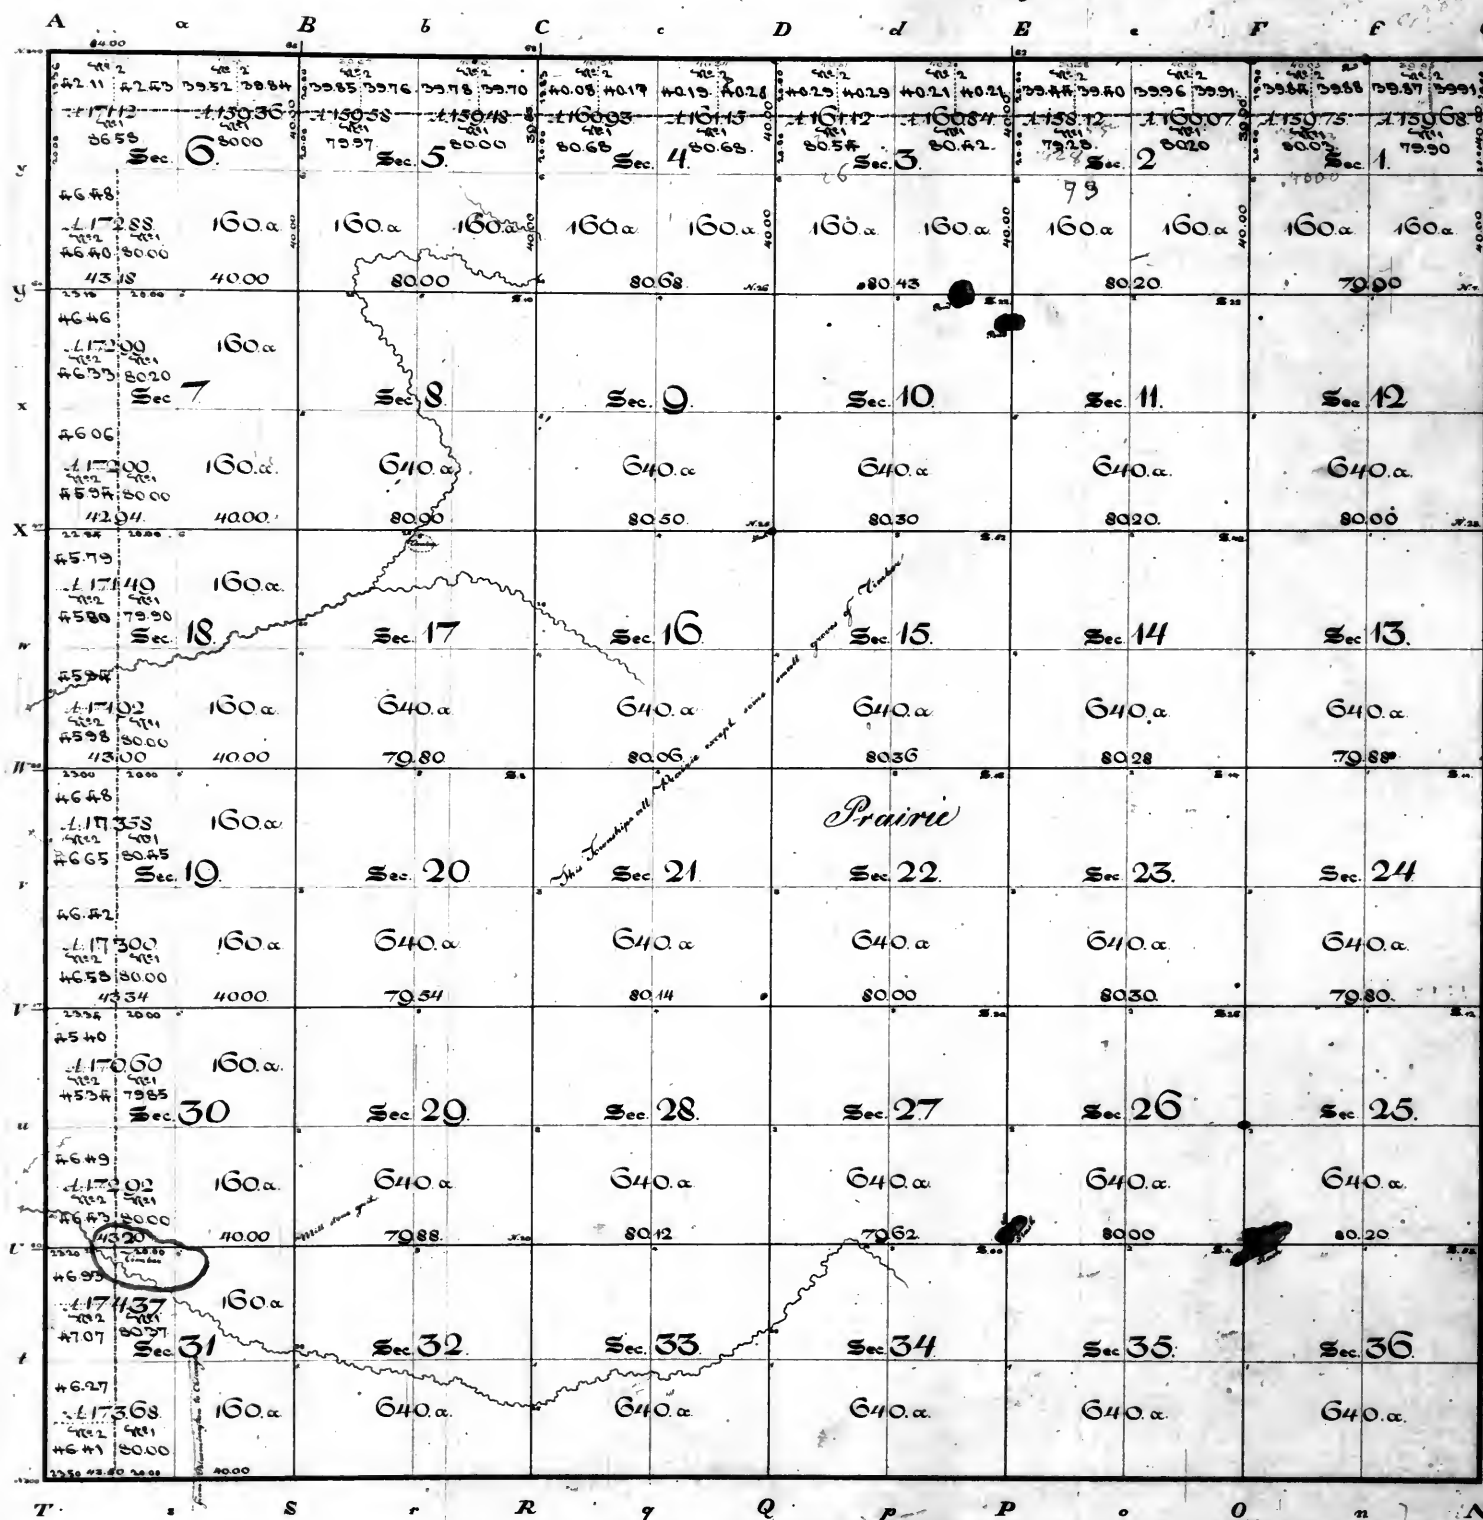

Reference to the field notes used in the construction of this Plat of the South, East, North & West boundaries & Subdivision lines by John Miller, Moore under his contract of the 12th of August 1853 and changed for in his account of the 30th of December 1854. The notes of the South boundary dated 12th of October 1853. East boundary as dated 15th of October 1853. North boundary as dated 10th & 24th of October 1853. West boundary as dated 18th of October 1853. Subdivision lines as dated from 9th to 26th of November 1853.

The South, East, North & West boundaries & the Subdivision lines were surveyed at an assumed Variation of 8° East to conform to the 3^d principal Meridian.

Surveyor's Office
St. Louis 11th Sept. 1852.
Plat of the North halves of sections 1, 2, 3, 4, 5, 6, of the S. 1/4 section of Sec. 6 and of the West halves of sections 1, 2, 3, 4, 5, 6, of the South west quarter of section 6, of the West quarters 7, 18, 19, and of the West quarter of section 30, west to the Republic of the State of Missouri.
General Land Office.


Aggregate Area 23,506.3 acres

Surveyor's Office
St. Louis 15th of June 1853

The above Plat of Township 27 North of the base line Range 2 East of 3^d principal Meridian is conformable to the field notes of the survey thereof on file in this Office.

E. J. Sangham

25

 

The South, East, North & West
boundaries and the Subdivision
lines were surveyed at an assumed
L variation of 8° East to conform
to the 3^d principal Meridian.



The above Plat of Township 28 North of the base line Range 2 East of 3^d principal Meridian is conformable to the field notes of the survey thereof on file in this Office

E. J. Langham

Township 29 North of the base line Range 2 East of 3^d principal Meridian

26

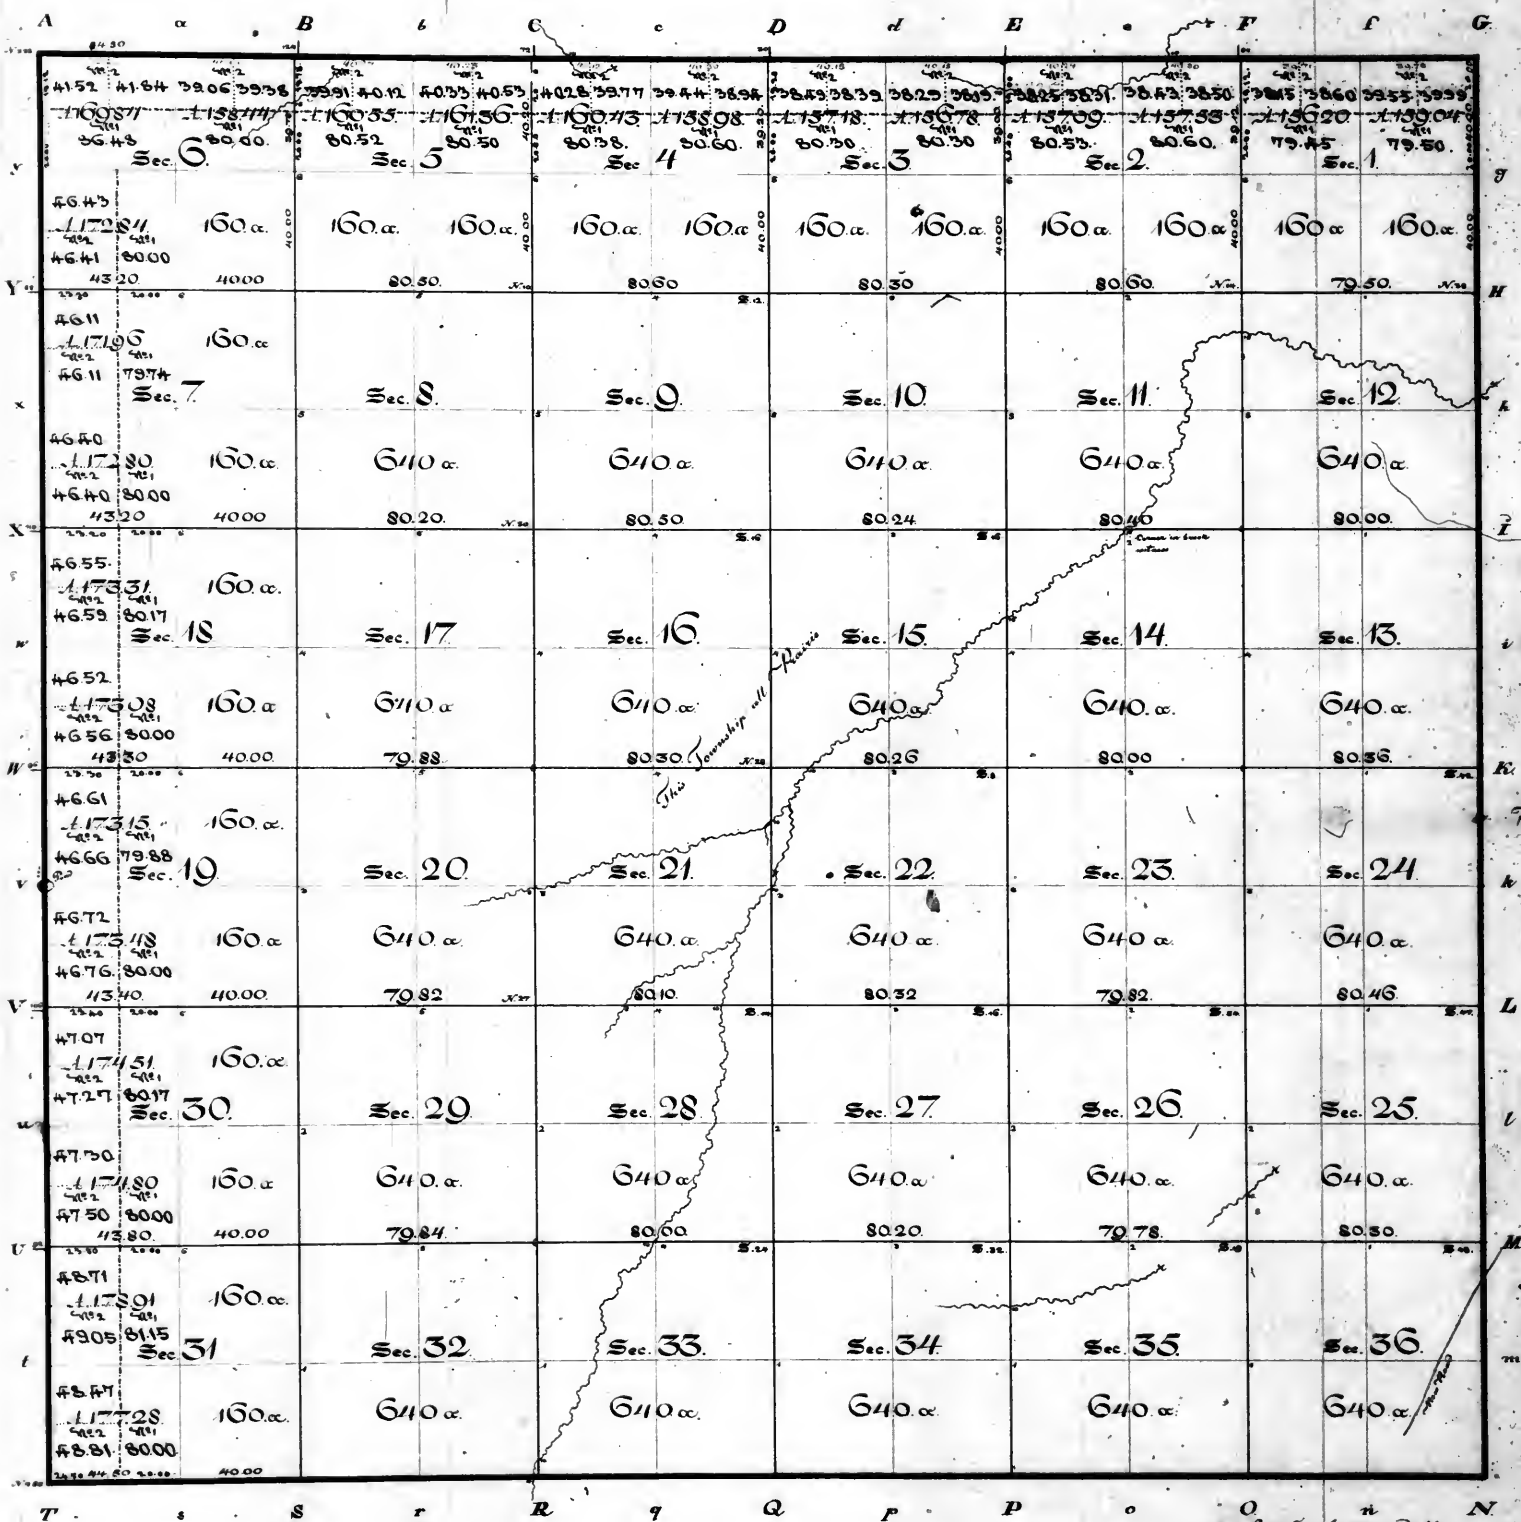

Reference to the field notes used in the construction of this Plat of the South, East, North & West boundaries & Subdivision lines by John Milton Moore and his assistant of the 12th of August 1833 and changed for in his account of the 30th of December 1834.

The note of the South boundary on date 20th of October 1833.

East boundary on date 21st of October 1833.

North boundary on date 25th of May 1834.

West boundary on date 23rd of April 1834.

Subdivision lines on date from the 6th to the 17th of May 1834.

The South East North & West boundaries & the Subdivision lines of the Township were surveyed at an assumed variation of 8° East to conform to the 3^d principal Meridian.

Surveyor's Office
St Louis 10th Sept. 1842

Plat of the North halves of sections 12, 23 & 34, of the 6th & 10th of Sec. 6 & of the West halves of Sec. 17 & 28 & 31 and this day to the Commr of the General Land Office.

Surveyor's office
St Louis 15th Jan. 1849.

Plat of the North halves of sections 1, 2, 3, 4, 5 & 6, of the South West quarter of section 6, and of the West halves of sections 7, 18, 19, 30, 31, and this day to the Register of the Land Office at Fairbault.

Aggregate Area 23189.84 acres


Surveyor's Office
St Louis 10th Sept. 1842

The above Plat of Township 29 North of the base line Range 2 East of 3^d principal Meridian is conformable to the field notes of the survey, thereof on file in this Office

E. J. Langhorne

Township 30 North of the base line Range 2 East of 3^d principal Meridian

27

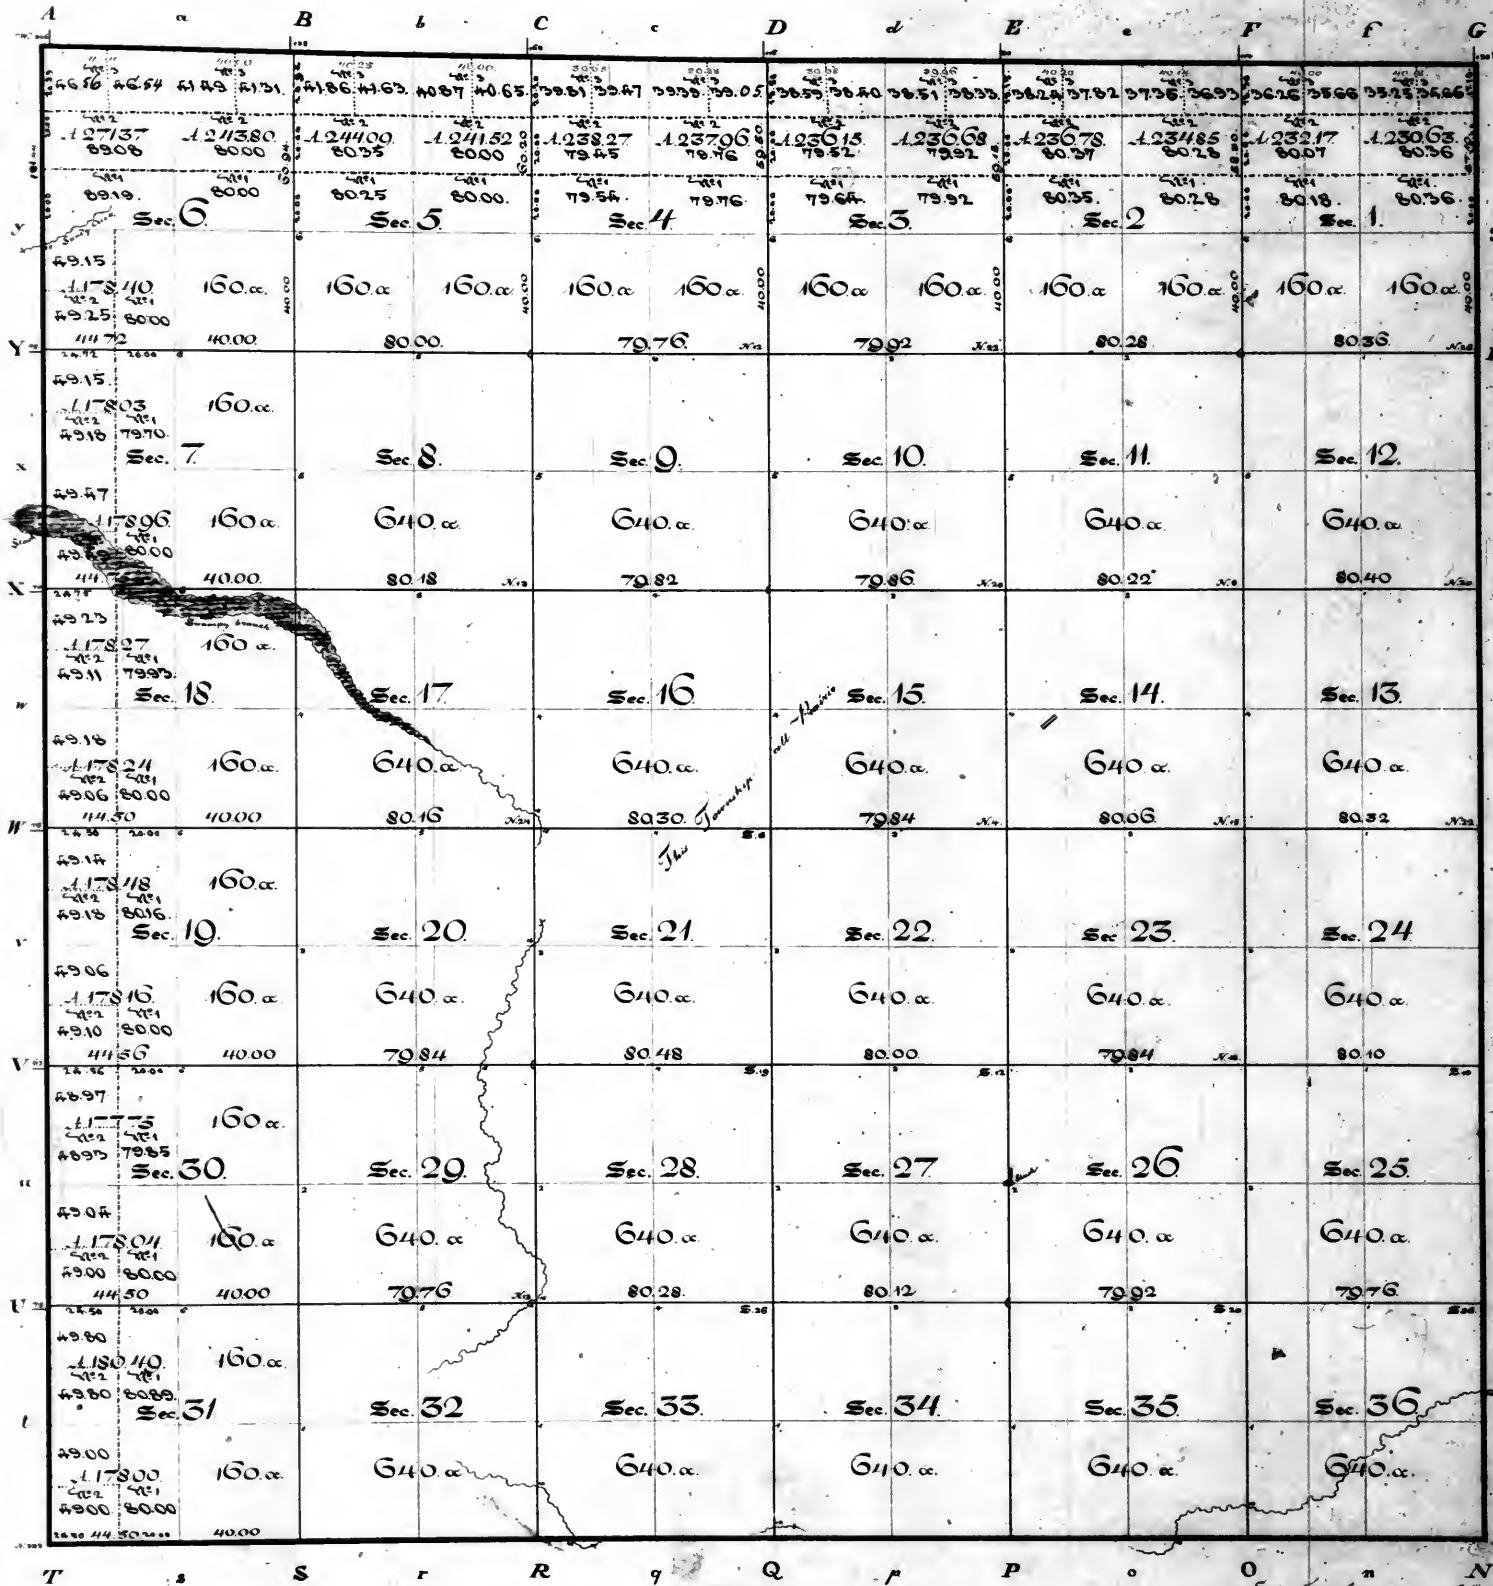

I Reference to the field notes used in the construction of this plat of the North boundary of R. 2 E. of the 3^d principal Meridian, made by A. J. Kilday in May 1894, of the North, South & East boundary lines & Subdivision lines by John Moore, under his contract of the 12th of August 1893 and changed for in his account of the 30th of December 1894. The notes of the West boundary were dated 16th of April 1894. South boundary was dated 6th of May 1894. East boundary was dated 12th of May 1894. Subdivision lines were dated from 12th to 20th of May 1894.

K The West, South & East boundaries of the Subdivision lines were surveyed at an assumed Meridian of 6th East to conform to the 3^d principal Meridian. The field notes of the North boundary were dated this day to the Variation at which it was surveyed.

L Surveyor's Office St. Louis 10th Sept. 1894. Plat of the North halves of sections 1, 2, 3, 4, 5 & 6, of the S. W. quarter of Sec. 6, and of the West halves of sections 7, 8, and of the North halves of sections 1, 2, 3, 4, 5 & 6, of the South West quarter of section 6, and of the West halves of sections 7, 8, sent this day to the Comptroller of the General Land Office.

M Surveyor's Office St. Louis June 15th 1894. Plat of the North halves of sections 1, 2, 3, 4, 5 & 6, of the South West quarter of section 6, and of the West halves of sections 7, 8, sent this day to the Comptroller of the General Land Office at Danville.


Scale of 40 chains to an inch
Aggregate area. 24207.09 aces.

Surveyor's Office St. Louis 19th June 1895. The above Plat of Township 30 North of the base line Range 2 East of 3^d principal Meridian is conformable to the field notes of the survey thereof on file in this Office.

E. J. Sangham

Township 31 North of the base line Range 2 East of the 3rd principal meridian.
 except sections 1, 12, 13, 24, 25 and 36, and the North halves of sections 2, 3, 4, 5, 6, which are omitted for the reasons stated in the margin.

28

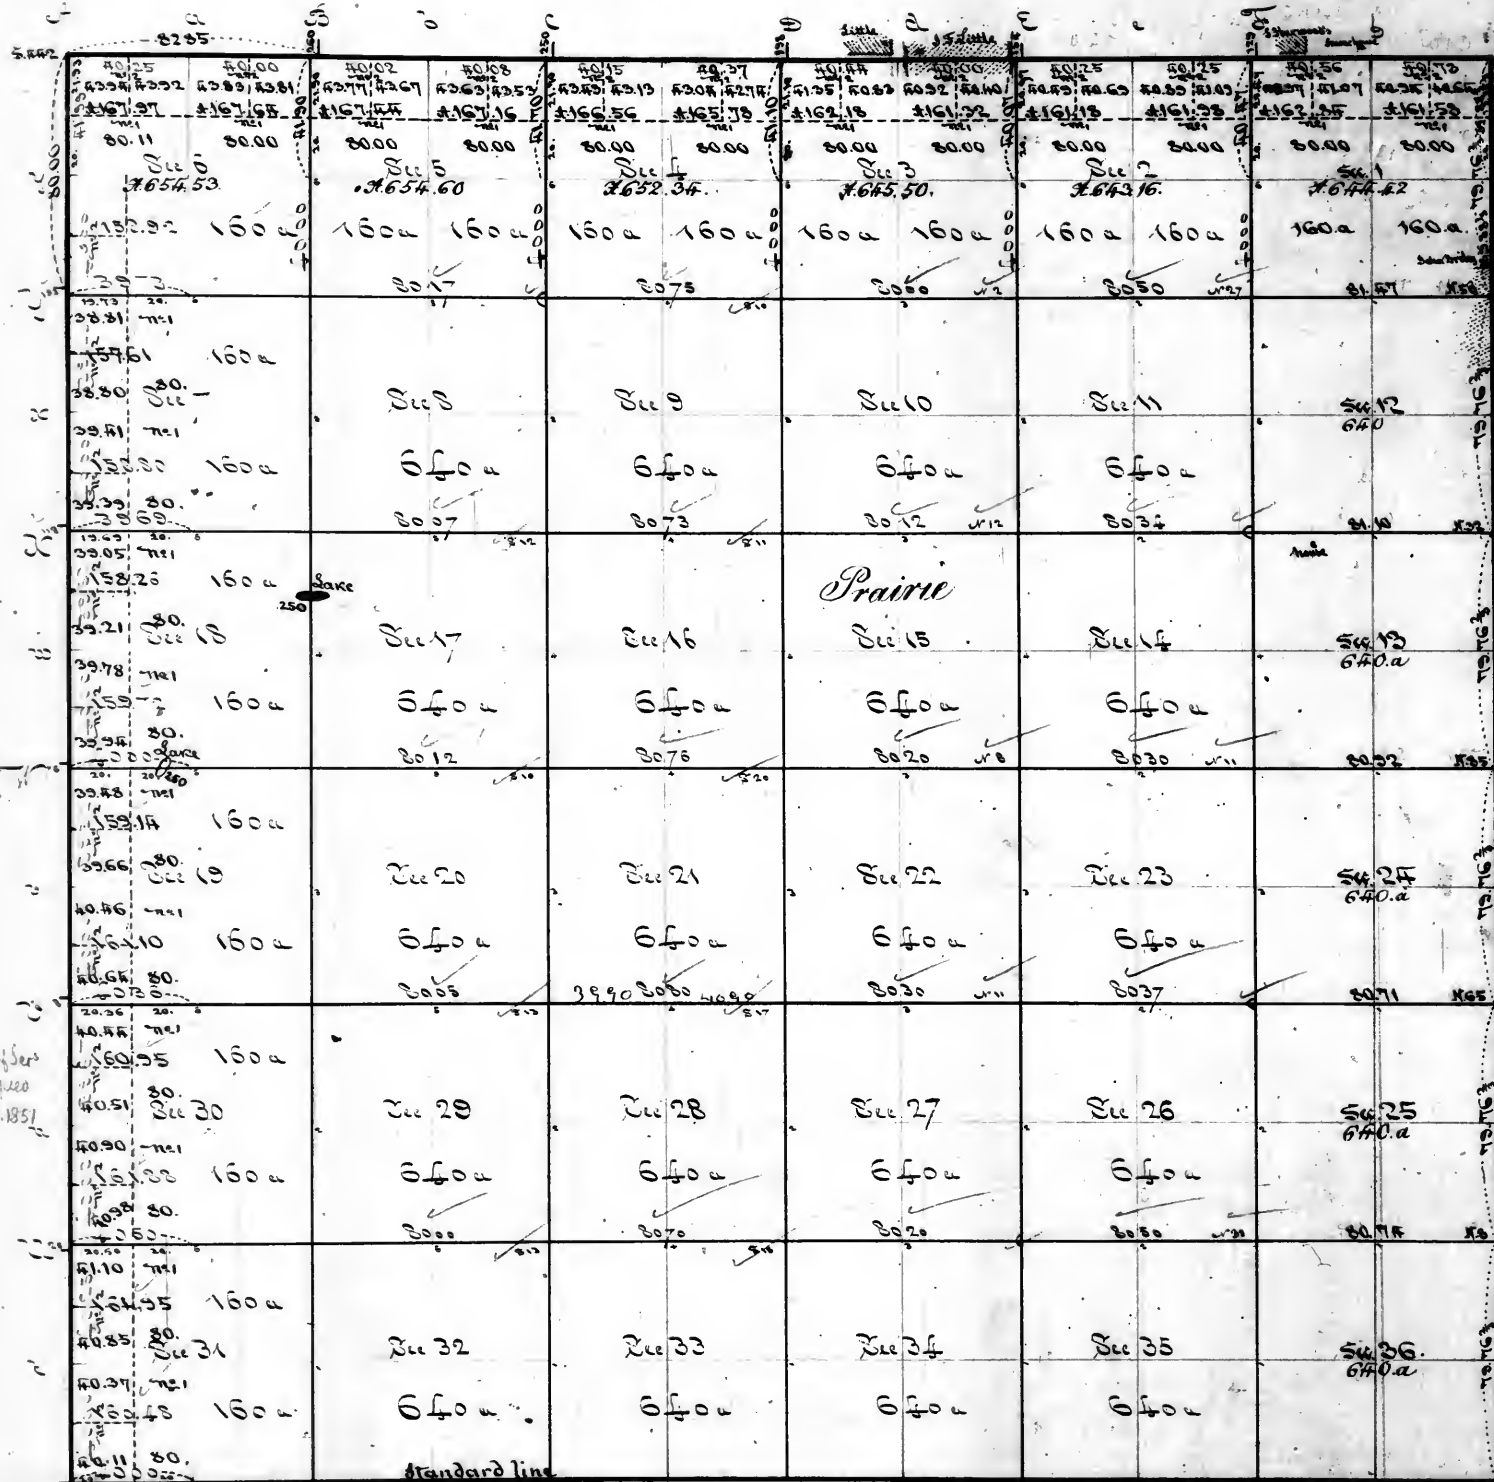

Surveyors Office
 St. Louis June 28th 1834
 These are notes
 of the survey of the East or North boundary
 of Township 31 North, Range 2 East of the 3rd
 principal meridian found on file in this Office
 sections 1, 12, 13, 24, 25 & 36, and the North halves
 of sections 2, 3, 4, 5 & 6, of that Township
 therefore omitted on the annexed Plat.

Statement referred to in Certificate
 below of the 18th Oct. 1834.

| Lines | d. m. sec. |
|--------------------------|------------|
| E. by of Township | 5 78 60 |
| Line between 25 & 36 | 1 00 14 |
| 24. 25 | 1 00 11 |
| 13. 24 | 1 00 32 |
| 12. 13 | 1 01 10 |
| 1. 12 | 1 01 47 |
| 1. 2. 3. 4. 5. 6. corner | 40 47 |
| 2. 3. 4. | 40 37 |
| 3. 4. 5. | 41 10 |
| 4. 5. 6. | 41 70 |
| 5. 6. 12 | 41 30 |
| | 13 49 63 |

Surveyors Office
 St. Louis June 28th 1834.

The above Plat of Township 31 North of the Baseline, Range 2 East of the 3rd principal meridian, is conformable to the field notes of the survey thereof on file in this Office.

E. J. Sanham


Surveyors Office
 Saint Louis 16th Oct. 1834.

Sections 1, 2, 3, 4, 5, 6, 12, 13, 24, 25, 26, were laid down on the above plat, and are strictly conformable to the field notes of the survey thereof on file in this Office, which have been examined and approved in April 1834, by G. Walker, and by sections of the 23rd of March of the same year, surveys the lines detailed in the marginal Statement, 13 miles 49. 67 chains, which were paid for in the 3rd quarter of 1834 and charged in the account current of the Surveyor General during the same quarter; and the appropriation of \$3000 of the 3rd March 1833, (p. 95 Act of 13th June 27th Congress) for the survey of detached and unfinished lines in Illinois & Missouri; at a rate not exceeding six dollars a mile.

Silas Reed
 Surveyor of the public land in
 the State of Missouri.

Plat of Township 33 North of the base line Range 2 East of the 3^d principal Meridian

30

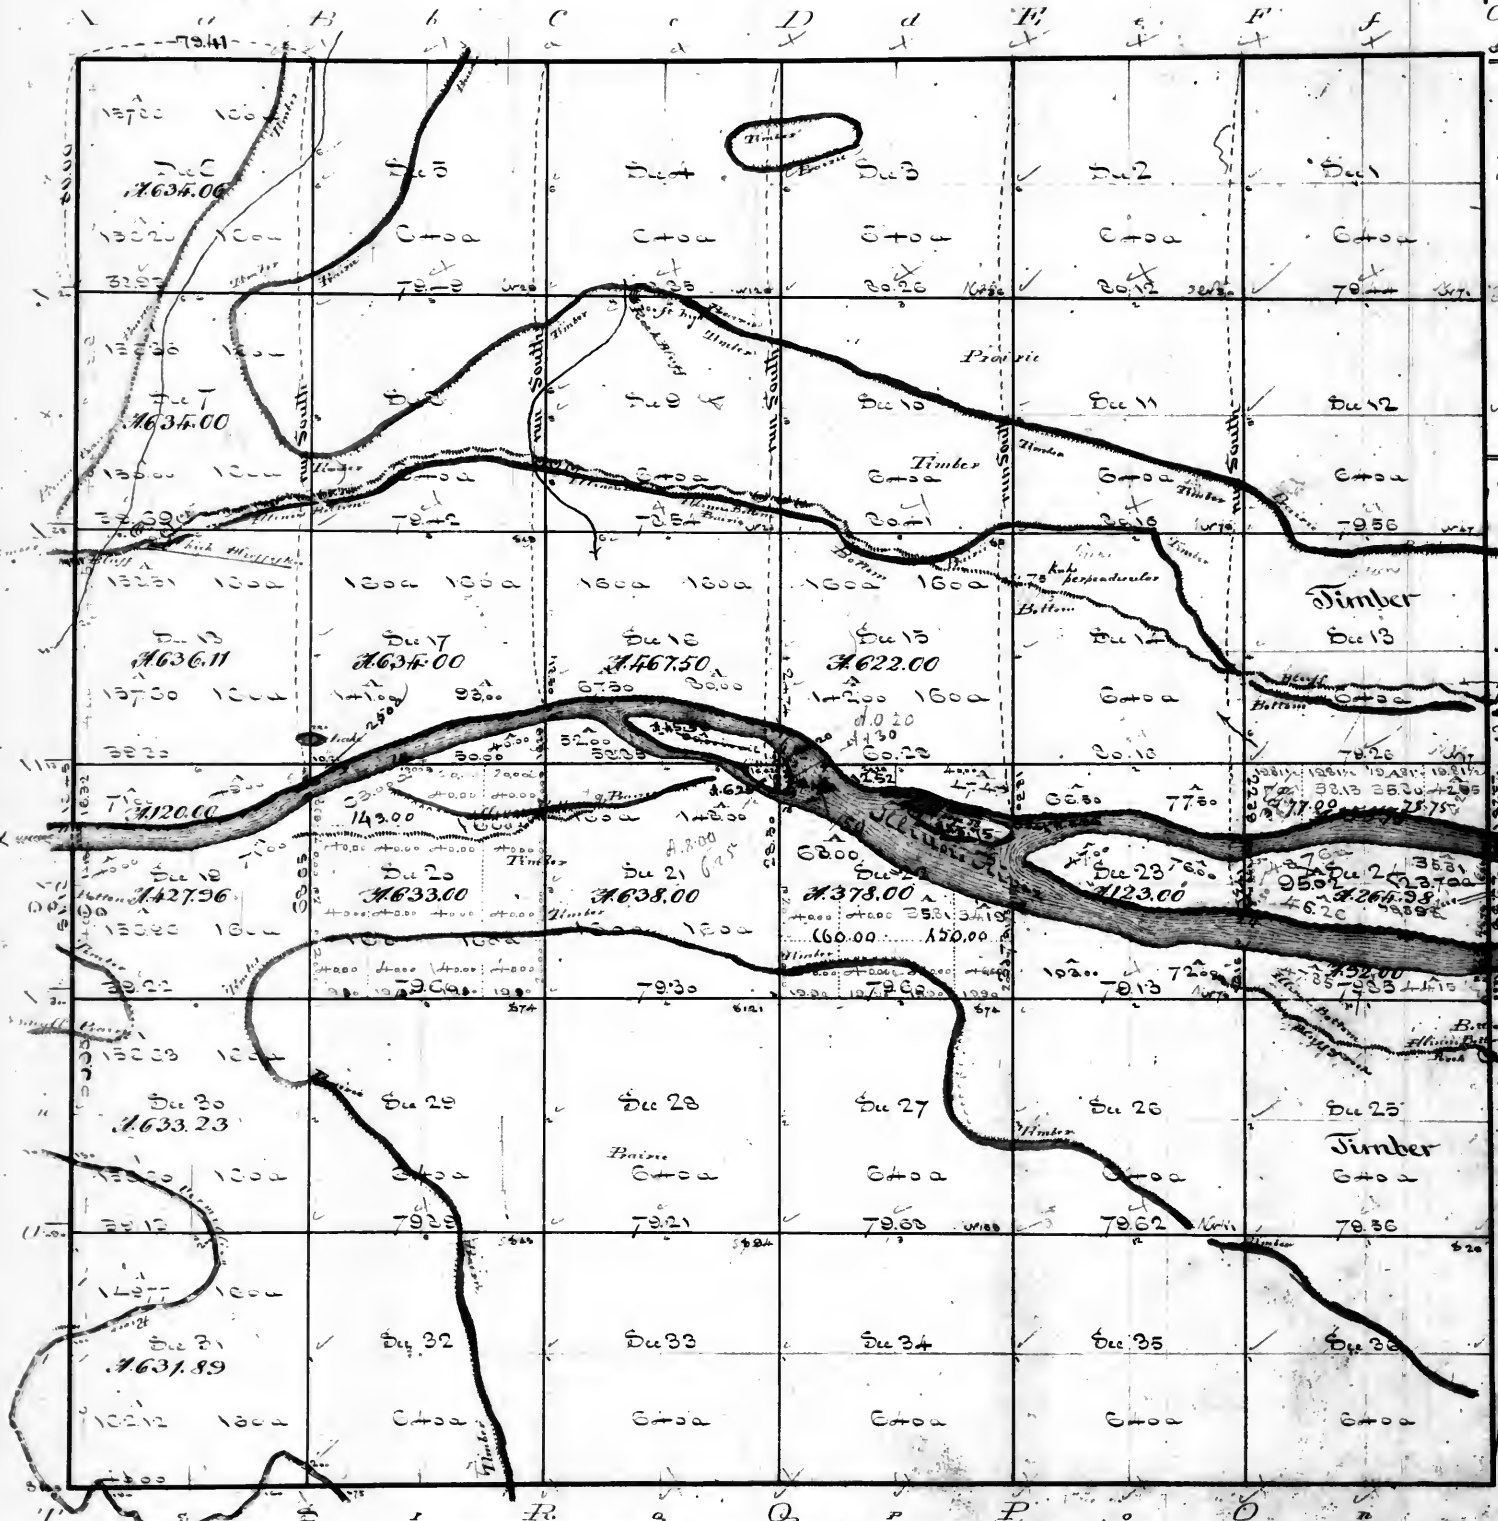

Aggregate area of public land = 22267.18 acres
 estimated area of the river = 700.00 - 11th Nov. 1842
 Total 22967.18 acres


Surveyors Office
 St. Louis June 21st 1834.

The above Plat of Township 33 North of the Base line, Range 2 East of the 3^d principal Meridian, is conformable to the field notes of the survey thereof on file in this Office.

E. J. Tamm


31

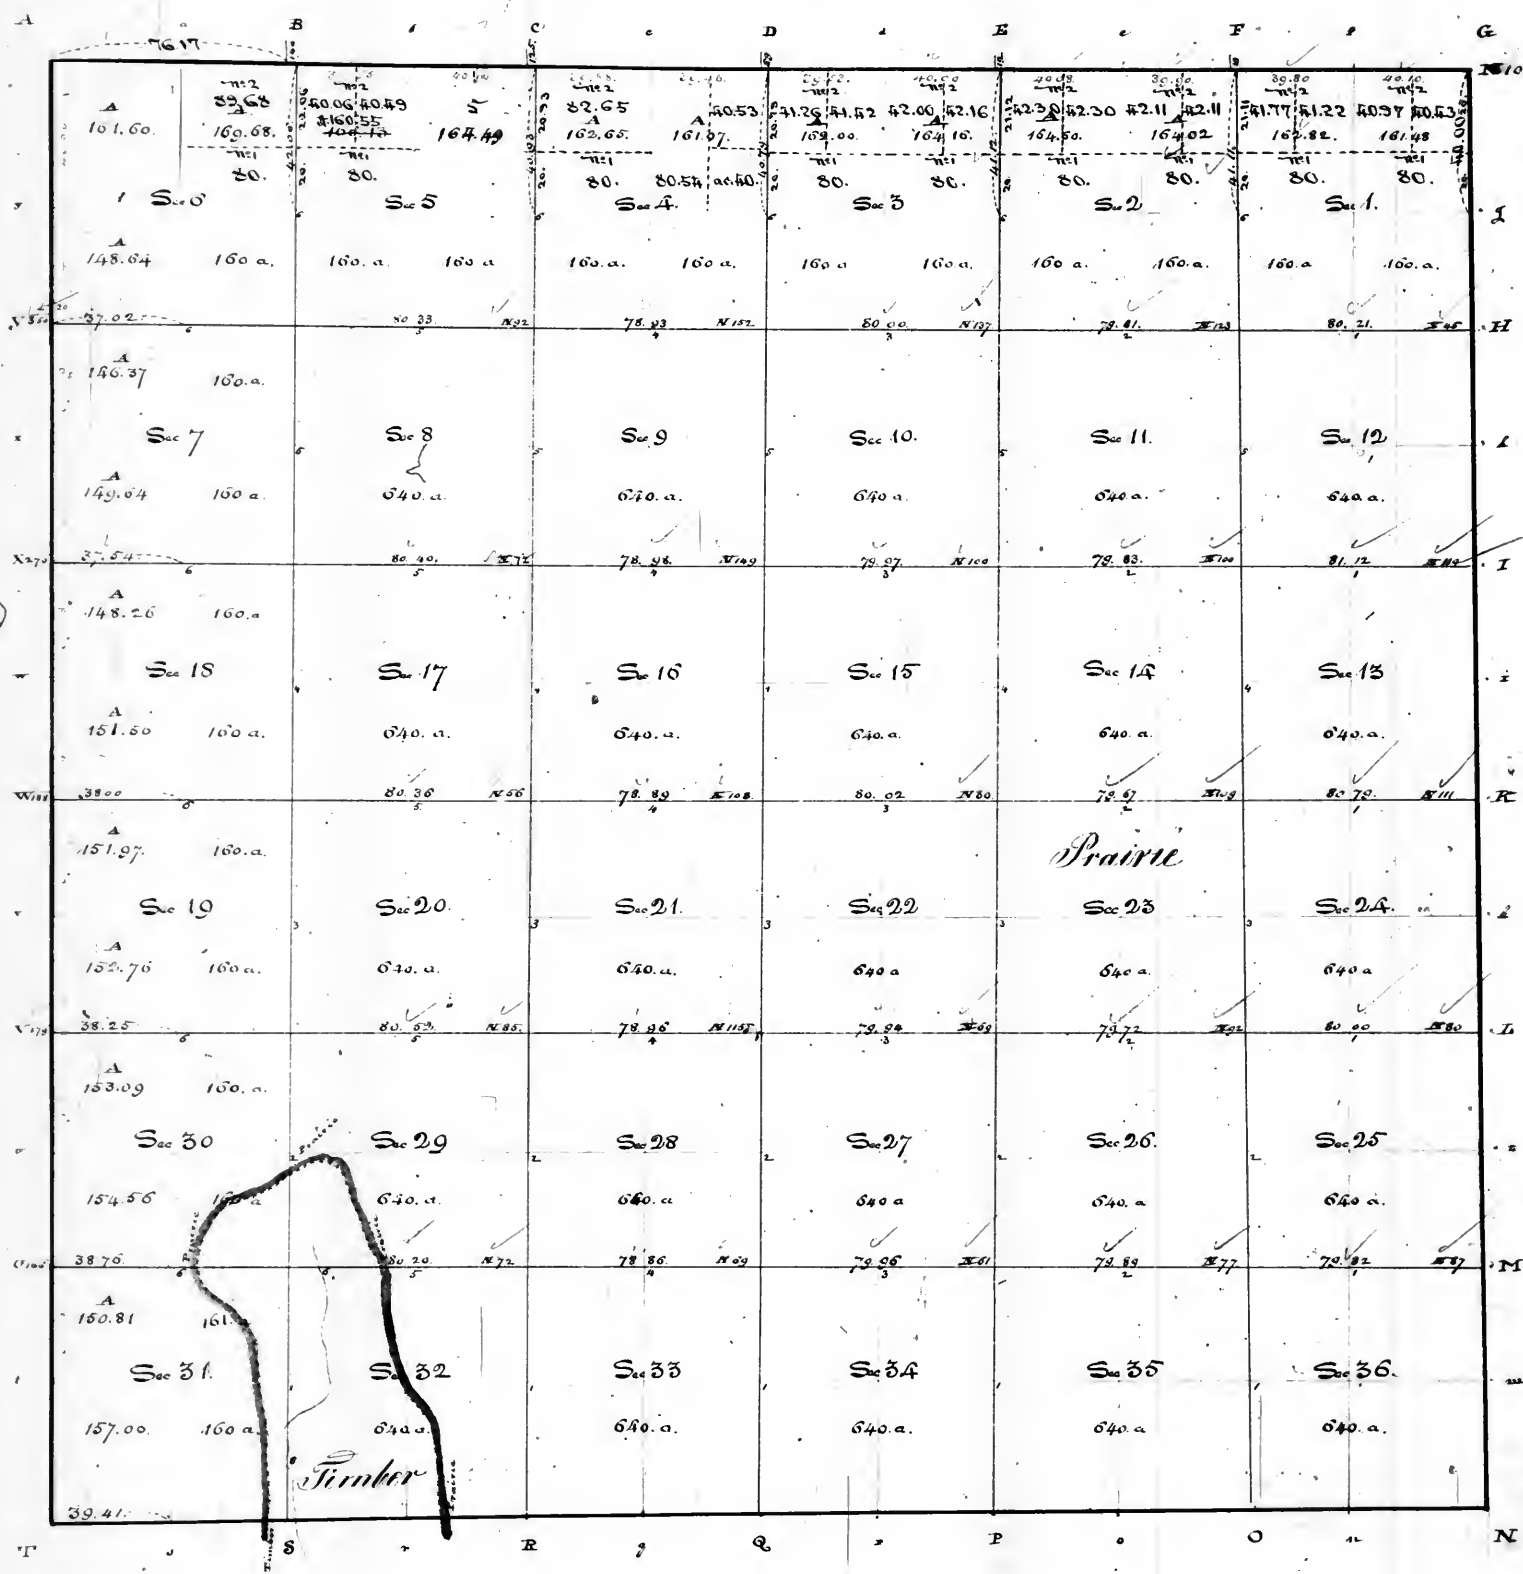

Sum of the areas of the several sections & fractional sections of T34 N. R. 2 E. of the 3^d P. M. meridian as set down on this plat.
22988.76. acres


Surveyors Office
St. Louis June 25th 1834.

The above Plat of Township 34 North of the Base line, Range 2 East of the 3^d Principal Meridian, is conformable to the field notes of the Survey thereof on file in this Office.

E. J. Langhorn

Township 35 North of the baseline, Range 2 East of the 3^d principal Meridian.

32

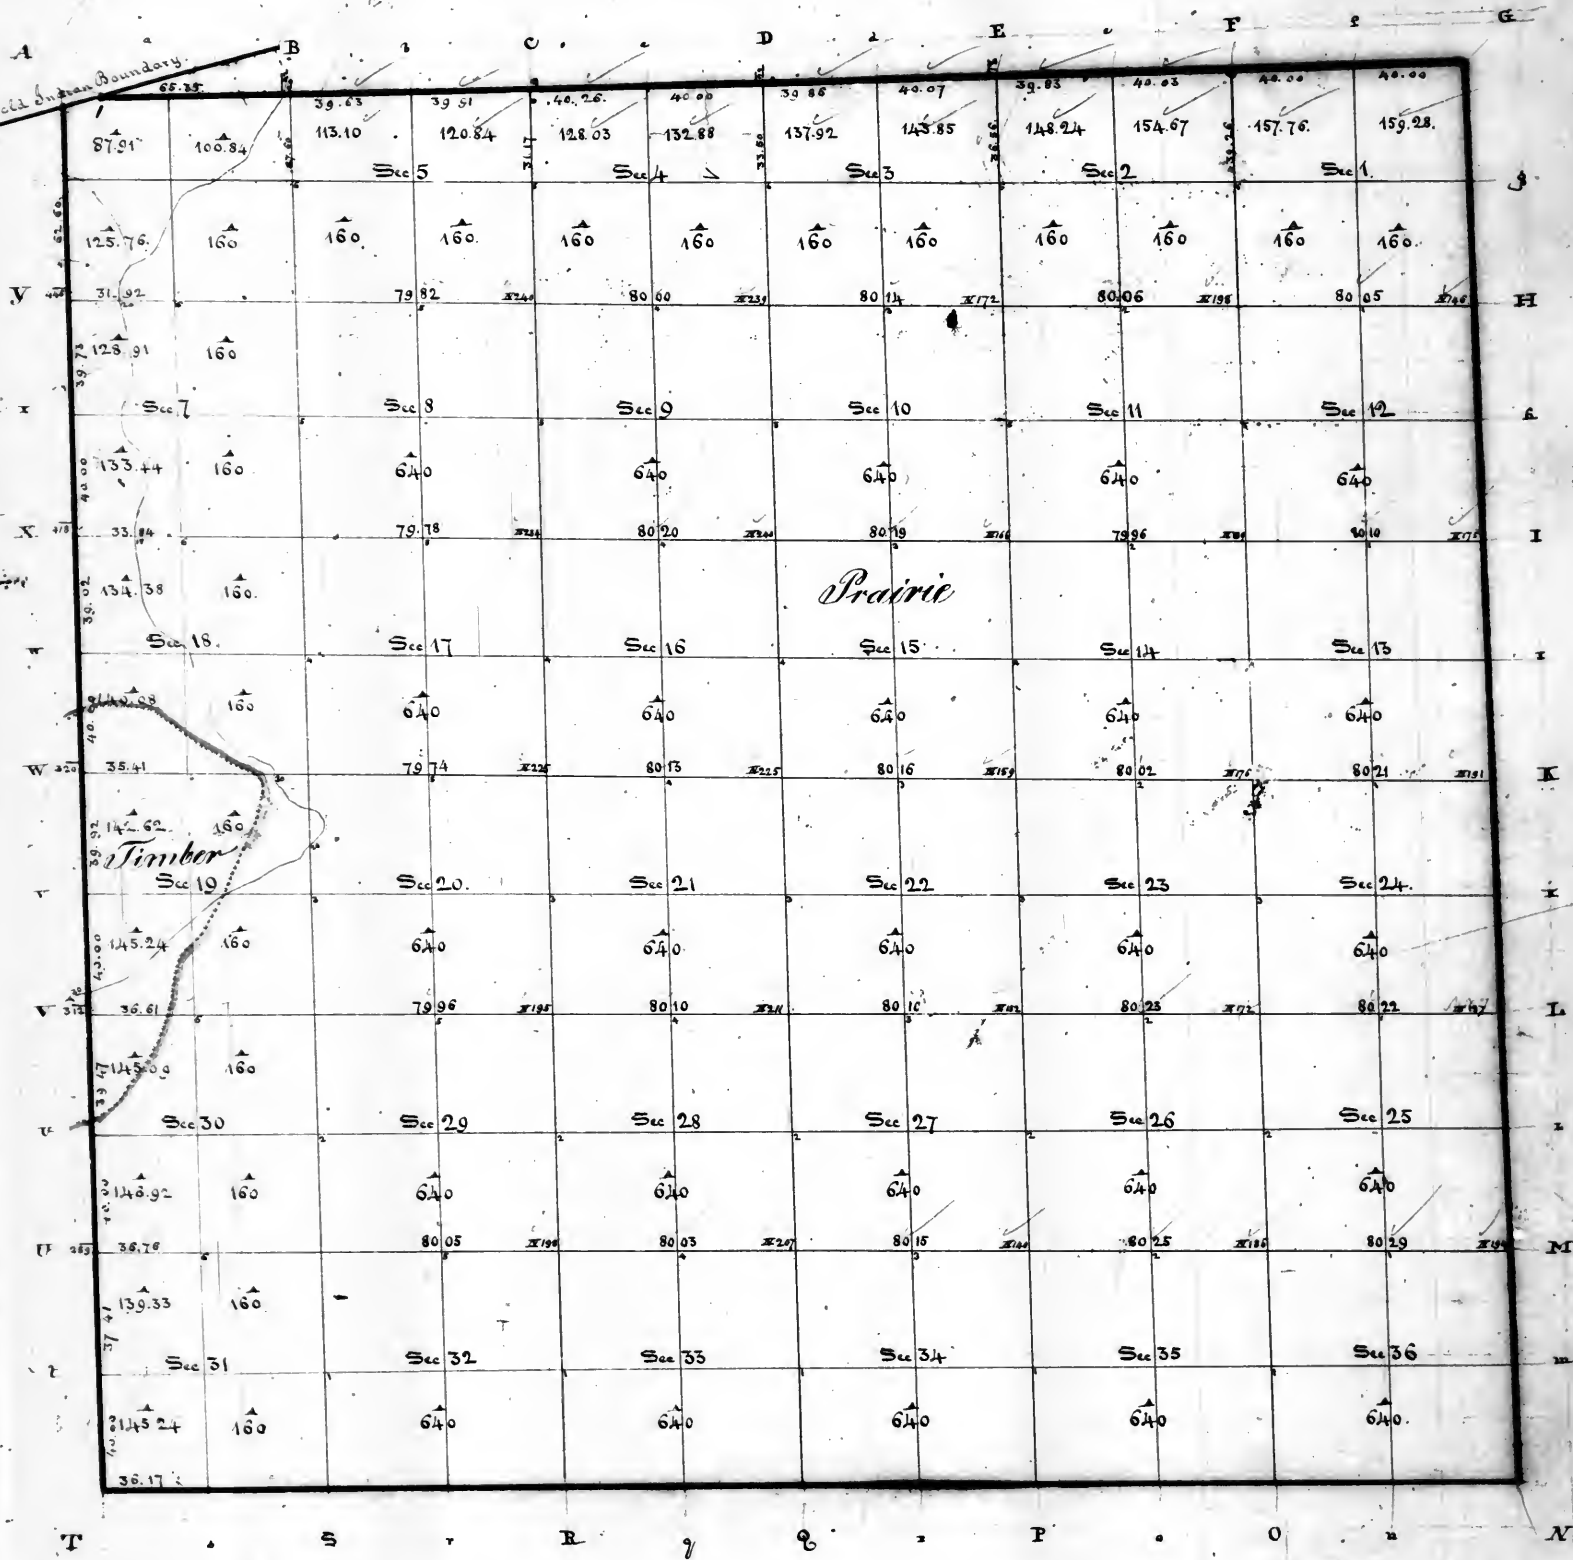


Surveyors Office
St. Louis July 1854

The above Plat of Township 35 North of the base line, Range 2 East of the 3^d principal Meridian, is conformable to the field notes of the survey thereof on file in this Office.


E. J. Langham

3/3

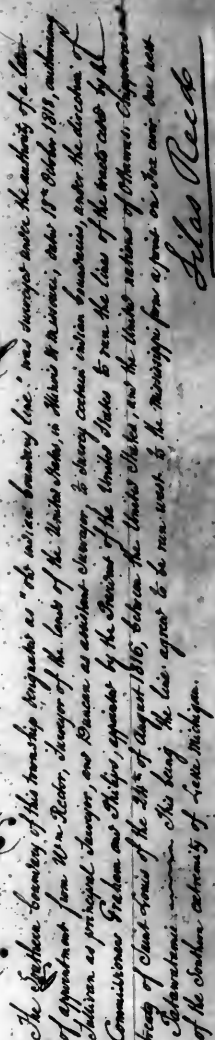

Surveyors Office.
Saint Louis 30th of May 1843.
The above plat of township 36. north of the base line
range 2 east of the 3^d principal meridian, north of the
old indian boundary is strictly conformable to the field
notes of the survey thereof on file in this office which
have been examined and approved.
Silas Reed
Surveyor of the public lands in
the State of Missouri &c.

Township 37 North of the base line Range 2 East of the 3rd principal Meridian,

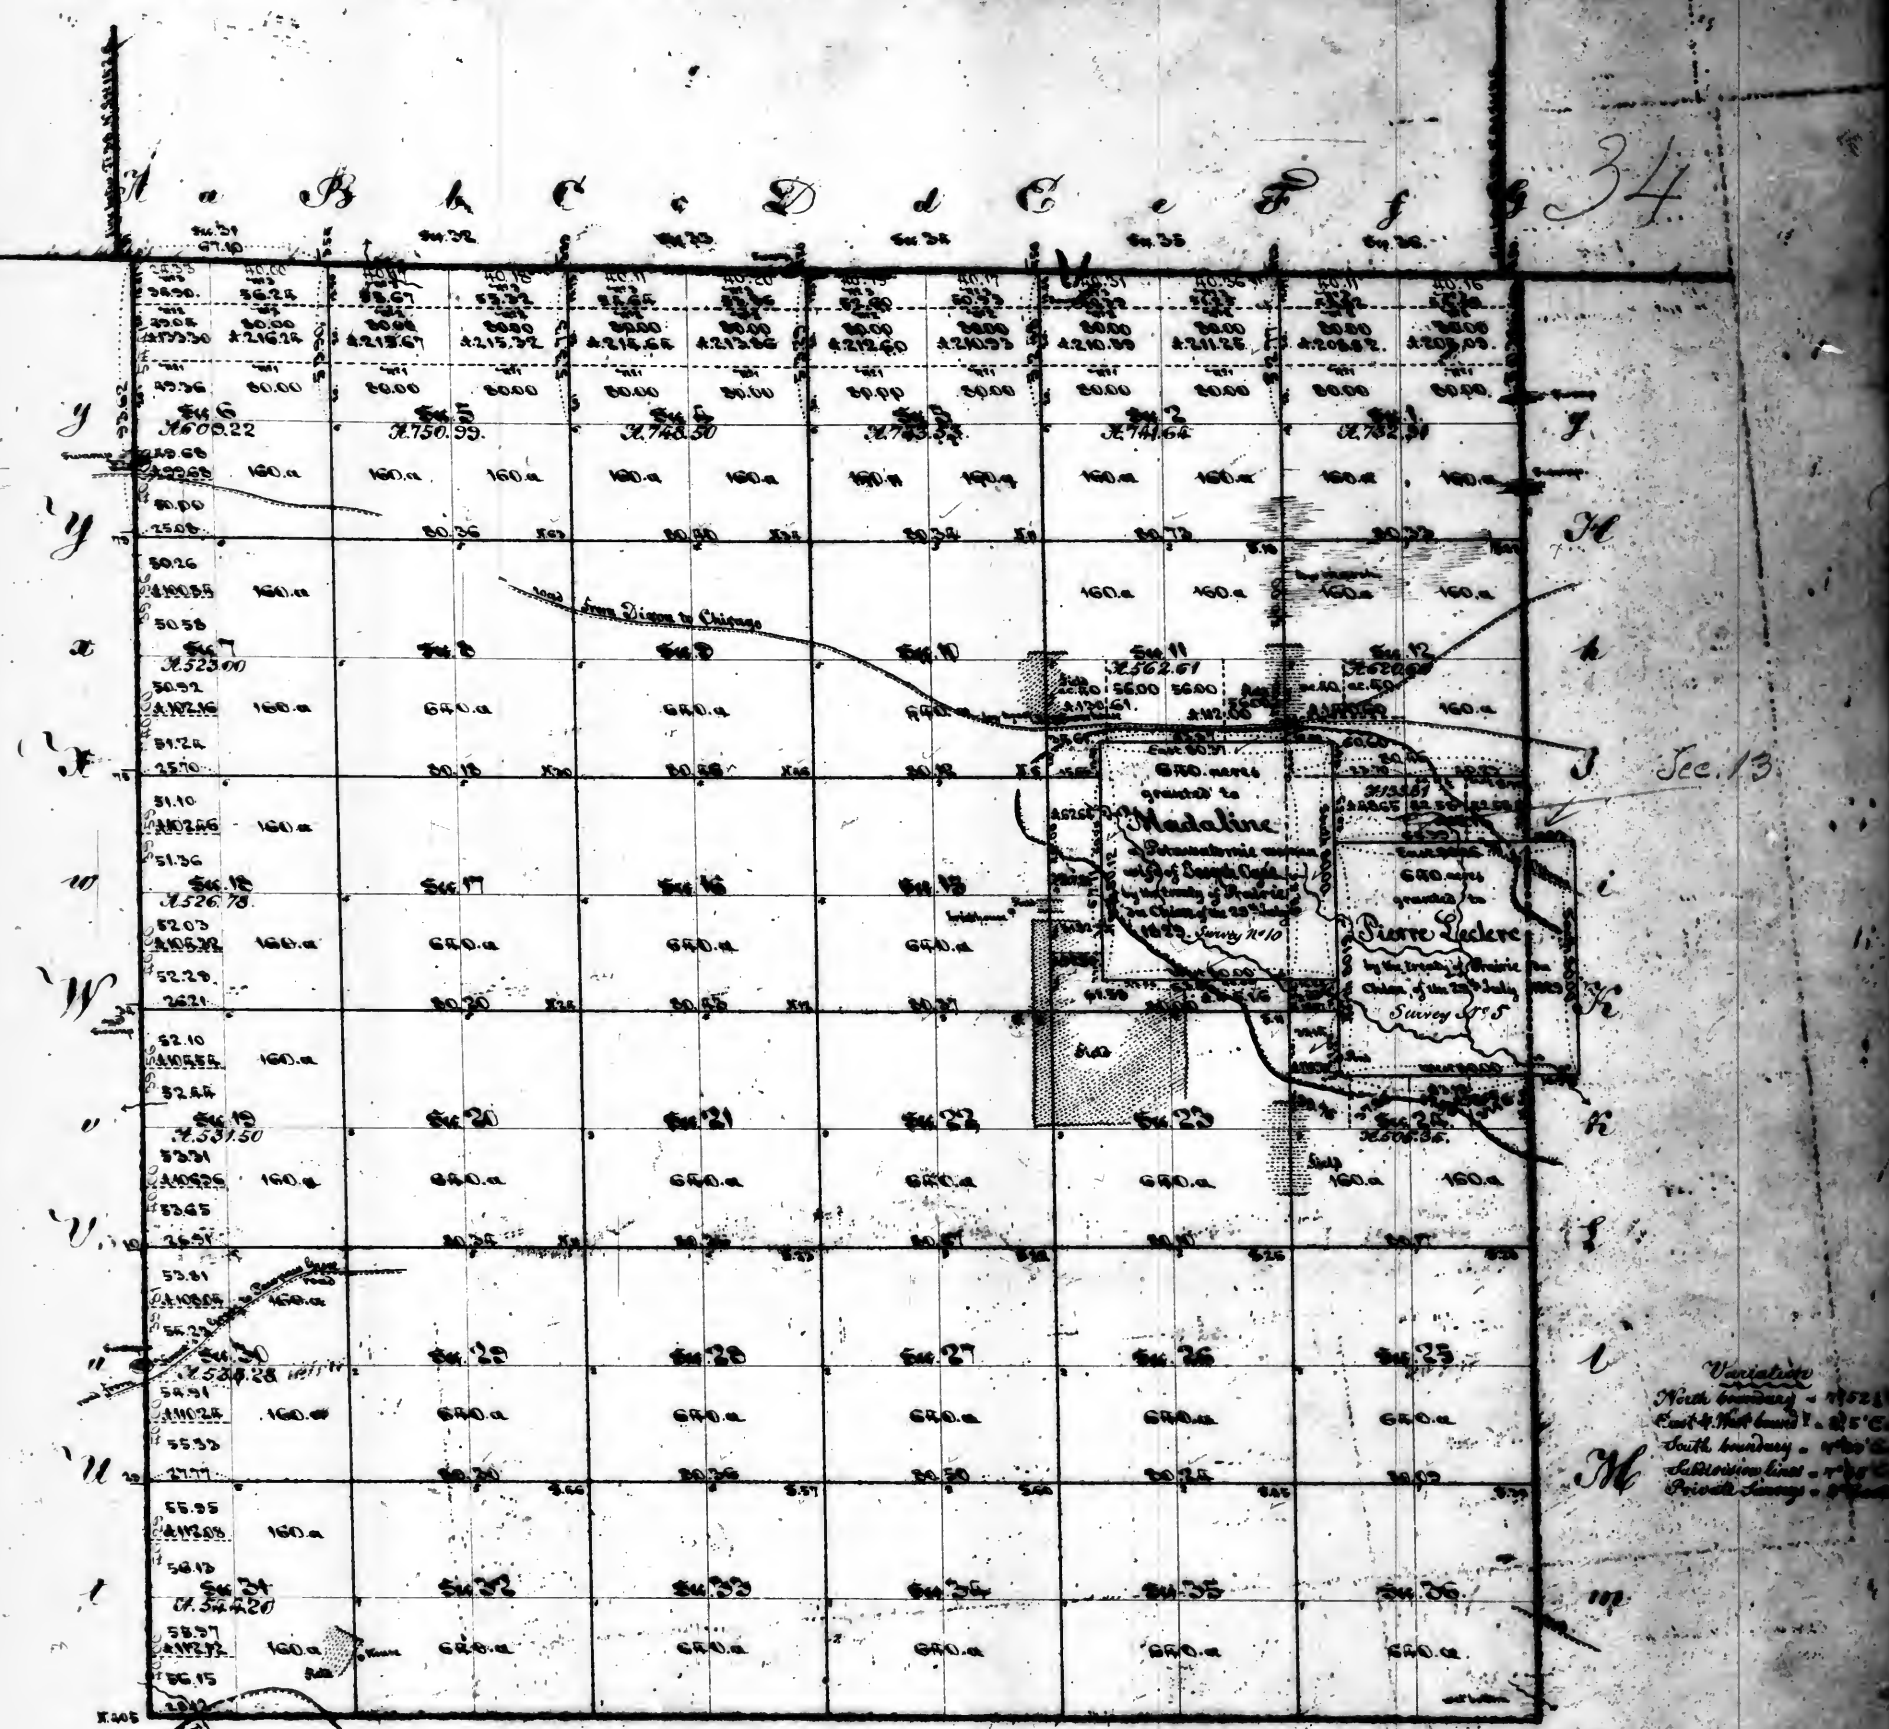


| Lines designated | By whom surveyed | Date of Contract | Amount of surveying miles, chains, links | When surveyed | When paid for | No of vouchers on Sur. Genl. account | Remarks |
|--|------------------|----------------------------|--|---|-------------------------------|--------------------------------------|---|
| Township lines | East boundary | Elw. S. Prescott | 6. 10. 38 | 4 th of 1837 | 3 rd December 1838 | 5 of 4 th of 1838 | |
| | South boundary | do | 5. 63. 12 | do | do | 5. do | |
| | West boundary | do | 6. 13. 62 | do | do | 5. do | |
| | North boundary | do | 5. 65. 29 | do | do | 5. do | |
| Indian grants to Madeline and Pierre Leclerc | A. H. Evans | 10 th May 1836 | | July 1836 | not paid for | | |
| Subdivision lines | G. E. Walker | 20 th Oct. 1842 | 60. 02. 88 | 4 th of 1842 & 1 st of 1843 | 20 th May 1843 | 5 of 2 nd of 1843 | The subdivision includes 5. 64. 18 of surveys on the line of Leclerc's survey and of concessions of the public lines, with the lines of the survey of the two grants. |

Surveyors office.
Saint Louis 30th of May 1843.
The above plat of township 37 north of the base line range 2 east of the 3rd principal meridian is strictly conformable to the field notes of the survey thereof on file in this office, which has been examined and approved.
Silas Reed
Surveyor of the public lands in the State of Missouri.

Township 38 North of the base line Range 2 East of the 3rd principal Meridian.

35

A a B b C c D d E e F f G

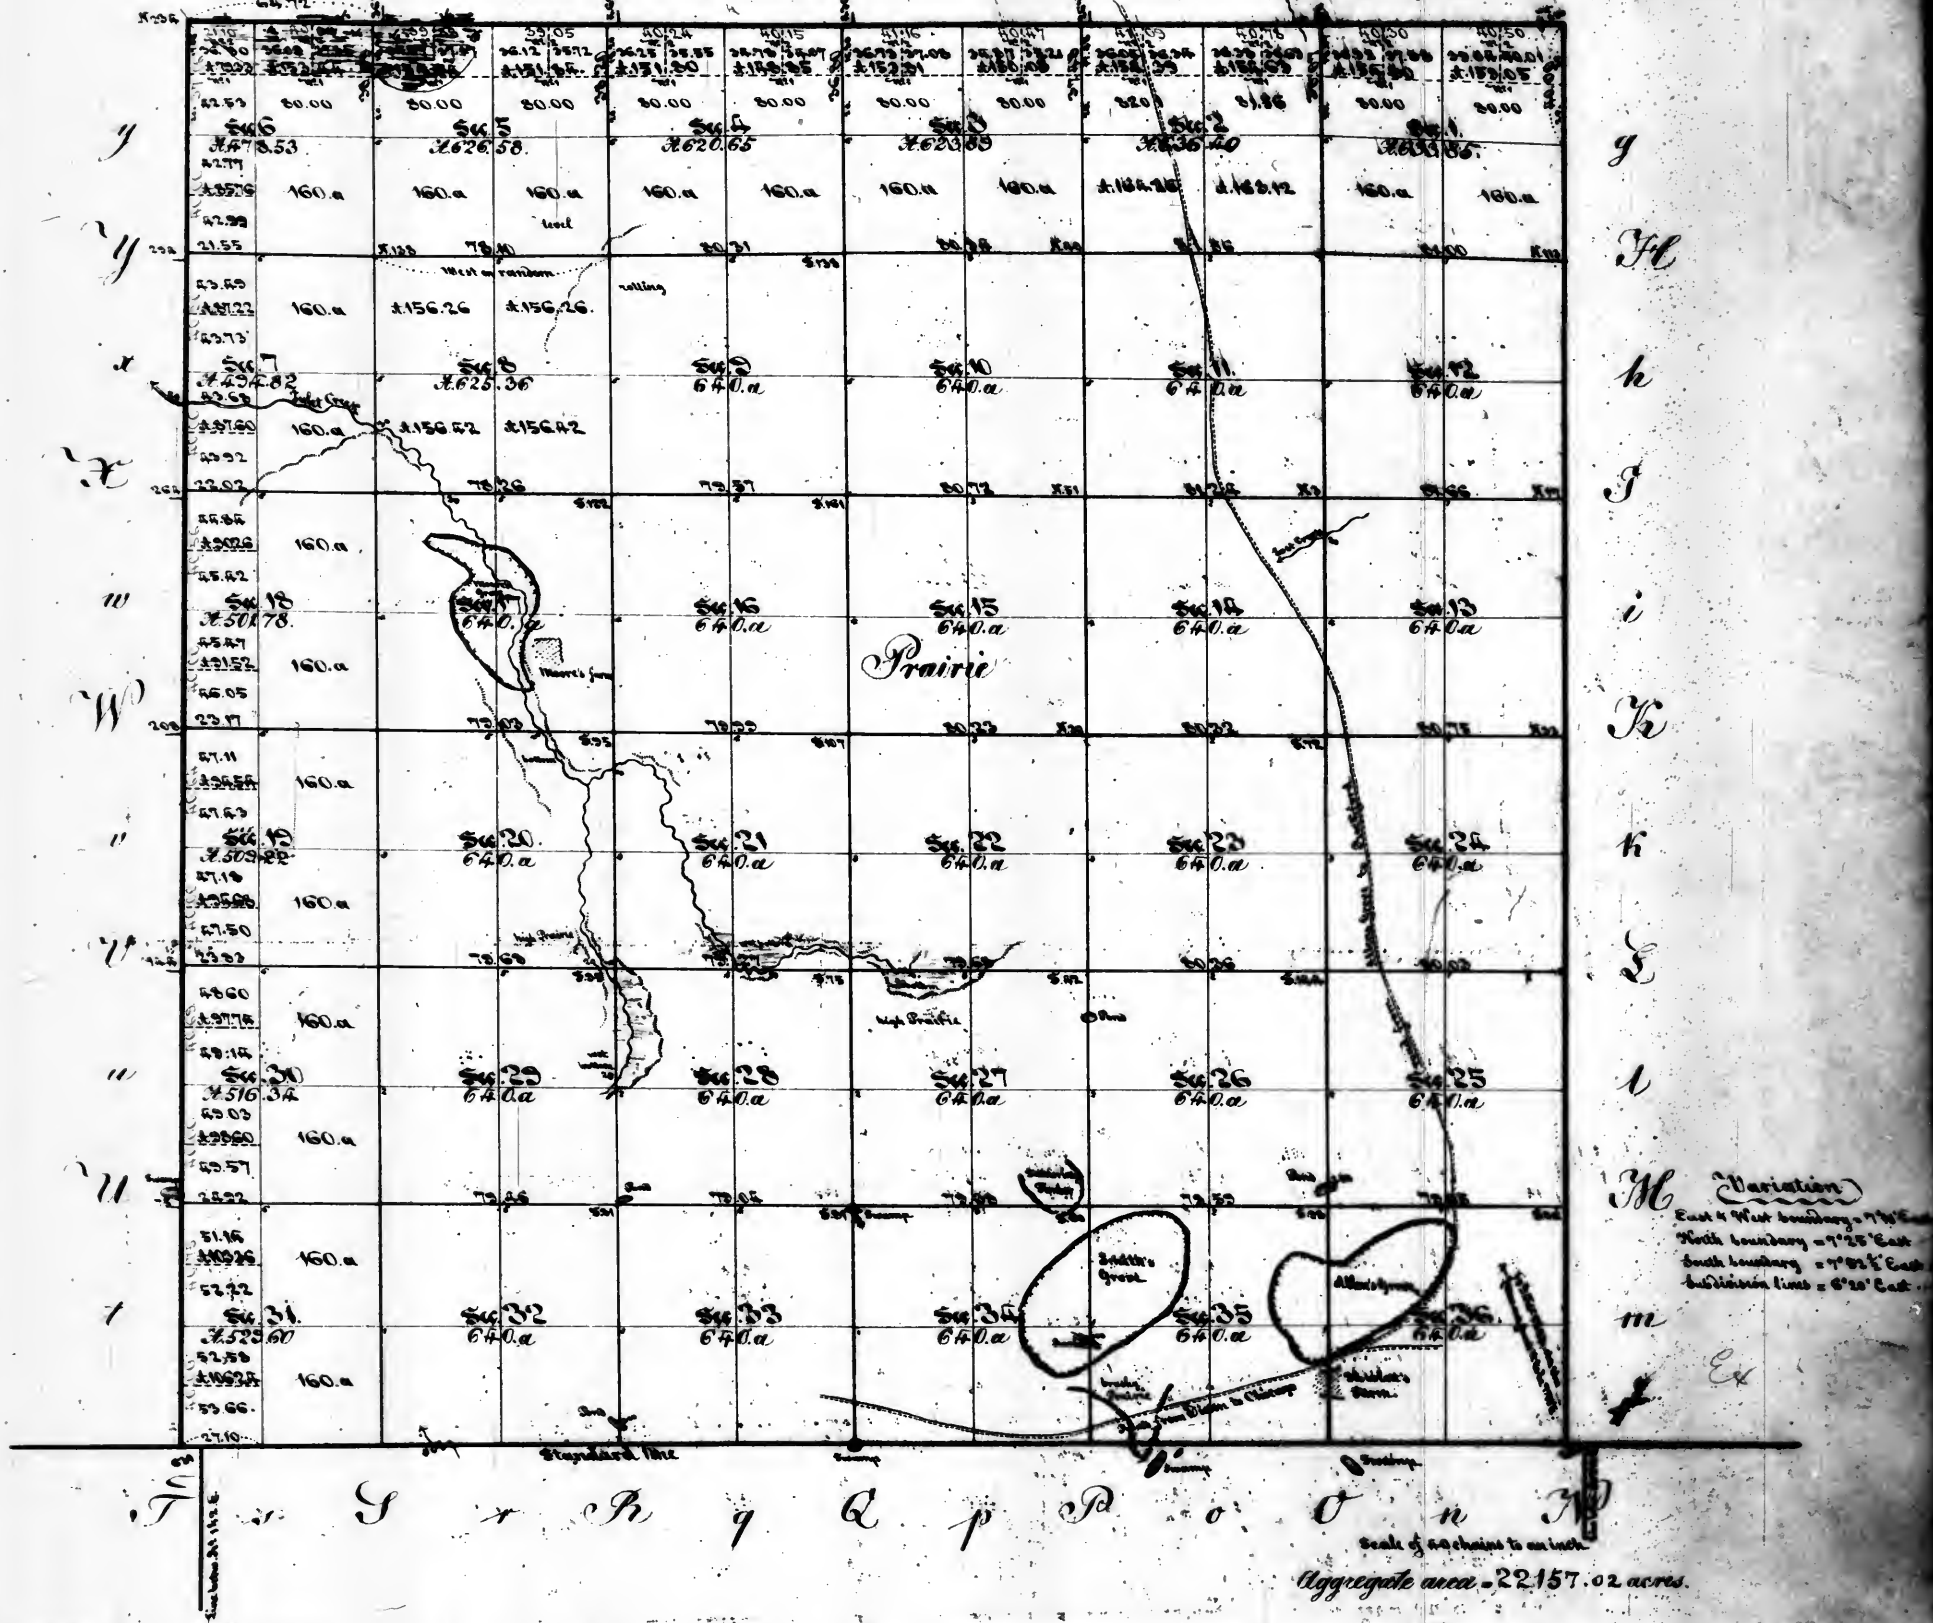


| Designated | By whom surveyed | Date of Contract | Amount of surveying miles, chains, links | When executed | When paid for | N ^o of vouchers in Sur. Gen. account | Remarks. |
|-----------------|---|--|--|---|----------------------------|---|----------|
| South boundary | C. S. Prescott | By S. S. Co. 8 th May 1837 | 5. 27. 10 | October 1837 | 2 nd Dec. 1838 | 5 of 4 th 1838 | |
| W. boundary | C. A. Spaulding | By S. S. Co. 8 th May 1837 | 6. 00. 00 | September 1838 | | | |
| E. boundary | do. | 20 th Sept. 1837 by Spaulding | 6. 00. 00 | October 1838 | 20 th June 1839 | 3 of 2 nd 1839 | |
| North boundary | do. | Spaulding 14 th May 1838 | 5. 64. 72 | Do. | | | |
| Division lines. | George M. Butler & William H. S. Miller | 21 st Oct 1842 | 58. 65. 05 | 1 st 2 nd quarters 1843 | 20 th May 1843 | 6. of 2 nd 1843 | |

Surveyor's office.
Saint Louis 24th of July 1843.
The above plat of township 38 north of the base line range 2 east of the 3rd principal meridian, is strictly conformable to the field notes of the survey thereof on file in this office which have been examined & approved.

Silas Reed
Surveyor General.

Township 39 North of the base line Range 2 East of the 3rd principal Meridian

36

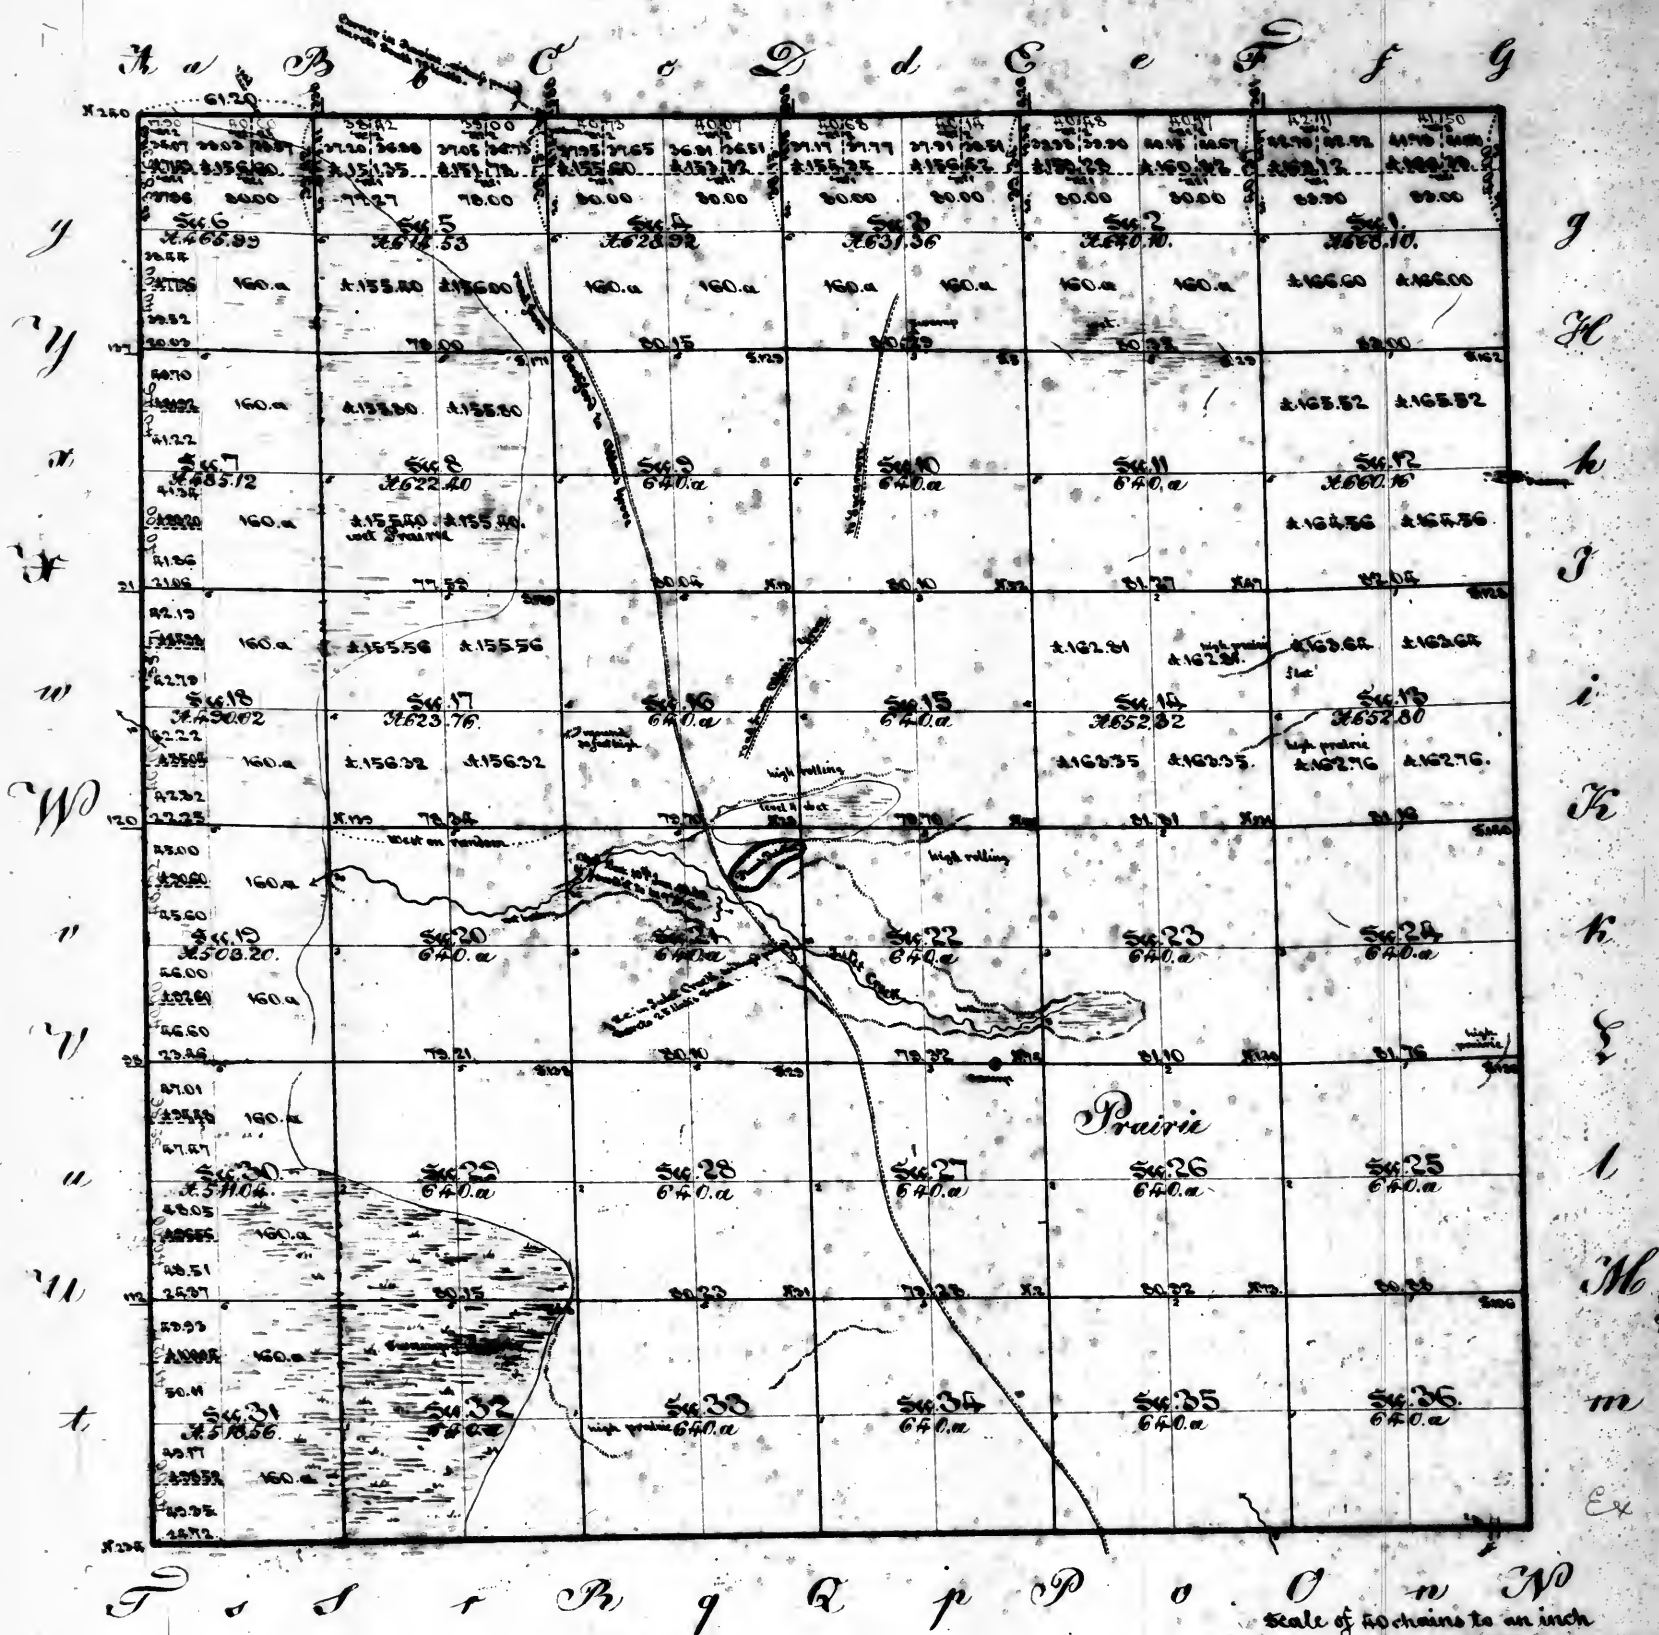

Scale of 40 chains to an inch
Aggregate area = 22,165.28 acres.

| Lines designated | By whom surveyed | Date of Contract | Amount of surveying
miles. chains. links | When executed | When paid for. | No of vouchers in
Surr. General's acct. | Remarks. |
|--|-----------------------------------|------------------------------------|---|---|----------------------------|--|----------|
| Boundary lines
} West boundary
} South boundary
} East boundary
} North boundary | S. A. Spaulding | Contract signed by him | 61.00.00 | Sept. 1838 | 20 th June 1839 | 8 th & 2 nd of 1839 | |
| | | Cont. on 2 nd September | 5.64.72 | October 1838 | | | |
| | | 1837 and by Spaulding | 6.00.00 | | | | |
| | | on 1 st May 1831 | 5.61.30 | | | | |
| Subdivision lines | G. W. Butler & W.
H. S. Miller | 21 st October 1842 | 53.75.69 | Jan ^y 4 th May 1843 | 23 rd May 1843 | 6 th & 2 nd of 1843 | |


Surveyor's office
Saint Louis 24th of July 1843.

The above plat of township 39 north of the base
line, range 2 east of the 3rd principal meridian
is strictly conformable to the field notes of the
survey thereof on file in this office which have
been examined and approved.

Silas Reed
Surveyor General.

Township 40 North, Range 2 East, 3rd P.M.

37

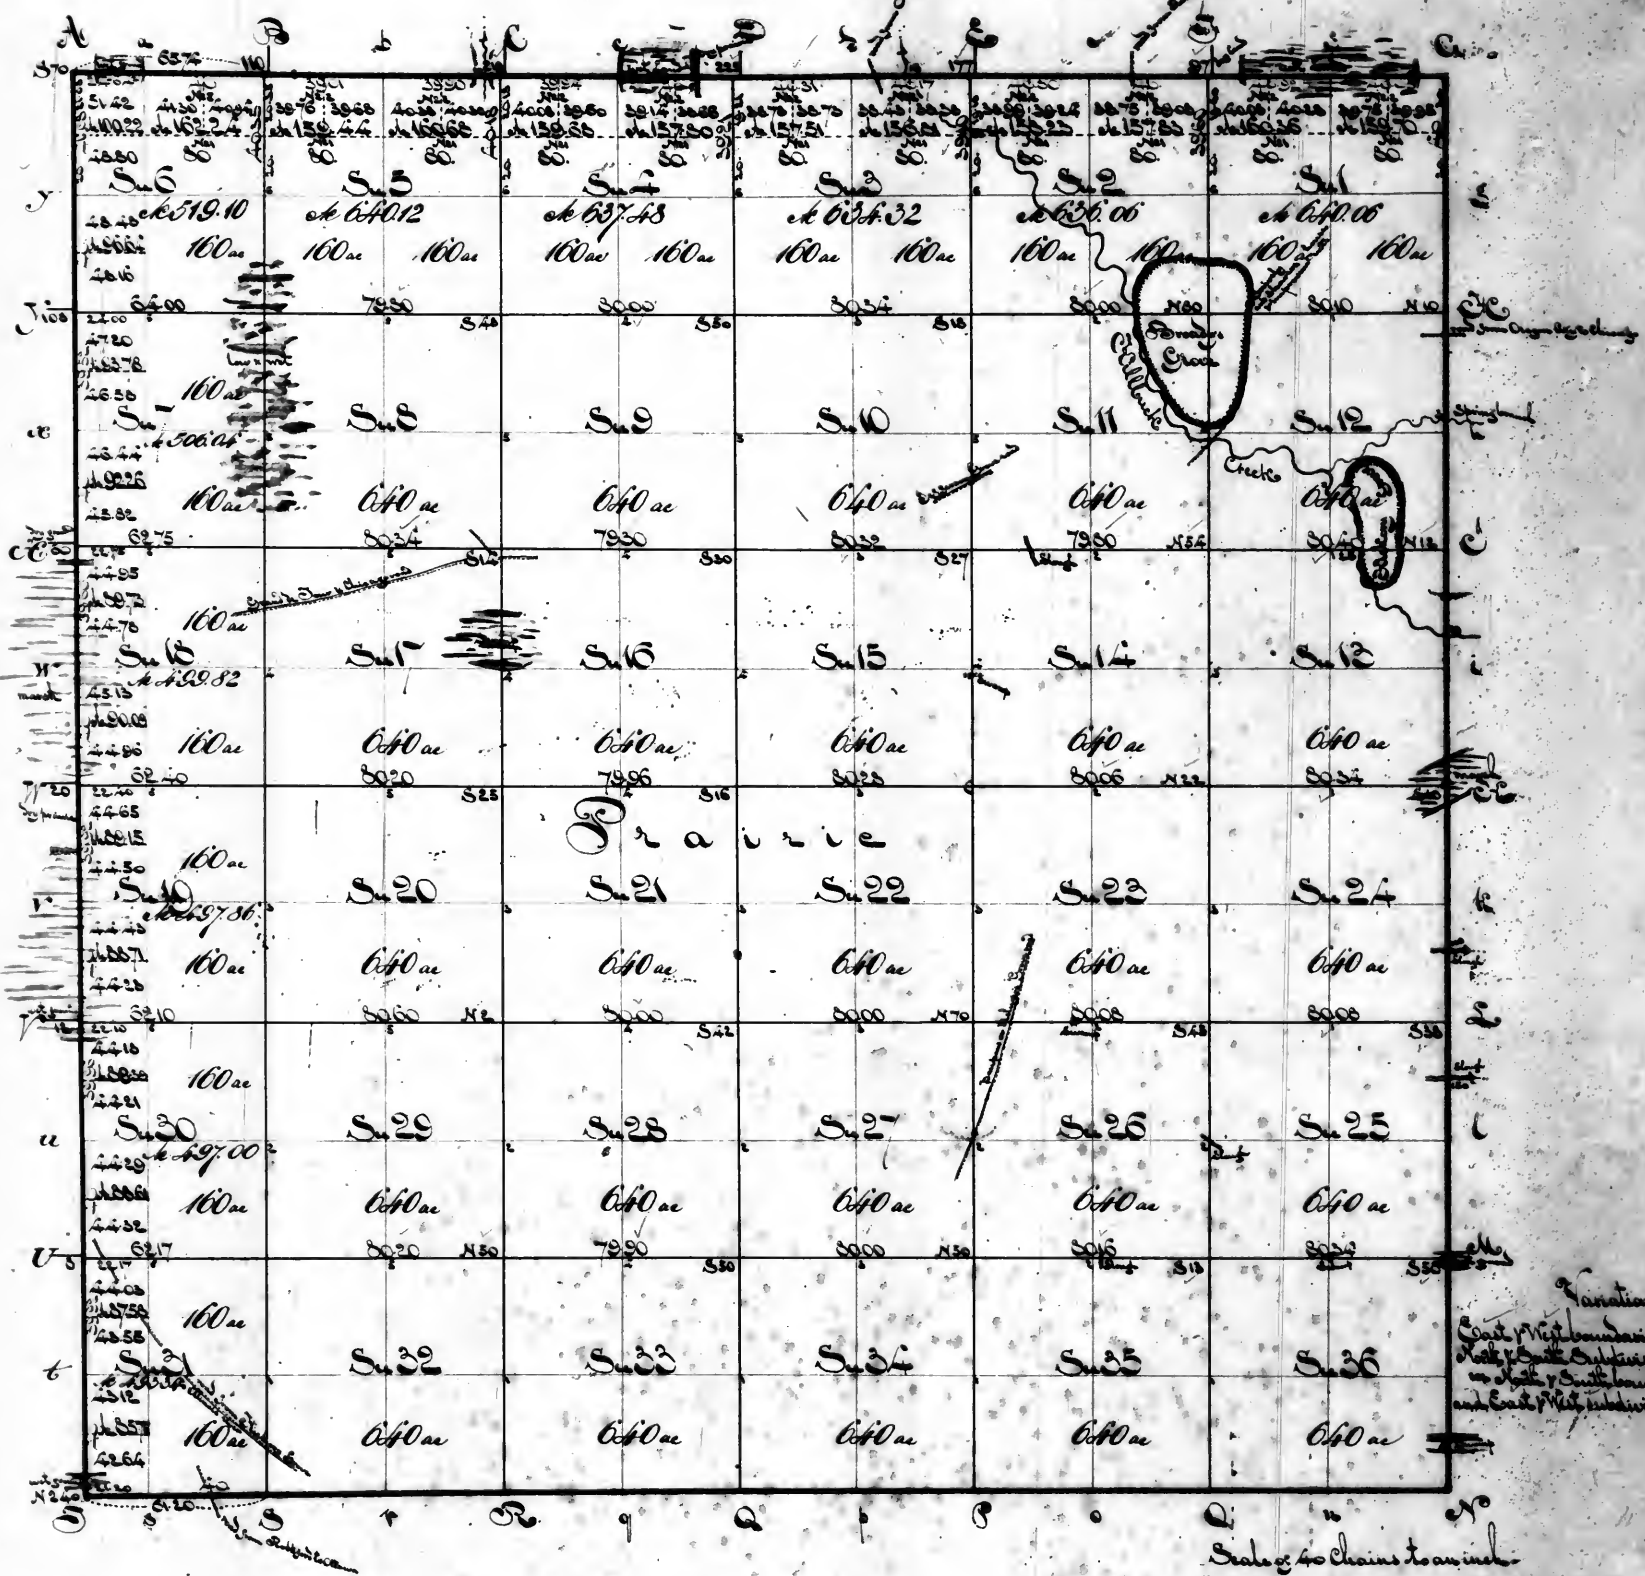


Scale of 40 chains to an inch.
Aggregate Area 22201.25 acres

| Lines designated. | By whom surveyed | Date of contract. | Amount of survey in chains, links | When surveyed | When paid for | N ^o of order in Sur. Gen's account | Remarks. |
|-------------------|--------------------------------|---|-----------------------------------|--|--|---|----------|
| South boundary | G. A. Spaulding | 20 Sept 1837 by Sur. G. 14 th May 1838 by Spaulding. | 5. 61. 20 | 4 th q ^r of 1838 | 2 nd q ^r of 1839 | 3 of 2 nd q ^r of 1839 | |
| East boundary | G. A. Spaulding | do | 6. 00. 00 | 4 th q ^r of 1838 | 2 nd q ^r of 1839 | 3 of 2 nd q ^r of 1839 | |
| North boundary | do | do | 5. 65. 74 | do | do | 3. do | |
| West boundary | do | do | 6. 00. 00 | 3 rd do | do | 3. do | |
| Subdivision lines | R. C. D. West
G. D. Sargent | Joint contract of 26 th October 1842 | 58. 74. 46 | 4 th q ^r of 1842 | 2 nd q ^r of 1843 | 2 of 2 nd q ^r of 1843 | |

Surveyors Office.
Saint Louis 26th May 1843.
The above plat of Township 40 north of the base line range 2 east of the 3rd principal meridian is strictly conformable to the field notes of the survey thereof on file in this office, which have been examined and approved.
Silas Reed
Surveyor of the public lands in the States of Illinois and Missouri.

38.

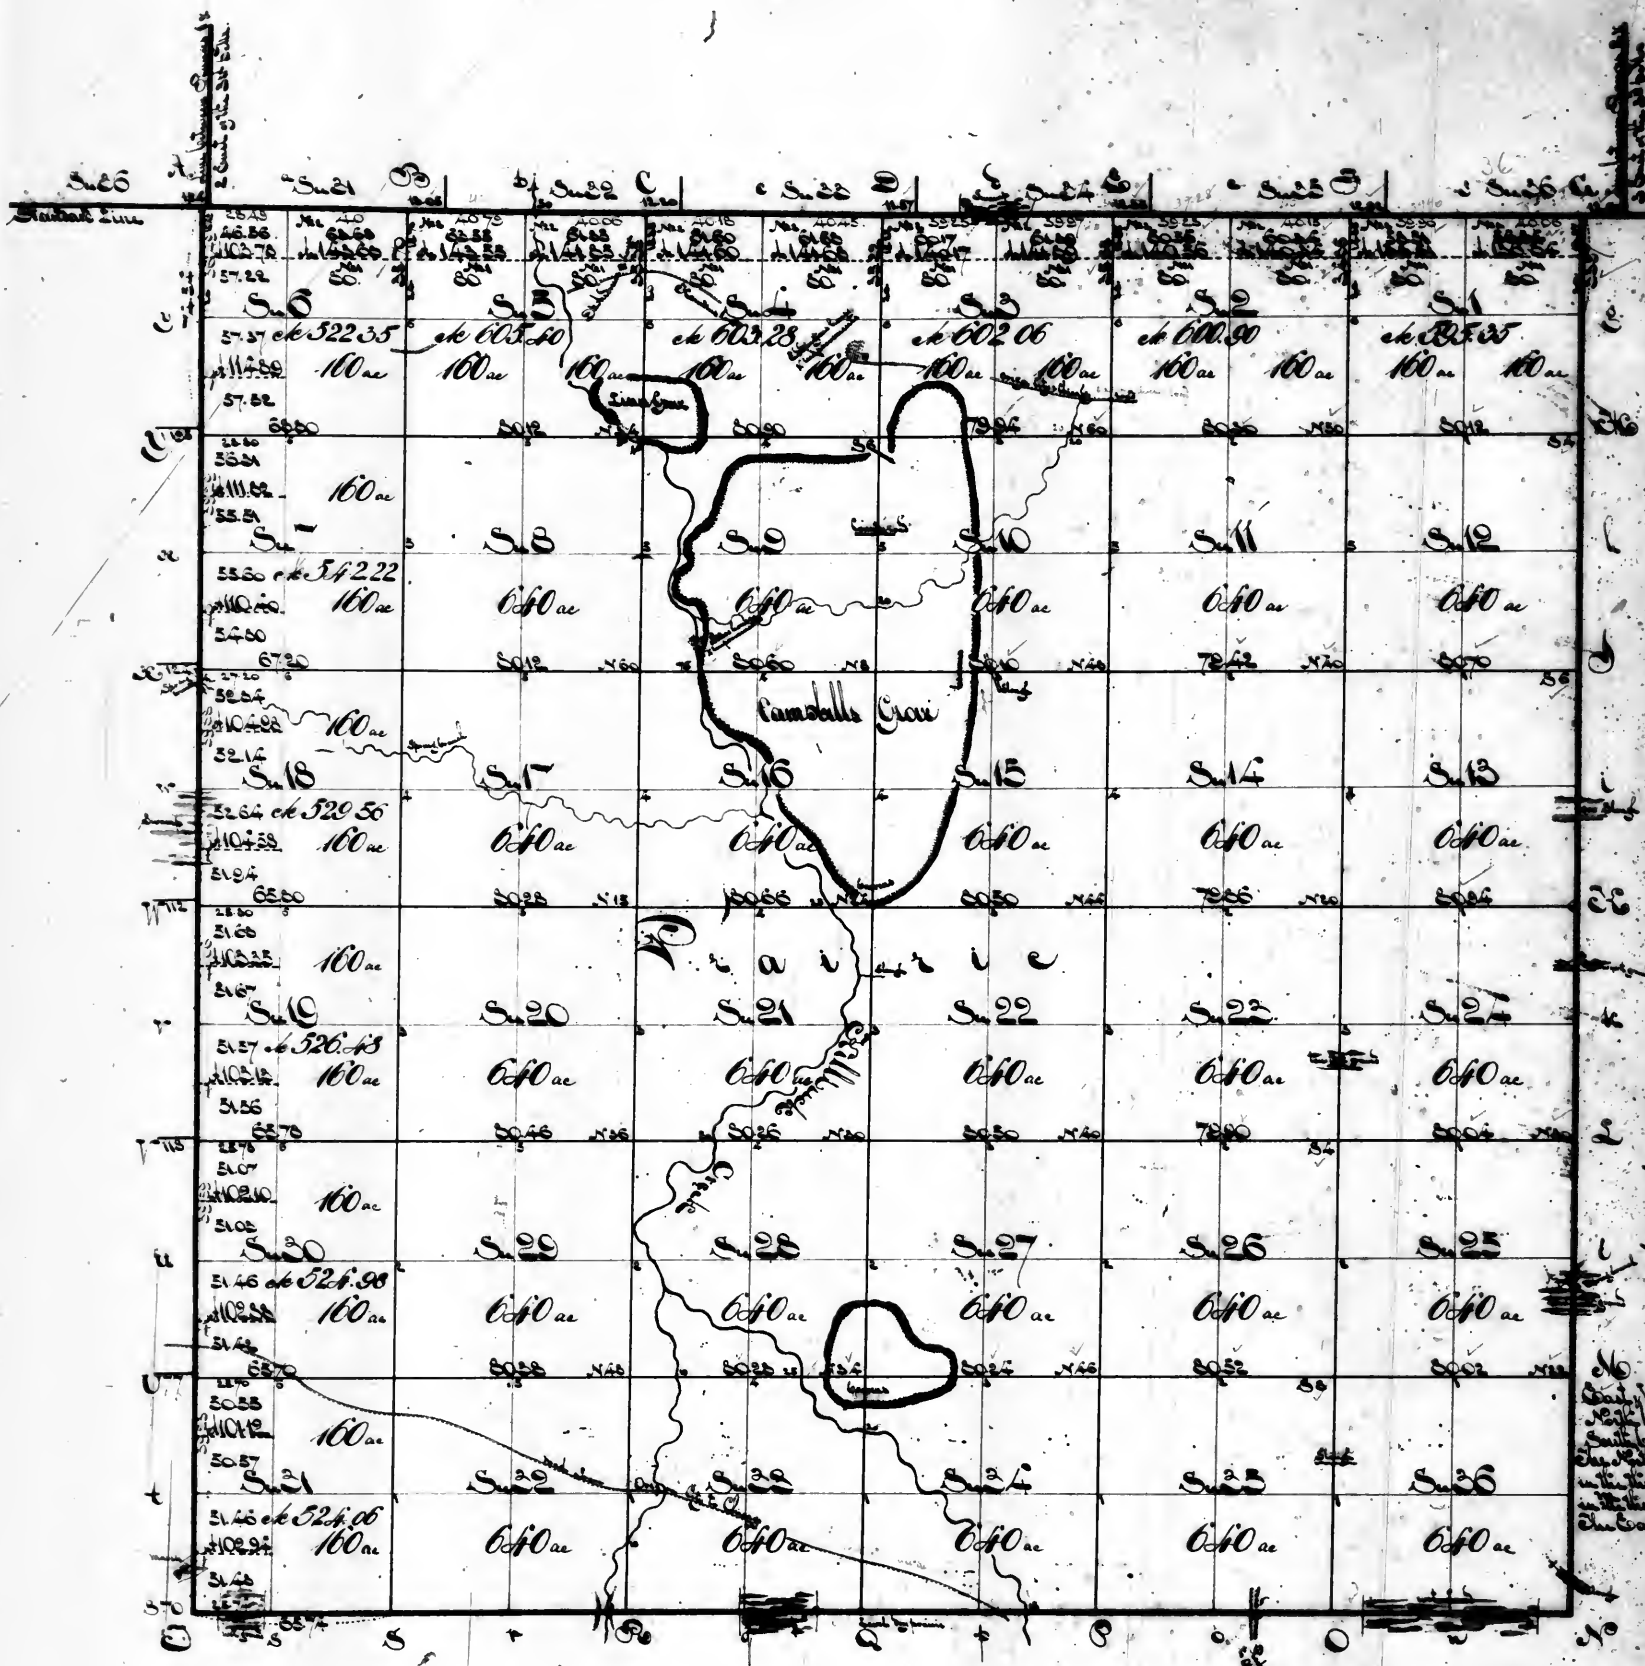

Note: The accounts in which the north boundary of this township is changed, amount to 5.68.64, of which 5.68.64 was paid on the 29th day 1837, and 5.68.64 on the 20th June 1839. The balance \$ 0.00, having been paid by this township for Surveyor General.

Variation
 East of North boundaries
 North boundary
 South boundary
 East boundary
 West boundary
 Subdivision lines
 in the time Southern lines of sections


Scale of 40 chains to an inch
 Aggregate Area 2276.64 ams.

| Lines designated | By whom surveyed | Date of Contract. | Amount of surveying miles, chains, links | When executed | When paid for | No of vouchers in Surveyor Genl's account | Remarks. |
|------------------|--------------------|----------------------------|--|---------------|--|---|--|
| Township lines | North boundary | S. A. Spaulding | 9 th June 1835 | 5. 68. 64 | 4 th quarter of 1835 | 3 rd q ^r of 1837 & 4 th q ^r of 1837 | These parts surveyed in 4 th q ^r 1835 is the N. by E. line, range 2 east of the 3 rd principal meridian, is shown conformable to the field notes of the survey thereon file in this office which have been examined and approved. |
| | South boundary | S. A. Spaulding | 20 Sept. 1837 by S. A. Spaulding | 5. 65. 74 | 4 th q ^r of 1836 | 2 nd q ^r of 1839 | |
| | East boundary | S. A. Spaulding | do | 5. 73. 97 | do | do | |
| | West boundary | do | do | 5. 74. 54 | 3 rd do | do | |
| | Subdivision lines. | R. C. Dent & G. B. Sargent | joint contract of 26 th Oct. 1842 | 58. 77. 12 | 4 th q ^r of 1842 | 2 nd quarter of 1843 | |

Surveyors Office.
 Saint Louis 26th of May 1843.
 The above plat of township 41 north of the base line, range 2 east of the 3rd principal meridian, is shown conformable to the field notes of the survey thereon file in this office which have been examined and approved.
 Silas Reed
 Surveyor of the public lands in the State of Missouri.

Township 42 North of the base line Range 2 East of the 3^d principal Meridian

39

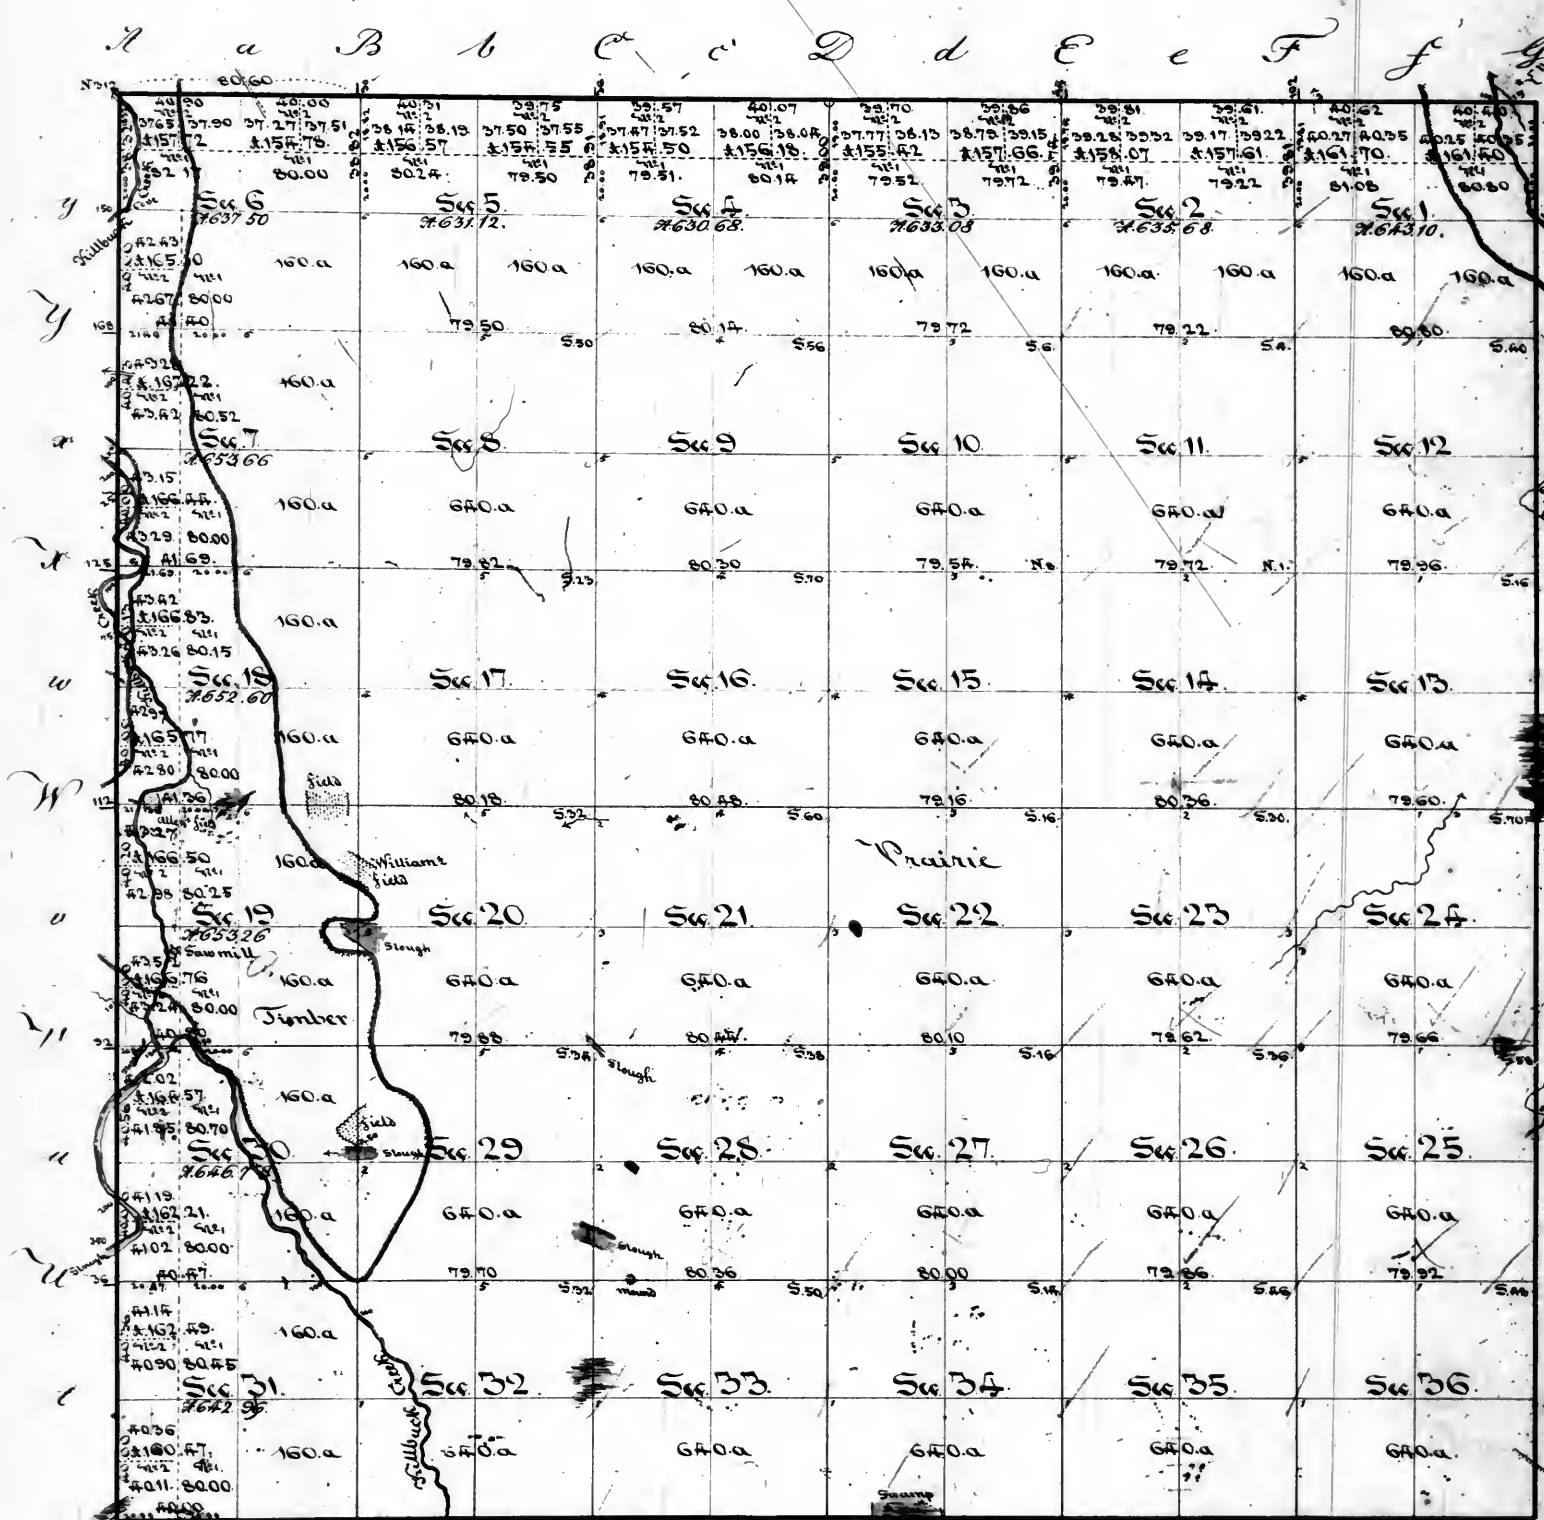

The accounts in which the surveying of this township is charged amount to \$2482.50 of which \$2050.00 were paid by Elias J. Spaulding on the 29th of July 1857, and \$432.50 on the 20th day of June 1858. The balance being \$432.50 having been paid by Elias J. Spaulding to the Surveyor General. See Voucher No. 6 of the Surveyor General's account for the 2^d quarter of 1857, and Voucher No. 7 of the account for the 2^d quarter of 1858.

Variation
 North boundary 7° 25' East
 West - " - 7° 27' East
 South - " - 7° 27' East
 East - " - 7° 5' East
 Subdivision lines 7° 50' East


Surveyor General's Office.
 St. Louis 1st July 1859.

Scale of 40 chains to an inch.
 Aggregate area 23060.42 acres.

The above plat of township 42 north of the base line range 2 east of the 3^d principal meridian is strictly conformable to the field notes of the survey thereof on file in this office which have been examined and approved. The west boundary 6 miles was surveyed in the 4th quarter of 1855 - the south boundary 6 miles the east boundary 6 miles and the north boundary 6 miles and 60 links were surveyed in the 3^d quarter of 1856; all by Wm. A. Spaulding under contract of the 9th of June 1855, and with the limitation noted in the margin were paid for in the 2^d quarter of 1857 and 2^d quarter of 1858, and charges in the account of the Surveyor General for those quarters, Vouchers No. 6 and 7. The subdivision lines 60 miles and 4 links were surveyed in the 3^d quarter of 1858 by W. A. Spaulding, under contract signed by the Surveyor General on the 20th of September 1857, and by the said Spaulding on the 14th May 1858 - they were paid for in the 2^d quarter of 1859 and charges in the account of the Surveyor General for that quarter, Voucher No. 8.

William Milwain
 Surveyor General

Township 43 North of the base line Range 2 East of the 3rd principal Meridian

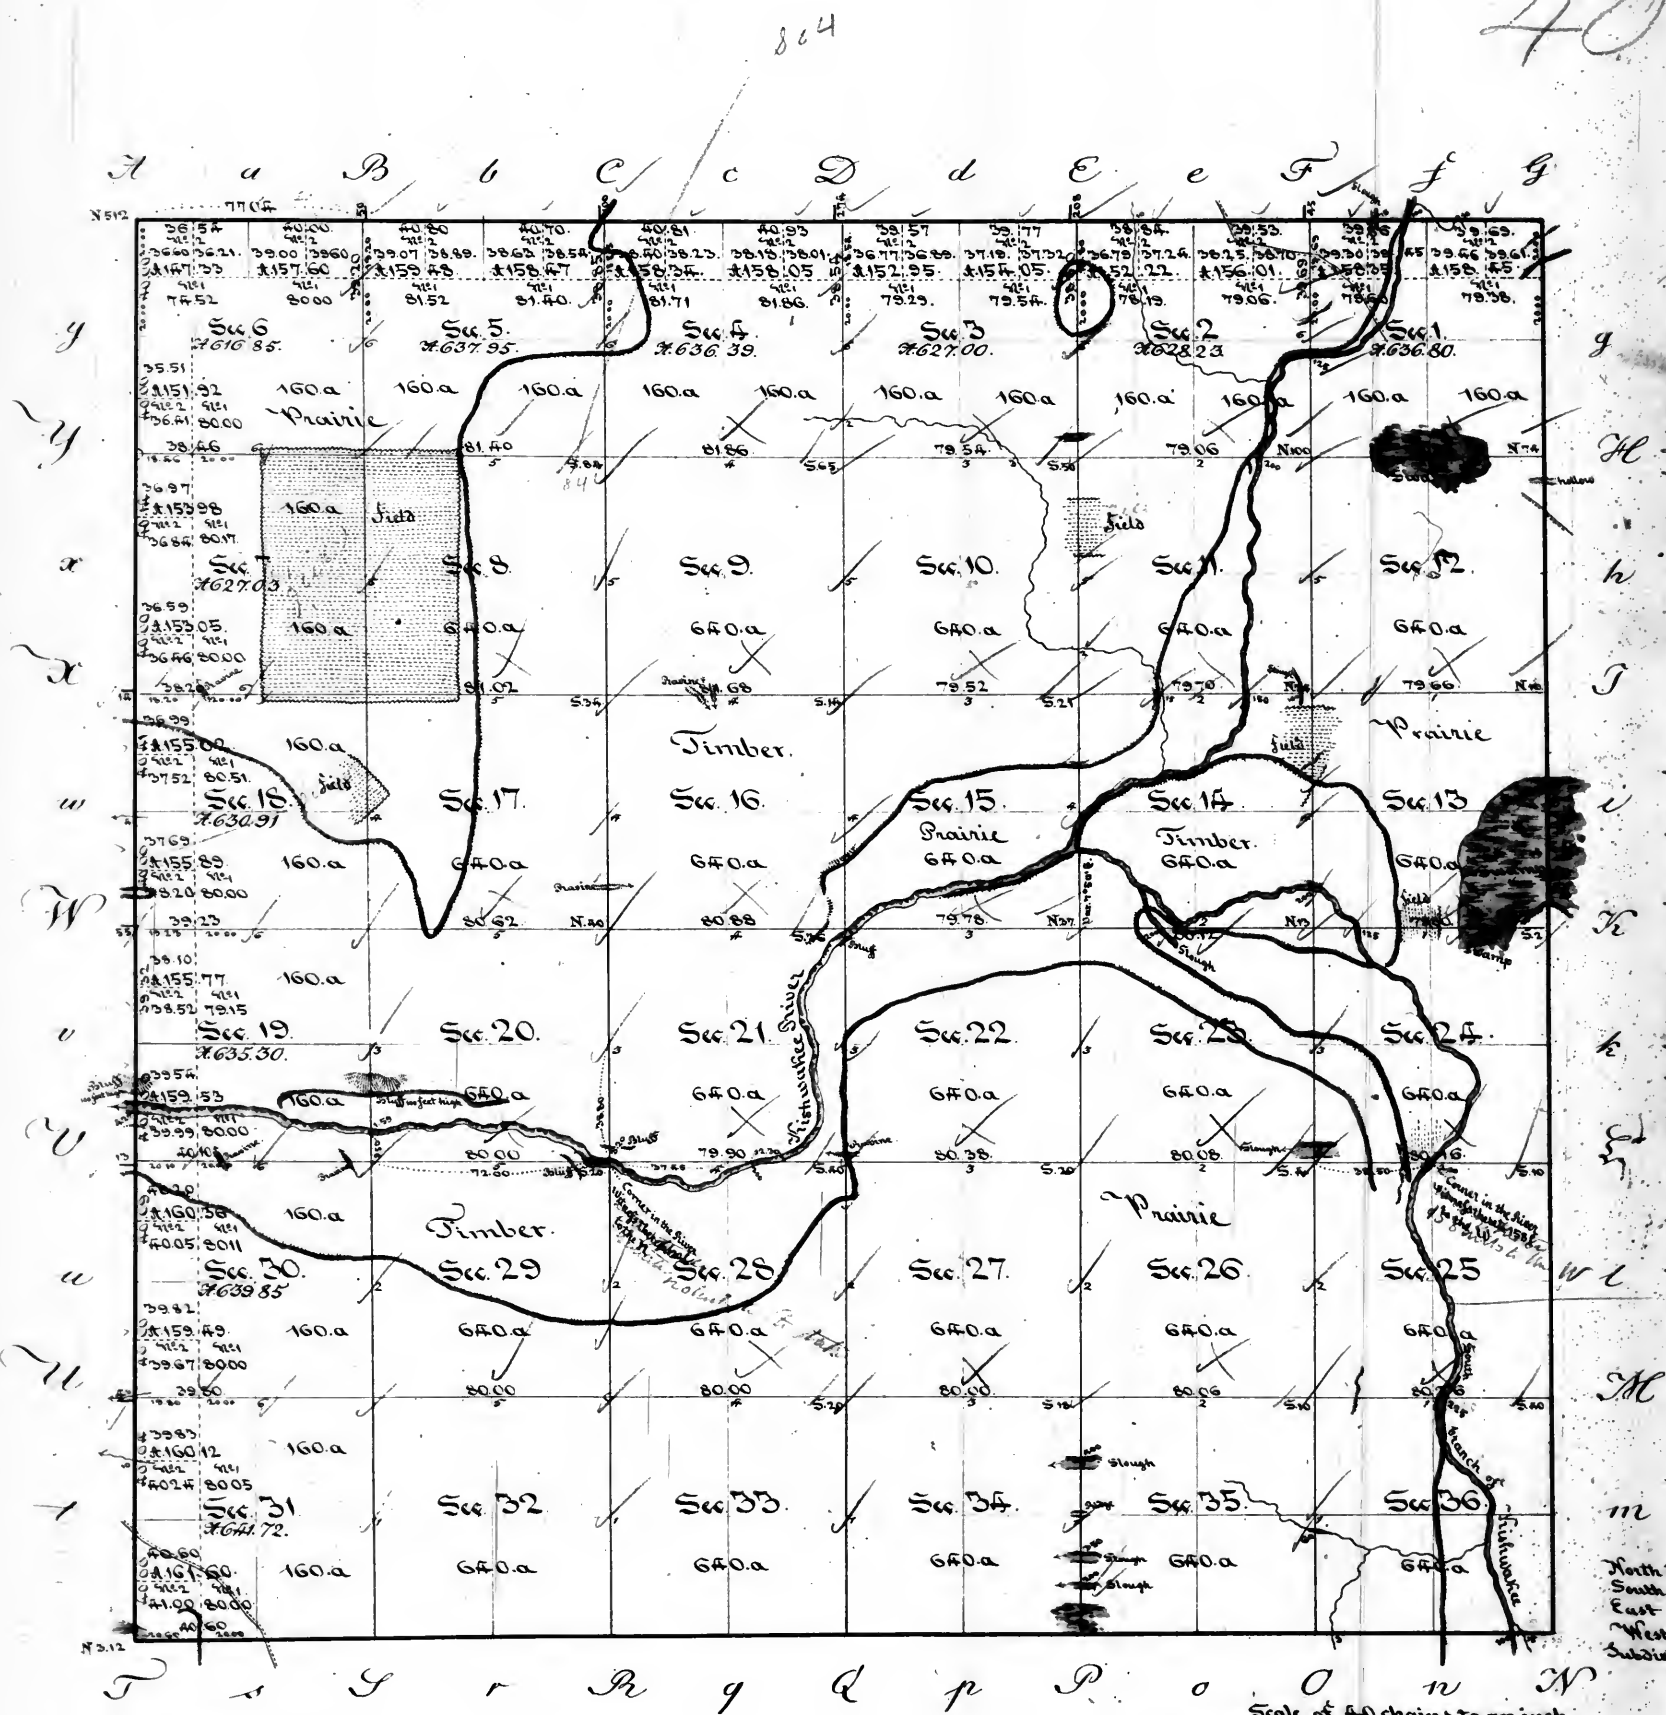

(Note. The accounts which the surveying of this township is charged amount to \$2442.95, of which \$2000 were paid on the 29th of July 1837, and \$242.95 on the 20th day of June 1839 - the balance being \$200 having been paid by Elias S. Longhen for the Surveyor General, on the 20th of September 1837, and Voucher No. 7, of the account for the 2nd quarter of 1839.

Variation
North boundary - 71° 25' East
South - - - 71° 25' East
East - - - 71° 35' East
West - - - 71° East
Subdivision lines - 71° 35' East.


Surveyors Office.
Saint Louis 1st of July 1839.

The above plat of township 43 north of the base line range 2 east of the 3rd principal meridian is strictly conformable to the field notes of the survey thereof on file in this office, which have been examined and approved. The west boundary 6 miles was surveyed in the 4th quarter of 1835, and the South boundary 6 miles and 60 links - the east boundary 6 miles and the North boundary 5 miles 77.04 chains were surveyed in the 3rd quarter of 1836, by Don Lorenzo Spaulding, under contract of the 9th of June 1835; and with the limitation noted in the margin were paid for in the 3rd quarter of 1837 and 2nd quarter of 1839, and charged on the accounts of the Surveyor General for those quarters - Vouchers No. 6 and 7. - the subdivision lines 59 miles 75.73 chains were surveyed in the 4th quarter of 1838 by Don Lorenzo Spaulding, under contract signed by the Surveyor General on the 20th of September 1837 and by the said Spaulding on the 14th of May 1838, they were paid for in the 2nd quarter of 1839 and charged on the account of the Surveyor General for that quarter, Voucher No. 8.

William Milburn
Surveyor General

Township N. 44 North of the Base line in Range N. 2 East of the 3^d principal Meridian.

41

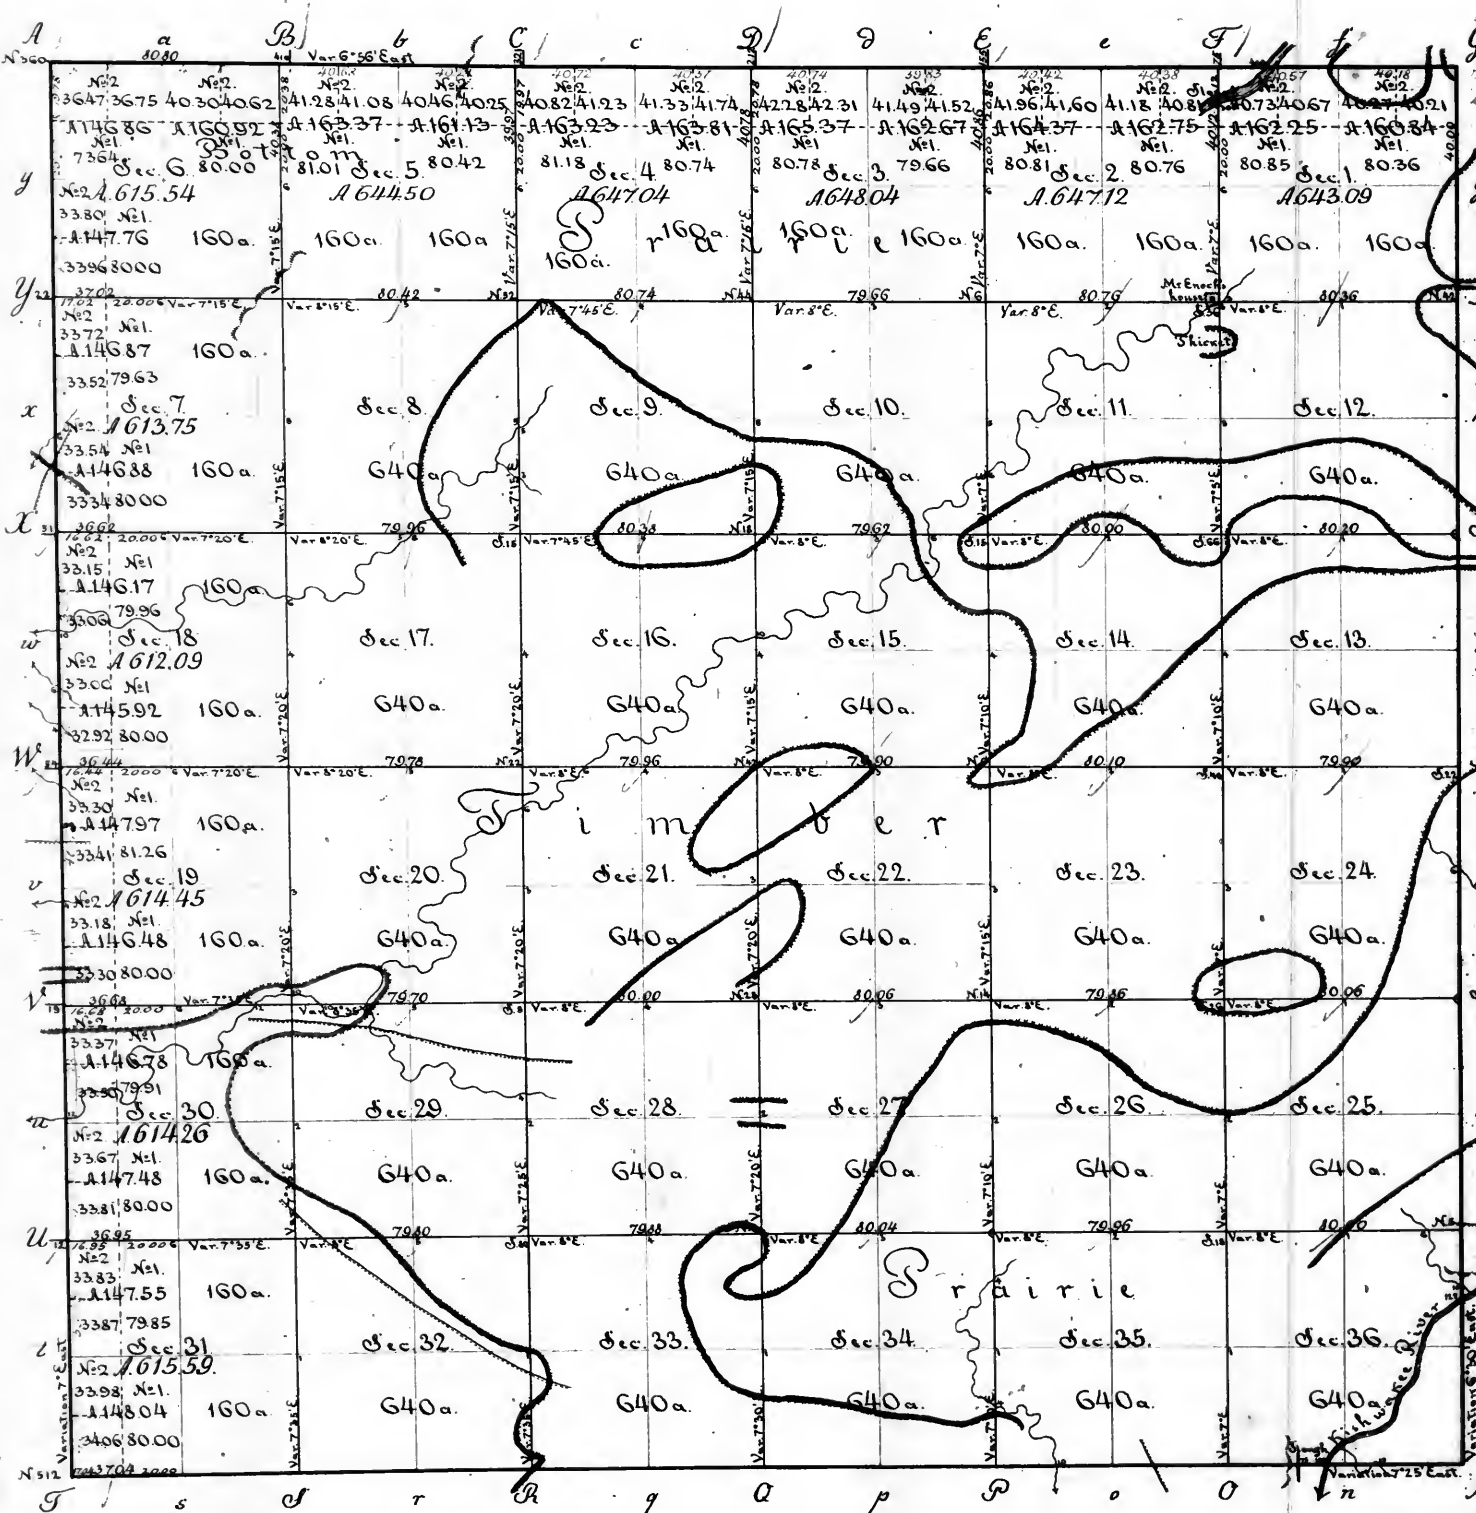


Note: The accounts in which the surveying of this township is charged amount to \$2,443.55, of which \$2050.00 were paid on the 29th of July 1837, and \$493.55 on the 25th day of June 1839. The balance being \$900.00. Having been paid by Elias J. Langham, former Surveyor General. See Voucher No. 6 of the Surveyor General's accounts for the 3^d quarter of 1837, and voucher No. 7 of the accounts for the 2^d quarter of 1839.

Surveyors Office.
Saint Louis 1st of July 1839.


Scale of 40 chains to one inch.
Aggregate Area 22915.47 acres.

The above plat of township 44 north of the base line range 2 east of the 3^d principal meridian is strictly conformable to the field notes of the survey thereof on file in this office, which have been examined and approved. The west boundary 6 miles, was surveyed in the 2^d quarter of 1835 - the South boundary 5 miles 77.04 chains and the east boundary 6 miles were surveyed in the 3^d quarter of 1836 - the north boundary 6 miles and 80 links was surveyed in the 3^d and 4th quarters of 1836 - and the subdivision lines 53 miles 66.38 chains were surveyed in the 1st quarter of 1837 - all by Don Alonso Spaulding under contract of the 9th of June 1835 - and with the limitation noted in the margin they were paid for in the 3^d quarter of 1837 and 2^d quarter of 1839 and charged in the accounts of the Surveyor General for those quarters - Vouchers No. 6 and 7.

William Millwright
Surveyor General

Township N. 45 North of the Base line in Range N. 2 East of the 3^d principal Meridian.

42

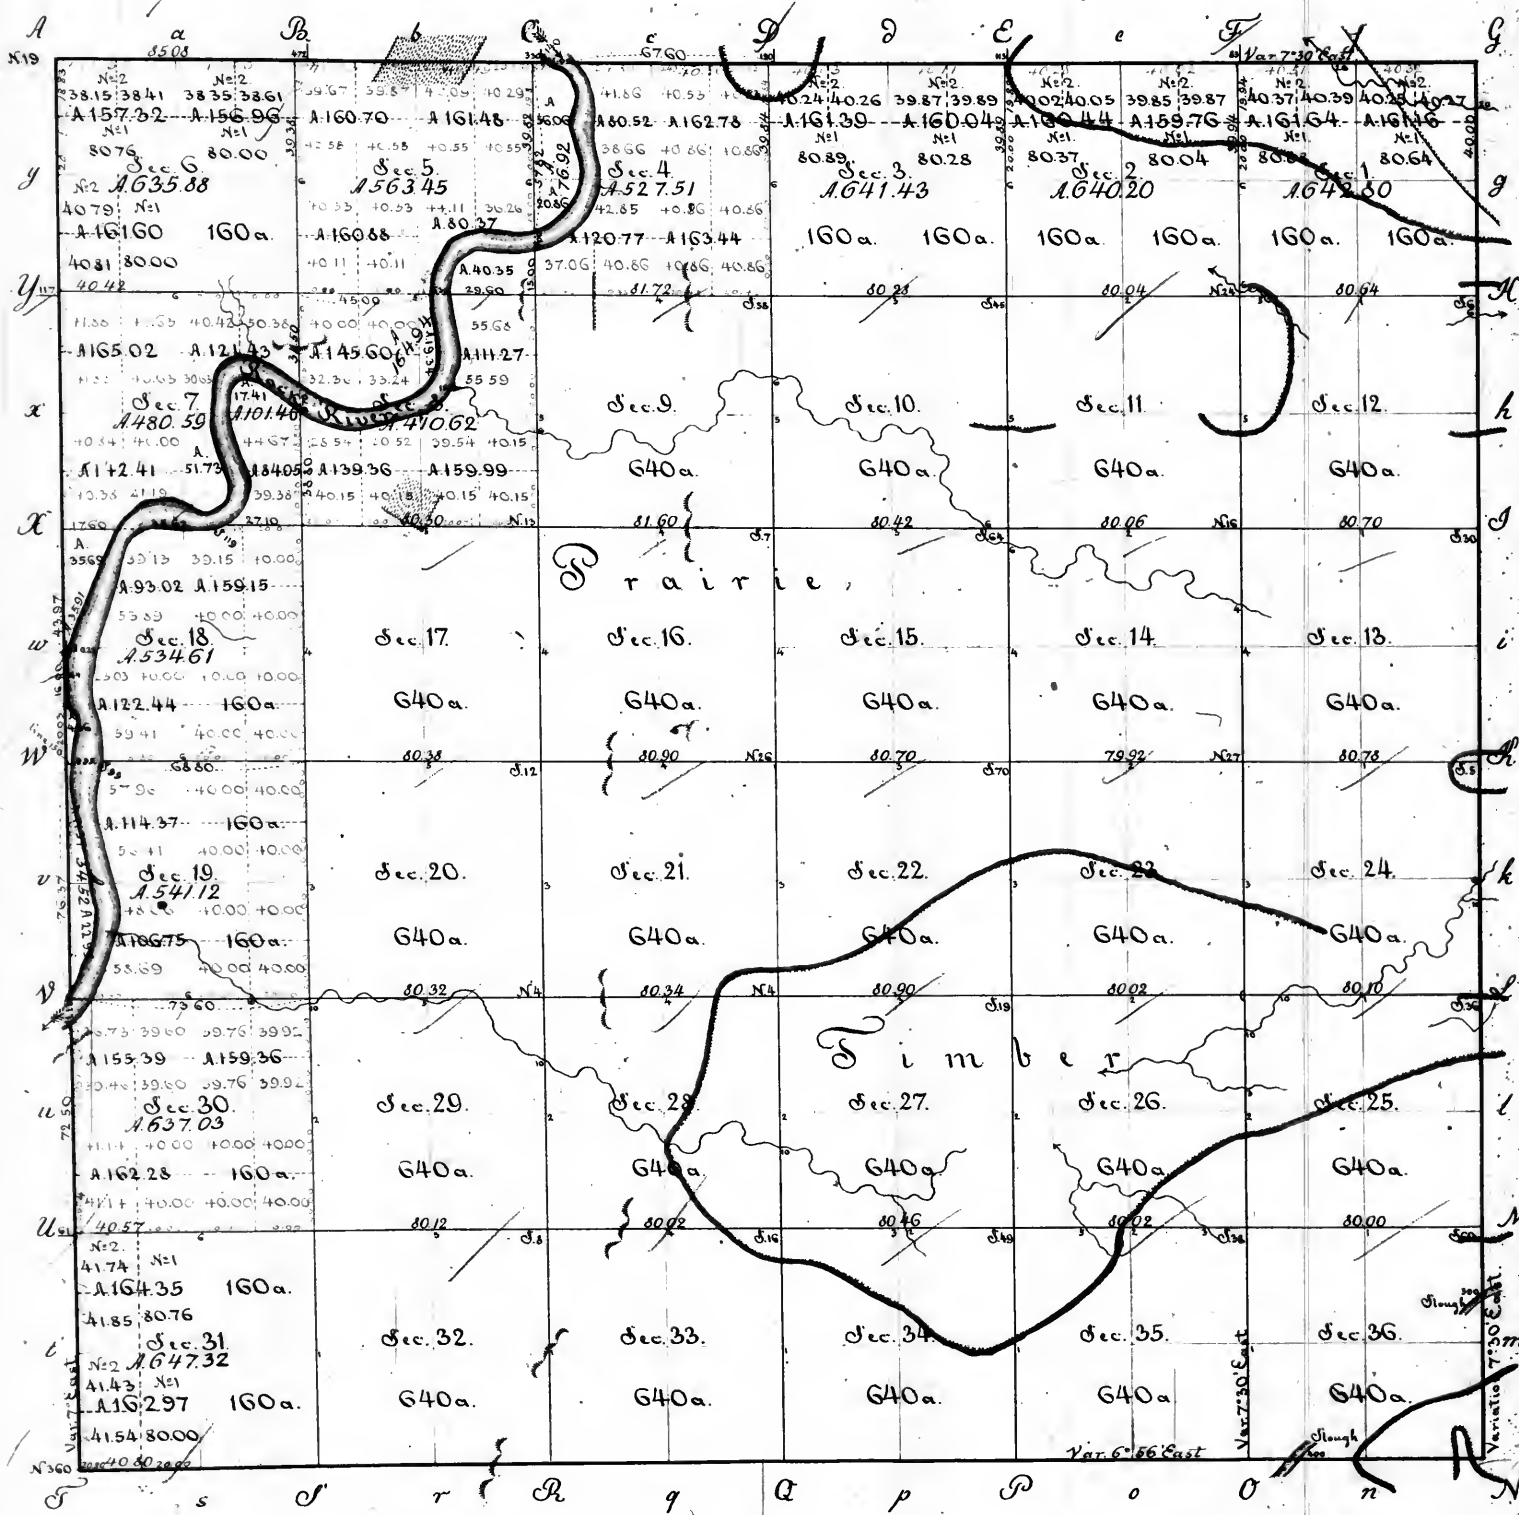

(Note. The accounts in which the surveying of this township is charged amount to \$2,475.36, of which \$2,050.00 were paid on the 29th of July 1837, and \$425.36 on the 20th day of June 1839. The balance being \$200.00, having been paid by Charles J. Langhorne, Surveyor General, in Voucher No. 6 of the Surveyor General's accounts for the 3^d quarter of 1837, and voucher No. 7 of account for the 2^d quarter of 1839.

Surveyors Office.
Saint Louis. 1st of July 1839.

The above plat of township 45 north of the base line range 2 east of the 3^d principal meridian, is strictly conformable to the field notes of the Survey thereof on file in this Office, which have been examined and approved. The west boundary 6 miles was surveyed in the 4th quarter of 1835: the south boundary 6 miles and 80 links was surveyed in the 3^d and 4th quarters of 1836: and the east boundary, 6 miles, the north boundary 6 miles 5.08 chains: the subdivision lines 59 miles 33.80 chains, and the meanders of Rock river 12 miles 11.53 chains were surveyed in the 4th quarter of 1836: all by Don Alonso Spaulding under contract of the 9th of June 1835, and with the limitations noted in the margin. They were paid for in the 3^d quarter of 1837 and 2^d quarter of 1839: and charged in the accounts of the Surveyor General for those quarters Vouchers No. 6 and 7.

Scale of 40 chains to one inch.

Aggregate Area 22,720.72 acres.


William Millburn
Surveyor General

Noted by
Specially, to the above
beam of the Survey
line, 7.55 - the 3^d line
of sections are built
the limits

Township N° 46 North of the Base line in Range N° 2 East of the 3^d principal Meridian.

43

St Louis Dec 1849
The islands in sections 6,
30 & 32 surveyed by James
Langdon in September & October
1849 and one copy of the
plat sent to the Commissioner
and another sent to the
Recorder at St Louis this day

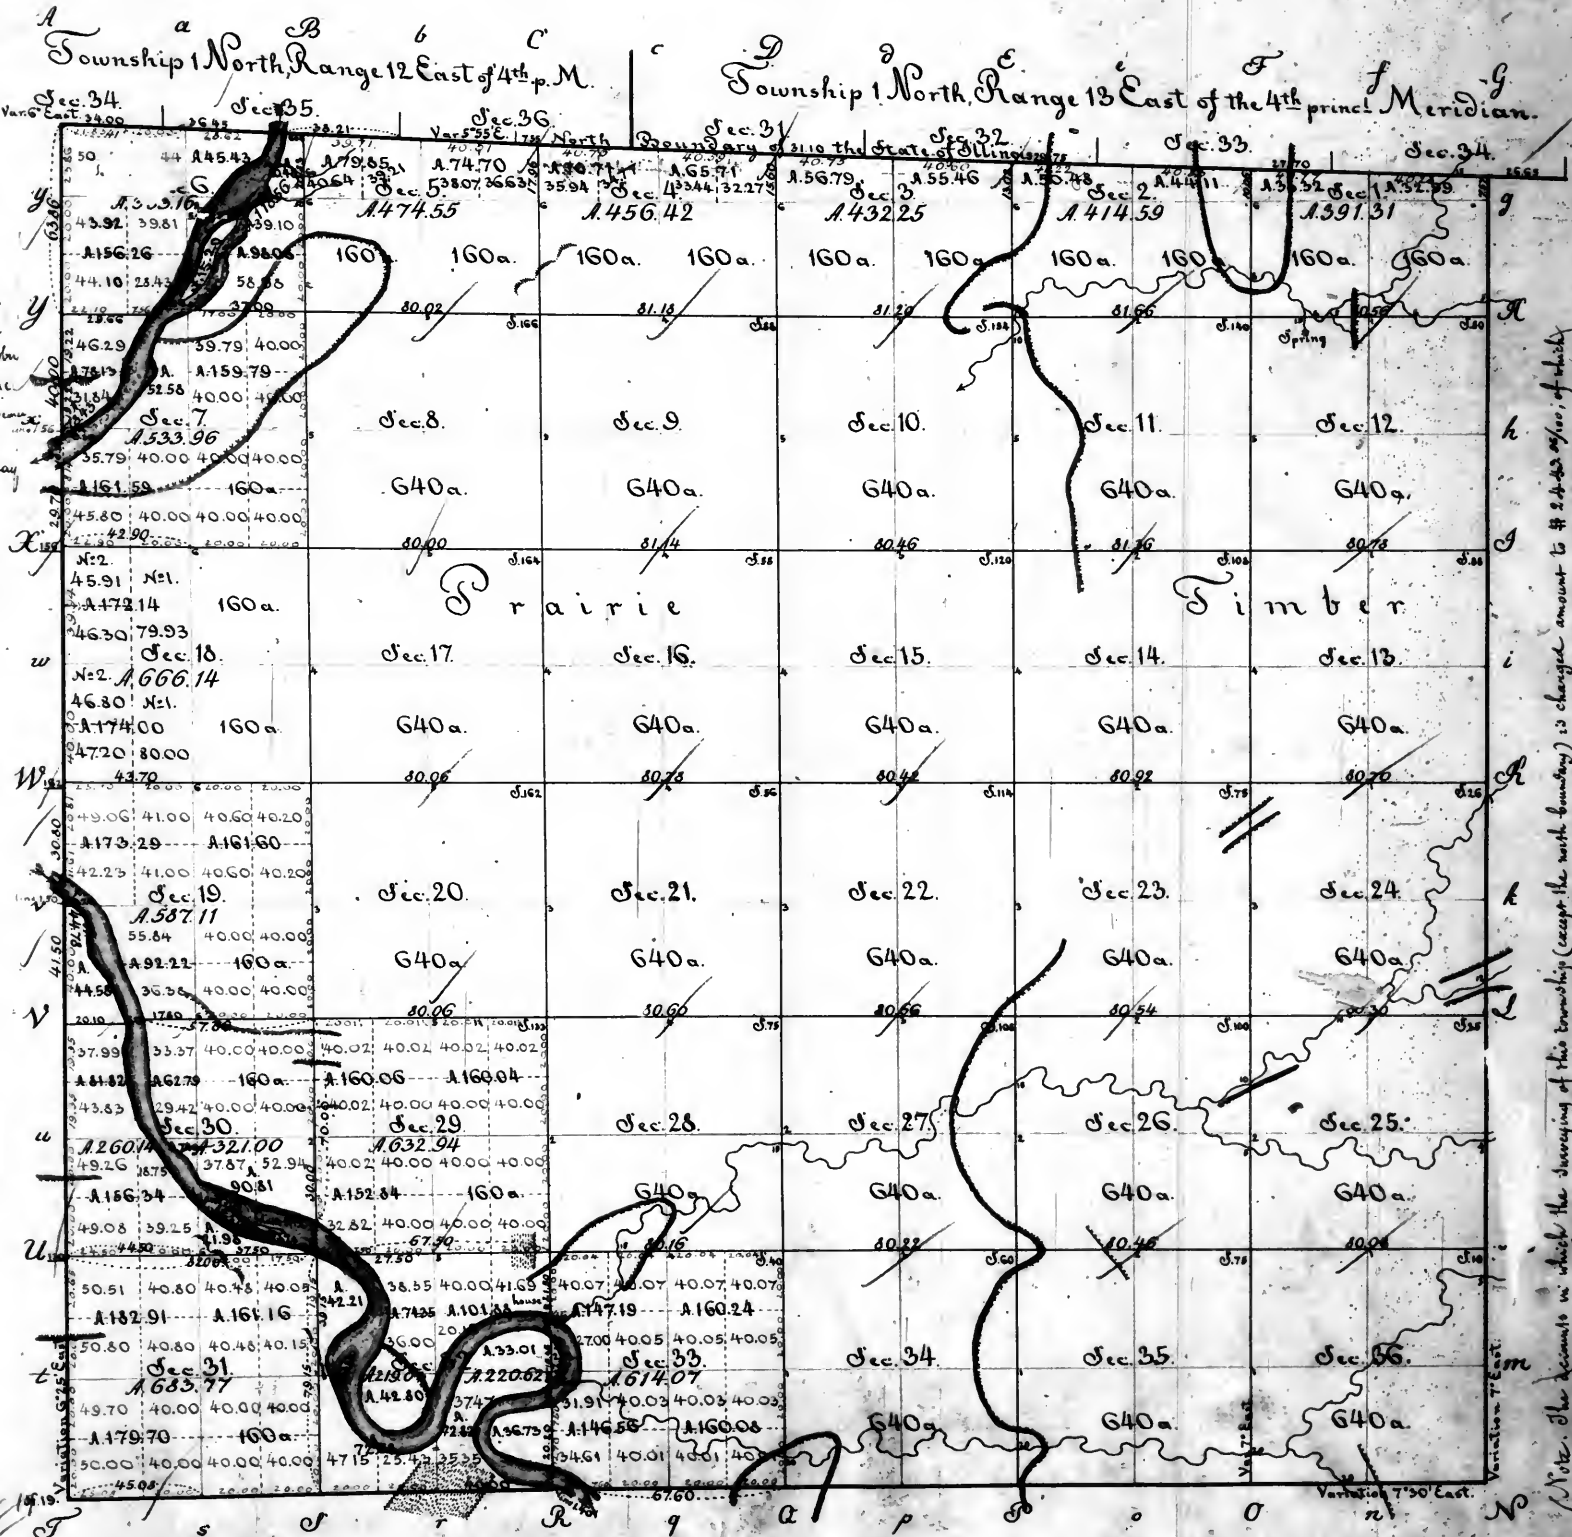

(Note: The amounts in which the surveying of this township (except the north boundary) is charged amount to \$2,423.00, of which \$2,050.00 was paid on the 20th of July 1852 - and \$373.00 on the 20th day of June 1853 - The balance being \$300.00 having been paid by Elias J. Langdon, former Surveyor General - See volume 20 G of the Surveyor General's accounts for the 5th quarter of 1852 and volume 20 G of the account for the 2^d quarter of 1853.

Scale of 40 chains to one inch.


Surveyors' Office.
Saint Louis. 1st of July 1853.

The above plat of Township 46 north of the base line, range 2 east of the 3^d principal meridian is strictly conformable to the field notes of the survey thereof on file in this office, which have been examined and approved - The north boundary 6 miles 7.35 chains was surveyed in 1832 & 1833 by Francis Lyon, Commissioner on the part of the United States, as certified to this office on the 6th of August 1833, by Wm. J. Williams, Surveyor General of Ohio, Indiana and Michigan - The east boundary being a part of the line between Illinois and Michigan, now Wisconsin - The west boundary, 5 miles 63.86 chains was surveyed in the 4th quarter of 1835, and 1st quarter of 1836 - The south boundary 6 miles 5.08 chains - The east boundary 5 miles 47.57 chains - The subdivision lines 58 miles 34.45 chains and the meanders of Rock river 14 miles 17.24 chains, were surveyed by Don Adams Spaulding, in the 4th quarter of 1836 - under contract of the 9th of June 1835, and the surveys by Spaulding, were, with the limitation noted in the margin paid for in the 3^d quarter of 1837, and 2^d quarter of 1839, and charges in the accounts of the Surveyor General for those quarters, Vouchers N° 6 and 7.

William Williams
Surveyor General

Township 26 North of the base line, Range 3 East of the 3rd principal Meridian.

44

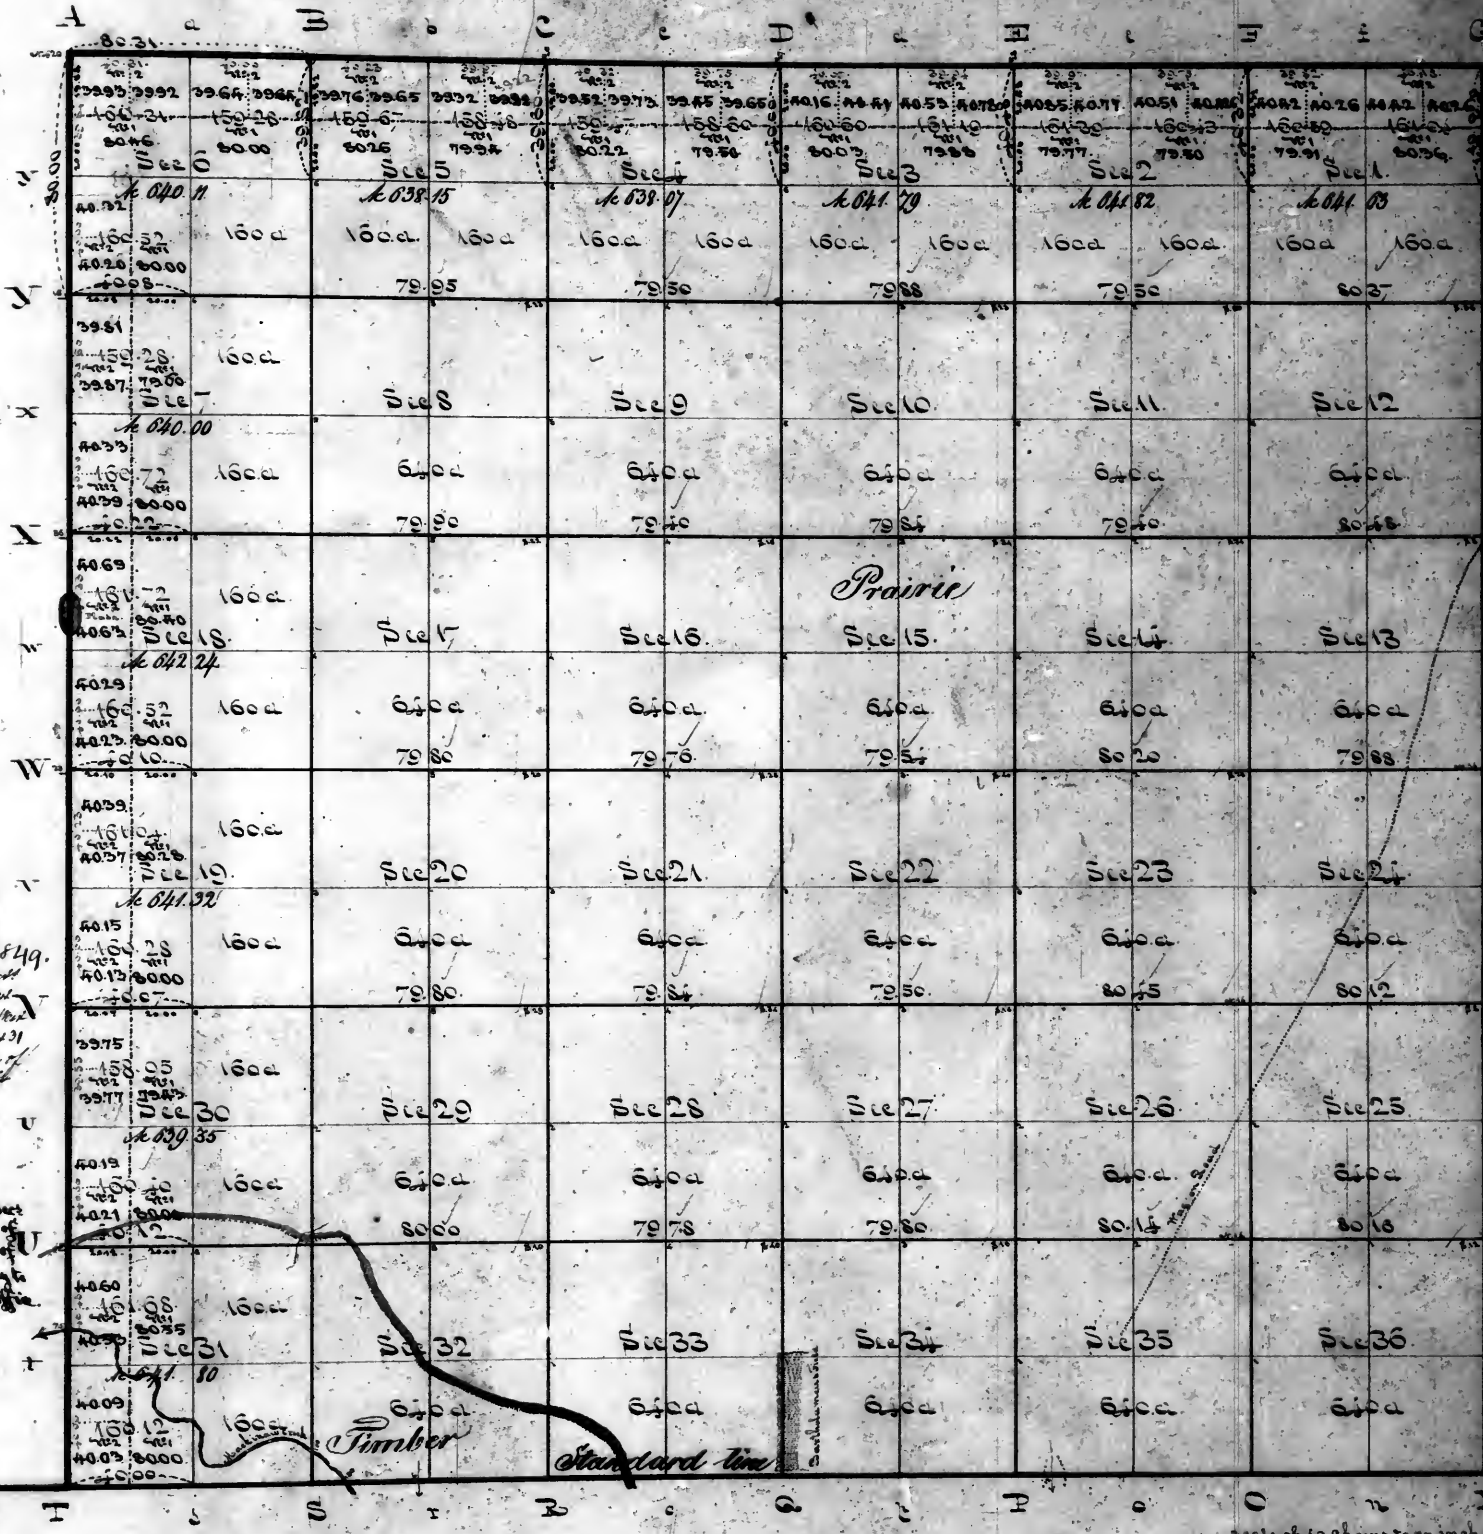

Surveyor's Office
St. Louis 15th Sept. 1849.
Plat of the North halves of Sects 1, 2, 3, 4, 5 & 6, of the South West 1/4 of Section 36, and of the North halves of Sects 7, 8, 9, 10 & 11, sent this day to the Register of the Land Office at St. Louis.

Surveyor's Office
St. Louis 15th Sept. 1849.
Plat of the North halves of Sects 12, 13, 14, 15, 16, of the S.W. quarter of Sect 6, and of the West halves of Sects 7, 8, 9, 10 & 11, sent this day to the Register of the Land Office at St. Louis.

K Return to the field notes and construction of this Plat of the South boundary, dated 25th 1832, not signed of the West boundary, dated 5th 1833, by S. M. Moore, under contract of 12th of August 1833, of the East & North boundaries, dated 25th 1833, by James Moore, under contract of 12th of August 1833, changed for in his account of April 1833.

L Subdivision, dated October 24th 1833, by James Moore, under contract of the 12th of August 1833, and changed for in his account of April 1833.

M The South boundary was surveyed in 1832, by James Moore, under contract of the 12th of August 1833. The West boundary was surveyed in 1833, by James Moore, under contract of the 12th of August 1833. The East & North boundaries were surveyed in 1833, by James Moore, under contract of the 12th of August 1833.

Surveyor's Office
St. Louis 21st August 1839.

The above Plat of Township 26 North of the base line, Range 3 East of the 3rd principal Meridian is conformable to the field notes of the survey thereof on file in this office, which have been examined and approved. The South boundary was surveyed in the 1st quarter of 1832, by Enosh Green, under his contract of the 9th of March 1822. The north, ——— and the east boundary lines ——— and the subdivision lines, were all surveyed in the 4th quarter of 1833, by James Moore, under contract of the 12th of August 1833. The West boundary was surveyed in the 4th quarter of 1833, by John M. Moore, under his contract of the 12th of August 1833.

William Millman
Surveyor General

Scale of 40 chains to an inch.

Aggregate area 23046.23 acres.

Township 27 North of the base line, Range 3 East of the 3rd principal meridian

45


I Reference to the field notes, as
 ed in the construction of this Plat
 West boundary, surveyed by S. M.
 Moore S. S. on the 19th Octo^r 1833
 at a Variation of 8° East, under
 his contract of the 12th of August
 1833.
 The South East and North bound-
 aries, were surveyed between
 the 8th October and the 12th of
 November 1833; at a Variation of 7° 30'
 East;
 the Township subdivided between
 the 19th of May 1834 at a Vari-
 ation of 7° 30' East; by James Moore
 S. under his contract of the 12th
 of August 1833; and included in
 his account of the 12th of April
 1835.

L Surveyor's Office
 St. Louis, June 15th 1849.
 Plat of the North halves of sections
 1, 2, 3, 4, 5, 6, of the South West
 quarter of Sec. 6, and of the West
 halves of sections 7, 8, 19, 20, 31, and
 32, of the Range 3 East of the 3rd
 principal meridian.

M Surveyor's Office
 St. Louis, 10th Sept. 1849.
 Plat of the North halves of sections
 1, 2, 3, 4, 5, 6, of the South West
 quarter of Sec. 6, and of the West
 halves of sections 7, 8, 19, 20, 31, and
 32, of the Range 3 East of the 3rd
 principal meridian.

Scale of 10 chains to an inch
 aggregate area 23132.10 acres.

Surveyor's Office
 St. Louis 21st August 1839.
 The above Plat of Township 27 North of the base line, Range 3 East of the 3rd prin-
 cipal meridian, is conformable to the field notes of the survey thereof, on file in this office,
 which have been examined and approved. The South, the East and the North boundary lines, were surveyed in the 4th quarter of
 1833 - and the subdivision lines were surveyed in the 2nd quarter of 1834 - all by James Moore - under his contract of the 12th of August 1833.
 The West boundary was surveyed in the 4th quarter of 1833, by J. M. Moore, under his contract of the 12th of August 1833.
 William Miller
 Surveyor General

46

I Reference to the field notes used
in the construction of this Plat
The West boundary was surveyed
at a Variation of 50 cts.
25 30' October 1830 by Geo
Simmons his contract of
August 1833.
The North, East & North boundary
were surveyed between the 6th
6th November 1833. and the
Township was divided between
the 15th of May 1834; all
a Variation of 7.36 cts by
Moore & S. under his co
et of the 12th of August 18
charged for in his account of
the 4th of April 1835.

Surveyor's office.
Saint Louis, Mo. 15th /
Not after North lot
2, 2, 3, 4, 5 & 6, of the
quarter section 6, and of
houses 7, 8, 9, 10, 11, 12, 13, 14, 15, 16, 17, 18, 19, 20,
sent this day to the Register
the said office at St. Louis

M
Surveyor's Office
St. Louis 10th Sept. 1861.
Plot of the North
1/2 Sec. 546 of the 6th
and 6th West halves of
and including the Township
Land Office.

aggregate area 23068.90 acres

The above Plat of Township 28 north of the base line, Range 3 East of the 3rd principal meridian, is ^{strictly} conformable to the field notes of the survey thereof, on file in this office which have been examined and approved — the South, the east and the north boundary lines, were surveyed in the 4th quarter of 1833 — and the subdivision lines, were surveyed in the 2nd quarter of 1834 — all by James Moore under his contract of the 12th of August 1833. The west boundary was surveyed in the 4th quarter of 1833, by D. M. Moore, under his contract of the 12th of August 1833.


William Melburn
Honeyport unit
J4

Township 29 North of the base line, Range 3 East of the 3rd principal meridian

39.61
39.76
79

97

47

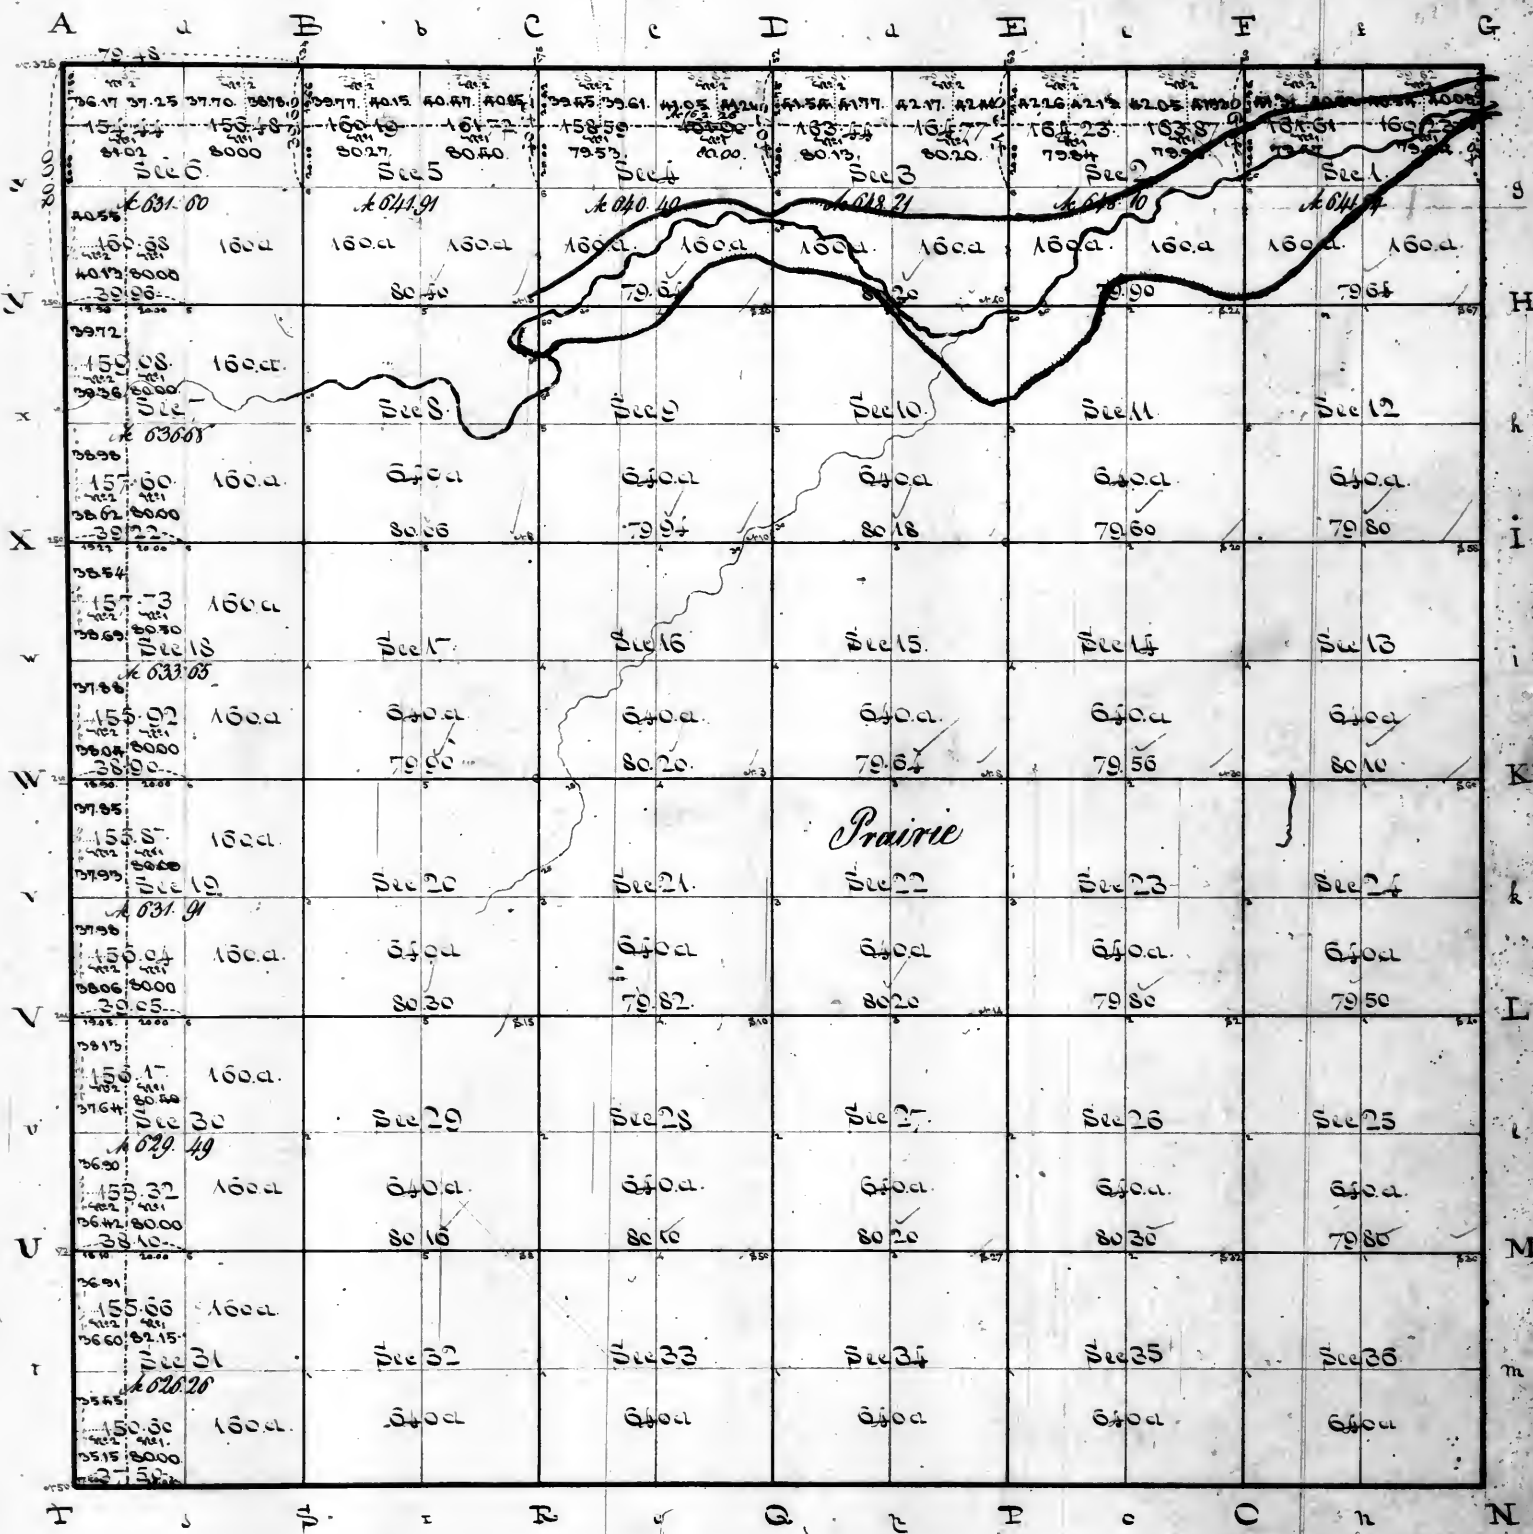

Reference to the field notes of the
Survey of this Township.
The West boundary was surveyed at
a variation of 5° 30' on the 21st of
October 1833, by S. M. Moore & S.
under his contract of the 12th of
August 1833.
The South East and North bound-
aries were surveyed from
the 8th of November 1833 to
the Township subdivided into
in the 5th of May 1834, at
a variation of 7° 16' East, except
the South boundary, which was
surveyed at a variation of 7° 50'
East) all by James Moore &
S. under his contract of the
12th of August 1833, and charged
for, in his account of the
4th of April 1835.
Surveyor's Office
St. Louis 15th May 1849.
Plat of the North halves of sections
1, 2, 3, 4, 5, 6, of the 29th North
quarter of section 2, and of the
West halves of sections 7, 8, 15, 16,
21, and 22, to the Register
of the Land Office at St. Louis.
E. J. M.
Surveyor's Office
St. Louis 17th Sept. 1849.
Plat of the North halves of sections
12, 13, 14, 15, 16, 17, 18, 19, 20,
21, and 22, of the 29th North
quarter of section 2, and of the
West halves of sections 7, 8, 15, 16,
21, and 22, to the Register
of the Land Office at St. Louis.
E. J. M.


Surveyor's Office
St. Louis 21st August 1839

The above Plat of Township 29 North of the base line, Range 3 East of the 3rd prin-
cipal meridian, is, ^{wholly} conformable to the field notes thereof on file in this Office, which have been
examined and approved. The South, the east, and the north boundary lines, were surveyed in the 4th quarter of 1833, and the
subdivision lines, were surveyed in the 2nd quarter of 1834 - all by James Moore under his contract of the 12th of August 1833. The
west boundary was surveyed in the 4th quarter of 1833, by S. Milton Moore, under his contract of the 12th of August 1833.

William Miller
Surveyor General

Township 30 North of the base line Range 3 East of the 3rd principal meridian

48

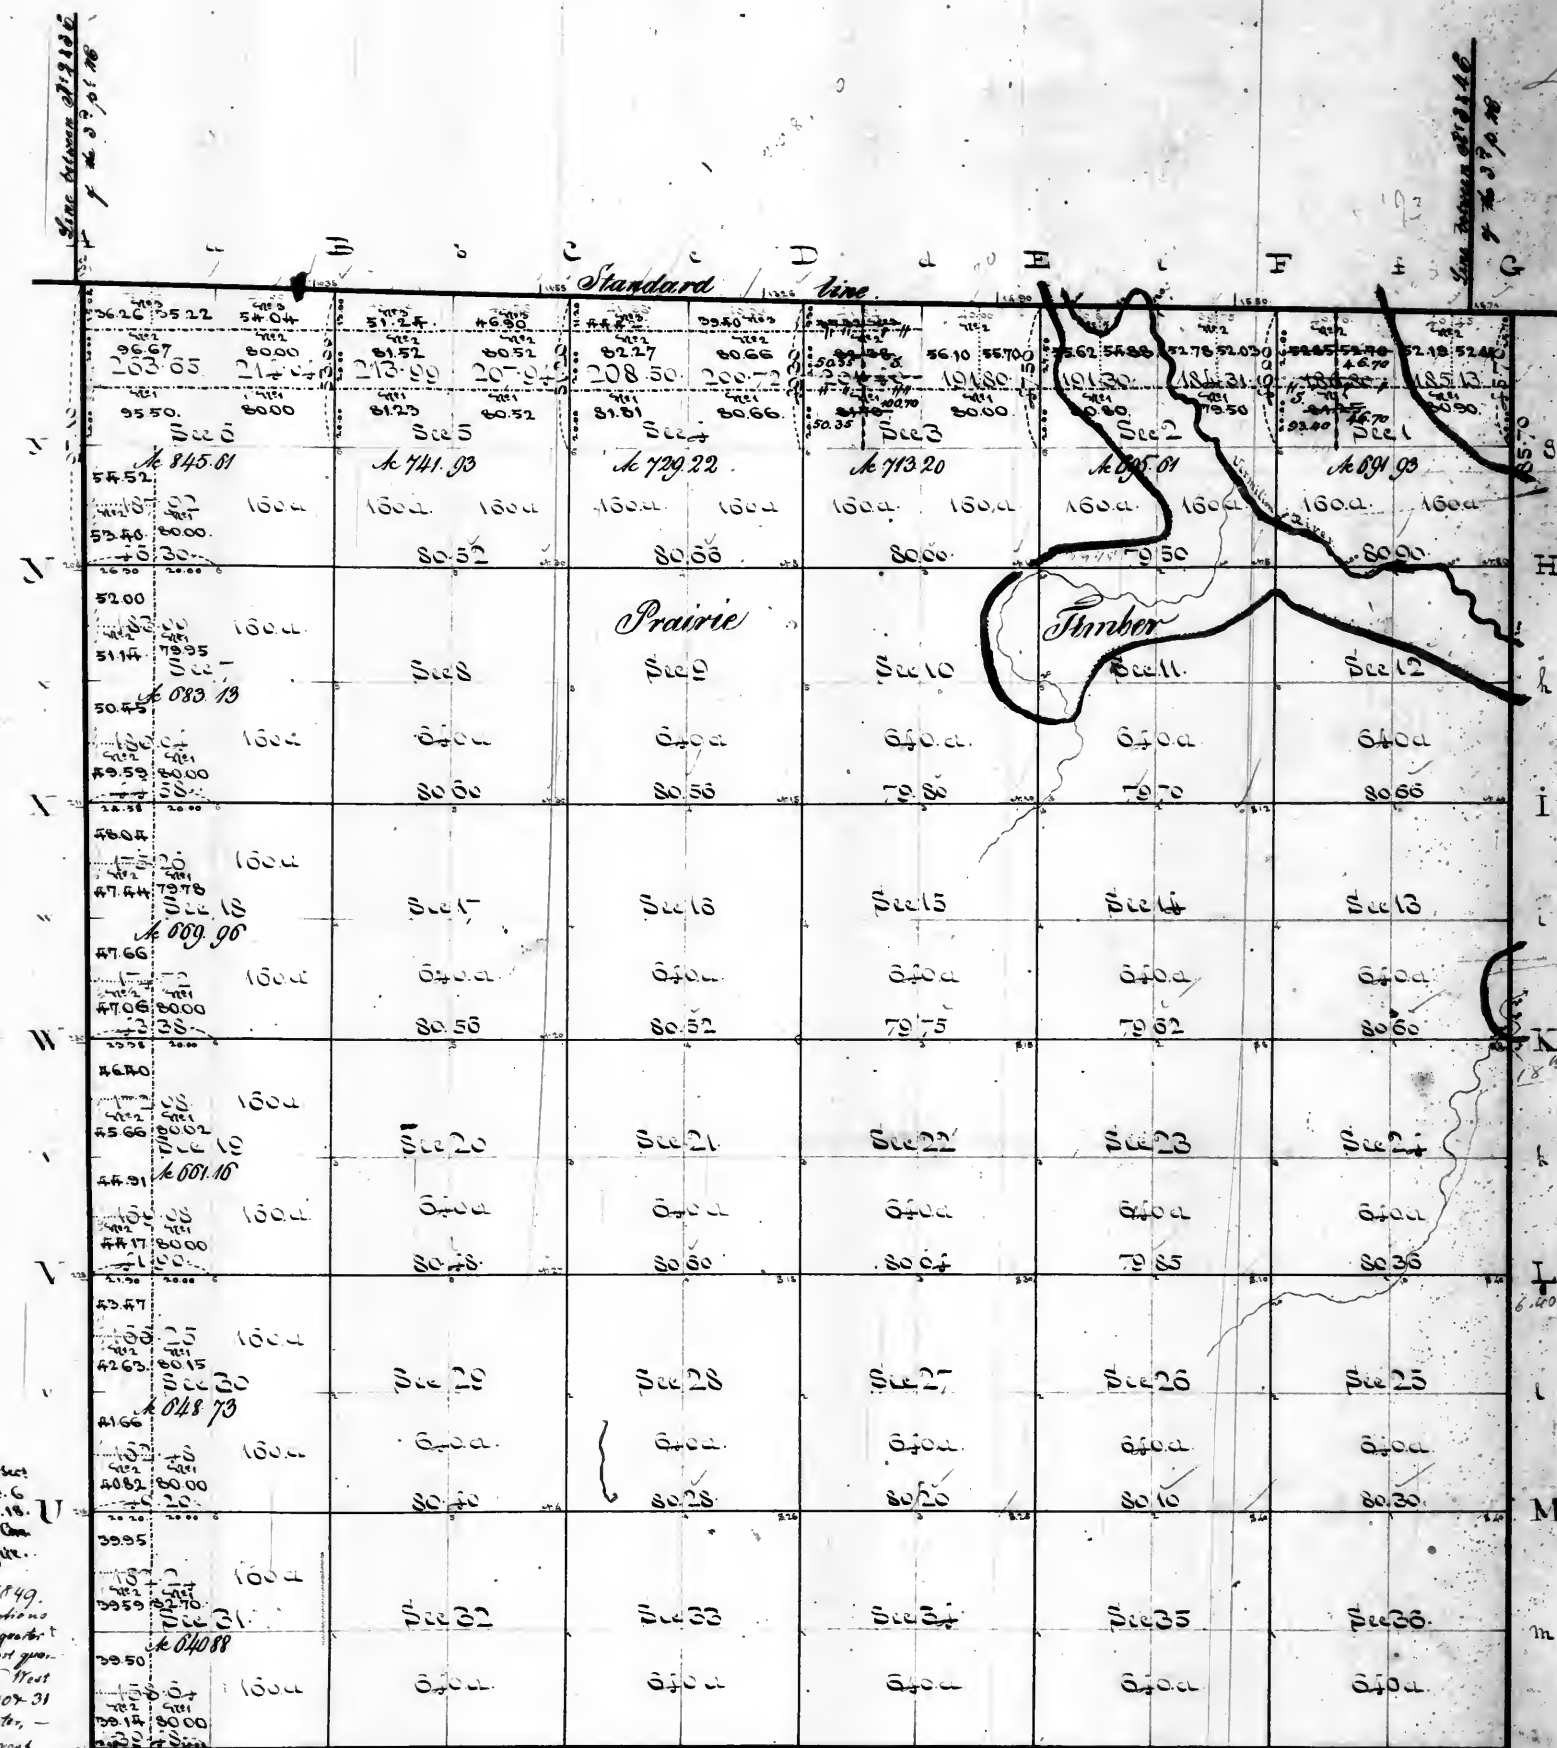

Reference to the field notes of the survey used in the construction of this Plat—
The West boundary was surveyed at a variation of 50 sets on the 12th of May 1822 by S. L. Moore under his contract of the 12th of August 1822—
The South and East boundaries were surveyed on the 12th of May 1822 by S. L. Moore under his contract of the 12th of August 1822, and charged for in his account of the 12th of April 1823—
The East boundary was surveyed at a variation of 50 sets on the 12th of May 1822 by S. L. Moore under his contract of the 12th of August 1822, and charged for in his account of the 12th of April 1823—
The South boundary was surveyed at a variation of 50 sets on the 12th of May 1822 by S. L. Moore under his contract of the 12th of August 1822, and charged for in his account of the 12th of April 1823—
The North boundary was surveyed on the 12th of May 1822 by S. L. Moore under his contract of the 12th of August 1822, and charged for in his account of the 12th of April 1823—


Surveyor's Office
St. Louis 10th Sept. 1844
Plat of the North halves of Sects 2, 3, 4, 5, 6, of the SW 1/4 of Sec. 6 and of the West halves of Sects 7, 18, 19, 20, 31, sent this day to the Commissioner of the General Land Office.
Surveyor's Office
St. Louis June 15th 1849
Plat of the North halves of sections 1, 4, 5, 6, of the North West quarter of Section 3, of the South West quarter of Section 6, and of the West halves of sections 7, 18, 19, 20, 31 sent this day to the Register, — and a plat of the North West quarter of Section 3, subdivided into 160 acres, to be given to previous sales marked 3, sent to the Commissioner of the General Land Office.

Scale of 60 chains to an inch.
aggregate area 23721.38 acres.

Surveyor's Office
St. Louis 21 August 1859
The above Plat of Township 30 North of the base line, Range 3 East of the 3rd principal meridian, is conformable to the field notes thereof on file in this office which have been examined and approved— The north boundary was surveyed in the 2nd quarter of 1821, by R. J. Holliday under the contract of the 12th of March 1821— The west boundary was surveyed in the 2nd quarter of 1824, by J. Milton Moore, under his contract of the 12th of August 1822— and the South and East boundaries were surveyed in the 4th quarter of 1822— the subdivision lines in the 2nd quarter of 1824 by James Moore under his contract of the 12th of August 1822.
William Millman
Surveyor General
J. H.

Township 21 North of the base line Range 3 East of the 3^d principal meridian
except the North halves of sections 1, 2, 3, 4, 5, 6, the North half and South West quarter of section 6, and the West halves of sections 7, 18, 19, 30 and 31 which are omitted

49

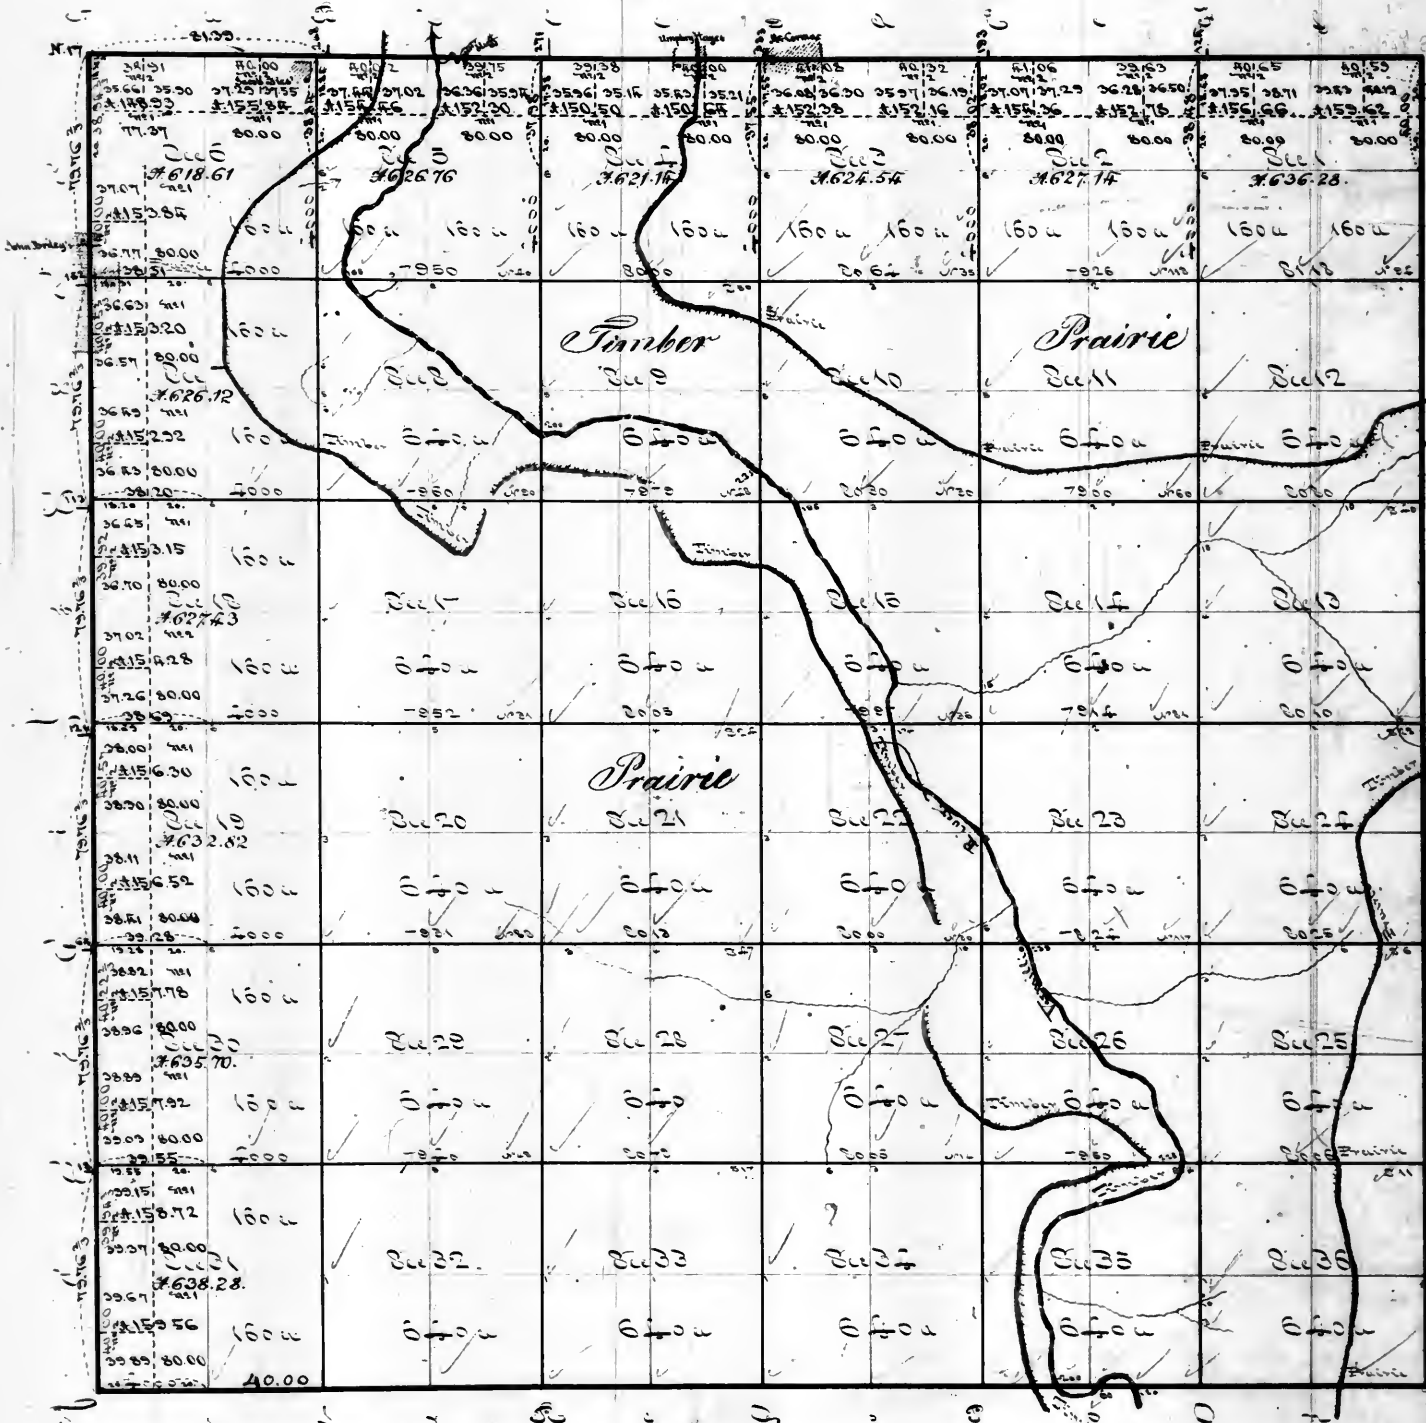

Surveyor's Office
St. Louis June 29th 1854
There are no notes of
the survey of the North & West boundaries of
this Township found on file in this Office.
The North halves of sections 1, 2, 3, 4, 5, 6, the
North half & West quarter of section 6, and
the West halves of sections 7, 18, 19, 30
& 31 are therefore omitted on this plat.
E. J. Sangham
1854
for recording on the
plat

Aggregate area 19360.00 acres exclusive of the N. halves of sections 1, 2, 3, 4, 5, 6, the S. W. 1/4
of section 6 and the West halves of sections 7, 18, 19, 30 & 31.

2554.82

Total = 22914.82 acres.

Surveyor's Office
St. Louis June 29th 1854

The above Plat of Township 21 North of the Baseline, Range 3 East of the 3^d principal
Meridian, is conformable to the field notes of the survey thereof on file in this Office

E. J. Sangham

Surveyor's Office. St. Louis 29th January 1841.

The above plat of township 21 north of the base line, range 3 east of the 3^d principal meridian, with the exception
specified in the marginal note certified by E. J. Sangham former Surveyor General of this district is strictly conformable to the field notes of the survey thereof on file in this office, which
have been examined and approved. The South boundary and the east boundary were surveyed by Nicholas J. Holliday, during the month of May 1821, and the subdivision lines
were surveyed in June 1821, all under the contract dated the 20th of March of the same year, of Stephen Sector and Thomas C. Sector.

Surveyor's Office.
St. Louis 16th of October 1844.
Sections 1, 2, 3, 4, 5, 6, 7, 18, 19, 30 & 31, were laid down on the above plat strictly conformable to the field notes of
the survey thereof on file in this Office which have been examined and approved. In April 1844, Geo. E. Waller, under
instructions from the Surveyor General dated the 23rd of March of the same year, surveyed the lines described in the
marginal statement, 4 miles 64.90 chains, which were paid for in the 3^d quarter of 1844 and charged in the account
current of the Surveyor General. During the same quarter under the appropriation of \$2000 of the 3^d of March 1843
(p. 95 of 3^d Session of the 27th Congress) for the survey of unfinished or defective lines in Missouri & Arkansas.

William Milburn

Surveyor of the public lands in
the State of Missouri and Arkansas.

Silas Beebe


Technical report to a certificate of
16 October 1854.

| Area | Acres |
|-------------------------------------|---------|
| Area between lat 36 20' of Missouri | 38 45 |
| do 36 30 do | 38 02 |
| do 36 40 do | 37 55 |
| do 36 50 do | 37 38 |
| do 37 00 do | 38 24 |
| do 37 10 W of p.m. | 38 31 |
| do 37 15 do | 38 20 |
| do 37 18 do | 38 03 |
| do 37 30 do | 38 38 |
| do 37 31 do | 38 55 |
| | 4 64 36 |

TOWNSHIP No 32 NORTH of the BASE LINE Range No 3 EAST of the 3rd PRINCIPAL MERIDIAN,

except sections 31, 32, 33, 34, 35 and 36, which are omitted for the reasons stated in the marginal note in accordance for the 17th of January 1841.

50

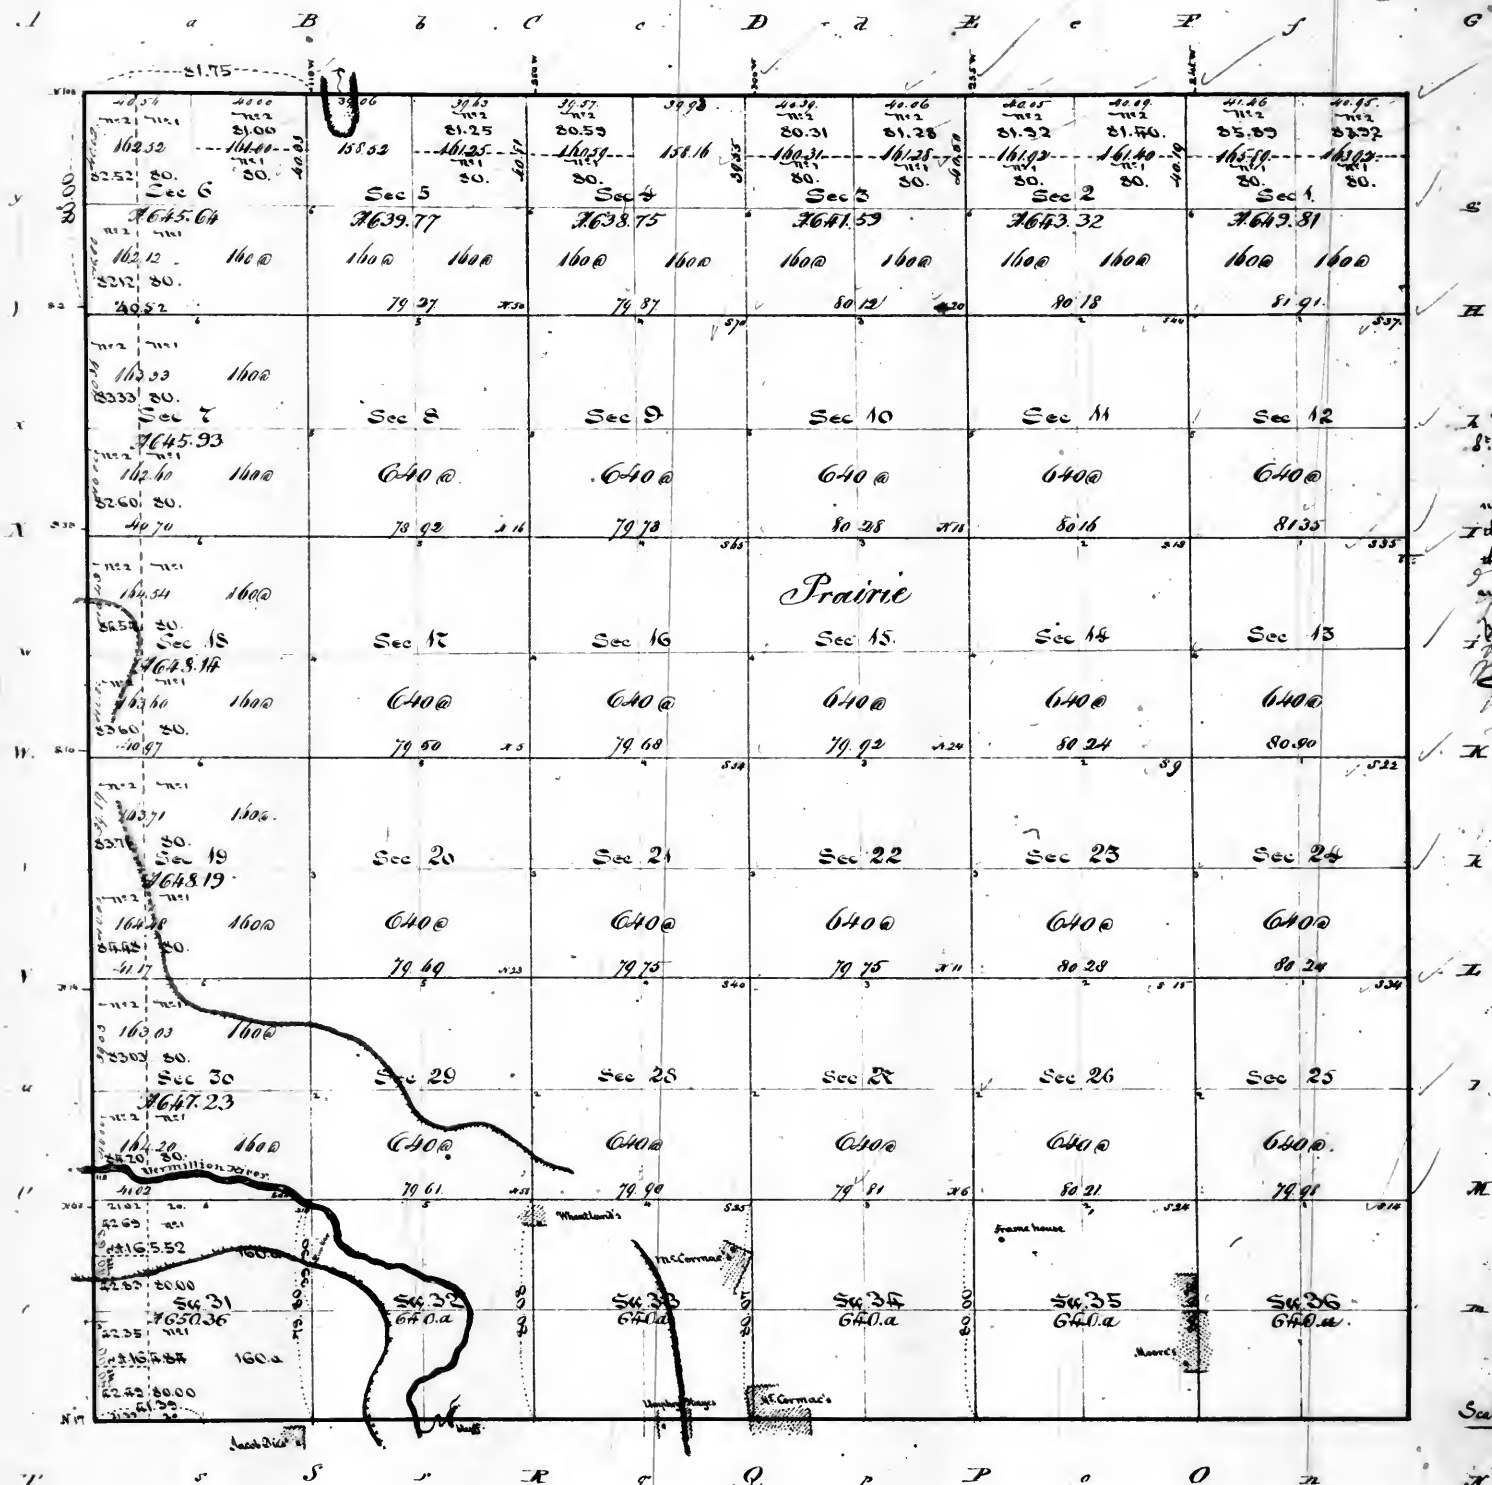

Surveyors Office
St. Louis June 28th 1834
These are
notes found on file in this Office, of
the survey of the base boundary of
this Township, sections 31, 32, 33, 34, 35
and 36 are therefore omitted on this
plat.
E. J. Lougham

Surveyors Office
St. Louis June 28th 1834

Aggregate area 18248.57 acres, exclusive of sections 31, 32, 33, 34, 35 & 36.
2850.36 area of do.
Total 23098.93

The above Plat of Township 32 North of the Base line, Range 3 East of the 3rd principal meridian, is conformable to the field notes of the survey thereof on file in this Office.

E. J. Lougham

Surveyors Office. Saint Louis 28th of January 1841.

The above plat of township 32 north of the base line, range 3 east of the 3rd principal meridian, with the exception specified in the marginal note certified by E. J. Lougham, former surveyor General of this district, is strictly conformable to the field notes of the survey thereof on file in this office, which have been examined and approved - The east boundary was surveyed in May 1831, by R. J. Redway; - The west boundary, the north boundary and the subdivision lines were surveyed in July 1831, by G. Thomas, all under the contract of Stephen Rector and Thomas C. Rector of the 20th of March of the same year.


Minam Mullen
Surveyor of the public lands
in the State of Missouri & Wisconsin.

Surveyors Office. Saint Louis 16th of October 1844.
Sections 31, 32, 33, 34, 35, 36 were laid down on the above plat strictly conformable to the field notes of the survey thereof on file in this office which have been examined and approved - On the north of April 1844, Geo. E. Waller, under instructions of the 23rd of March of the same year, surveyed the south boundary of the township, and the lines between sections 31 & 32, 32 & 33, 33 & 34, 34 & 35, 35 & 36, in all 11 miles 01. 40 chains, which was paid for in the 3rd quarter of 1844, and charged in the account current of the Surveyors General, during the same quarter under the appropriation of \$3000. of the 3rd of March 1843, Cap. 95 Act 3rd Session 27th Congress for the survey of detached and unfinished lines in Missouri & Wisconsin.
Silas Reed

Township 33 North of the base line, Range 3 East of the 3^d principal Meridian

79.64
50.27
286.7

51

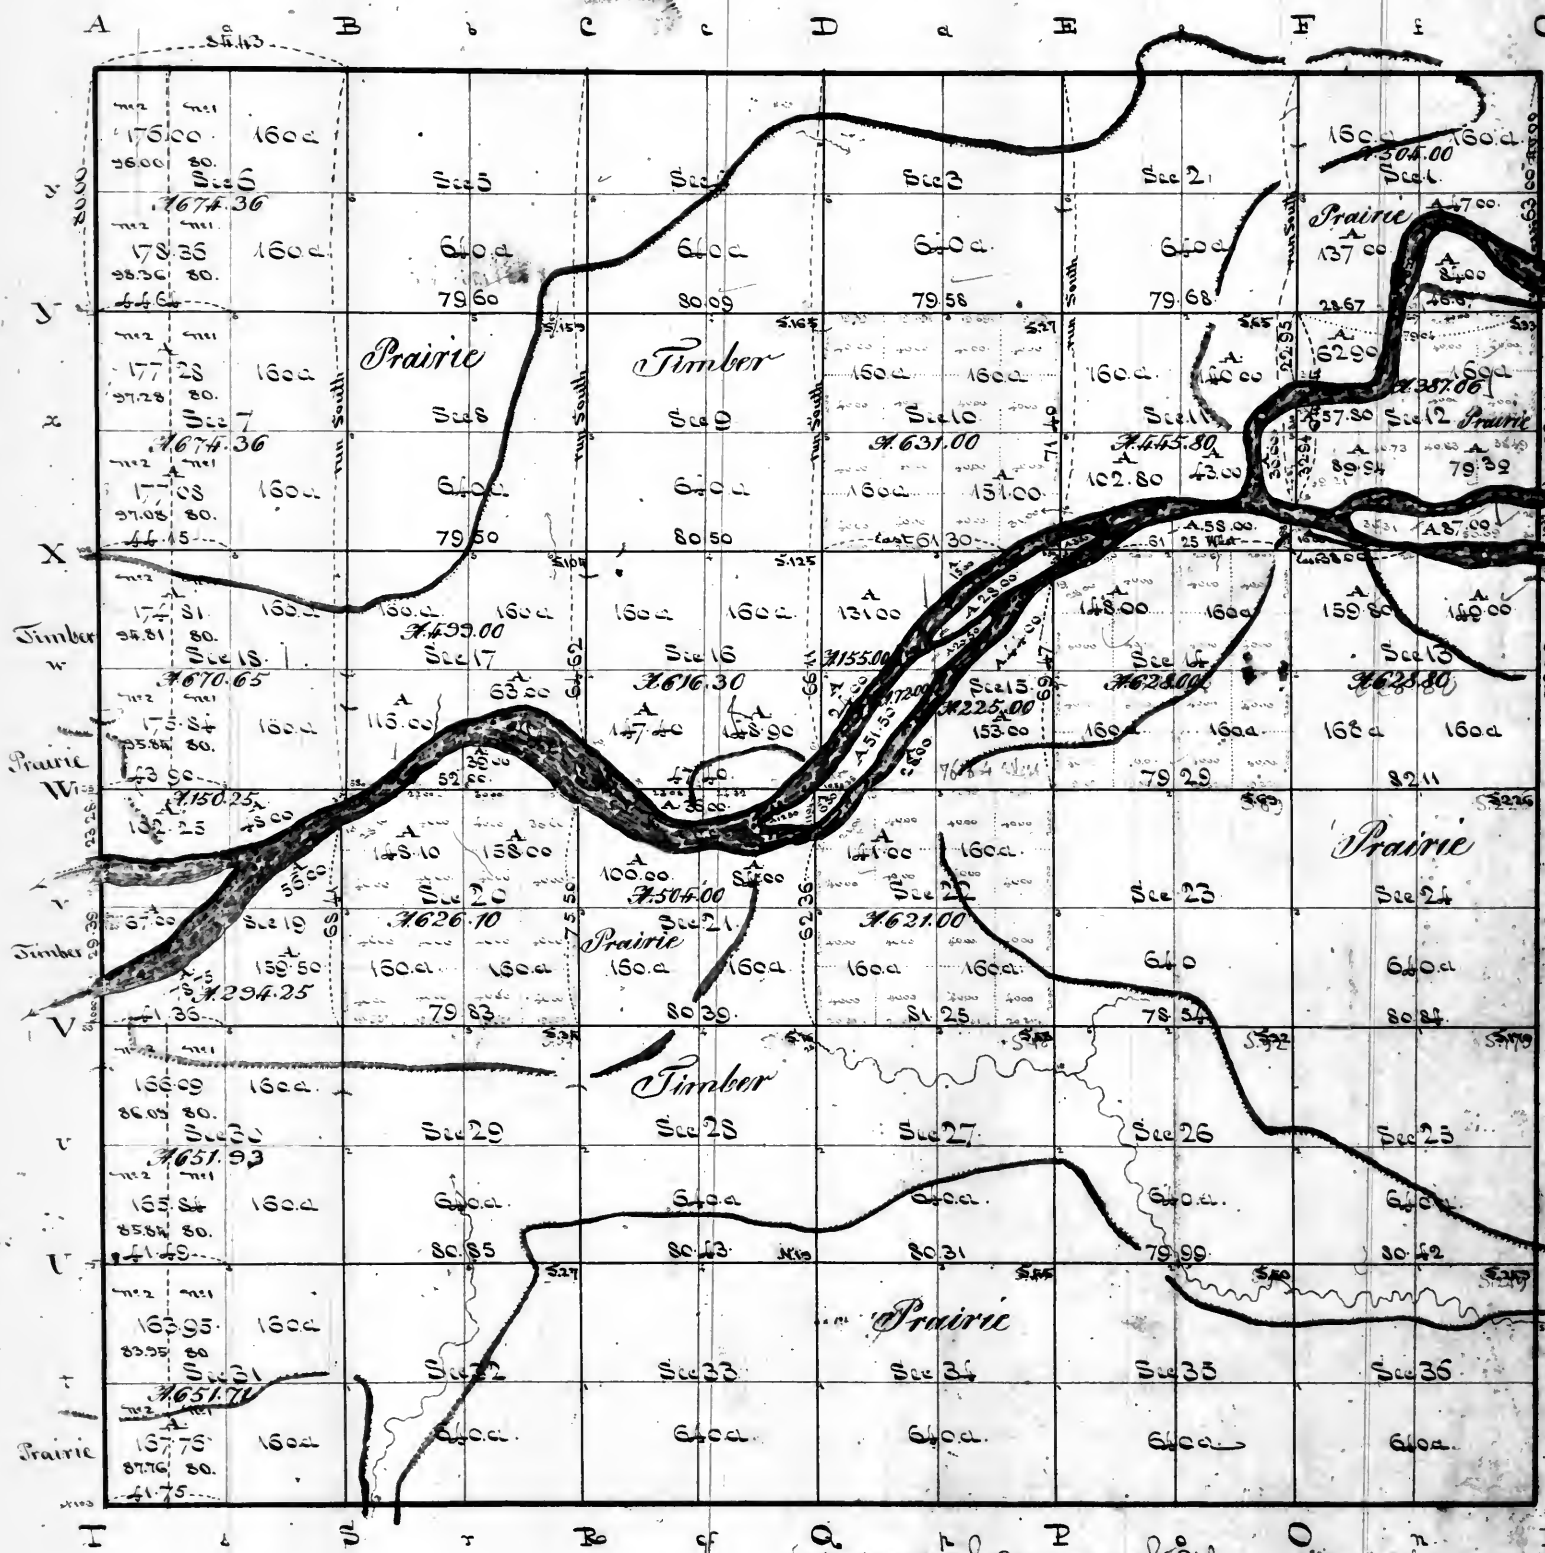

Areas of fractions of Islands
in sections 10, 11, 14, & 15
July 10. 0.75 A
11. 3.50
14. 2.75
15. 28.00
Total 35.00 acres

Areas of fraction of Island
in sections 15, 21, & 22
July 15. 1.75 A
21. 51.00
22. 6.50
Total 59.25 acres

Note In the field notes appears the length
of the line between Sec 15 & 22 as read
from corner to Sec 15 & 22
as 76.68 chains.
In taking out the latitude & separ-
ture of the meander courses of the
left bank of Illinois river in Sec 22
(See Vol. 241 pag 302) the writings
are 17.35 ch which added to 76.68
chains gives the whole length 94.03
ch which is evidently erroneous.

Surveyors Office
St. Louis July 5th 1834

21st Nov 1834, Sent to the Commissioner of the Land
Office a plat of this Township 33 North of the base line
Range 3 East of the 3^d principal Meridian
Aggregate area of public land = 22363.47 acres
estimated area of the river = 800.00
Total = 23163.47 acres

The above Plat of Township 33 North of the base line, Range 3 East of the 3^d principal Meridian, is conformable to the field notes of the survey thereof on file in this Office.

E. J. Langham

Township 34 North of the baseline Range 3 East of the 3^d principal Meridian

52


Surveyors Office
St. Louis June 23 1834


Aggregate area - 23431.91 acres - 647.94
23431.91

The above Plat of Township 34 North of the Baseline, Range 3 East of the 3^d principal meridian, is conformable to the field notes of the Survey thereof on file in this Office.

E. J. Langham

Township 35 North of the base line Range 3 East of the 3rd principal meridian

53

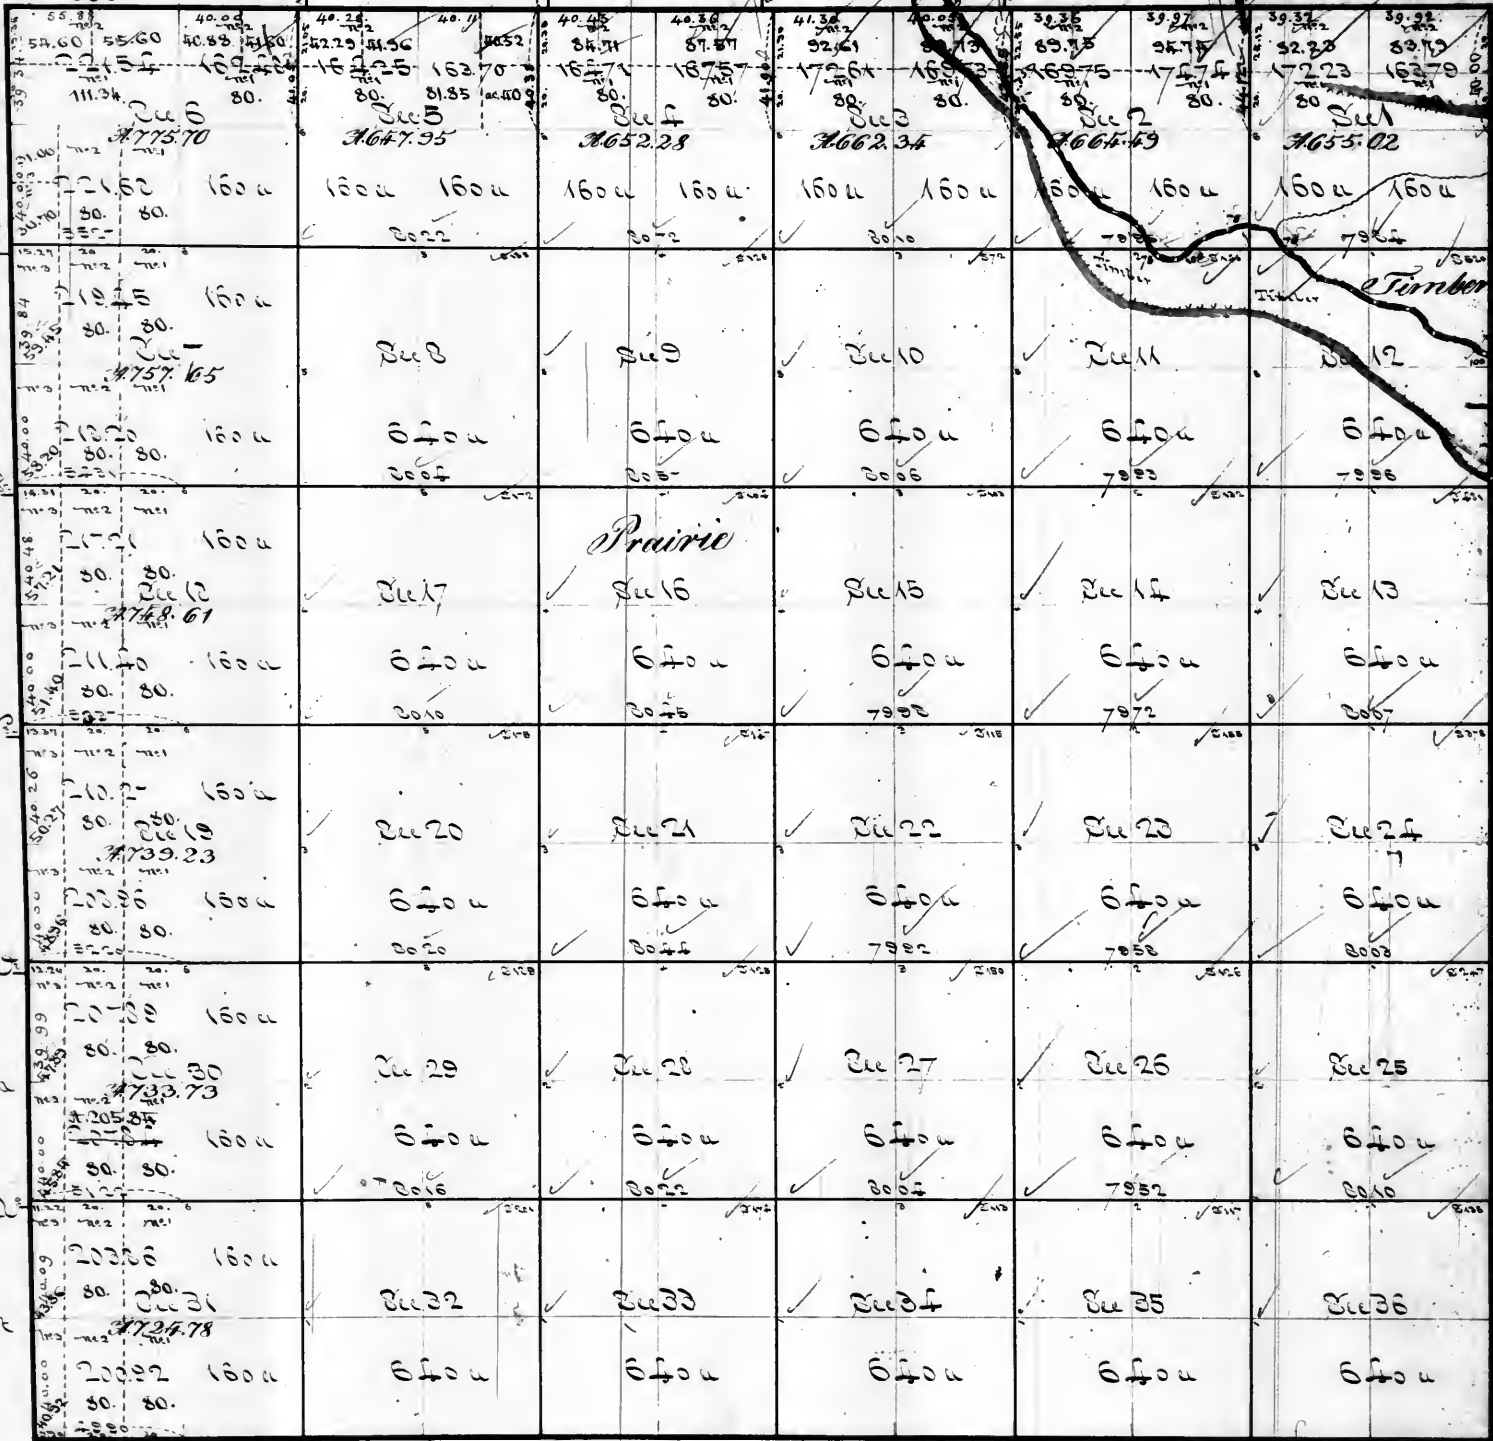

Aggregate area - 23761.78 acres

Surveyors Office
St. Louis June 20th 1834.


The above Plat of Township 35 North of the Base line, Range 3 East of the 3rd principal meridian, is conformable to the field notes of the Survey thereof on file in this Office.

E. J. Smythorn

distances on N & W 1834
to be entered from 20

Fractional Township No 36 North of the Base line in Range No 3 East of the 3^d principal Meridian.

54

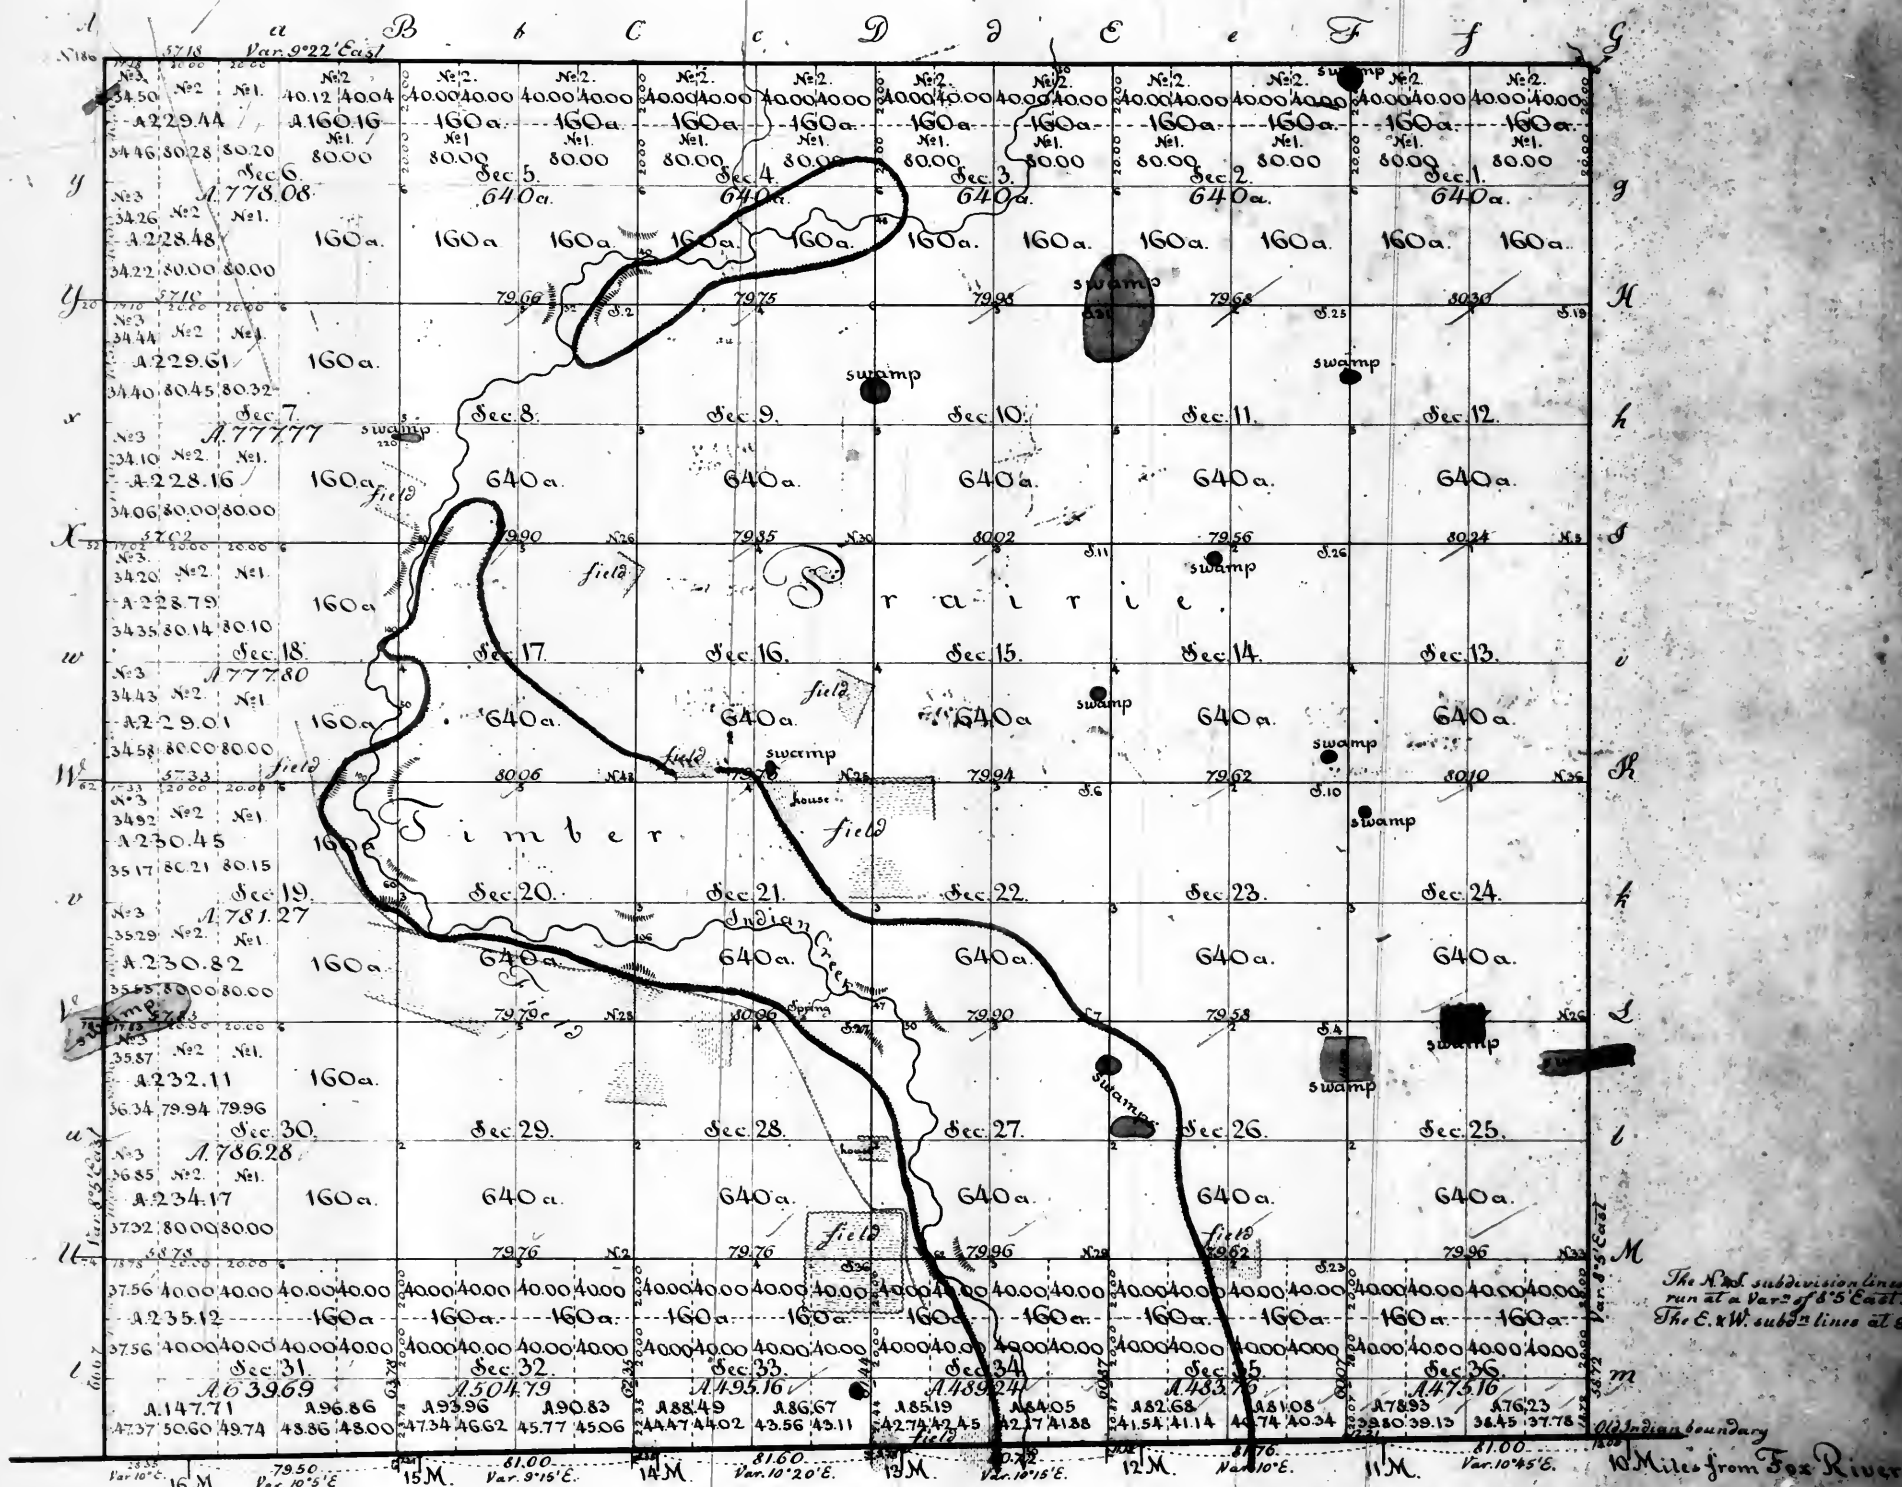

Surveyors Office. Saint Louis 21st of May 1839.


Scale of 40 chains to one inch.
Aggregate Area 22989.00 acres.

The above plat of fractional township 36 north of the base line range 3 east of the 3^d principal meridian, north of the old indian boundary, is mostly conformable to the field notes of the survey thereof on file in this office, which have been examined and approved. The Southern boundary which is designated 'old indian boundary' was surveyed by John C. Sullivan assisted by James M. Duncan, in the first quarter of 1819, under the authority of a letter of appointment from William Hector Surveyor of the lands of the United States in Illinois and Missouri, dated October 18th 1818, authorizing them to survey certain indian boundaries, under the direction of Commissioners Graham and Phelps appointed by the President to run the lines of the tract ceded by the treaty of Saint Louis of the 24th August 1804, between the United States and the United Nations of Illinois, Chippewas, and Potawatamies - This being the line agreed to be run West to the Mississippi from a point on the river one mile west of the Southern extremity of Lake Michigan: - It was surveyed 6 miles 20.85 chains, and the mile points thereon were surveyed at the several distances set down on the map - The west boundary 5 miles 66.67 chains - the east boundary 5 miles 57.75 chains - and the north boundary 6 miles 17.18 chains were surveyed in the 4th quarter of 1827, and the subdivision lines 50 miles 73.15 chains were surveyed in the 3^d quarter of 1838 - all by Eli S. Prescott, under contract signed by the Surveyor General on the 8th of May, and by Prescott on the 3rd of June 1837 - and with the exception of the subdivisional line between sections 18 and 19, 1 mile 17.33 chains were paid for in the 4th quarter of 1838, and charged in the account of the Surveyor General for that quarter, voucher 765 - The line between sections 18 & 19 was suppressed from the account, because the quarter section corner was not established: - I find upon examination that the place of the said quarter section corner is in the middle of a large cultivated field in a prairie and without any mark or monument in a reasonable distance - that the establishment of the corner would be more a matter of form than actual utility; and that its position can readily be determined by means of the adjacent corners: I have therefore approved of the survey of said line as at first returned, but have not yet paid therefor.

William McIlwain
Surveyor General

Township 37 North of the base line Range 3 East of the 3rd principal Meridian

55

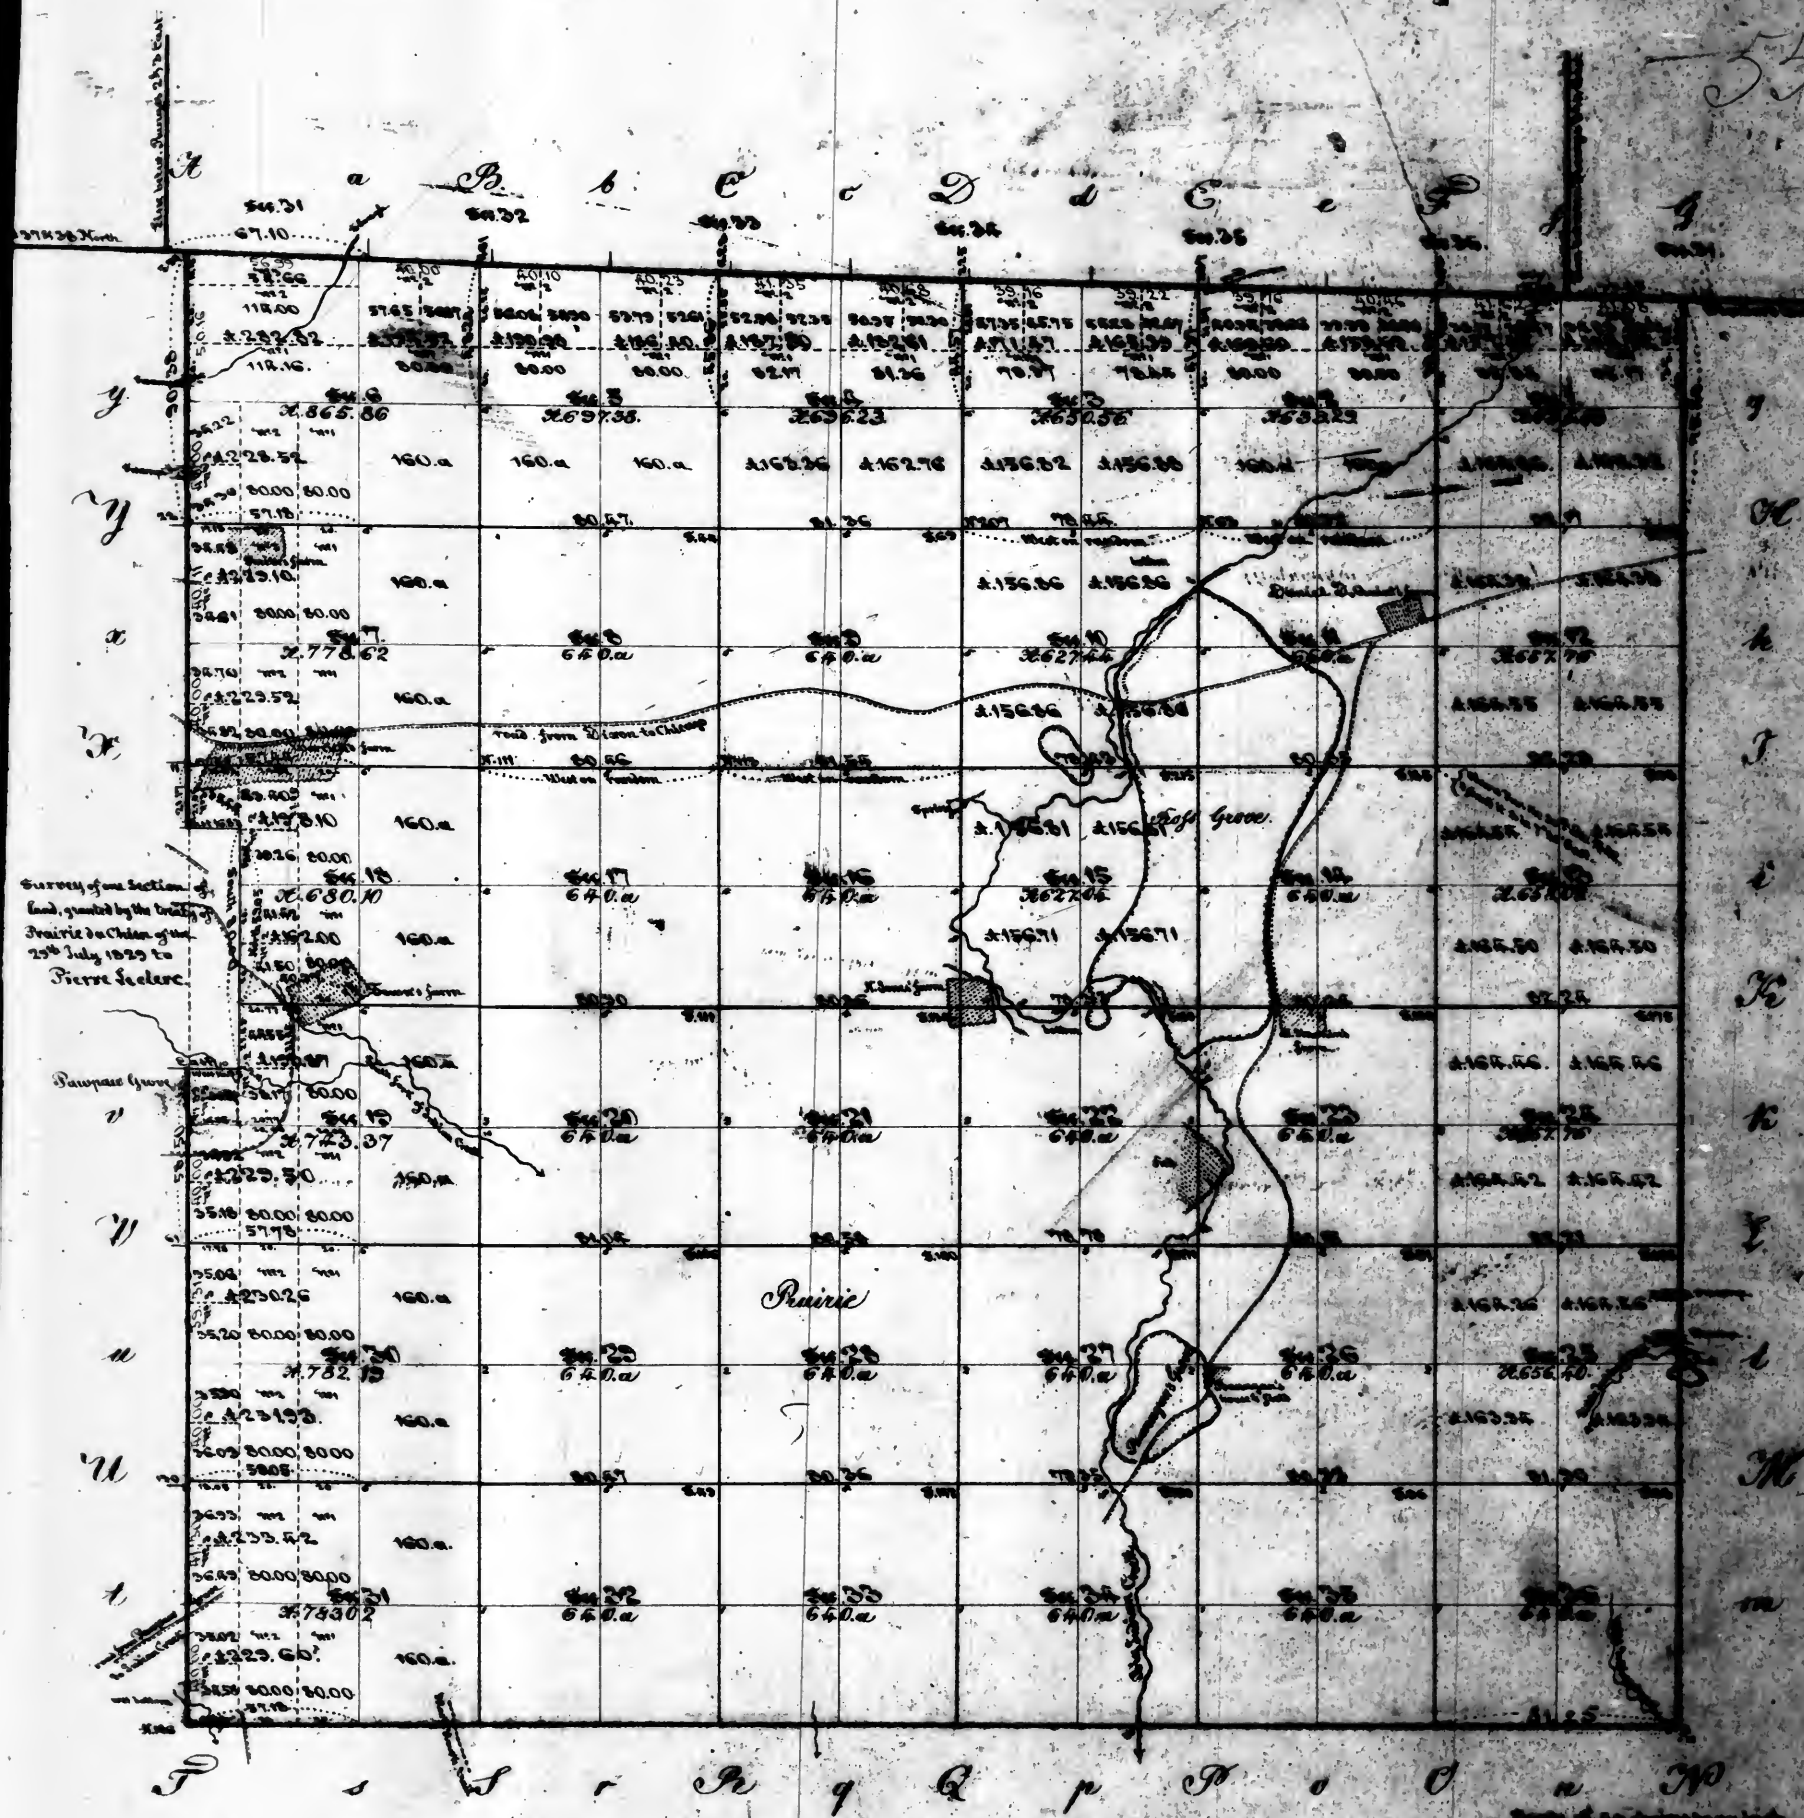




| Lines designated | By whom surveyed | Date of contract or instructions | Amount of surveying miles, chains, links | When executed | When paid for | N ^o of voucher for full account | Remarks |
|--------------------------------------|-------------------|--------------------------------------|--|---------------------|------------------------------|--|---------|
| South boundary | C. D. Prescott | by order of 1 st May 1827 | 6. 17. 18 | A ^g 1827 | D ^o December 1827 | G of A ^g 1827 | |
| East boundary | | | 5. 75. 40 | | | | |
| West boundary | | | 6. 10. 31 | | | | |
| North boundary | | | 6. 20. 65 | | | | |
| Subdivision line | S. M. Butler & Co | 21 st October 1828 | 61. 24. 33 | November 1828 | 20 th May 1828 | G of 2 nd 1828 | |
| | W. H. Miller | | | | | | |
| | A. H. Evans | | | | | | |
| | G. A. D. & Co | | | | | | |
| Survey of Indian grant of 9 sections | A. H. Evans | 10 th May 1826 | | July 1826 | not paid for | | |
| Survey of | G. A. D. & Co | 21 st Oct. 1828 | 1. 24. 28 | November 1828 | 20 th May 1828 | G of 2 nd 1828 | |
| by Sec. 26 | do | do | 1. 01. 25 | A ^g 1828 | do | do | |

Surveyor's office.
Saint Louis 28th July 1828.
The above plat of township 37 north of the base line range 3 east of the 3rd principal meridian is strictly conformable to the field notes of the survey thereof on file in this office which have been examined and approved.

Silas
Surveyor

Township 38 North of the base line Range 3 East of the 3rd principal Meridian.

56

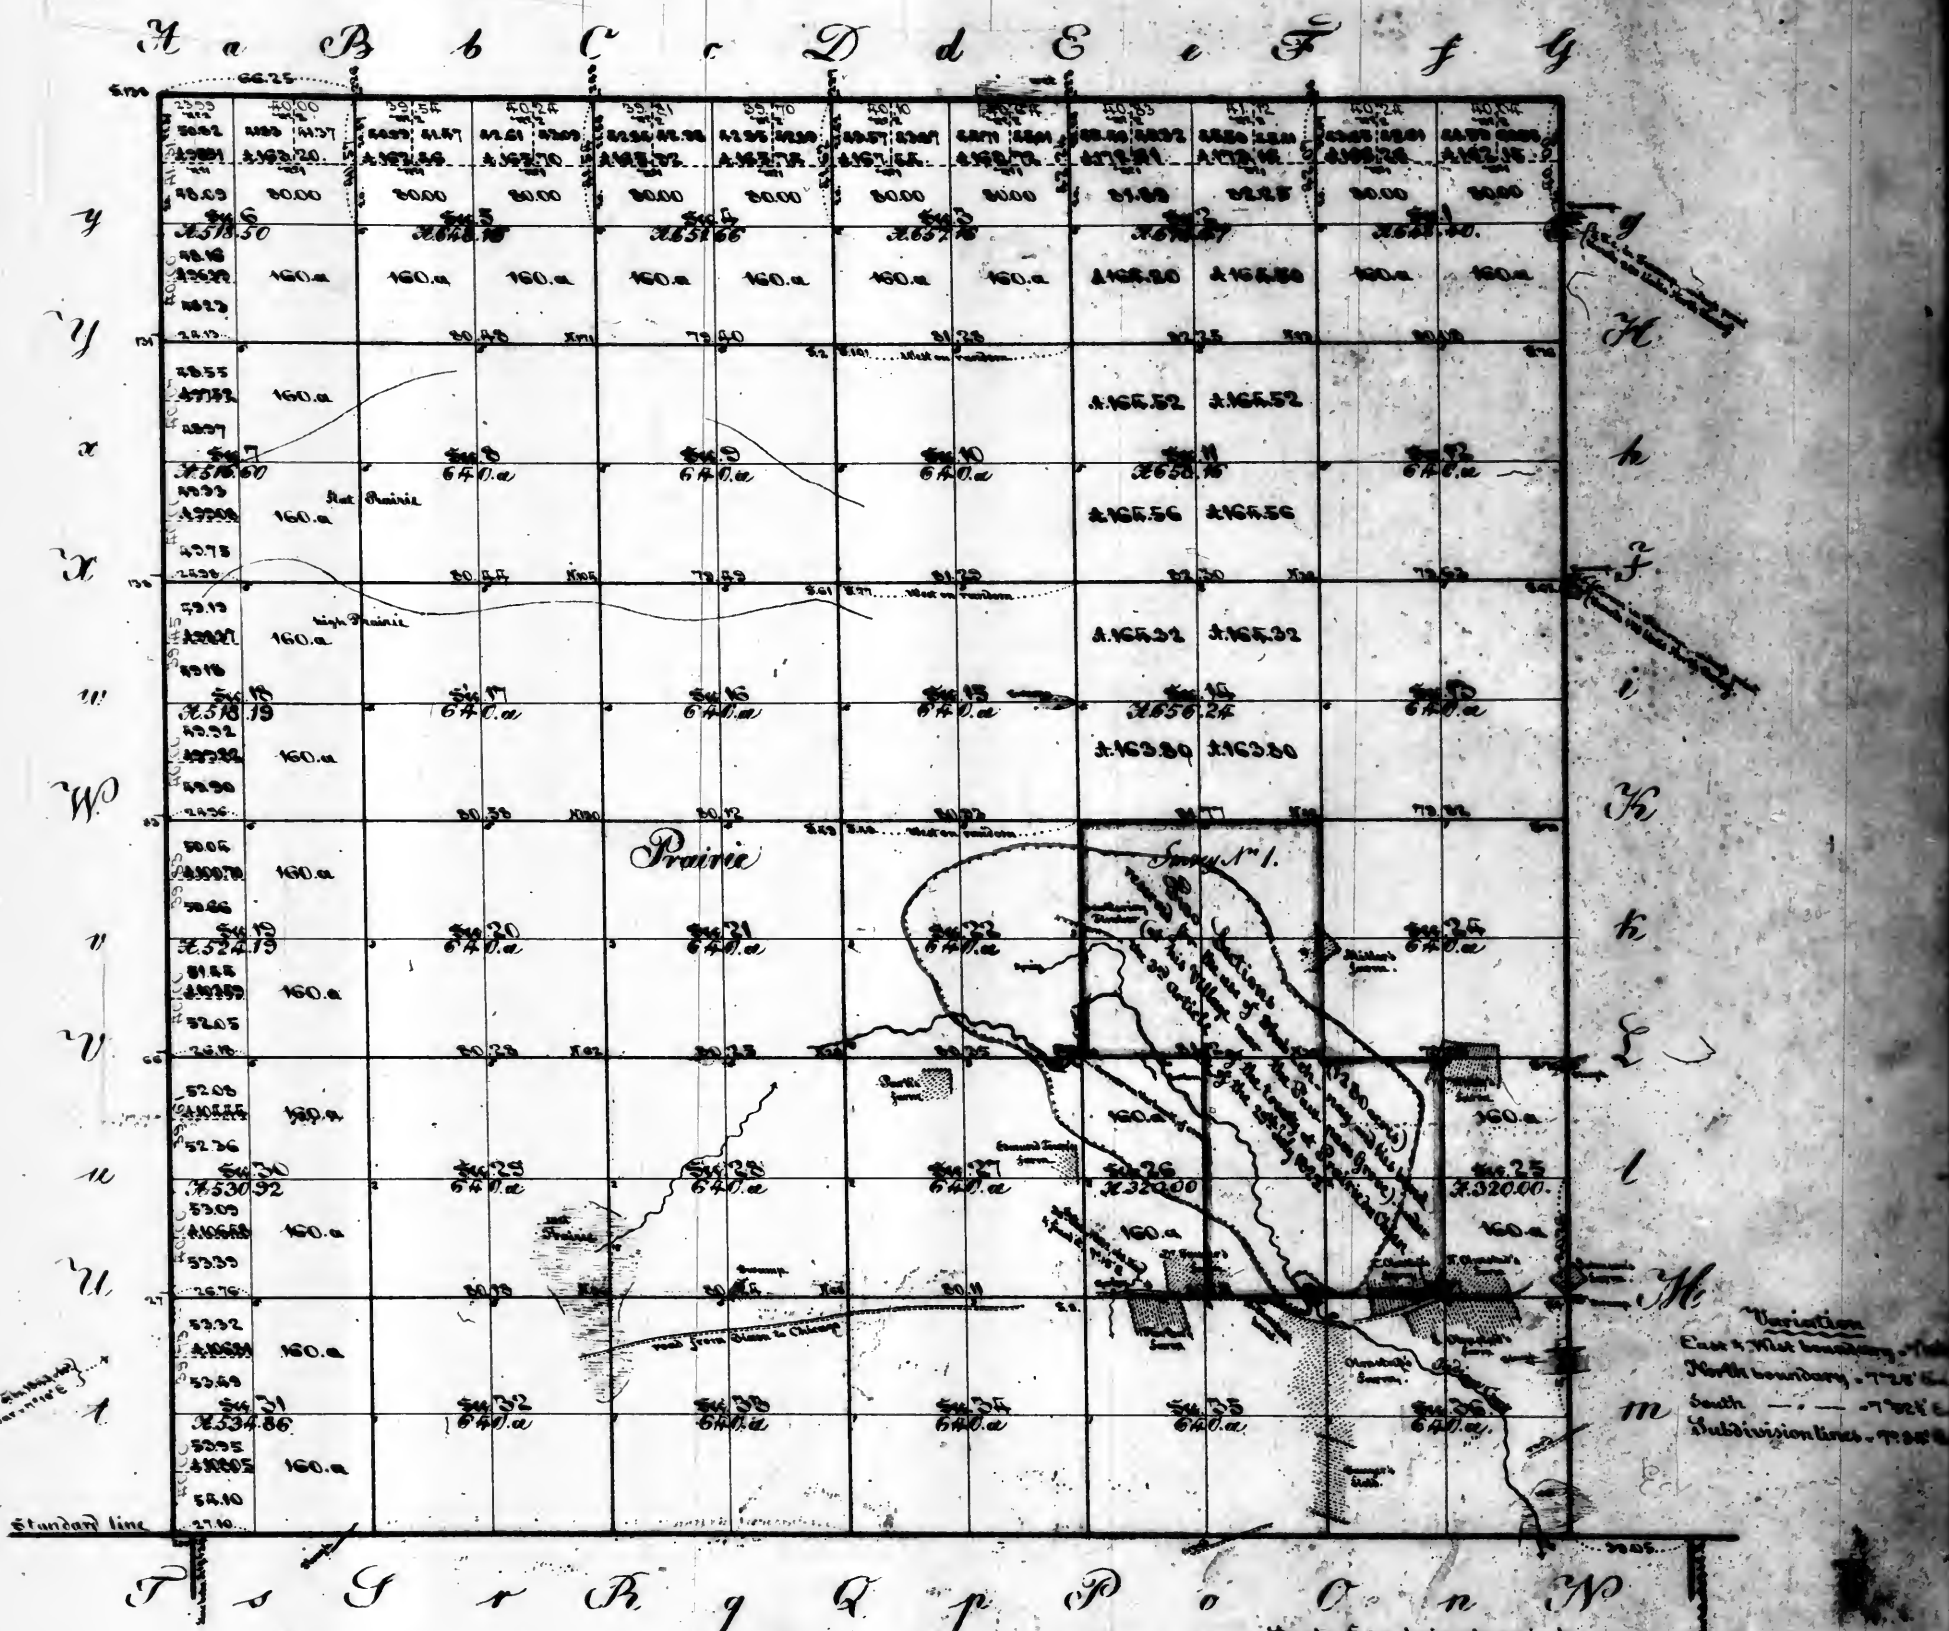


Scale of 40 chains to an inch.
 Aggregate area - 21177.21 acres of public land
 and of the Indian Reserve - 1250.00 acres
 Aggregate area of the Township - 22427.21 acres

| Lines designated | By whom surveyed | Date of Contract | am ^t of surveying miles chains links | When executed | When paid for | Number of vouchers in Gov. Sec. account | Remarks. |
|-------------------|----------------------------------|----------------------------|---|---------------|----------------------------|---|---|
| South boundary | G. S. Prescott | 15 th Oct. 1837 | 5 67. 10 | Oct. 1838 | 2 nd Dec. 1838 | 5 of 2 nd 1838 | |
| East boundary | G. S. Prescott | 15 th Oct. 1837 | 5 00. 00 | Oct. 1838 | 20 th June 1838 | 3 of 2 nd 1838 | See surveys. |
| West boundary | G. S. Prescott | 15 th Oct. 1837 | 6 00. 00 | Oct. 1838 | 20 th June 1838 | 3 of 2 nd 1838 | See surveys. |
| North boundary | G. S. Prescott | 15 th Oct. 1837 | 5 66. 28 | Oct. 1838 | 20 th June 1838 | 3 of 2 nd 1838 | See surveys. |
| Subdivision lines | G. M. Fowler and W. H. J. Miller | 21 st Oct. 1842 | 59. 28. 34 | December 1842 | 20 th May 1843 | 6 of 2 nd 1843 | |
| East boundary | G. M. Fowler and W. H. J. Miller | 21 st Oct. 1842 | 1. 00. 53 | December 1842 | 20 th May 1843 | 6 of 2 nd 1843 | Not by the 25 th Act of Sec. 36. |

Surveyor's Office.
 Saint Louis 24th July 1843.
 The above plat of Township 38 North of the base line range 3 East of the 3rd principal meridian, is strictly conformable to the field notes of the Survey thereof on file in this office, which have been carefully compared and approved.
 Silas H. Reed
 Surveyor General.

Township 39 North of the base line Range 3 East of the 3rd principal Meridian

57

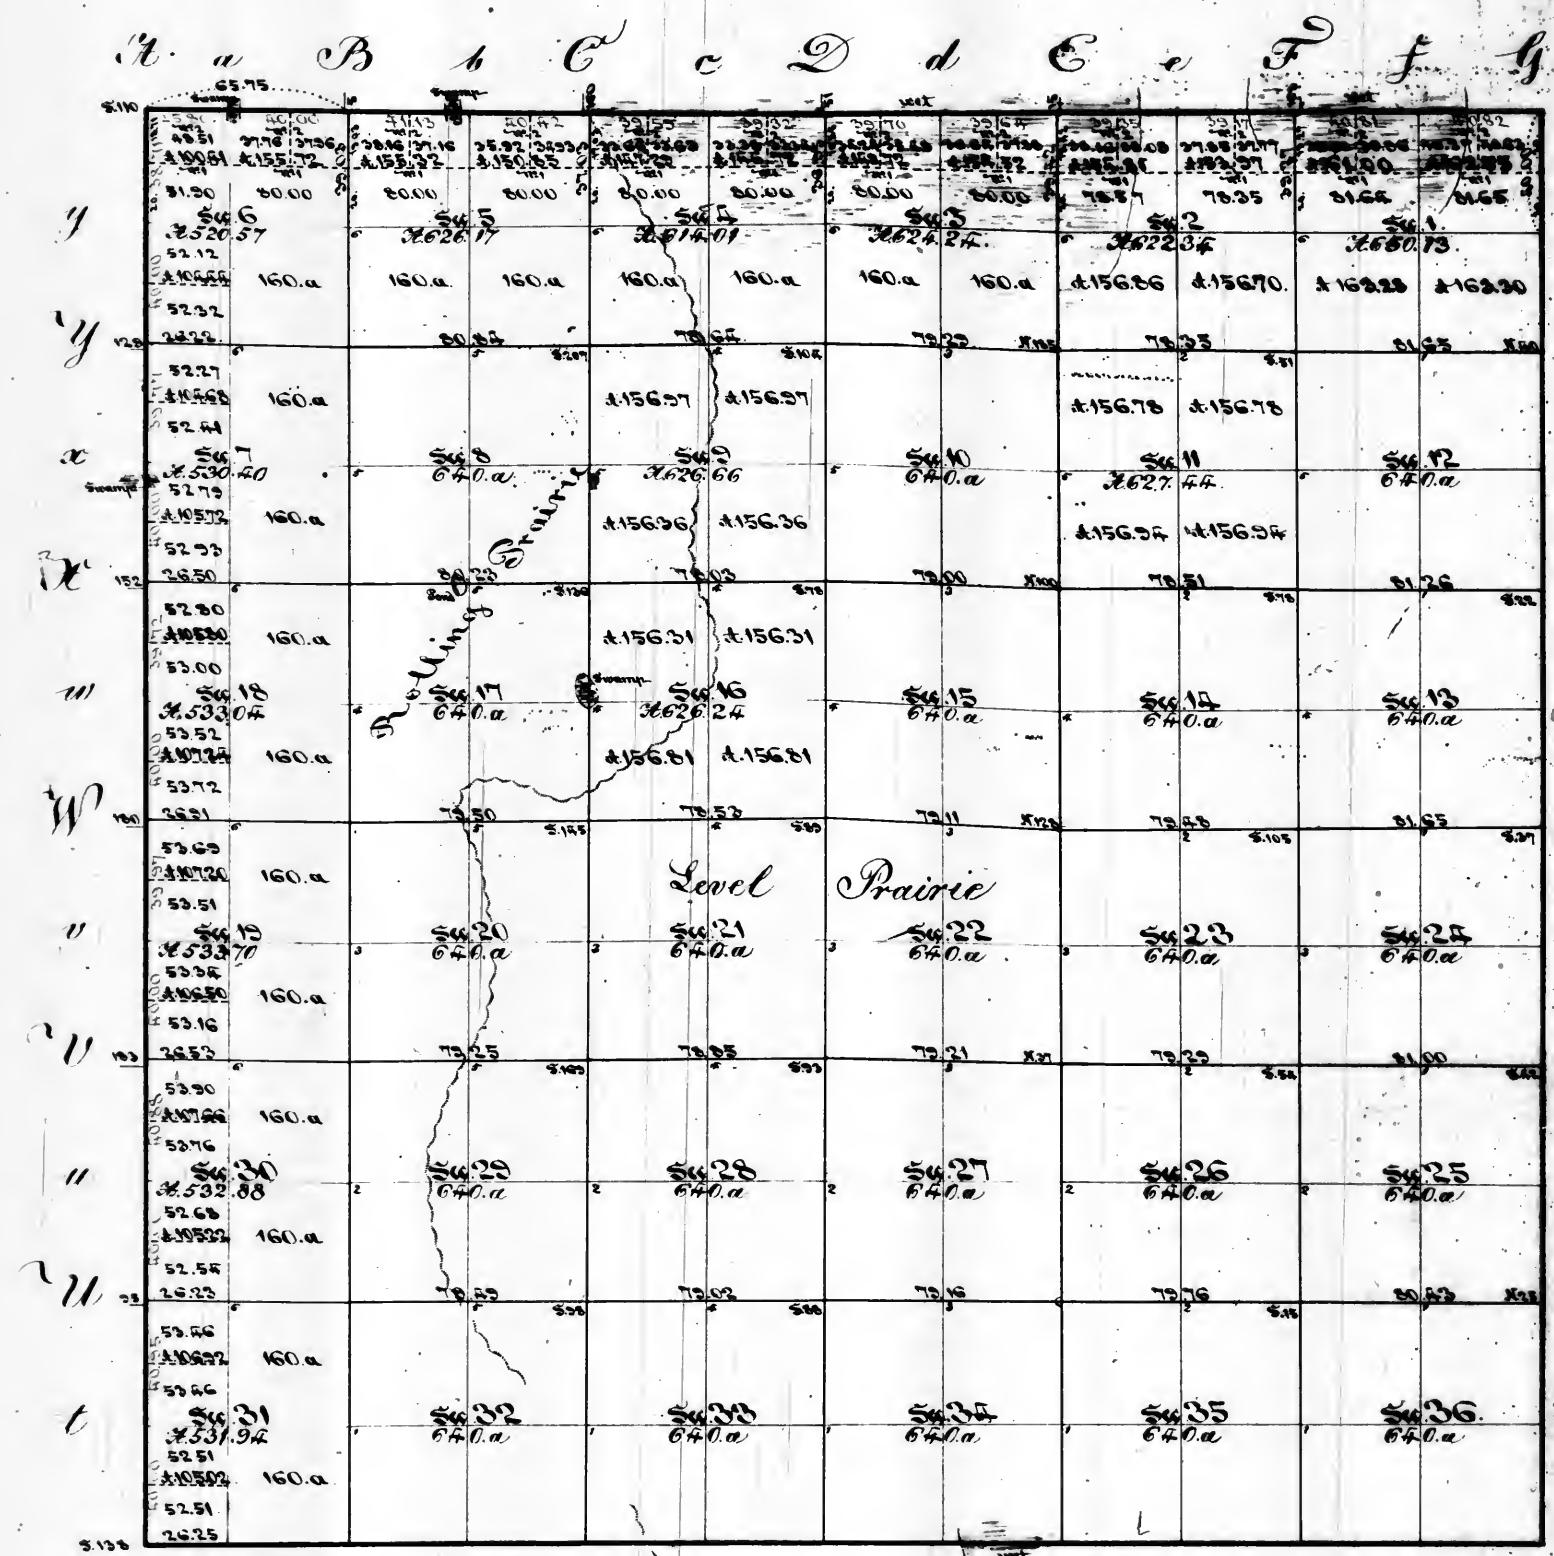

g
H
h
J
i
K
h
L
l
M
m
Ex

Correction
East & West boundary = 7° 10' E
North & South boundary = 7° 25' E
Subdivision lines = 7° 15' E

Township 39 North of the base line Range 3 East of the 3rd principal Meridian

Scale of 60 chains to an inch.
Aggregate area = 22279.76 acres.


| Designated | By whom Surveyed | Date of Contract or instructions | Amount of Surveying miles chains-links | When executed | When paid for | Amount of voucher in Town & Co's account | Remarks |
|-------------------|----------------------------------|--|--|-------------------------|----------------------------|--|---------|
| East boundary. | G. H. Spradling | under contract signed by the Gov. Feb. 20- | 6. 00. 00 | 4 th of 1833 | 20 th June 1833 | 8 of 2 nd of 1833 | |
| South boundary | | Apr. 1837 and by Special | 5. 66. 25 | | | | |
| West boundary. | | on 14 th May 1838 | 5. 66. 75 | | | | |
| North boundary | | | | | | | |
| Subdivision lines | G. M. Butler and W. H. G. Miller | 21 st October 1842 | 58. 73. 62 | 1 st of 1843 | 23 rd May 1843 | 6 of 2 nd of 1843 | |

Surveyor's Office.
Saint Louis 24th July 1842.
The above plat of township 39 north of the base line range 3 east of the 3rd principal meridian is strictly conformable to the field notes of the survey thereof on file in this office which have been examined and approved.
Silas Reed
Surveyor General.

Township 40 North of the base line Range 2 East of the 3d P.M.

58

58

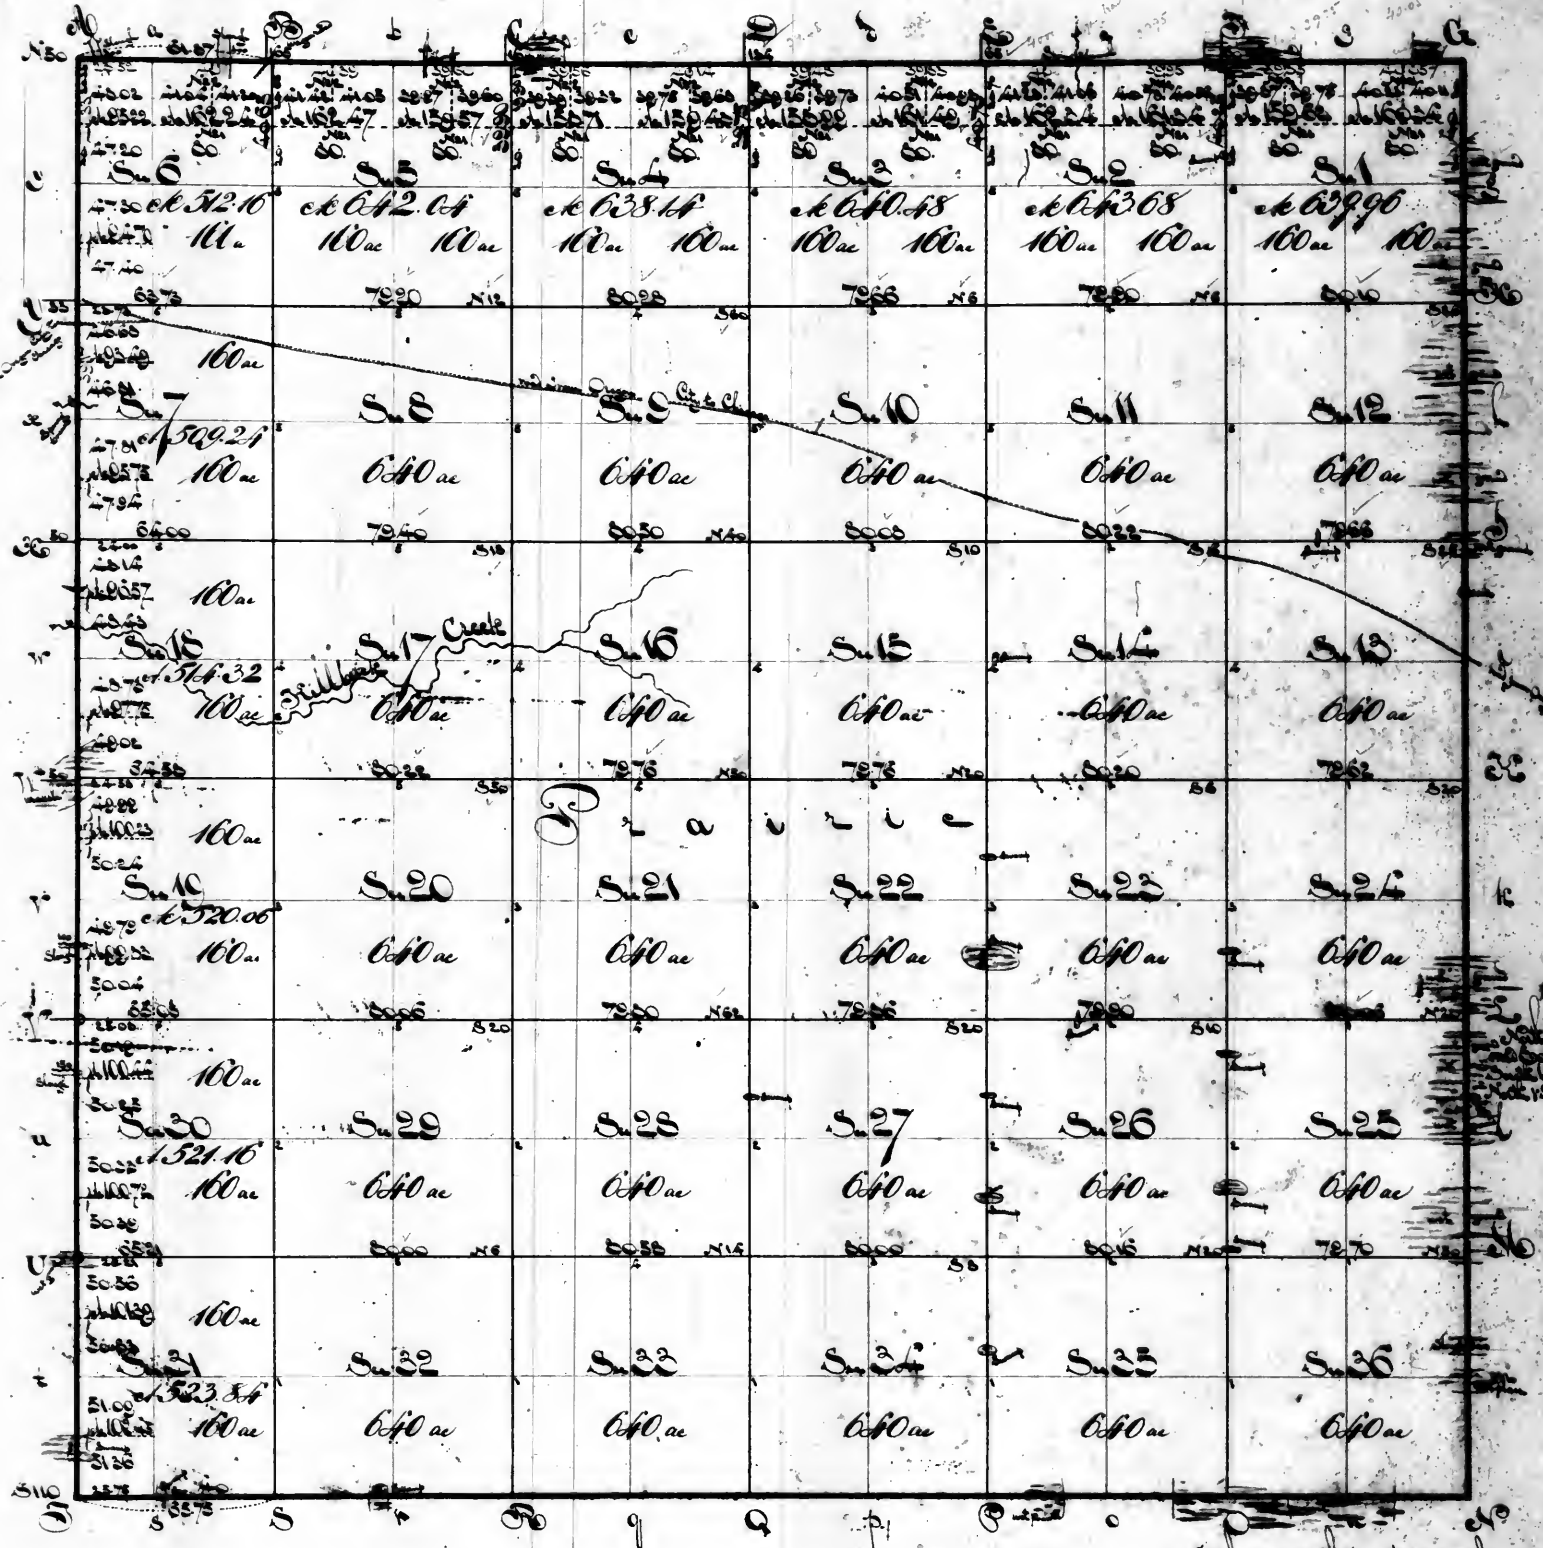

Scale of 40 chains to an inch
Aggregate Area 29205.00 acres


| Lines designated | By whom surveyed | Date of contract | Amount of surveying
miles, chains, links | When executed | When paid for | N ^o of vouchers in
Surveyor's account | Remarks |
|----------------------|----------------------------------|---|---|--|--|---|---------|
| South boundary | W. A. Spaulding | 20th Sept. 1837 by Gen. Govt.
14th May 1839 by Spaulding | 5. 65. 75 | 4 th q ^r of 1838 | 2 nd q ^r of 1839 | 8 of 2 nd q ^r of 1839 | |
| East boundary | W. A. Spaulding | do | 6. 00. 00 | 4 th q ^r of 1838 | 2 nd q ^r of 1839 | 8 of 2 nd q ^r of 1839 | |
| North boundary | do | do | 5. 61. 87 | do | do | 8 do. | |
| West boundary | do | do | 6. 00. 00 | do | do | 8 do. | |
| Subdivision
lines | R. C. Breathe &
G. B. Sargent | joint contract of
26 th of October 1842 | 59. 02. 53 | 1 st quarter of 1843 | 2 nd q ^r of 1843 | 2 of 2 nd q ^r 1843 | |

Surveyors Office.
Saint Louis, 26th May 1843.
The above plat of township 40 north of the base line
range 2 east of the 3^d principal meridian, is strictly
conformable to the field notes of the Survey thereof on file
in this office which have been examined and approved.
Silas Reed
Surveyor of the public lands in
the State of Missouri.

Township 41 North of the base line Range 3 East of the 3^d principal meridian

59

59

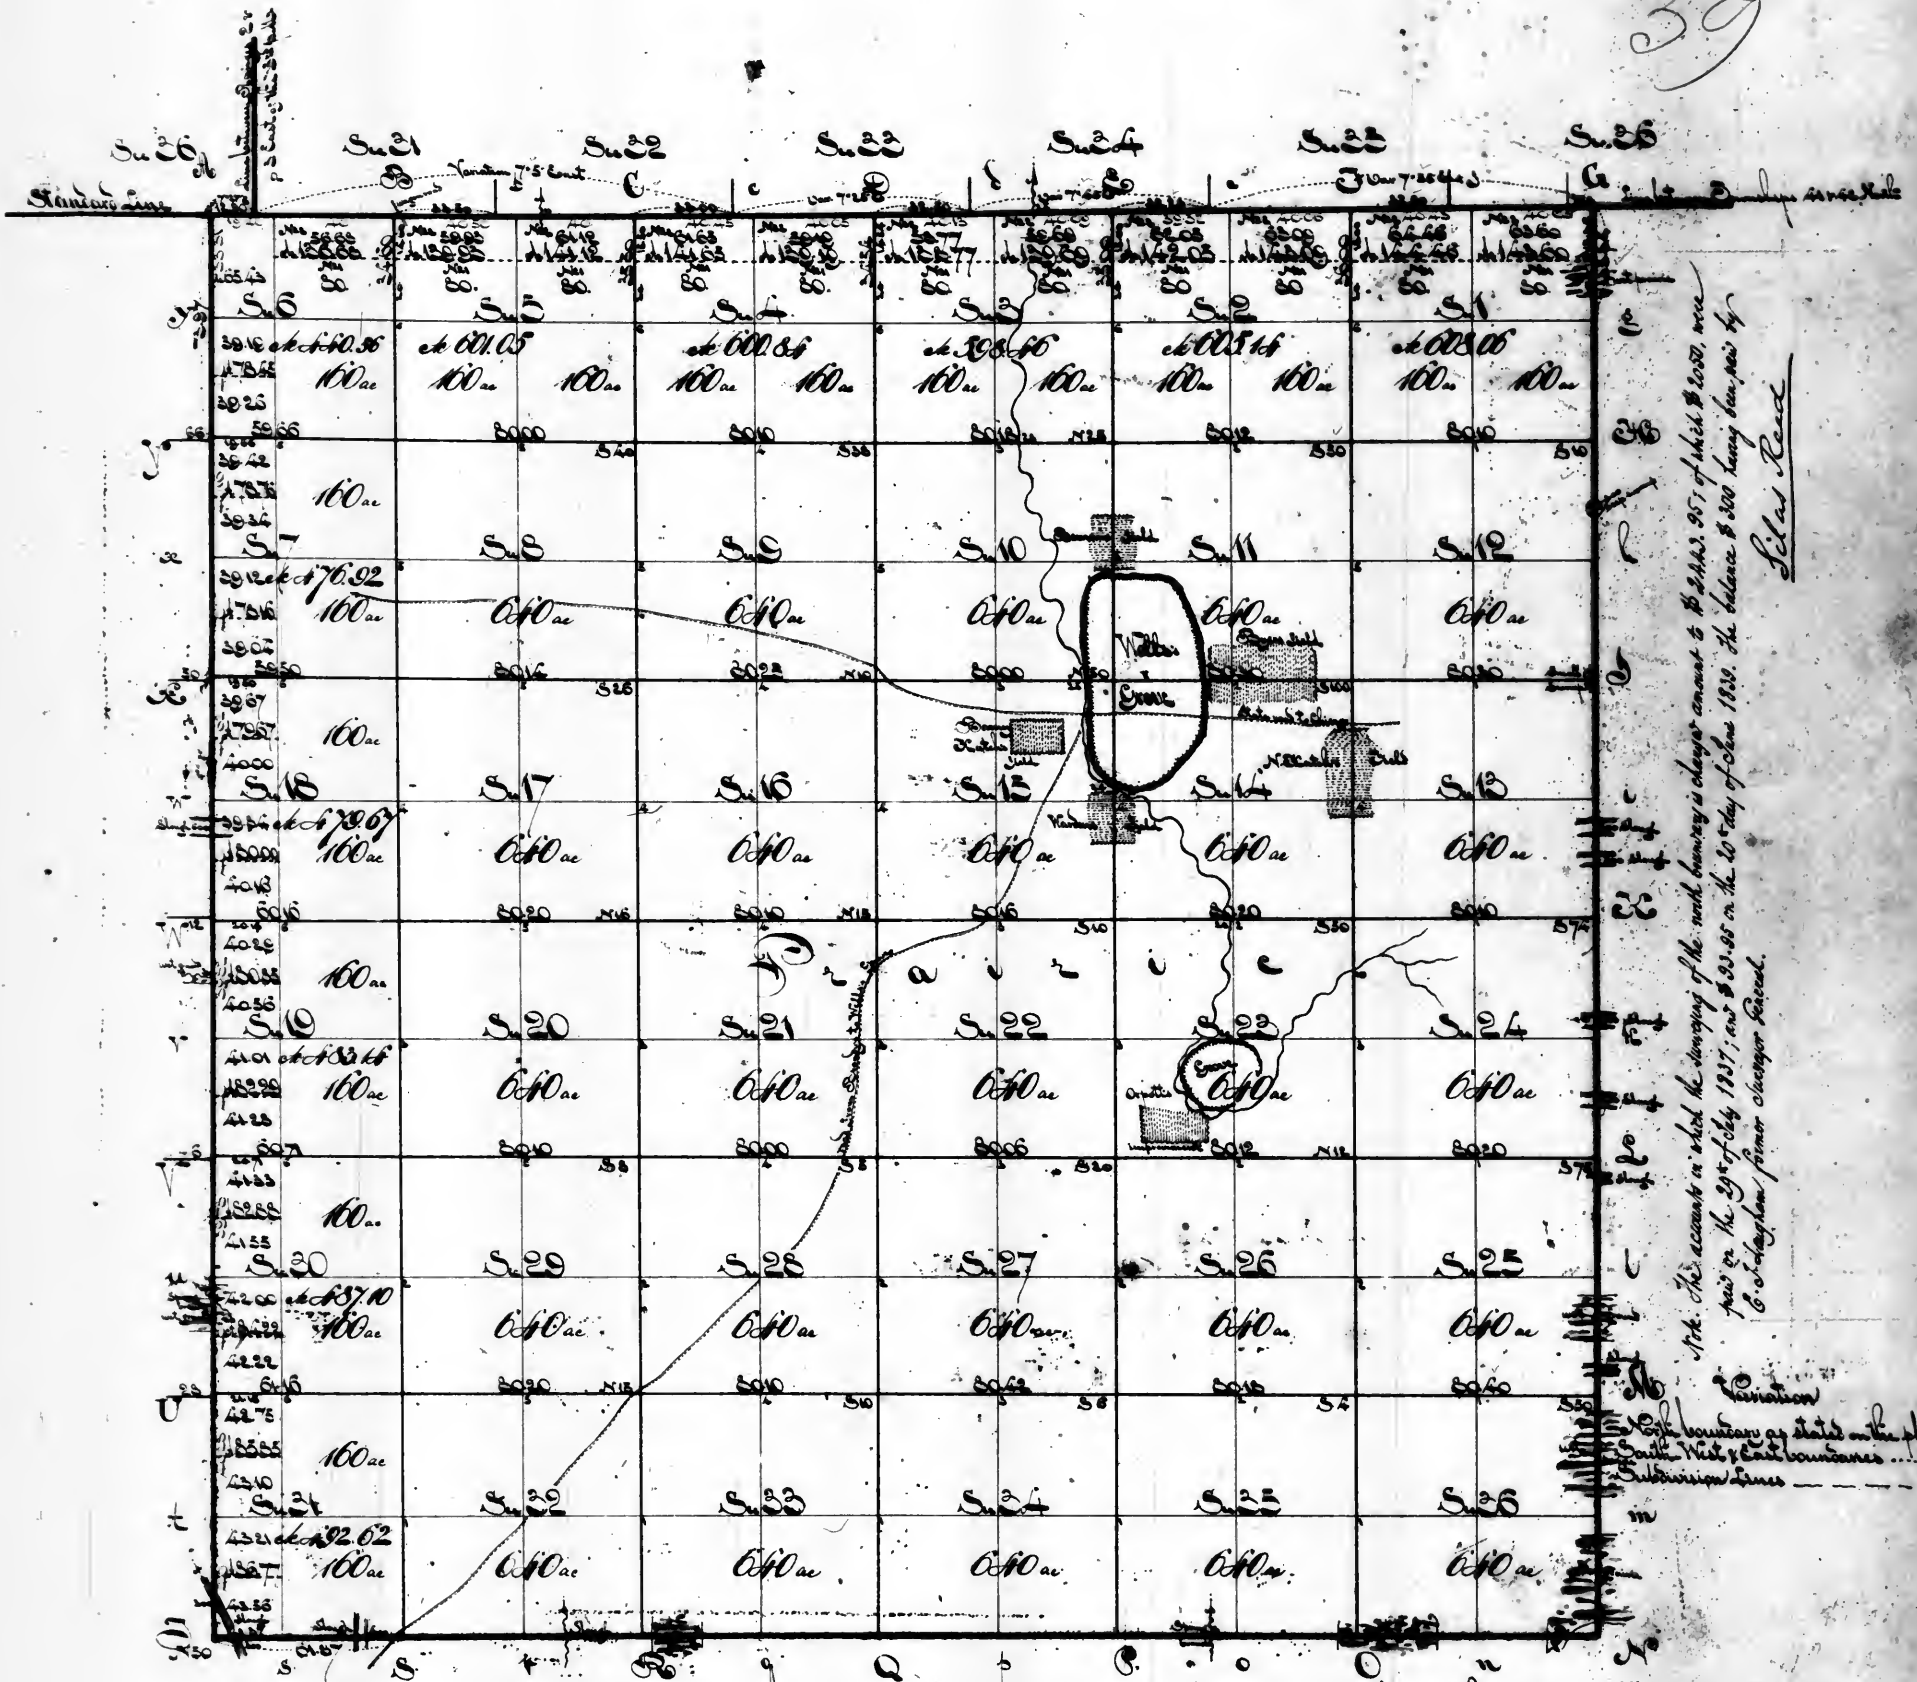


Silas Reed


Scale of 400 Chains to an inch
Aggregate Area 21872.56 acres.

| Lines designated | by whom surveyed | Date of contract | Amount of surveys
miles, chains, links | When executed | When paid for | No of vouchers in
Sur. General's account | Remarks. |
|----------------------|---------------------------------|--|---|--|---------------------------------------|---|-----------|
| North boundary | W. A. Spaulding | 9 th of June 1835 | 5. 60. 48 | 4 th q ^r of 1836 | 2 ^d q ^r of 1837 | 6 of 3 ^d q ^r of 1837 | See note. |
| East boundary | W. A. Spaulding | 20 th Sept. 1837 by Sur. Genl. | | | 2 ^d q ^r of 1839 | 7 of 2 ^d q ^r of 1839 | |
| South boundary | W. A. Spaulding | 4 th May 1838 by Spaulding | 5. 75. 84 | 4 th q ^r of 1838 | 2 ^d q ^r of 1839 | 3 of 2 ^d q ^r of 1839 | |
| West boundary | do. | do | 5. 61. 37 | do | do | 3. do | |
| Subdivision
lines | W. C. Forest &
G. D. Sargent | joint contract of
26 th of Oct. 1842 | 58. 42. 86 | 1 st quarter of 1843 | 2 ^d q ^r of 1843 | 2 of 2 ^d q ^r of 1843 | |

Surveyors office.
 Chas. Lewis 26th of May 1843.
 The above plot of township 41 north of the base
 line, range 3 east of the 3^d principal meridian is
 strictly conformable to the field notes of the survey
 thereof on file in this office which have been
 examined and approved.
 Silas Reed
 Surveyor of the public lands in
 the State of Missouri & Mississippi.

Ownership 42 North of the base line Range 3 East of the 3^d principal Meridian

60

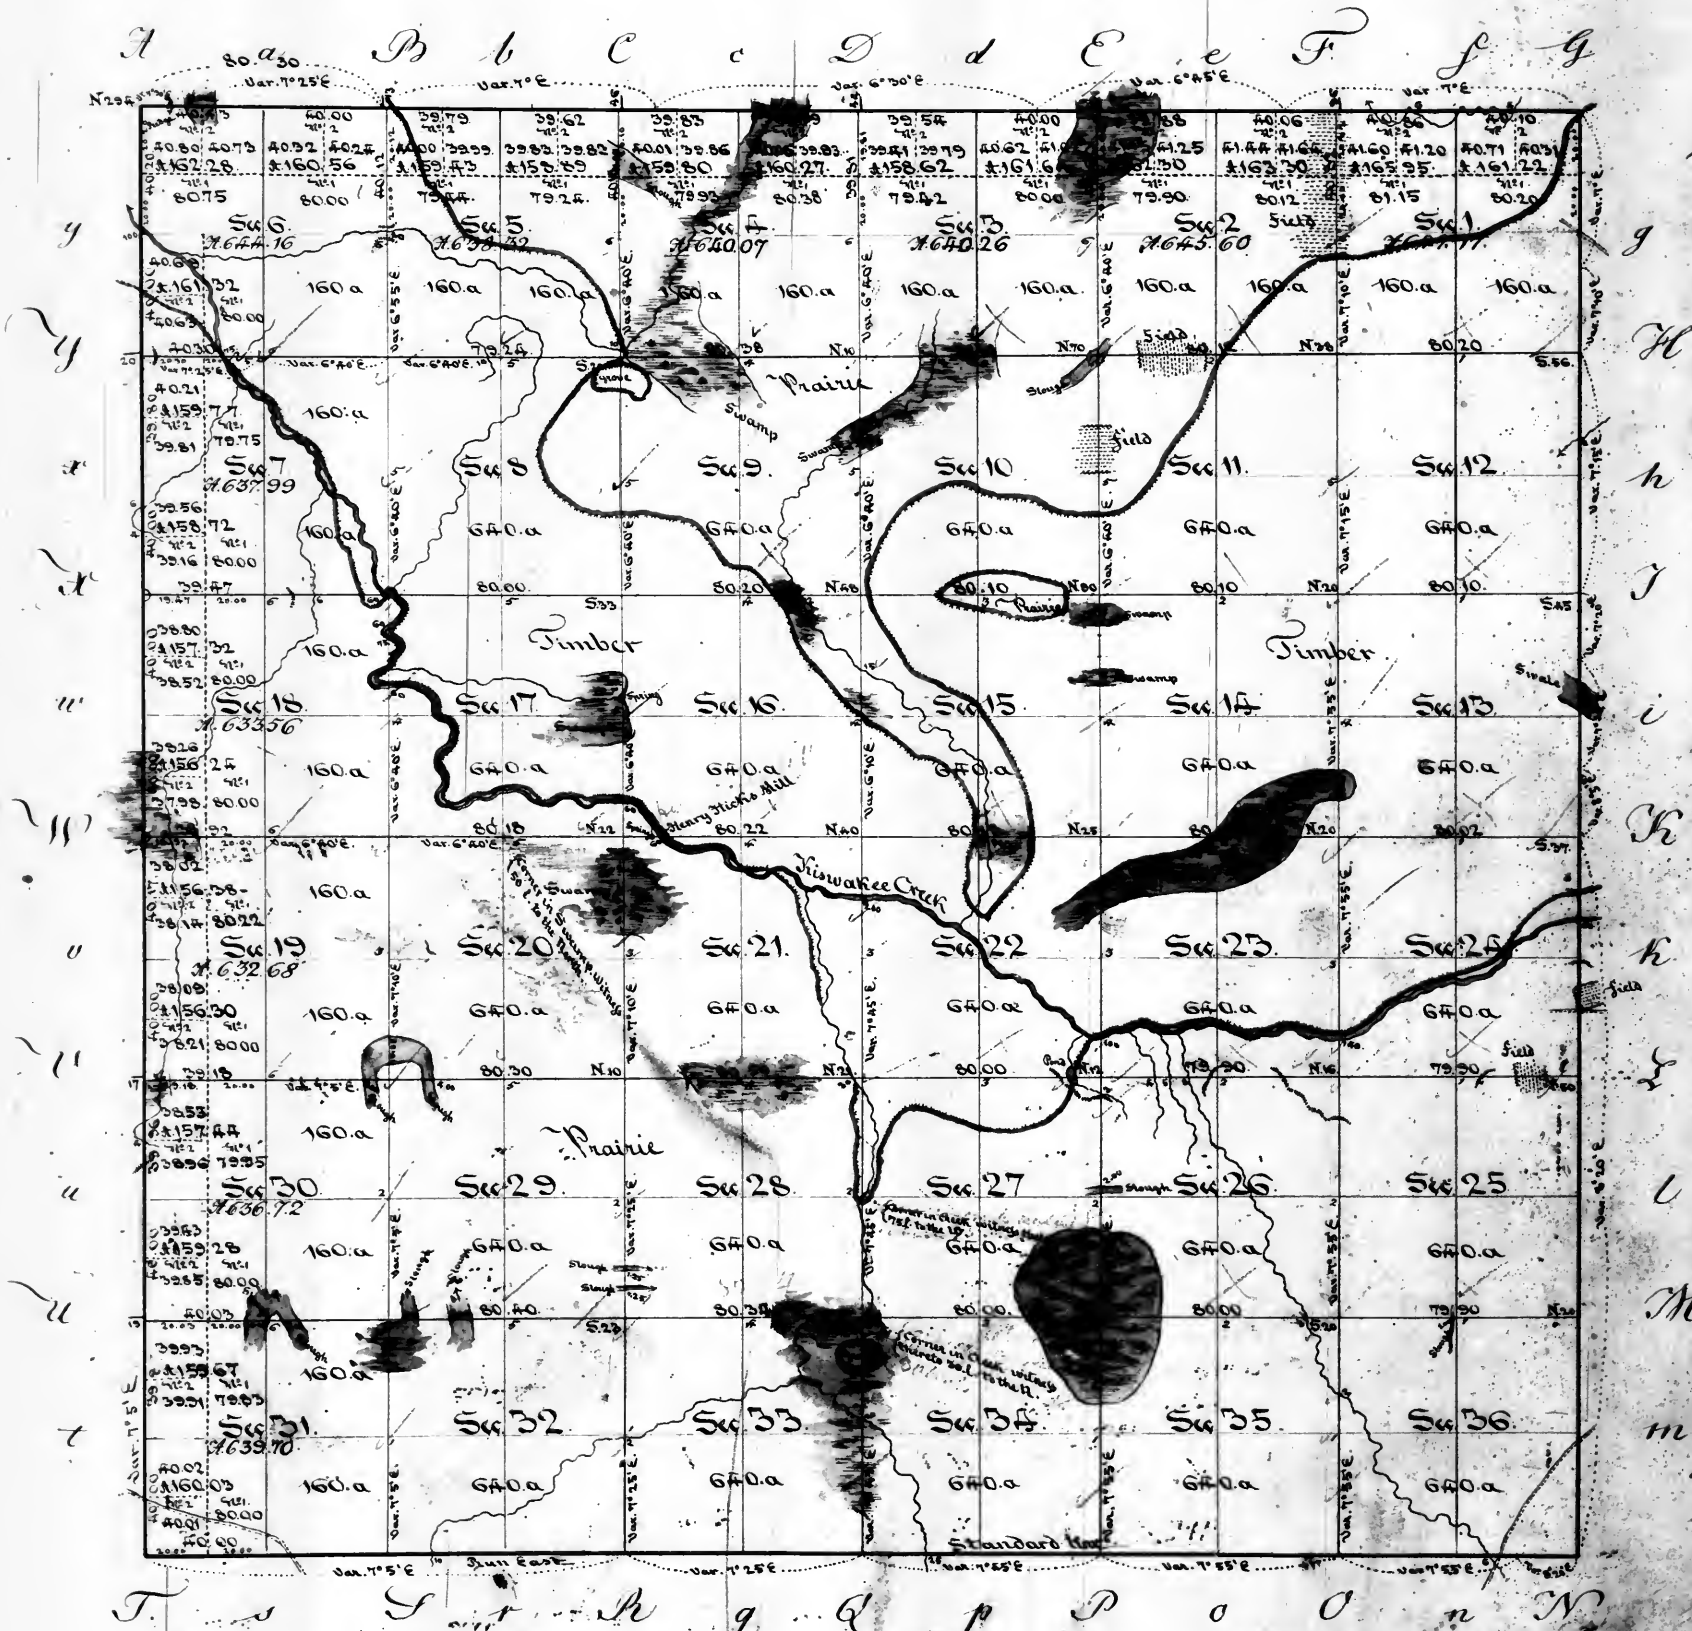

Note: The accounts in which the surveying of the boundary lines of this township is charged amount to \$2442.85/100 of which \$2000.00 were paid on the 29th of July 1837 - and \$442.85 on the 20th day of June 1838 - The balance being \$400.00 - having been paid by Elias J. Langham, former Surveyor General. See voucher No 6 of the account of the Surveyor General for the 3^d quarter of 1837. and voucher No 7 of accounts for the 2^d quarter of 1838.


Surveyor General's Office.
Saint Louis 3rd of July 1839.

Scale of 40 chains to an inch
Aggregate area = 23036.23 acres

The above plat of township 42 North of the base line range 3 East of the 3^d principal meridian is strictly conformable to the field notes of the survey thereof on file in this office which have been examined and approved. The west boundary 6 miles was surveyed in the 3^d quarter of 1836 - and the South boundary 6 miles - the east boundary 6 miles - and the north boundary 6 miles and 30 tenths - were surveyed in the 3^d quarter of 1836, all by Don Alonso Spaulding, under contract of the 3^d of June 1835; and with the former survey in the meadow, they were paid for in the 2^d quarter of 1837 and 2^d quarter of 1839, and charged in the accounts of the Surveyor General for those quarters Voucher No 6 and 7 - The subdivision lines 36 miles 1.71 chains were surveyed in the 4th quarter of 1838, by the Sp. Spaulding, under contract signed by the Surveyor General on the 29th of September 1837, and by Spaulding on the 14th of May 1838 - They were paid for in the 2^d quarter of 1839 and charged in the account of the Surveyor General for that quarter - Voucher No 8.

William Milburn
Surveyor General

Township 43 North of the base line Range 3 East of the 3rd principal Meridian

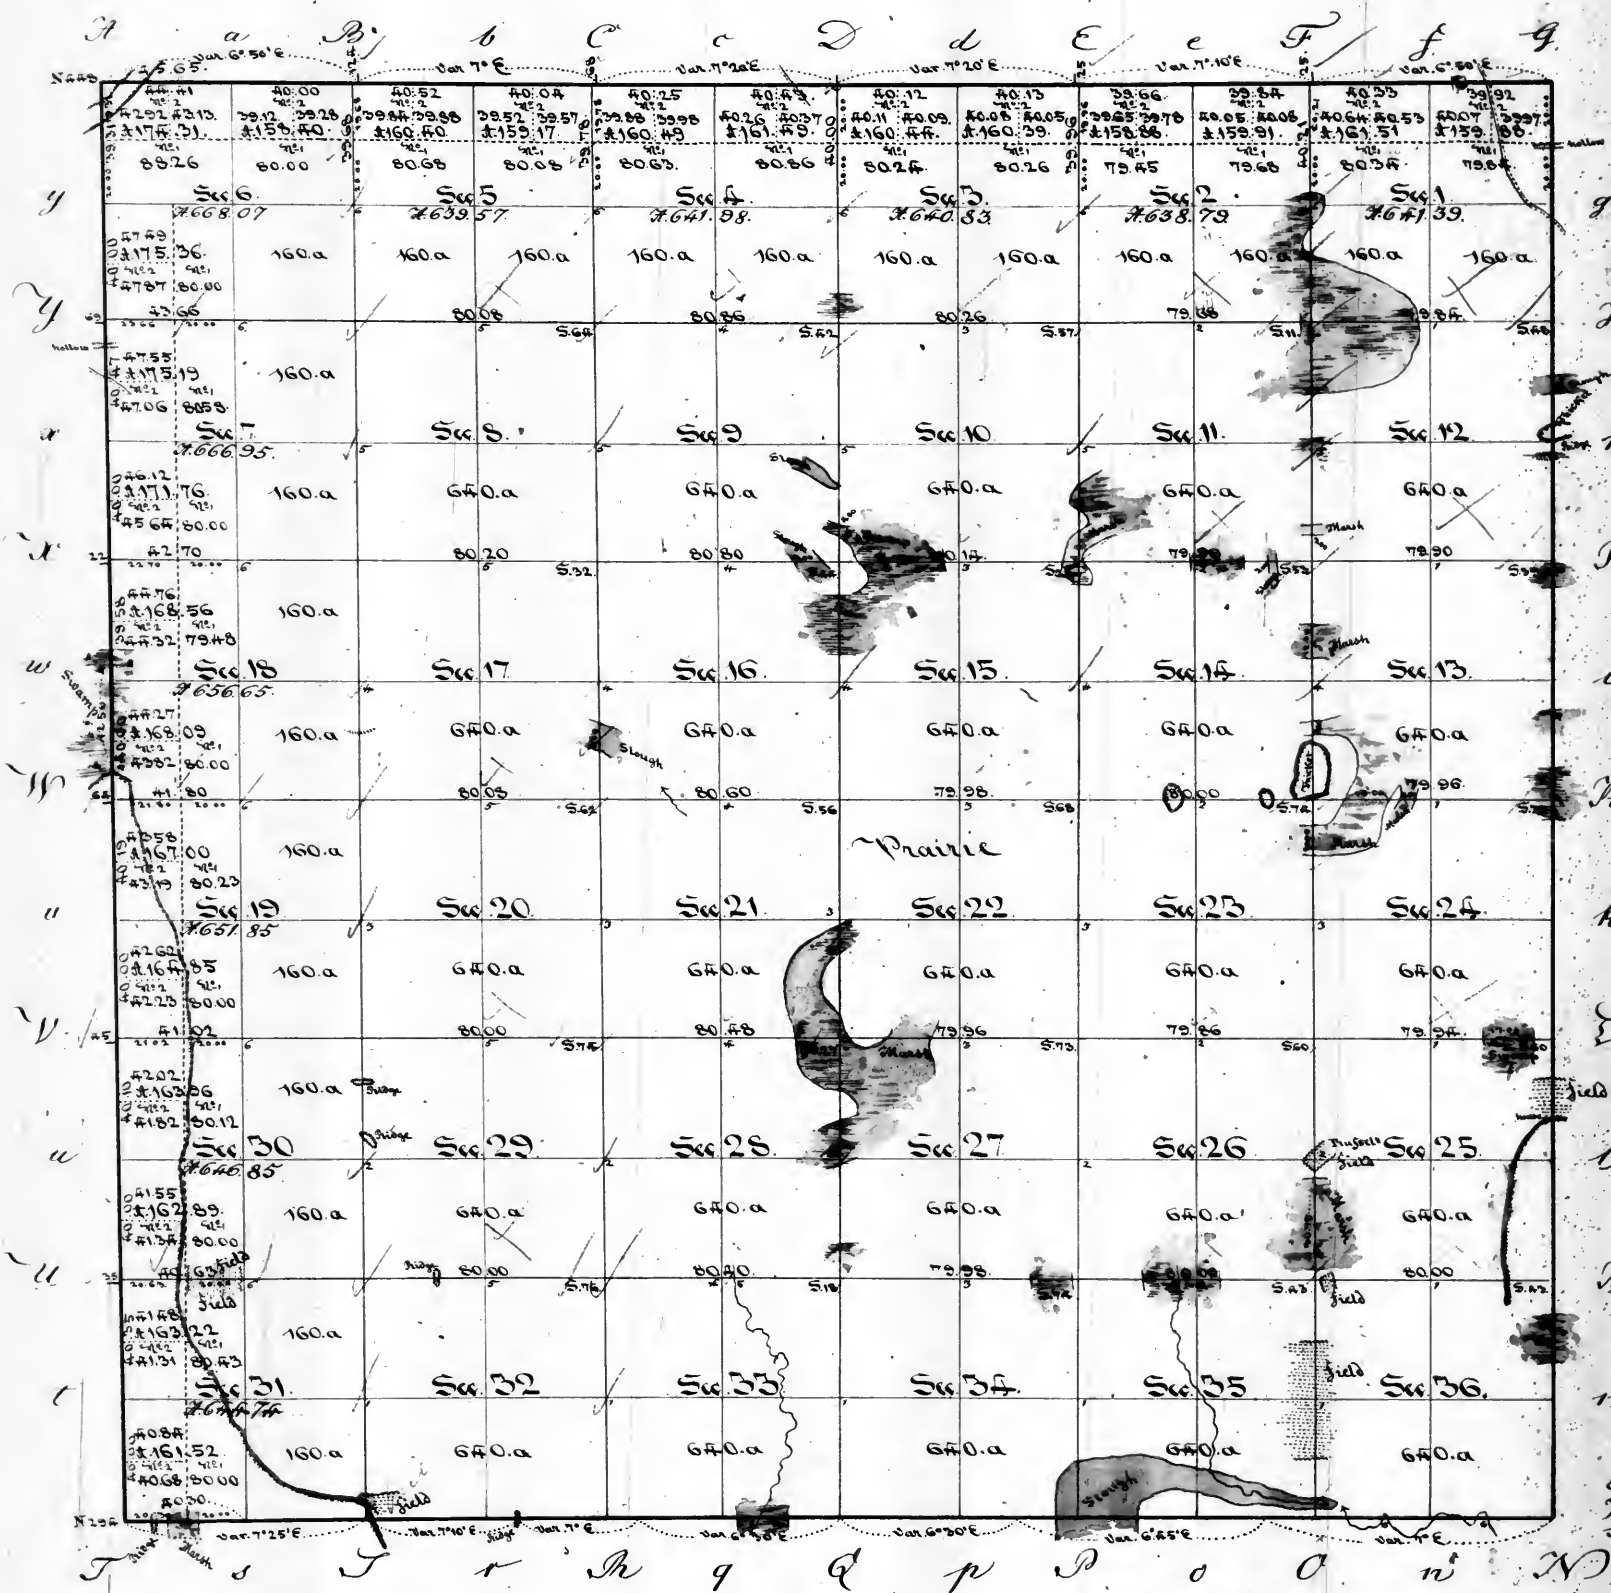

Note: The accounts in which the surveying of the boundary lines of this township is charged amount to \$2433.84, of which \$2050.00 were paid on the 29th of July 1837, and \$383.84 on the 20th day of June 1839. The balance being \$383.84, having been paid by Eliza J. Longham, former Surveyor General, her Voucher No. 6 of the accounts of the Surveyor General for the 3rd quarter of 1837, and Voucher No. 7 of the accounts for the 2nd quarter of 1839.

Variation
East boundary = 7° E
West — — — = 7° 35' E
Subdivision lines = 7° E

Surveyor General's Office.

St. Louis 1st of July 1839.


Scale of 40 chains to an inch
Aggregate area = 23137.67 acres.

The above plat of Township 43 north of the base line range 3 east of the 3rd principal meridian is strictly conformable to the field notes of the survey thereof on file in this office which have been examined and approved. The west boundary 6 miles was surveyed in the 3rd quarter of 1836, and the South boundary 6 miles and 30 links, the east boundary 6 miles and the north boundary 6 miles 5.65 chains were surveyed in the 4th quarter of 1836 — all by John Long Spaulding, under contract of the 3rd of June 1835, and with the limitation noted in the margin were paid for in the 3rd quarter of 1837 and 2nd quarter of 1839, and charged in the accounts of the Surveyors General for those quarters Vouchers No. 6 and 7. — The subdivision lines 60 miles 13.34 chains were surveyed in the 4th quarter of 1838 by the said Spaulding under contract signed by the Surveyor General on the 20th of September 1837, and by the said Spaulding on the 14th of May 1838 — They were paid for in the 2nd quarter of 1839, and charged in the account of the Surveyor General for that quarter. Voucher No. 8.

William Melburn
Surveyor General

Township No. 44 North of the Base line in Range No. 3 East of the 3^d principal Meridian.

62

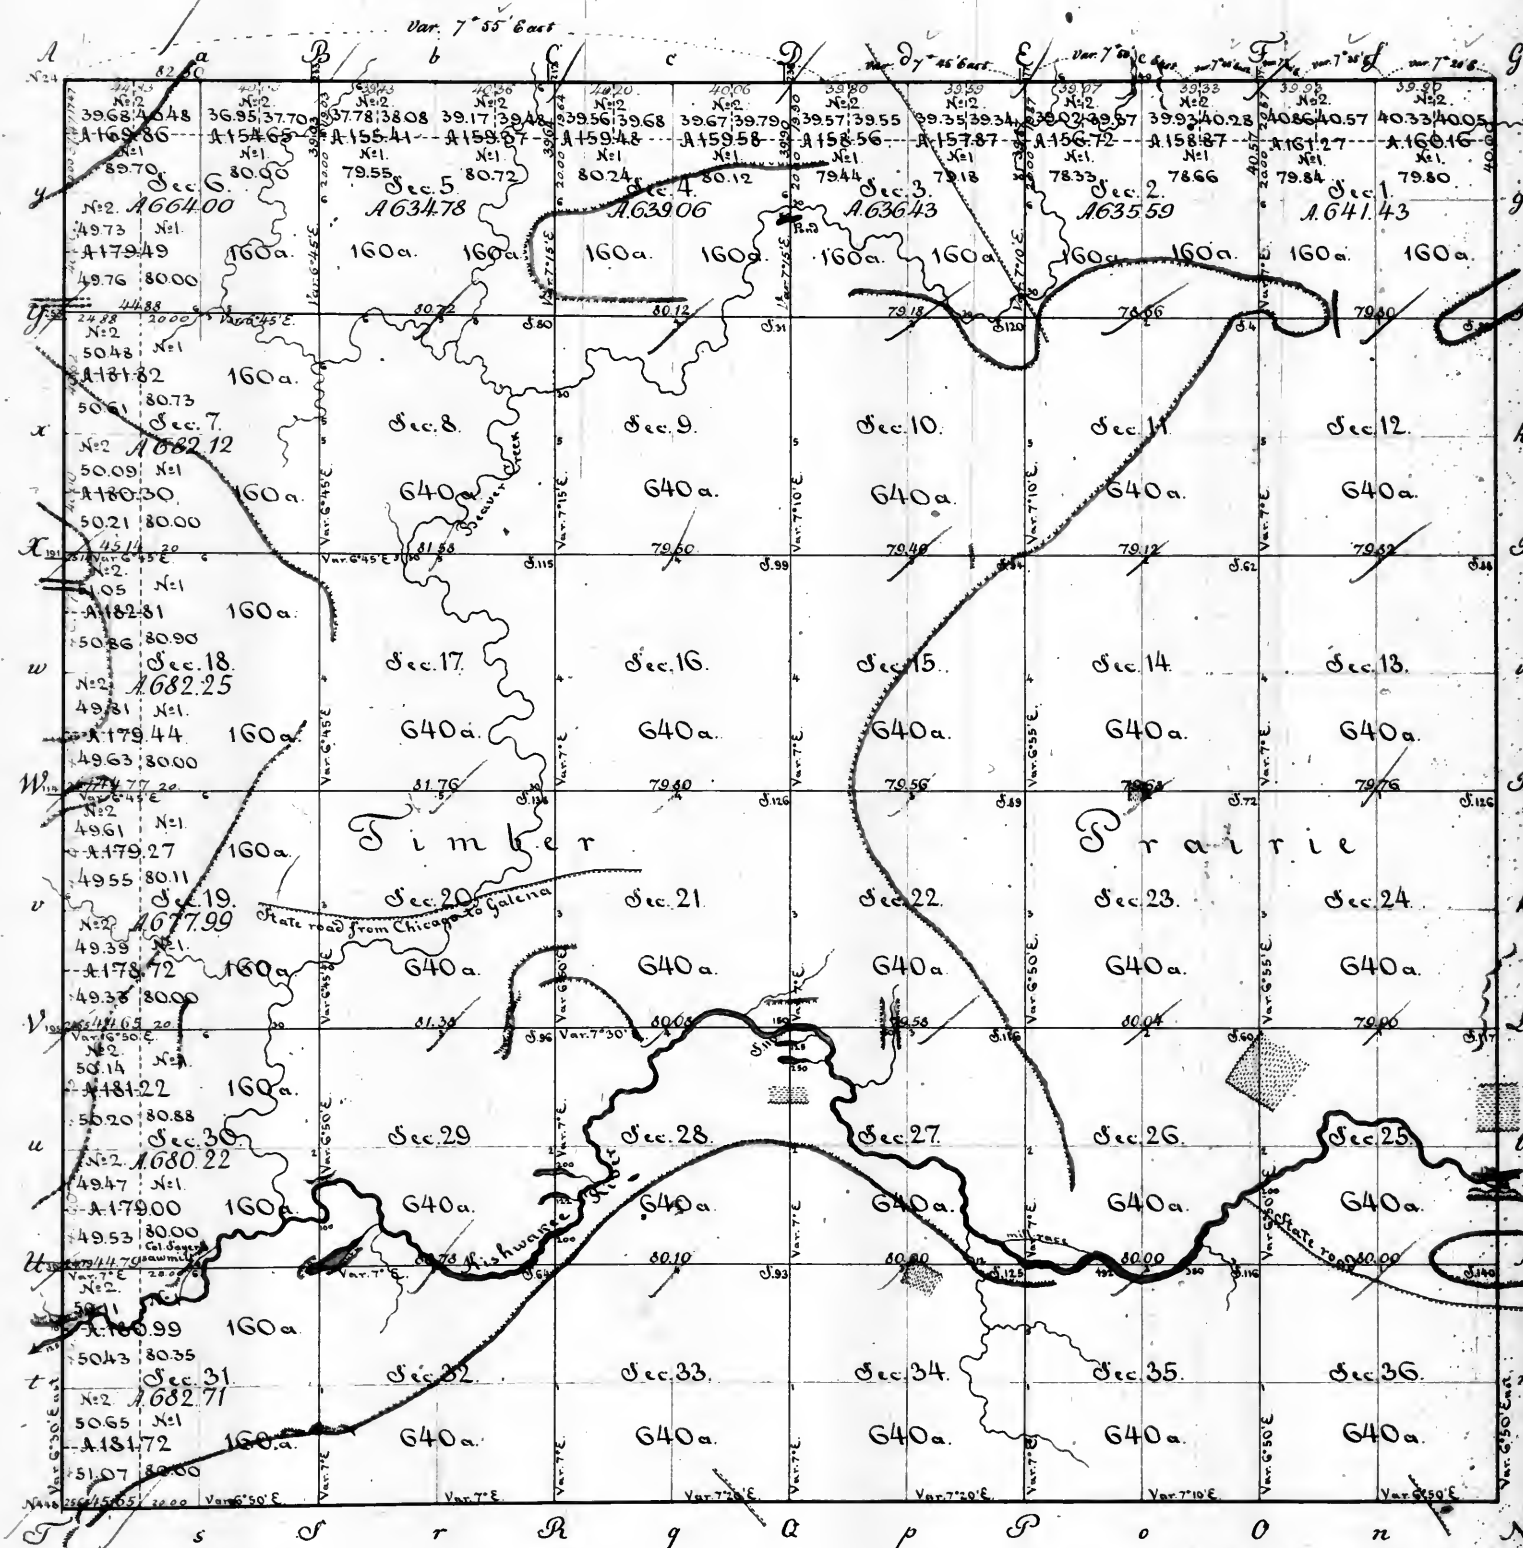

Note. The accounts in which the surveying of this township is charged amount to \$2,433.55; of which \$205.00 were paid in the 3^d quarter of July 1837, and \$99.50 in the 2^d quarter of June 1839. The balance being \$208.55, having been paid by Elias J. Langham, from Chicago General. Sec. under No. 6 of the Surveyor General's account for the 3^d quarter of 1837, and under No. 7 of the account for the 2^d quarter of 1839.

Surveyors Office.
Saint Louis 1st of July 1839.


Scale of 40 chains to one inch.
Aggregate Area 23254.58 acres.

The above plat of township 44 north of the base line range 3 East of the 3^d principal meridian, is strictly conformable to the field notes of the survey thereof on file in this office, which have been examined and approved. The west boundary, 6 miles, was surveyed in the 3^d quarter of 1836 - the South boundary 6 miles 5.65 chains - the east boundary 6 miles - and the North boundary 6 miles 2.50 chains were surveyed in the 4th quarter of 1836 - and the subdivision lines 60 miles 23.56 chains were surveyed in the 1st quarter of 1837 - and the accuracy of the survey of the suspended subdivision lines and of the North boundary was verified in the 4th quarter of 1837, all by D. Blong Spaulding, under contract of the 9th of June 1835 - and with the limitation noted in the margin, they were paid for in the 3^d quarters of 1837 and 2^d quarter of 1839 - and charged in the accounts of the Surveyor General for those quarters Vouchers No. 6 and 7.

William Milburn
Surveyor General

Township 45 North of the base line Range 3 East of the 3rd principal Meridian

63

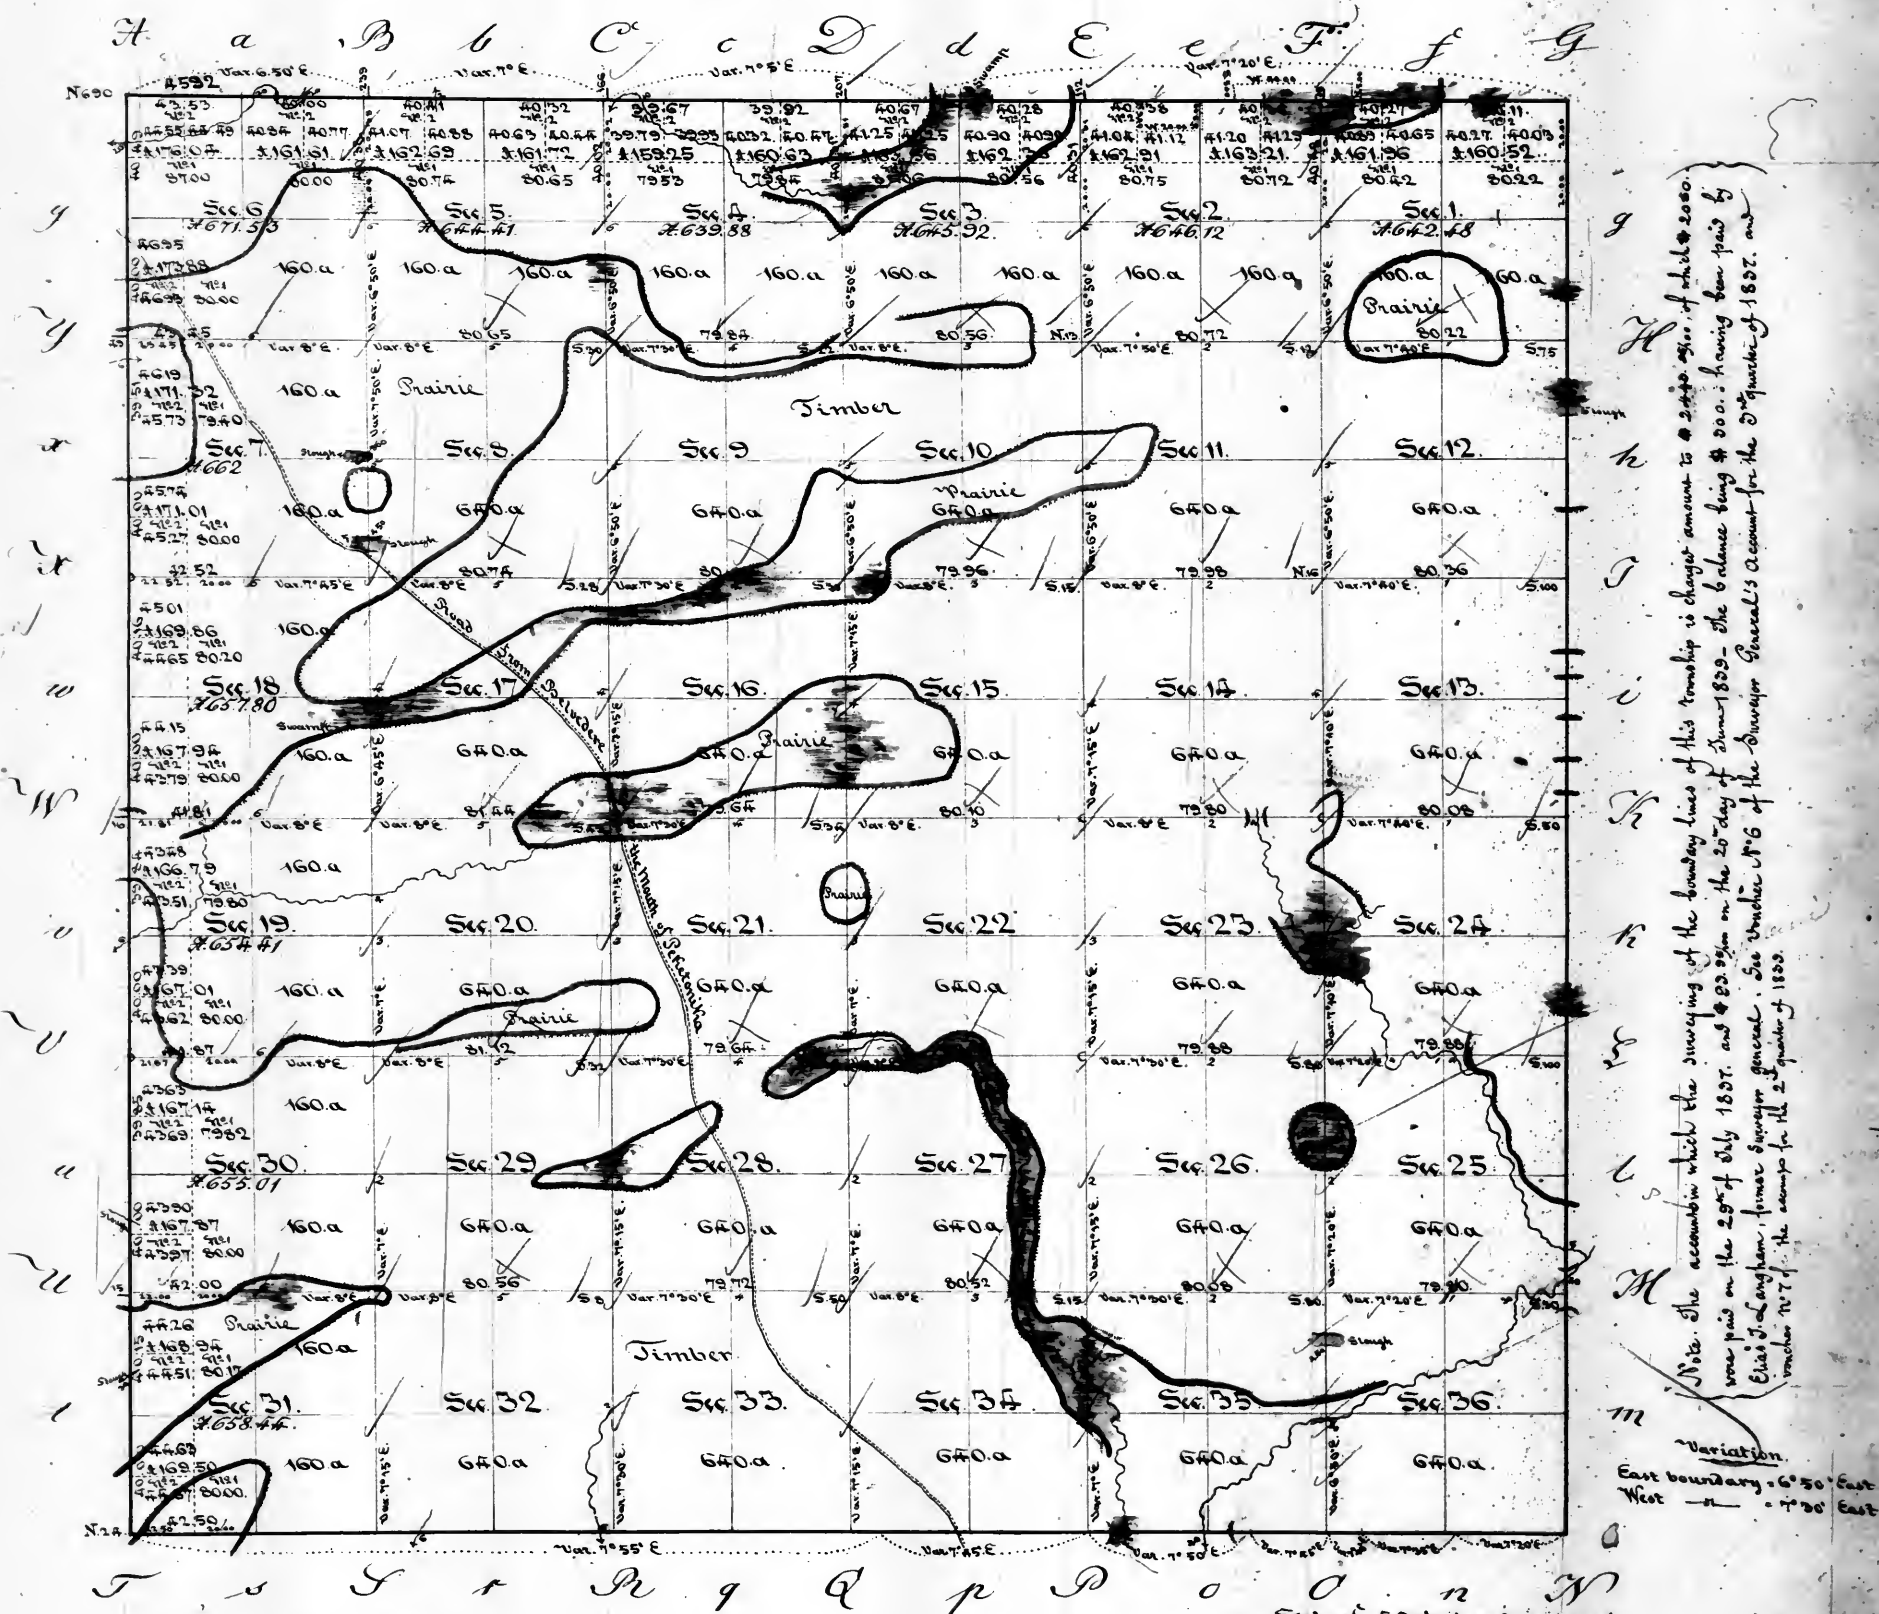

Surveyor General's Office.


Saint Louis 14th of July 1839.

The above plat of Township 45 north of the base line range 3 east of the 3rd principal meridian is strictly conformable to the field notes of the Survey thereof on file in this Office, which have been examined and approved. — The west boundary, 6 miles — The South boundary 6 miles 2.50 chains — the east boundary 6 miles and the north boundary 6 miles 5.92 chains were surveyed by Don Alongo Spaulding, in the 4th quarter of 1836, and with the limitation noted in the margin the east and west boundaries were paid for in the 2nd quarter of 1837 and 2nd quarter of 1839, and charged in the accounts of the Surveyor General for those quarters Vouchers No. 6 and 7. The South and North boundaries were paid for in the 2nd quarter of 1839, and charged in the account of the Surveyor General for that quarter, Voucher No. 7. The subdivision lines 60 miles 18.38 chains, were surveyed in the 4th quarter of 1838, by the said Don Alongo Spaulding, under contract signed by the Surveyor General on the 20th of September 1837, and by Spaulding on the 14th of May 1838. They were paid for in the 2nd quarter of 1839, and charged in the account of the Surveyor General for that quarter Voucher No. 8.

William Millburn
Surveyor General

Township 36 North of the base line Range 3 East of the 3rd principal Meridian

64

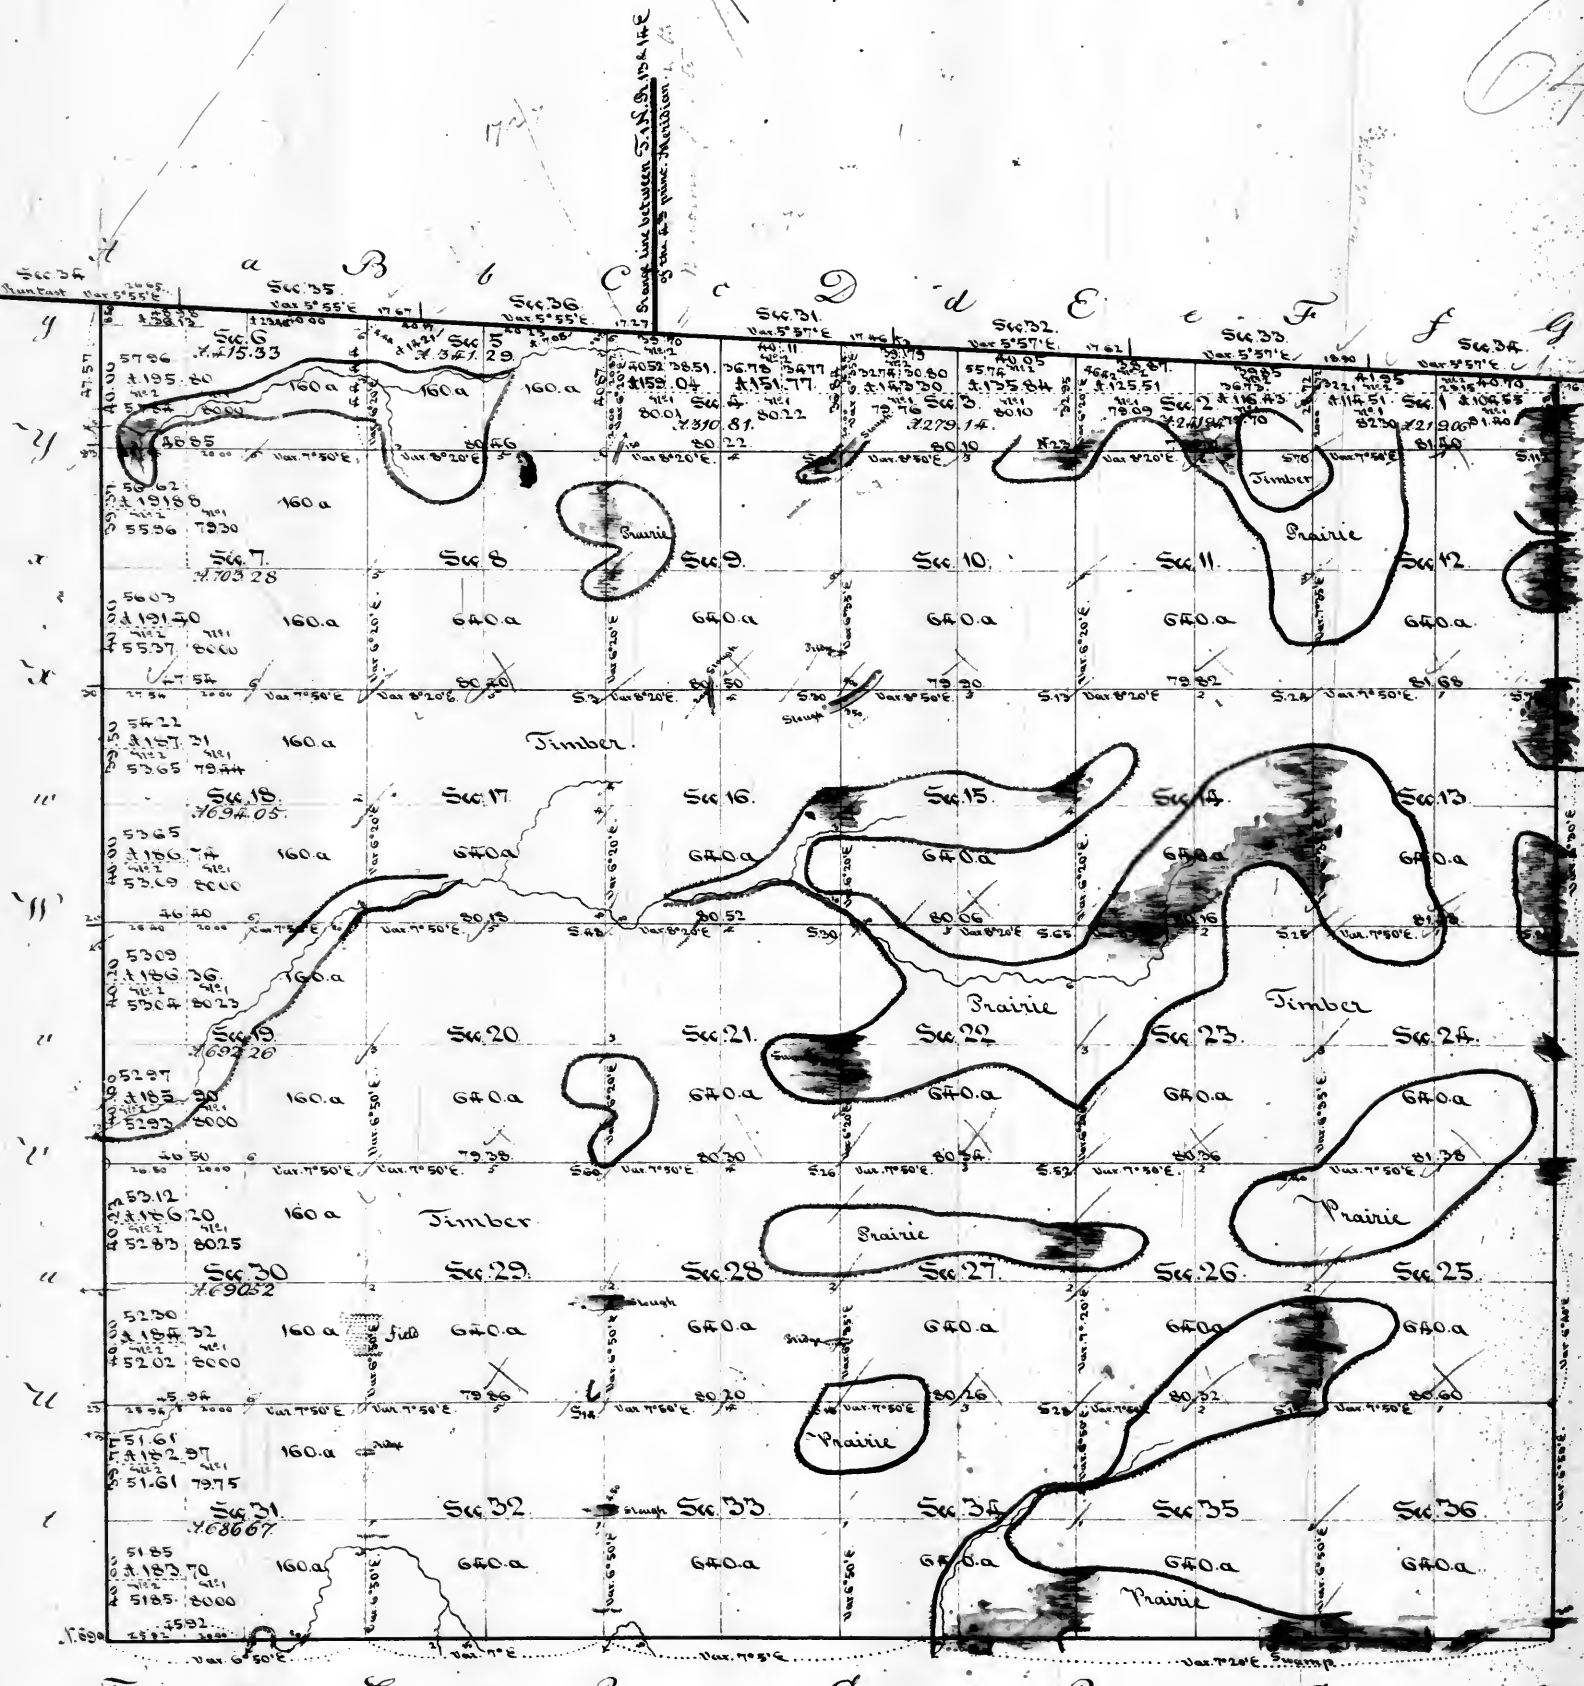

Note. The accounts in which the east, south and west boundary lines of the township are charged amount to \$2423.25, in which \$2500... were paid on the 25th of July 1837 - and \$833.25 on the 25th of July 1839 - the balance being \$200.00 having been paid by Elias Edgerton, from Surveyor General. The Voucher No. 6 of the account of the Surveyor General for the 3rd quarter of 1837 and Voucher No. 7 of account for the 2nd quarter of 1839.

T 36 N R 3 E
 Scale of 40 chains to an inch
 Aggregate area = 21274.35 acres.

Surveyor General's Office.
 Saint Louis 1st of July 1839.

The above plat of township 36 north of the base line, range 3 east of the 3rd principal meridian, is strictly conformable to the field notes of the survey thereof on file in this office which have been examined and approved. The north boundary 6 miles 10.50 chains was surveyed in 1832 and 1833 by Lucius Lyon, Commissioner on the part of the United States as certified to this office by Mr. J. Williams, Surveyor General of Ohio, Indiana & Michigan: - The said line being a part of the boundary between Illinois and Michigan, now Wisconsin: - The west boundary 5 miles 47.57 chains - The south boundary 6 miles 5.92 chains - and the east boundary 5 miles 24.63 chains, were all surveyed in the 4th quarter of 1836 by Gen. Alonzo Spaulding, under contract of the 9th of June 1835 - and with the limitation noted in the margin the West and East boundaries were paid for in the 3rd quarter of 1837 and 2nd quarter of 1839 - and charged in the accounts of the Surveyor General for those quarters Vouchers No. 6 and 7: - The South boundary was paid for in the 2nd quarter of 1839, and charged in the account of the Surveyor General for that quarter, Voucher No. 7. - The subdivision lines 57 miles 68.62 chains were surveyed in the 4th quarter of 1838, by Gen. Alonzo Spaulding, under contract signed by the Surveyor General on the 20th of September 1837, and by Spaulding on the 14th of May 1838 - They were paid for in the 2nd quarter of 1839, and charged in the account of the Surveyor General for that quarter Voucher No. 8.

William Milburn
 Surveyor General

VOL. 27

Township 26 North of the base line Range 4 East of 3rd principal Meridian


Surveyor General's Office
St. Louis 27th of August 1835

Reference to the field notes used in the construction of this map of the South boundary and signed dated in March 1832 of the East, North & West corner Daniel & Subdivision lines by the same Moore and in his contract of the 12th of August 1833 and changed for in his contract of the 3rd of April 1835.

The East boundary was laid 18th of October 1833.

North boundary was laid 20th of October 1833.

West boundary was laid 31st of October 1833.

Subdivision lines were laid from the 22nd to the 29th of October 1833.

The East North & West boundaries & the Subdivision lines were surveyed by the same Moore and in his contract of the 12th of August 1833 and changed for in his contract of the 3rd of April 1835.

William H. Harrison
Surveyor General

Surveyor's Office
St. Louis 14th of Sept. 1835
Plot of the North boundary of the 6th and 7th sections of the 6th and 7th ranges of the 26th township of the 4th range of the 3rd principal Meridian.


Plotted the
Notes of sections 1, 2, 1000.

Aggregate Area 23028.89 Acres

Surveyor's Office
St. Louis 14th of Sept. 1835
The above Plot of Township 26 North of the base line Range 4 East of 3rd principal Meridian is conformable to the field notes of the survey thereof on file in this Office

E. J. Langham

2

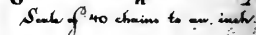

Aggregate Area 23041.67 acres

Surveyors Office
St. Louis *Apr. 14th 1855*

Surveyors Office
St. Louis *Apr. 14th 1855* The above Plat of Township 2 North of the base line Range 4 East of 3^d principal Meridian is conformable to the field notes of the survey thereof on file in this Office

E. J. Sangham

Reference to the field notes used
in the construction of this Plate,
of the South, East, North West
boundaries & the Subdivision
lines by James Moore under
his contract of the 12th of August
1853 and changed Feb in his account
of the 3rd of April 1855.

The notes of the South boundary are
dated 29th of October 1853.
East boundary on date
15th of November 1855
North boundary on date
5th of November 1855.
West boundary on date
23rd of November 1855.
Subdivision lines on date
20th of October 5th of Novem-
ber and from 15th to the 24th of
December 1853.

The West boundary of this Township
was surveyed at a bearing Variation
of $7^{\circ} 30'$ East.


The East & North bound.
Darius & the Subdivision lines were
surveyed at a Variation of $7^{\circ} 30'$
East.

William Miller
Inverclyde

Surveyor's Office
St. Louis 11th Sept. 1841.
Plot of the North halves of Secs 1, 2, 3,
4, 5 & 6, of the S.W. 1/4 of Sec 6, and of the
West halves of Secs 7, 8, 9, 10 & 11, sent
this day to the Comdr. of the Post
Land Office.

Corrections were made in the areas
of the 6th, 7th of sect 3, & 17th of
sect 7, & 5th of sect 19 - and
a plat thereof sent to the Commis-
sioner of the Land Office, on the
6th of June 1849.


On the same day, plat of the
North halves of sections 1, 2, 3, & 6th,
the West half of sect 6, 7, 17, 19 &
the 17th of sect 31 - were sent
to the Register at Danville,
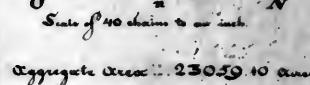
$$\begin{array}{r} 3973. \\ 4150. \\ \hline 807.0 \end{array}$$


Lunsford's Office
 St Louis 15th Sept. 1869.
 Plat of the North halves of lots 1, 2, 3,
 5 & 6 of the 5th quarter of lot 6, and of the
 West halves of lots 7, 8, 9, 10, 11, 12, and
 13, lying in the County of the said State.
 On the 6th of June 1869 -
 a plat of the S. W. quarter
 of section 14, 2, was made to
 Comm: of the Co. "East" Officers
 and on the same day, Plat
 of the North halves of section
 1, 2, 3, 4, 5 & 6, S. E. q. of lot 6,
 and West halves of sections 7, 8,
 9, 10, 11, 12, were sent to the
 Register at Darvill. Ill.

E. J. Sangham

79 06

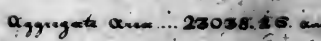


Surooy's Office
 St. Louis 10th Sept. 1842.
 Plate of the North halves of seed 12, 3
 & 546, of the S. N. halves of seed, being
 the West halves of seed 1
 was sent to the Com. of the Ind. Land
 On the 6th of June 1843,
 Plate of the North half of
 of seed 1, 546, of seed 3
 and 17, 19, of seed 19, were
 sent to the Com. of the Ind. Land
 on the same day. Plate of
 North halves of seed 1, 62
 of seed 3. West halves
 of seeds 6, 7, 18, 19, 30 & 31
 of seed 9, of seed 6 - were
 sent to the Register -

E. J. Sargham

Township 30 North of the base line Range 4 East of 3rd principal Meridian

5

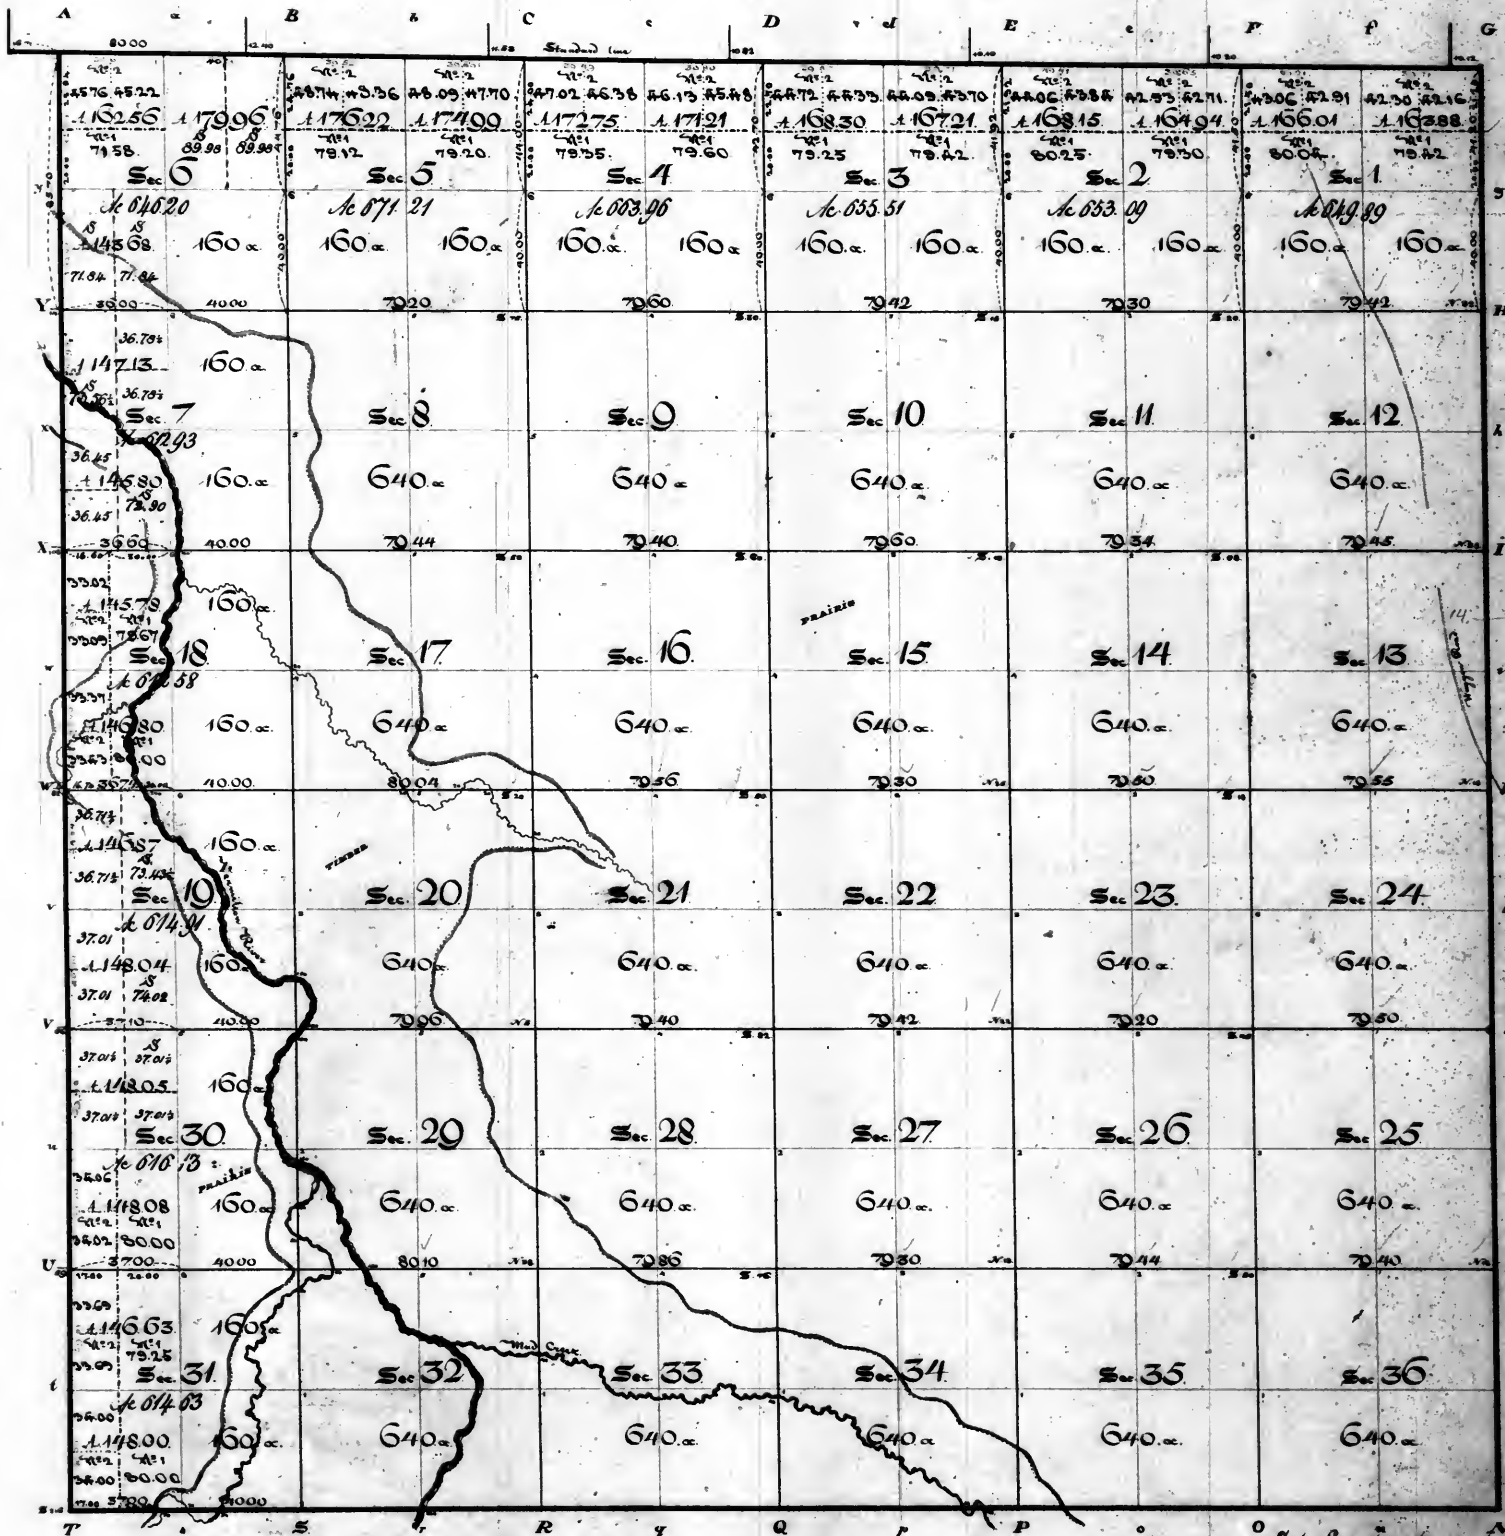

Surveyor General's Office
St. Louis 27th of August 1835.
Reference to the field notes used in
the construction of this Plate
of the North boundary of James
Wells dated 13th & 14th of May 1835
of the South East & West town
divided Subdivision lines by
James Wells under his contract
of the 12th of August 1835 and
changed for in his account of the
3rd of April 1835.
The note of the North boundary on
2nd 18th of November 1835
East boundary on 2nd
19th of November 1835
West boundary on 2nd
19th of November 1835
Subdivision lines on 2nd
20th & 27th of the
November 1835.
Matthew H. Sullivan
Surveyor General

The field notes of the North town.
Dated 13th & 14th of May 1835
which was changed
The South boundary was changed at
a Variation of 8th 50' East
The West boundary was changed at
a Variation of 8th 40' East
The East boundary of the Subdivi-
sion lines was changed at a
Variation of 8th 30' East.
Matthew H. Sullivan
Surveyor General



On June 6th 1835 -
A plat of the West halves of
sects 7 & 19, 8 & 21, 9 & 23
of sec. 6 and 11, 12 & 14 of sec. 1
of the North halves of sections
1, 2, 3, 4 & 5, 6 & 7, 8 & 9
of sec. 6, and West halves of
sections 7, 19, 31 & 33, were sent
to the Register at Danville.

Surveyor's Office
St. Louis 10th of 1835

The same Plate of Township 30 North of the base line Range 4 East of 3rd principal Meridian is conformable
to the field notes of the survey thereof on file in this Office.

E. J. Langham

T34S of Township 31 North of the Base line, Range 4 East of the 3^d Principal Meridian

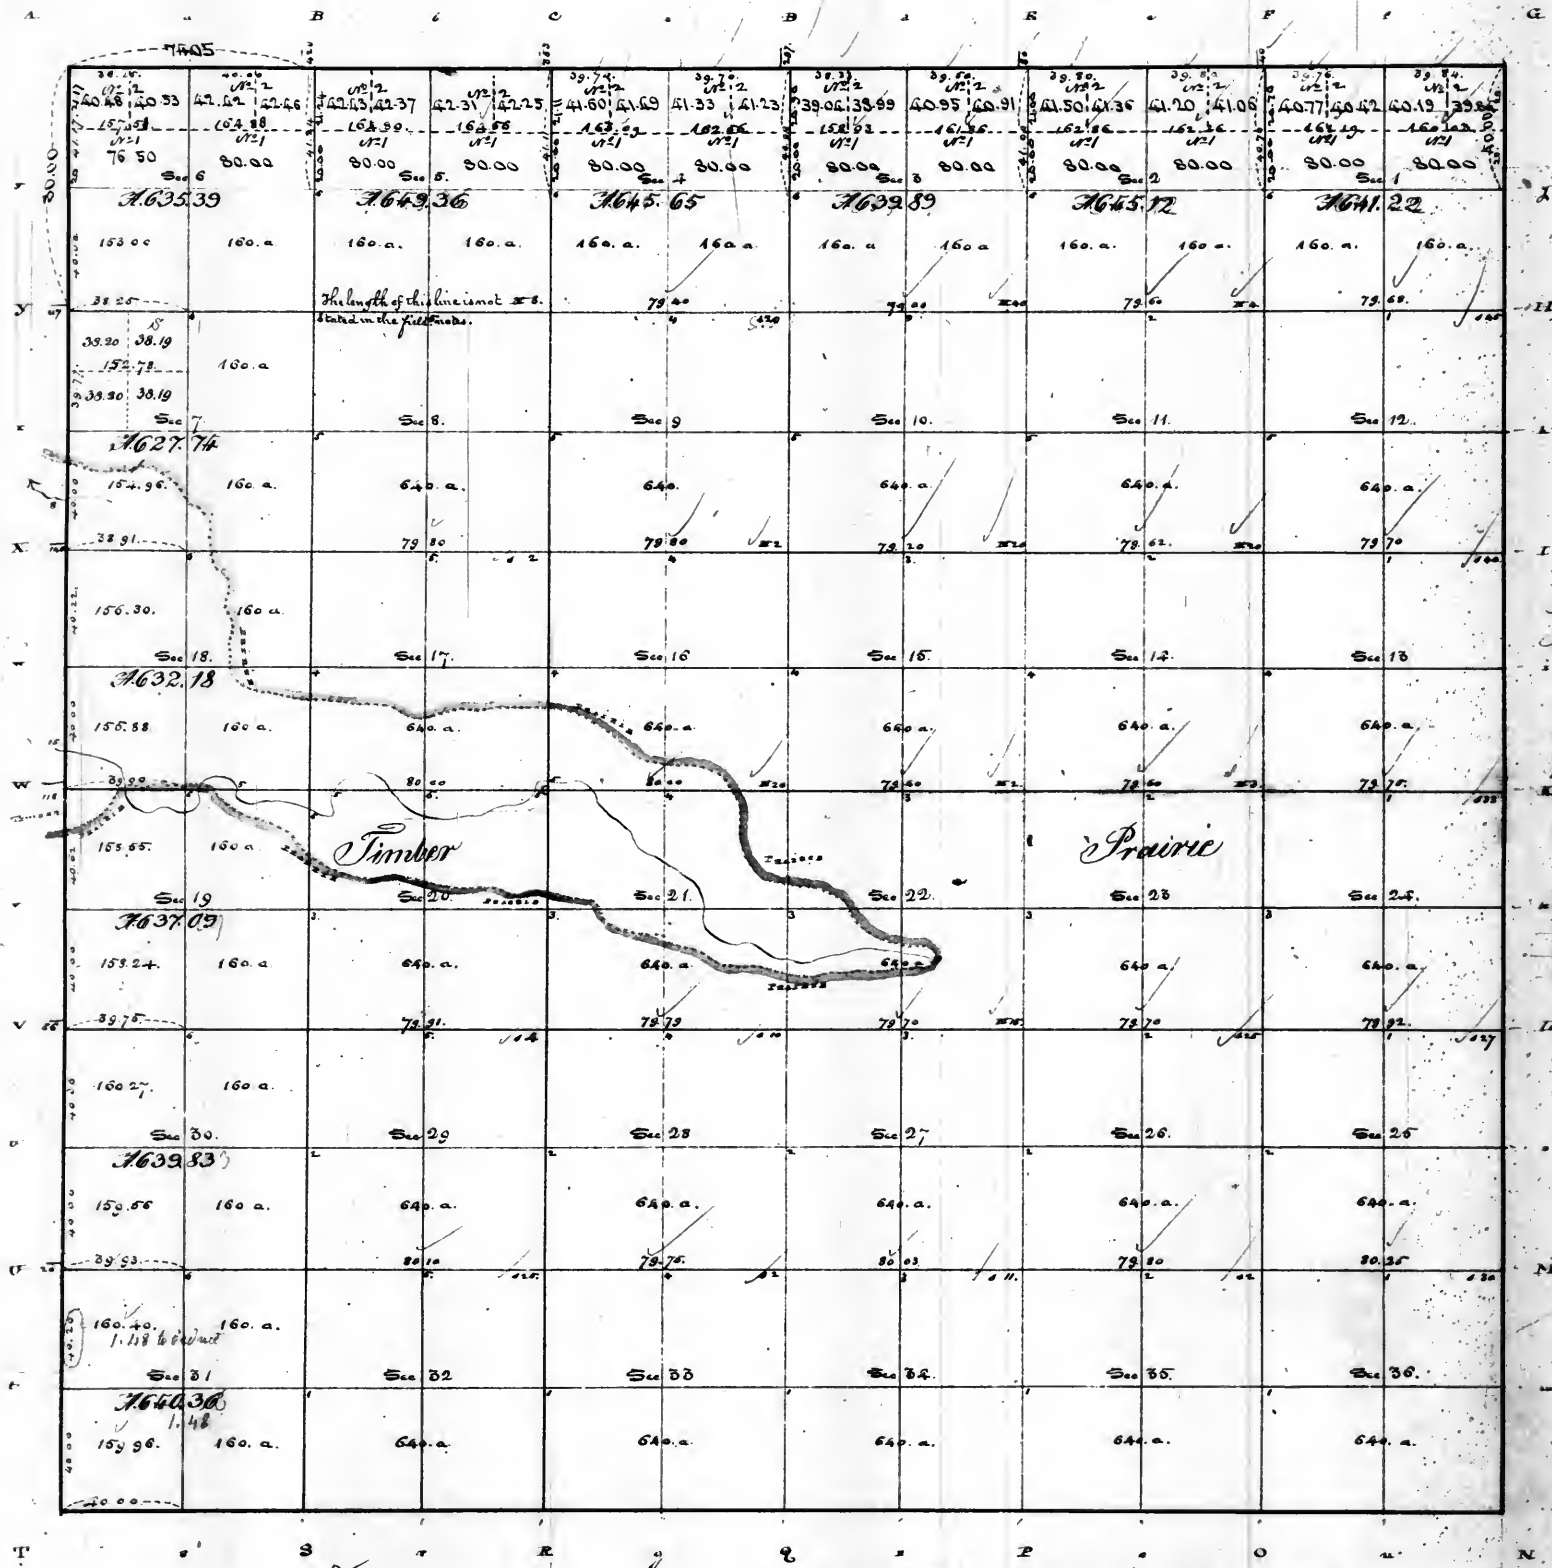

Surveyor's Office
St. Louis

Subdivided under the
act of 1832, by the 7th of Sec
1, 2, 3, 4, 5, the 1st and 2nd
of Sec 6, and sent today a
copy of the plat thereof one to the
Register and another to the
Commissioner.

On February 5th 1834, sent a plat of
the 1st 1st of section 7, as subdivided
under the act of 1832, to the
Register and another to the
Commissioner.


10th June 1834
16th June 1834

Aggregate area = 23033.83 acres
1.48

Surveyor's Office
St. Louis June 2nd 1834.

The above Plat of Township 31 North of the Base line, Range 4 East of
the 3^d Principal Meridian, is conformable to the field notes of the Survey thereof on file in this Office.

E. J. Sanborn

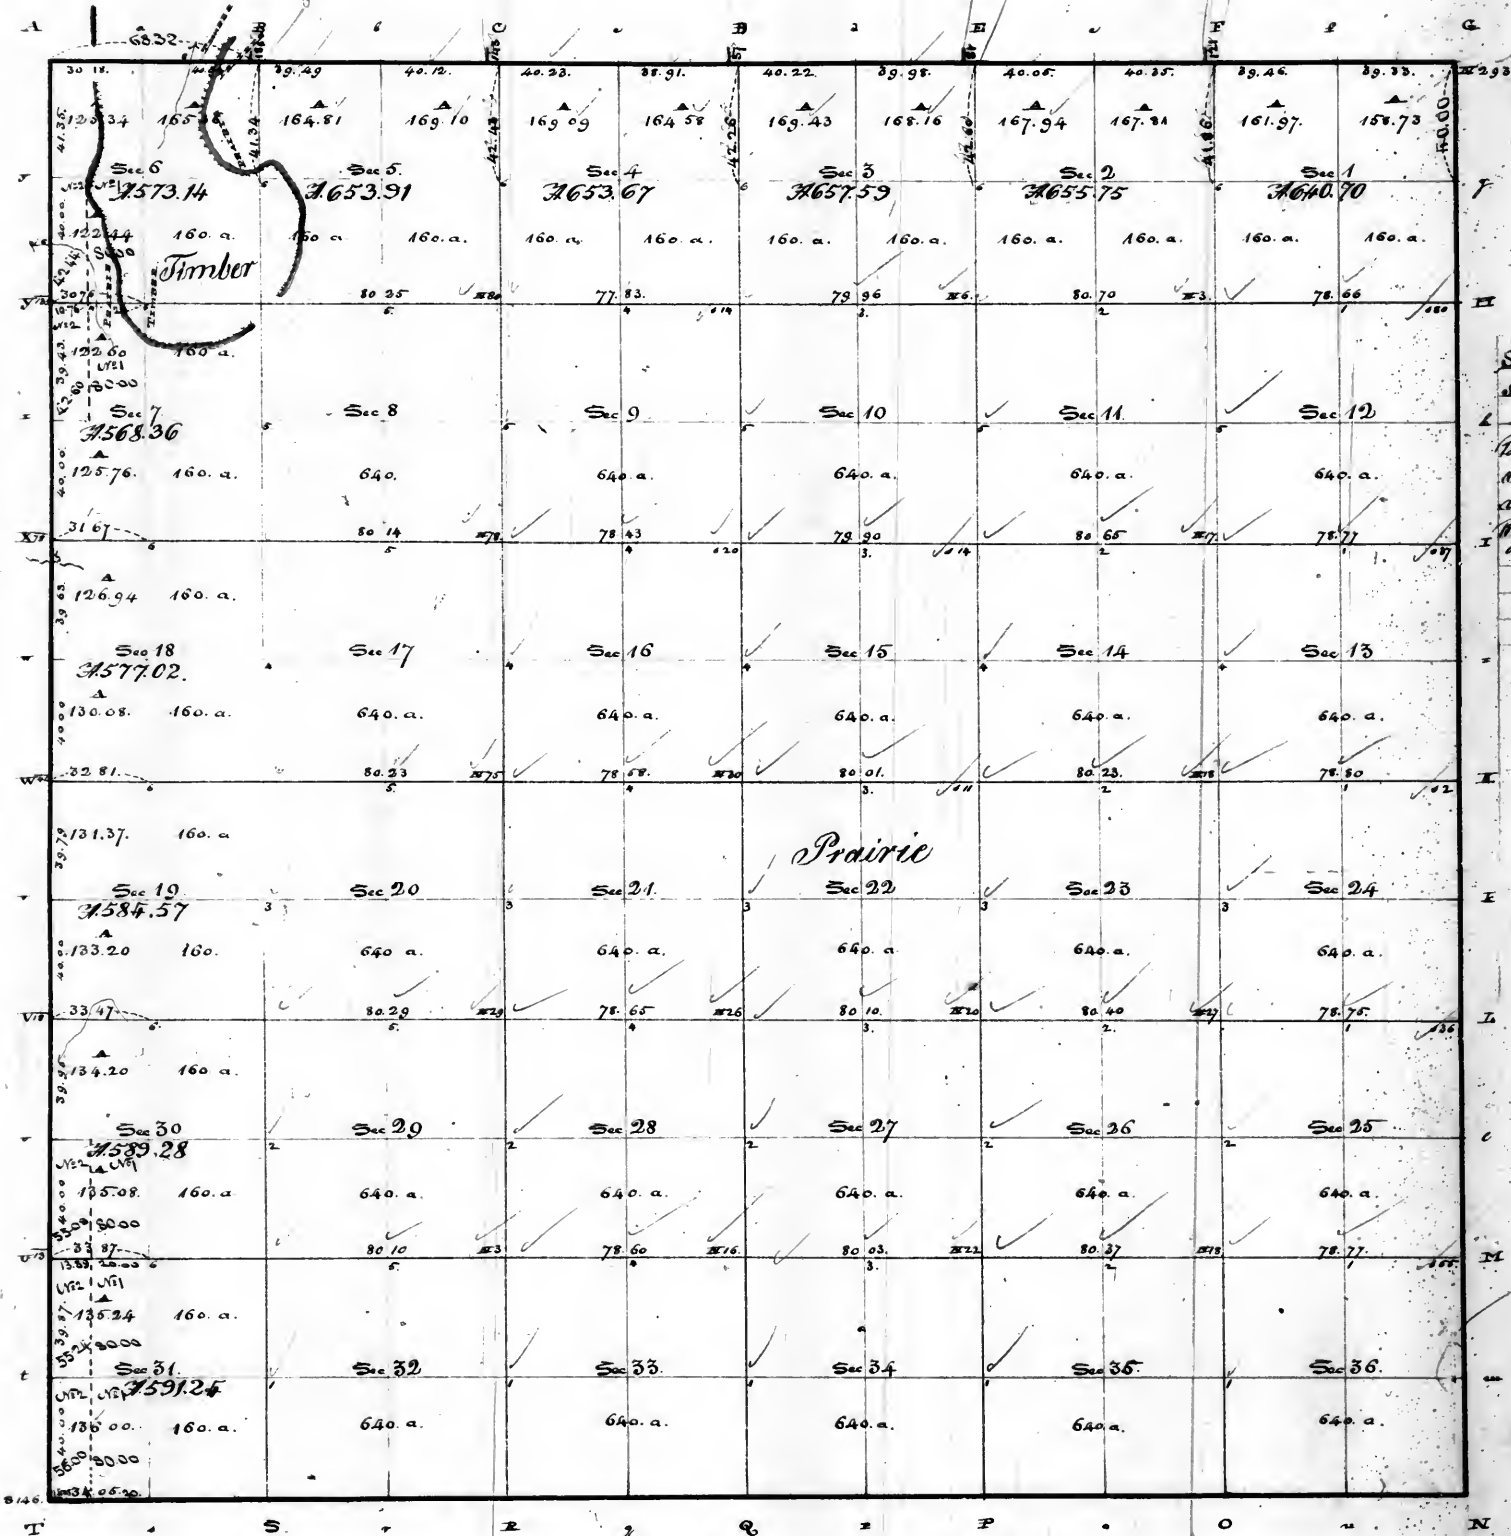

Aggregate area - 22745.23 acres


Surveyors Office
St. Louis June 25th 1834

The above Plat of Township 32 North of the Base line, Range 4 East of the 3rd Principal Meridian, is conformable to the field notes of the Survey thereof on file in this Office.

E. J. Smyth

Surveyors Office
St. Louis June 25th 1834
Subdivided under the act
of 1832, viz: the 10th of Sec 6 & 30
and the 10th of Sec 21. and sent today
a copy of the plat thereof to the
Register and another to the Clerk.

Township 33 North of the baseline, Range 4 East of the 3rd Principal Meridian

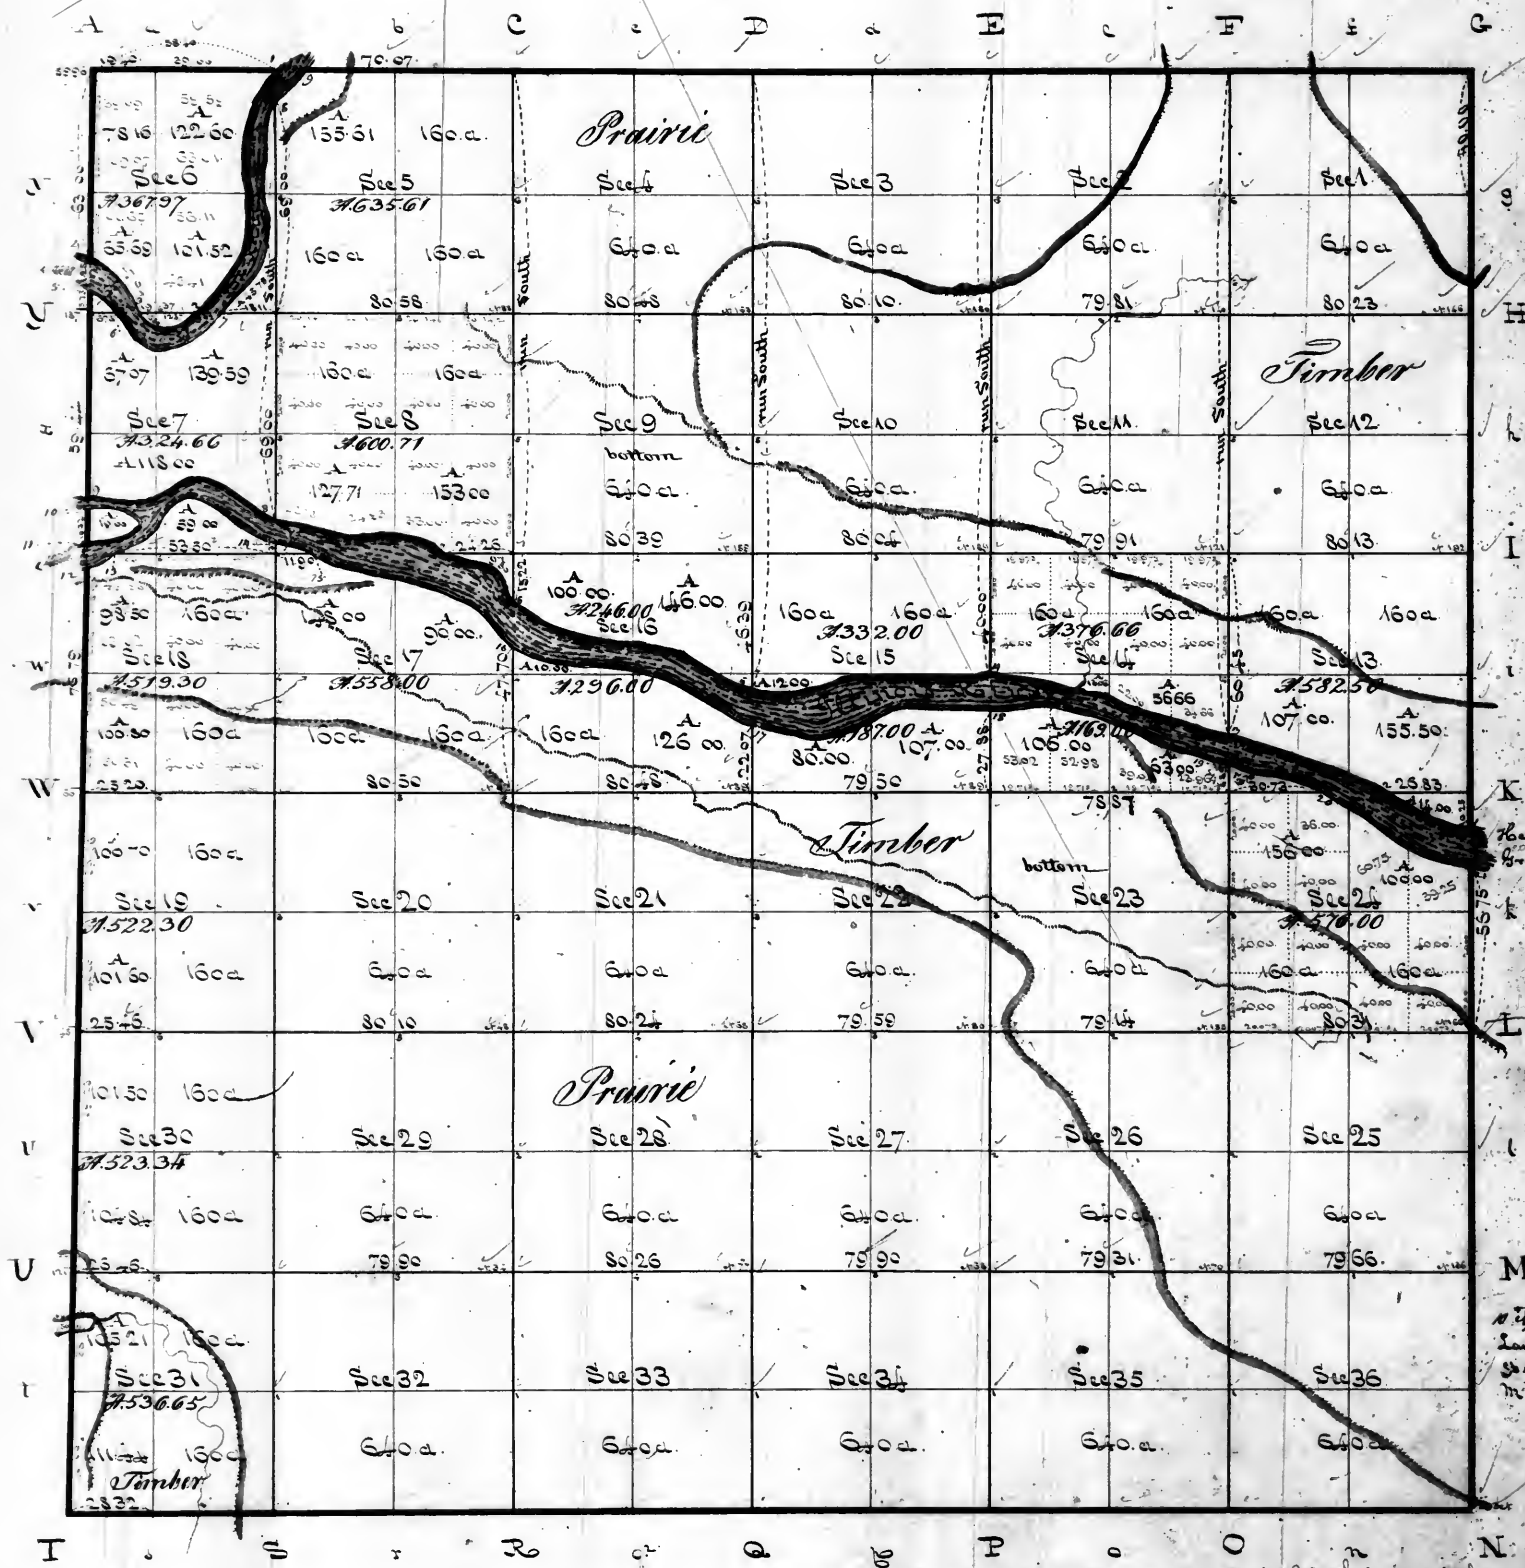


Surveyors Office
St. Louis July 7th 1834

Aggregate area of public land - 21601.02 ac
Estimated area of the river - 700.00 ac
Total - 22301.02 ac

The above Plat of Township 33 North of the baseline, Range 4 East of the 3rd Principal Meridian, is conformable to the field notes of the Survey thereof on file in this Office.

E. J. Langham

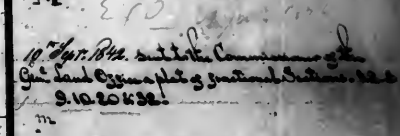


Aggregate area of public land = 2 1286.55 ac
estimated area of the river = 500.00 ac
Total = 2178.65 acres

E. J. Sangham

1839

43 W 82 62 W 194 W

Township N 35 North of the Base Line Range 4 East of the 3rd Principal Meridian

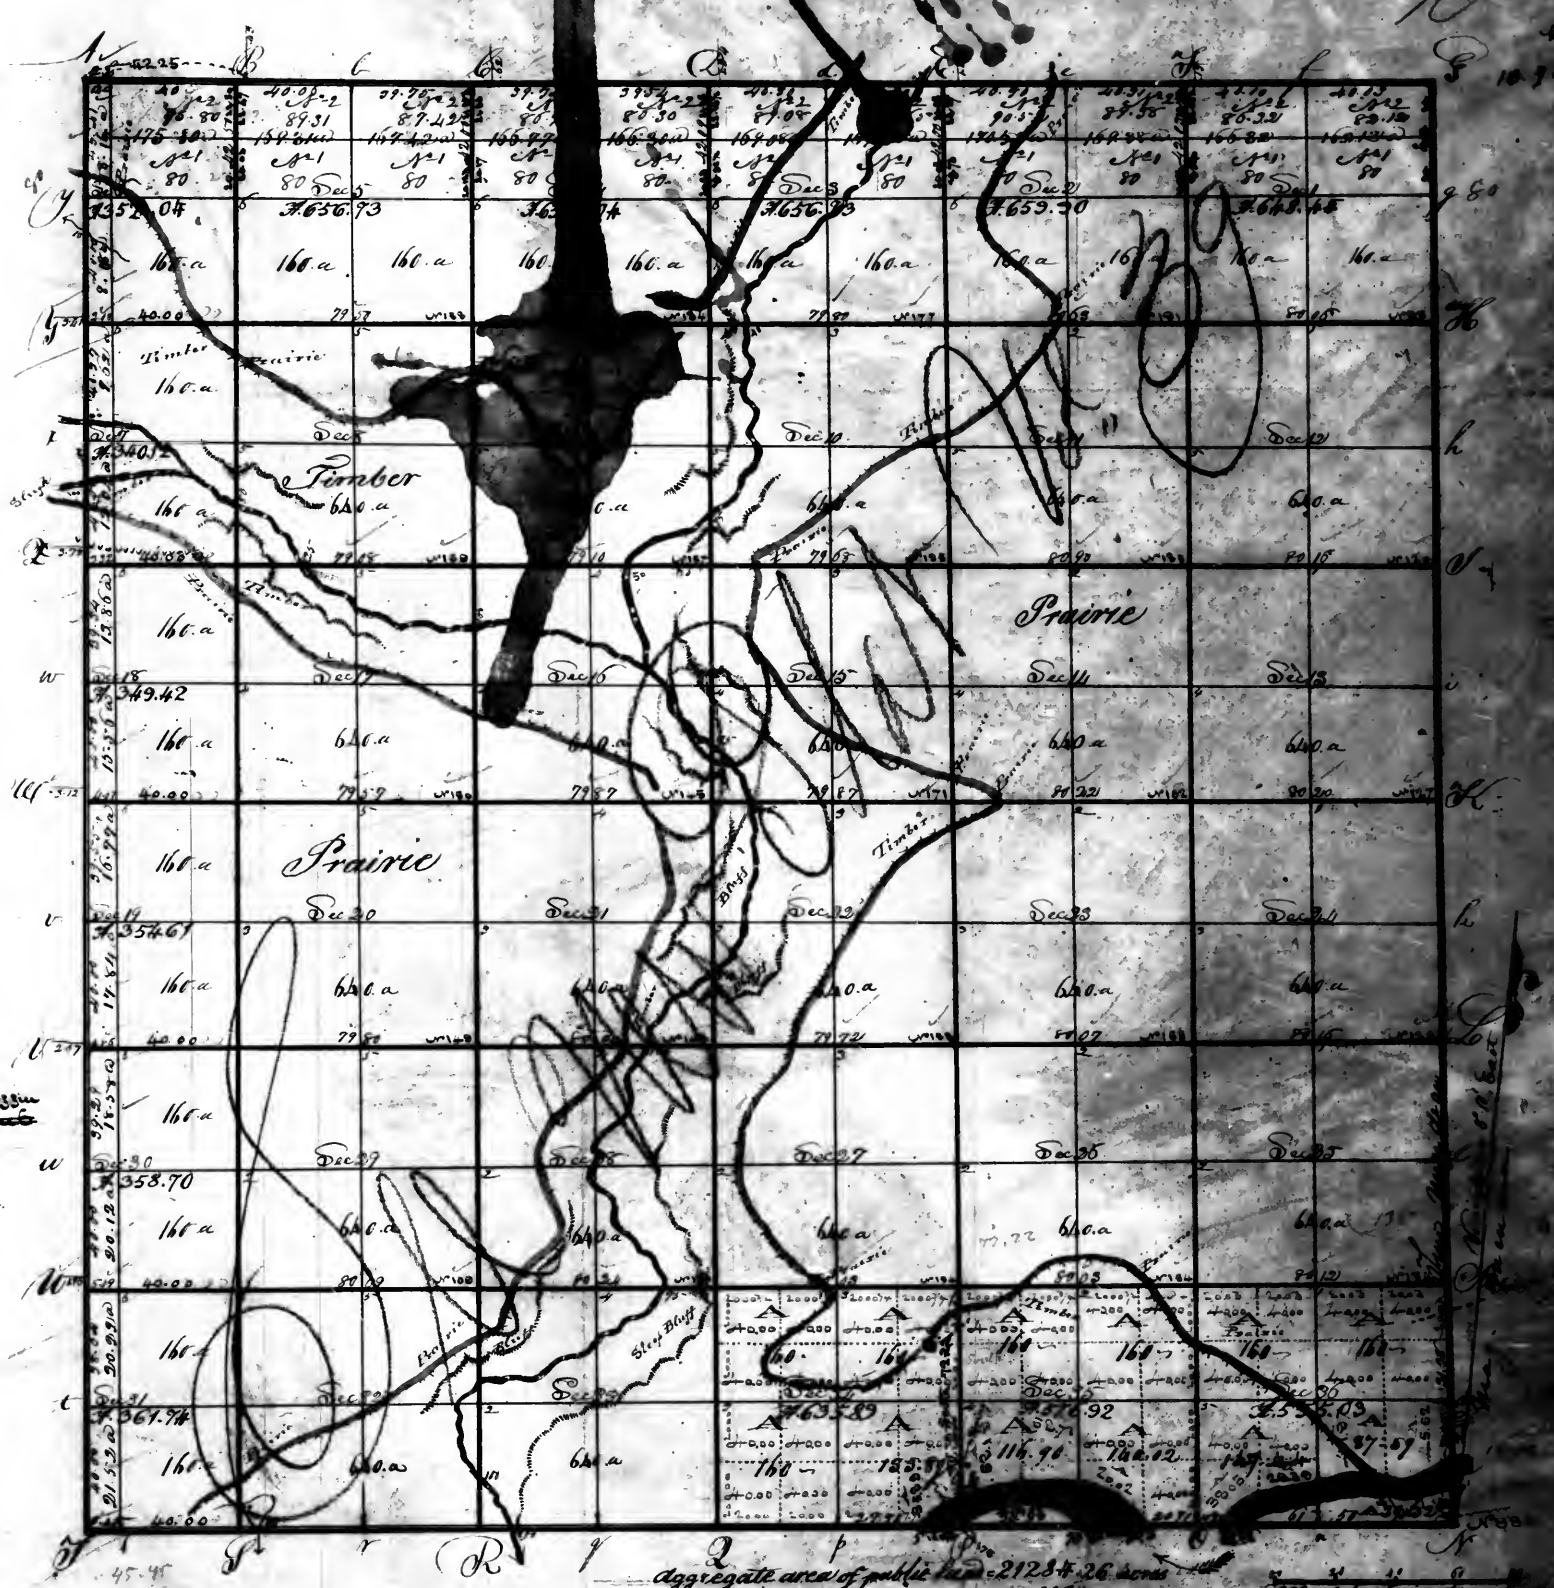



Aggregate area of public land 21254.26 acres
estimated area of the river 110.00
Total = 21364.26 acres

Pursuant to a contract with and instructions from William Dector Surveyor of the land of the United States in the States of Illinois and Missouri and Territory of Arkansas bearing date the twentieth day of March A.D. 1824 We have measured and laid out and surveyed the above described Township, and do hereby certify that it had such marks and boundary both natural and artificial as are represented on said Plat and described in the field notes made thereof and returned with this Plat into the Office of the Surveyor of the United States in the States of Illinois and Missouri and Territory of Arkansas.

Certified this First day of Nov. 1829

Examined

Surveyors Office
St. Louis June 28. 1834


Wm Dector D. Surveyor
Deputy Dector

St. Louis June 28. 1834

The above Plat of Township N 35 North of the Base Line, Range 4 East of the 3rd Principal Meridian, is conformable to the field notes of the Survey thereof on file in this Office.

Wm Dector

Fractional Township No. 36 North of the Base line in Range No. 4 East of the 3^d principal Meridian.

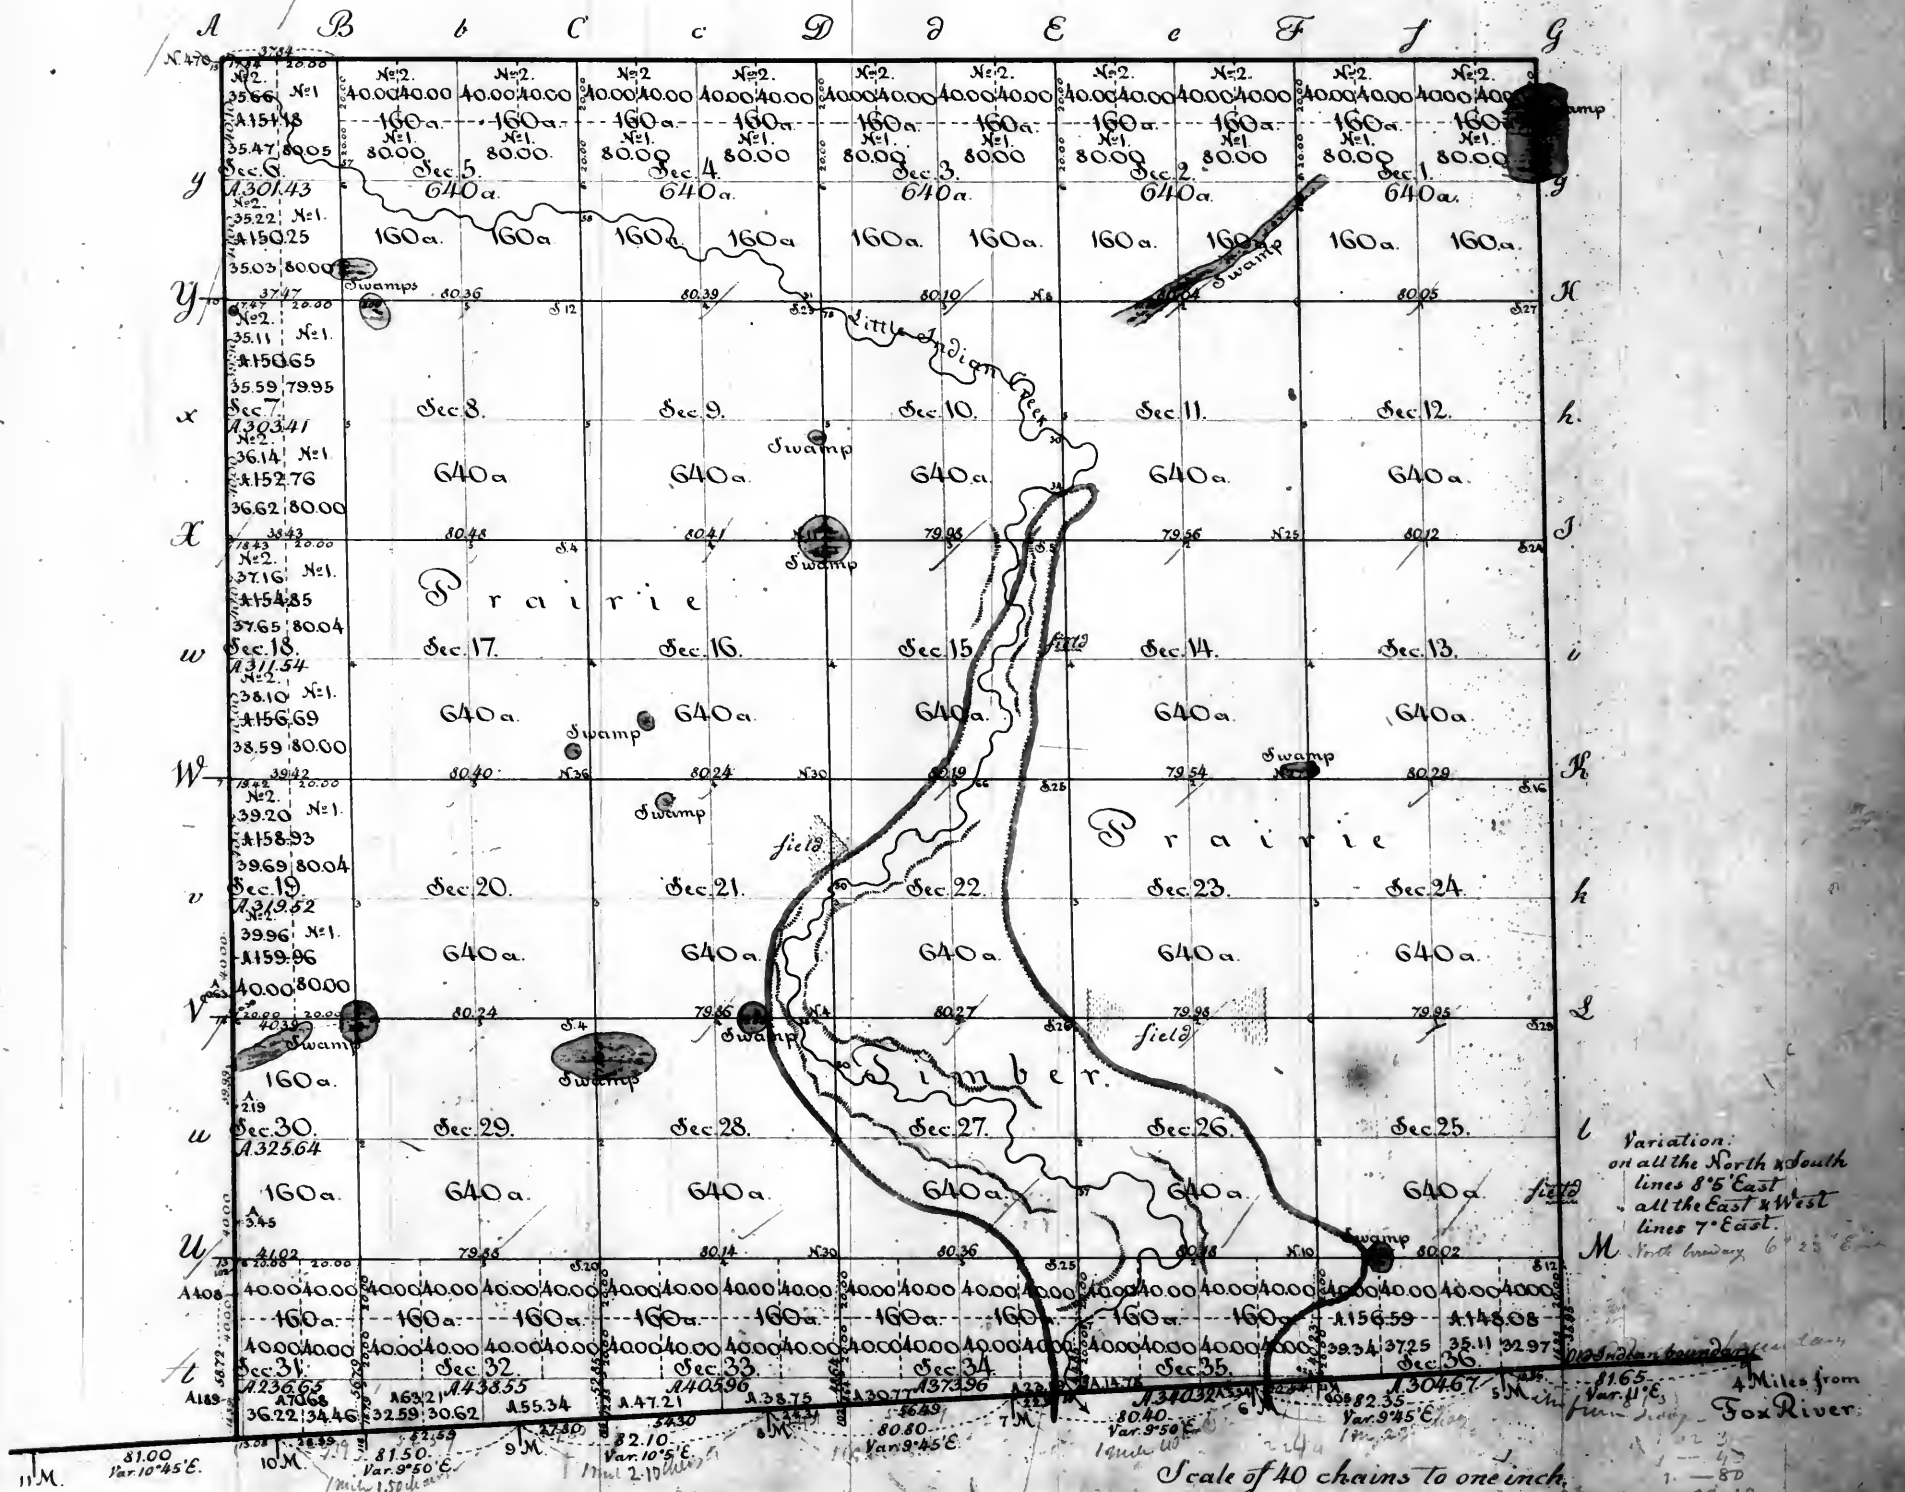


Surveyors Office.

Saint Louis 20th May 1839.

The above plat of fractional township 36 North range 4 East of the 3^d principal meridian, north of the old indian boundary is strictly conformable to the field notes of the survey being on file in this office, which have been examined and approved. The Southern boundary which is designated "Old Indian Boundary" 5 miles 40.03 chains, was surveyed by John C. Sullivan, assisted by James M. Duncan in the first quarter of 1819, under the authority of a letter of appointment from William Becher Surveyor of the lands of the United States in Illinois and Missouri dated October 18th 1818, authorizing them to survey certain indian boundaries under the direction of Commissioners Graham and Phelps appointed by the president to run the lines of the tracts ceded by the treaty of Saint Louis of the 23rd of August 1816, between the United States and the United Nations of Ottawa, Chippewas and Pottawatomies - this being the line agreed to be run west to the Mississippi from a point on Fox river one west of the Southern extremity of Lake Michigan. It was re-surveyed 5 miles 40.03 chains, and the mile points thereon renewed at the several distances set down on the map by Eli S. Prescott in the 4th quarter of 1837. - The west boundary 5 miles 58.72 chains - The east boundary 5 miles 35.95 chains and the north boundary 5 miles 37.34 chains were surveyed by Eli S. Prescott in the 3^d quarter of 1837 and the subdivision lines 55 miles 43.12 chains were surveyed by the said Prescott in the 2^d and 3^d quarters of 1838 - all the surveys by Prescott were executed under contract signed by the Surveyor General on the 8th of May 1837, and by the said Prescott on the 3^d day of June of the same year - They were paid for in the 4th quarter of 1838, and charges in the account of the Surveyor General for

Fractional Township N. 36 North of the Base line in Range N. 4 East of the 3^d principal Meridian.

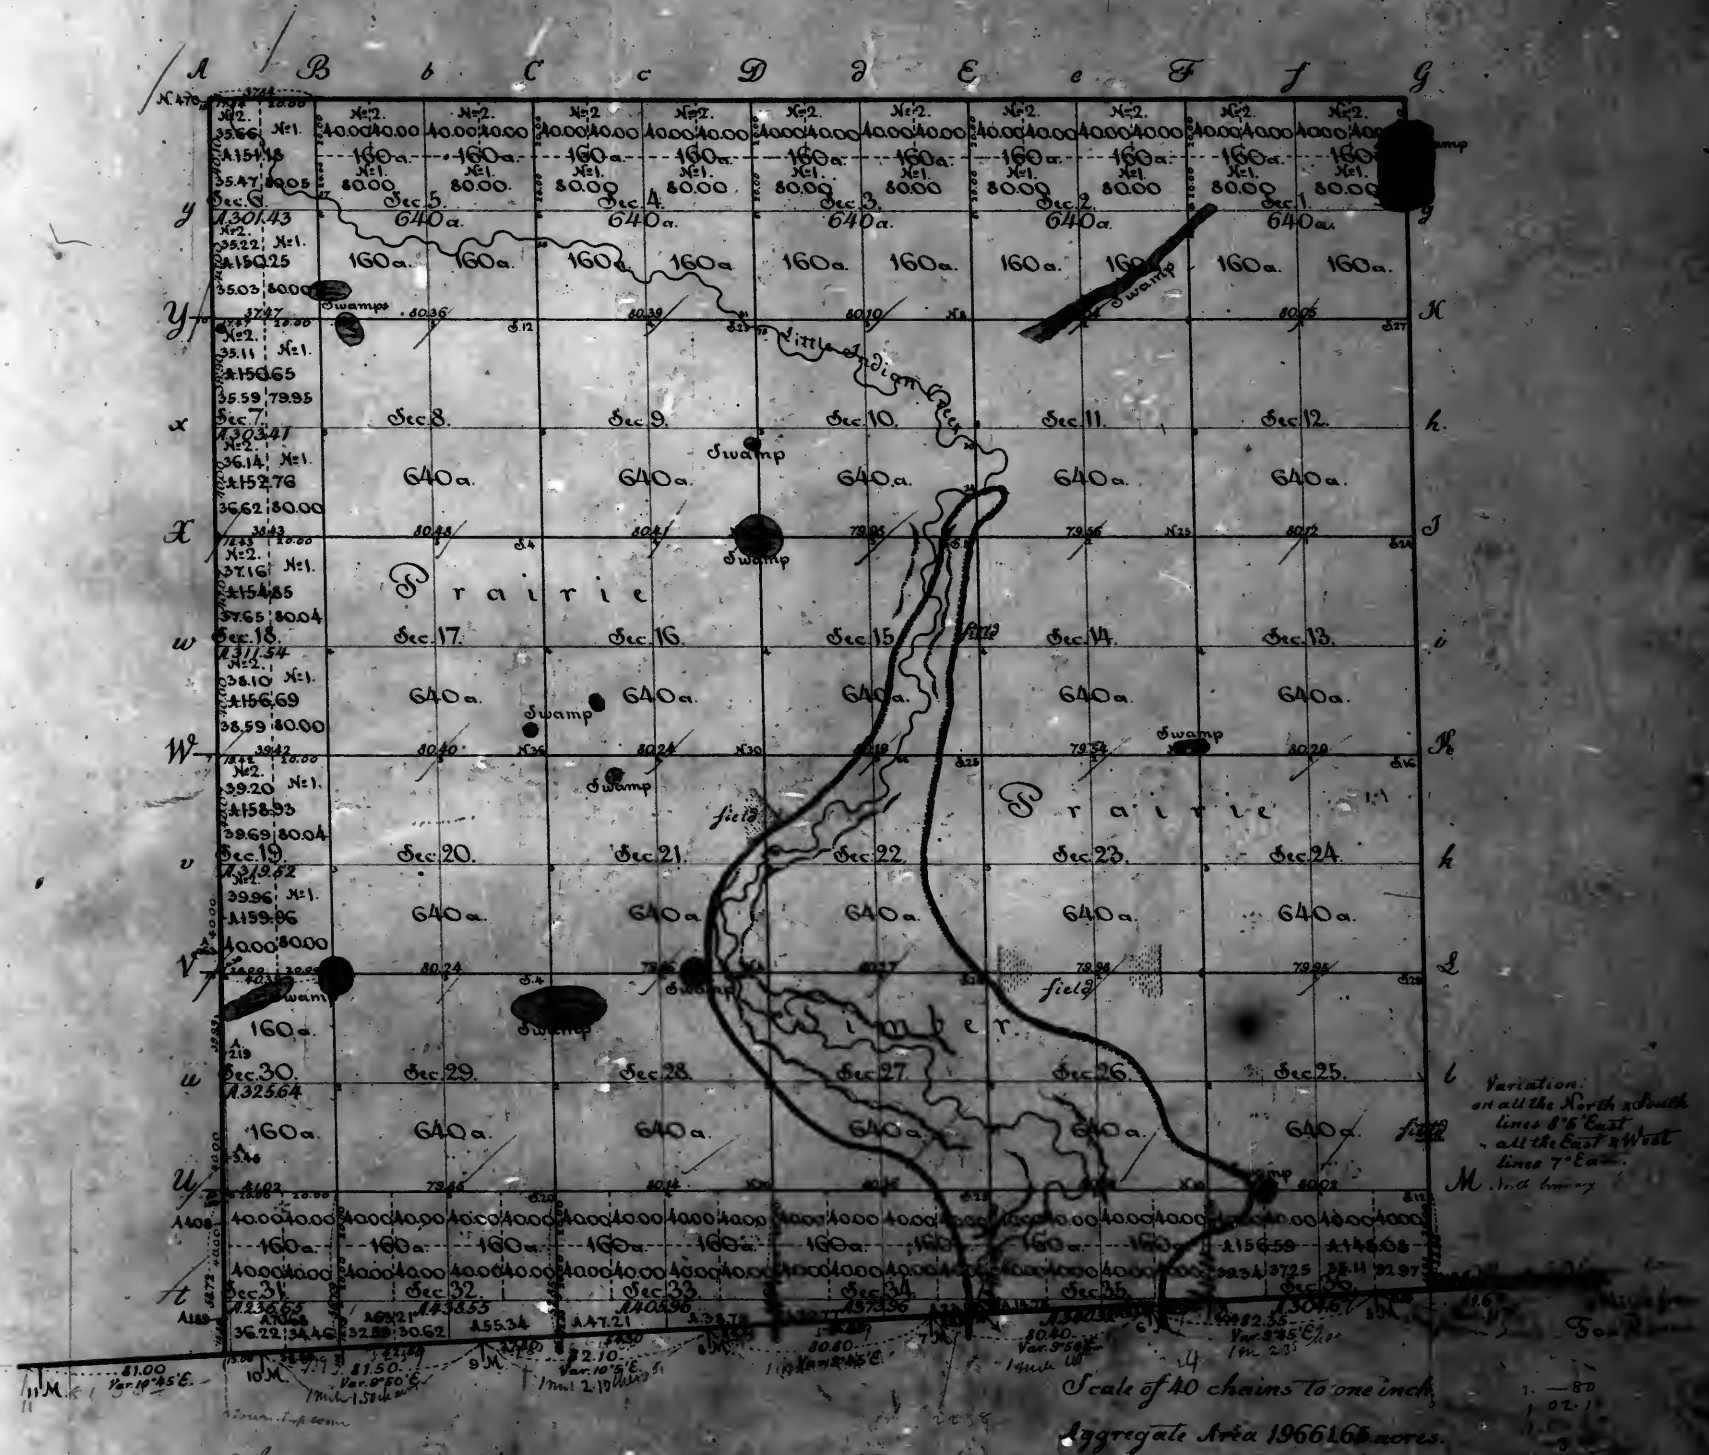


Surveyors Office.

Saint Louis 20th May 1837.

The above plat of fractional township 36 North range 4 East of the 3^d principal meridian, north of the old Indian boundary is strictly conformable to the first notes of the survey thereof on file in this office, which have been examined and approved. The southern boundary which is designated "Old Indian boundary" 5 miles 40.03 chains, was surveyed by John C. Sullivan, assisted by James Duncan in the first quarter of 1819, under the authority of a letter of appointment from William Becher Surveyor of the United States in Illinois and Missouri dated October 18th 1818, authorizing them to survey Indian boundaries under the direction of Commissioners Graham and Phelps appointed by the president to run the lines of the tract ceded by the treaty of Saint Louis of the 23rd of August 1816, between the United States and the United Nations of Ottawa, Chippewas and Potawatamies - this being the line agreed to be run west to the Mississippi from a point on the river due west of the southern extremity of Lake Michigan. It was surveyed 5 miles 40.03 chains, and the mile points thereon removed at the several distances of the map by Eli S. Prescott in the 4th quarter of 1837. - The west boundary 5 miles 58.72 chains - The east boundary 5 miles 43.12 chains were surveyed by Eli S. Prescott in the 3^d quarter of 1837 and the subdivision lines 36 sections were surveyed by the said Prescott in the 2^d and 3^d quarters of 1833 - all the surveys by contract signed by Mr. Surveyor General on the 8th of May 1837, and by the said Prescott on the 1st of June of the same year - They were paid for in the 3^d quarter of 1838, and charged in the account of the Surveyors Office that quarter - Voucher No 5.

William Becher

Township N° 37 North of the Base line in Range N° 4 East of the 3rd principal Meridian.

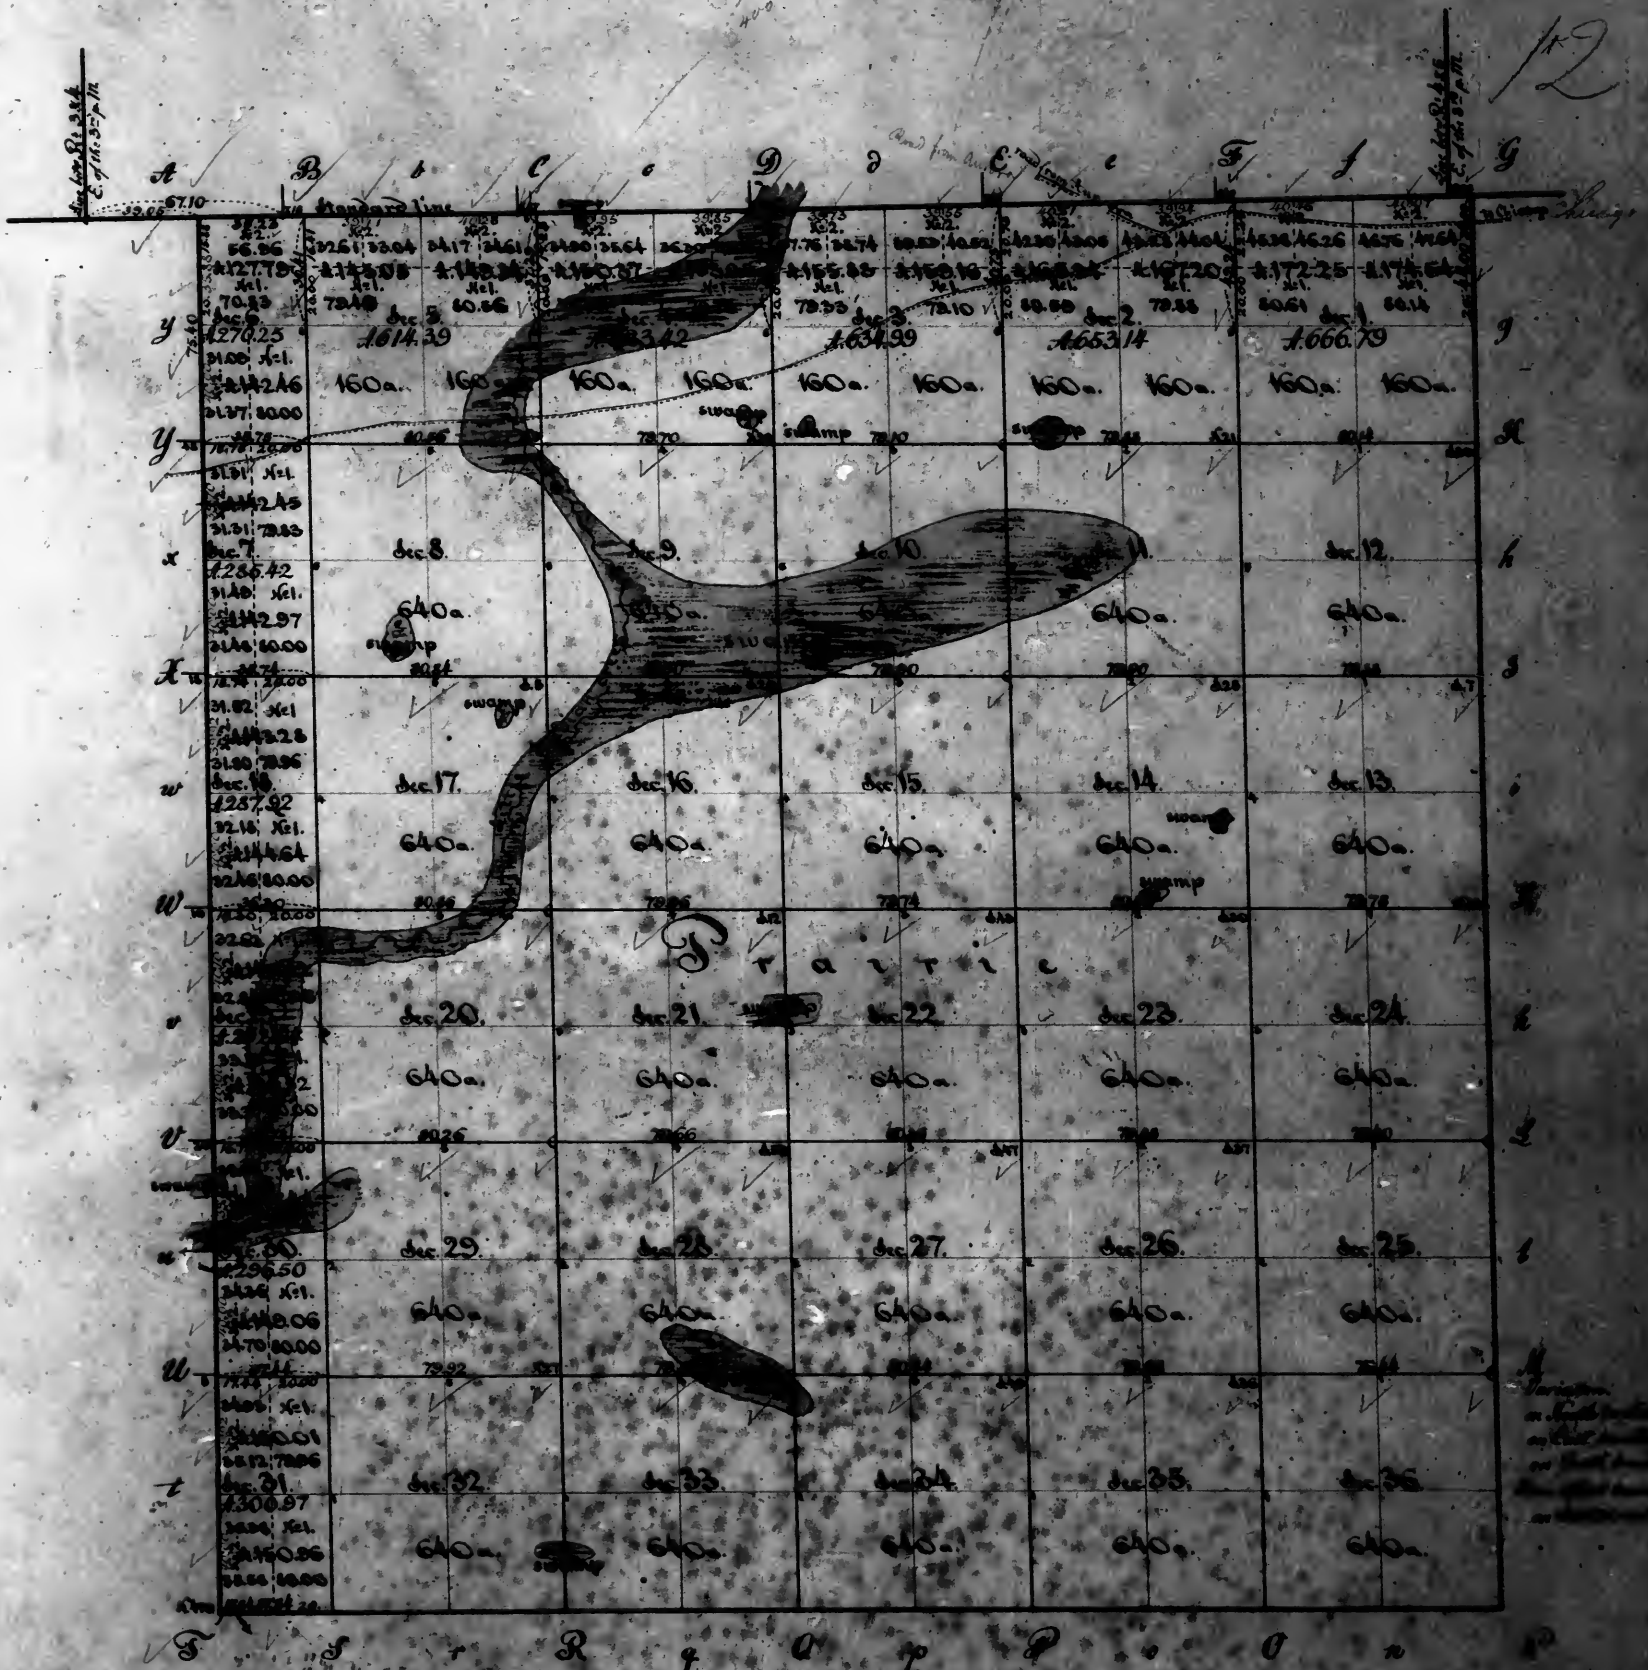

Scale of 40 chains to one inch.

Aggregate area 20925.00 acres.


Surveyors Office. Sept. 25th of August 1862.

The above map of Township N° 37 North of the base line, range 4 East of the 3rd principal meridian is a copy of the first notes of the survey thereof on file in this office which have been examined and approved. The south boundary 5 miles 57.07 chains - the east boundary 6 miles - the north boundary 5 miles 57.07 chains - and the west boundary 5 miles 75.00 chains, were all surveyed on the 1st of June 1857, by Chas. S. Brown, under contract signed by the Surveyor General, on the 3rd of May 1857, and by Wm. Brown on the 2nd of June following - they were paid for in the 4th quarter of 1858, and changed in the account current of the Surveyor General during the same quarter, Voucher N° 5. The subdivision lines of the 36 sections, were surveyed in September, 1858, by Charles H. Rice, for Chas. S. Brown, without authority, and were not treated with this office, but the first notes have been received for examination, upon their receipt, in virtue of the directions contained in the letter of the Commissioner of the General Land Office, to Surveyor General Matthews, dated 5th of June 1860, and Wm. Brown's notes having been examined and approved and paid for, the said 57 miles 57.07 chains, were then paid out of the general appropriation for surveying the public lands; and the same were charged in the account current of the Surveyor General during the 3rd quarter of 1862, Voucher N° 1. The first notes of the survey of the Township N° 37 North of the base line, range 4 East of the 3rd principal meridian, were received in this office on the 25th of July 1862, exhibiting the same payment for the same thereon, and which is not here again to be surveyed.

Chas. S. Brown

Surveyor of the public lands in the State of Illinois



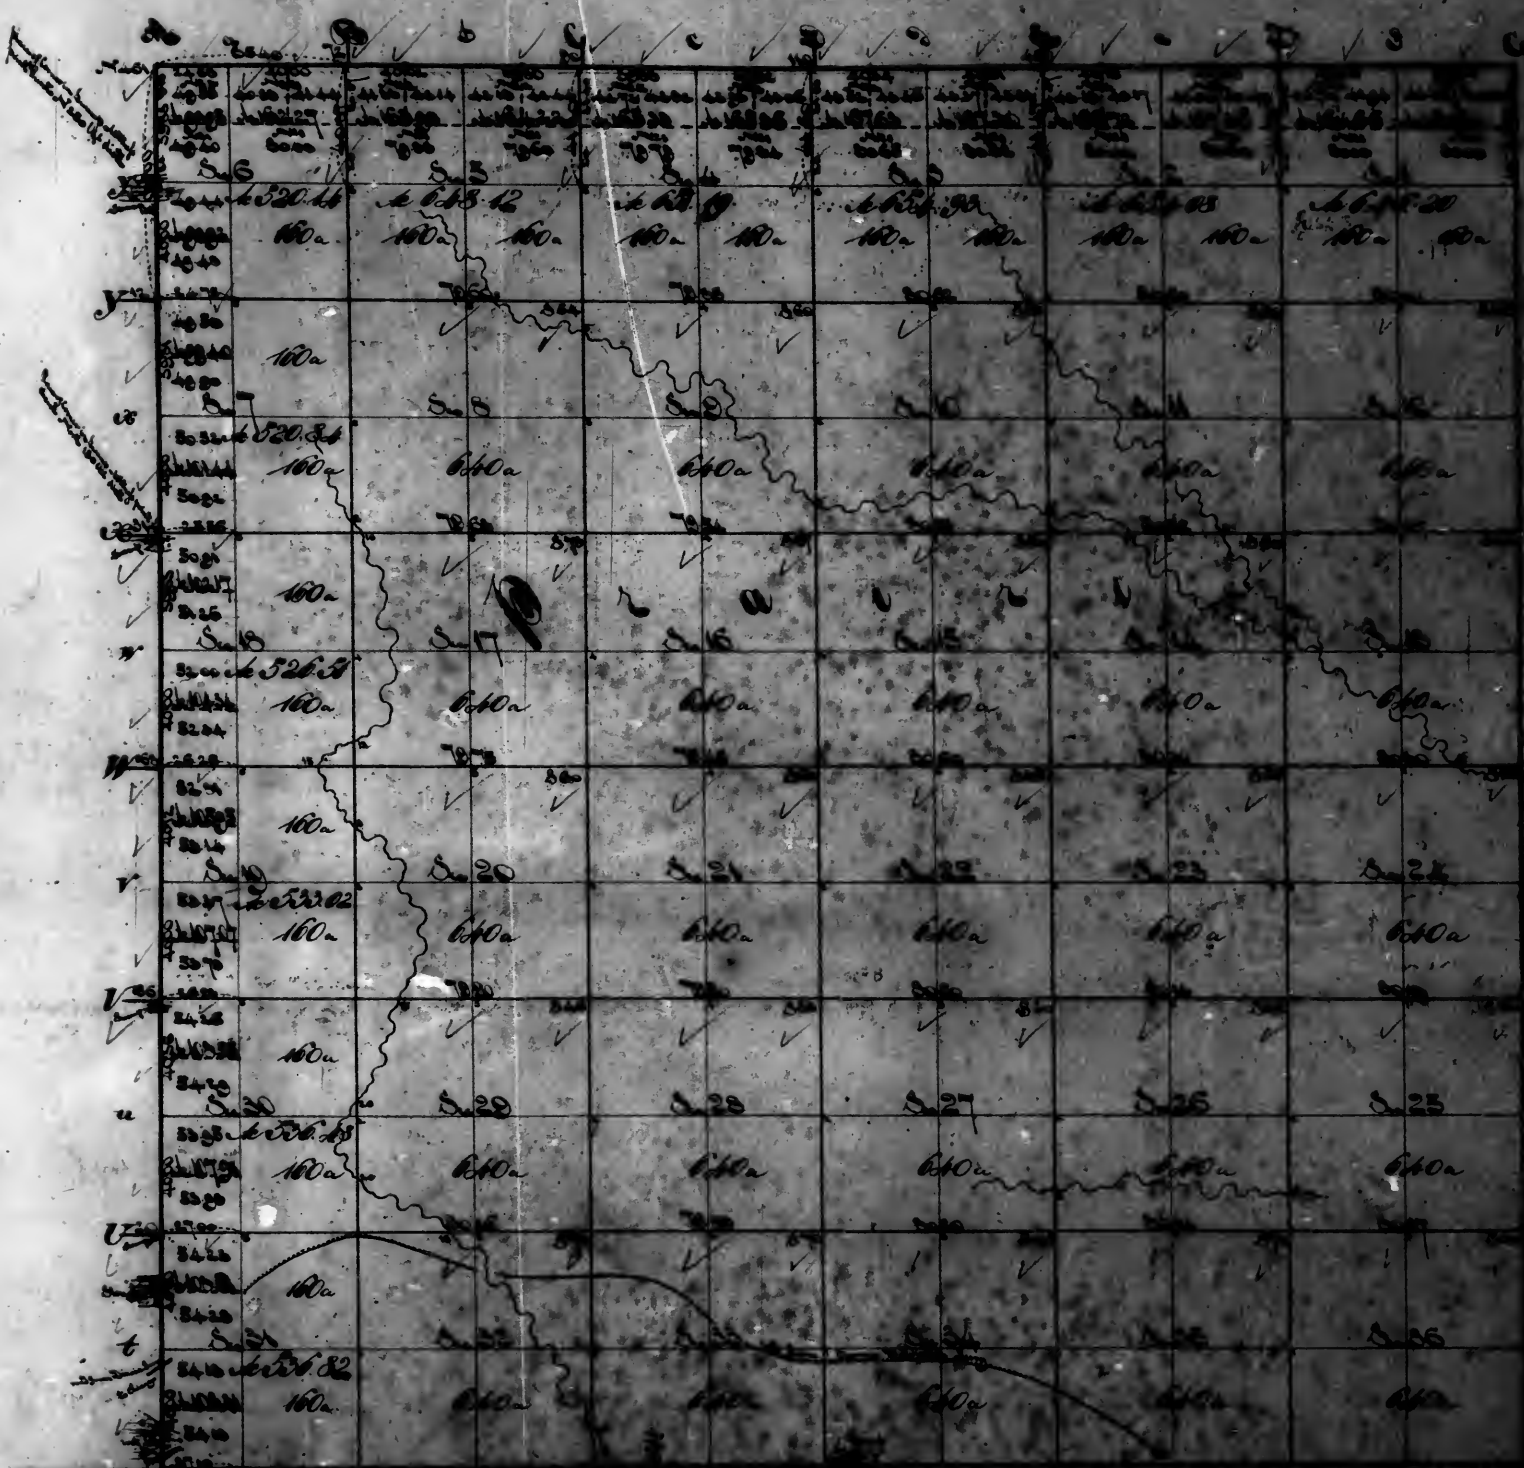


Surveyors Office - Saint Louis 25 of August 1842.



7. Silas Reed

Township 33 North, 4 East of the 3d principal Meridian

14

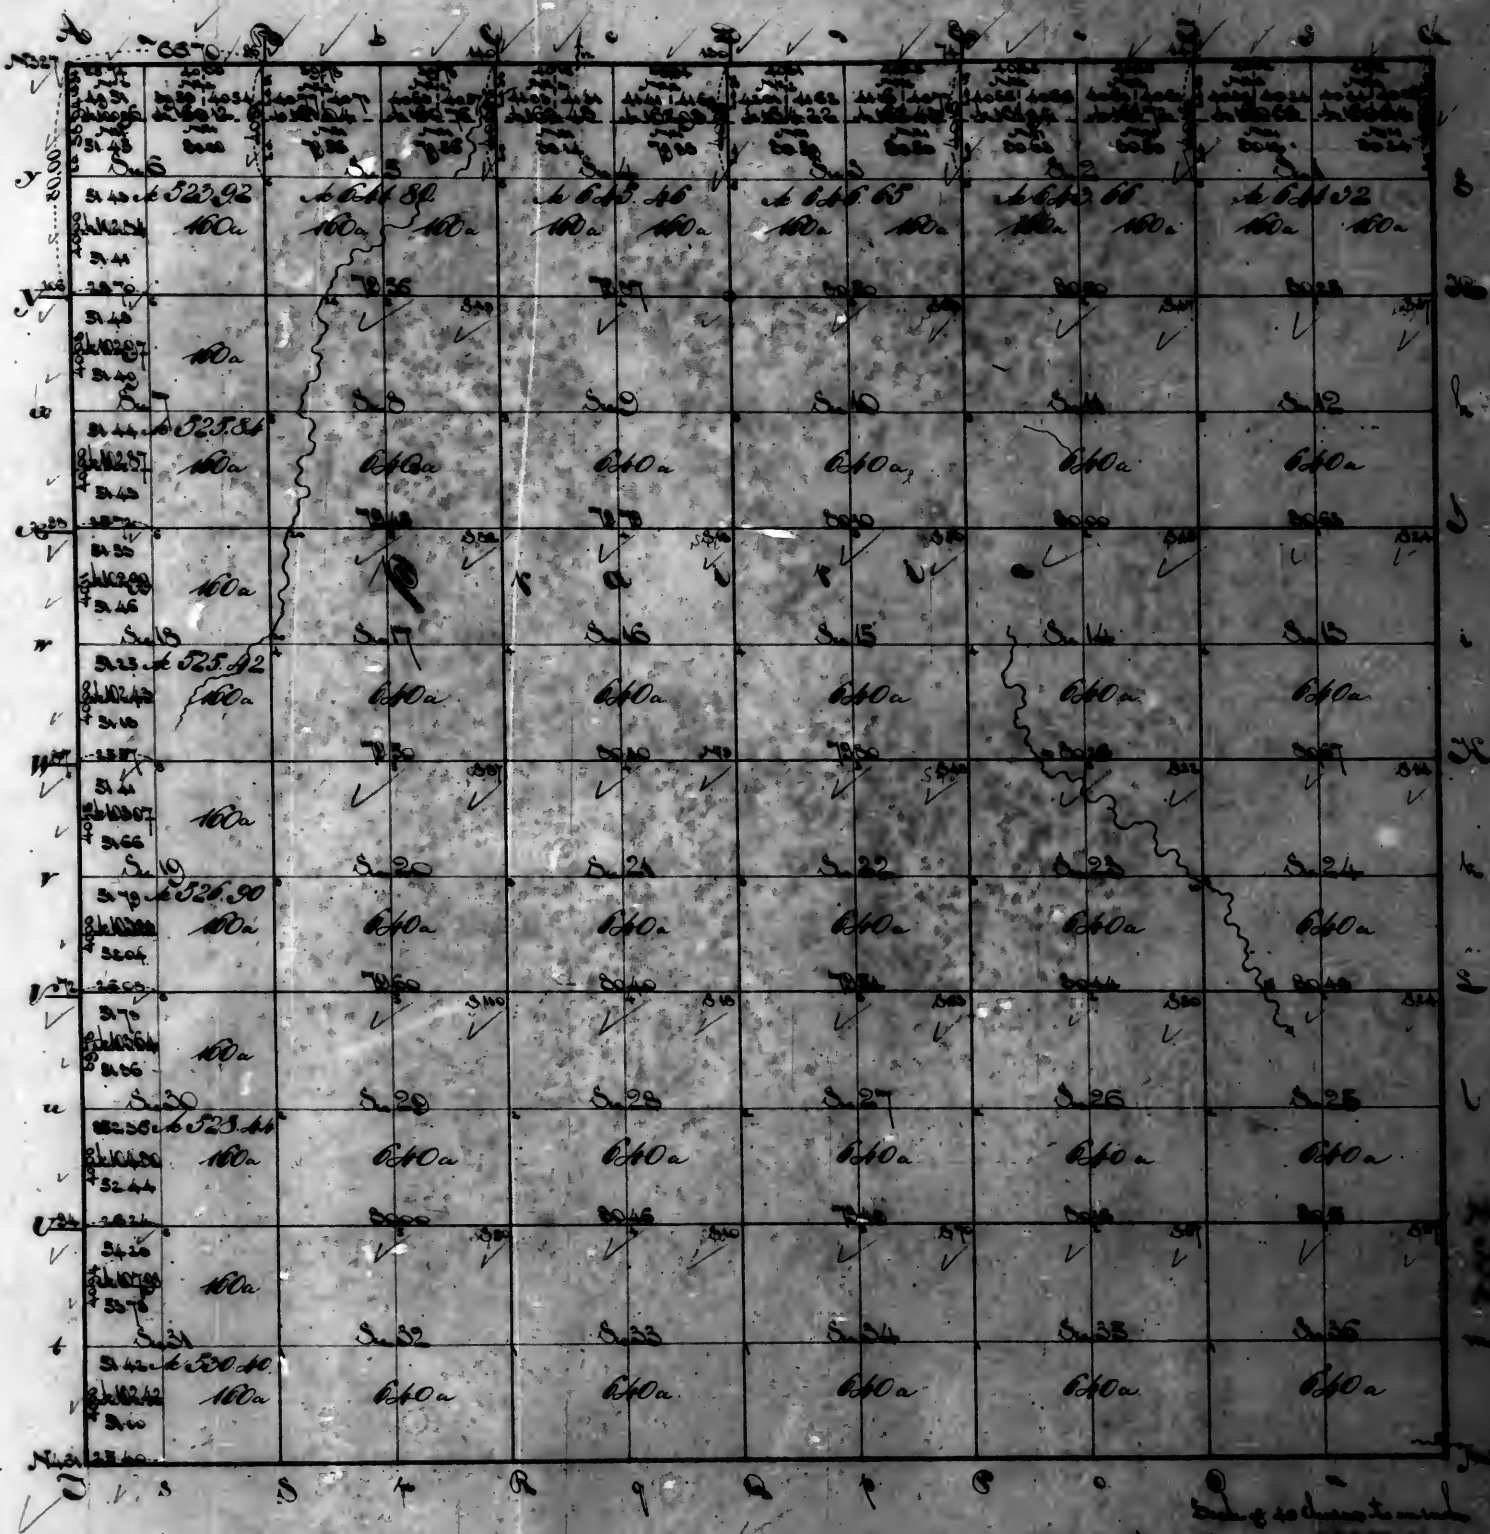

Surveyors Office, Saint Louis 25th of August 1842.


The above plat of township 33 north of the base line range 4 east of the 3d principal meridian is strictly conformable to the field notes of the survey thereof on file in this office which have been examined and approved. The west boundary 6 miles, was surveyed in the 4th quarter of 1833, by John Alonzo Spaulding, under contract signed by the Surveyor General on the 20th of September 1833, and by M. Spaulding on the 14th of May 1833. It was paid for in the 2nd quarter of 1834 and charged in the account current of the Surveyor General during the same quarter, Voucher N° 8. The south boundary 5 miles 65 to chains - the east boundary 6 miles - and the north boundary 5 miles 66 to chains, were surveyed in the 4th quarter of 1833, by James Thompson and John P. Thompson, under their joint contract of the 21st of September 1833. They were paid for in the 3rd quarter of 1840, and charged in the account current of the Surveyor General during that quarter, Voucher N° 17. The subdivision lines 36 miles 15 to chains, were surveyed in the 4th quarter of 1840, by James Thompson and John P. Thompson, under their joint contract of the 13th of September 1840. They were paid for in the 3rd quarter of 1842, and charged in the account current of the Surveyor General during the said 3rd quarter, Voucher N° 17.

Silas Reeds

Surveyor of the public lands
in the State of Missouri.

Township 40 North, Range 4 East of 3rd Principal Meridian

15

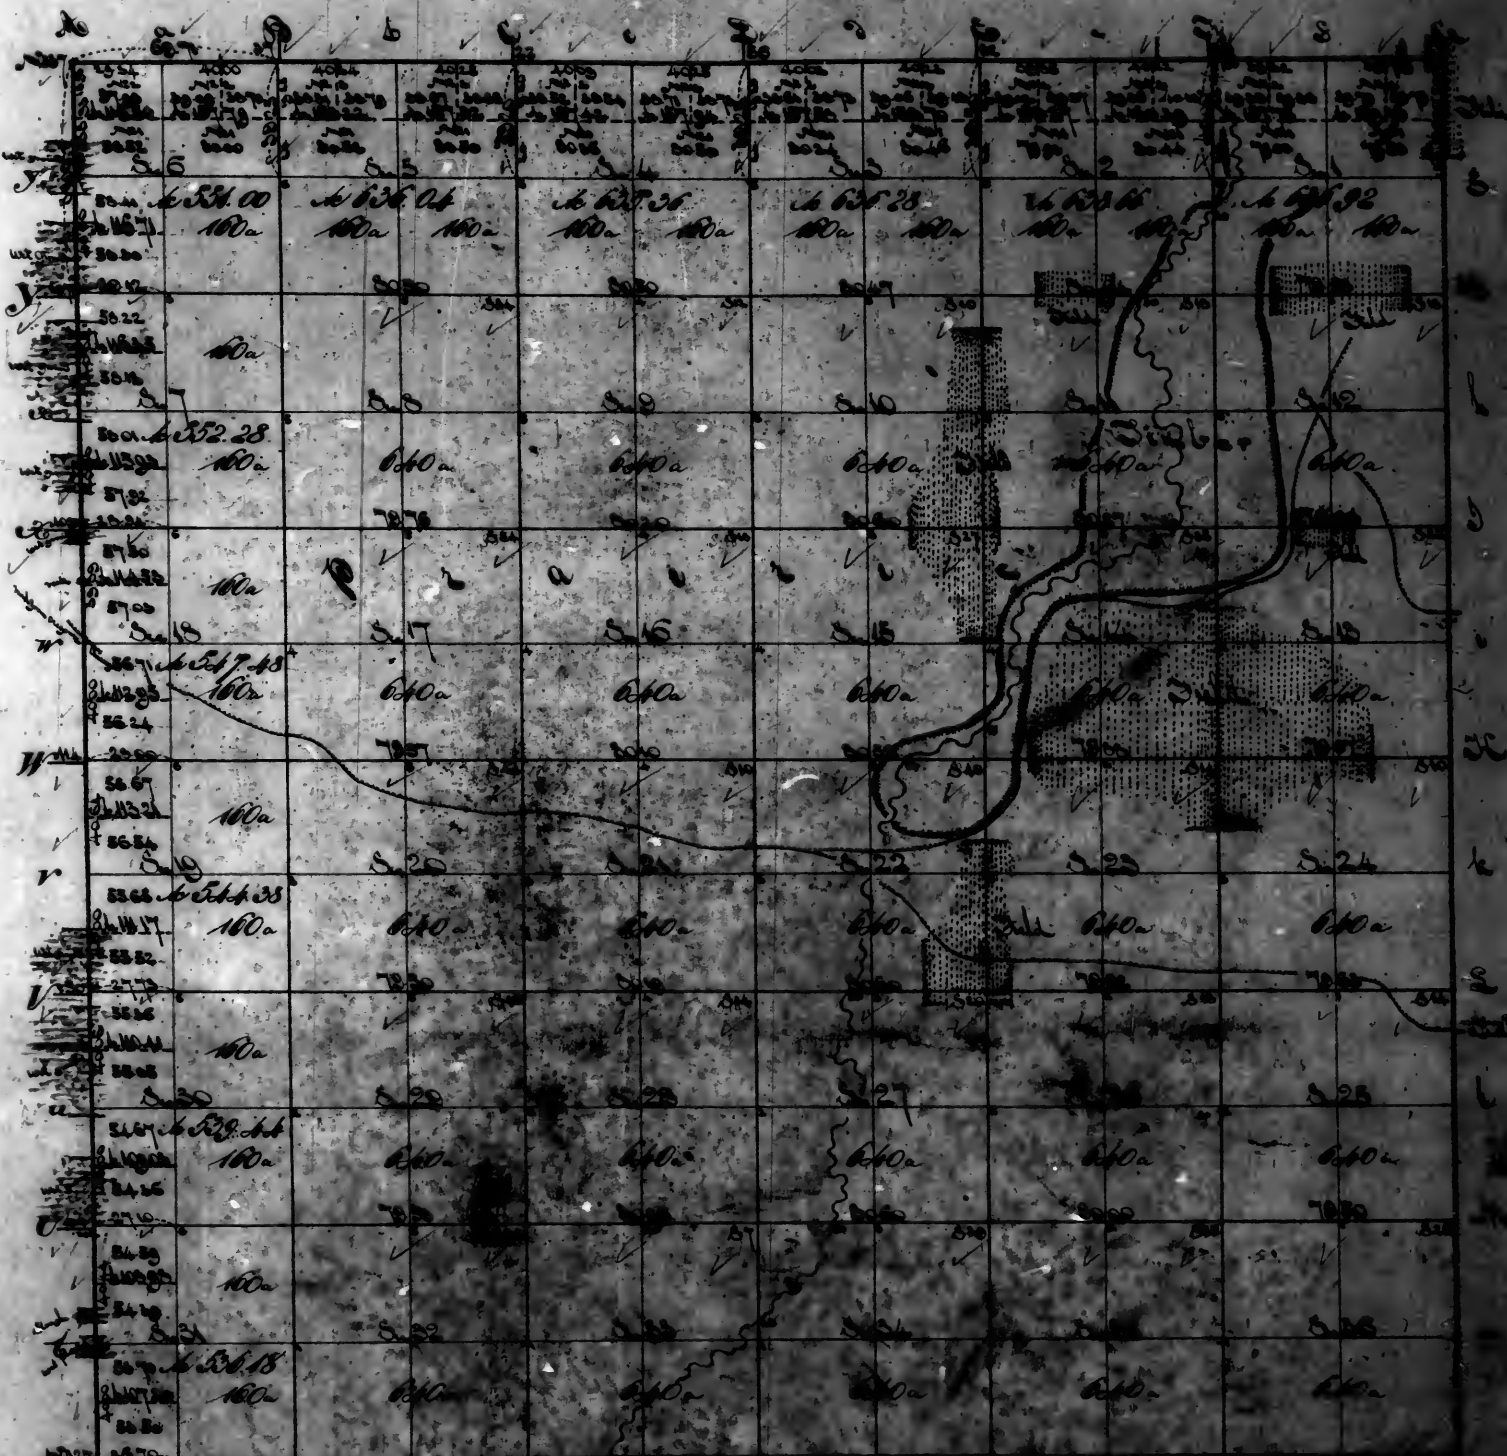

Surveyors office, Saint Louis 25 of August 1880


The above plat of township 40 north of the base line and range 4 east of the 3rd principal meridian, is hereby confirmed to the full and entire thereof on file in this office which have been examined and approved. The north boundary 6 miles, was surveyed by Spaulding, under a contract signed by the Surveyor General on the 20th September 1887 and by McSpaulding on the 1st of October 1888. It was paid for in the 3rd quarter of 1888, and charges in the account of the Surveyor General for that quarter, Voucher N° 6. The east boundary 6 miles, and the north boundary 5 miles 69.71 chains, were surveyed in the 4th quarter of 1888, by J. Thompson, under their joint contract of the 21st of September 1889. They were paid for in the 3rd quarter of 1889, and charges in the account of the Surveyor General during that quarter, Voucher N° 17. The subdivision line 59 miles 13.51 chains, was surveyed in the 4th quarter of 1889, by James Thompson and John J. Thompson, under their joint contract of the 18th of September 1889. They were paid for in the 3rd quarter of 1889, and charges in the account current of the Surveyor General during that quarter, Voucher N° 7.

Silas Reeds

Surveyor of the public lands
the State of Missouri

Township 41 North of the base line Range 4 East of the 3rd principal Meridian

16

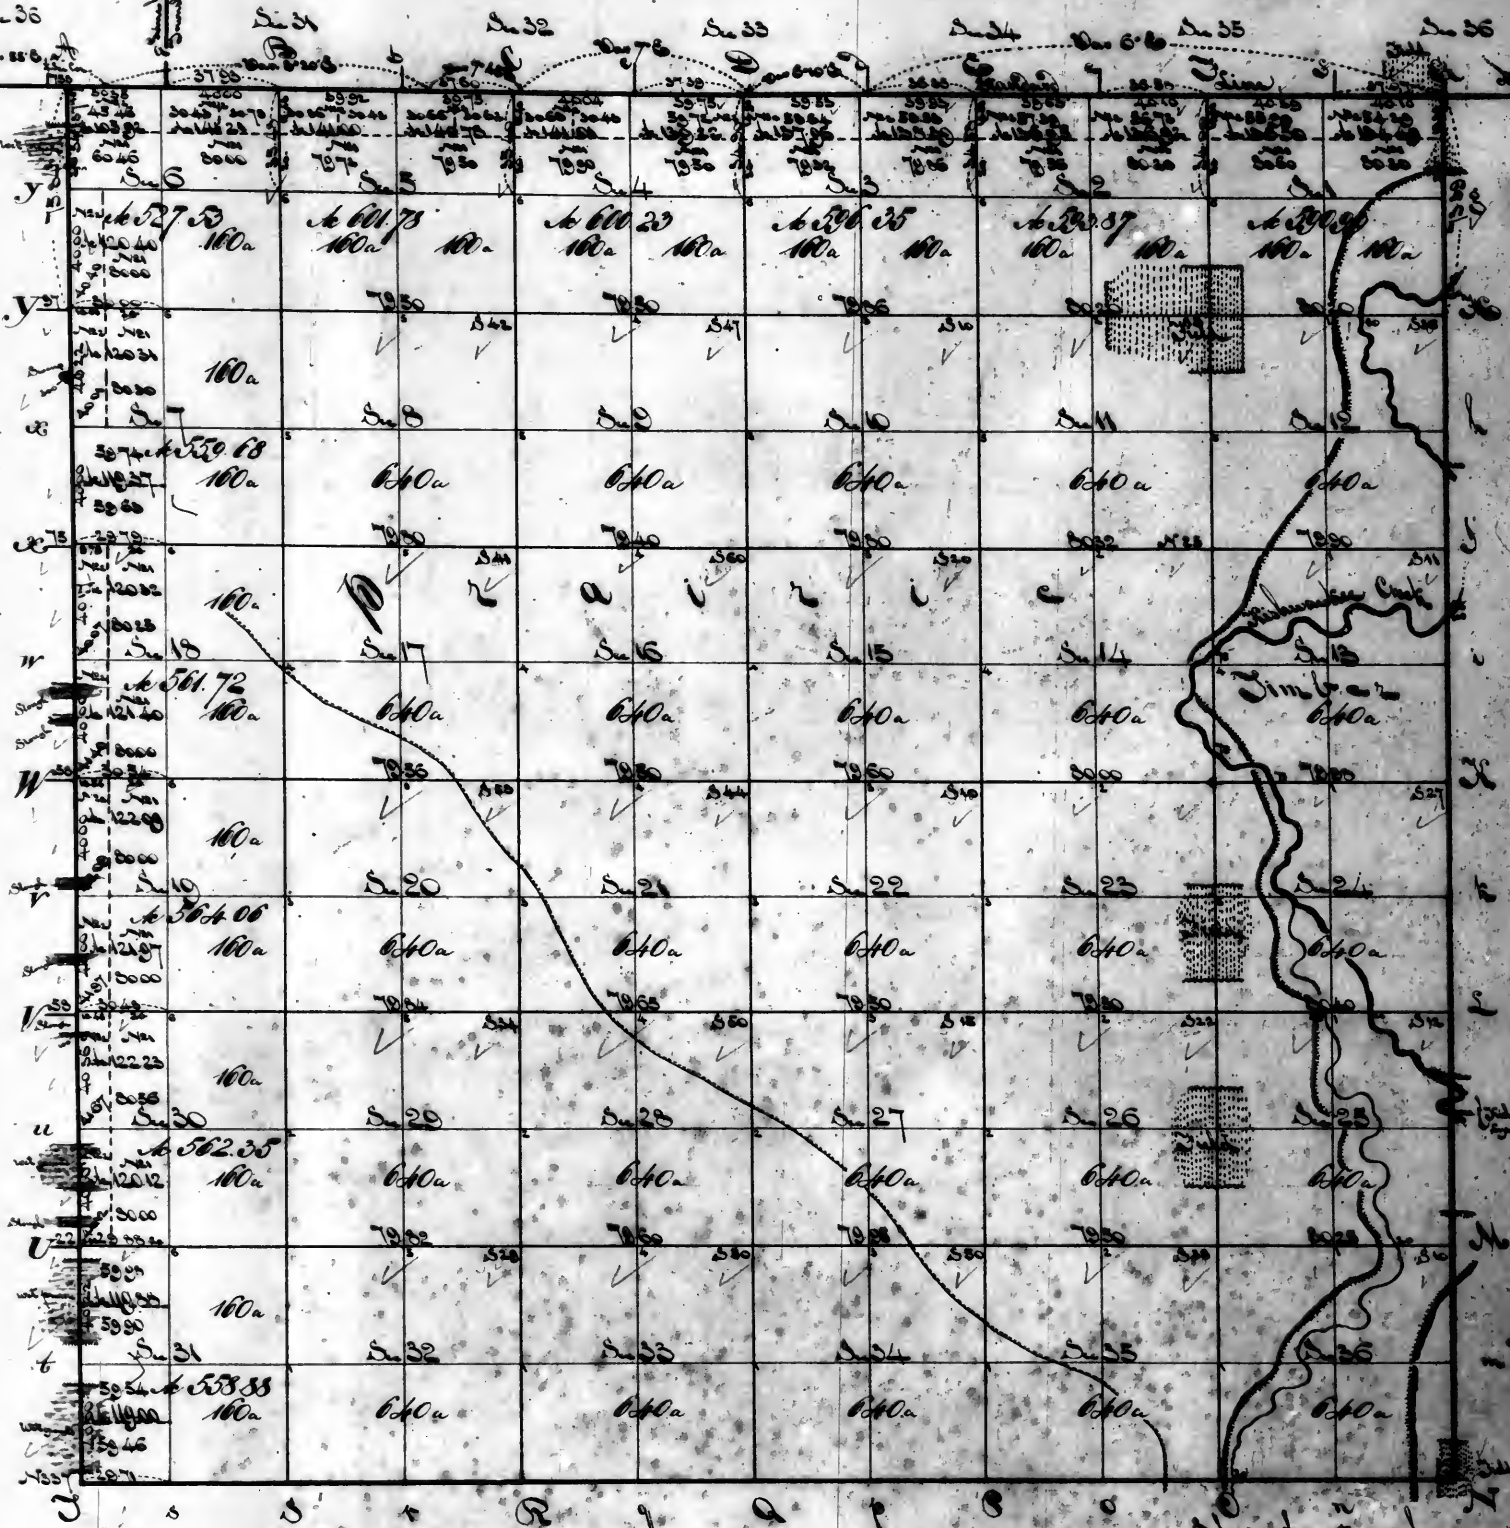

Notes: The accounts in which that part of the land boundary of this township, west of the range line, between ranges 3 & 4 is charged, comes to \$2,443.59m of which \$2,550. was paid on the 20th of May 1837 - and \$93.59m on the 20th of May 1838. The balance being \$200 having been paid by Elias S. Langdon from township funds.

Silas Reeds

Surveyors Office. Saint Louis 24th of August 1842.

The above plat of township 41 north of the base line, range 4 east of the 3rd principal meridian is strictly conformable to the field notes of the survey thereof on file in this office which have been examined and approved. That part of the north boundary which is west of the range line between S. 42 R. 3 & 4, was surveyed in the 1st quarter of 1836, by S. A. Spaulding, under contract of the 9th of June 1835; - and with the limitation noted in the margin, it was paid for (32.42 chains) in the 3rd quarter of 1837 and 2nd quarter of 1839 and charged in the accounts current of the Surveyor General for those quarters, Vouchers N^o 6 and 7. That part of the north boundary, east of the said range line 5 miles and 35 chains was surveyed in the 2nd quarter of 1837, by S. A. Spaulding, under contract signed by the Surveyor General on the 21st of November and by M. Sprigg on the 15th of December 1836; - it was paid for in the 1st quarter of 1839, and charged in the account current of the Surveyor General during that quarter, Voucher N^o 2. The west boundary 5 miles 75.84 chains, was surveyed in the 4th quarter of 1838, by S. A. Spaulding under contract signed by the Surveyor General on the 20th of September 1837, and by Spaulding on the 14th of May 1838; - it was paid for in the 2nd quarter of 1839, and charged in the account current of the Surveyor General during the same quarter, Voucher N^o 8. The south boundary 5 miles 69.71 chains, and the east boundary 5 miles 73.39 chains were surveyed in the 4th quarter of 1839, by James Thompson, and John P. Thompson, under their joint contract of the 21st of September 1839 - they were paid for in the 3rd quarter of 1840, and charged in the account current of the Surveyor General during that quarter, Voucher N^o 17. The subdivision lines 59 miles and 13 links, were surveyed in the 4th quarter of 1840, by James Thompson and John P. Thompson, under their joint contract of the 18th of September 1840 - they were paid for in the 3rd quarter of 1842, and charged in the account current of the Surveyor General during that quarter, Voucher N^o 7.


Silas Reeds

Surveyor of the public lands in the States of Illinois and Missouri.

By J. A. Spaulding
24th of August 1842

Township N^o 42 North of the Base line in Range N^o 4 East of the 3^d principal Meridian.

Note. The survey of the East boundary and of each of the several ranges of sections in the subdivision of this Township was commenced at the respective variations stated on the Southern tier of Sections, and the meridian lines were carried North through the Township by fore and back sights, disregarding the many changes in the variation, occasioned by local attraction, which are noted on the plat. The East & West random lines and the West lines in the Western range of Sections were all run at right angles to the proper North & South lines.

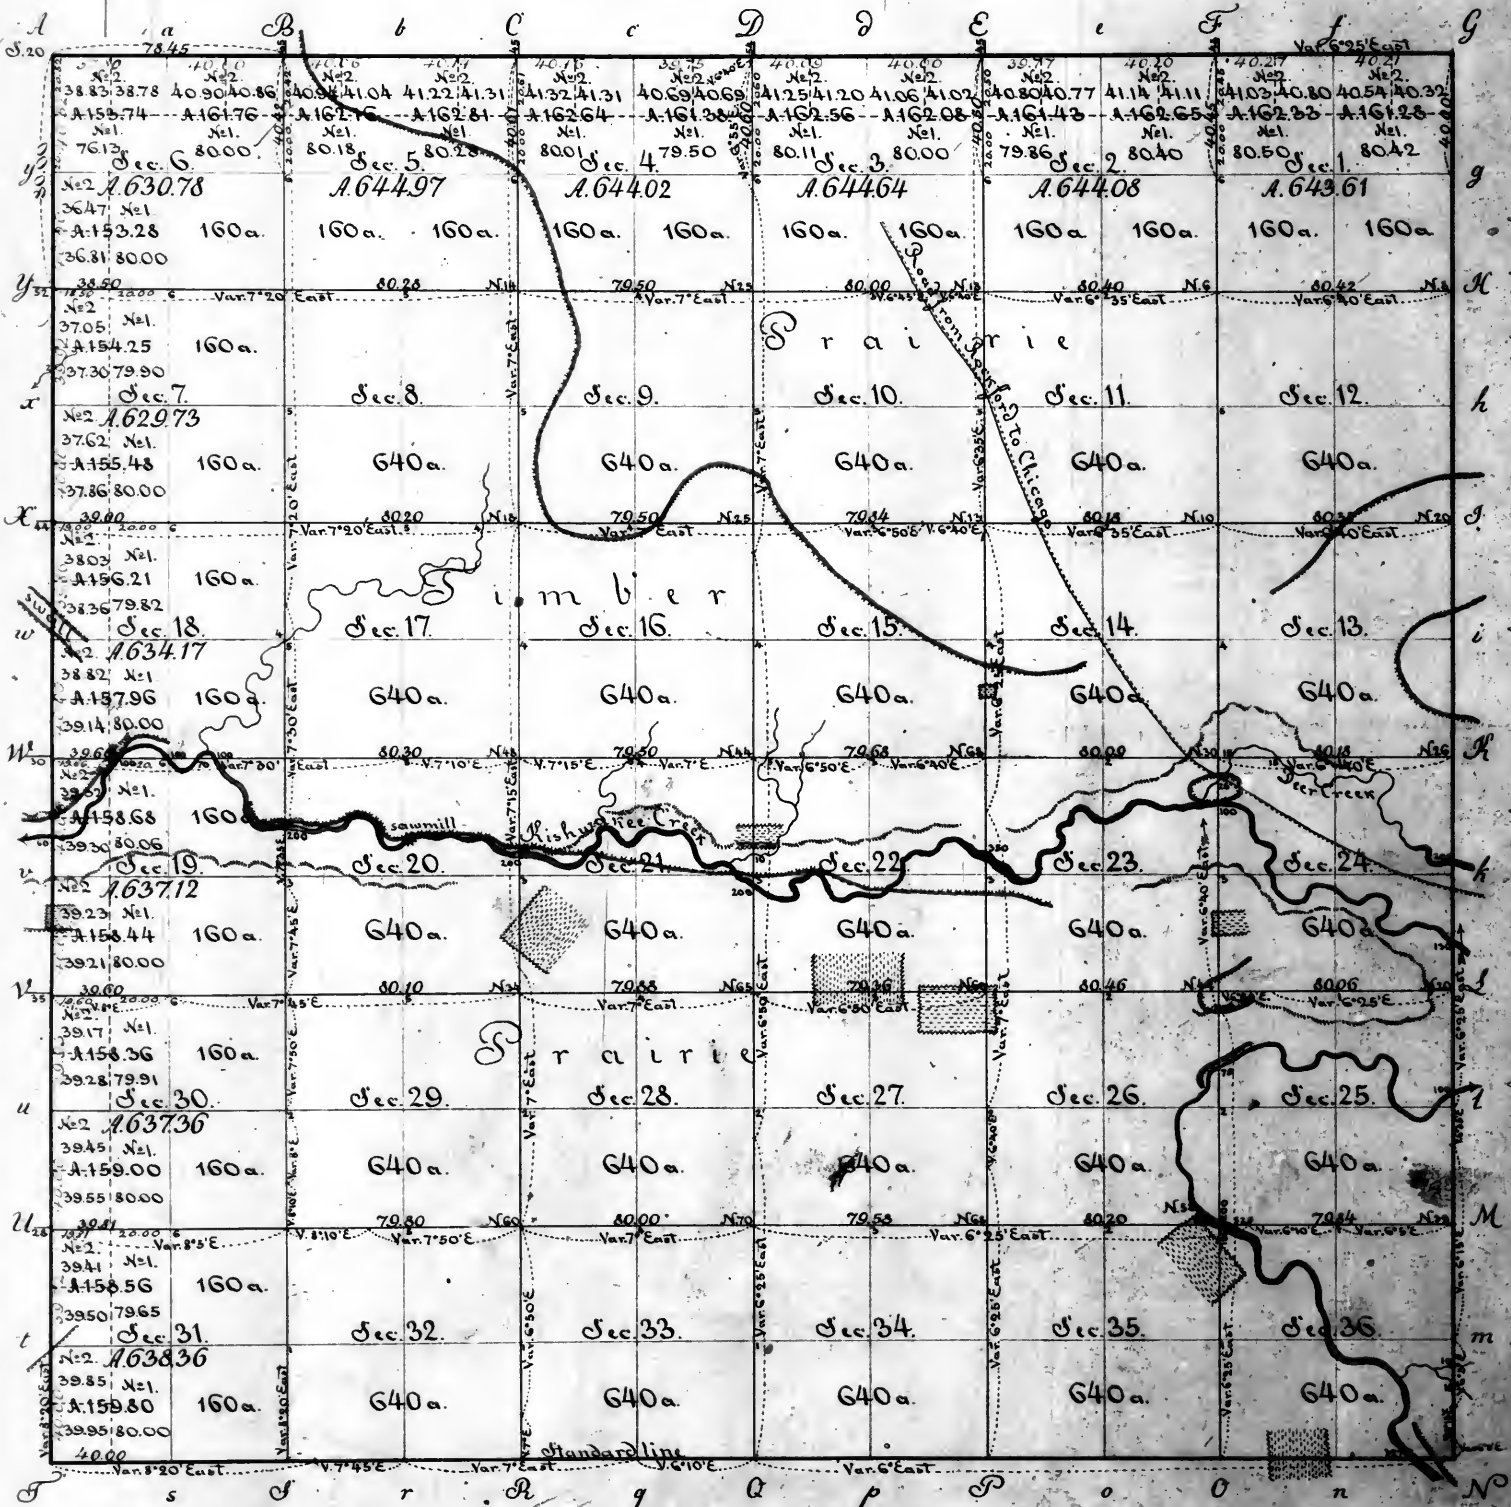

Surveyors Office.

Saint-Louis 14th of May 1839


Scale of 40 chains to one inch.

Aggregate Area 2302884 acres.

The above plat of township 42 north of the base line, range 4 east of the 3^d principal meridian, is strictly conformable to the field notes of the survey thereof, on file in this Office, which have been examined and approved. - The west boundary (6 miles) was surveyed in the 4th quarter of 1836, by D. B. Spaulding, under contract of the 9th of June 1835, and was paid for in the 3^d quarter of 1837 - and charged in the account of the Surveyor General for that quarter - Voucher N^o 6 - The South and East boundaries (6 miles each) and the north boundary (5 miles 78.45 chains) were surveyed in the 2^d quarter of 1837, and the subdivision lines (59 miles 78.88 chains) were surveyed in the 3^d quarter of 1837 - all by Ignatius Spragg, under contract signed by the Surveyor General on the 21st of November, and by the said Spragg on the 15th of December 1836 - and to the extent noted in the margin, they were paid for in the first quarter of 1839, and charged in the account of the Surveyor General for that quarter - Voucher N^o 2.

William M. M. M.
Surveyor General

Township N. 43 North of the Base line in Range N. 4 East of the 3^d principal Meridian.

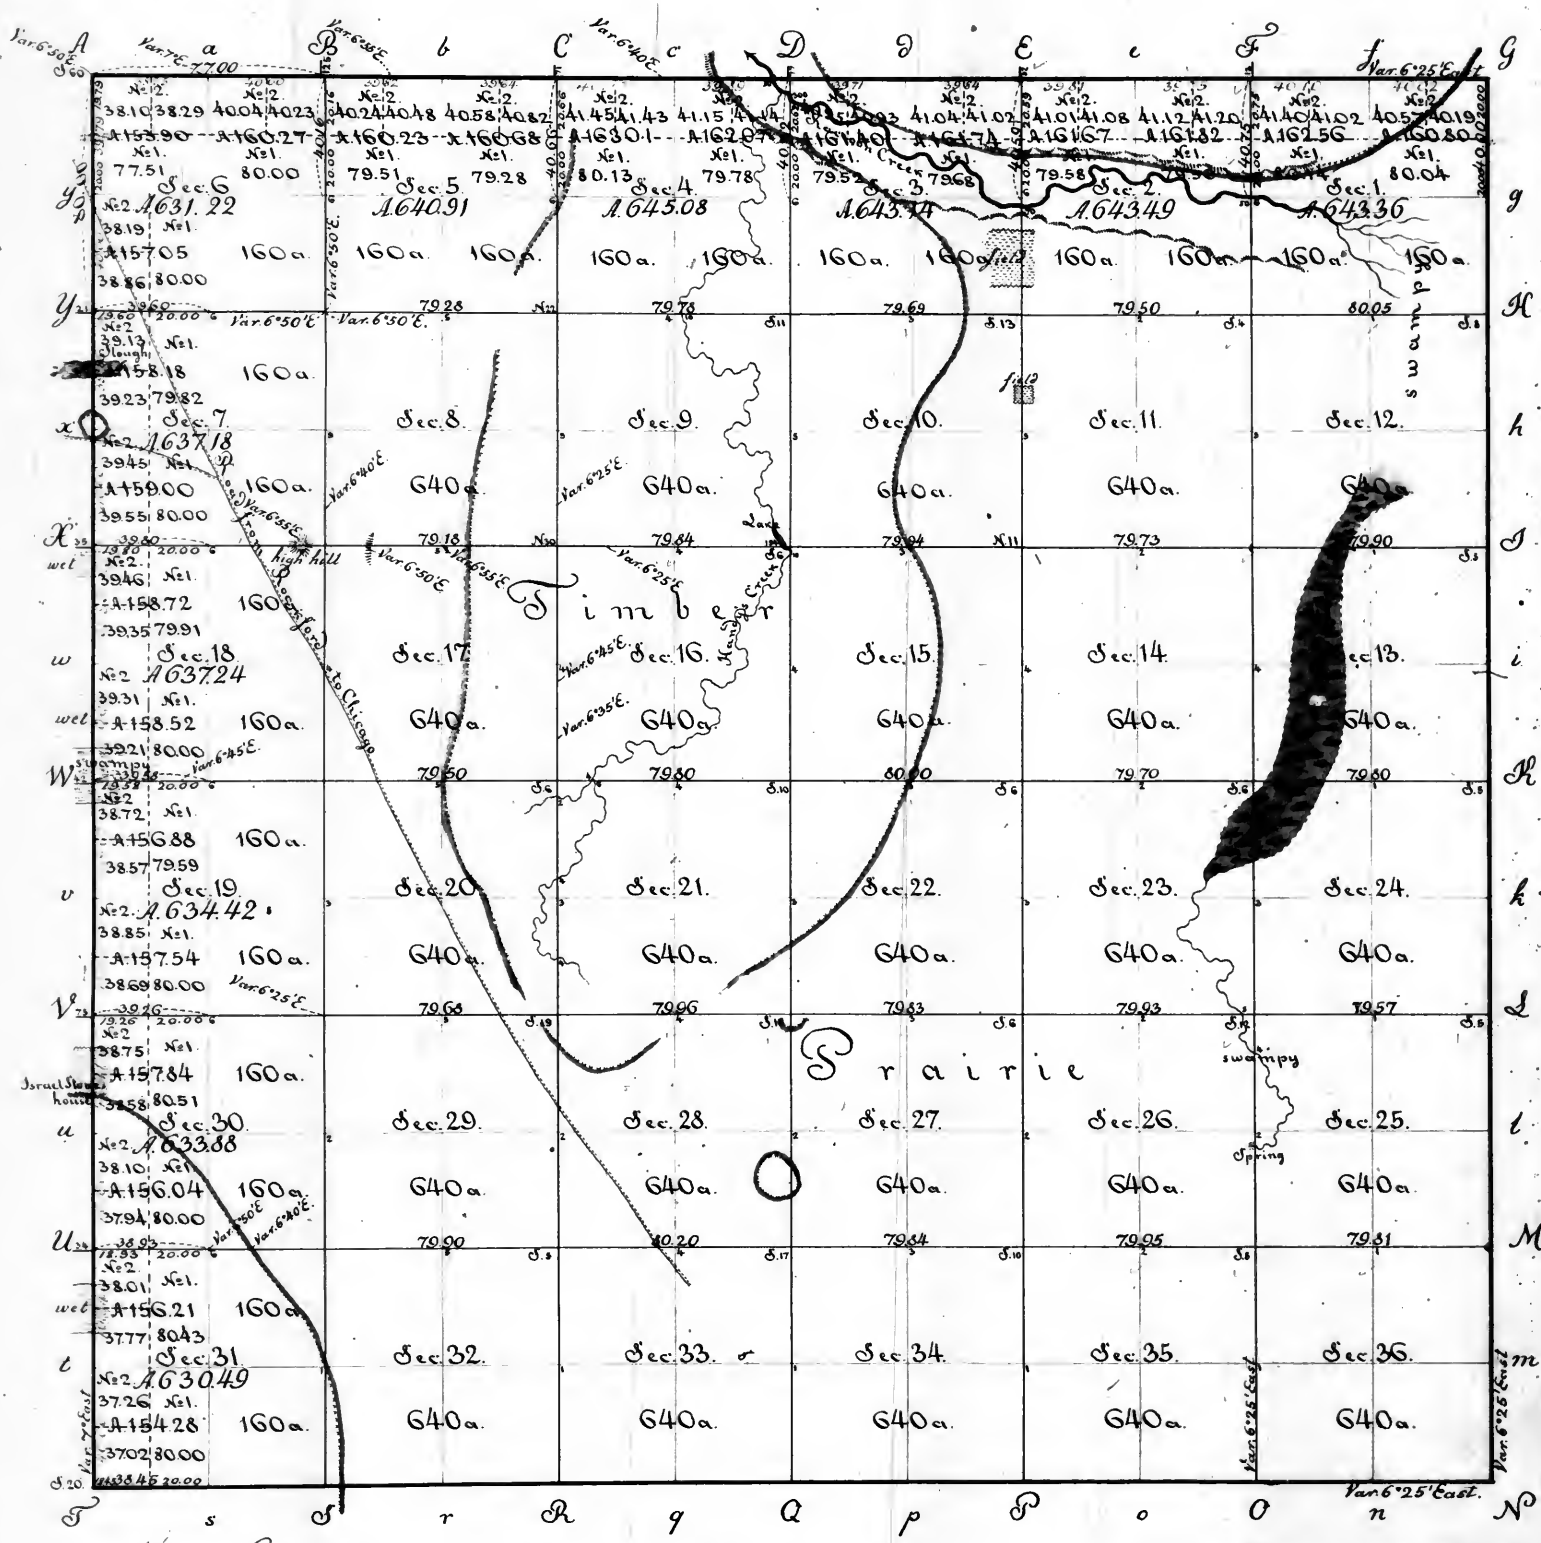

(Note: The accounts in which the west boundary of this township is charged amount to \$2,443.95, of which \$2050.00 were paid on the 25th of July 1837 - and \$493.95 on the 20th of June 1839 - the balance being \$900.00 having been paid by C. O. Langham - former Surveyor General, due Voucher N. 6 of the account of the Surveyor General for the 3^d quarter of 1837 - and voucher N. 7 of account for the 2^d quarter of 1839)

Surveyor General's Office.
Saint Louis 22 July 1839.


Scale of 40 chains to one inch.
Aggregate area 23020.41 acres.

The above plat of township 43 north of the base line range 4 east of the 3^d principal meridian is strictly conformable to the field notes of the survey thereof on file in this Office, which have been examined and approved - The west boundary 6 miles was surveyed in the 4th quarter of 1836 by D. H. Spaulding, under contract of the 9th of June 1835, and with the limitation noted in the margin it was paid for in the 3^d quarter of 1837 and 2^d quarter of 1839, and charged in the accounts of the Surveyors General for those quarters Vouchers N. 6 & 7. The South boundary 5 miles 78.45 chains - The east boundary 6 miles - The North boundary 5 miles and 77 chains were surveyed in the 2^d quarter of 1837 - and the subdivision lines 57 miles 74.68 chains + 79.94 chains + 79.69 chains - 59 miles 74.31 chains were surveyed in the 3^d quarter of 1837 and 2^d quarter of 1839 - all by Ignatius J. Sprigg, under contract signed by the Surveyor General on the 21st of November 1836, and by the said Sprigg on the 15th day of December of the same year. They were paid for on the 1st and 2^d quarters of 1839, and charged in the accounts of the Surveyors General for those quarters Vouchers N. 2 and 3.

William Milburn
Surveyor General
LH

Township N. 44 North of the Base line in Range E. 4 East of the 3^d principal Meridian.

19

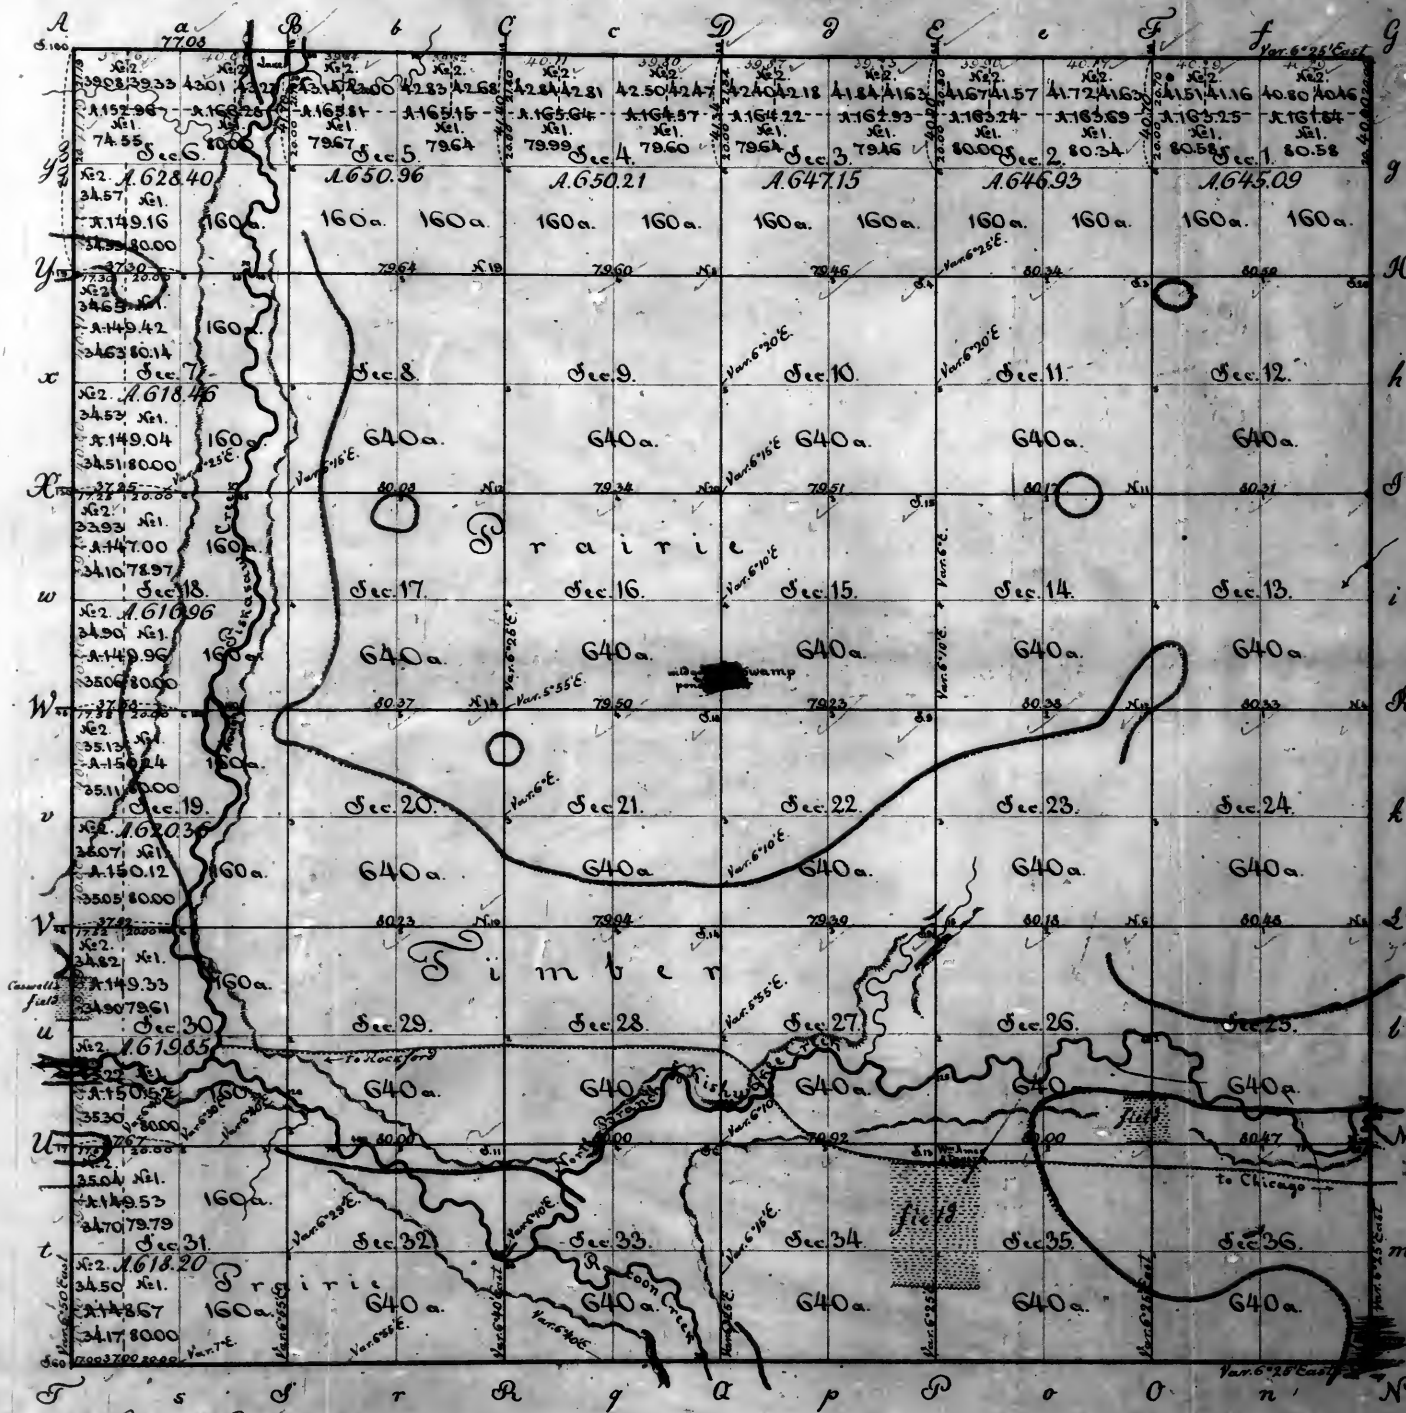



Surveyor General's Office.
 Saint Louis 22 July 1839.

The above plat of Township N. 44 north of the base line, range 4 east of the 3^d principal meridian, is strictly conformable to the field notes of the survey thereof on file in this office, which have been examined and approved. The west boundary 6 miles was surveyed in the 4th quarter of 1836, by Don A. Long Spaulding, under contract of the 3rd of June 1835, and with the limitation noted in the margin it was paid for in the 2^d quarter of 1837, and 2^d quarter of 1839, and charged in the accounts of the Surveyor General for those quarters Vouchers N. 6 and 7 - The south boundary 5 miles 77 chains - The east boundary 6 miles, and the North boundary 5 miles 77.08 chains, were surveyed in the 2^d quarter of 1837 - and the subdivision lines 58 miles 72.45 chains + 1 mile 27 links = 59 miles 72.72 chains, were surveyed in the 3^d quarter of 1837, and 2^d quarter of 1839, all by Ignatius J. Sprigg, under contract signed by the Surveyor General on the 21st day of November 1836, and by Sprigg on the 15th day of December of the same year. The surveys by Sprigg were paid for in the 1st and 2^d quarters of 1839 - and charged in the accounts of the Surveyor General for those quarters Vouchers N. 2 and 3.

William Millburn
 Surveyor General

Township N. 45 North of the Base line in Range N. 4 East of the 3^d principal Meridian.

20

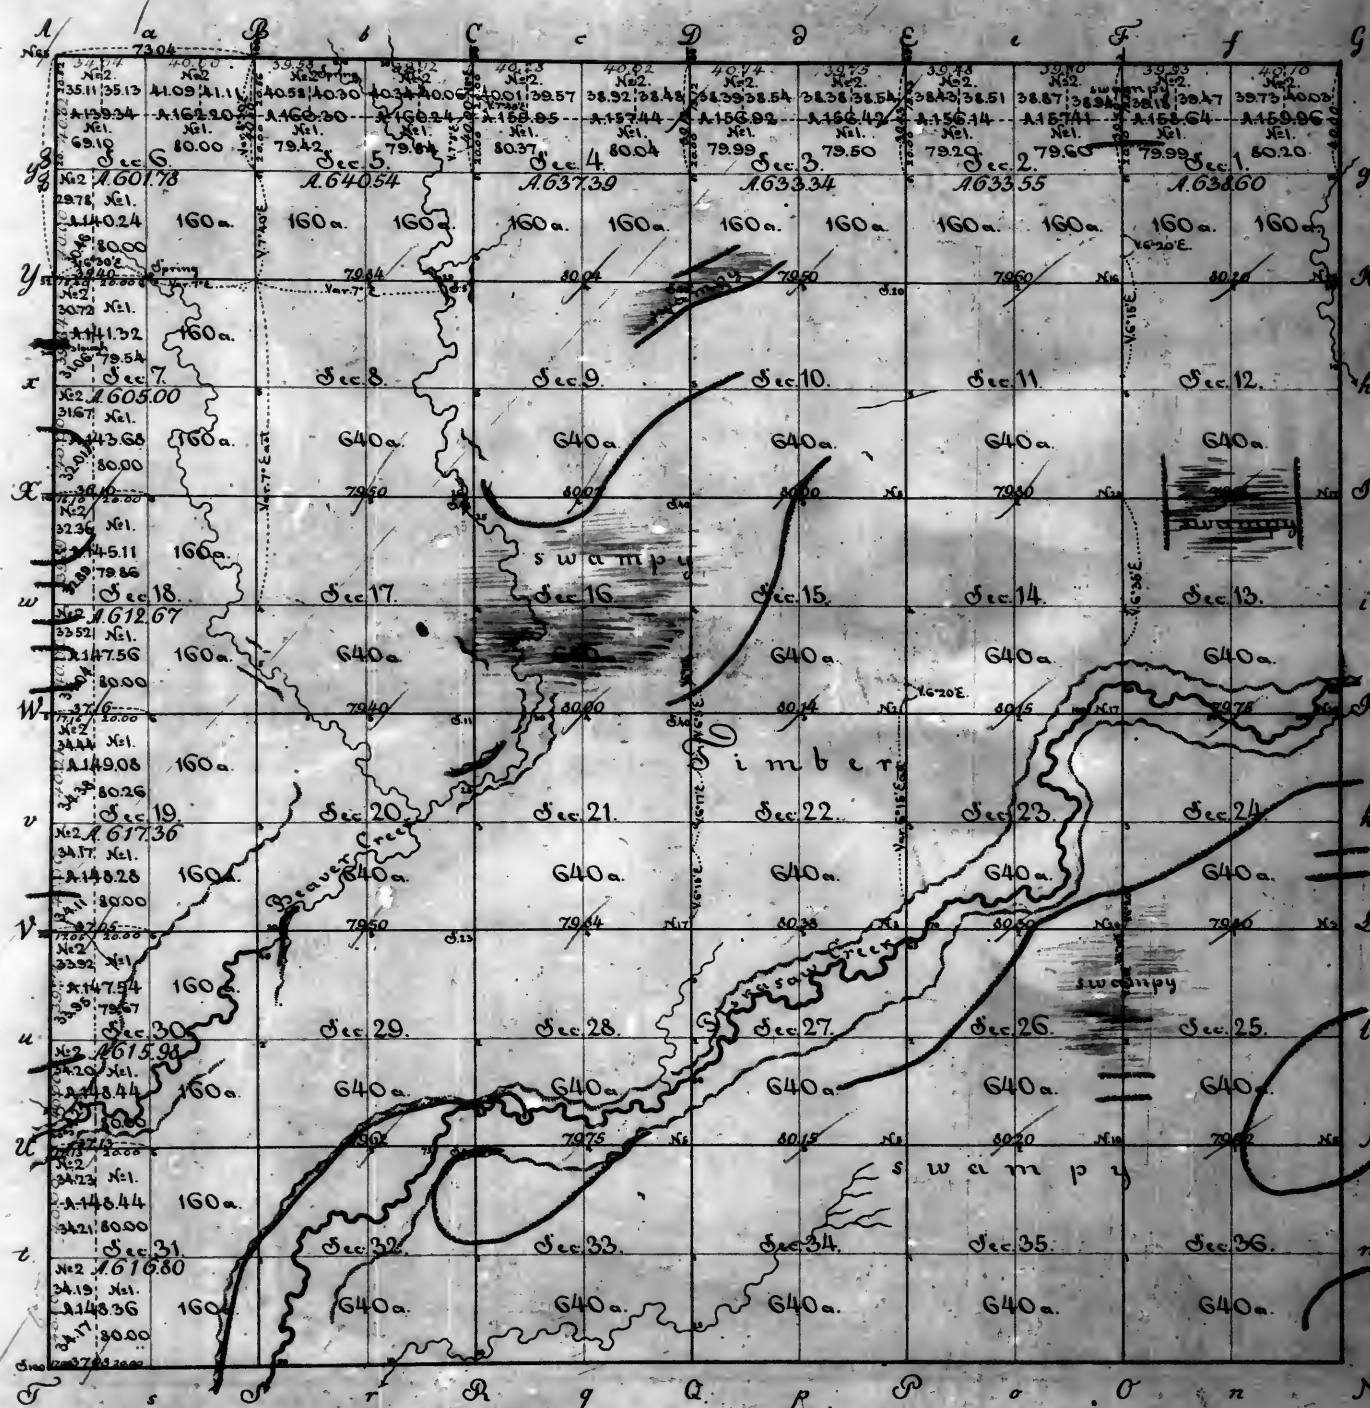


Surveyors' Office.

Scale of 40 chains to one inch.

Aggregate Area 22853.01 acres.


The above plat of township N. 45 North, range N. 4 East of the 3^d principal meridian is strictly conformable to the field notes of the survey thereof on file in this office, which have been examined and approved. 

Surveyor General

Variation:
on W. 12th - 6° 50' East
on all the other lines 6° 25' East
except where stated otherwise
on this plat, the change in
variation being accounted for
attraction, which was
by operating with fore

Township $\#46$ North of the Base line in Range $\#4$ East of the 3^d principal Meridian.

Explanatory note by the Deputy Surveyor relative to the variation of the needle in subdividing this township. — In all cases where there was a variation of the needle, the variation was noted by me, and shown by the direction of the needle, when the compass was set on the direct line as before, and adjusted to the variation of which the line was commenced on the South boundary of the township in the subdivision; or on the standard line in ranging the exterior lines. The South boundary line of Township $\#46$ North, Range $\#4$ East was run at a variation of $6^{\circ} 25'$ East the north being free of attraction in the subdivision of said township the N. & E. lines were each started from the South boundary thereof with the compass adjusted to said variation ($6^{\circ} 25'$) and continued as straight lines to the North boundary, fore and back sights being used as before over all such parts of said lines where there appeared to be any attraction — all random lines were commenced with the compass adjusted to the variation shown by the needle, when set on the direct North and South lines at the corners from which said randoms were started and continued by fore and back sights over all such parts of said lines where there appeared to be any attraction — they were run at right angles to the proper North and South lines — January 5th 1839 — J. Sprigg

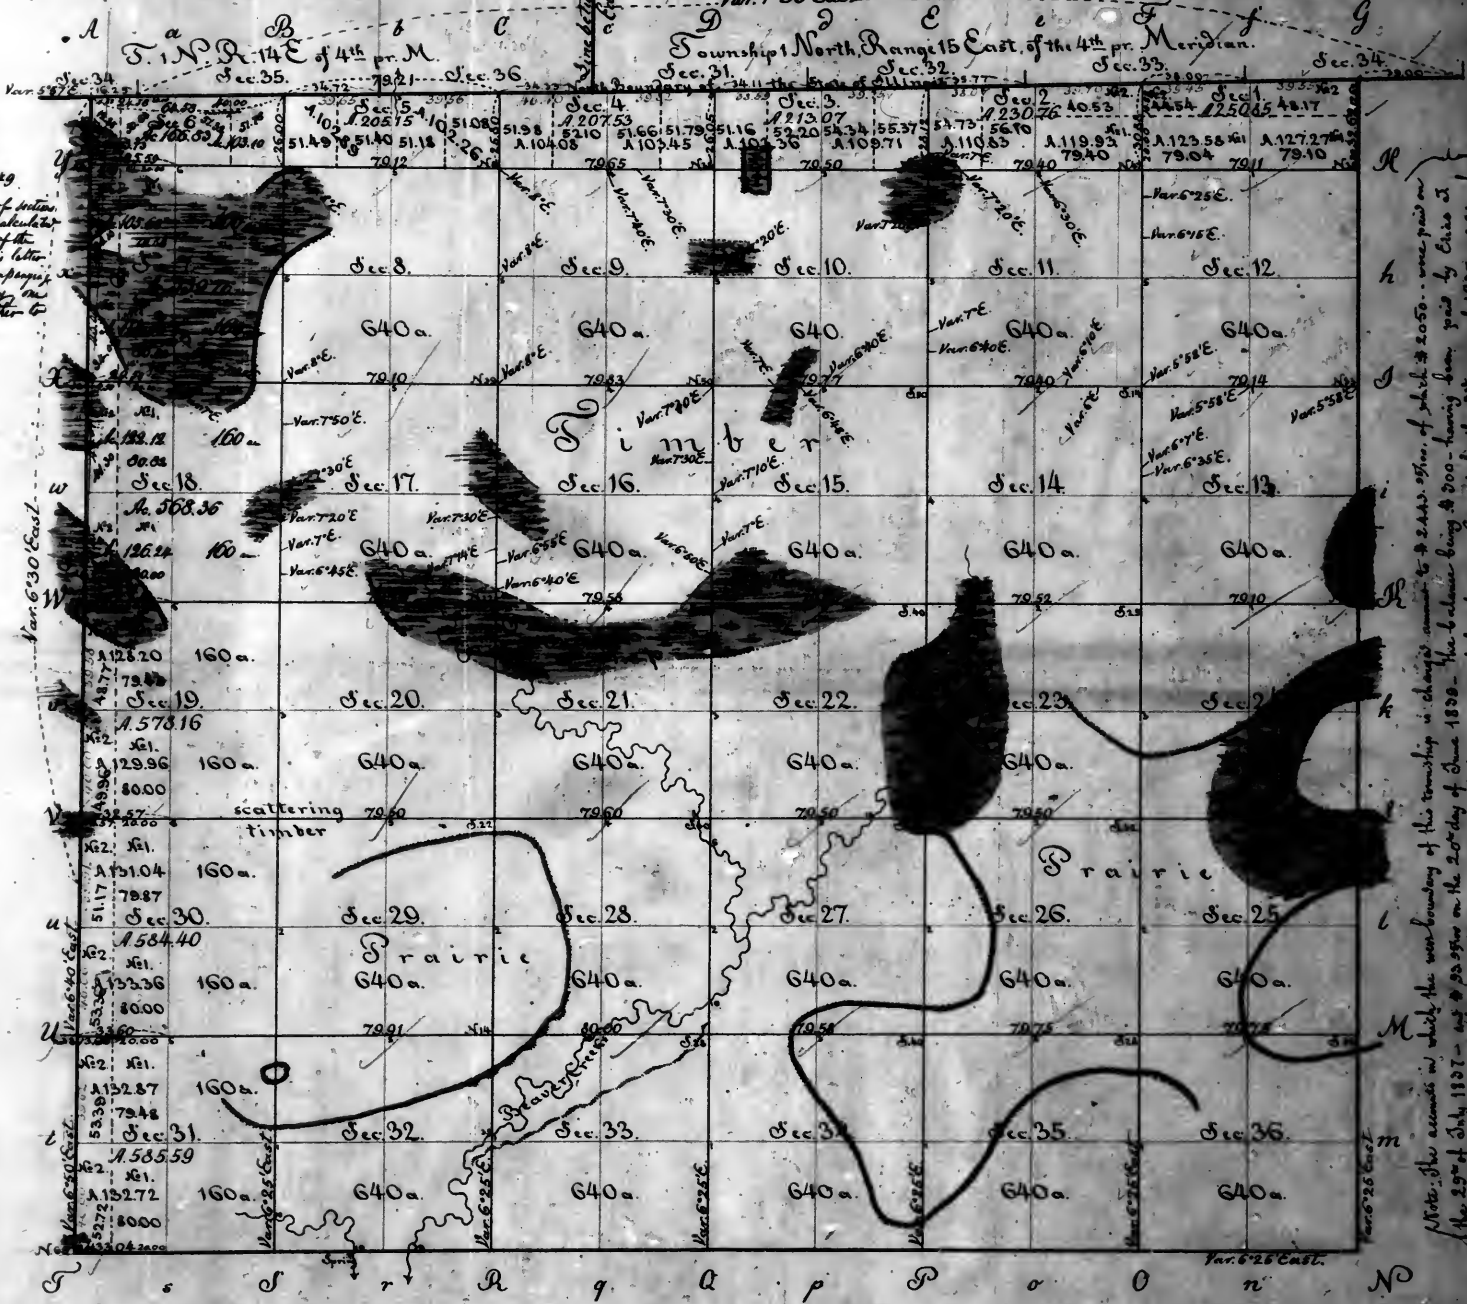

Surveyor General's Office.

Saint Louis. 22 July 1839

The above plat of Township $\#46$ north of the base line, range $\#4$ east of the 3^d principal meridian, is strictly conformable to the field notes of the survey thereof on file in this Office, which have been examined and approved. The North boundary was surveyed in 1832 and 1833 by Lucius Lyon, Commissioner on the part of the United States as certified to this Office by No. 1 Williams, Surveyor General of Ohio, Indiana & Michigan. The said line being a part of the boundary between Illinois and Michigan, now Wisconsin — The west boundary 5 miles 24.68 chains was surveyed in the 4th quarter of 1836, by Don Alvaro Spaulding, under contract of the 9th of June 1835, and with the limitation noted in the margin it was paid for in the 3^d quarter of 1837, and 2^d quarter of 1839, and charged in the accounts of the Surveyors General for those quarters, vouchers No. 6 & 7 — The South boundary 5 miles 73.04 chains, was surveyed in the 2^d quarter of 1837 — the east boundary 5 miles 32.62 chains — and the subdivision lines 56 miles 4.52 chains, were surveyed in the 3^d quarter of 1837, all by Ignatius J. Sprigg, under contract signed by the Surveyor General, on the 21st of November 1836, and by Sprigg on the 15th day of December of the same year. The surveys by Sprigg, were paid for in the 1st and 2^d quarters of 1839 — and charged in the accounts of the Surveyors General for those quarters Vouchers No. 2 and 3

William Milburn
Surveyor General

Notes: The accounts in which the west boundary of this township is charged amount to \$2,443.25, of which \$2,059.00 were paid on the 25th of July 1837 — and \$384.25 on the 20th day of June 1839. The balance being \$384.25 having been paid by Charles J. Longfellow, former Surveyor General, in Voucher No. 6 of the accounts of the Surveyor General for the 3^d quarter of 1837, and Voucher No. 7 of account for the 2^d quarter of 1839 (William Milburn)

22


David Buchanan
Sic. Land.


22

m


Township 27 North of the base line Range 5 East of the 3rd principal Meridian

23

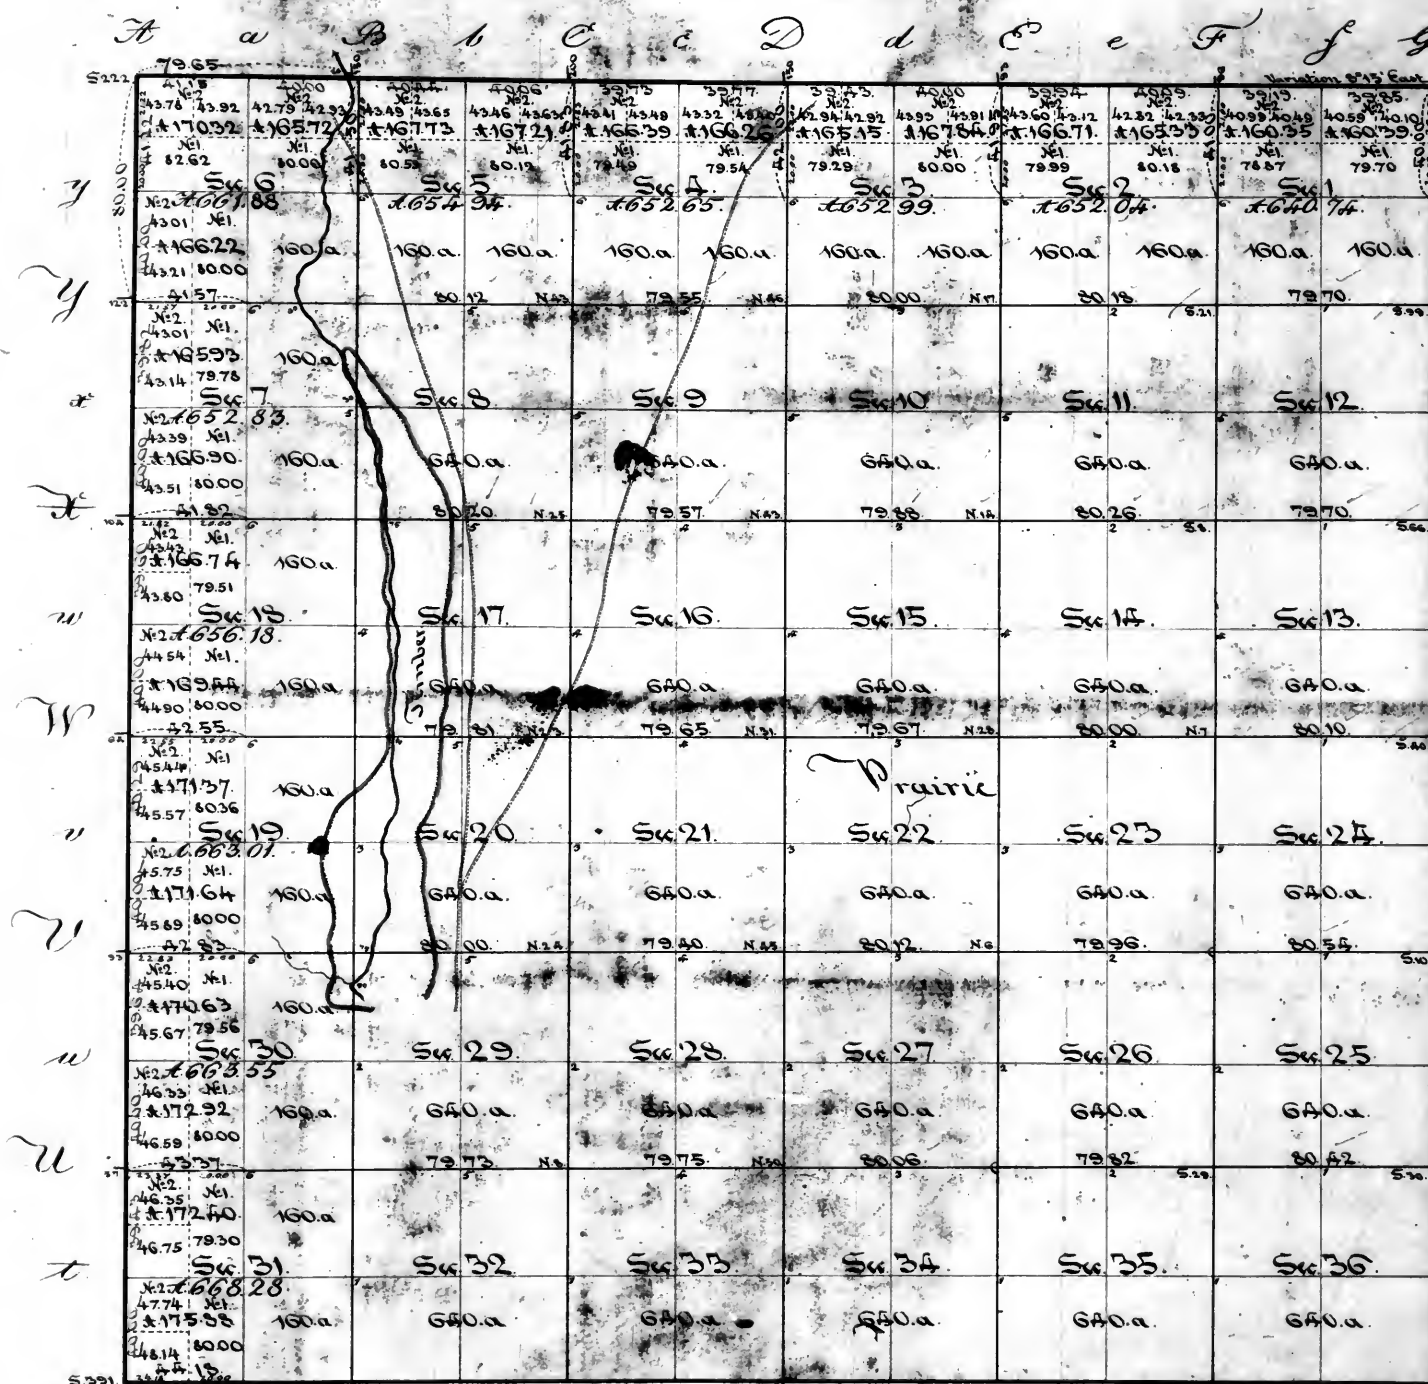





III. Variation

| | |
|-------------|-------------|
| West bounds | - 7° 20' E. |
| South | - 8° 15' E. |
| East | - 7° 57' E. |
| North | - 8° 15' E. |
| Subdivision | - 7° 57' E. |

Surveyors Office
Sami Louis. October 3rd 1838.


Scale of 40 chains to an inch.
Aggregate area = 23219.09 acres.

The above plat of township 27 North, range 5 East of the 3^d principal meridian is strictly conformable to the field notes of the survey thereof on file in this office which have been examined and approved. — The West boundary (6 miles) was surveyed in the 4th quarter of 1833, by James Moore, under contract of the 12th day of August of that year: — and the South boundary (6 miles 4.18 chains) was surveyed in the 4th quarter of 1833. — The East boundary (6 miles) — The North boundary (5 miles 79.65 chains) — and the subdivision lines (60 miles 18.61 chains) were surveyed in the 2nd quarter of 1834 — all by Enosh Moore under contract of the 12th day of August 1833, and with the limitation notes in the margin, the surveys by Enosh Moore were paid for in the 2nd quarter of 1833, and charged in the account of the Surveyor General for that quarter.

David Dunklin
Sut. Genl.

Township 28 North of the base line Range 5 East of the 3rd principal Meridian

24

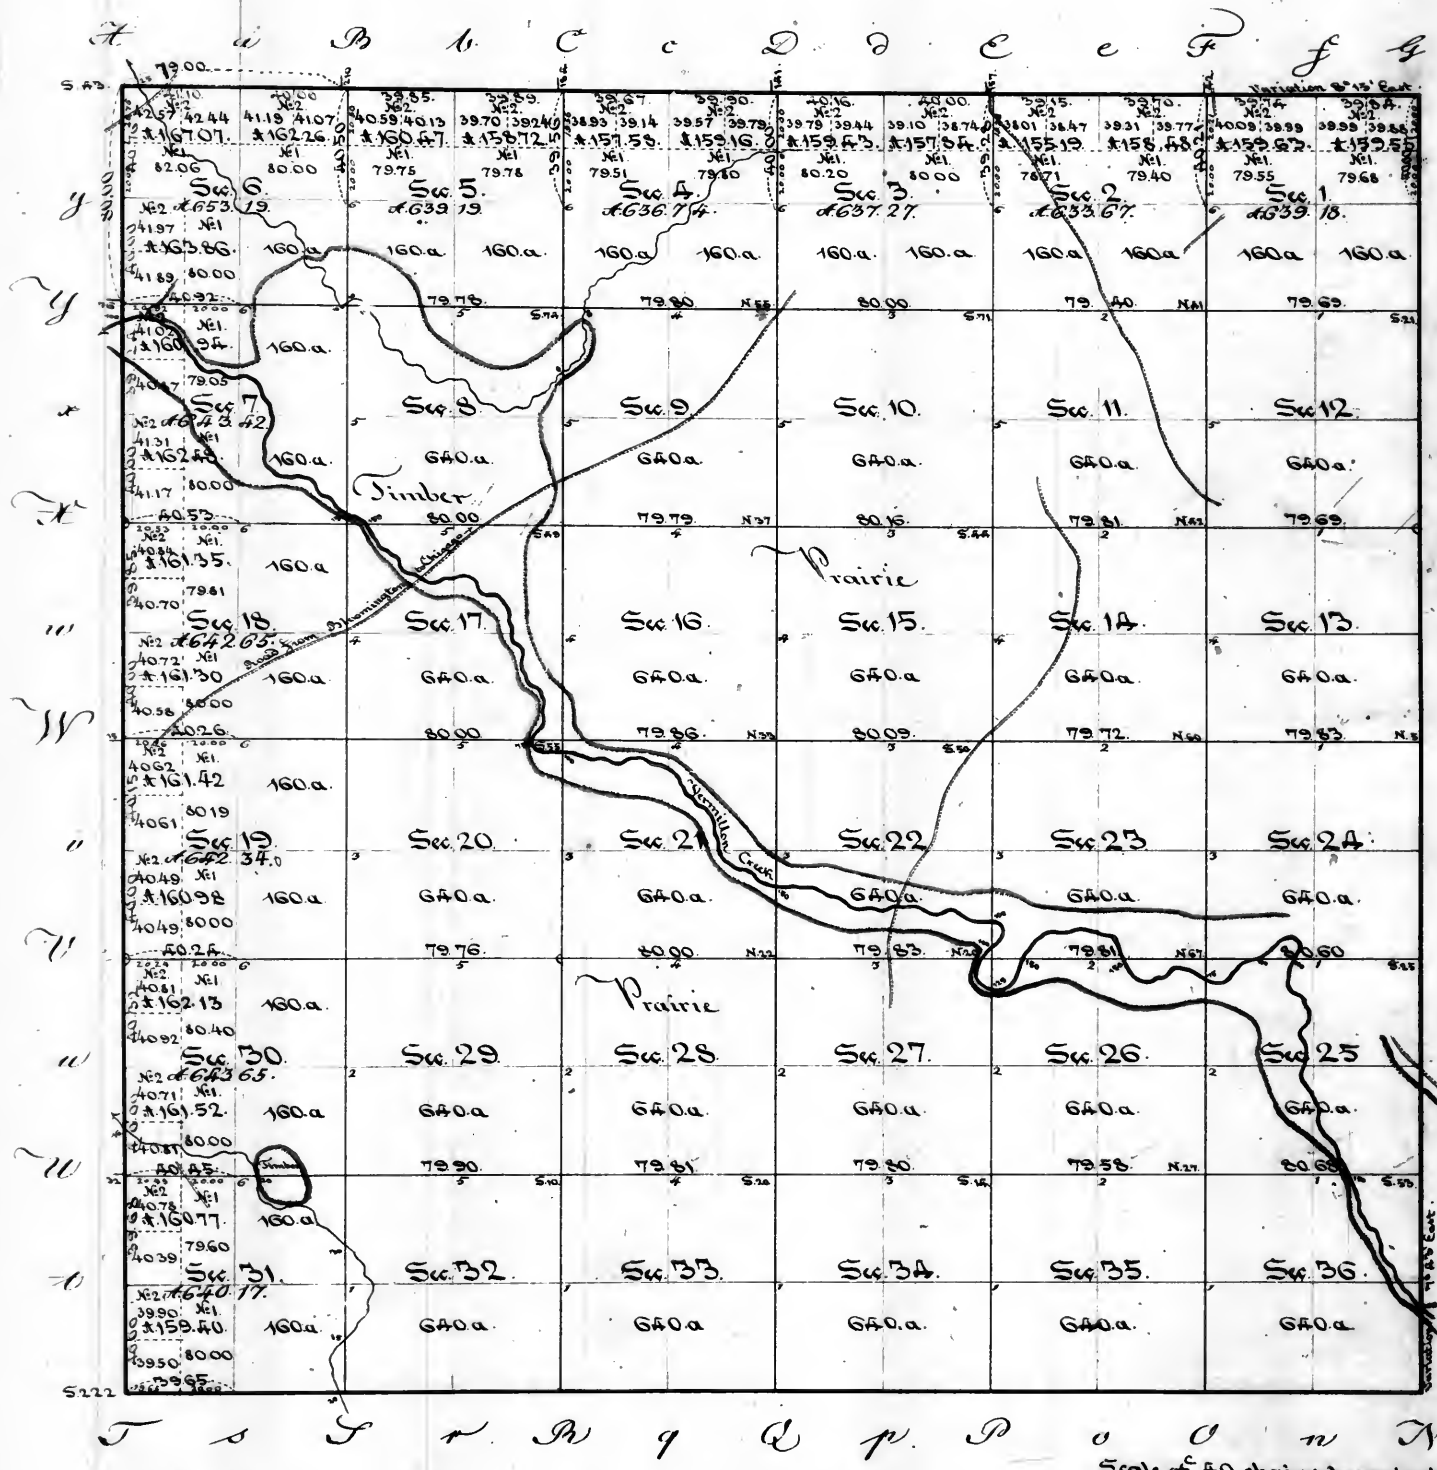

Notes: The approximate amount of the survey of this township (except the West boundary) is charged amount to \$ 2157. This of which \$ 1937 was paid on the 15th of June 1833; and the balance being \$ 200.00 was withheld for the purpose of paying the survey of the survey of the township range of sections in township 26 N. R. 5 E. which was done by J. M. Moore, under contract to the land office except that \$ 76.00 as paid survey of the township, and which is a consequence of the survey of the township line by J. M. Moore, under contract to the land office.

At St. Louis 10 Sept 1838

Check this map to the corners of the plot

Land office a copy of the plat of the northern (and western) tier of quarter sections

| Variation | |
|-------------|-----------|
| West bound | 71° 15' E |
| South | 8° 15' E |
| East | 71° 45' E |
| North | 8° 15' E |
| Subdivision | 71° 25' E |

Surveyors Office
Saint Louis October 31st 1838


Scale of 40 chains to an inch
Aggregate area = 23051.53 acres.

The above plat of township 28 north of the base line, range 5 East of the 3rd principal meridian, is strictly conformable to the field notes of the survey thereof on file in this Office, which have been examined and approved - The West boundary (6 miles) was surveyed in the 4th quarter of 1833 by James Moore, under contract of the 12th of August of that year - And the North boundary (5 miles 79 chains) was surveyed in the 4th quarter of 1833 - The South boundary (5 miles 79.65 chains) - The East boundary (6 miles) and the Subdivision lines (59 miles 79.34 chains) were surveyed in the 2nd quarter of 1834 - all by Enoch Moore, under contract of the 12th day of August 1833 - and with the limitation noted in the margin, the surveys by Enoch Moore, were paid for in the 2nd quarter of 1838, and charged in the account of the Surveyor General for that quarter.

David Sturges
Sur. Genl.

Township 29 North of the base line Range 5 East of the 3rd principal Meridian

25

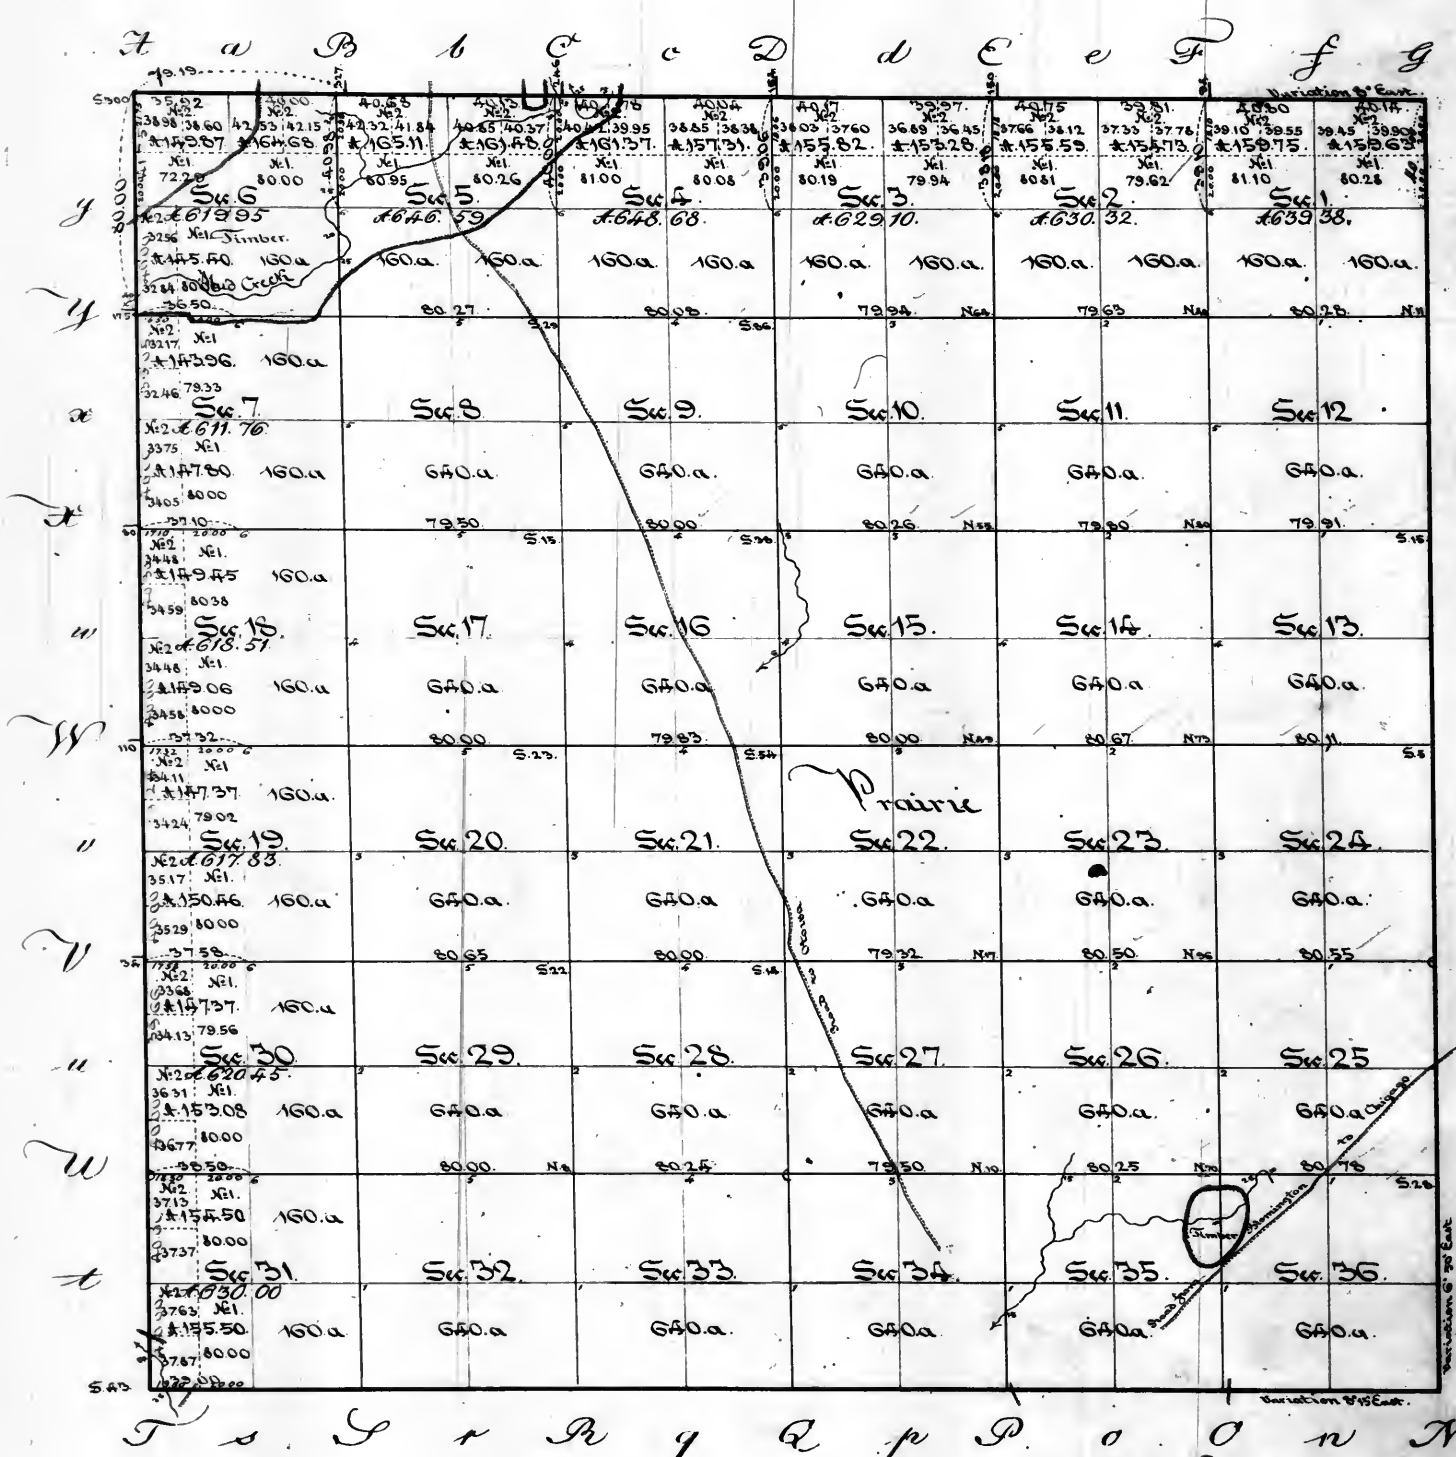

Note. The opposite account of Mr Moore in which the survey of the township, (except the West boundary) is charged amounts to \$ 2150 3/4, of which \$ 1937 9/16 was paid on the 15th June 1838, (viz the balance of £ 200. - was withheld for the purpose of meeting the partly completion of the survey of the Western range of sections in Sth 26th 27th and 28th E. which was done by J. Mc. Nevinson and D. Mc. Nevinson to the line between ranges 2 and 3 East, as far surveyed by Mr Moore, and which as a consequence of the survey of the two ranges done by Mr Moore, must be considered thenceforth by him.

 I enclose thereto a copy of the plan of the Western
 section two of quarter section.

777 Variation.
West bound 6° 50' E
South — 8° 15' E
East — 6° 50' E
North — 8° E
Subdivision - 6° 50' E

Surveyors Office
Saint Louis October 3rd 1838

Scale of 40 chains to an inch
Aggregate area = 22912.57 acres.

The above plat of Township 29 north of the base line, range 5 East of the 3^d principal meridian, is strictly conformable to the field notes of the survey thereof on file in this office, which have been examined and approved. The West boundary (6 miles) was surveyed by James Moore in the 4th quarter of 1833, under his contract of the 12th day of August 1833 — and the South boundary (5 miles 79 chains) — The East boundary (6 miles) and the North boundary (5 miles 79.19 chains) were surveyed in the 4th quarter of 1833 — and the subdivision lines (59 miles 66.39 chains) were surveyed in the 4th quarter of 1833 and 2^d quarter of 1834 — all by Erach Moore, under his contract of the 12th day of August 1833 and with the limitation noted in the margin, the surveys by Erach Moore, were paid for in the 2^d quarter of 1838, and charged in the account of the Surveyor General for that quarter.


David Hunt Clin
Sur Genl

Township 30 North of the base line Range 5 East of the 3^d principal Meridian.

26

193

26

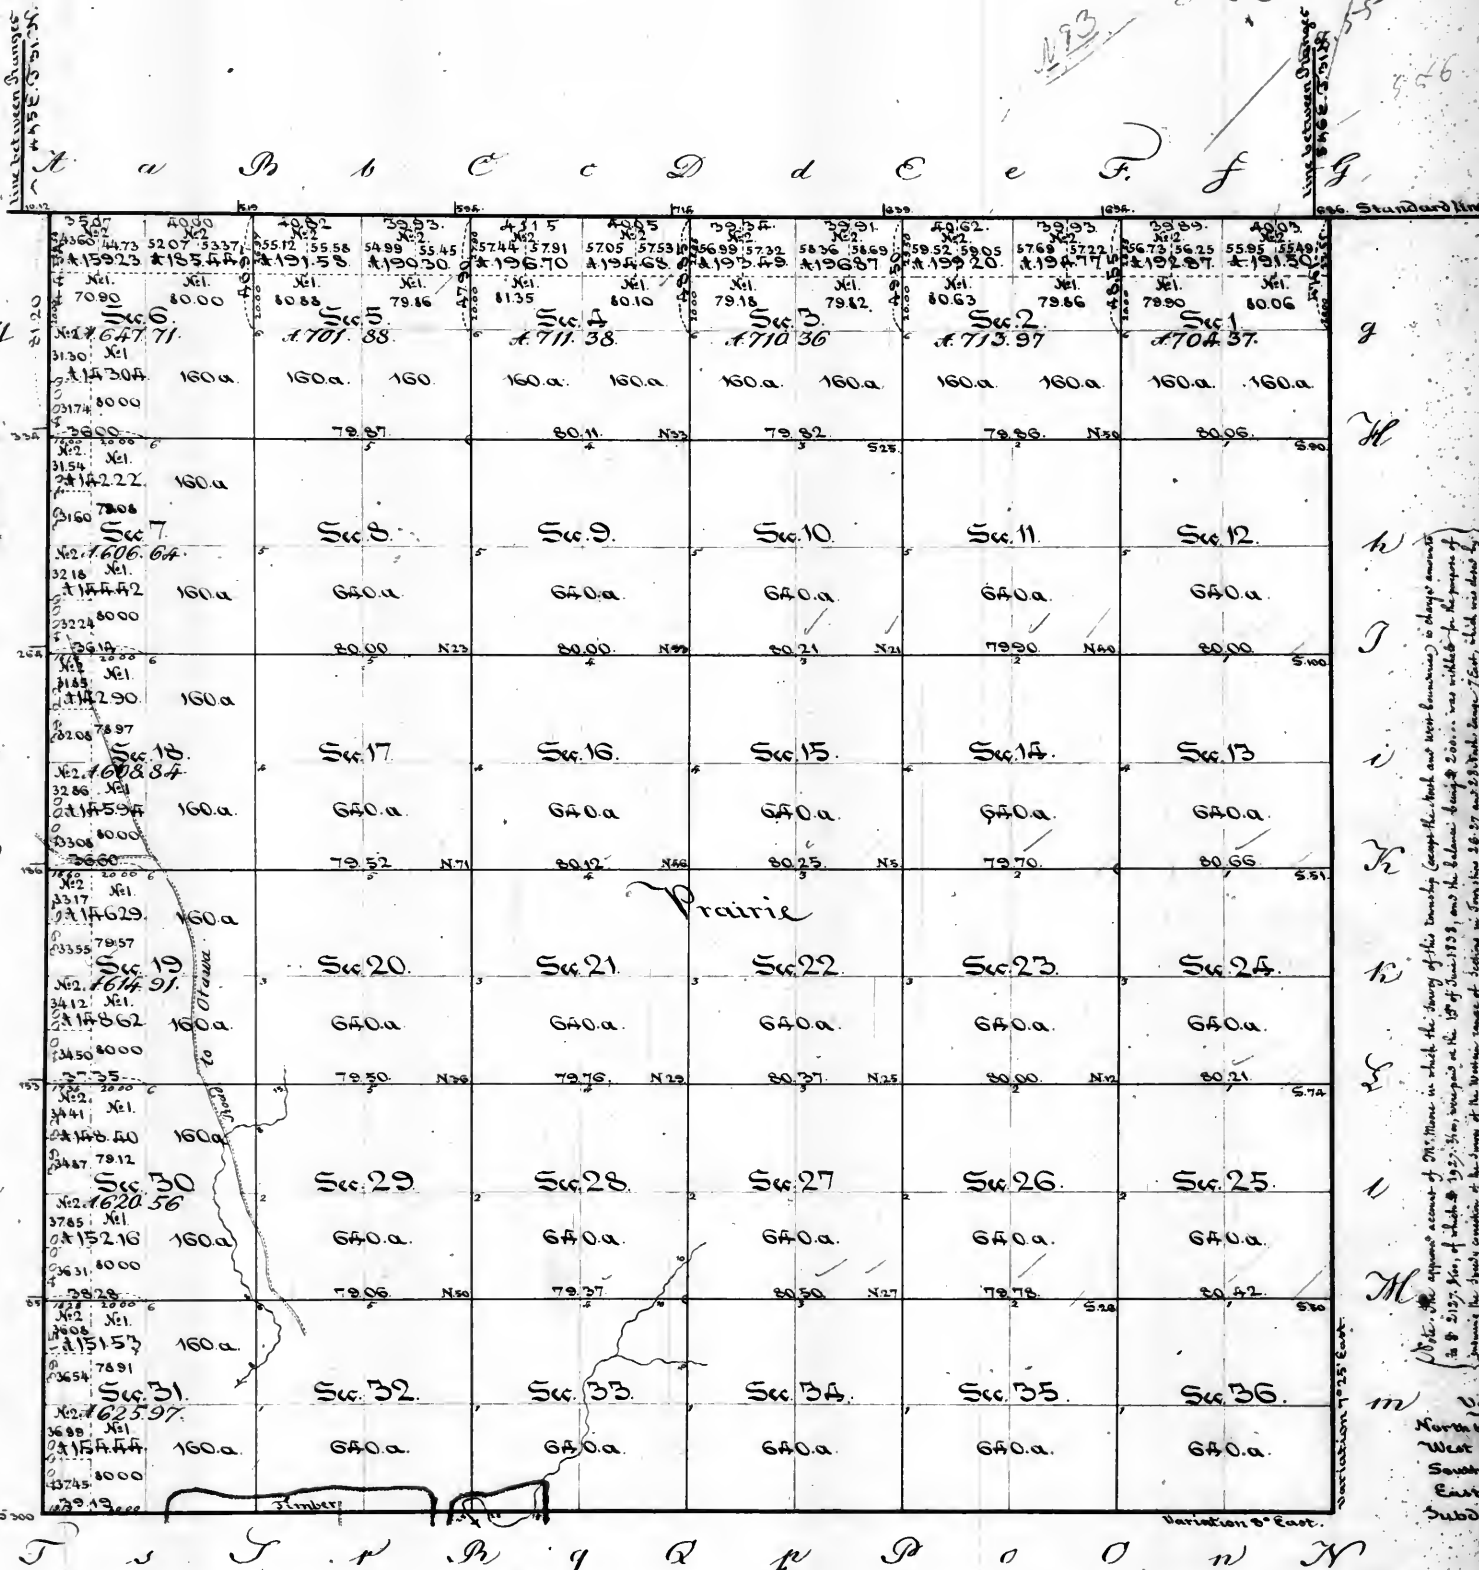

Surveyors Office
Saint Louis October 9th 1838

Scale of 40 chains to an inch
Aggregate area = 23266.59 acres.

The above plat of Township 30 North of the base line, range 5 East of the 3^d principal meridian, is strictly conformable to the field notes of the survey thereof on file in this Office, which have been examined and approved. The North boundary (5 miles 76.76 chains) was surveyed in the 2^d quarter of 1821, by Daniel Miller, under the joint contract of Stephen Rector and Thomas C. Rector, with the Surveyor General, dated 20th of March 1821. The West boundary (6 miles 12.0 chains) was surveyed in the 4th quarter of 1833, by James Moore, under contract of the 12th day of August 1833. and the South boundary (6 miles 79.19 chains) the East boundary (6 miles 6.77 chains) and the subdivision lines (6 miles 25.19 chains) were all surveyed in the 4th quarter of 1833, by Enock Moore, under contract of the 12th day of August 1833. and with the limitation noted in the margin, the surveys by Enock Moore, were paid for in the 2^d quarter of 1838, and charged in the account of the Surveyor General for that quarter.

Daniel Miller
Sur. Genl.

Variation
North bound 2 not stated
West bound 6° 20' E
South 8° E
East 7° 25' E
Subdivision 7° 25' E

Township N 31 North of the base line Range N 5 East of the 3^d principal Meridian.

27

of the several sections of T 31 N. R. 5 E. of the 3^d principal Meridian, as set down on this plat.
23007.68 acres


Surveyors Office
St. Louis, Mo.
Subscribed and sworn to
at St. Louis, Mo. this 1st day of
July 1854.
Sec. 6, the S.W. cor. of Sec. 13, the
W. cor. of Sec. 14, 30 and 31
and sent true copies of the
plat thereof to the Register
and another to the Commissioner.

Examined
17 June 1854

Surveyors Office
St. Louis July 1st 1854


The above Plat of Township N 31 North of the base line, Range 5 East
of the 3^d principal Meridian, is conformable to the field notes of the Survey thereof on file in this Office.

E. J. Conham

Justices on N 31 N
boundaries to the Cape
from old plat

Township 33 North of the base line, Range 5 East of the 3rd principal meridian.

29

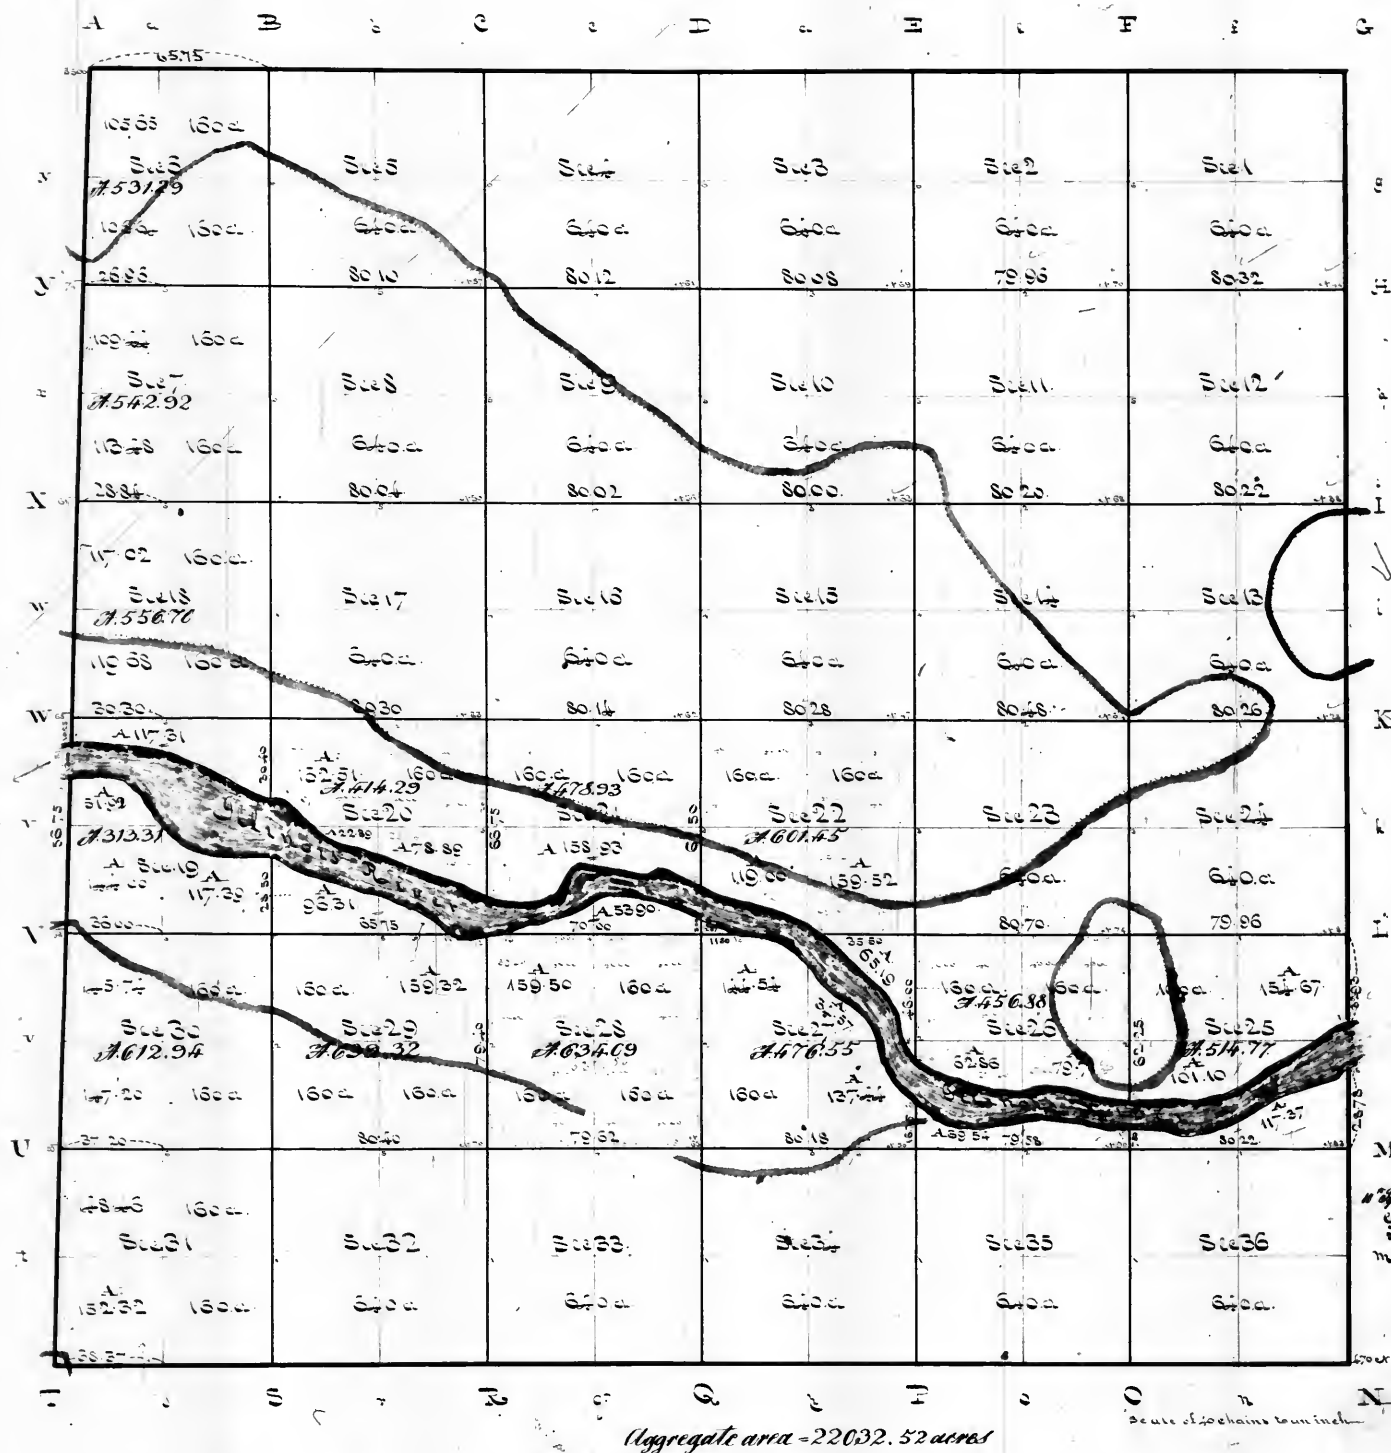

Surveyors Office
St. Louis July 1st 1834


The above Plat of Township 33 North of the base line, Range 5 East of the 3rd principal meridian, is conformable to the field notes of the Survey thereof on file in this Office.

E. J. Langham

Township N: 34 North of the base line, Range N: 5 East of the 3^d principal Meridian

[illegible]

Smith 496.

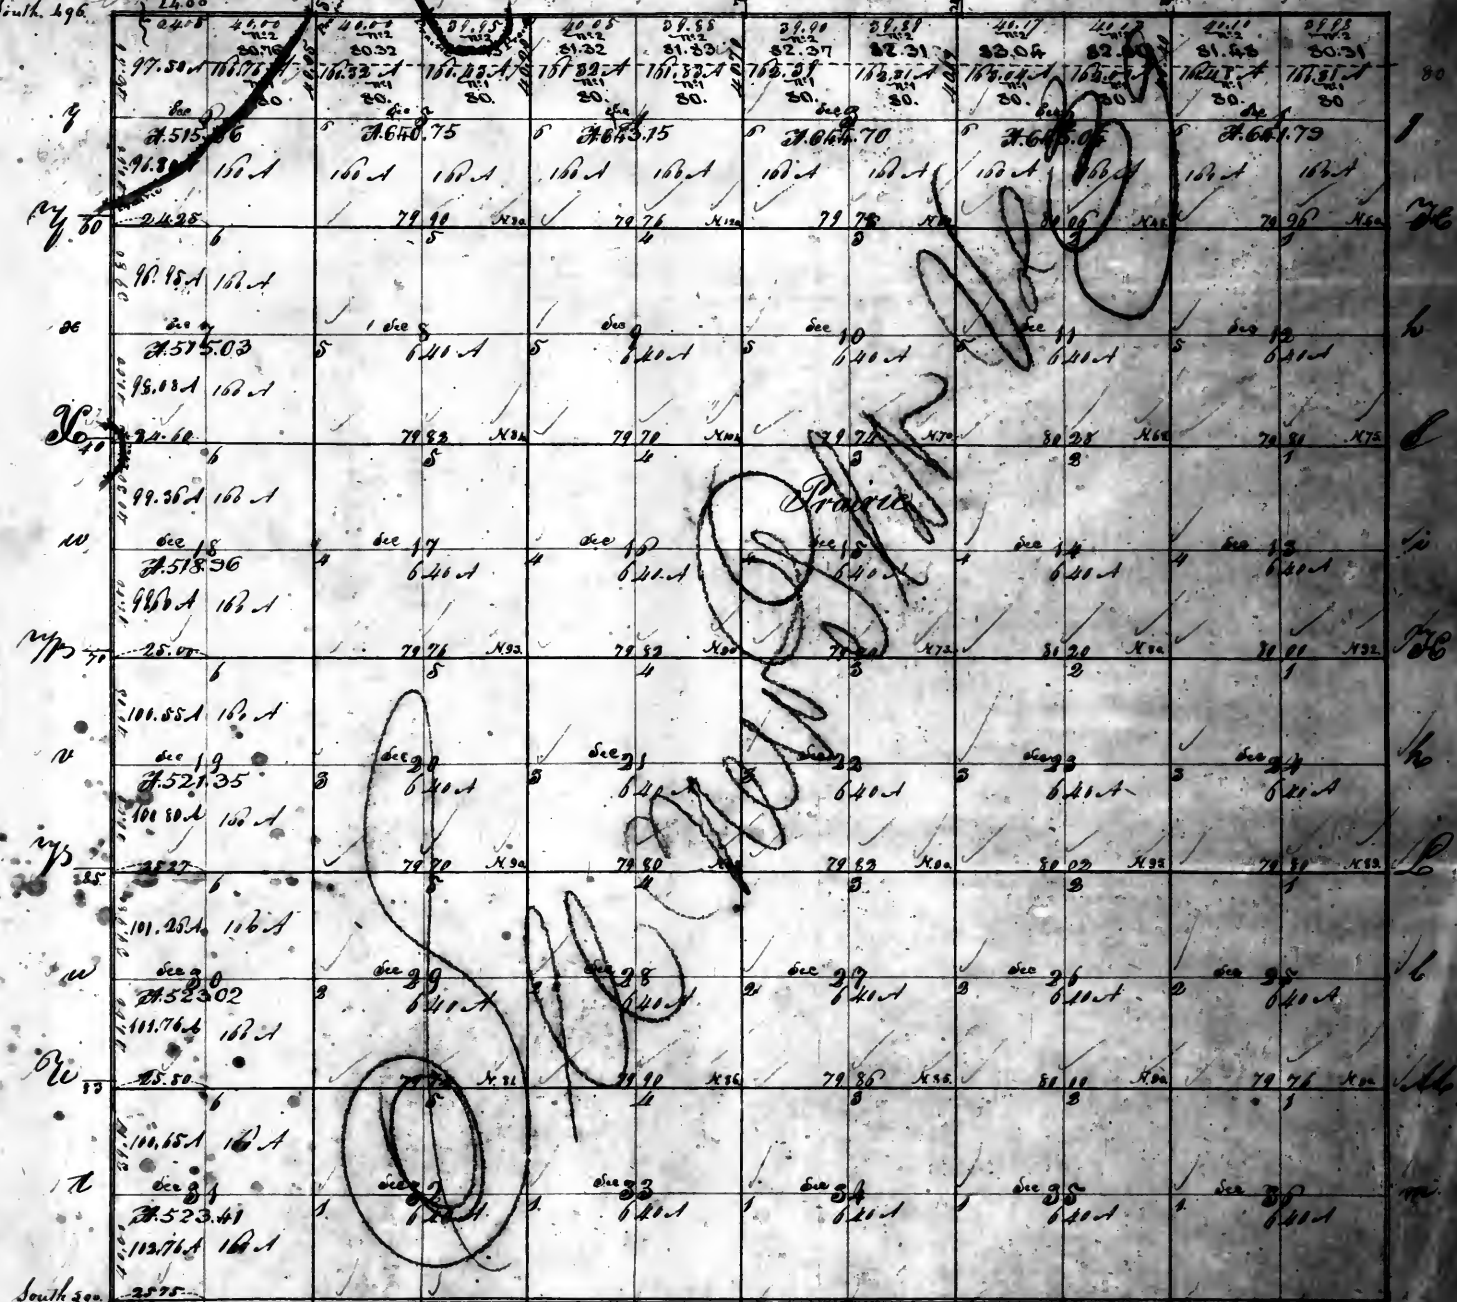

z s d n m q 2 p m o o n k


Substant to a contract with and instructions from William Hector, Surveyor of the lands of the United States in the States of Illinois and Missouri and Territory of Arkansas bearing date the Twentieth day of March One thousand Eight hundred and Twenty one I have examined laid out and surveyed the above described Township and do hereby Certify that it has such marks and bounds both Natural and Artificial as are represented on said plat and described in the field notes made thereof and returned with this plat into the Office of the Surveyor of the lands of the United States for the States of Illinois and Missouri and Territory of Arkansas

Surveyors Office
St Louis June 1834

The above Plat of Township 34 North of the Baseline, Range 5 East of the 3^d principal Meridian, is conformable to the field Notes of the Survey thereof on file in this office

Township 35 North of the base line, Range 5 East of the 3^d principal Meridian -
on the right or West side of Fox River also that part of said Township which lies East of Fox River and south of the Old Indian boundary line.

31

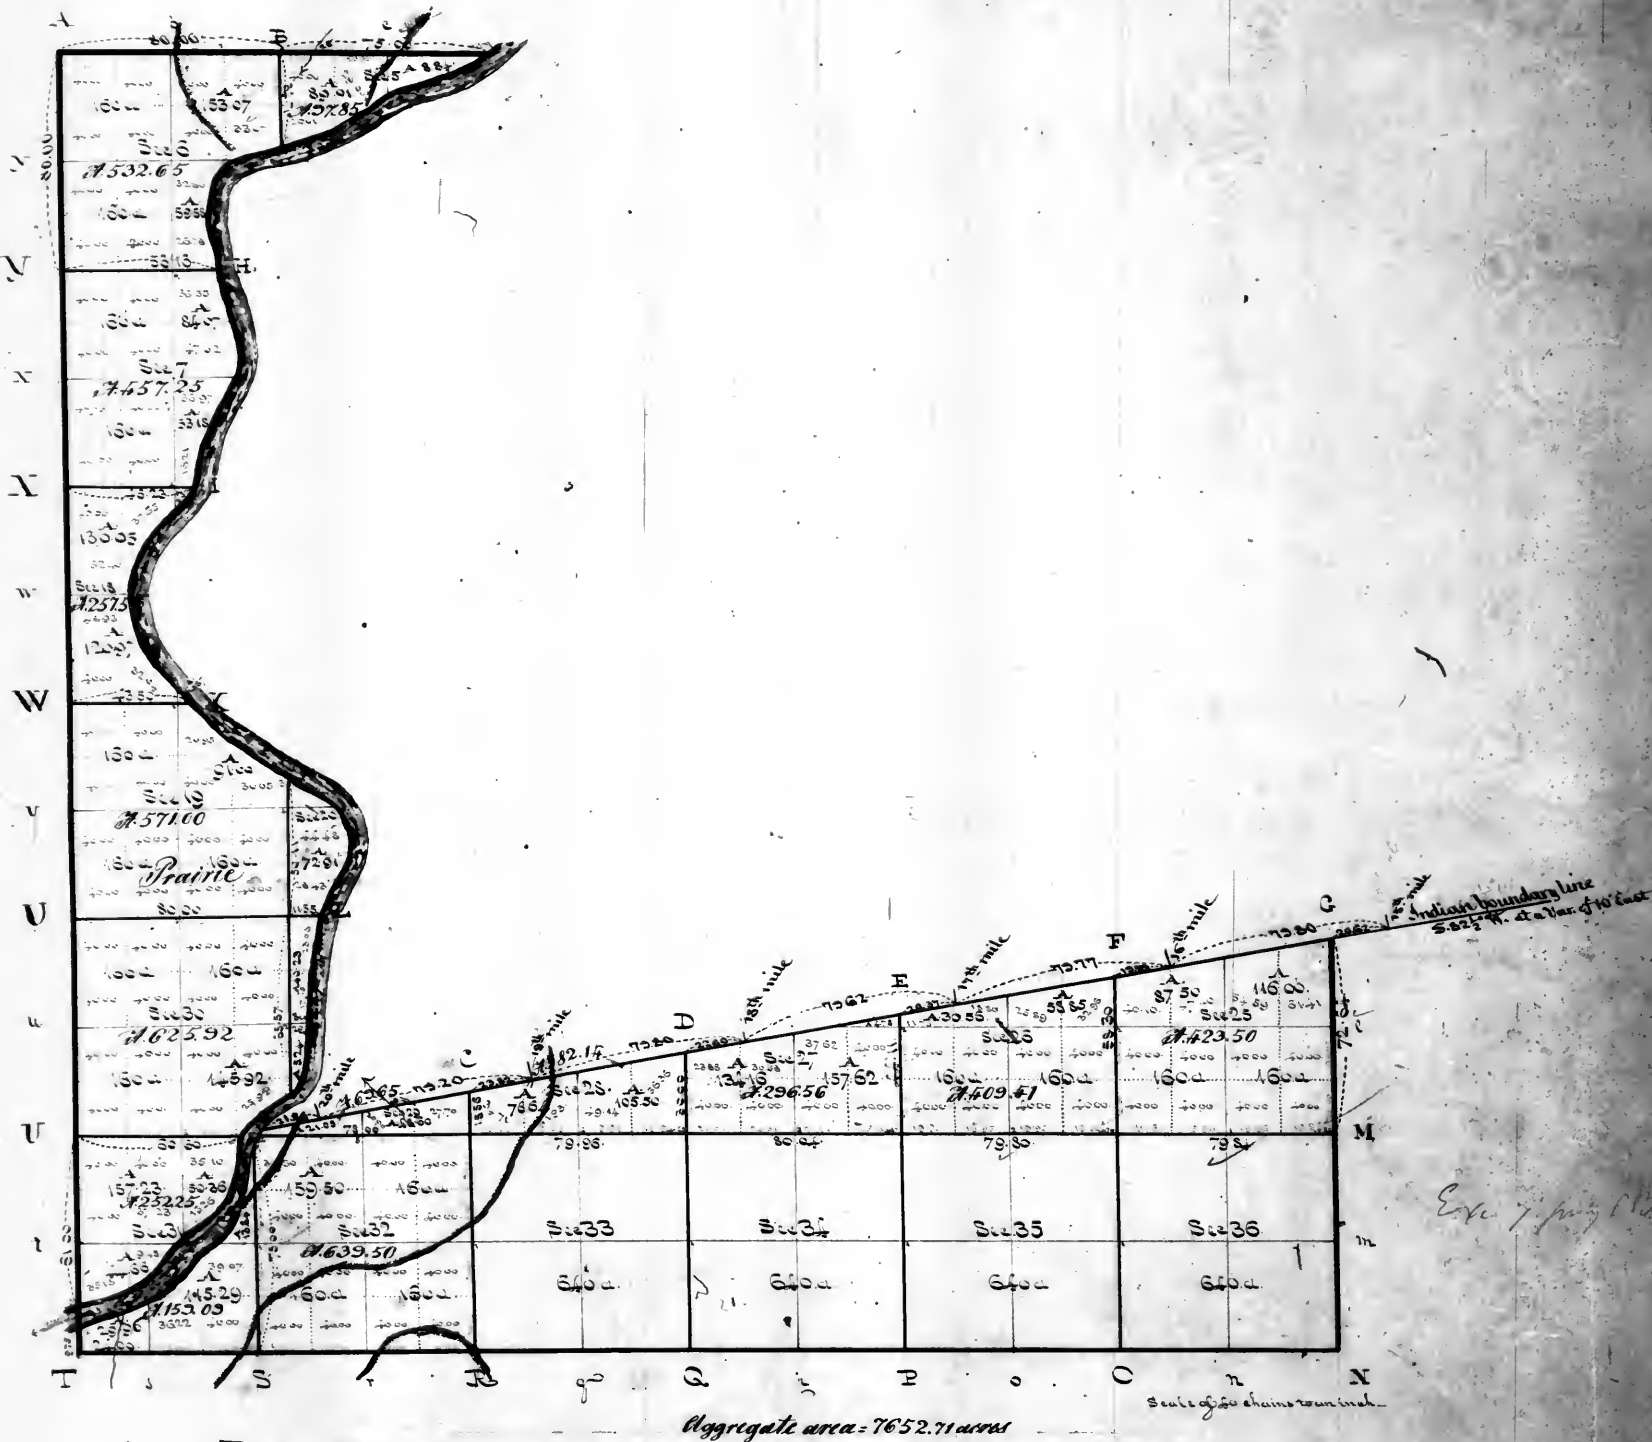


Surveyors Office
St. Louis July 27th 1834

The above fractional
Plat of Township 35 North of the base line, Range 5 East of the 3^d
principal Meridian, is conformable to the field notes of the survey thereof on file in this Office.

Ed. Langhorne

Fractional Township 35 North of the Base line in Range 5 East of the 3^d principal Meridian.

32

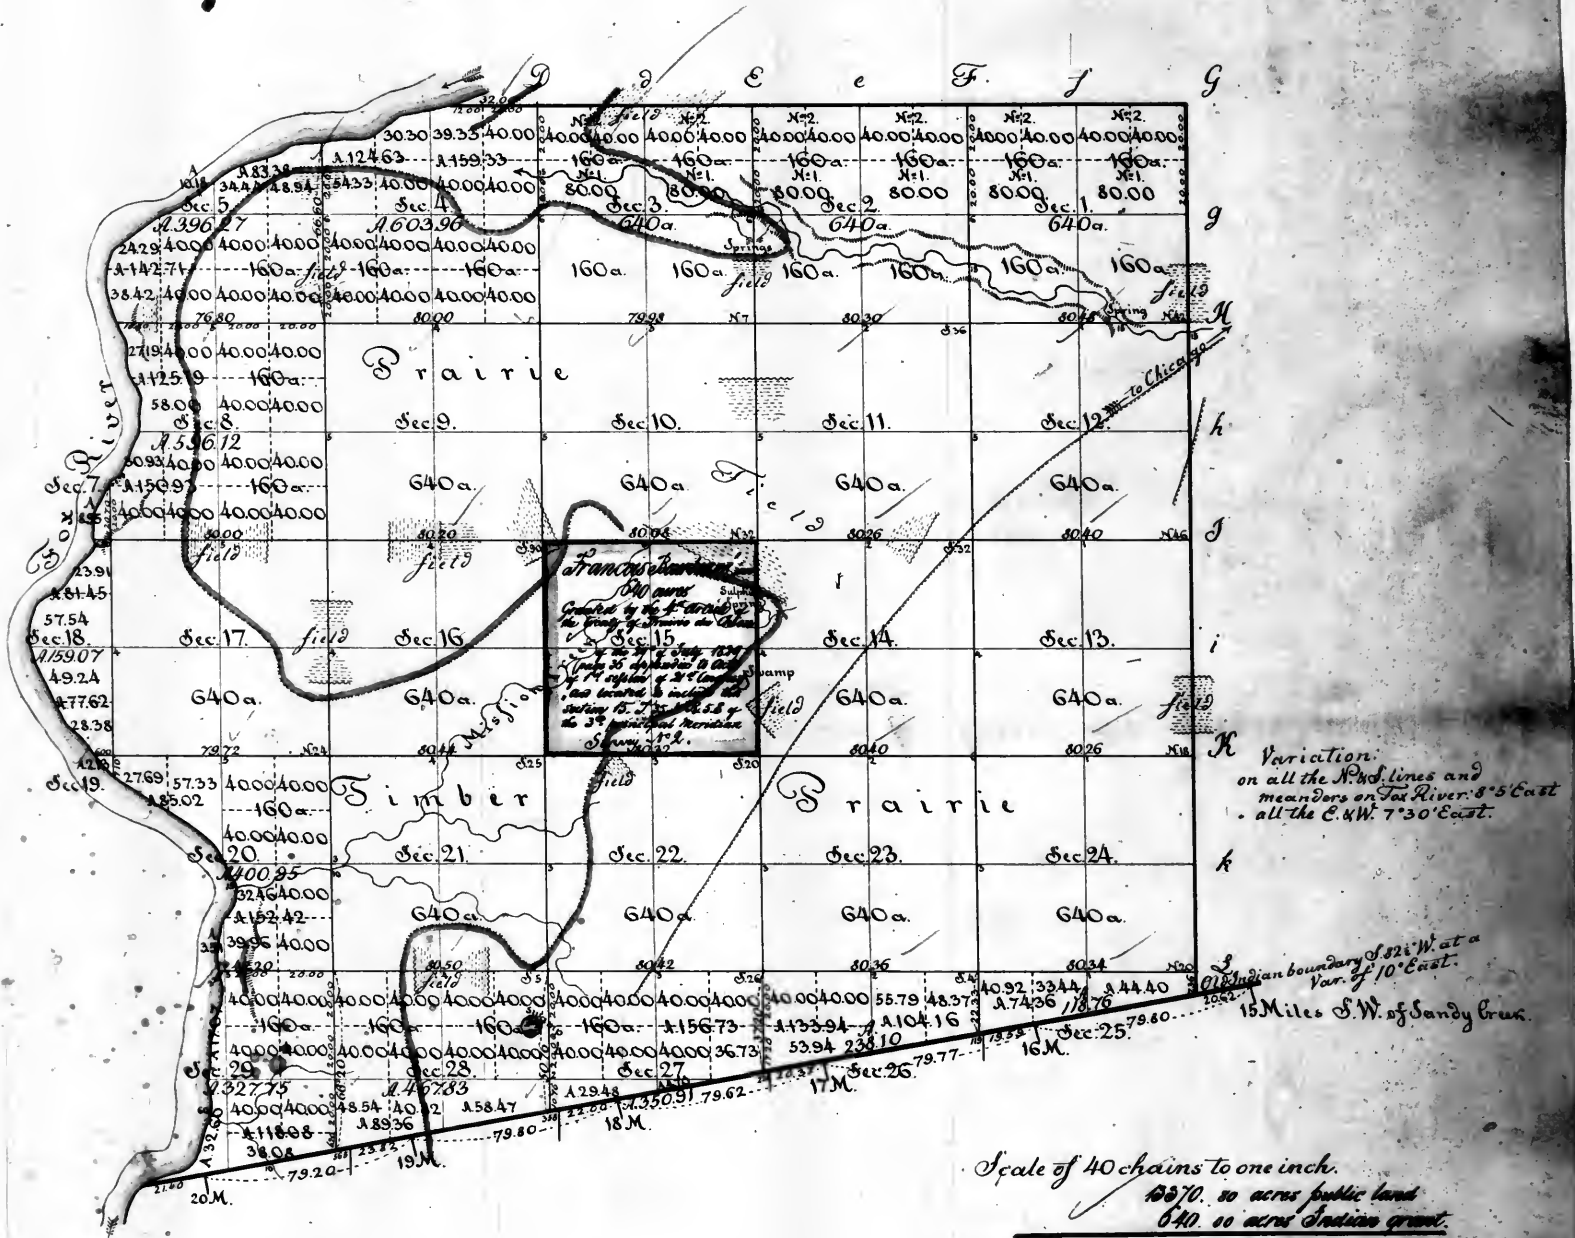


Surveyor's Office.
Saint Louis 21st of May 1839.

The above plat of fractional township 35 north of the base line, range 5 east of the 3^d principal meridian, north of the old indian boundary, east of Fox river is strictly conformable to the field notes of the survey thereof on file in this office, which have been examined and approved. — The Southern boundary which is designated 'the Indian boundary' was a survey in September 1821, in order to close the surveys to the South thereby, under the contract of Stephen Rector, and Thomas C. Rector, of the 20th of March 1821, and was intended as a survey of the indian boundary which could not be properly identified, that had been surveyed in the 4th quarter of 1818, by John C. Sullivan, assisted by James M. Duncan, from a point on Sandy creek 10 miles above its mouth S. 82° W. 28 miles and 66 chains to a point on Fox river 10 miles above its mouth, under a letter of appointment dated October 18th 1818 for running the line of the treaty of St. Louis of the 24th of August 1816, between the United States and the United Nations of Ottawas, Chippewas and Pottawatomies: — That part of said line which forms a boundary to this fractional township 4 miles 78.9 chains was resurveyed — and the east boundary of the township 8 miles 7.36 chains — the north boundary 2 miles and 38 chains were surveyed in the 4th quarter of 1837 — and the subdivision lines 39 miles 6.75 chains — and meanders of the left bank of Fox river, 6 miles 71.80 chains were surveyed in the 2^d quarter of 1838 — all by Eli S. Prescott, under contract signed by the Surveyor General on the 8th day of May, and by Prescott on the 3rd of June 1837: — They were paid for in the 4th quarter of 1838 — and charged on the account of the Surveyor General for that quarter — Voucher No. 5.

William Milburn
Surveyor General
O H

TOWNSHIP NO. 36 NORTH, RANGE NO. 5 EAST, THIRD PRINCIPAL MERIDIAN, ILLINOIS.

PLAT OF AN ISLAND IN FOX RIVER, SECTION 25.

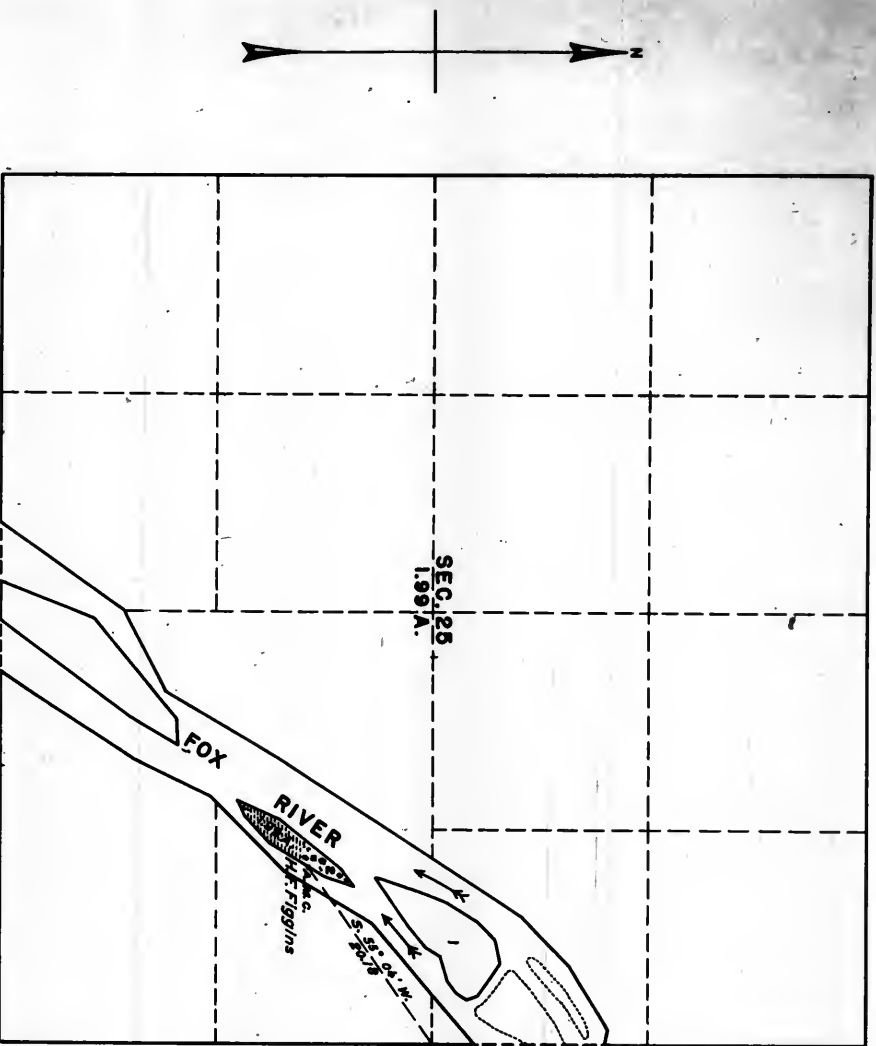

SCALE: 10 CHAINS TO AN INCH.

AREA SURVEYED, 1.99 ACRES.

| LINES DESIGNATED | BY WHOM SURVEYED | GROUP NO. | DATE | MILEAGE M.S. CHS. | WHEN SURVEYED BEGUN | COMPLETED |
|------------------|------------------|-----------|--------------|-------------------|---------------------|----------------|
| CONNECTION | HAL D. CRAIG, | 8 | MAY 3, 1938. | 0 20.18 | JUNE 11, 1938. | JUNE 11, 1938. |
| WEANDER | SURVEYOR. | | | 0 27.71 | 1938. | 1938. |

MEMORANDUM.

THIS PLAT REPRESENTS THE SURVEY OF AN ISLAND IN FOX RIVER IN SECTION 25, WHICH WAS NOT INCLUDED IN THE PRIOR OFFICIAL SURVEYS AS REPRESENTED ON THE PLATS APPROVED MAY 21, 1839, AND MARCH 9, 1936.

THE SURVEY WAS EXECUTED PURSUANT TO AUTHORITY CONTAINED IN GENERAL LAND OFFICE LETTER 1579506 "E" DATED JULY 16, 1937, WHICH BEARS DEPARTMENTAL APPROVAL UNDER DATE OF JULY 22, 1937.

OFFICE OF THE SUPERVISOR OF SURVEYS.
DENVER, COLORADO, JANUARY 31, 1939.
THE ABOVE PLAT OF AN ISLAND IN FOX RIVER, IN SECTION 25, TOWNSHIP NO. 36 NORTH, RANGE NO. 5 EAST, THIRD PRINCIPAL MERIDIAN, ILLINOIS, IS STRICTLY CONFORMABLE TO THE FIELD NOTES OF THE SURVEY THEREOF, WHICH HAVE BEEN EXAMINED AND APPROVED.

Wm. H. Brown
SUPERVISOR OF SURVEYS.


UNITED STATES
DEPARTMENT OF THE INTERIOR.
GENERAL LAND OFFICE.

WASHINGTON, D. C., MAY 9, 1939.
THE SURVEY REPRESENTED BY THIS PLAT, HAVING BEEN CORRECTLY EXECUTED IN ACCORDANCE WITH THE REQUIREMENTS OF LAW AND THE REGULATIONS OF THIS OFFICE, IS HEREBY ACCEPTED.

Paula M. Thompson
ASSISTANT COMMISSIONER.

Fractional Township 36 North of the Base line in Range 5 East of the 3^d principal Meridian.

33

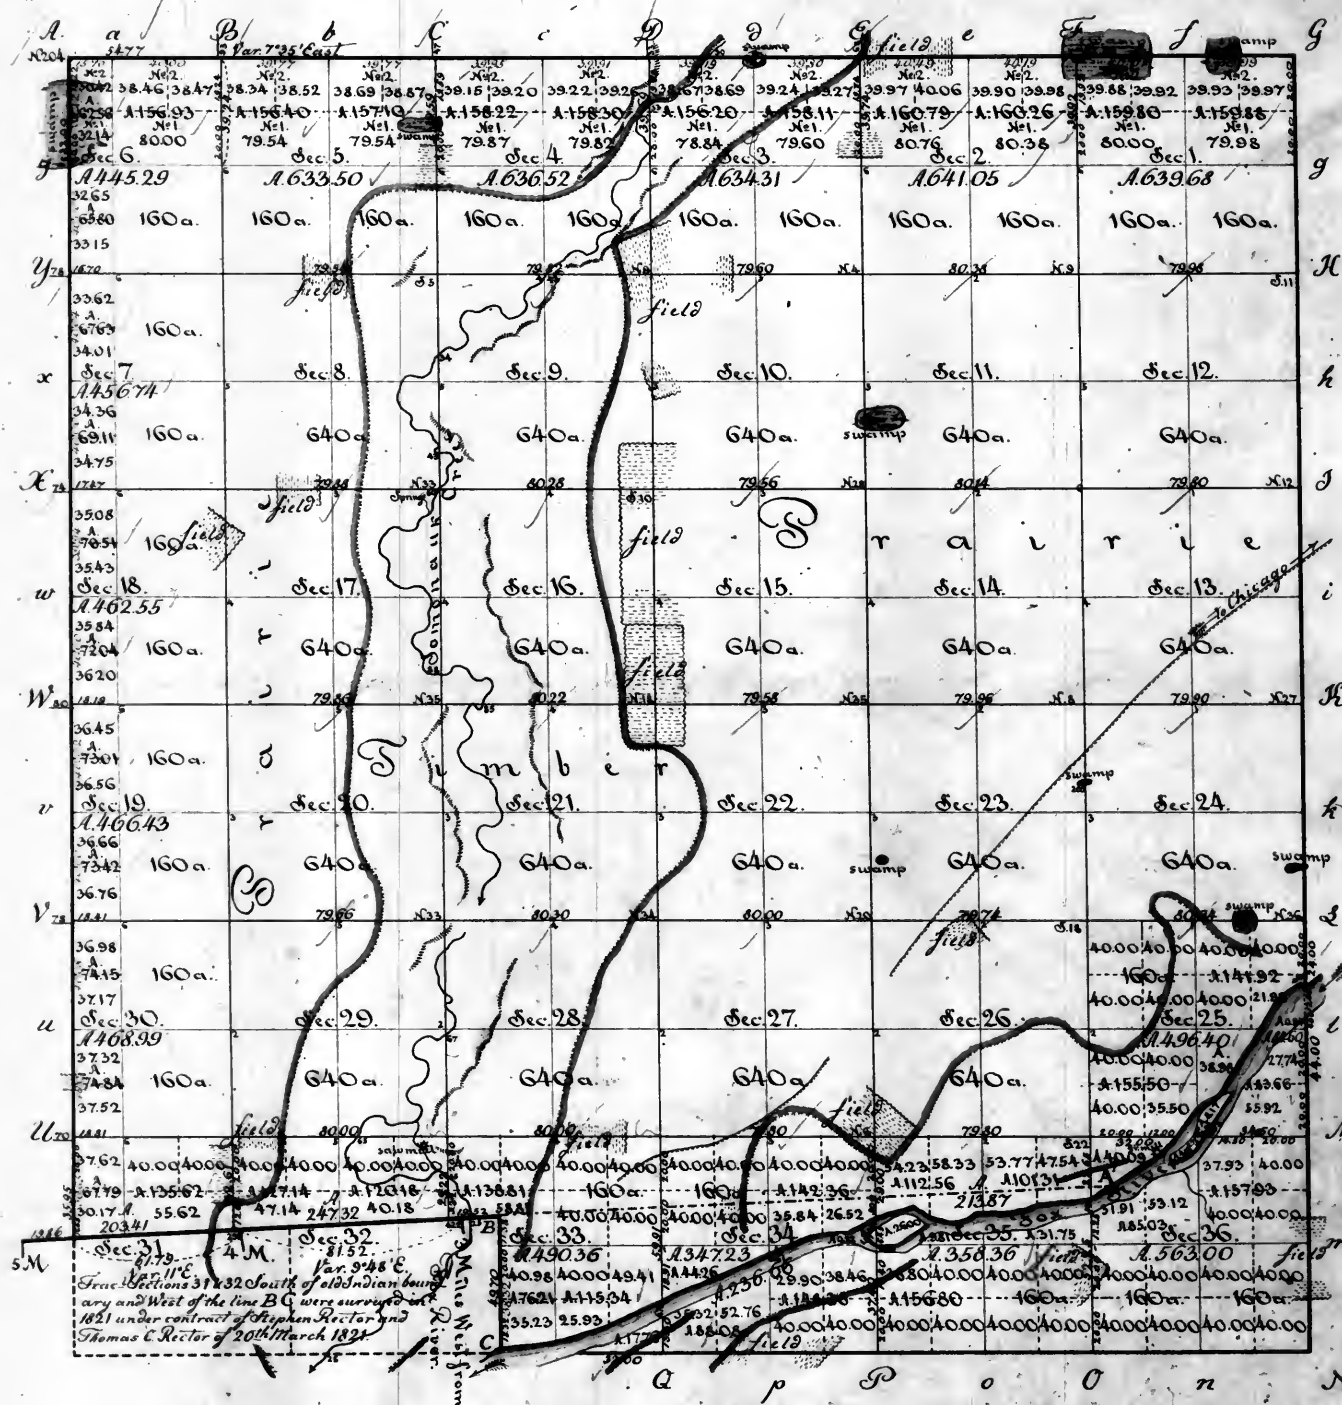

Scale of 40 chains to one inch.

Aggregate Area 21623.66 acres


Surveyors Office - Saint Louis 21st of May 1839.

The above plat of fractional township 36 north of the base line, range 5 East of the 3^d principal meridian, is strictly conformable to the field notes of the survey thereof on file in this office, which have been examined and approved. The old Indian boundary from the point on the west bank of Fox River due west of the southern extremity of Lake Michigan, was surveyed west to the Mississippi river in the first quarter of 1819 by John C. Sullivan assisted by James W. Duncan under a letter of appointment dated October 19th 1818 for running the line of the treaty of Saint Louis of the 26th of August 1816, between the United States and the United Nations of Ottawas, Chippewas and Potawatimias - That part of said boundary, which runs in part through and in part bounds this fractional township, being 4 miles 62.74 chains, was reserved for the purpose of conceal and identification; and the west boundary 5 miles 35.95 chains - the south boundary, east of Fox River 2 miles and 35 chains - the east boundary 6 miles - the north boundary 5 miles 57.77 chains were surveyed in the 4th quarter of 1827 - and the subdivision lines 37 miles 22.15 chains - and the meanders of Fox river on both banks and two islands 2 miles 65.06 chains were surveyed in the 2^d quarter of 1833 by E. S. Prescott, under contract signed by the Surveyor General on the 8th of May and by the said Prescott on the 3rd of June 1837. They were paid for in the 4th quarter of 1838, and charged in the accounts of the Surveyor General for that quarter under No. 5.

William Sullivan
Surveyor General
D 4

Township N:37 North of the Base line in Range N:5 East of the 3^d principal Meridian.

34

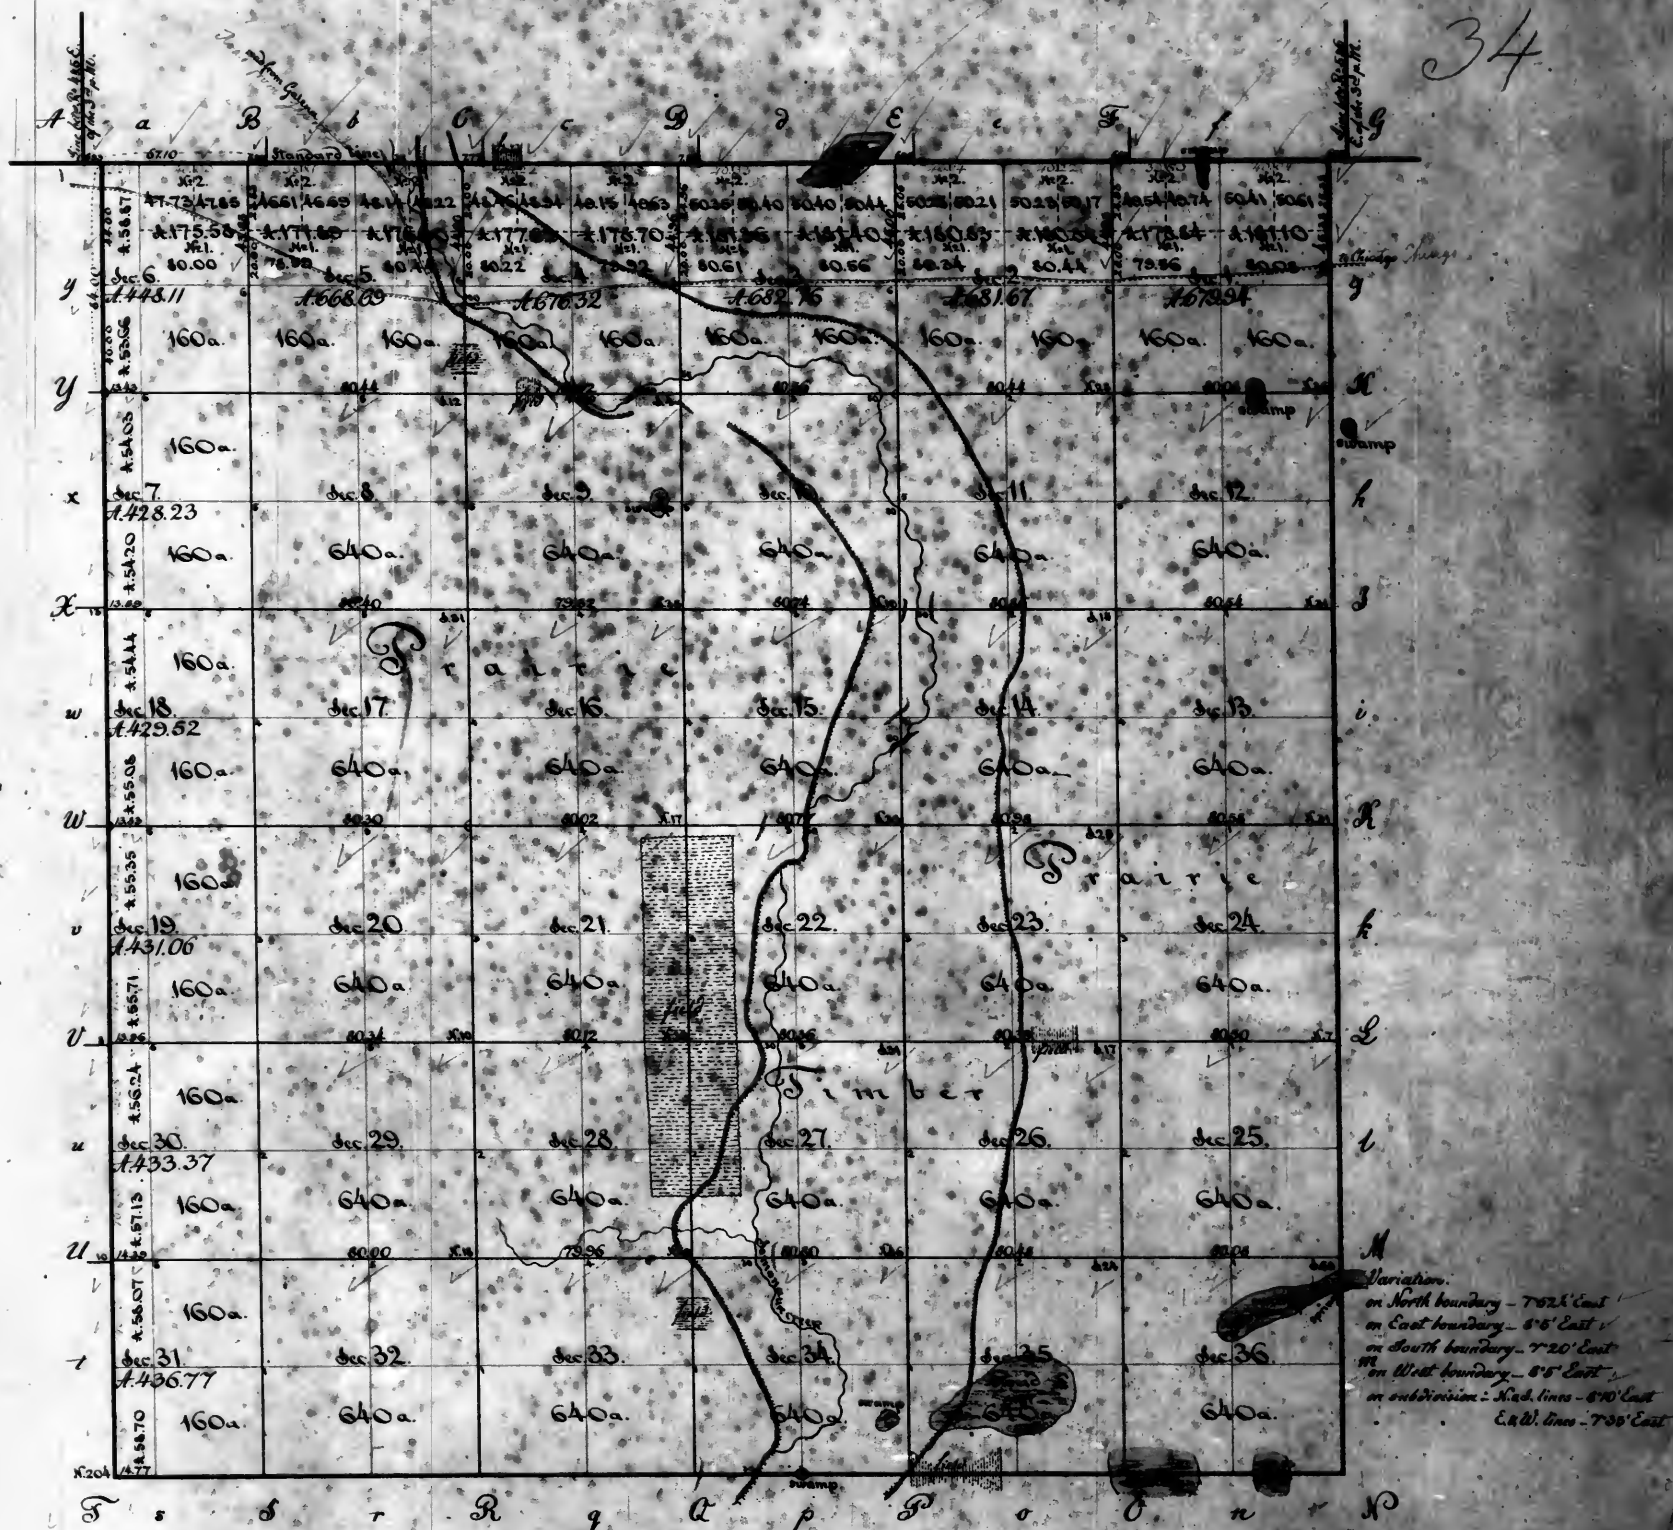

Scale of 40 chains to one inch.

Aggregate area 21996.42 acres.


Surveyor's Office. Saint Louis 28th of August 1842.

The above plat of township 37 north of the base line, range 5 east of the 3^d principal meridian is, strictly conformable to the field notes of the Survey thereof on file in this Office, which have been examined and approved. The South boundary 5 miles 54.77 chains—the east boundary 6 miles 5.33 chains—the north boundary 5 miles 53.19 chains—and the west boundary 6 miles and 4 chains, were all surveyed in the 4th quarter of 1837, by Eli S. Proctor, under a contract signed by the Surveyor General on the 8th of May 1837, and by M. Proctor on the 3rd of June following—They were paid for in the 4th quarter of 1838, and charged in the account current of the Surveyor General during the same quarter, Voucher N^o 5.—The subdivision lines, 57 miles 61.46 chains, were surveyed in the 3^d quarter of 1837, by James H. Rice, for Eli S. Proctor, without authority from, or a contract with, this office; but the field notes thereof have been received for examination upon their own merits, in virtue of the directions contained in the letter of the Commissioner of the general land office, to Surveyor General McIlhenny, dated 5th of June 1840; and Mr Rice's notes having been examined as aforesaid, and found correct;—and the Commissioner of the General Land Office, in his letter to Surveyor General Rice, dated 6th May 1842, having authorized him to pay therefore, the 57 miles 61.46 chains, more than they pay out of the general appropriation, and they will be charged in the account current of the Surveyor General, during this 3^d quarter of 1842, Voucher N^o— but for the plat of the Commissioner of the General Land Office of the 25th of July 1842, withholding the said payment for the same herein assigned, and should be not have upon Mr Rice's charge.

Silas Reed
Surveyor of the public lands in
the States of Illinois and Missouri.

Township 38 North of the base line Range 5 East of the Meridian

35

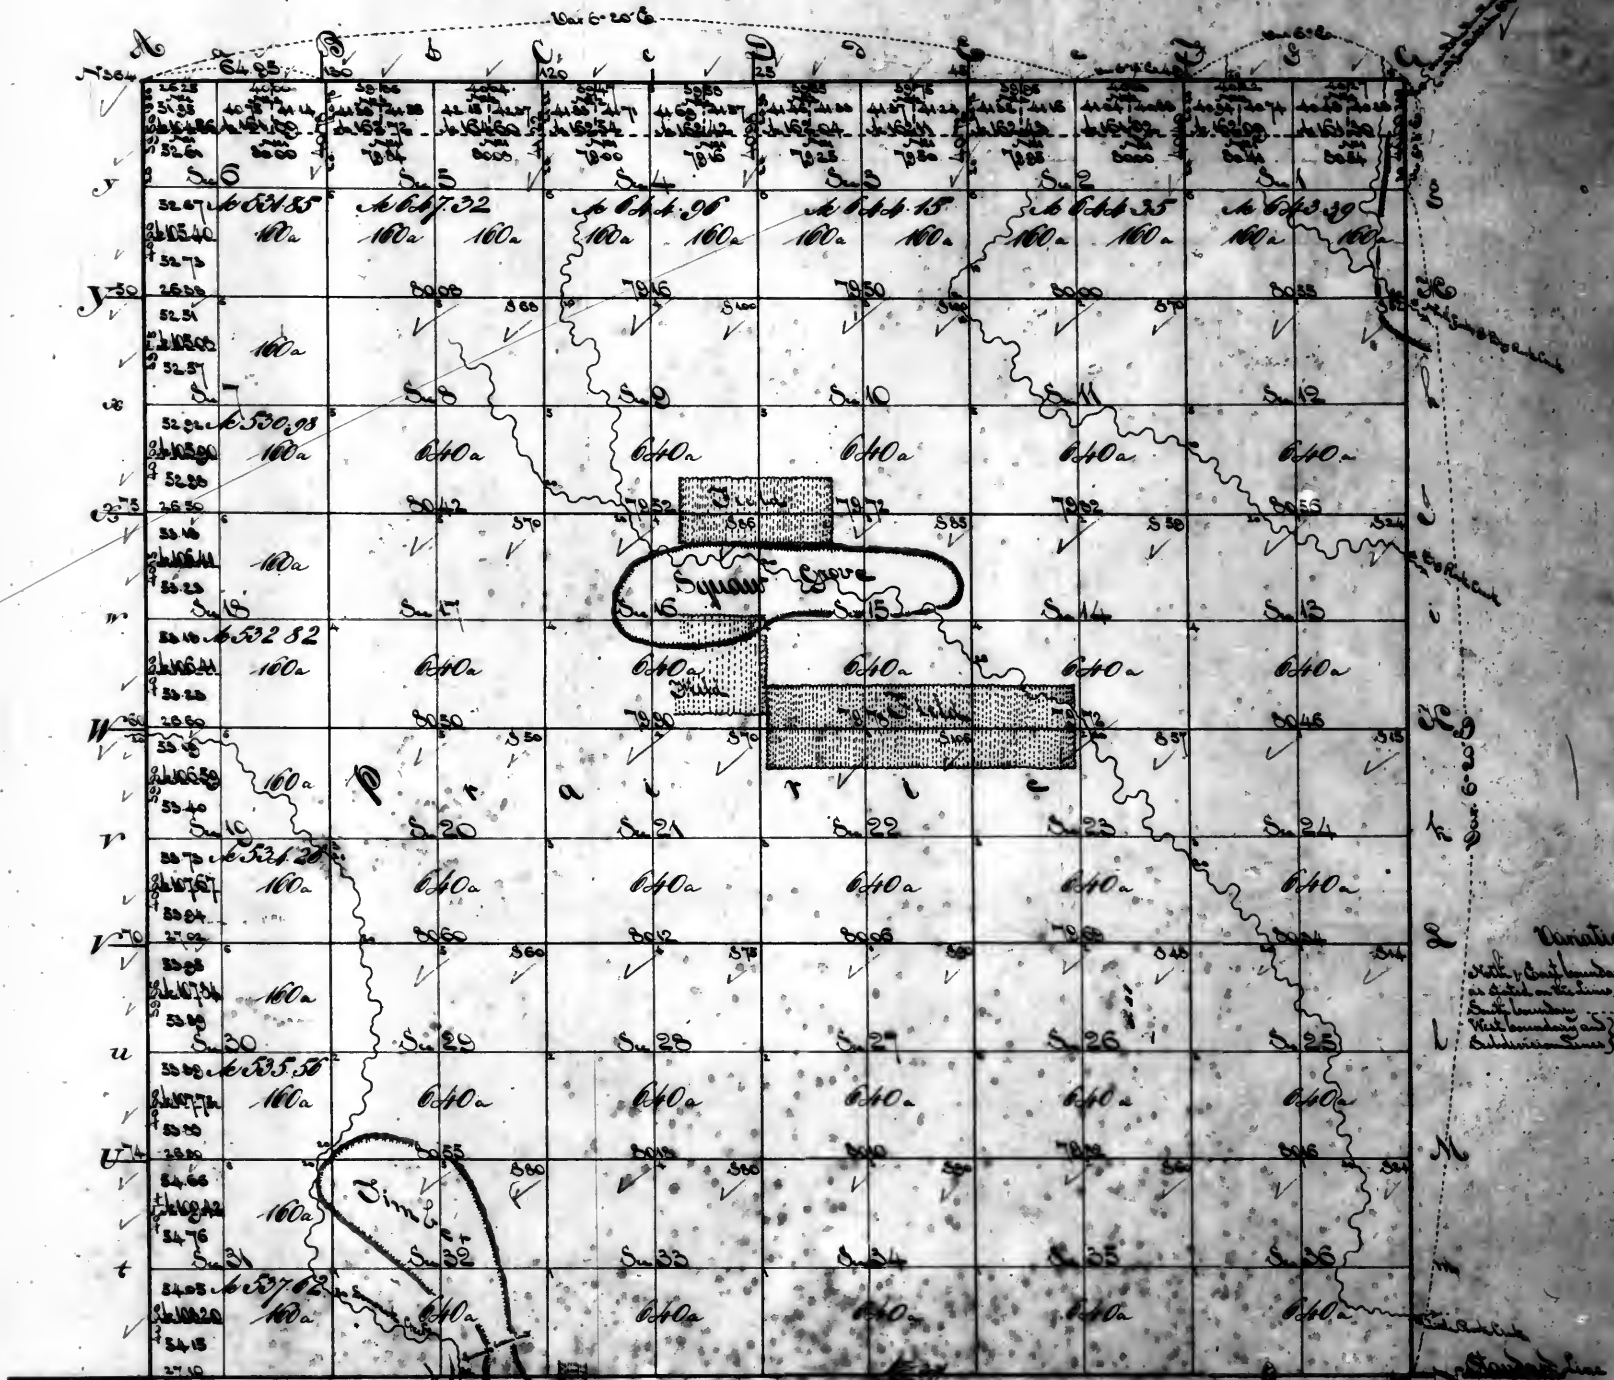

Double line
North & East boundary
as dated on the line
South boundary
West boundary and
Subdivision line


Surveyor's Office, Saint Louis 25th of August 1842.

The above plat of Township 38 north of the base line range 5 East of the 3rd principal meridian is strictly conformable to the field notes of the survey thereof on file in this office which have been examined and approved. The South boundary 5 miles 67.40 chains, was surveyed in the 4th quarter of 1837, by Eli S. Frost, under contract signed by the Surveyor General on the 8th of May, and by Frost on the 3rd of June 1837:— it was paid for in the 4th quarter of 1838 and charged in the account current of the Surveyor General during that quarter, Voucher N. 5. The west boundary 6 miles—the east boundary 6 miles—and the north boundary 5 miles 64.95 chains, were surveyed by James Thompson and John P. Thompson, under their joint contract of the 21st of September 1839:— They were paid for in the 3rd quarter of 1840, and charged in the account current of the Surveyor General during the same quarter, Voucher N. 11. The subdivision lines 53 miles 18.41 chains were surveyed in the 4th quarter of 1840, by James Thompson and John P. Thompson under their joint contract of the 18th of September 1840. They were paid for in the 3rd quarter of 1842, and charged in the account current of the Surveyor General during the said 3rd quarter, Voucher N. 7.

Silas Reed
Surveyor of the public lands in
the State of Missouri

Township 39 North of base Range 5 East of 4th principal Meridian

36

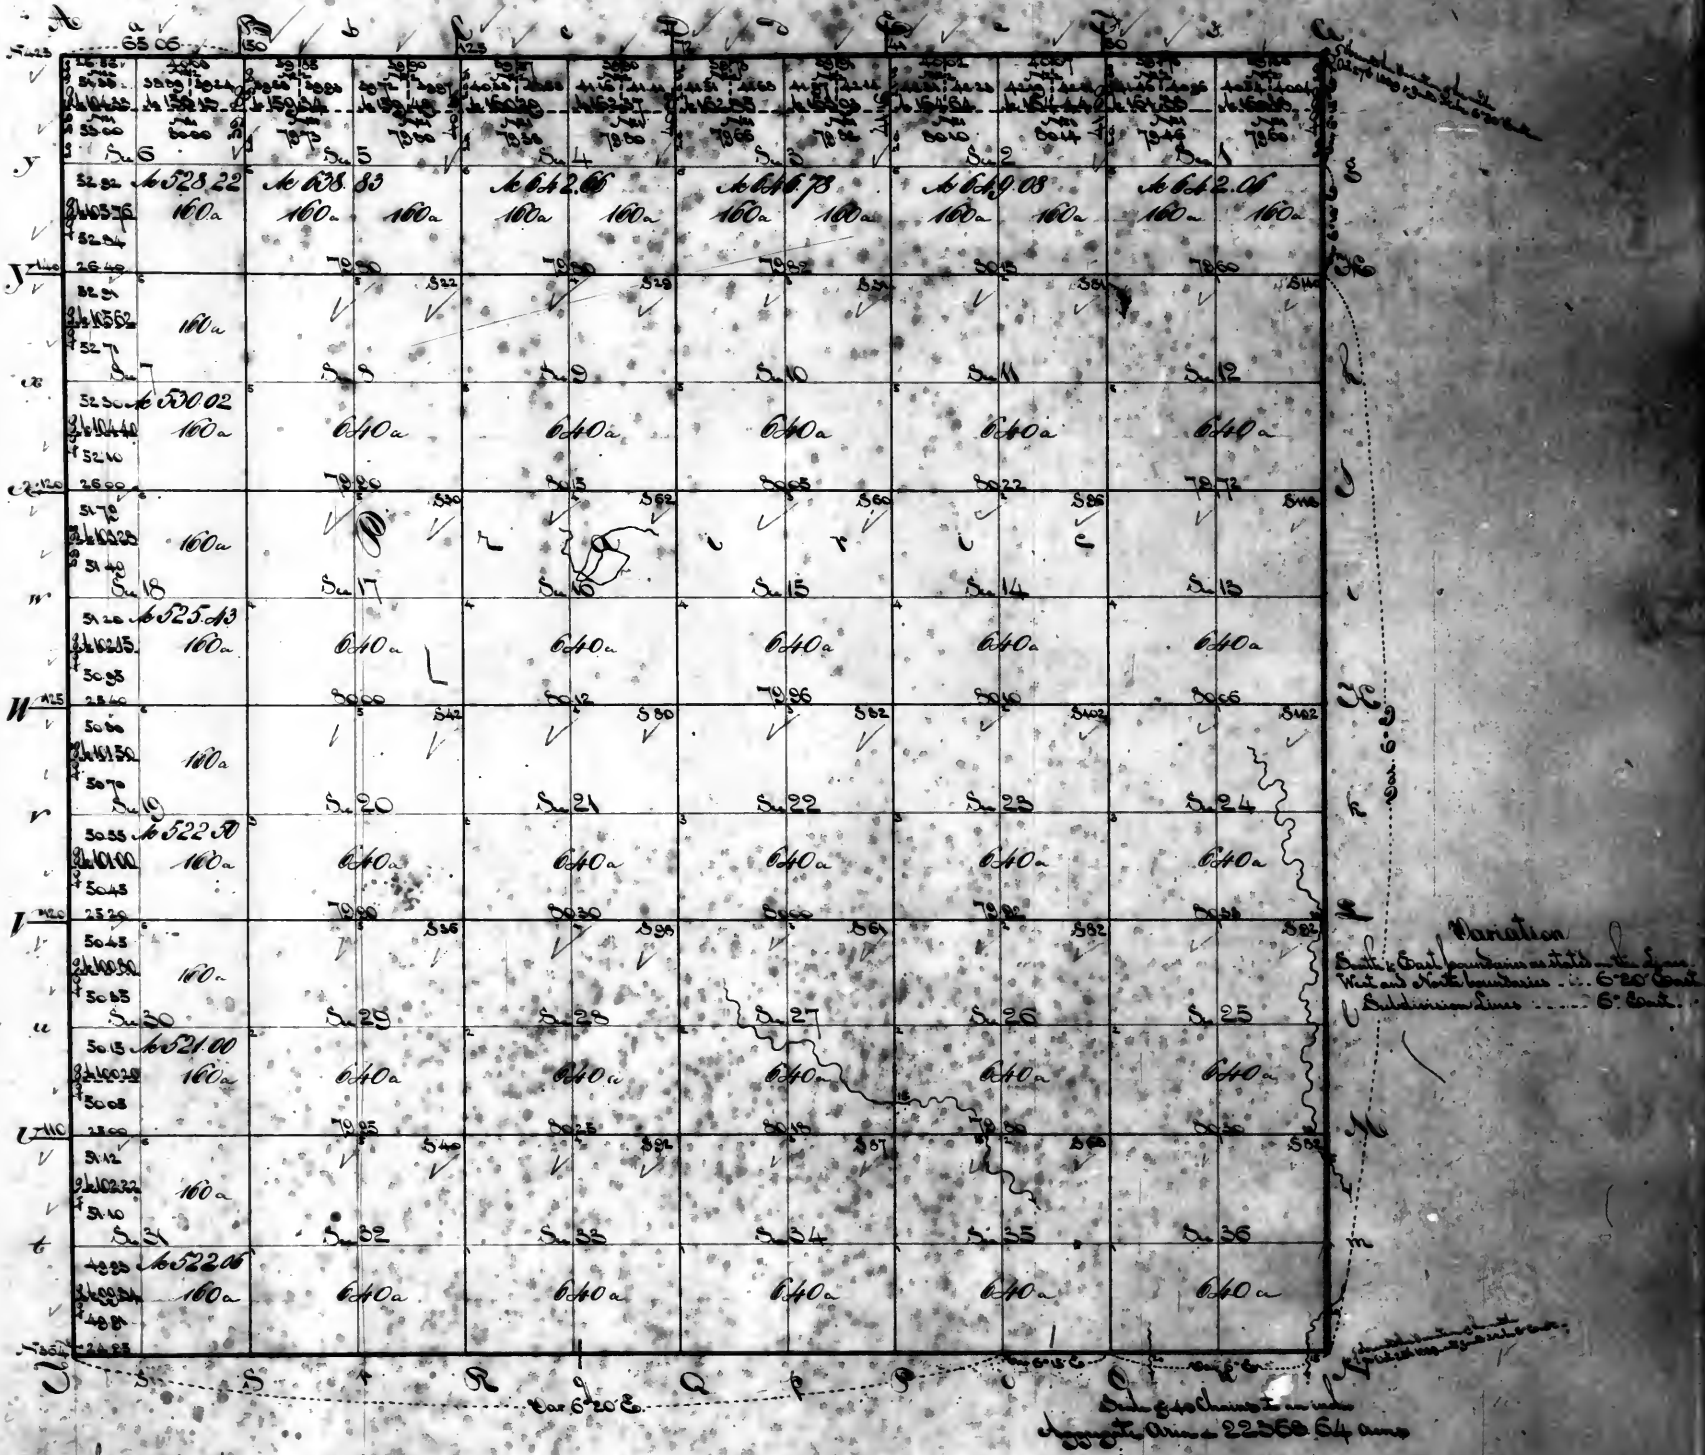





Silas Keedy

Surveyor of the public lands
in the State of Missouri.

Township 40 North Range 5 East of 3rd principal Meridian

37

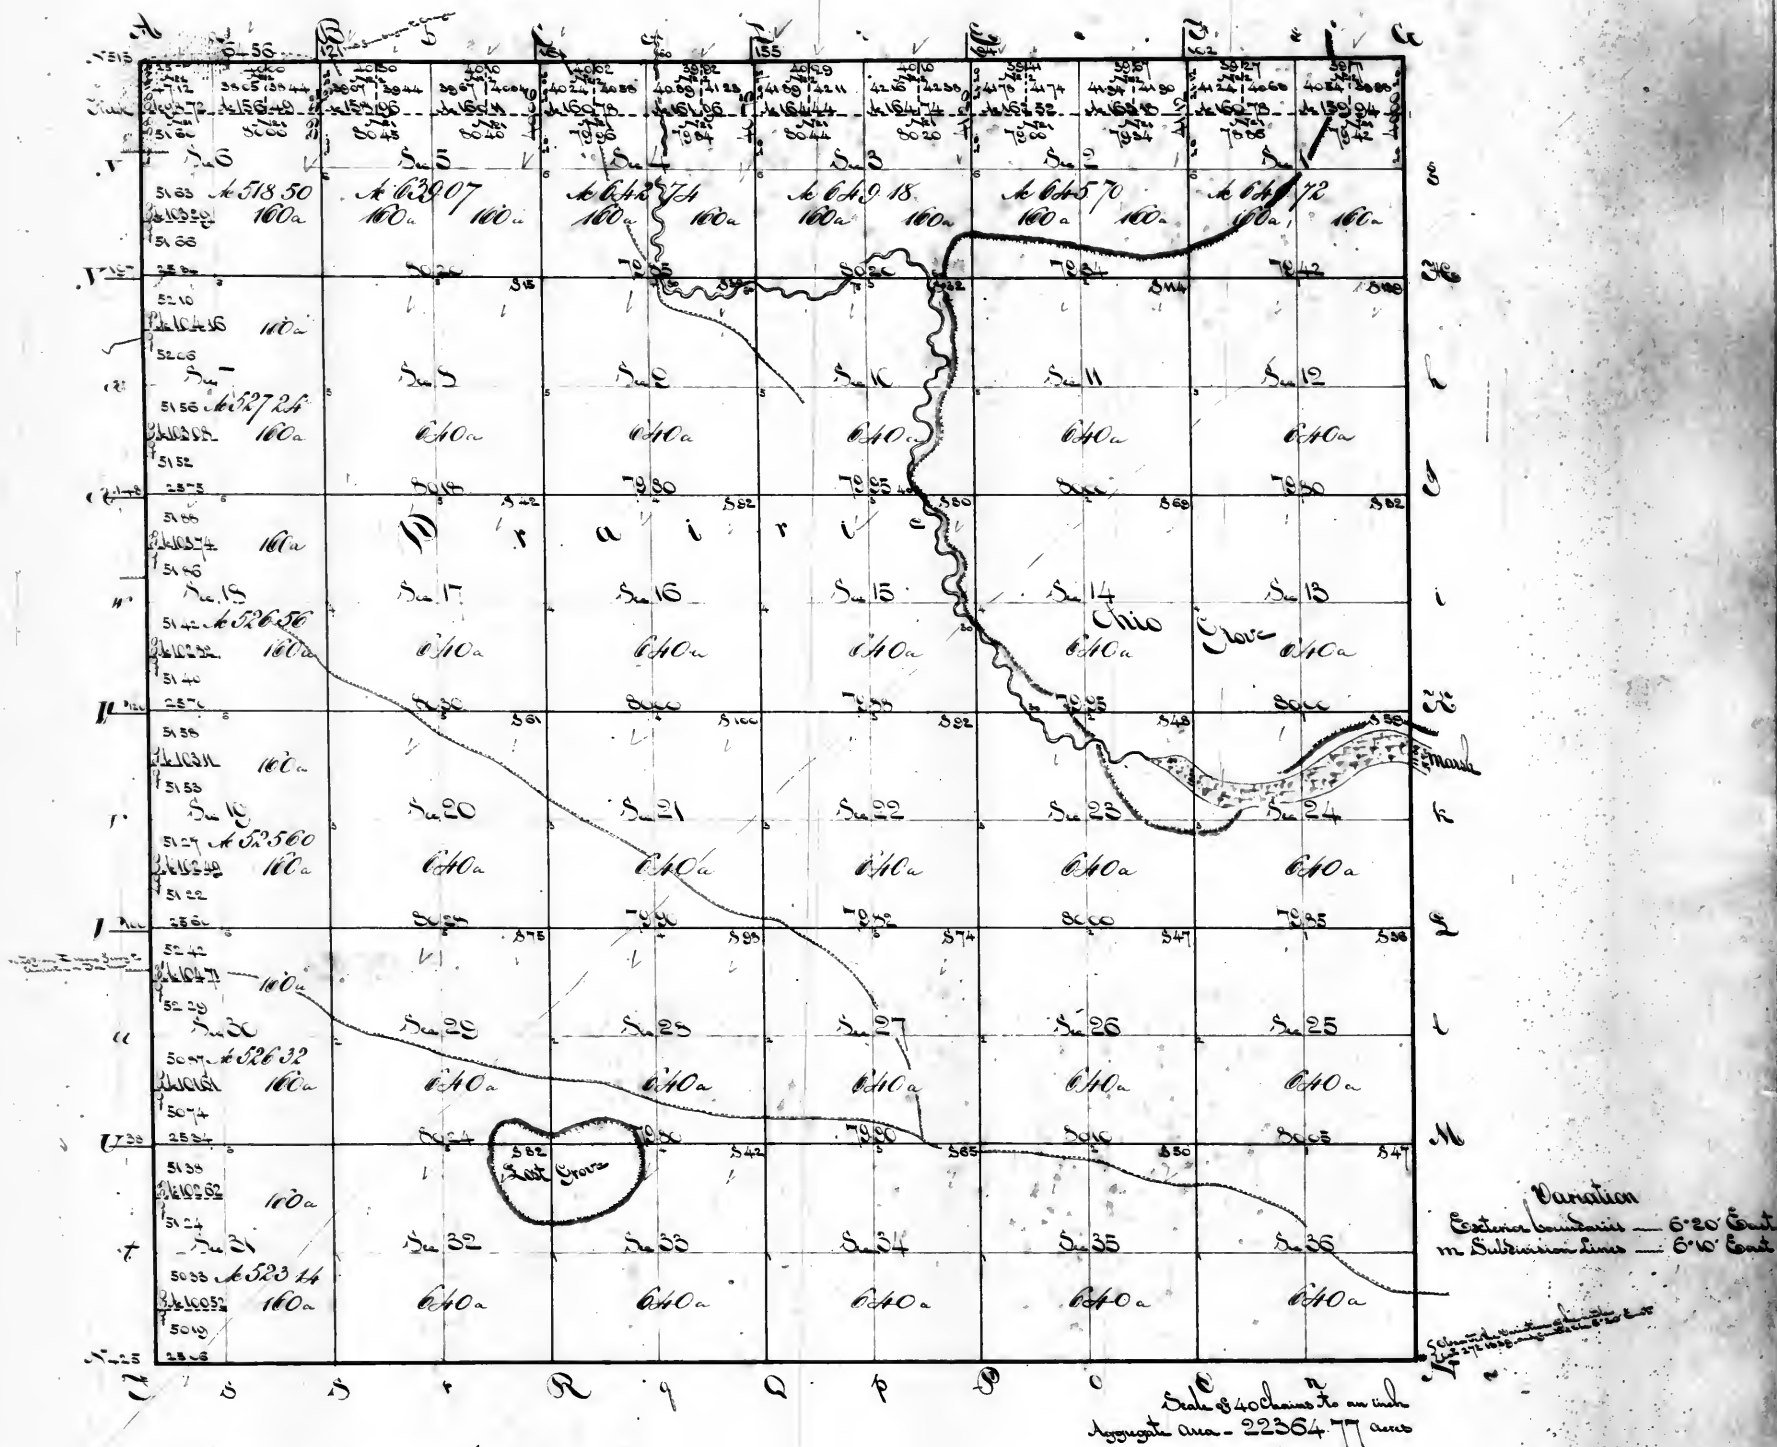


Surveyors Office. Saint Louis 25th of August 1842.

The above plat of township 40 north of the base line range 5 east of the 3rd principal meridian is strictly conformable to the field notes of the survey thereof on file in this Office which have been examined and approved. The south boundary 5 miles 35.06 chains - the east boundary 6 miles - the north boundary 5 miles 64.58 chains and the west boundary 6 miles, were surveyed in the 4th quarter of 1839, by James Thompson and John P. Thompson, under their joint contract of the 21st of September 1839. They were paid for in the 3rd quarter of 1840, and charged in the account current of the Surveyor General during the same quarter - Voucher No. 17 - The subdivision lines 59 miles 9.42 chains, were surveyed in the 4th quarter of 1840, by James Thompson and John P. Thompson, under their joint contract of the 18th of September of the same year - They were paid for in the 3rd quarter of 1842, and charged in the account of the Surveyor General during the said 3rd quarter, Voucher No. 7.

Silas Reede
Surveyor of the public lands in
the States of Illinois & Missouri

Township 41 North of the base line Range 5 East of the 3d principal Meridian.

38

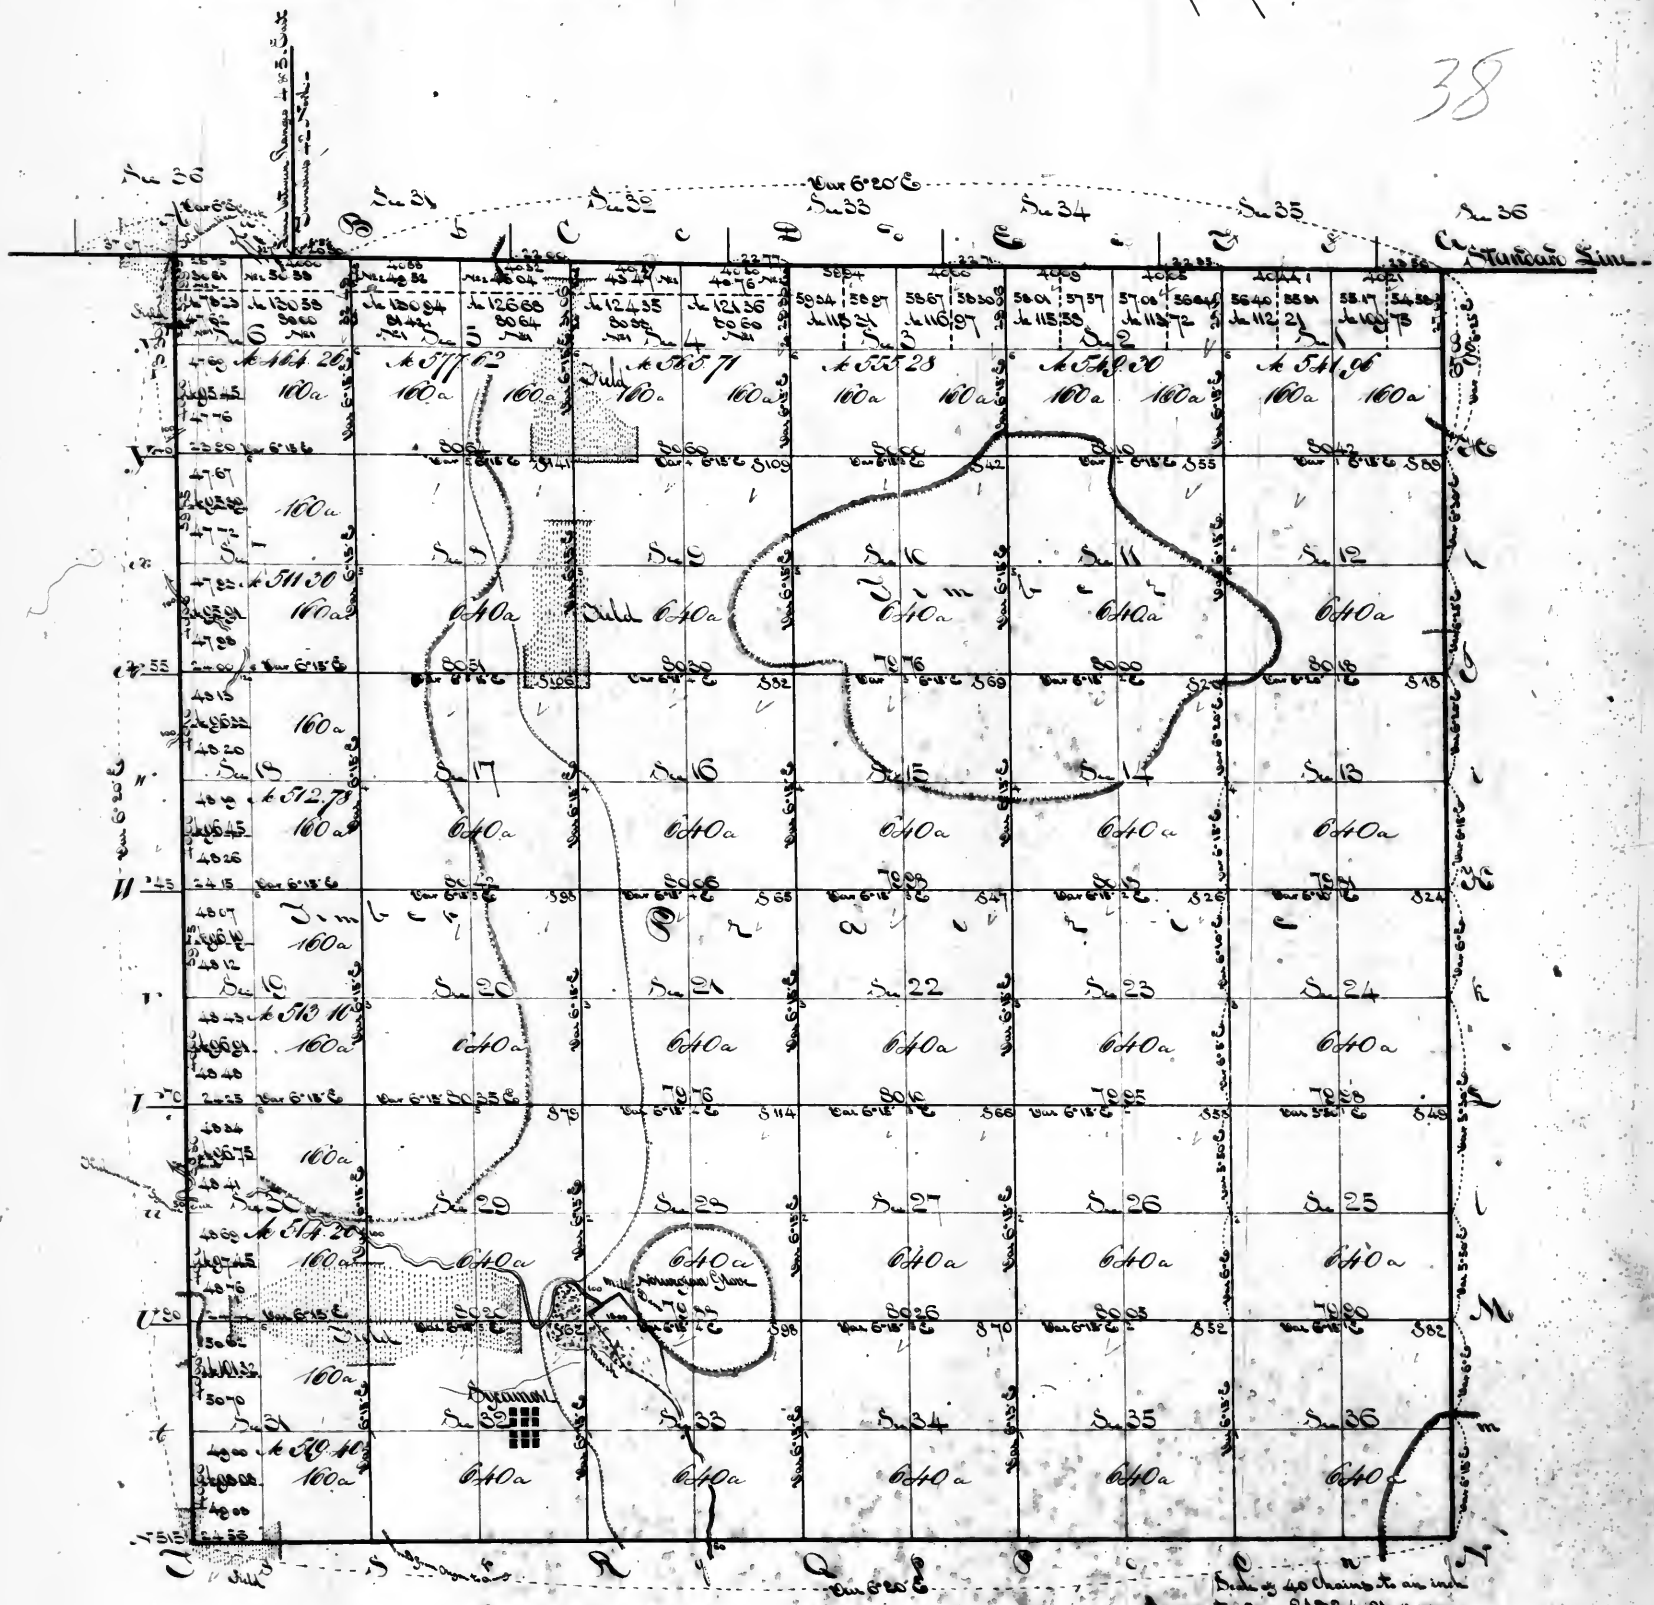


Surveyors Office. Saint Louis 25th of August 1842.

The above plat of township 41 north of the base line, range 5 east of the 3d principal meridian is strictly conformable to the field notes of the survey thereof on file in this office which have been examined and approved. The north boundary 5 miles 66.45 chains, was surveyed in the 2d quarter of 1827, by Squier Sprigg, under contract signed by the Surveyor General on the 21st of November and by Sprigg on the 15th of December 1826 - it was paid for in the 1st quarter of 1829, and charged in the account current of the Surveyor General during the same quarter, Voucher No. 2. The east boundary 5 miles 67 chains - the south boundary 5 miles 62.56 chains - and the west boundary 5 miles 73.33 chains, were surveyed in the 4th quarter of 1829, by James Thompson and John P. Thompson, under their joint contract of the 21st of September 1829. They were paid for in the 3d quarter of 1840, and charged in the account current of the Surveyor General during the same quarter, Voucher No. 17. The subdivision lines 50 miles 24.77 chains, were surveyed in the 4th quarter of 1829, by James Thompson and John P. Thompson, under their joint contract of the 18th of September 1829. They were paid for in the 3d quarter of 1842, and charged in the account current of the Surveyor General, during the same quarter, Voucher No. 7.

Silas Reed

Surveyor of the public lands in
the State of Illinois & Missouri.

Township N^o 42 North of the Base line in Range N^o 5 East of the 3^d principal Meridian.

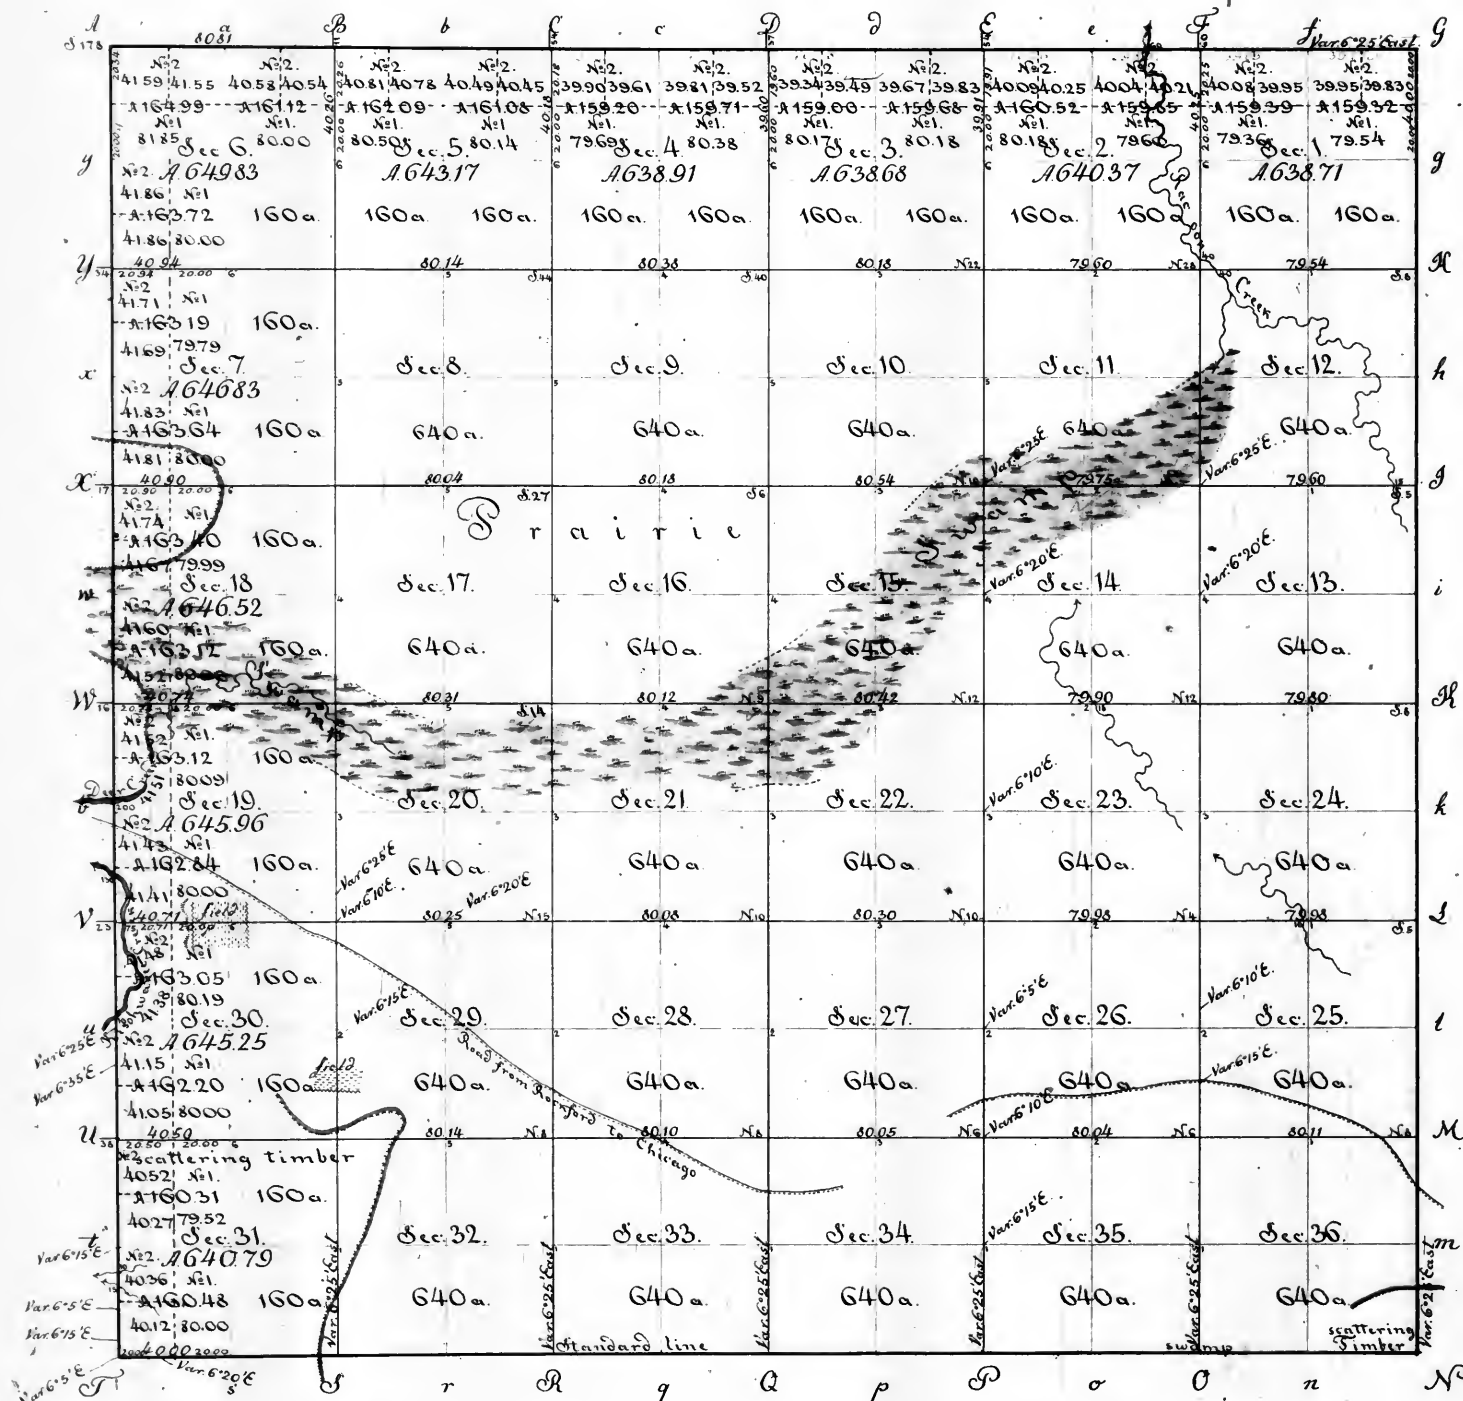

Surveyor General's Office.
Saint Louis 22^d July 1839.


Scale of 40 chains to one inch.
Aggregate area 23075.02 acres.

The above plat of Township 42 north of the base line, range 5 east of the 3^d principal meridian, is strictly conformable to the field notes of the survey thereof on file in this office, which have been examined and approved. The west, south and east boundaries, 6 miles each were surveyed in the 2^d quarter of 1837; the North boundary 6 miles and 81 links was surveyed in the 3^d quarter of 1837; and the subdivision lines 58 miles 5.17 chains + 1 mile and 31 links + 1 mile and 4 links = 60 miles. 5.52 chains were surveyed in the 3^d quarter of 1837, and 2^d quarter of 1839, all by Ignatius J. Sprigg, under contract signed by the Surveyor General on the 21st of November 1836, and by Sprigg on the 15th day of December of the same year. They were paid for in the 1st and 2^d quarters of 1839, and charges in the accounts of the Surveyors General for those quarters. Vouchers N^o 2 & 3.

William Milburn
Surveyor General

Township N. 43 North of the Base line in Range N. 5 East of the 3^d principal Meridian.

40

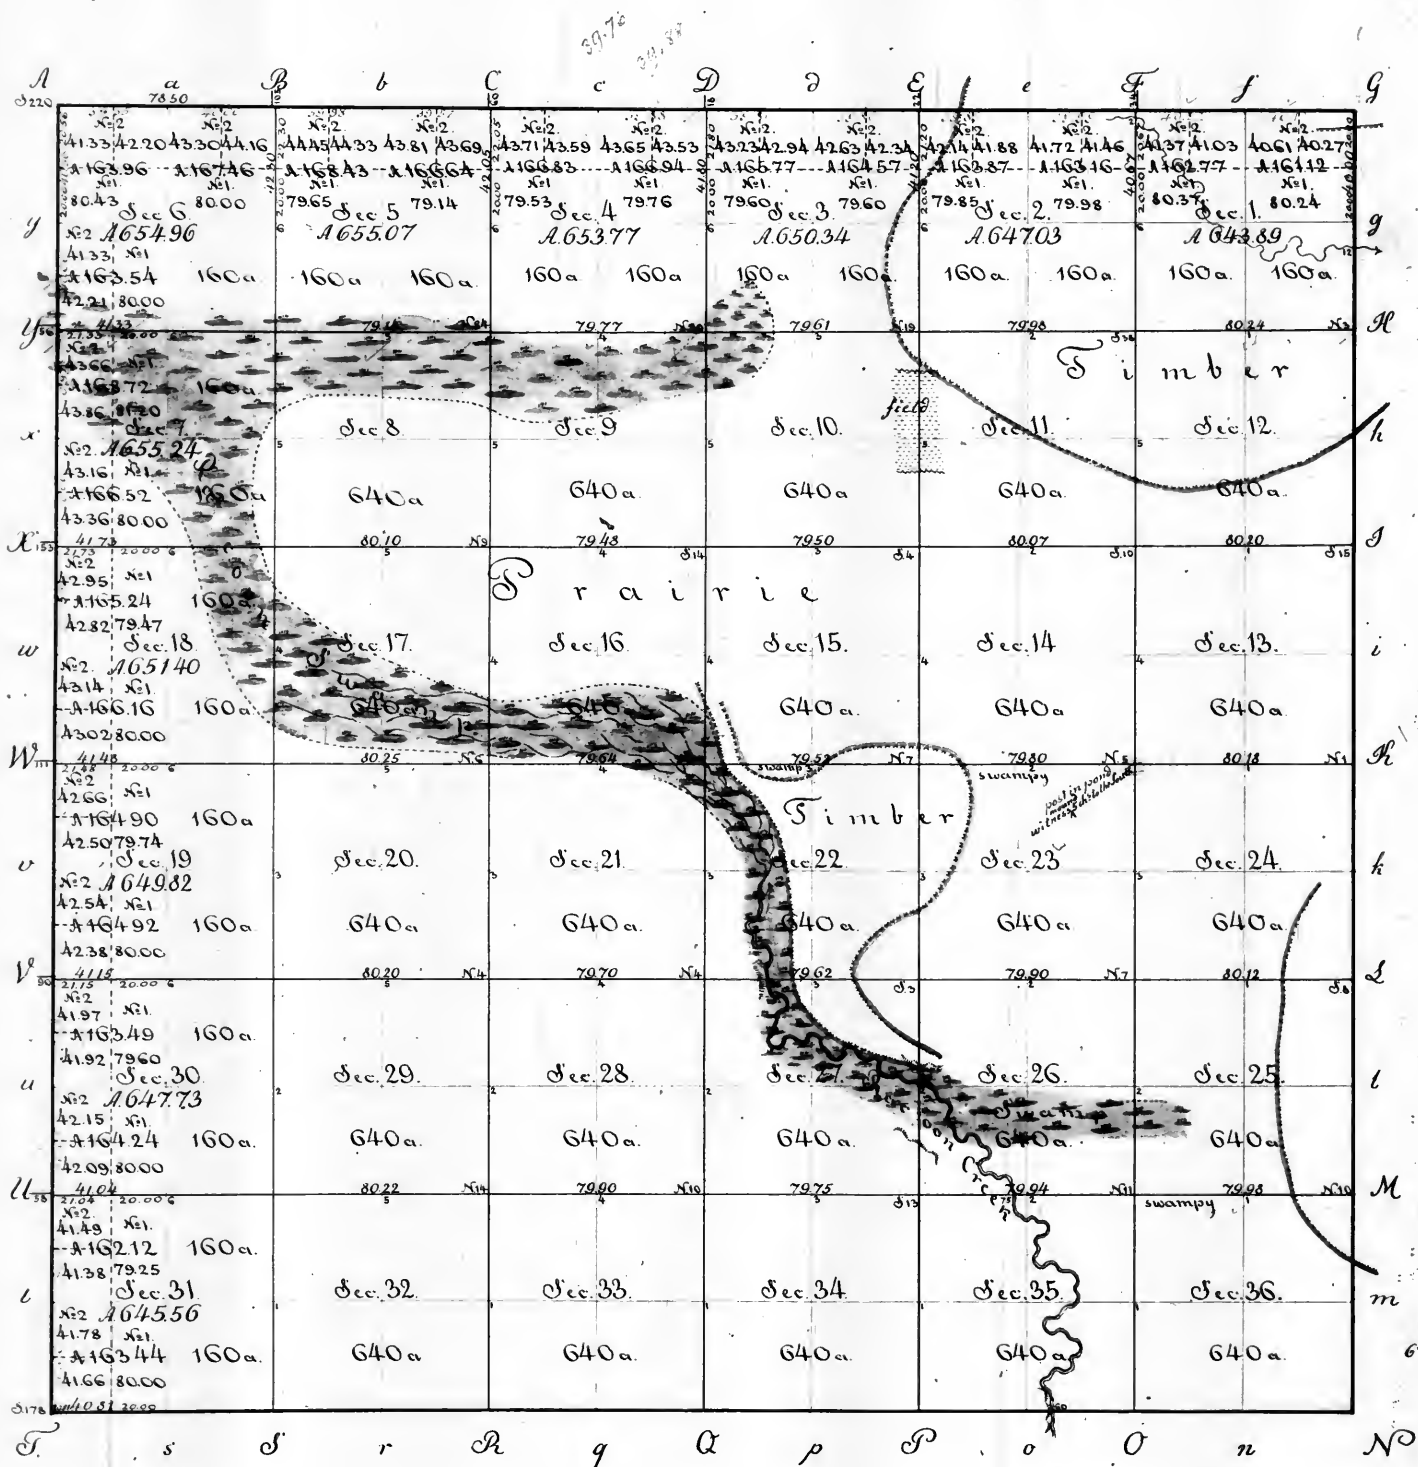

Surveyor General's Office.
Saint Louis 22 July 1839.


Scale of 40 chains to one inch.
Aggregate area 23154.81 acres.

The above plat of township 43 north of the base line, range 5 east of the 3^d principal meridian is strictly conformable to the field notes of the Survey thereof on file in this office, which have been examined and approved - The east and west boundaries 6 miles each, were surveyed in the 2^d quarter of 1837 - The South boundary 6 miles and 81 links of the North boundary 5 miles 78.50 chains, were surveyed in the 3^d quarter of 1837 - and the Subdivision lines 58 miles 11.09 chains + 79.14 chains + 1 mile 1.83 chains = 60 miles 12.06 chains were surveyed in the 3^d and 4th quarters of 1837, and 2^d quarter of 1839, all by Ignatius J. Sprigg, under contract signed by the Surveyor General on the 21st of November 1836, and by Sprigg on the 15th day of December of the same year - They were paid for in the 1st and 2^d quarters of 1839, and charges in the accounts of the Surveyors General for those quarters Vouchers N. 2 and 3.

William Milburn
Surveyor General

Township N:44 North of the Baseline in Range N:5 East of the 3^d principal Meridian.

41

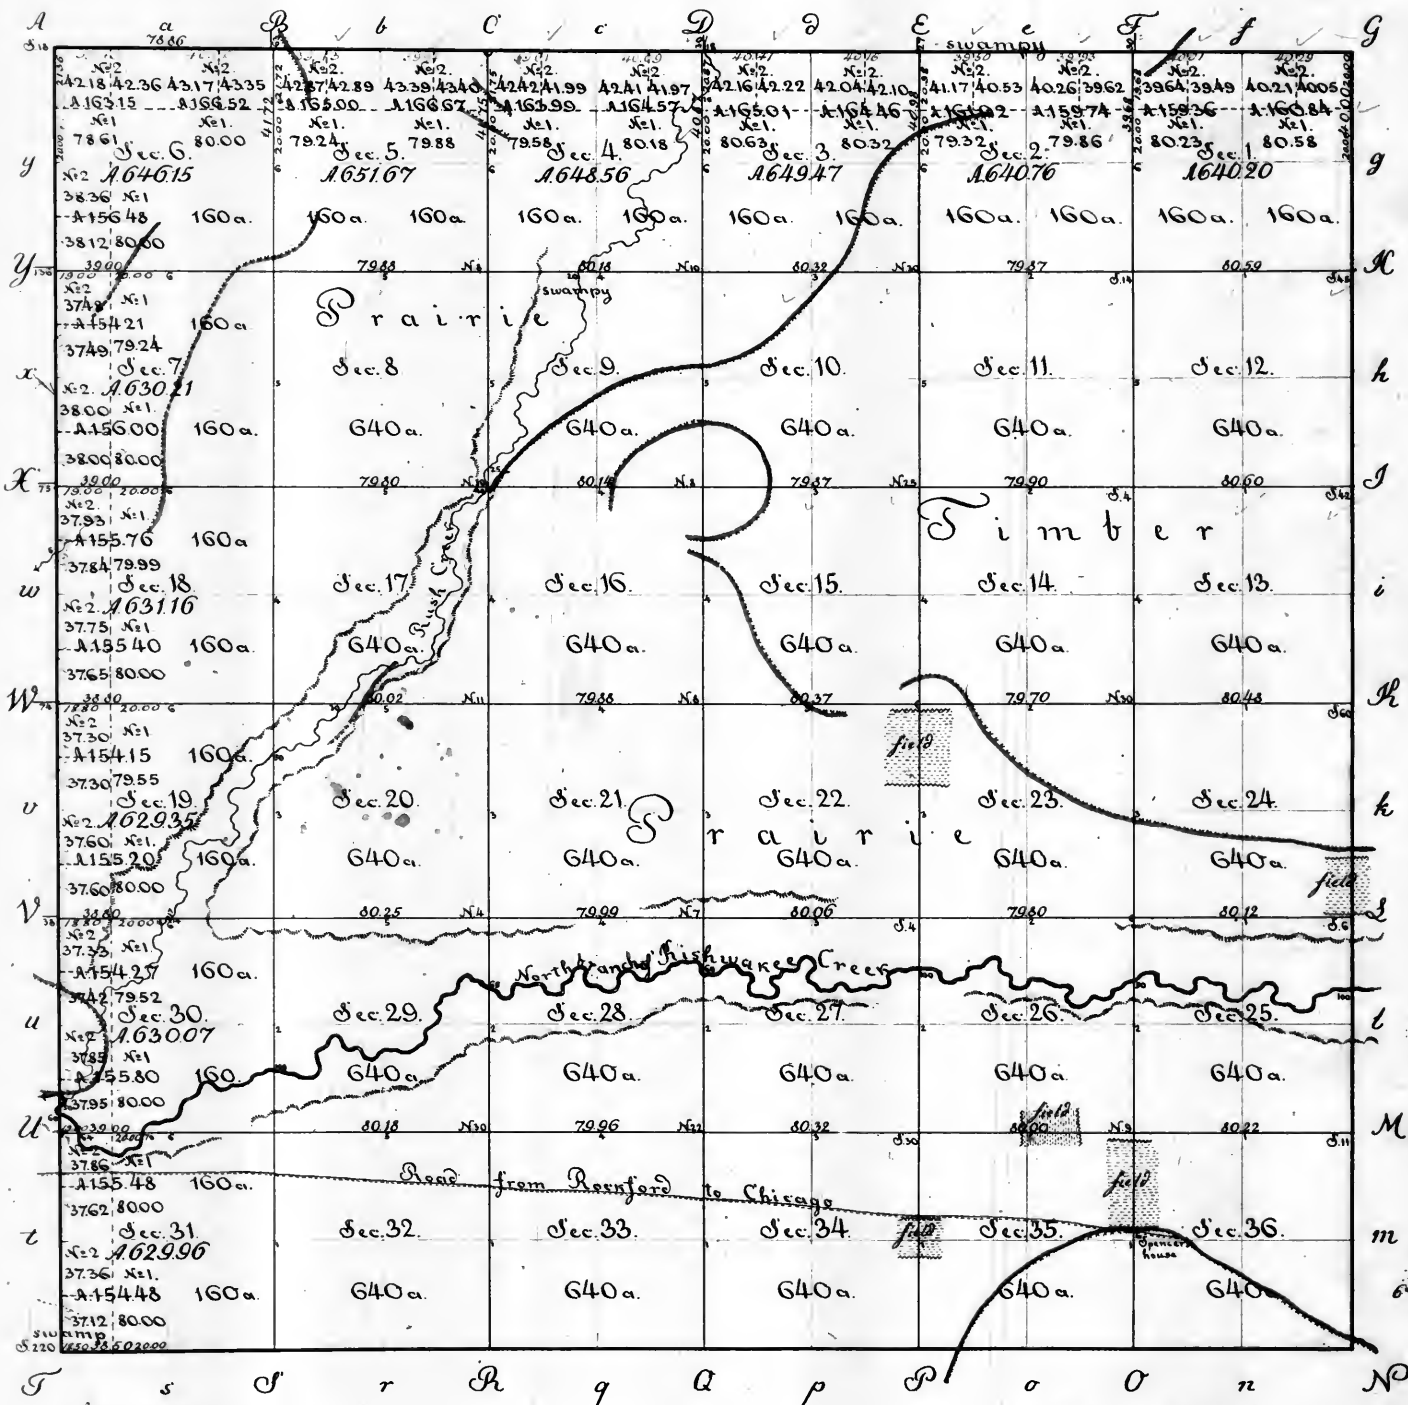

Variation:
6°25' East on all the lines.

Surveyors General's Office,
Saint Louis 22^d July 1839.


Scale of 40 chains to one inch.
Aggregate area 23027.56 acres.

The above plat of township 44 north of the base line, range 5 east of the 3^d principal meridian is strictly conformable to the field notes of the Survey filed on file in this office which have been examined and approved. The east and west boundaries 6 miles each were surveyed in the 2^d quarter of 1837 - The South boundary 5 miles 73.50 chains was surveyed in the 3^d quarter of 1837 - The North boundary 5 miles 73.85 chains, was surveyed in the 4th quarter of 1837 - and the subdivision lines 60 miles 2.10 chains were surveyed in the 1st quarter of 1837 and 2^d quarter of 1839, all by Ignatius J. Sprigg, under contract signed by the Surveyor General on the 21st of November, 1836, and by Sprigg on the 15th day of December of the same year. They were paid for in the 1st and 2^d quarters of 1839, and charged in the accounts of the Surveyors General for those quarters - Vouchers N: 2 and 2.

William Milburn
Surveyor General

Township N^o 45 North of the Base line in Range N^o 5 East of the 3^d principal Meridian.

42

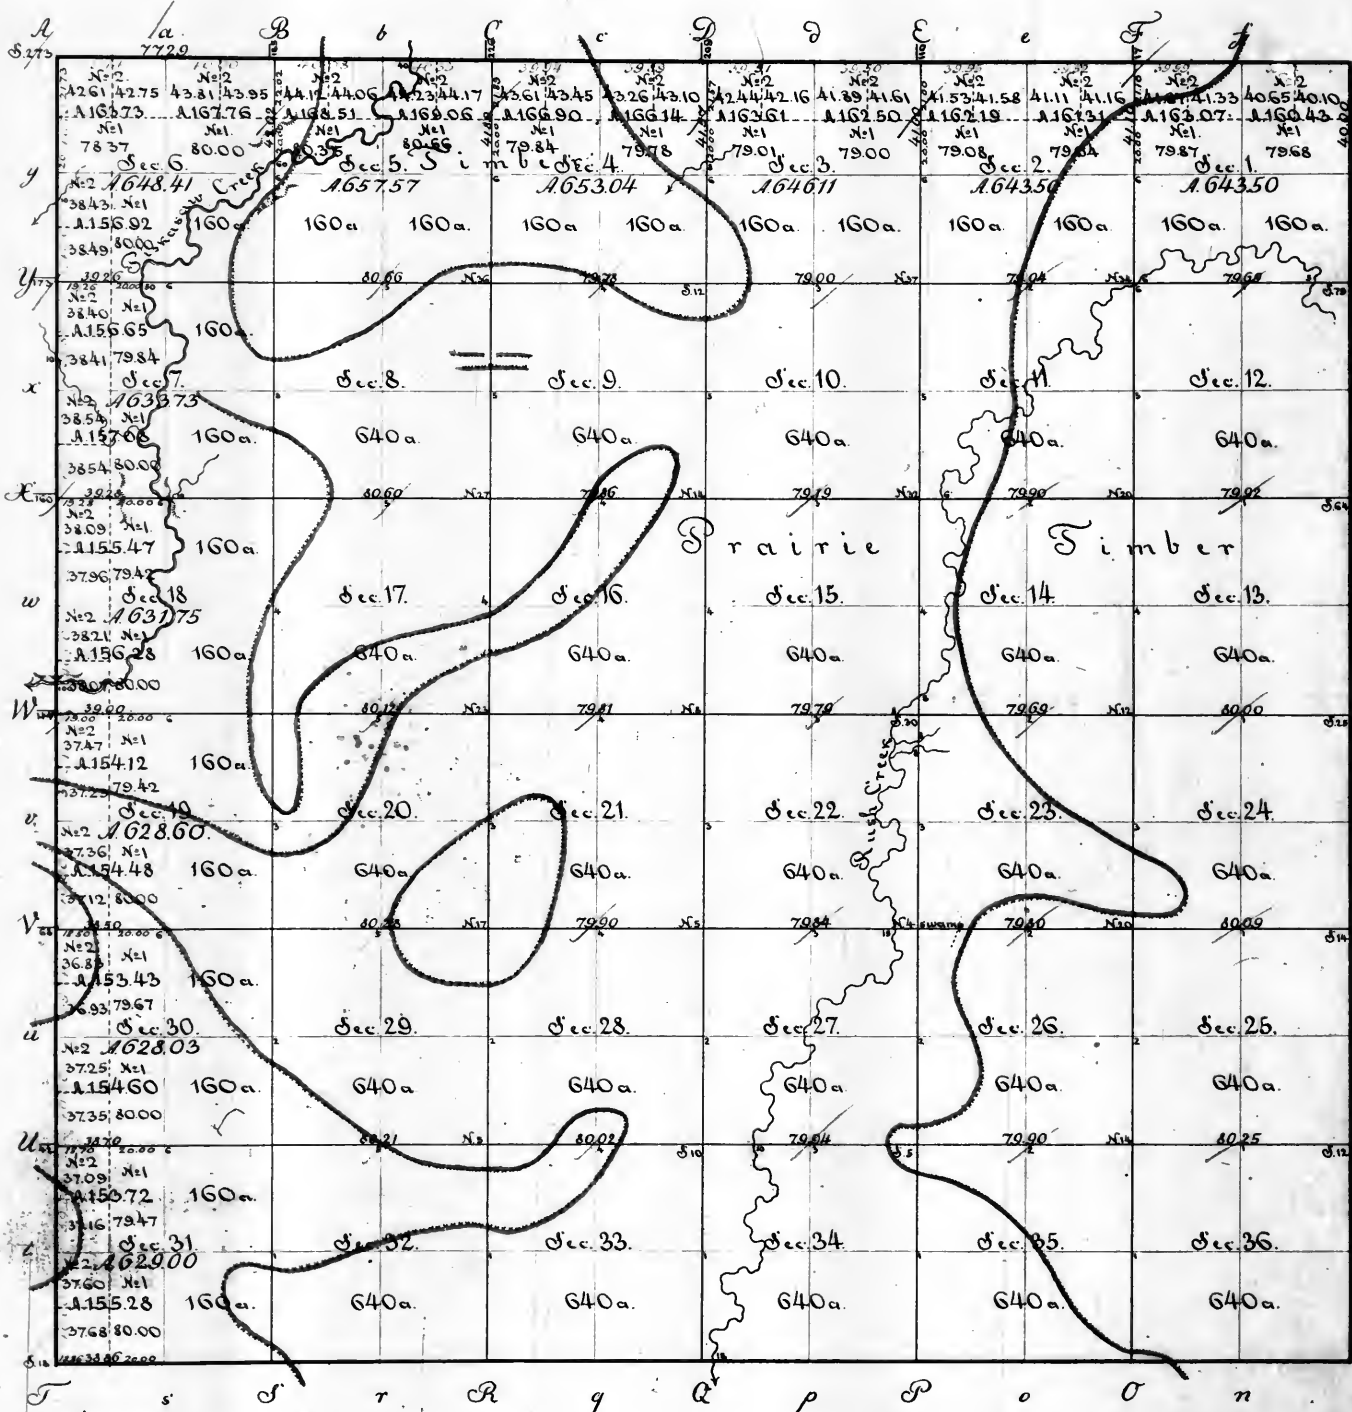

W. m. l. k. A. i. J. h. H. (Note. The account of Mr. Spragg in which the savings of the exterior and individual lines of this township are charged amounts to \$2112.62600, of which \$1978.9400 was paid on the 6th of February 1855 - The balance \$133.68600 being withheld to insure the speedy execution of the improvements &c.)

Surgeons Office.

Saint Louis 14th of May 1839

Scale of 40 chains to one inch.

Aggregate Area 23043.24 acres.


The above plat of township 45 North of the base line range 5 east of the 2nd principal meridian is strictly conformable to the field notes of the Survey thereof on file in this office, which have been examined and approved. The West and East boundaries (6 miles each) were surveyed in the 2nd quarter of 1837 — the North boundary (5 miles 17.29 chains) was surveyed in the 3rd quarter of 1837 — and the South boundary (5 miles 73.86 chs) and the subdivision lines 59 miles 79.60 chains were surveyed in the 4th quarter of 1837 — all by Ignatius Sprigg, under contract signed by the Surveyor General on the 21st of November and by the said Sprigg on the 15th of December 1836 — and to the extent noted in the margin were paid for in the 1st quarter of 1839 and charged in the account of the Surveyor General for that quarter — Voucher N^o. 2.

William Milburn
Surveyor General

Ex
May 2. 1839

Township N 46 North of the Base line in Range N 5 East of the 3^d principal Meridian.

43

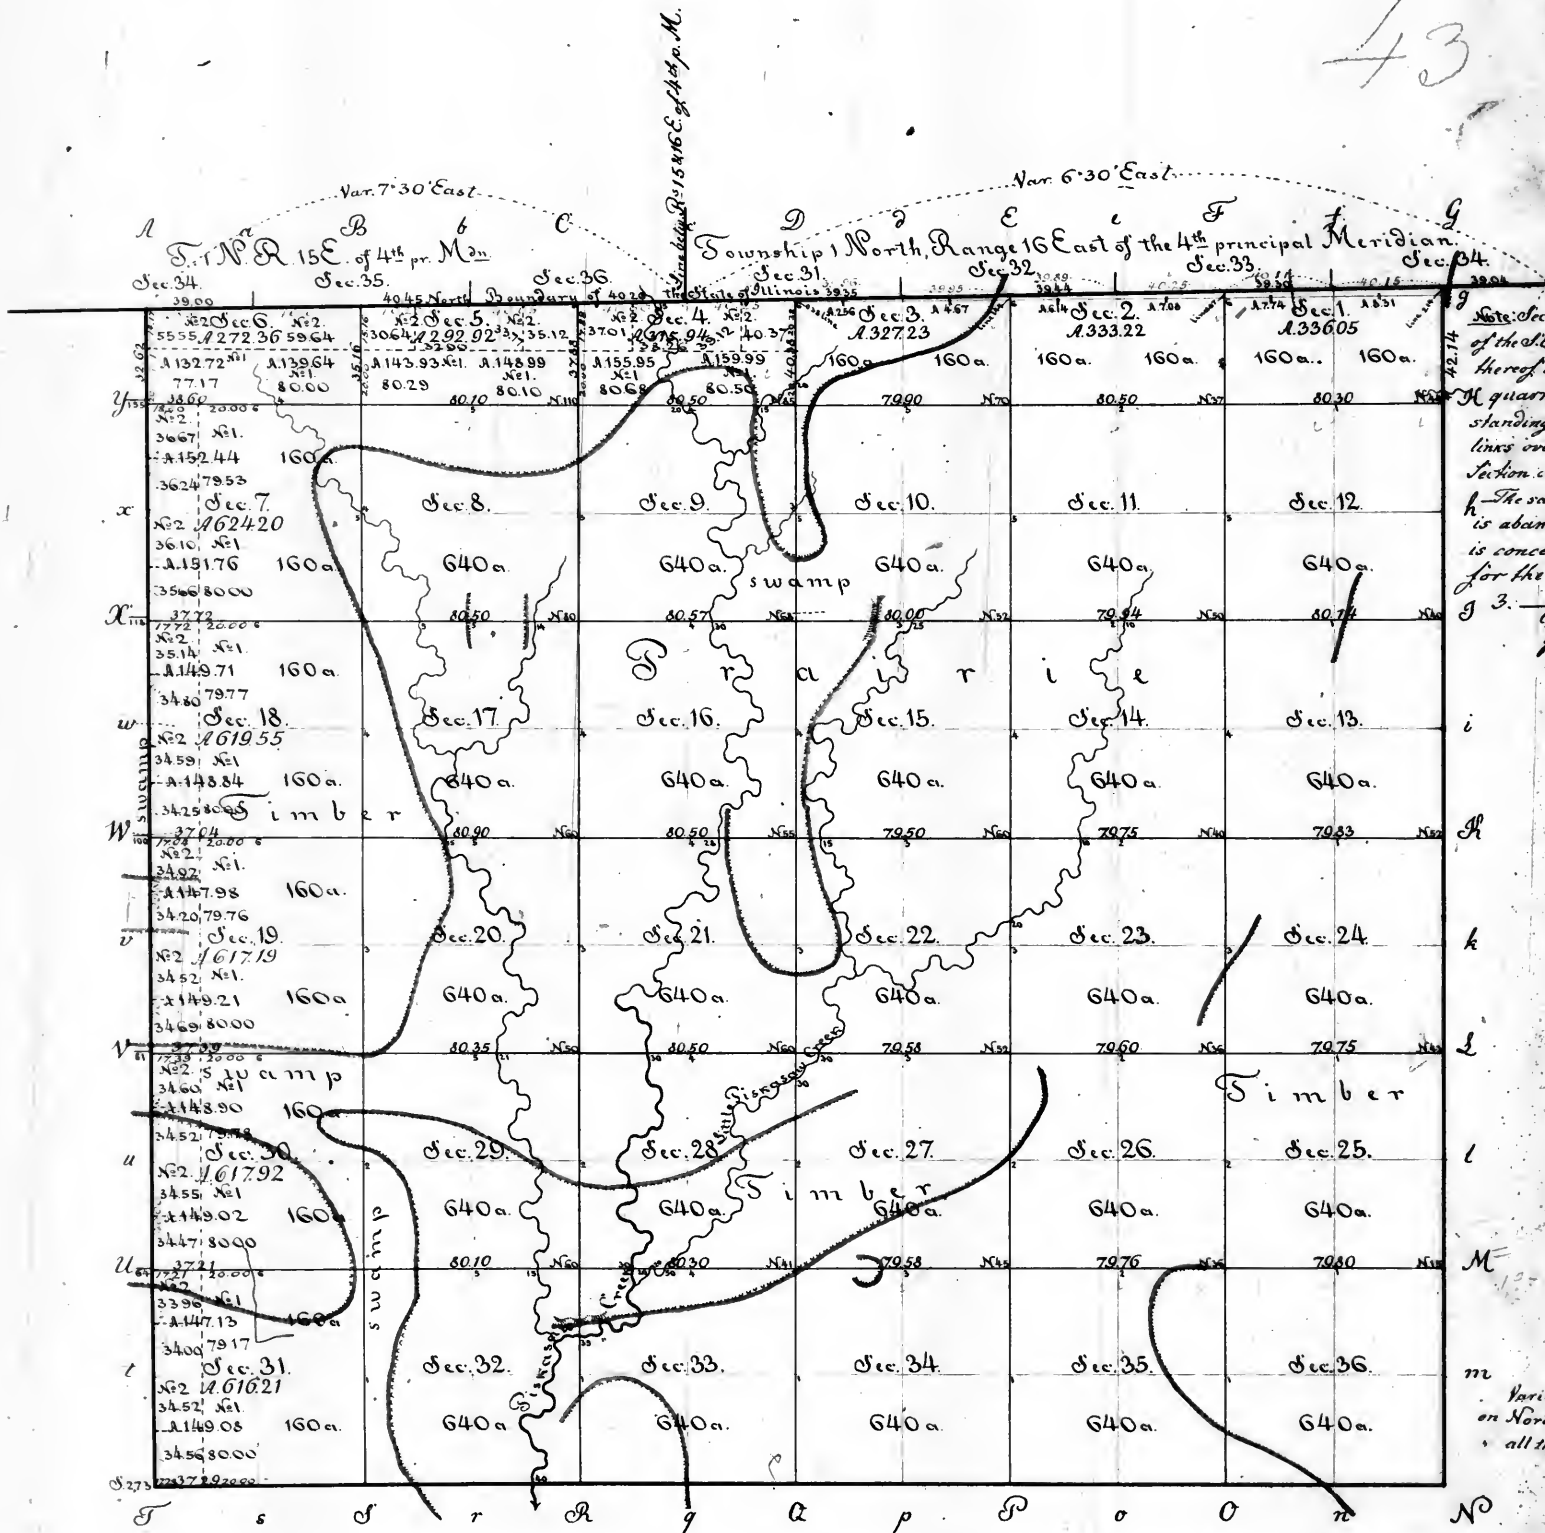

Note: Sec. 4 is divided into lots 1 & 2 of the S.E. & W. quarters, and no part thereof will be designated the S.E. A quarter of the Section, notwithstanding the East boundary is 38 links over the half mile, and a quarter section corner was established there. The said quarter section corner is abandoned so far as this Section is concerned, and is retained only for the use of the adjoining Section 3.

22 June 1839
William Milburn
Surveyor General

Surveyor General's Office.
Saint Louis 22^d July 1839.


Scale of 40 chains to one inch.
Aggregate area 20972.89 acres.

The above plat of township 46 north of the base line, range 5 east of the 3^d principal meridian, is strictly conformable to the field notes of the Survey thereof on file in this office which have been examined and approved. The north boundary was surveyed in 1832 and 1833 by Lucius Lyon, Commissioner on the part of the United States as certified to this office by M. J. Williams, Surveyor General of Ohio, Indiana & Michigan:—the said line being a part of the boundary between Illinois and Michigan, now Wisconsin.—The east boundary 5 miles 42.14 chains was surveyed in the 2^d and 3^d quarters of 1837.—The South boundary 5 miles 77.23 chains.—The west boundary 5 miles 32.62 chains, and the subdivision line 5 miles 26.34 chains, were surveyed in the 3^d quarter of 1837, all by signatus J. Sprigg, under contract signed by the Surveyor General on the 21st of November 1836, and by Sprigg on the 15th day of December of the same year.—They were paid for in the 1st and 2^d quarters of 1839, and charged in the accounts of the Surveyors General for those quarters. Vouchers A. 2 and 2.

William Milburn
Surveyor General

Township 28 North of the base line Range 6 East of the 3rd principal Meridian

46

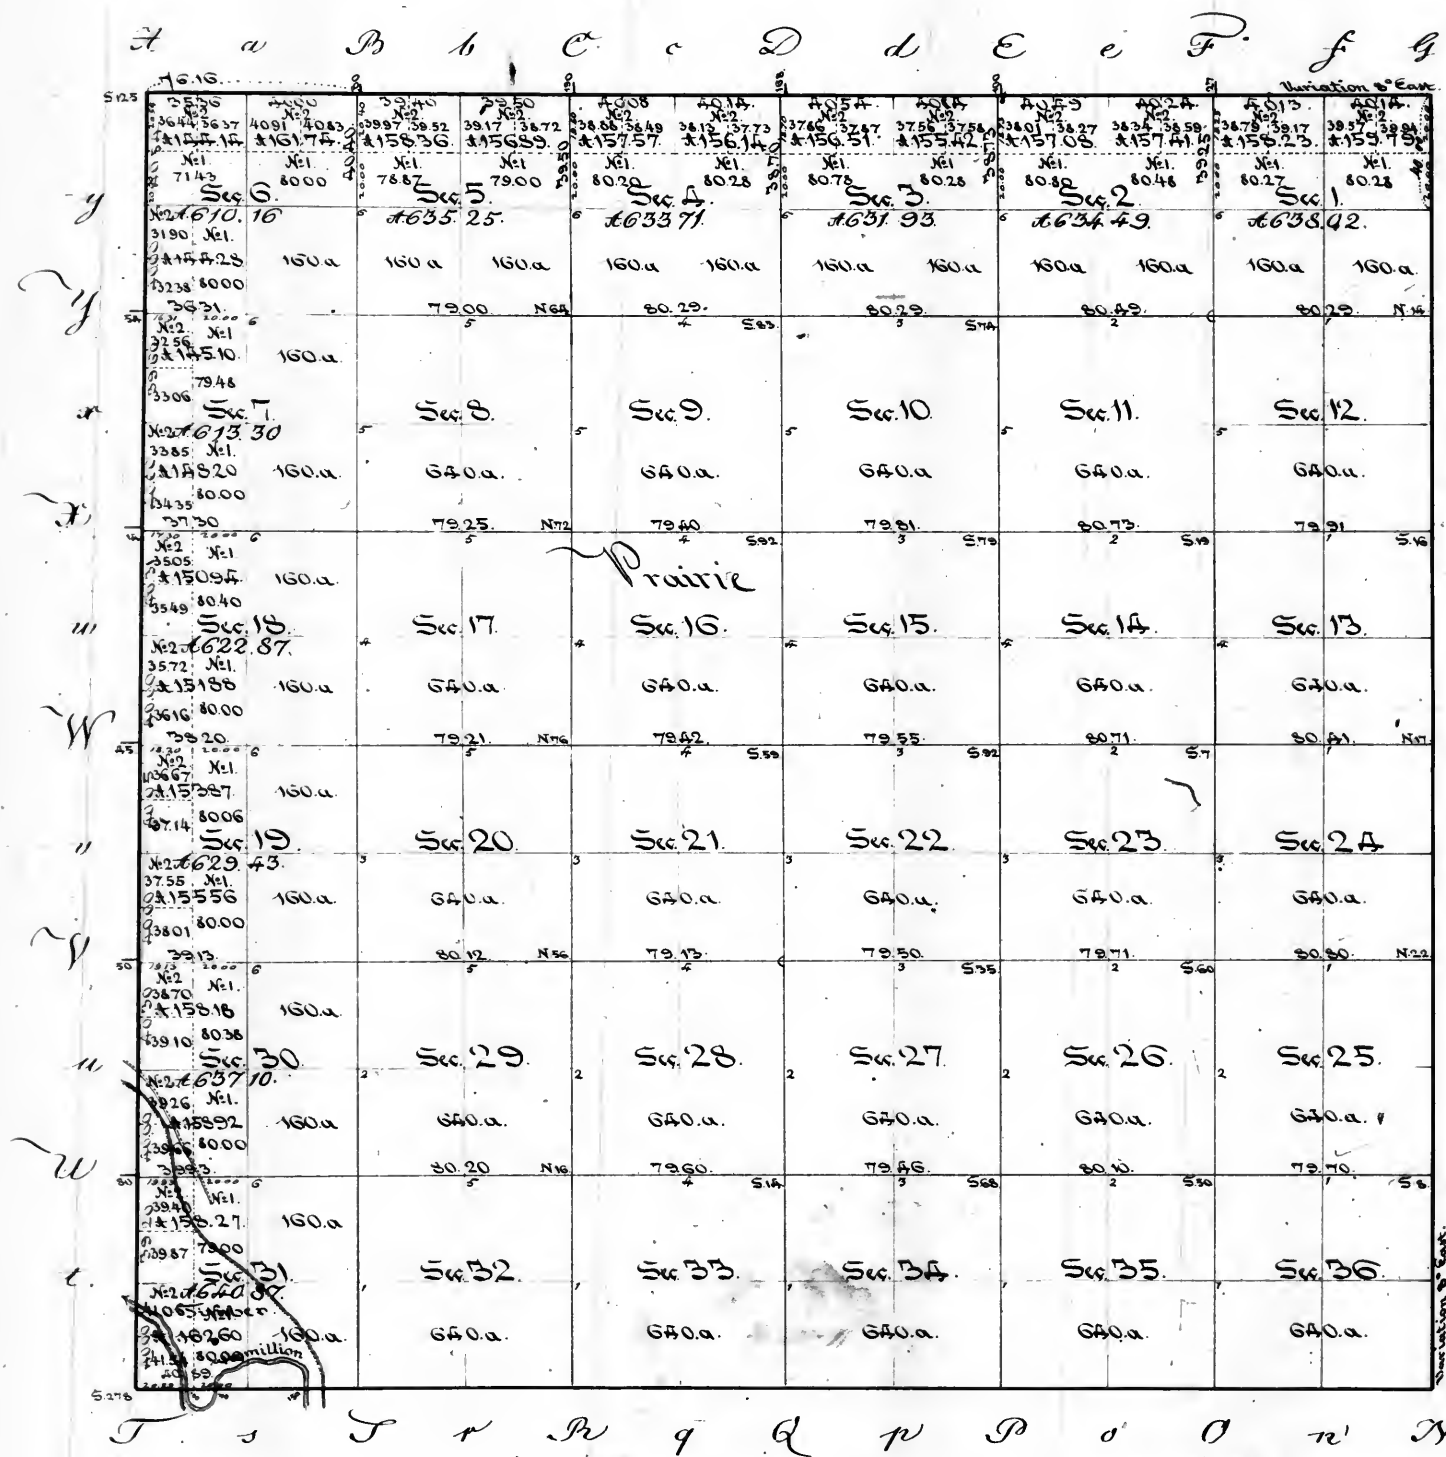

Surveyors Office
Saint Louis October 3rd 1838

The above plat of township 28 north of the base line, range 6 east of the 3rd principal meridian, is strictly conformable to the field notes of the survey thereof on file in this office, which have been examined and approved. The North boundary (5 miles 76.15 chains) was surveyed in the 4th quarter of 1833 - and the West boundary (6 miles) - The South boundary (6 miles and 80 chains) - The East boundary (6 miles) - and the Subdivision lines (59 miles 64.50 chains) were surveyed in the second quarter of 1834 - all by Erastus Moore, under contract of the 12th of August 1833 - and with the limitation notes in the margin, were paid for, in the 2nd quarter of 1838, and charged in the account of the Surveyor General for that quarter.

David Huntlin
Sur. Genl.

Notes. The original account of 28 March, in which the survey of the township is charged, amounts to \$ 2517 1/2, of which \$ 191 1/2 was paid in the 1st quarter of 1833, and the balance being \$ 2200, was withheld for the purpose of securing the speedy completion of the survey of the western range of sections in 3rd 26 1/2, and 28 1/2, which was done by J. M. Mearns and Dr. S. Mearns, to the final between ranges 6 and 7 East, as first surveyed by Dr. Moore, and which, in consequence of the survey of the 3rd range line by Dr. Mearns, must be revised therewith by him.



Variation
West bound - 11th 15' E.
South - 8th 15' E.
East - 8th E.
North - 8th E.
Subdivision - 8th E.

Township 29 North of the base line Range 6 East of the 3rd principal Meridian

17

47

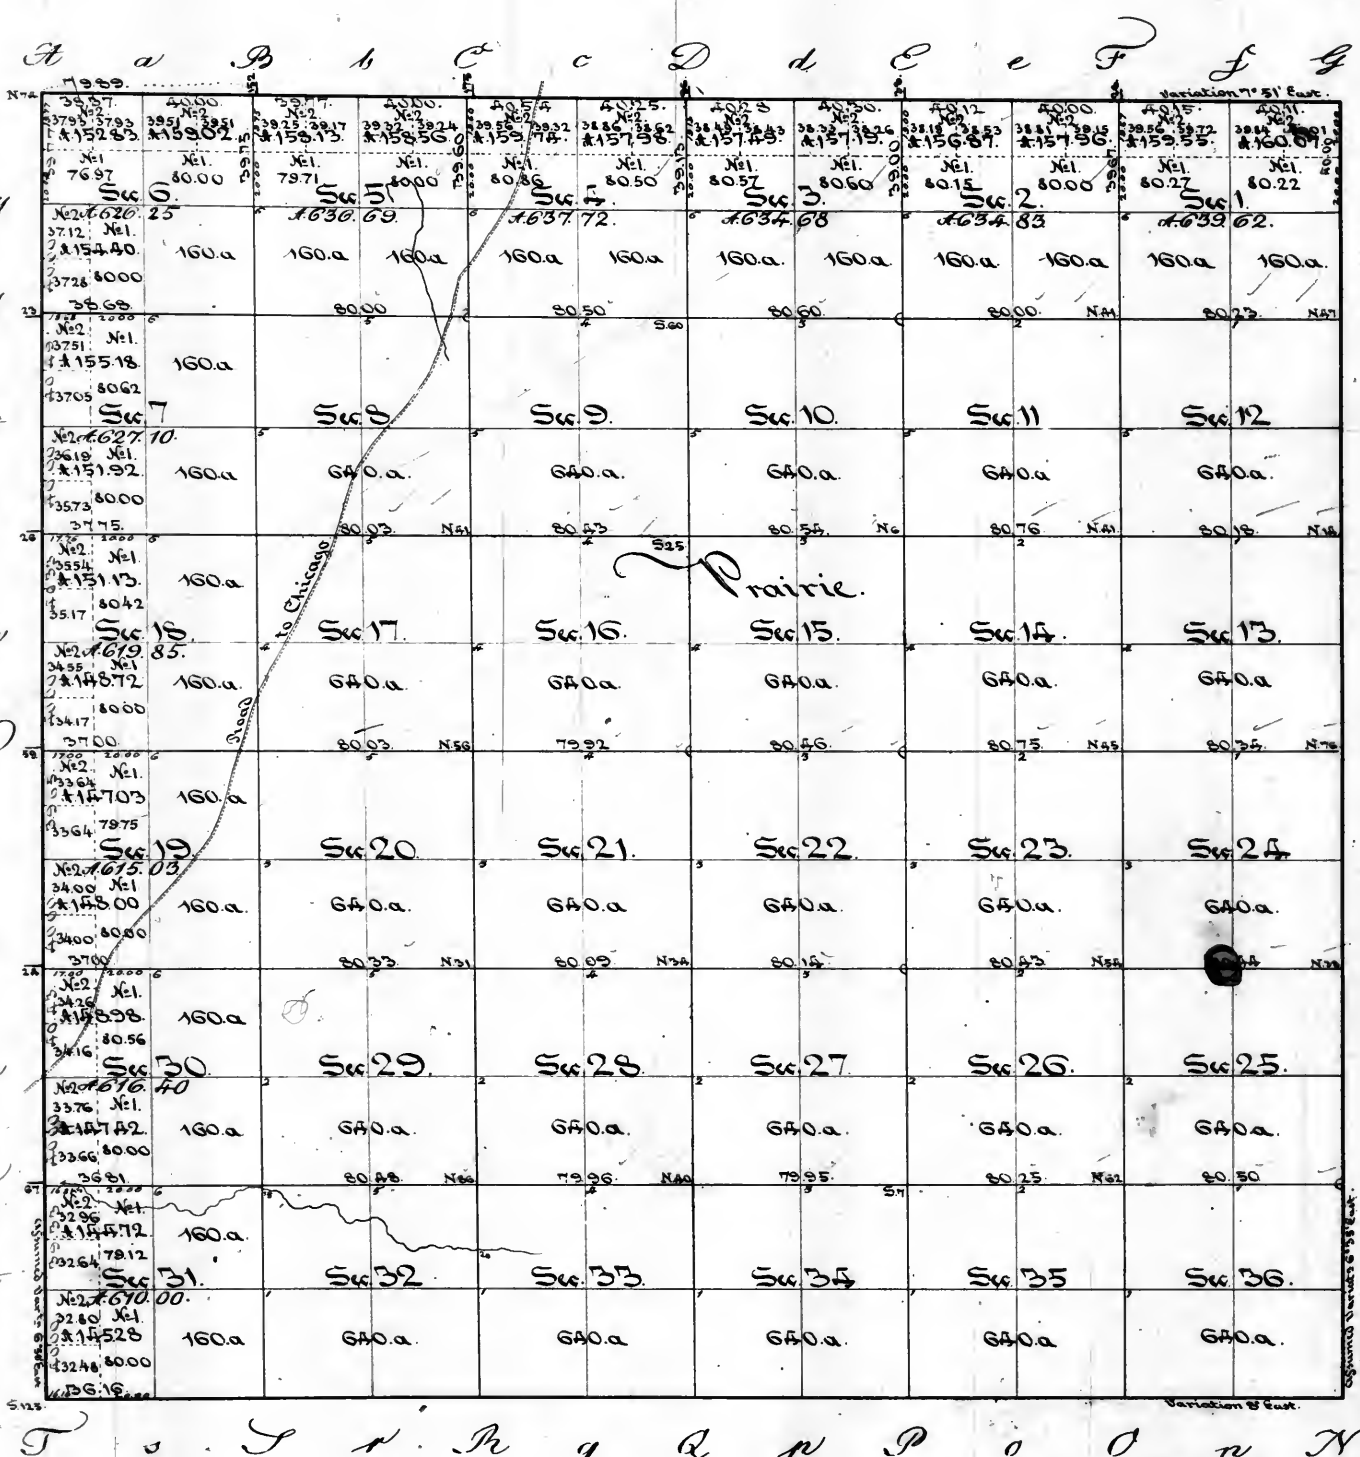




Surveyors Office.
Saint Louis October 3rd 1838

The above plat of township 29 North of the base line, range 6 East of the 3rd principal meridian is strictly conformable to the field notes of the survey thereof, on file in this office, which have been examined and approved. The West boundary (6 miles) - The South boundary (5 miles 76-10 chains) - The East boundary (6 miles) - and the North boundary (5 miles 79-29 chains), were surveyed in the 1st quarter of 1833 - and the subdivision lines (36 miles 71-73 chains) were surveyed in the 2nd quarter of 1834 - all by Ezekiel Moore, under contract of the 15th of August 1833, and with the limitation noted in the margin, were paid for, in the second quarter of 1838, and charged on the accounts of the Surveyor General for that quarter.

Daniel S. M. Phelps
Sur. Genl.

Township 30 North of the base line Range 6 East of the 3^d principal Meridian.

48

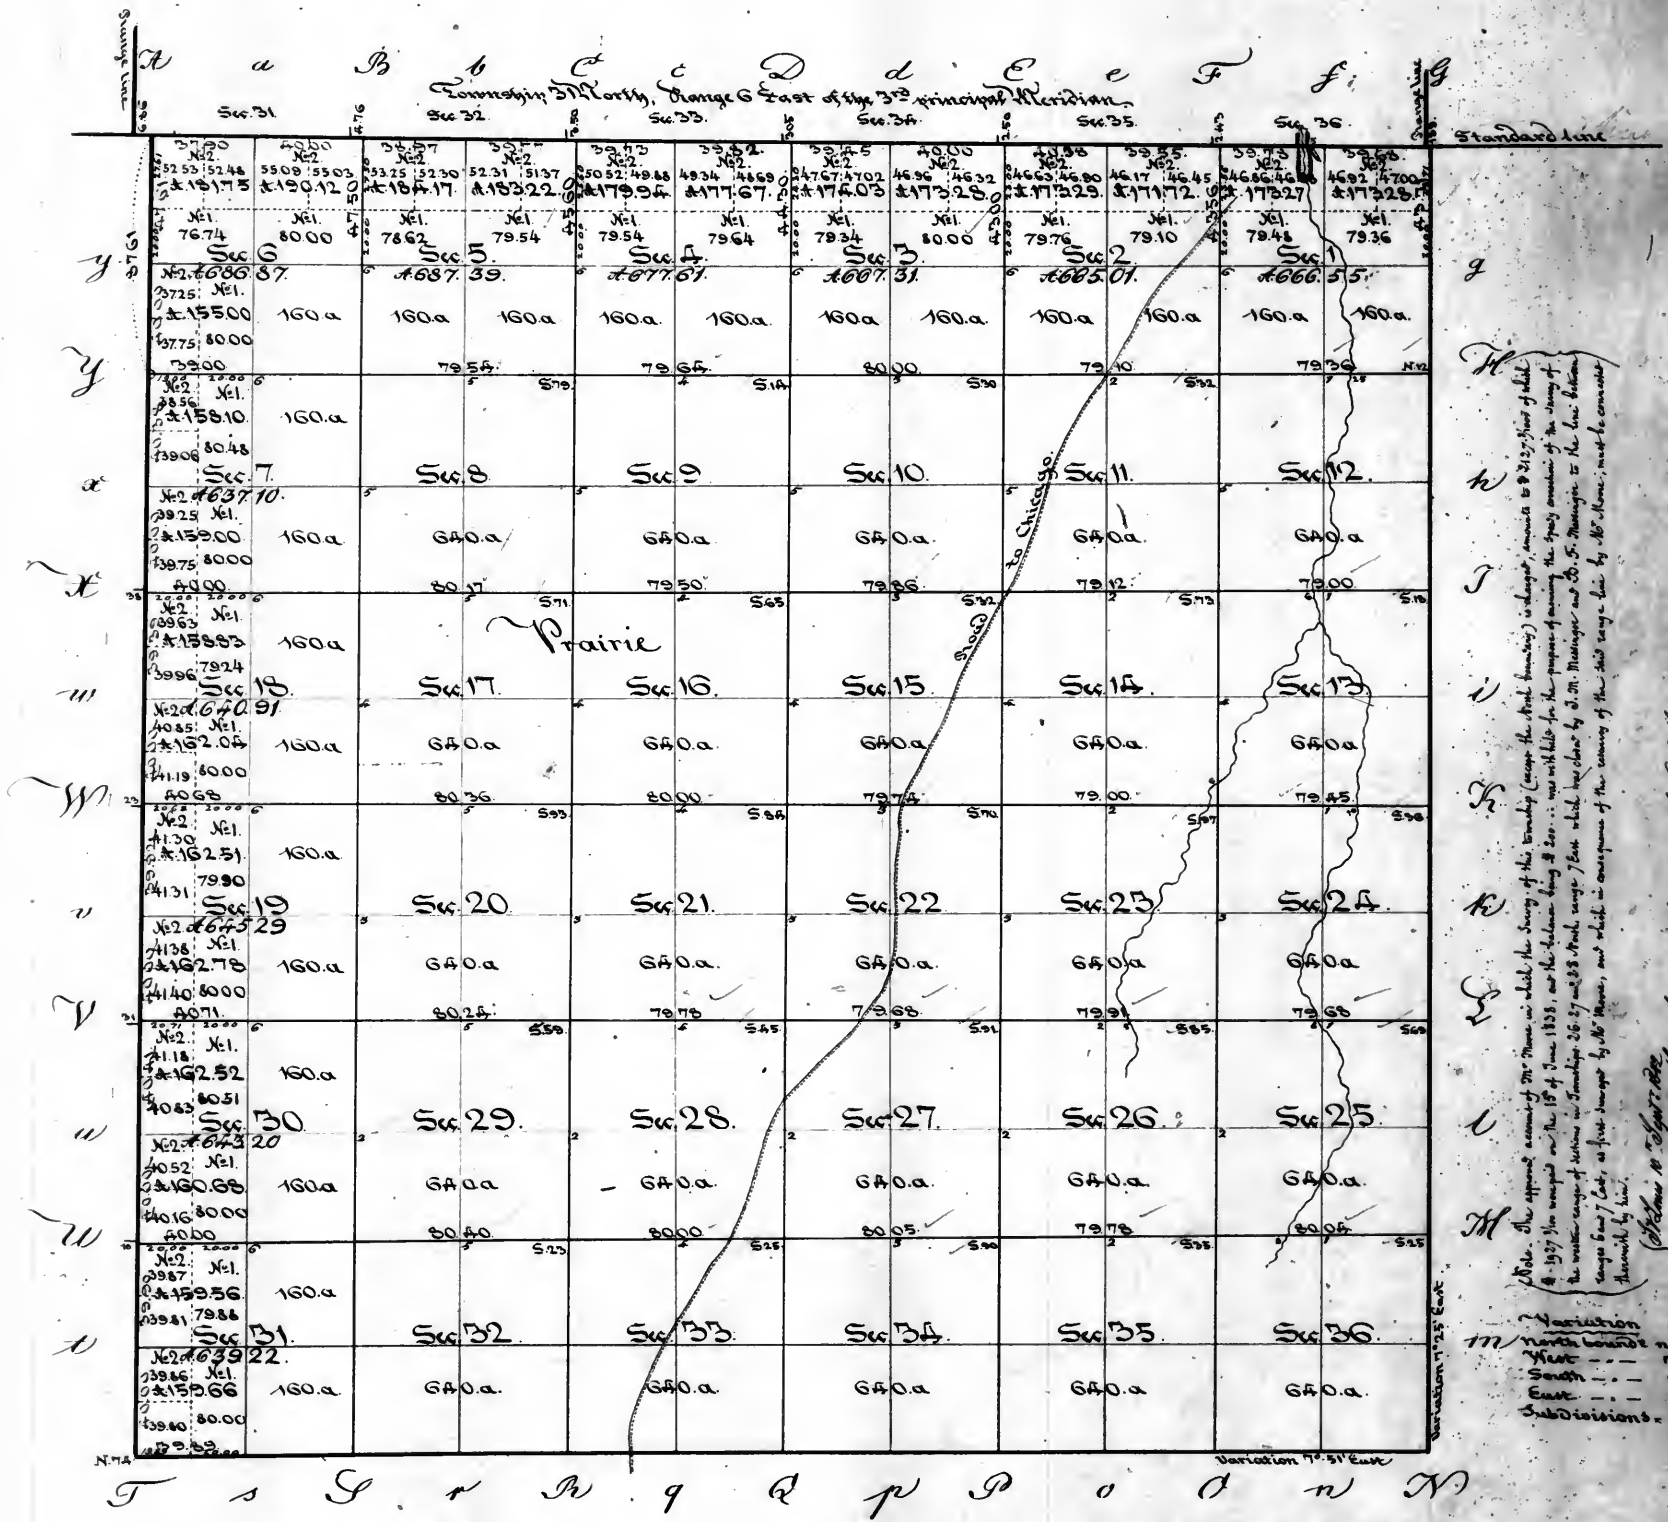

Chicago & St. Louis

Variation
North - 7° 25' E
South - 7° 25' E
East - 7° 25' E
Subdivisions - 7° 25' E

Surveyors Office
Saint Louis. October 3^d 1838

The above plat of township 30 north of the base line, range 6 East of the 3^d principal meridian, is strictly conformable to the field notes of the survey thereof on file in this Office, which have been examined and approved. The North boundary (5 miles 75.03 chains) was surveyed in the 2^d quarter of 1821, by Daniel Miller under the joint contract of Stephen Rector and Thomas C. Rector, with the Surveyor General dated 20th March 1821 - The South boundary (5 miles 79.89 chains) The West boundary (6 miles 7.61 chains) and the East boundary (6 miles 3.71 chains) were surveyed in the 4th quarter of 1833 - and the subdivision lines (60 miles 17.75 chains) were surveyed in the 2^d quarter of 1834, all by Green Moore, under his contract of the 12th of August 1833, and with the limitation notes in the margin were paid for in the second quarter of 1838, and charged in the accounts of the Surveyor General for that quarter.

David Gurnell
Sur. Genl.


69

Surveyor's Office

The above Plat of Township 31 North of the Baseline, Range 6 East of the 3^d principal Meridian is conformable to the field Notes of the Survey thereof on file in this Office.

E. J. Langham

Plat of Township 32 North of the Base line Range N 6 East of the 3^d Principal Meridian 50

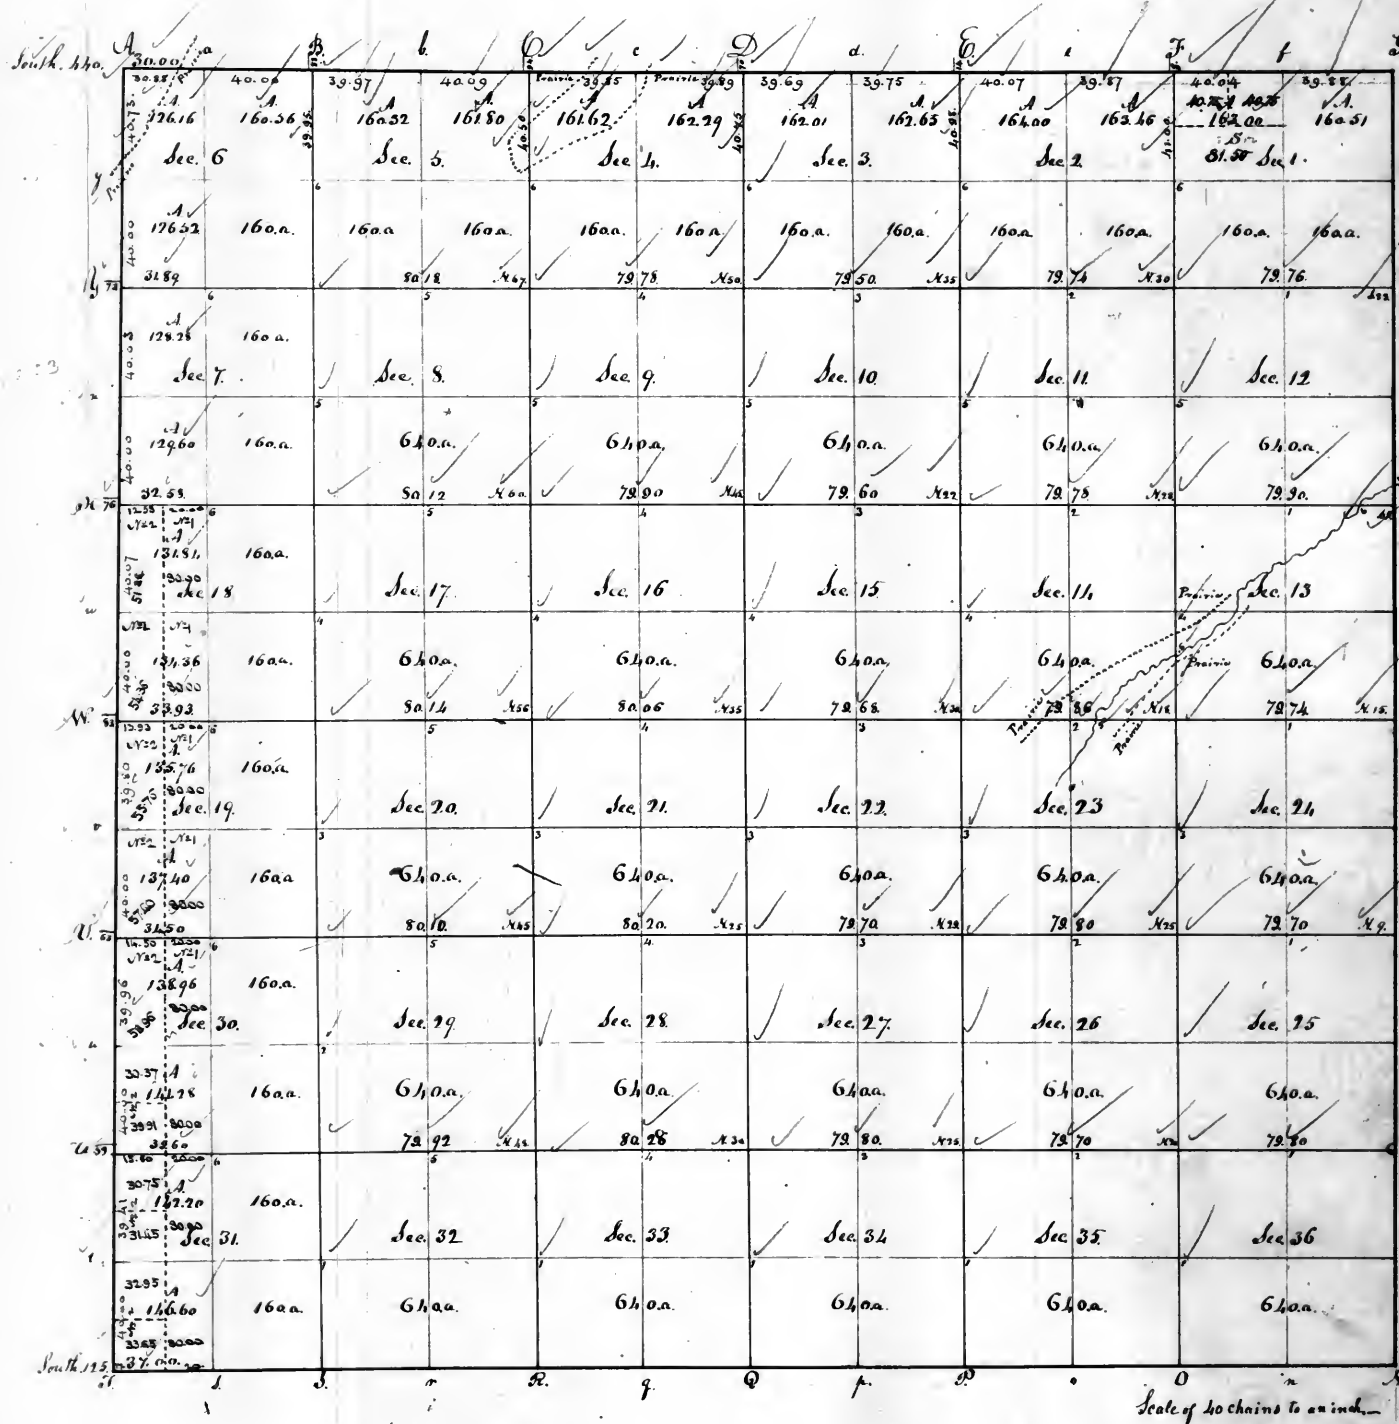

Surveyor's Office
St. Louis June 1834

Subdivided under the act of 1820, the 10th of Sect. 19-20 and 21, and sent a copy of the plat, through one to the Register and another to the Commissioner.

The 10th of Sect. 1, subdivided according to previous sales, has been sent to the Register and another to the Commissioner.


18th June 1834

Surveyor's Office
St. Louis June 1834

The above Plat of Township 32 North of the Base line, Range 6 East of the 3^d principal meridian is conformable to the field notes of the Survey thereof on file in this Office.

E. J. Sanborn

Plat of Township 32 North of the Base line Range N° 6 East of the 3^d Principal Meridian. 50

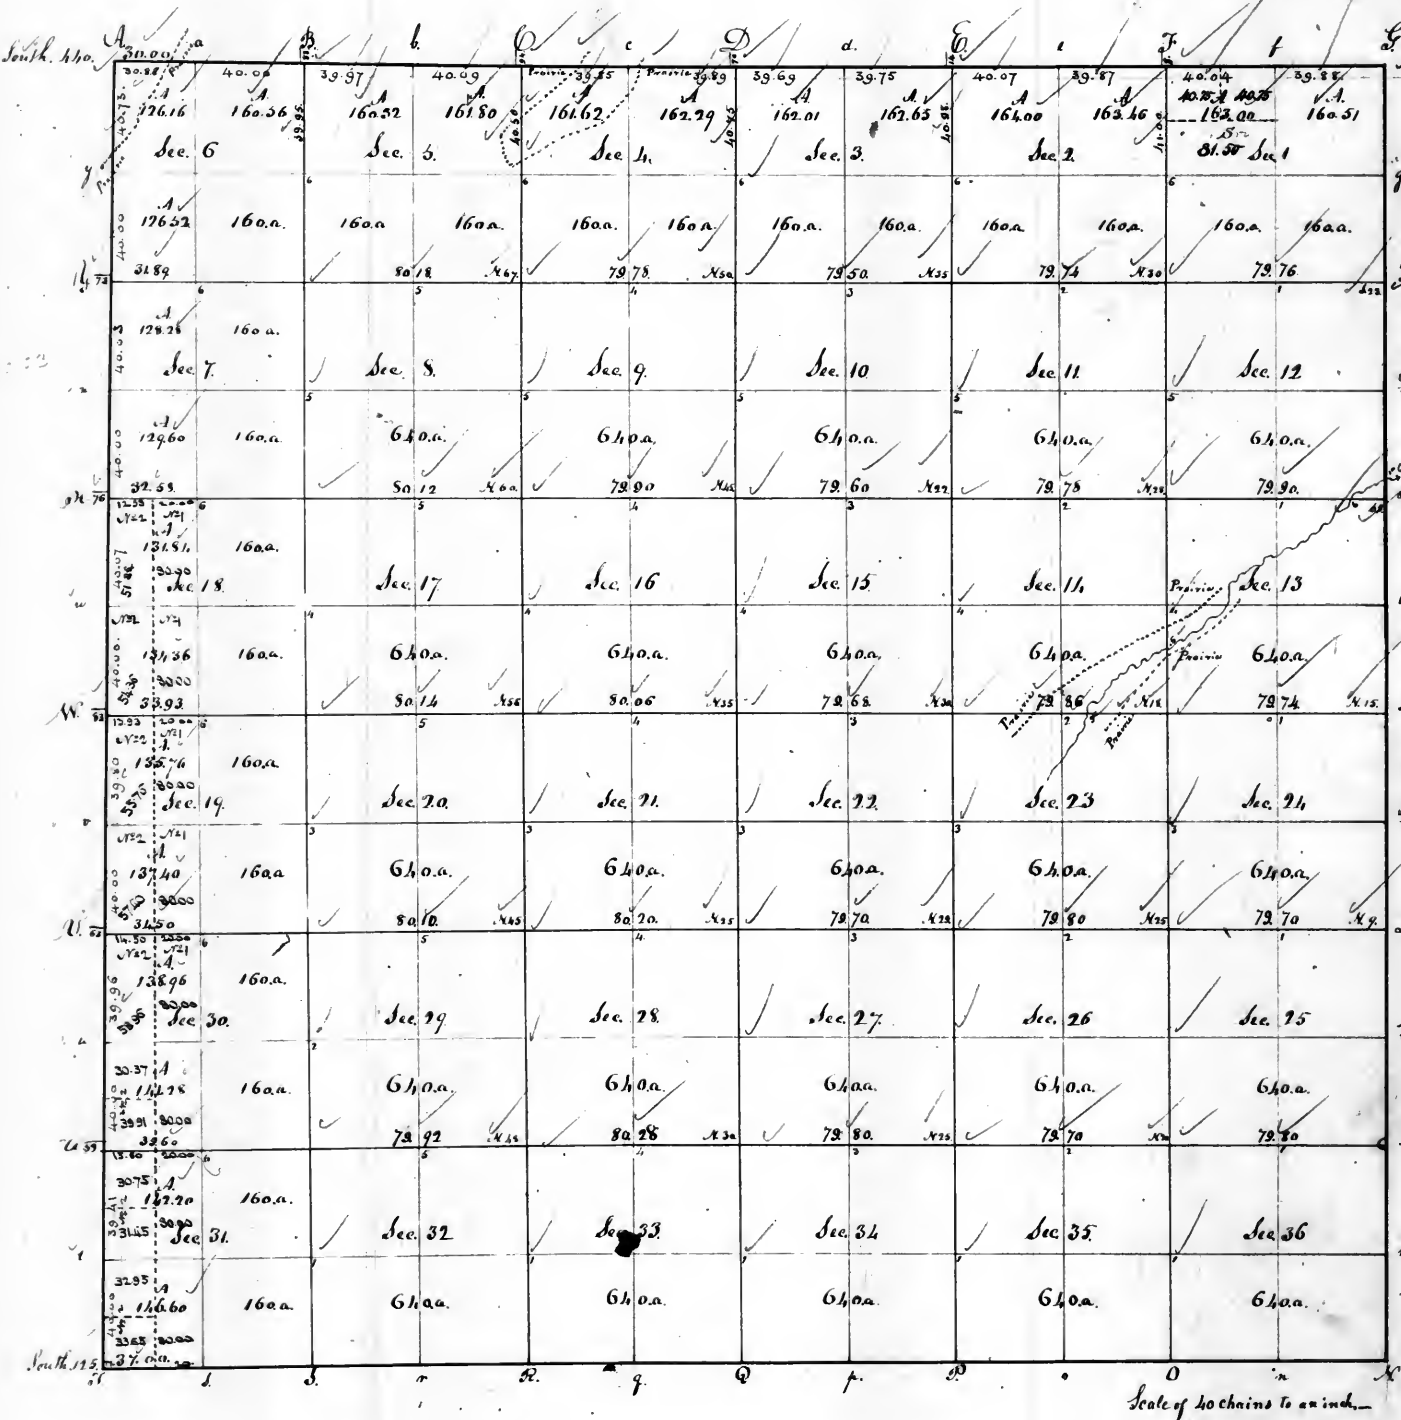

Surveyor's Office
St. Louis June 1834
Subdivided under the act
of 1820, as the 17th of Dec. 18-
20 and 21, and sent copy of
the plat thereof to the Register and
another to the Commissioner.
On Feb. 5th 1839, a plat of the
N. 1/2 of Sec. 1, subdivided accord-
ing to previous sale, has been sent
to the Register and another to the
Commissioner.


Surveyor's Office
St. Louis June 1834

The above Plat of Township 32 North of the Base line, Range 6 East
of the 3^d Principal Meridian is conformable to the field notes of the Survey thereof on file in this Office.

E. J. Sanborn

Township 33 North of the base line Range 6 East of the 3rd principal meridian

51

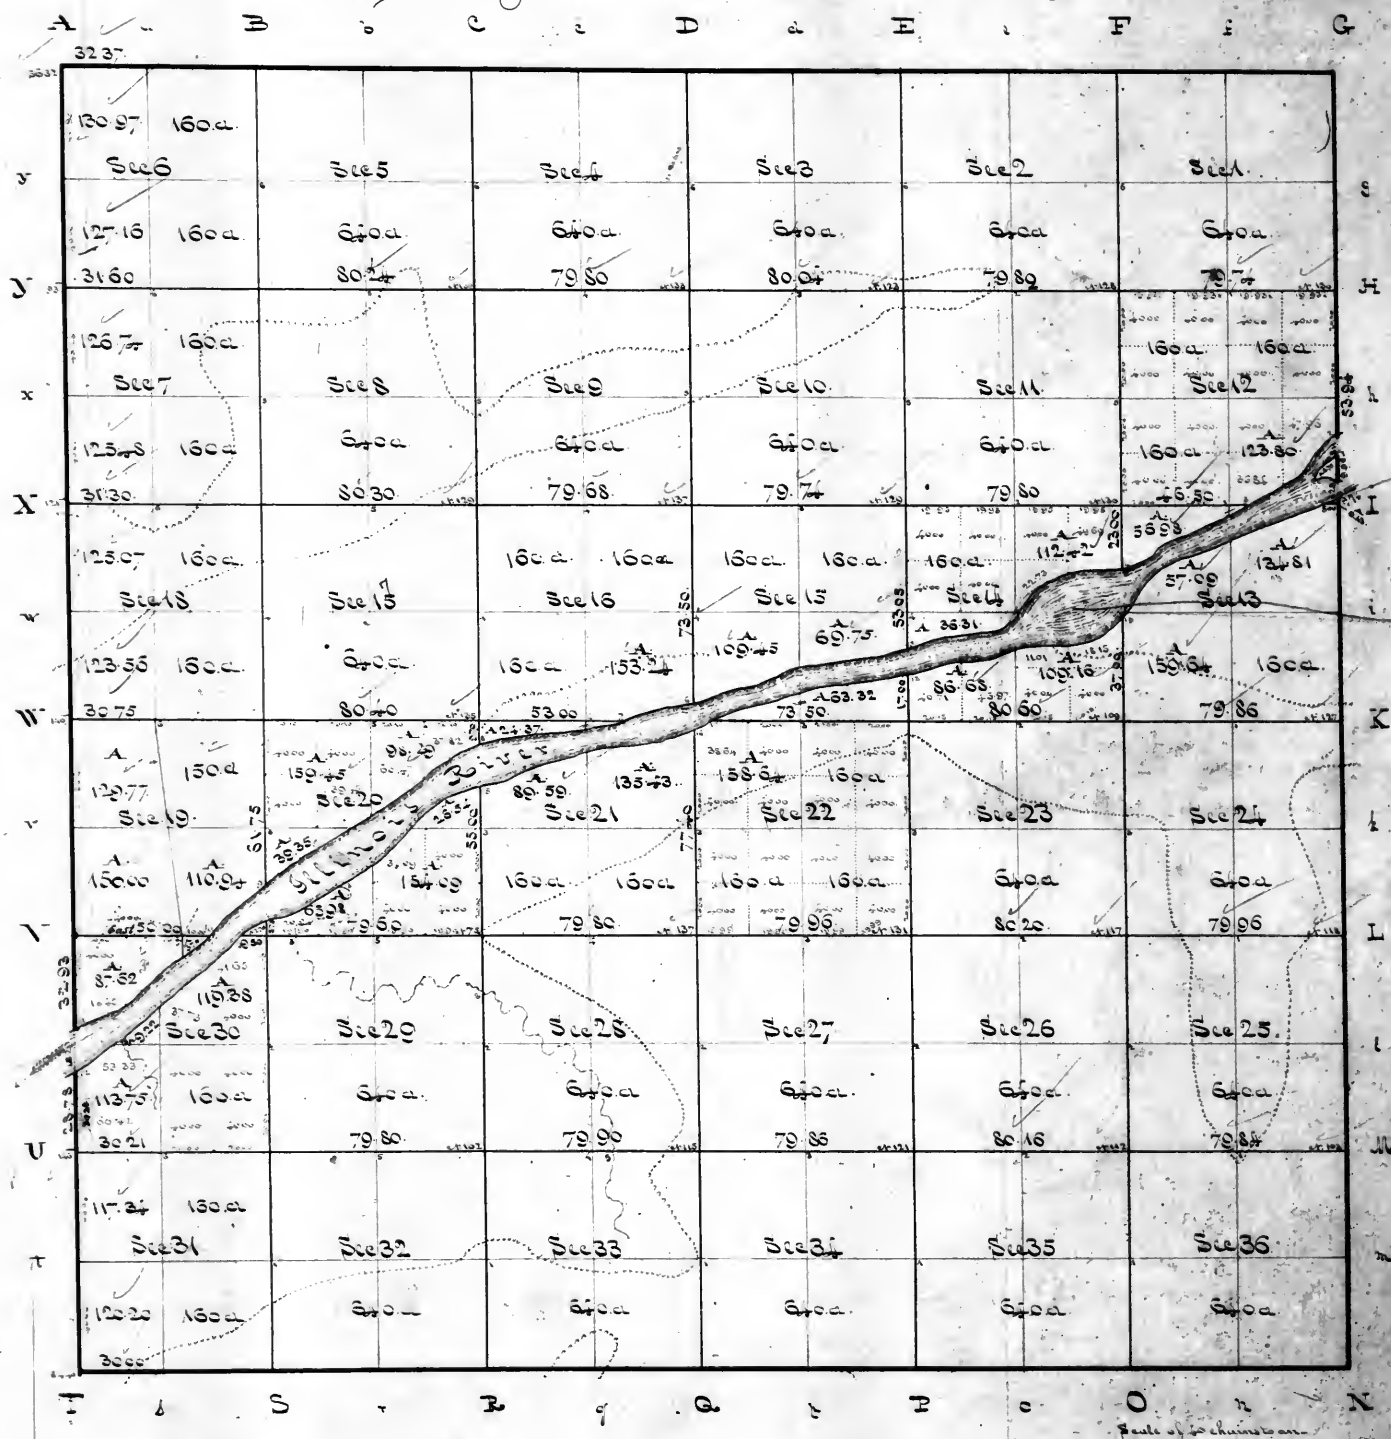


Surveyors Office
St. Louis July 3/1834

The above Plat of Township 33 North of the base line, Range 6 East of the 3^d principal Meridian, is conformable to the field notes of the survey thereof on file in this Office. *E. J. L.*

ed. *E. J. Lapham*

FRACTIONAL TOWNSHIP No 35 NORTH of the BASELINE, RANGE No 6 EAST of the 3rd PRINCIPAL MERIDIAN.
South of the Indian Boundary.

53

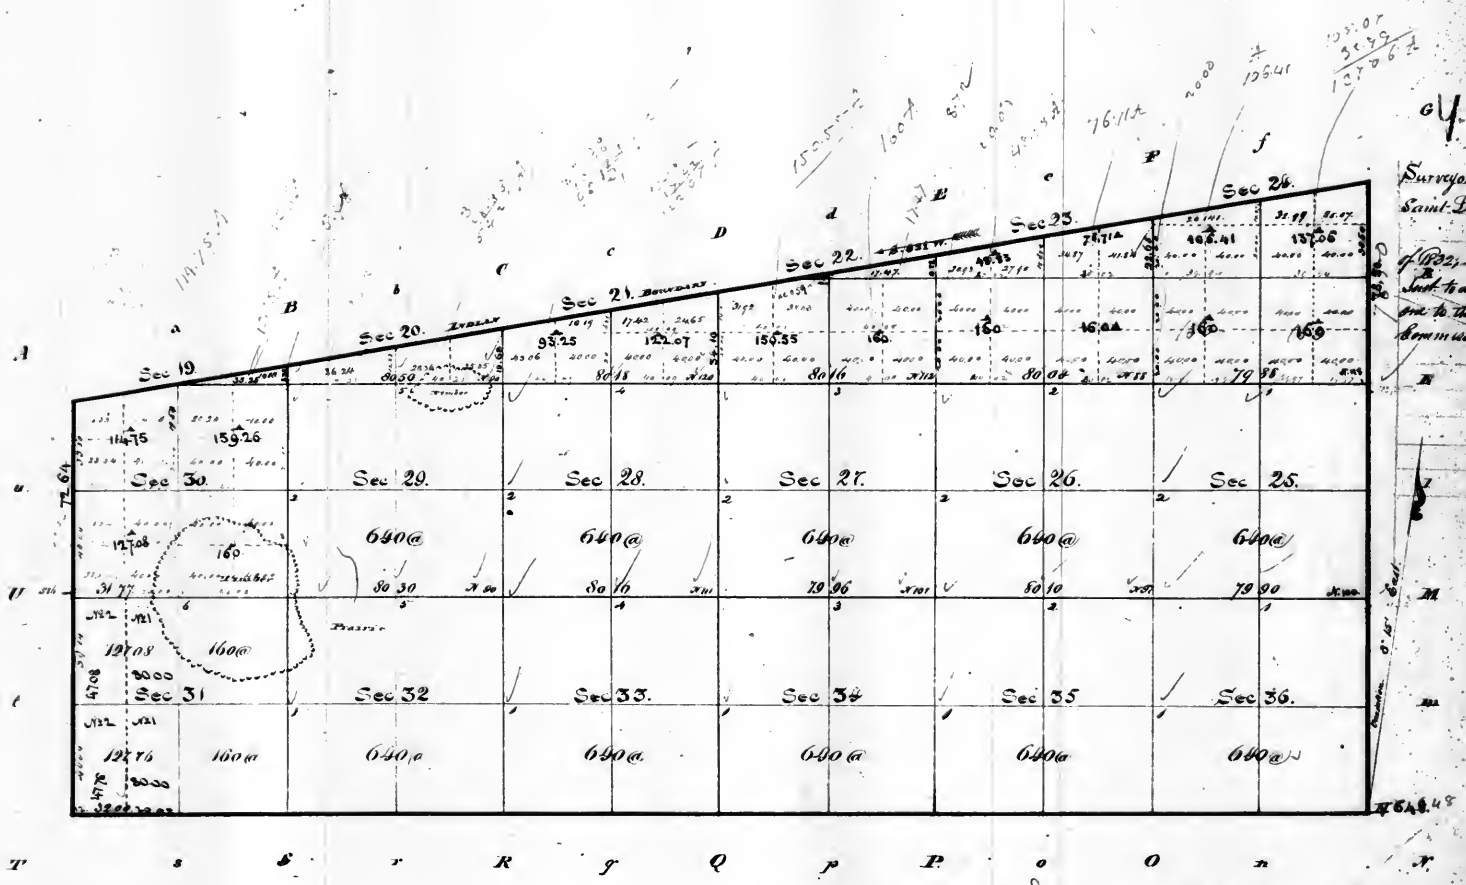

Surveyors Office
Saint Louis Mo.
Subdivided under the act
of 1820, by the act of 1834
and to day copies of the plat thereof
are in the Register and another for the
Department.

Exd 20.
June 1834


Surveyors Office
St. Louis June 27th 1834

The above Plat of fractional Township 35 North of the Baseline, Range 6 East of
the 3rd principal Meridian, and South of the Indian Boundary, is conformable to the field Notes of the Survey
thereof on file in this Office.

E. J. Sanborn

Fractional Township N. 35 North of the Base line in Range N. 6 East of the 3^d principal Meridian.

54

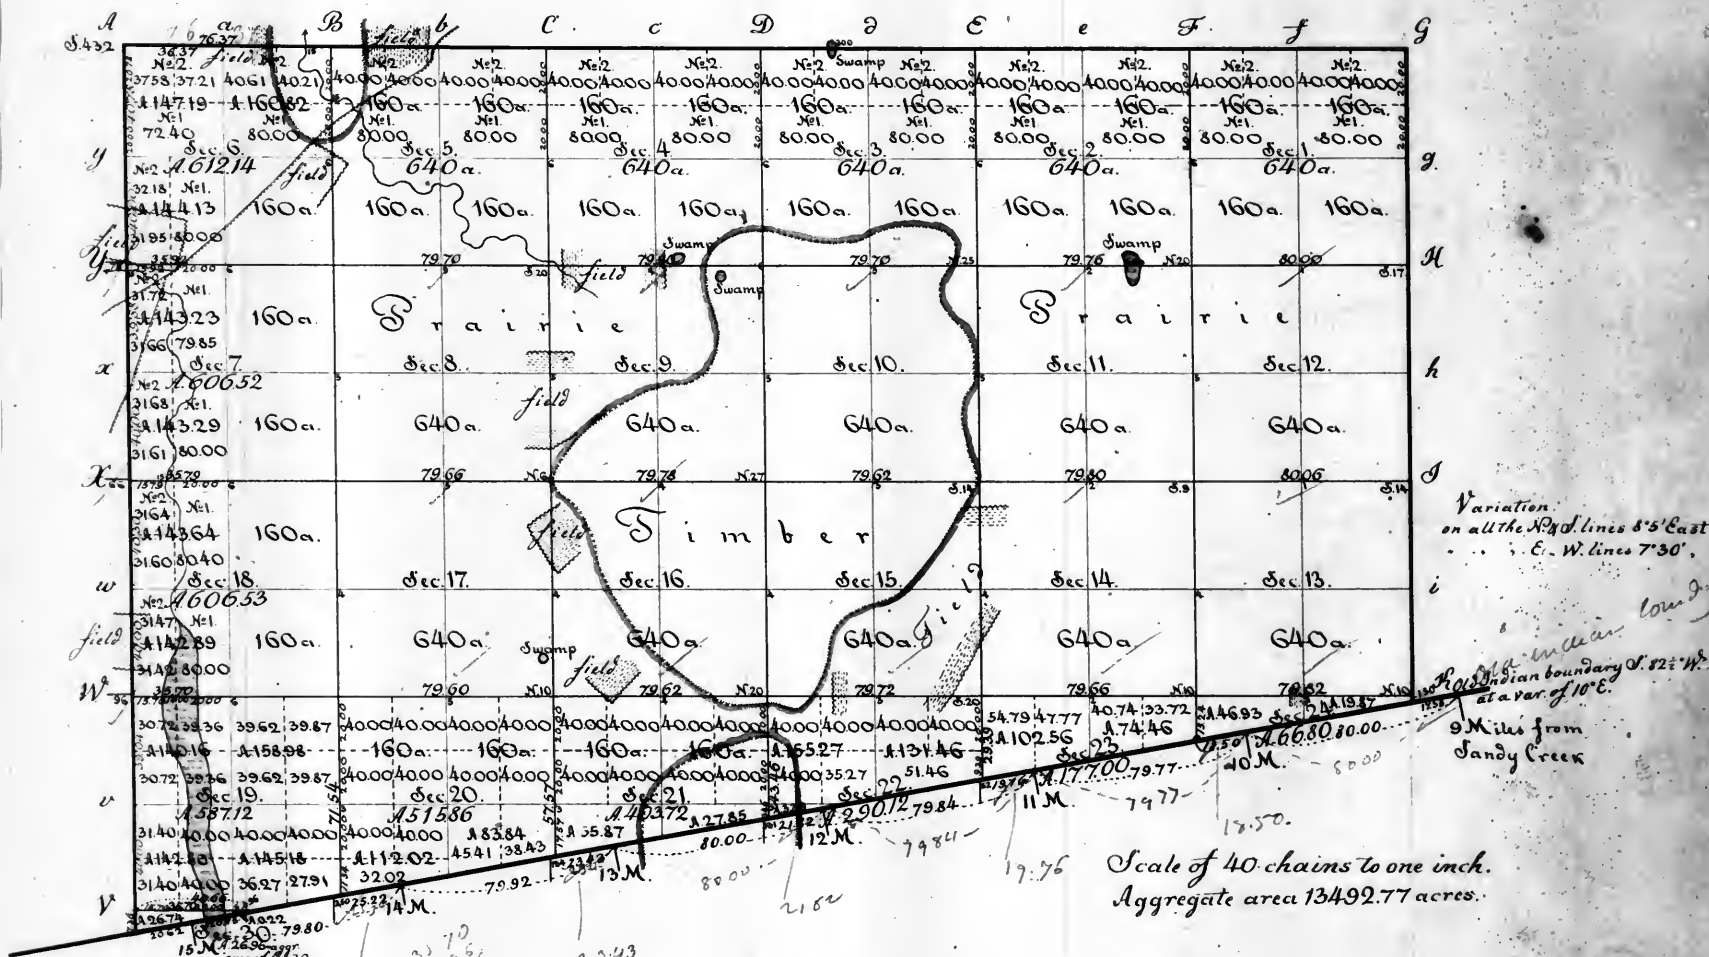


Surveyors Office.
Saint Louis 23rd of May 1839.

The above plat of fractional township 35 north of the base line range 6 east of the 3^d principal meridian, north of the old indian boundary is strictly conformable to the field notes of the survey thereof on file in this Office, which have been examined and approved. The Southern boundary which is designated 'old Indian boundary' was a resurvey in September 1821 - in order to close the surveys to the South thereof, under the contract of Stephen Rector and Thomas C. Rector of the 20th of March 1821, and was intended as a resurvey of the indian boundary (which could not be properly identified) that had been surveyed in the 4th quarter of 1818, by John C. Sullivan assisted by James W. Duncan from a point on Sandy creek 10 miles above its mouth 3.82 1/2 miles and 66 chains to a point on Fox river 10 miles above its mouth, under a letter of appointment dated October 18th 1818, for running the lines of the treaty of Saint Louis of the 24th of August 1804, between the United States and the United Nations of Illinois, Chippewas, and Pottawatimies - That part of said line as surveyed in 1821, which constitutes a boundary of this fractional township 6 miles 2.60 chains was resurveyed and the west boundary 4 miles 7.36 chains - the east boundary 3 miles 1.50 chains - the north boundary 5 miles 76.37 chains were surveyed in the 4th quarter of 1837, and the subdivision lines 36 miles 1.67 chains were surveyed in the 2^d quarter of 1838, and with the exception of the line between sections 19 and 30 of the subdivision, all the lines of the fractional township were paid for in the fourth quarter of 1838, and charged in the account of the Surveyor General for that quarter voucher 965. - In the 3^d quarter of 1839, the survey of the line between sections 19 and 30 was corrected by Mr. Prescott - the field notes have been examined and approved, but not yet paid for - The last resurvey of the indian boundary and the survey of all the other lines of the fractional township, were by E. S. Prescott, under contract signed by the Surveyor General on the 8th day of May and by Mr. Prescott on the 3rd day of June 1837.

William Milburn
Surveyor General

Township No 36 North of the Base line in Range No 6 East of the 3^d principal Meridian.

55

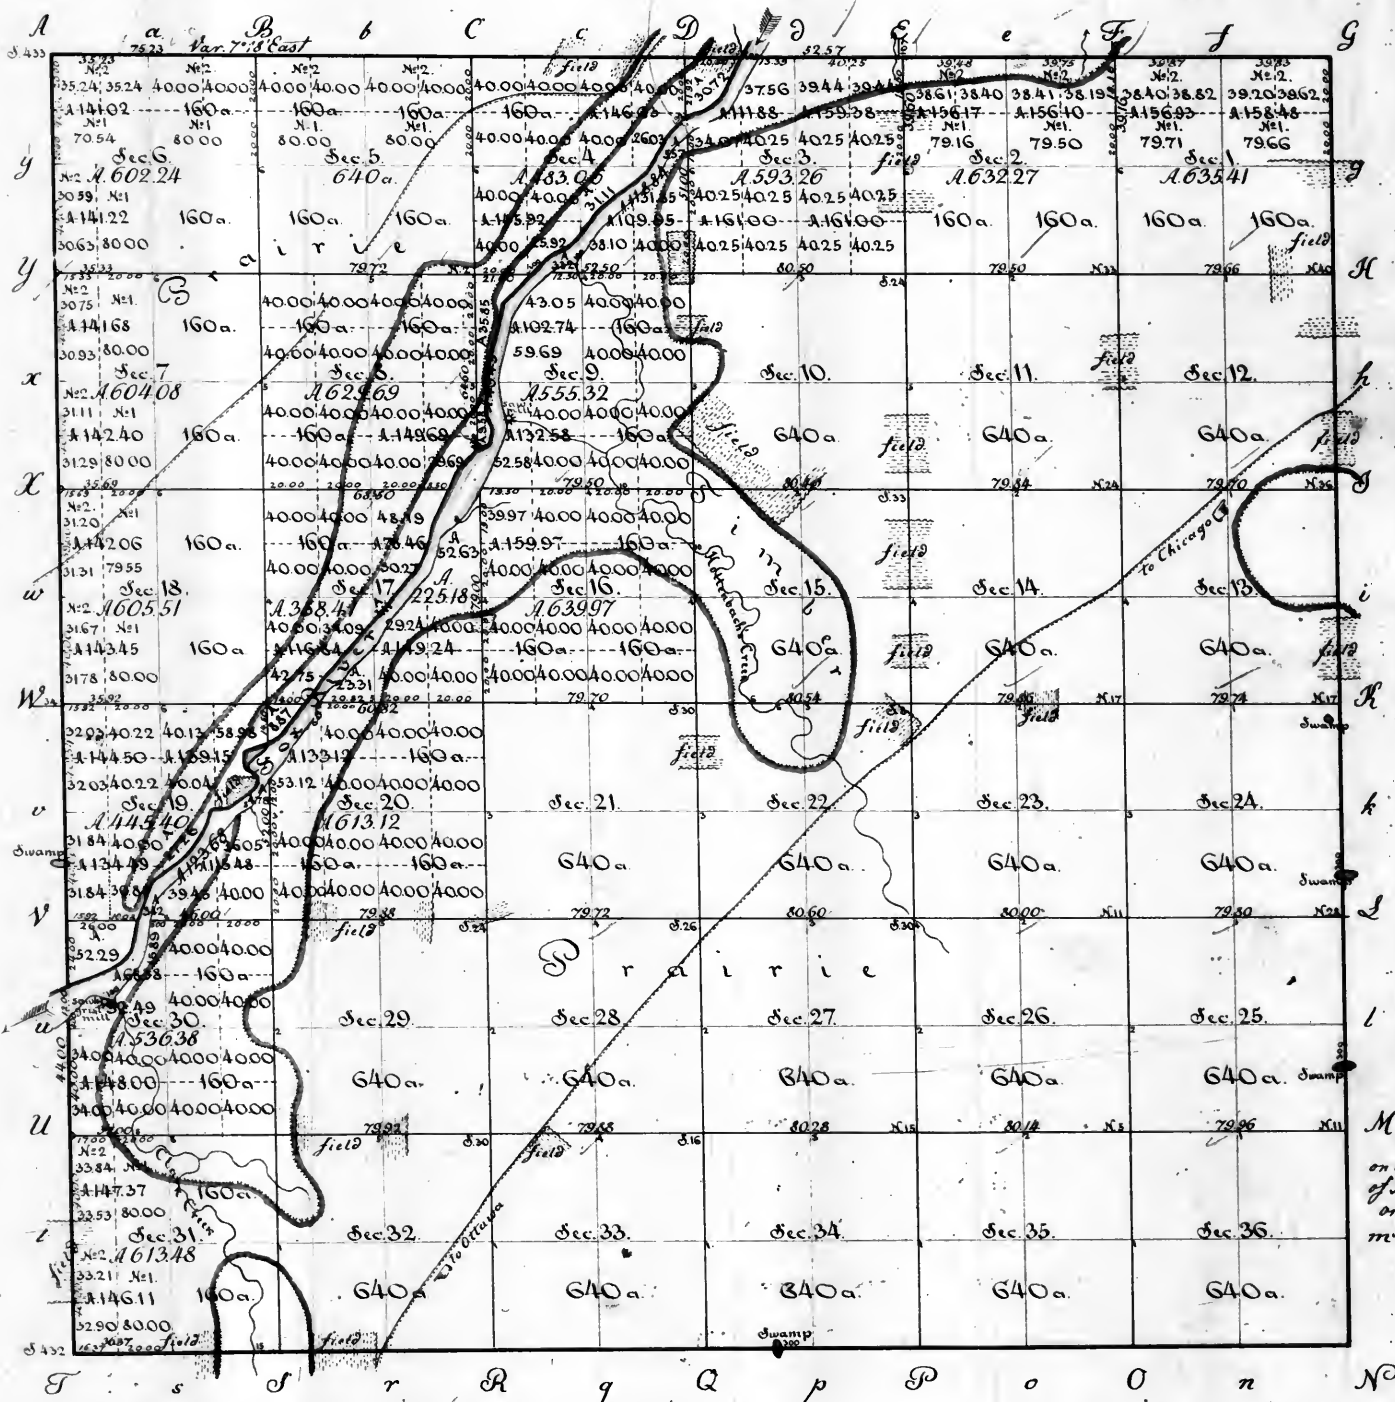

Variation:
on all the N&S lines and meanders
of Fox River 8.5 East
on all the E&W lines except the
North boundary 7.30 East.


Surveyor's Office.
Saint Louis 21st of May 1839.

Scale of 40 chains to one inch.
Aggregate Area 2259261 acres.

The above plat of Township 36 North of the base line, range 6 East of the 3^d principal meridian, is strictly conformable to the field notes of the survey thereof on file in this Office, which have been examined and approved - The west boundary, 6 miles - the South boundary 5 miles 76.37 chains - the east boundary 6 miles - and the north boundary 5 miles 76.33 chains, were surveyed in the 4th quarter of 1837 - and the subdivision lines, 58 miles 73.38 chains - and meanders of both banks of Fox river, 11 miles 45.30 chains were surveyed in the 3^d quarter of 1838 - all by Ch. S. Prescott, under contract signed by the Surveyor General on the 5th of May and by said Prescott on the 3^d day of June 1837 - They were paid for in the 4th quarter of 1838, and charged on the account of the Surveyor General for that quarter - Voucher 285.

William Milburn
Surveyor General

Township N° 37 North of the Base line in Range N° 6 East of the 3rd principal Meridian.

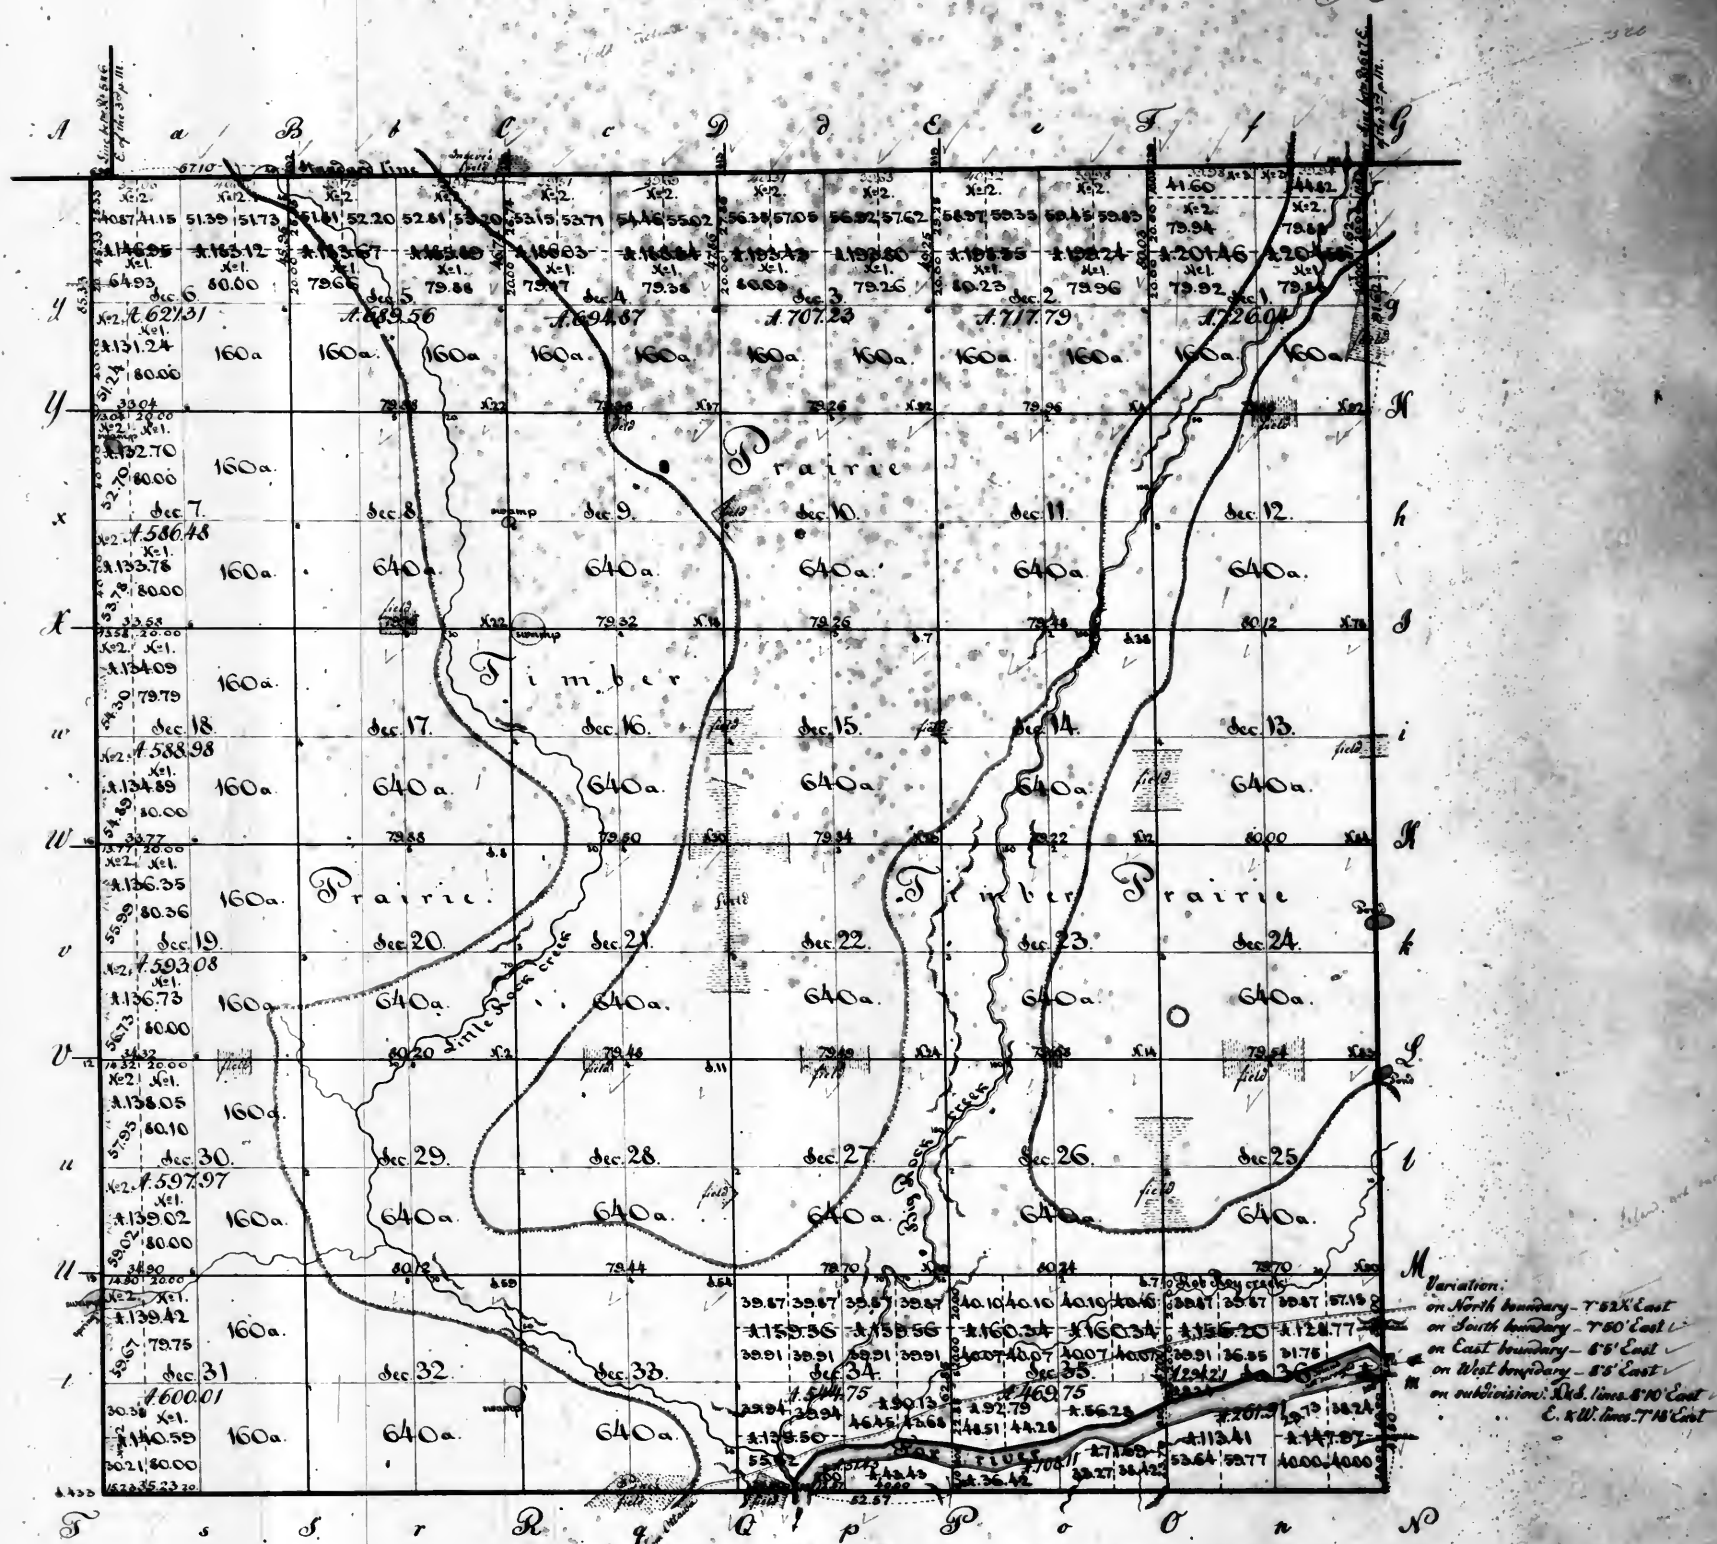

Scale of 40 chains to one inch.

area of public lands - 22933.48 acres

estimated area of river - 167.82 acres


Aggregate area of Township 23121.40 acres

Surveyors Office. Saint Louis 25th of August 1842.

The above plat of township 37 north of the base line, range 6 east of the 3rd principal meridian is strictly conformable to the field notes of the survey thereof on file in this office, which have been examined and approved. The south boundary 5 miles 75.43 chains, the east boundary 6 miles 11.62 chains - the north boundary 5 miles 11.61 chains, and the west boundary 6 miles 5.33 chains, were all surveyed in the 4th quarter of 1837, by Eli S. Prouty, under a contract signed by the Surveyor General on the 8th May 1837, and by Mr. Prouty on the 3rd of June of the same year - they were paid for in the 4th quarter of 1838, and charged in the account current of the Surveyor General during that quarter, Branch N° 5 - The subdivision lines, 60 miles and 67 links, and the meanders of both banks of Fox river, 5 miles 62.70 chains, were surveyed in August 1838, by James H. Reed, for Eli S. Prouty, without authority from, or a contract with the Surveyor General; but the field notes thereof have been received for accommodation upon their own merits, in virtue of the directions contained in the letter of the Commissioner of the Public Land Office, to Surveyor General McWhorter, dated 25th June 1840 - and Mr. Reed's notes having been examined and approved - and the Commissioner of the General Land Office, in his letter to Surveyor General Reed, dated 6th May 1842, having authorized him to pay therefor, the said subdivision lines and meanders were then paid out of the general surveying appropriation - and they will be charged in the account current of the Surveyor General, during this 3rd quarter of 1842, Branch N° 5 but for the letter of the Commissioner of the General Land Office of the 25th of July 1842, withholding the said payment for the same then assigned, and which is not here upon Mr. Reed's charge.

Silas Reed
Surveyor of the public lands in
the State of Missouri.

Township No 38 North of the Base line in Range No 6 East of the 3^d principal Meridian.

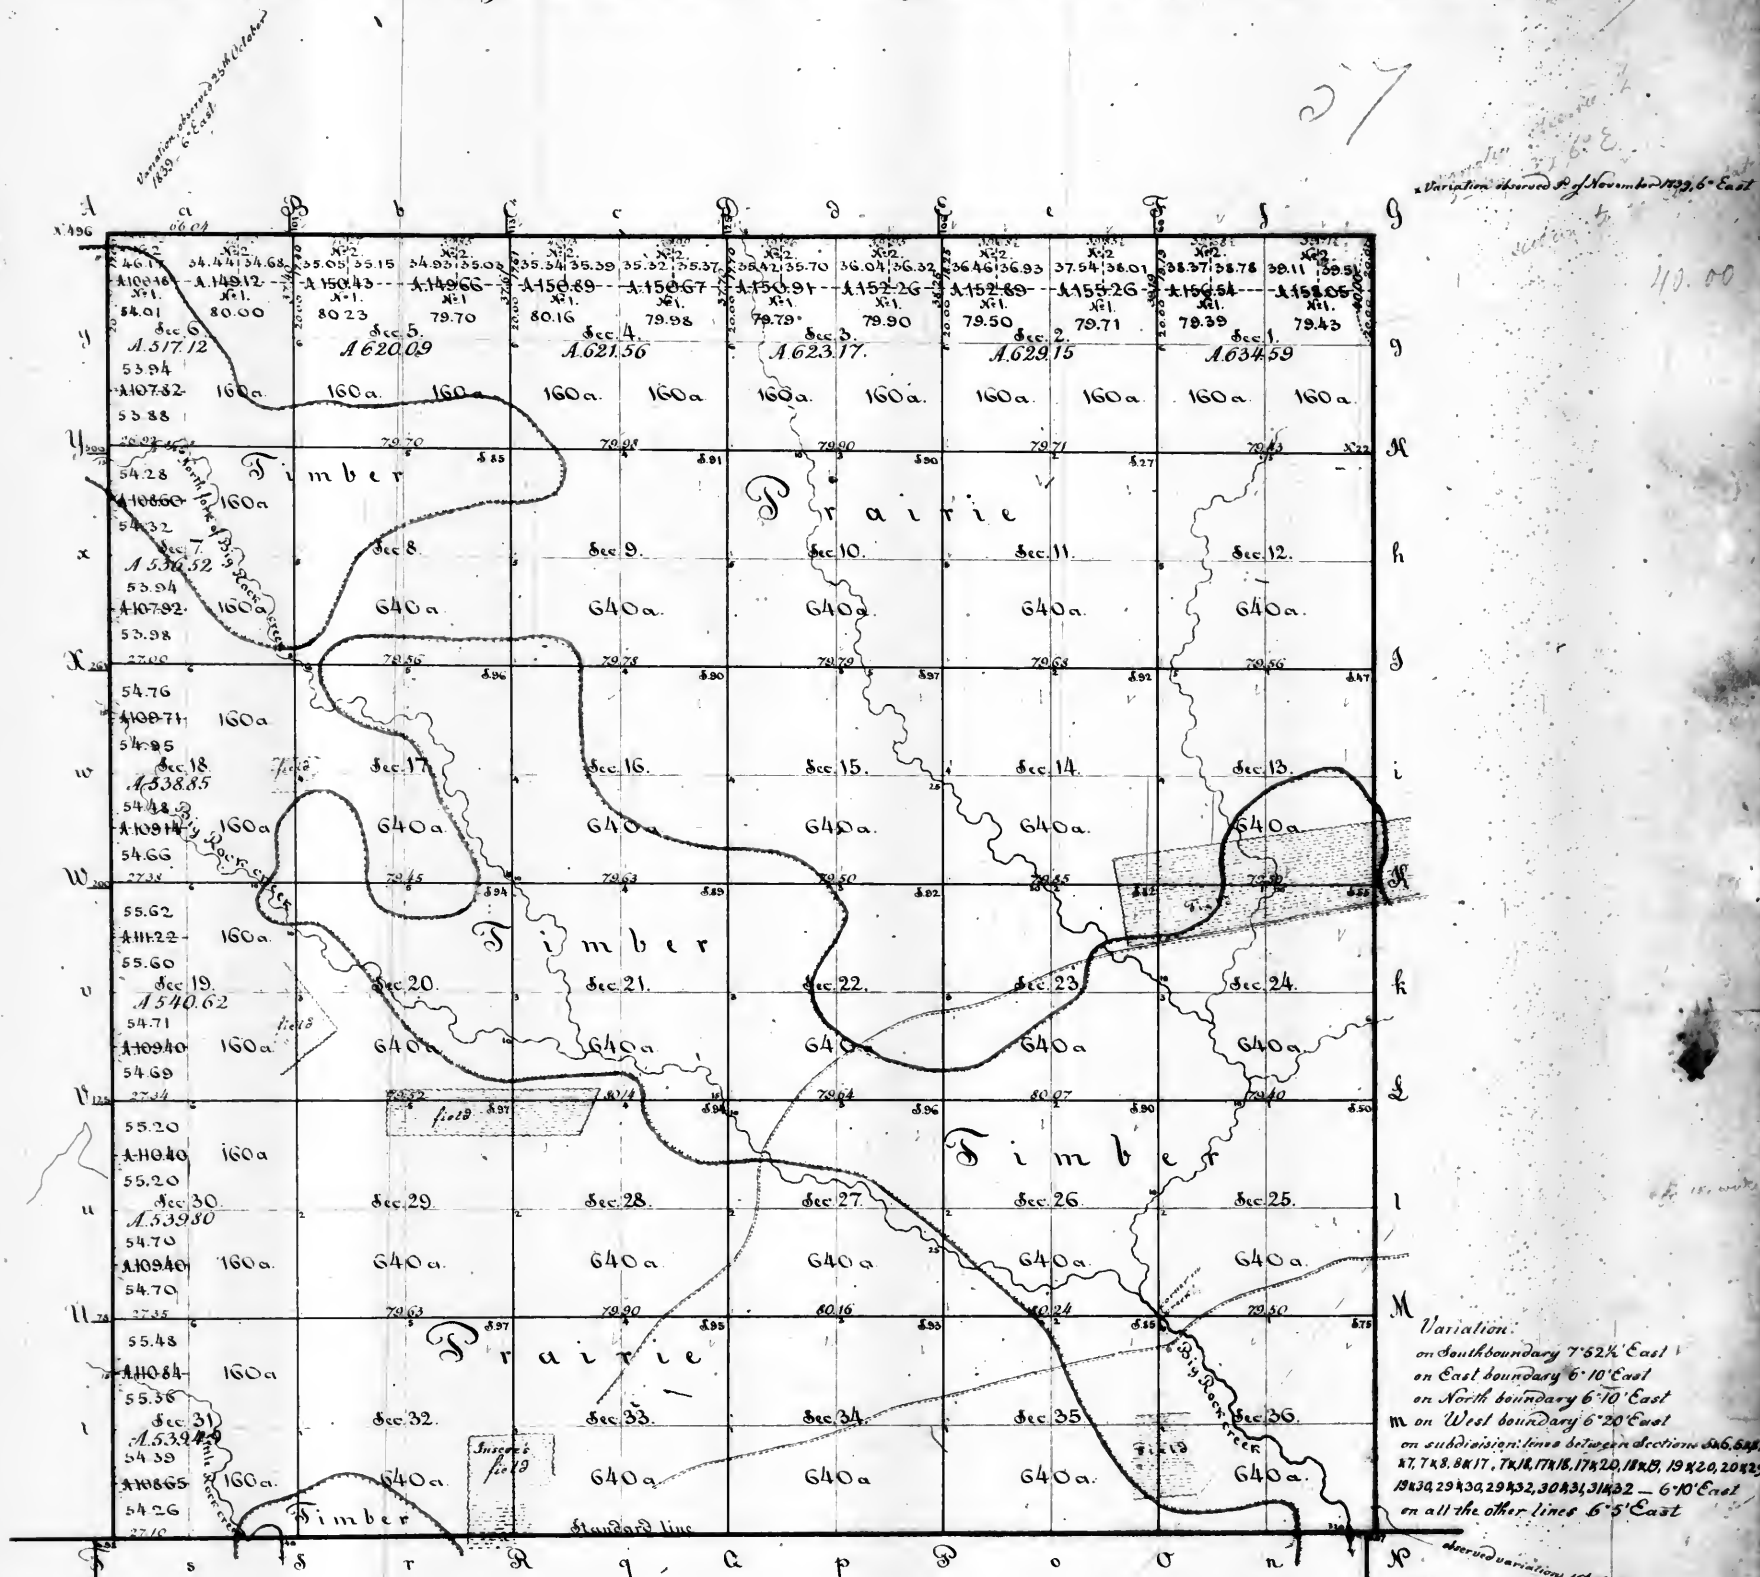

Surveyors Office
Saint Louis 29th of September 1840.

The above plat of township 38 north of the base line in range 6 east of the 3^d principal meridian is strictly conformable to the field notes of the survey thereof on file in this office which have been examined and approved. The South boundary 5 miles and 67.10 chains was surveyed by Eli S. Prescott in the 4th quarter of 1837, under contract signed by the Surveyor General on the 8th of May, and by 276th Patent on the 3rd of June 1837:—it was paid for in the 4th quarter of 1838, and charges in the account of the Surveyor General for that quarter. Voucher No 5.—The east boundary 6 miles — The west boundary 6 miles — the north boundary 5 miles and 66.04 chains, — and the subdivision lines 53 miles 79.38 chains, were all surveyed in the 4th quarter of 1839 by James Thompson and John P. Thompson, under their first contract of the 21st of September 1839. These surveys by Messrs Thompson, were paid for in this 3rd quarter of 1840, and they will be charged in the account current of the Surveyor General, during the said quarter, under the general appropriation for surveying the public lands. Voucher No 7.

William Melburn


Surveyor of the public lands in the
State of Missouri.

[Signature]

Township 30 North of the base line Range 6 East of the 2nd principal Meridian

58.

58.

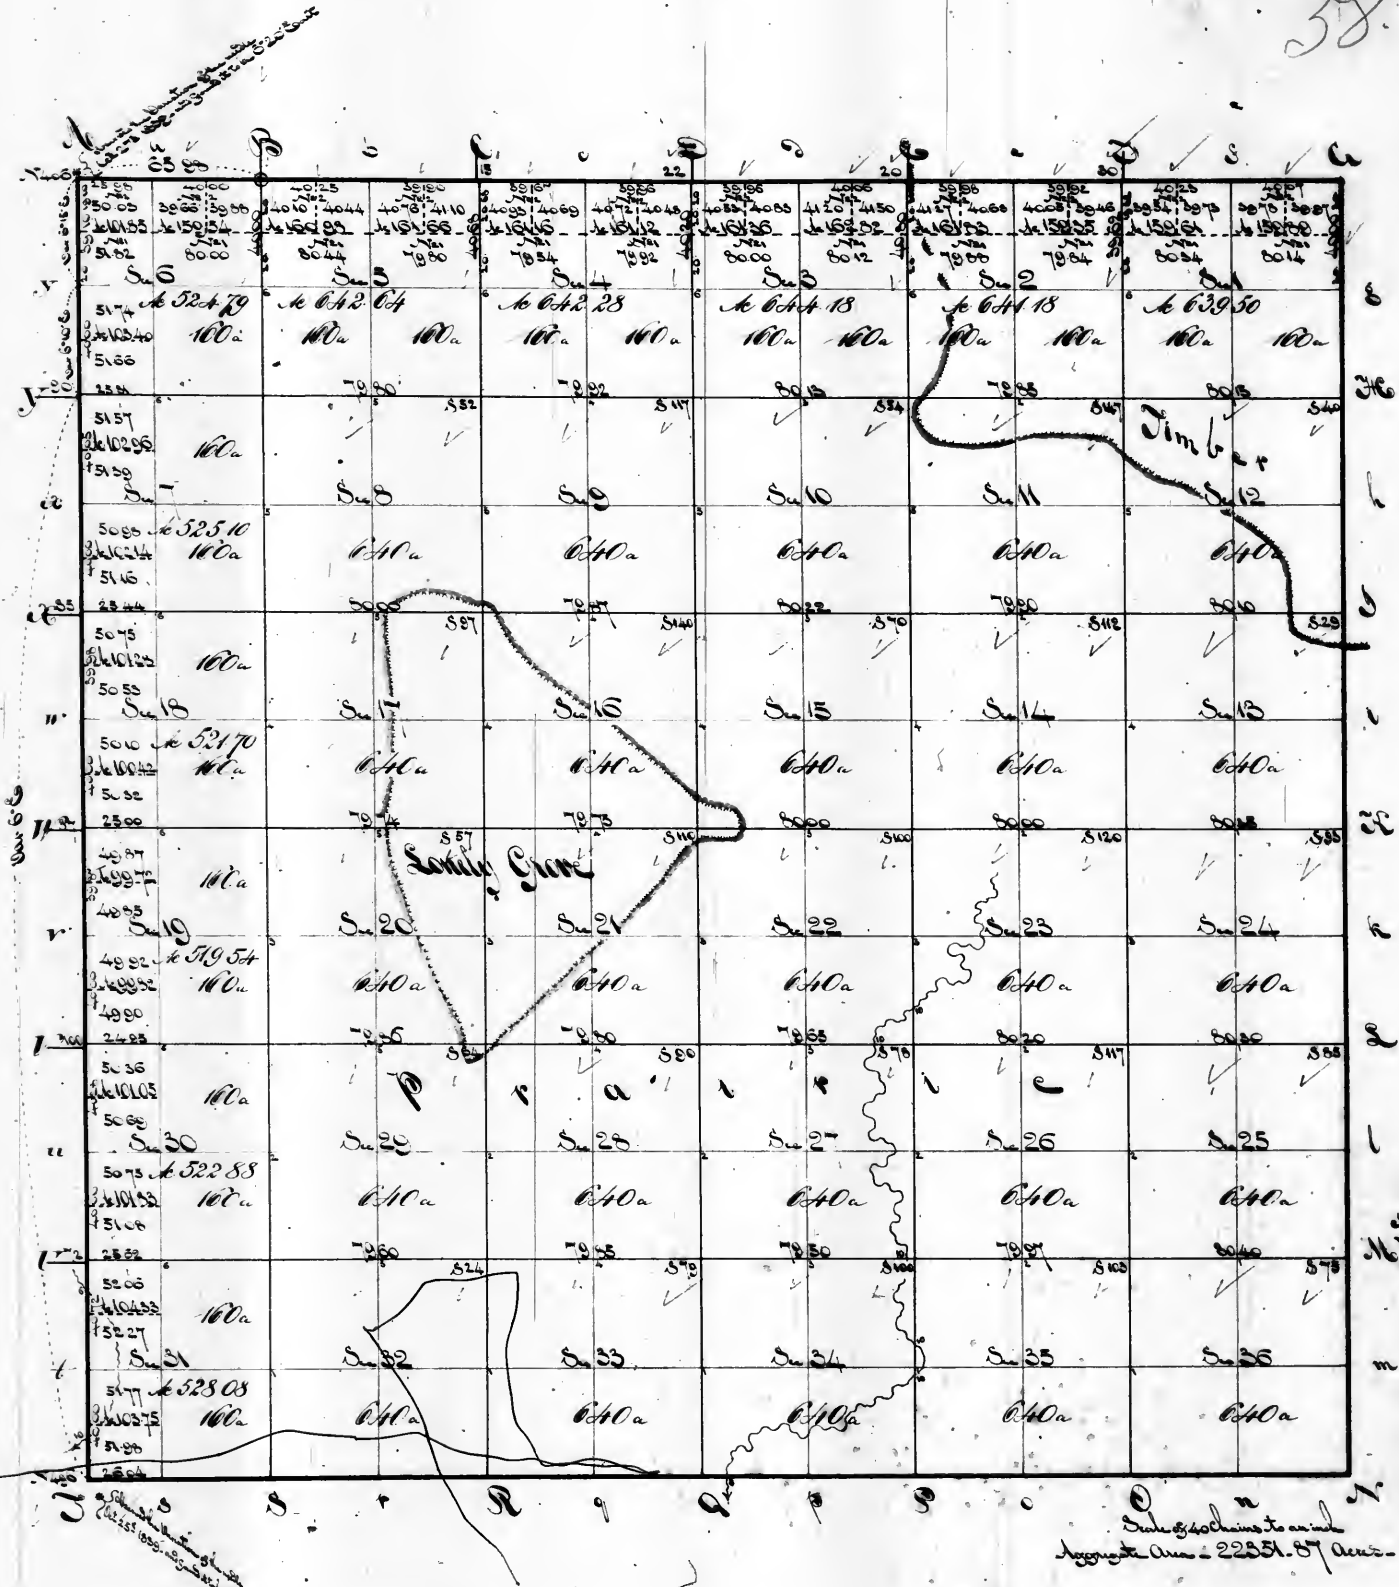

Surveyors Office Saint-Louis 25th of August 1842.


The above plat of township 30 north of the base line, range 6 east of the 2nd principal meridian is strictly conformable to the field notes of the survey thereof on file in this office which have been examined and approved. The south boundary 5 miles 66.04 chains - the east boundary 6 miles - the north boundary 5 miles 65.03 chains - and the west boundary 6 miles, were surveyed in the 2nd quarter of 1839, by James Thompson and John P. Thompson, under the joint contract of the 21st of September 1839 - they were paid for in the 3rd quarter of 1840, and charged in the account current of the Surveyor General during the same quarter, Voucher No. 17 - The subdivision lines 59 miles 7.03 chains were surveyed in the 4th quarter of 1840, by James Thompson and John P. Thompson, under their joint contract of the 18th of September 1840 - they were paid for in the 2nd quarter of 1842 and charged in the account of the Surveyor General during the said quarter, Voucher No. 7.

Silas Reed

Surveyor of the public lands in
the States of Illinois and Missouri.

Township 40 North Range 6 East of the 3rd principal Meridian

59

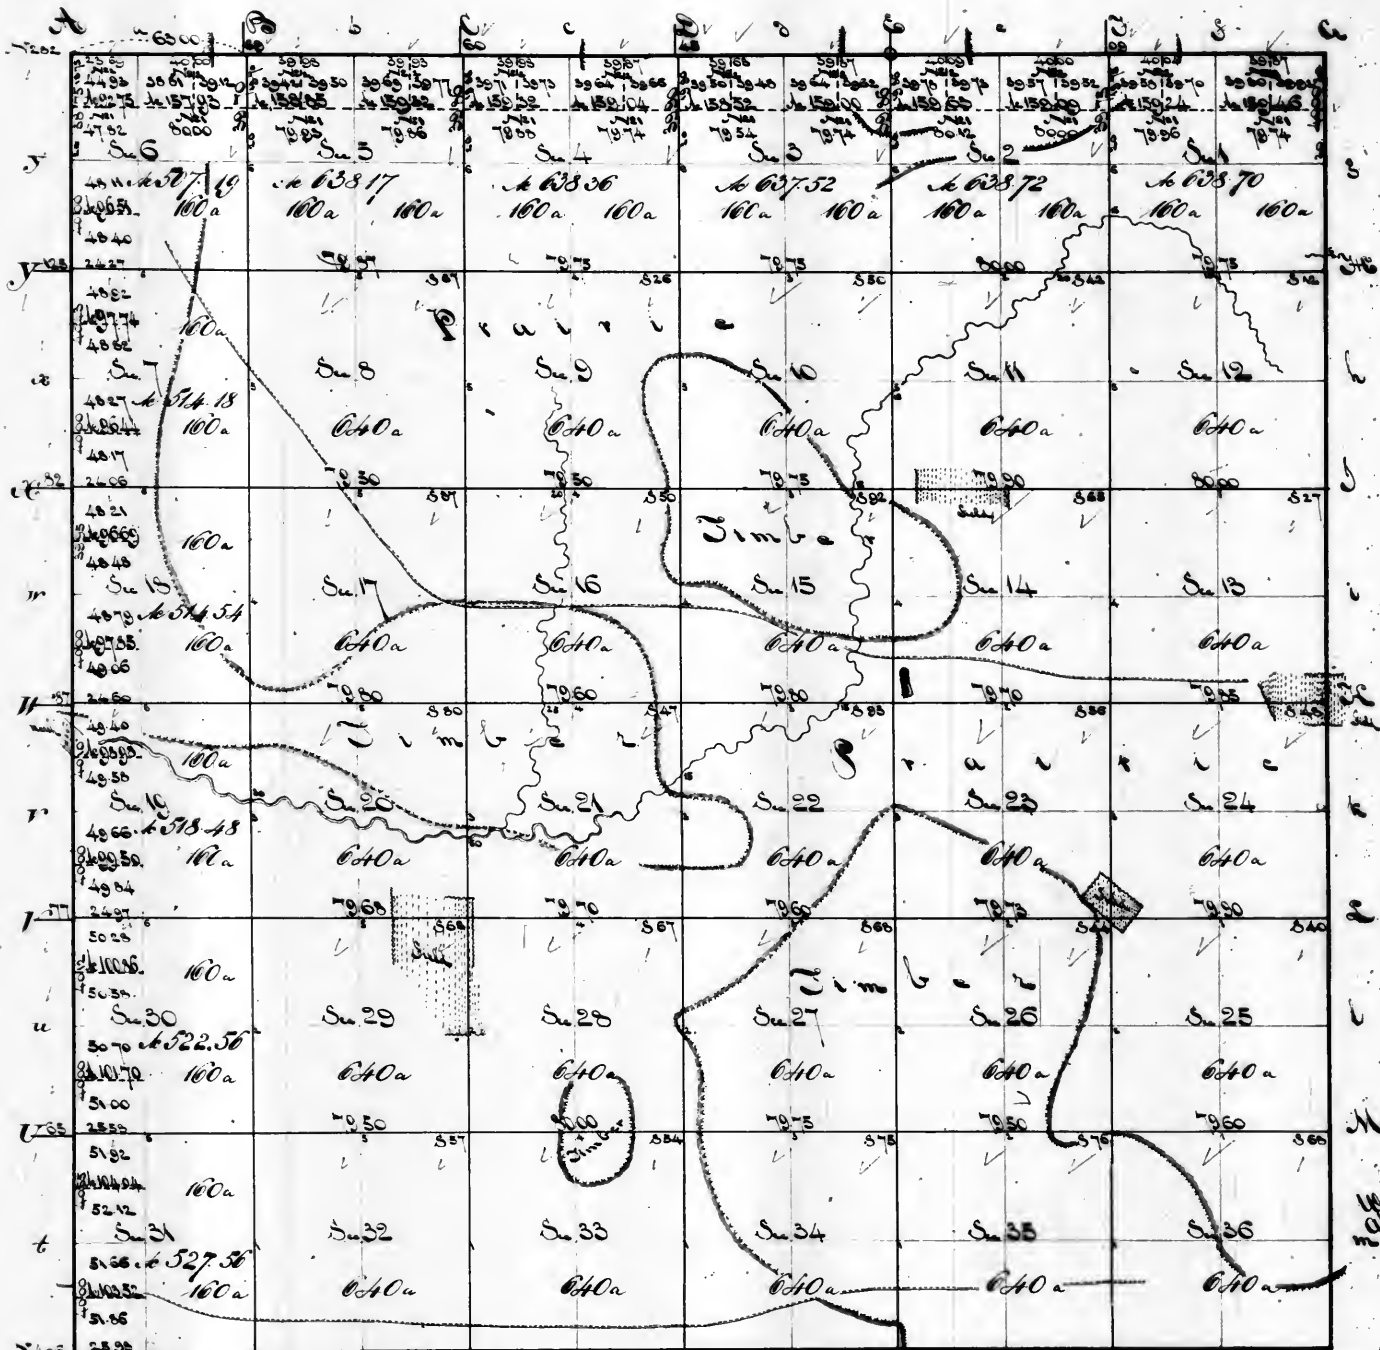

Division
West boundary 6° 20' East
All other lines 6° 10' East

Scale of 40 chains to an inch
Aggregate Area - 22285.98 acres

Surveyors Office.

Saint Louis 25th of August 1842.

The above plat of township 40 north of the base line, range 6 east of the 3^d principal meridian is strictly conformable to the field notes of the survey thereof on file in this office which have been examined and approved. The south boundary 5 miles 65.93 chains - the east boundary 6 miles - the north boundary 5 miles and 63.42 chains - and the west boundary 6 miles, were surveyed in the 4th quarter of 1839, by James Thompson and John P. Thompson, under their joint contract of the 21st of September 1839. They were paid for in the 3^d quarter of 1840, and charged in the account current of the Surveyor General, during the same quarter, Voucher No. 17. The subdivision lines 59 miles 76.03 chains were surveyed by James Thompson and John P. Thompson in the 4th quarter of 1840, under their joint contract of the 18th of September of that year. They were paid for in the 3^d quarter of 1842, and charged in the account current of the Surveyor General during the said 3^d quarter, Voucher No. 7.

Silas Reed

Surveyor of the public lands in
the State of Illinois and Missouri.

60



Surveyors office. Saint Louis 25th of August 1842.

Scale of 40 chains to an inch
Aggregate Area - 21525.24 acres


The above plat of township 41 north of the base line, range 6 east of the 3^d principal meridian is strictly conformable to the field notes of the survey thereof on file in this office which have been examined and approved - The north boundary, west of the range line, between ranges 5 & 6 is 56.20 chains was surveyed in the 2^d quarter of 1837, by Squibb Sprigg, under contract signed by the Surveyor General on the 21st of November, and by said Sprigg on the 18th of December 1833 - It was paid for in the 1st quarter of 1839, and charged in the account current of the Surveyor General during the said quarter, Voucher N^o 2 - The north boundary, east of the said range line, 5 miles and 7 chains was surveyed in the 2^d quarter of 1837, by James Thompson, under contract signed by the Surveyor General on the 21st of November and by Thompson on the 15th of December 1836 - It was paid for in the 1st quarter of 1839, and charged in the account of the Surveyor General during the said quarter, Voucher N^o 6 - The south boundary 5 miles and 63 chains, the east boundary 5 miles 64.90 chains, and the west boundary 5 miles and 67 chains were surveyed in the 4th quarter of 1839, by James Thompson and John P. Thompson, under their joint contract of the 21st of September 1839 - They were paid for in the 3^d quarter of 1840, and charged in the account current of the Surveyor General during the same quarter, Voucher N^o 15 - The subdivision lines 53 miles 1.73 chains, were surveyed in the 4th quarter of 1840, by James Thompson and John P. Thompson, under their joint contract of the 18th of September 1840 - They were paid for in the 3^d quarter of 1842, and charged in the account current of the Surveyor General during the said 3^d quarter, Voucher N^o 7.

Silas Reed

Surveyor of the public lands in
Illinois and Missouri.

Township 42 North of the base line Range 6 East of the 3^d principal Meridian

61

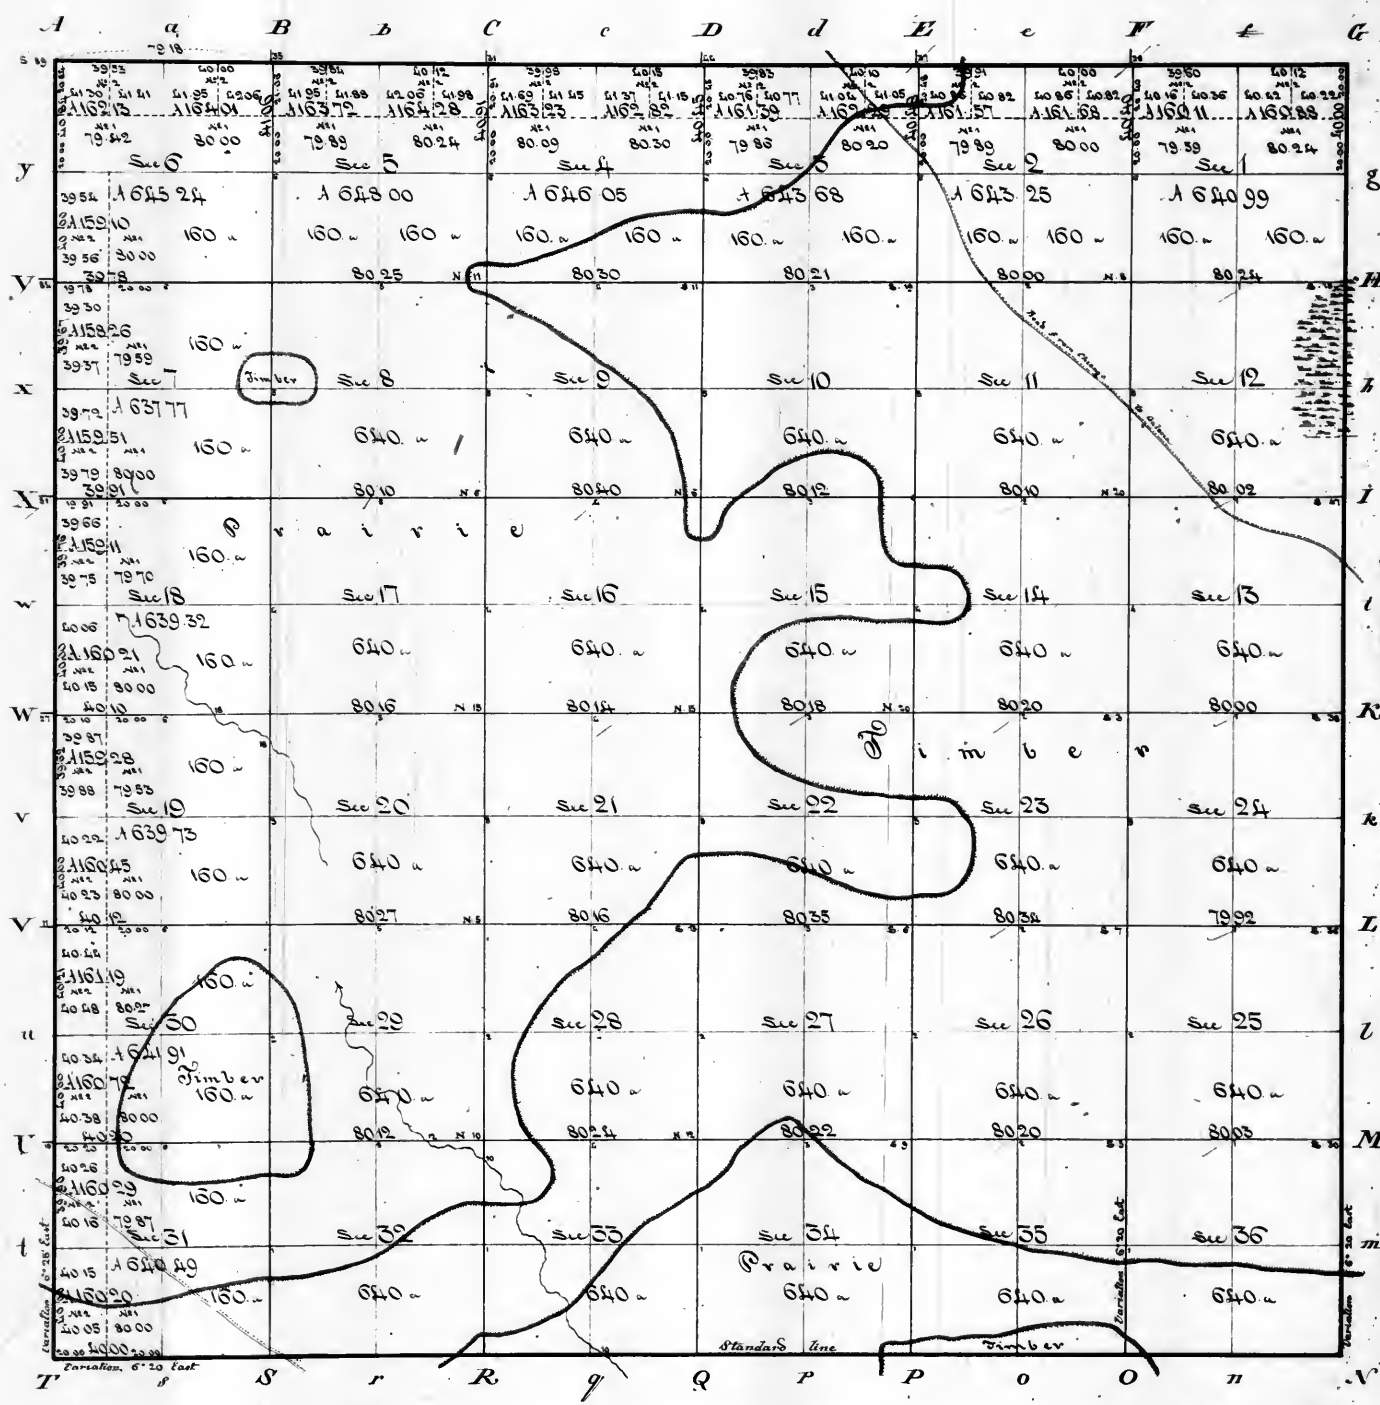

Note: The account of Mr. Sprigg, dated the 21st of November of 1836, is changed amount to \$ 2114.00 of which \$ 1778.75 was paid on the 6th day of February 1839. The account of Mr. Thompson, dated the 15th of December of 1836, is changed amount to \$ 125.00 of which \$ 100.00 was paid on the 15th day of February 1839.

Surveyors Office.
Saint Louis. 3^d May 1839

Scale of 40 Chains to an Inch.
Aggregate Area 23066.23 acres


The above plat of township 42 north of the base line, range 6 East of the 3^d principal meridian, is strictly conformable to the field notes of the survey thereof on file in this office, which have been examined and approved. The west boundary, 6 miles, was surveyed by Aquinas Sprigg in the 2^d quarter of 1837, under contract signed by the Surveyor General on the 21st of November 1836, and by the said Sprigg on the 15th of December of the same year; it was paid for, with the limitation noted in the margin, in the first quarter of 1838, and charged in the account of the Surveyor General for that quarter (Voucher 212). The South and east boundaries, 6 miles each; and the north boundary, 5 miles 79.18 chains, were surveyed in the 2^d quarter of 1837, and the subdivision lines, 60 miles 7.68 chains, were surveyed in the 3^d and 4th quarters of 1837 - all by James Thompson, under contract, signed by the Surveyor General on the 21st of November, and by the said Thompson on the 15th day of December 1836 - The surveys by Thompson were paid for in the 1st quarter of 1838, and charged in the account of the Surveyor General for that quarter. (Voucher 216.)

William Milburn
Surveyor General

Township 43 North of the base line Range 6 East of the 3^d principal Meridian

Copy

62

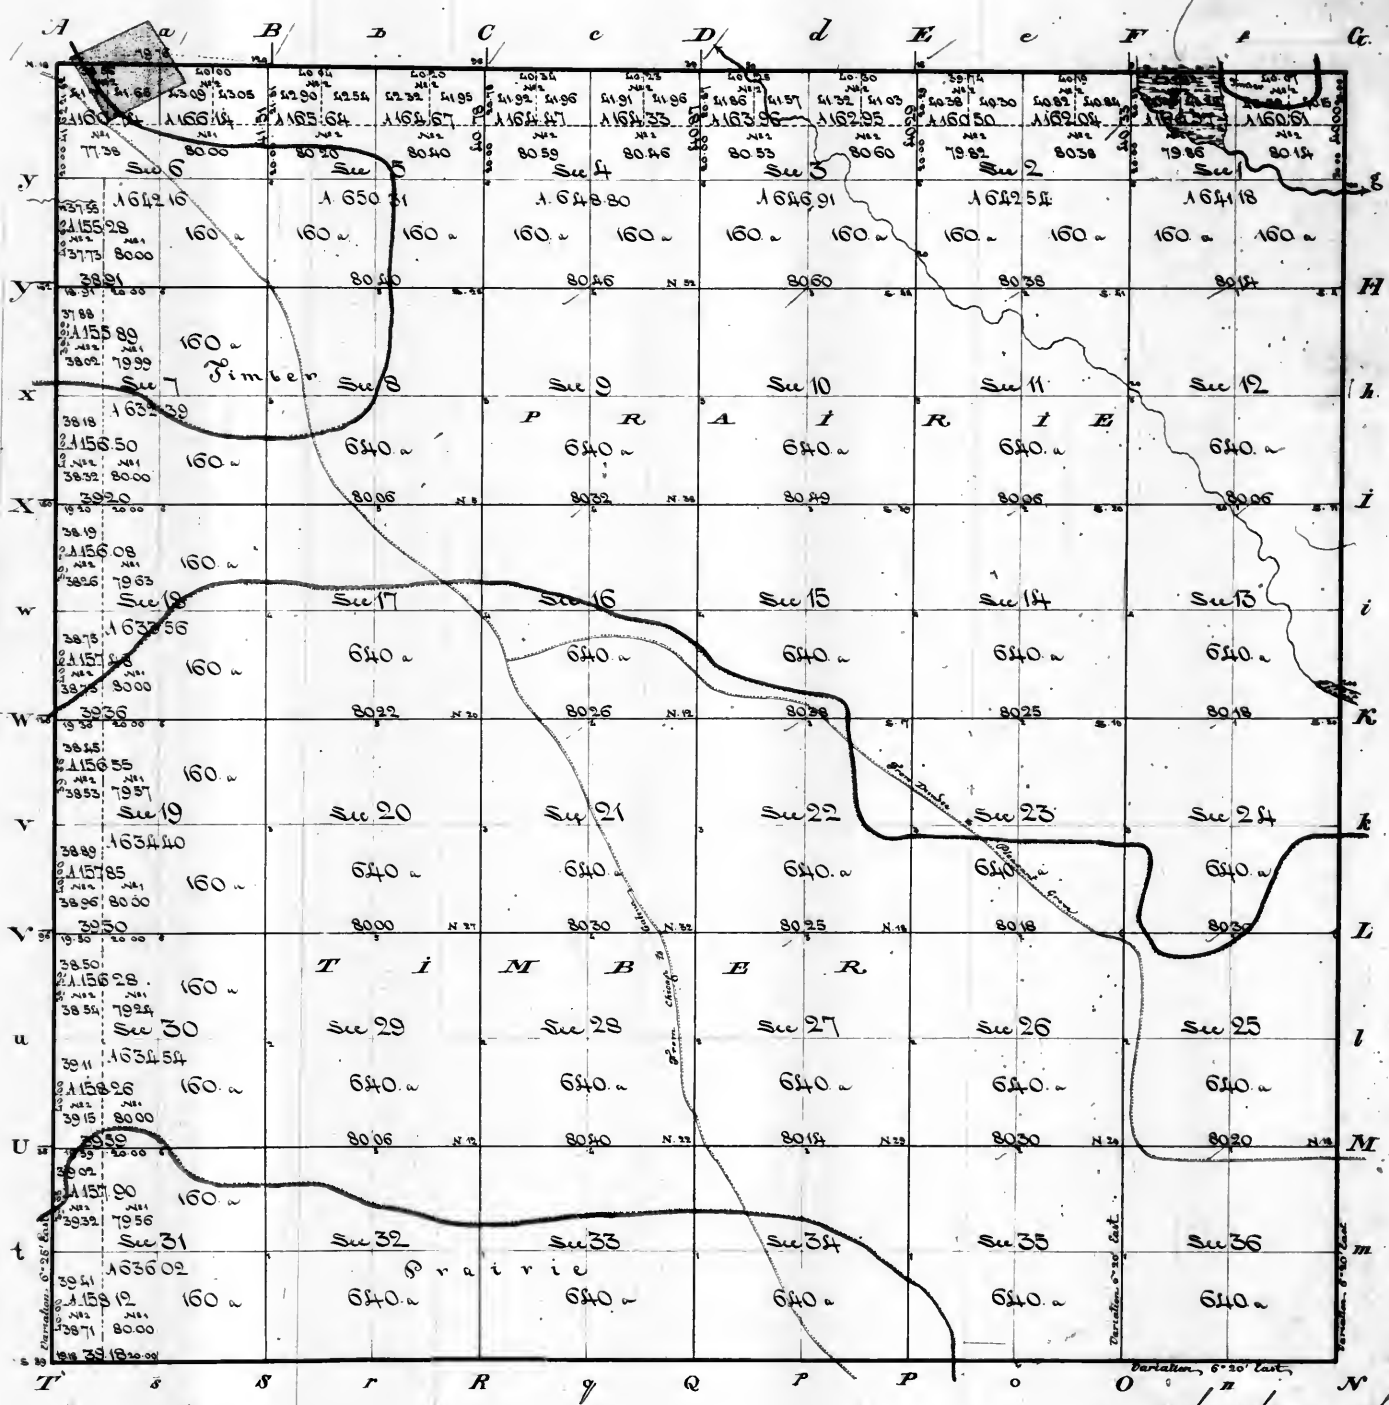

Note - The account of Mr. Sprigg in which the west boundary of this township is charged amounts to 2114 5/16, of which 1978 7/16 was paid in the 6th of February 1839 - The balance of said account (\$ 136 86/100) having been withheld to insure the speedy completion of the surveyed line.

Surveyors Office.
Saint Louis. 3 May 1839

Scale of 40 chains to an inch.
Aggregate area 23042.81 acres

The above plan of township 43 north of the base line, range 6 East of the 3^d principal meridian, is strictly conformable to the field notes of the survey thereof on file in this Office, which have been examined and approved. - The West boundary (6 miles) was surveyed in the 2^d quarter of 1827 by Squier Springs, under contract signed by the Surveyor General on the 21st day of November, and by the said Springs on the 15th of December 1826; and with the limitation noted in the margin was paid for in the 3^d quarter of 1829 and charged in the accounts of the Surveyor General for that quarter - (Voucher No 2.) - The South boundary (5 miles 79.13 chains) - the east boundary (6 miles) - and the north boundary (5 miles 79.16 chains) were surveyed in the 2^d quarter of 1827 - and the Subdivision lines (60 miles 6.73 chains) were surveyed in the 2^d quarter of 1827 - all by James Thompson, under contract signed by the Surveyor General on the 21st of November, and by Thompson on the 15th of December 1826 - the surveys by Thompson were paid for in the 3^d quarter of 1829, and charged in the accounts of the Surveyor General for that quarter - (Voucher No 6.)


William Milburn
Surveyor General

Ex. 2 May 1839

Township 44 North of the base line Range 6 East of the 3^d principal Meridian

63.

63

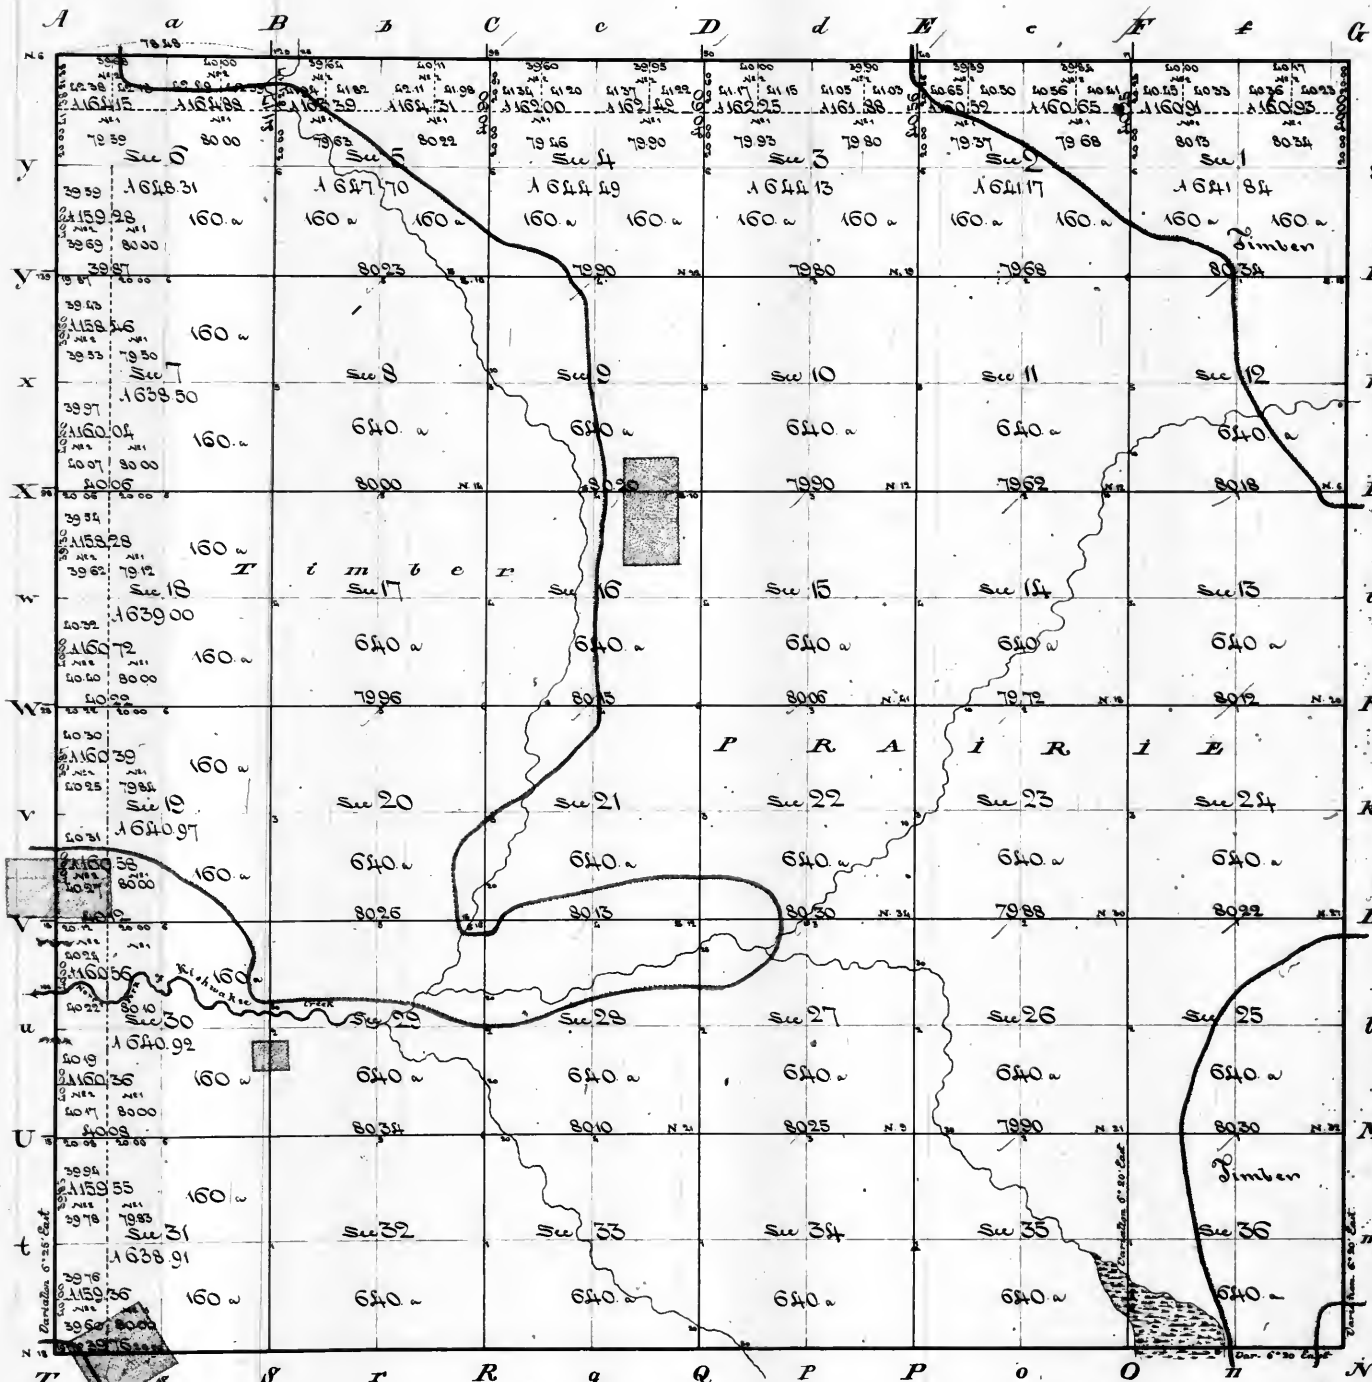

Note. The account of Mr. Sprigg, in which the west boundary of this township is charged amounts to \$2114.63 for the 1972-76 line was paid on the 6th day of February 1839 - the balance of his account (\$155.86) having been withheld to cover the surveying of the township line.

Surveyors Office.


St. Louis 3 May 1839

The above plat of township 44 north of the base line range 6 east of the 3^d principal meridian is strictly conformable to the field notes of the survey thereof on file in this office, which have been examined and approved. - The west boundary (6 miles) was surveyed in the 2^d quarter of 1827, by Ignatius Sprigg, under contract signed by the Surveyor General on the 21st of November, and by the said Sprigg on the 15th of December 1826 - and with the limitation noted in the margin was paid for in the 3^d quarter of 1828 and charged in the account of the Surveyor General for that quarter (Voucher No. 2) - The South boundary (5 miles 79.76 chains) - The east boundary (6 miles) - and the north boundary (5 miles 78.33 chains) were surveyed in the 2^d quarter of 1827, and the subdivision lines (60 miles 5.37 chains) were surveyed in the 3^d quarter of 1827 - all by James Thompson under contract signed by the Surveyor General on the 21st of November, and by the said Thompson on the 15th of December 1826 - The surveys by Thompson were paid for in the 3^d quarter of 1828 and charged in the account of the Surveyor General for that quarter (Voucher No. 6)

William Melbourne
Surveyor General
24

Township 45 North of the base line Range 6 East of the 3^d principal Meridian

64

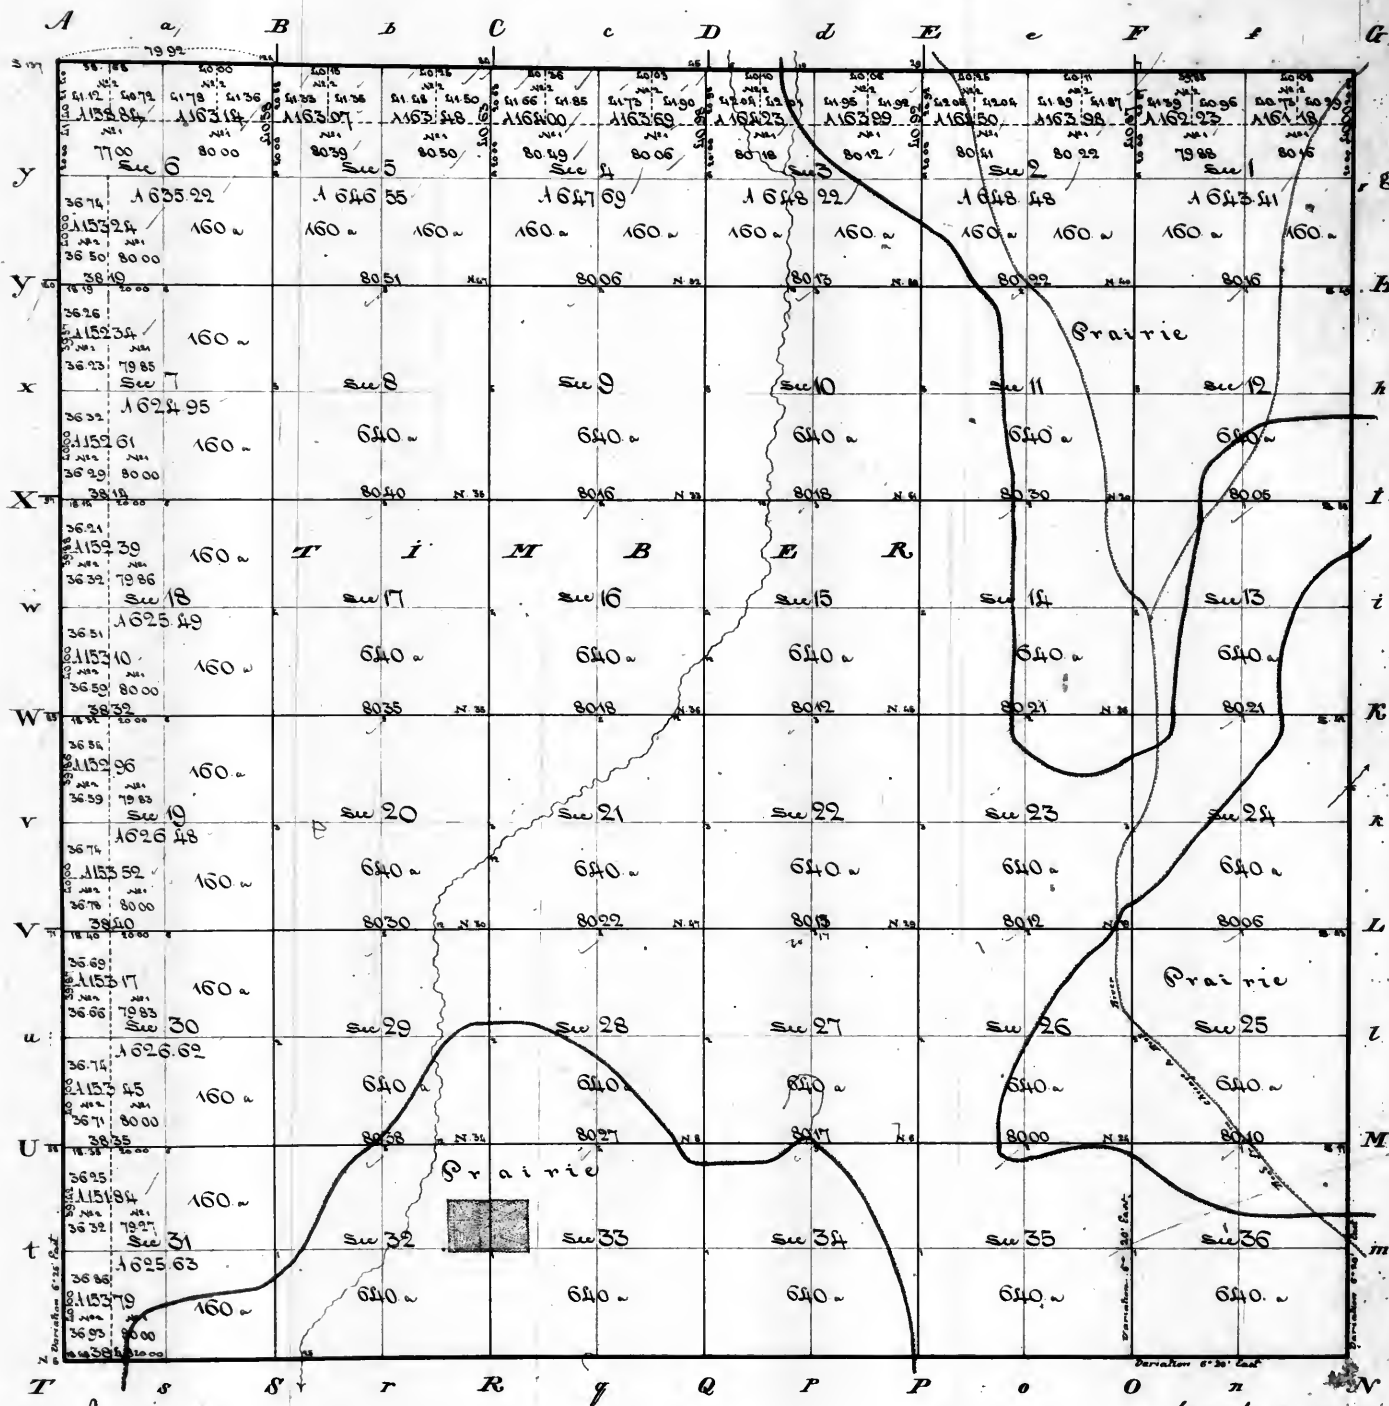


Surveyors Office.

Saint Louis 3^d of May 1839

The above plan of Township 45 North, of the base line, range 6 east of the 3^d principal meridian is strictly conformable to the field notes of the survey thereof on file in this Office, which have been examined and approved. The west boundary (6 miles) was surveyed in the 2^d quarter of 1827, by Squatens Sprigg, under contract signed by the Surveyor General on the 25th of November, and by the said Sprigg on the 15th of December 1826. it was, with the limitation noted in the margin, paid for in the 3^d quarter of 1829 and changed in the accounts of the Surveyor General for that quarter (Voucher 212). The South boundary (5 miles 73.48 chains) - The east boundary (6 miles) - and the North boundary (5 miles 79.92 chains) - were surveyed in the 2^d quarter of 1827, and the subdivision lines (60 miles and 30 lines) were surveyed in the 2^d and 3^d quarters of 1827, all by James Thompson, under contract signed by the Surveyor General on the 25th of November and by the said Thompson on the 15th day of December 1826. The survey by Thompson were paid for in the 3^d quarter of 1829, and changed in the accounts of the Surveyor General for that quarter (Voucher 216)

William Millburn
Surveyor General


Scale 1 inch = 1 mile
Approximate Area 27,998 7/8 acres

Ex - 2 May 1839

VOL. 28

Vol 24

Township 26 North of the base line Range 7 East of the 3rd principal Meridian.

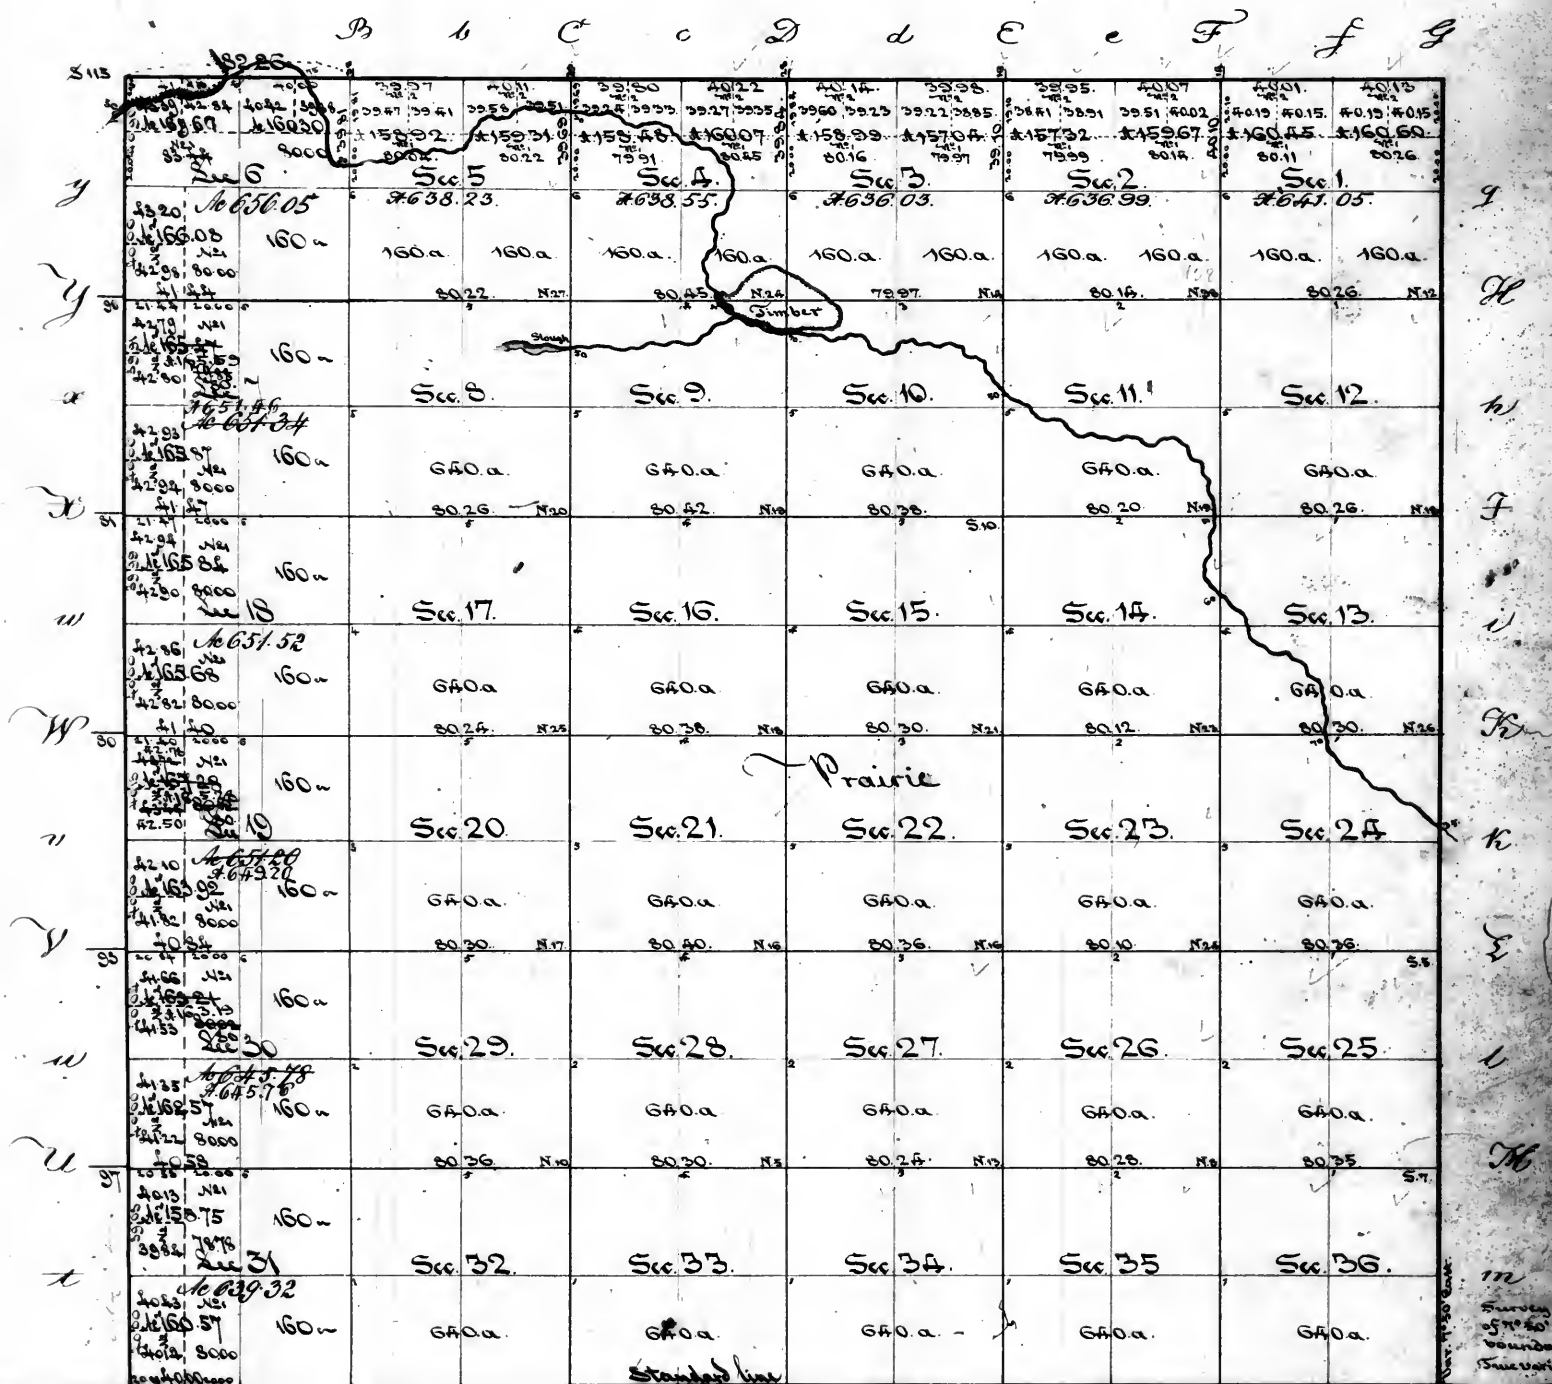

Surveyor General's Office.
Saint Louis 21 August 1833.

The above plat of Township 26 north of the base line, range 7 east of the 3rd principal meridian, except Sections 6, 7, 13, 19, 30 & 31, which are omitted, because they are not connected with the east boundary of T. 26 N. R. 6 E. by E. Moore, is strictly conformable to the field notes of the Survey of said Township on file in this office which have been examined and approved - The South boundary was surveyed in the 1st quarter of 1822 - by C. Sten, under contract of the 5th of March 1822 - The north and the east boundaries - and the subdivision lines were surveyed in the 4th quarter of 1830 - as by J. M. Messinger and J. J. Messinger, under their joint contract of the 2nd of September 1830.


William Hillman
Surveyor General


Sections 6, 7, 13, 19, 30 & 31 of this township which were excepted in the certificate of the approval of the Survey thereof, are retained from suspension and their areas calculated in consequence of Erskine Moore, having in August 1830, corrected their lines with his recovered East boundary of T. 26 N. R. 6 E. - and the 200, - that had been withheld from him on the 15 June 1830, to ensure the speedy execution of this work were paid to him on the 3rd September 1840, as per voucher N. 16 of account current for the 3rd quarter of that year under the general surveying fund. An authentic copy of the plat of the above sections is this day sent to the Commissioner of the General Land Office and a duplicate to the Register at St. Louis.

M. Lewis Clark
Surveyor General

Township 27 North of the base line Range 7 East of the 3rd principal Meridian

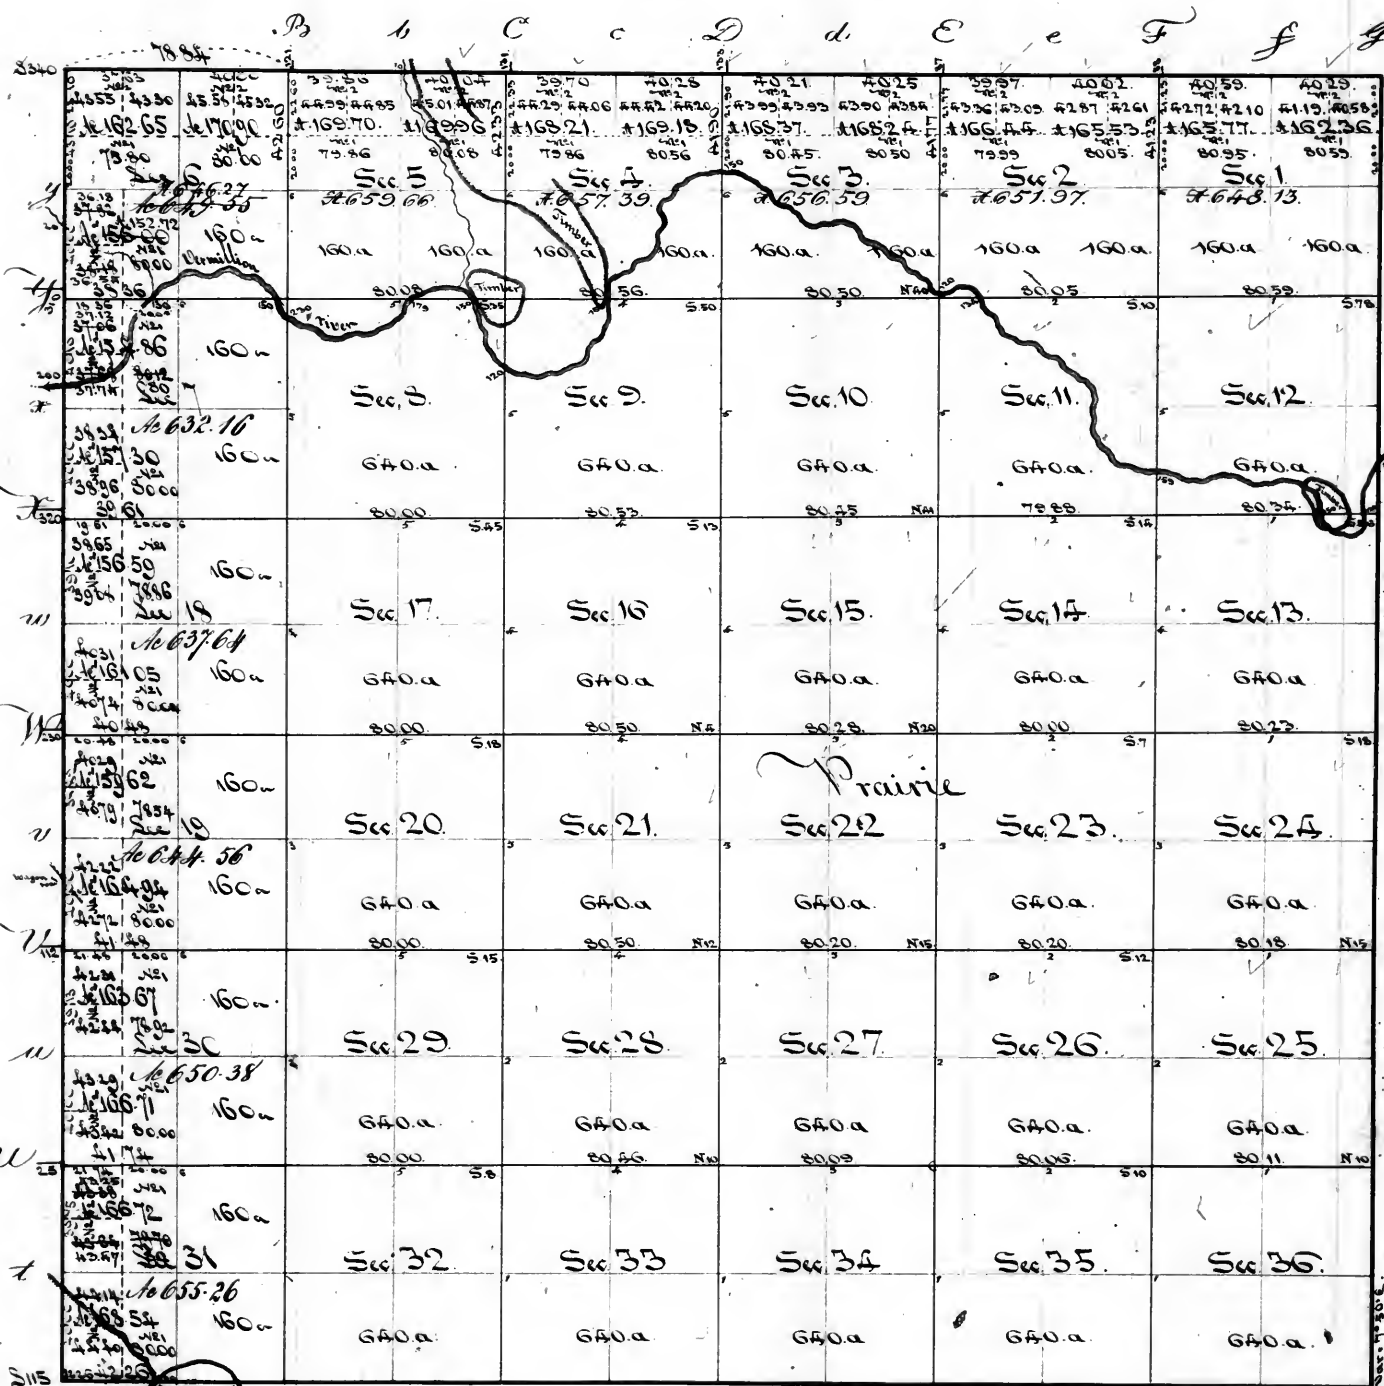

Surveyor General's Office.
Saint Louis 21 August 1833.

The above plat of township 27 north of the base line, range 7 east of the 3rd principal meridian, except sections 6, 7, 18, 19, 30 & 31, which are omitted because they are not connected with the surveyed east boundary of T. 27 N. R. 6 E, by S. Moore, is strictly conformable to the field notes of said township on file in this Office, which have been examined and approved. The north, the east and the south boundaries, and the subdivision lines were all surveyed in the 4th quarter of 1823 - by J. M. Messinger and D. J. Messinger, under their joint contract of the 2nd of September 1823.

Office of the Surveyor General for Illinois and Missouri.
Saint Louis 21 June 1830.

Sections 6, 7, 18, 19, 30 & 31, of this township which were excepted in the above certificate of the approval of the Survey thereof, are released from suspension and their areas calculated, in consequence of Creek Moore, surveyor in August 1830, connecting their lines with his surveyed east boundary of T. 27 N. R. 6 E. And the \$200, then had been withheld from him on the 15 June 1828, to induce the speedy execution of his work, were paid to him on the 9 September 1830, as per voucher NKS of account current for the 2nd of that year, under the general Surveying fund. An authenticated copy of the plat of the above sections is this day sent to the Commissioner of the general land office, and is deposited in the Register at St. Louis.


Area = 19273.74 acres exclusive of Secs 6, 7, 18, 19, 30 & 31.
Aggregate Area 23743.29 acres

William Miller
Surveyor General

M. Lewis Clark
Surveyor General

Township 28 North of the base line Range 7 East of the 3^d principal Meridian

3

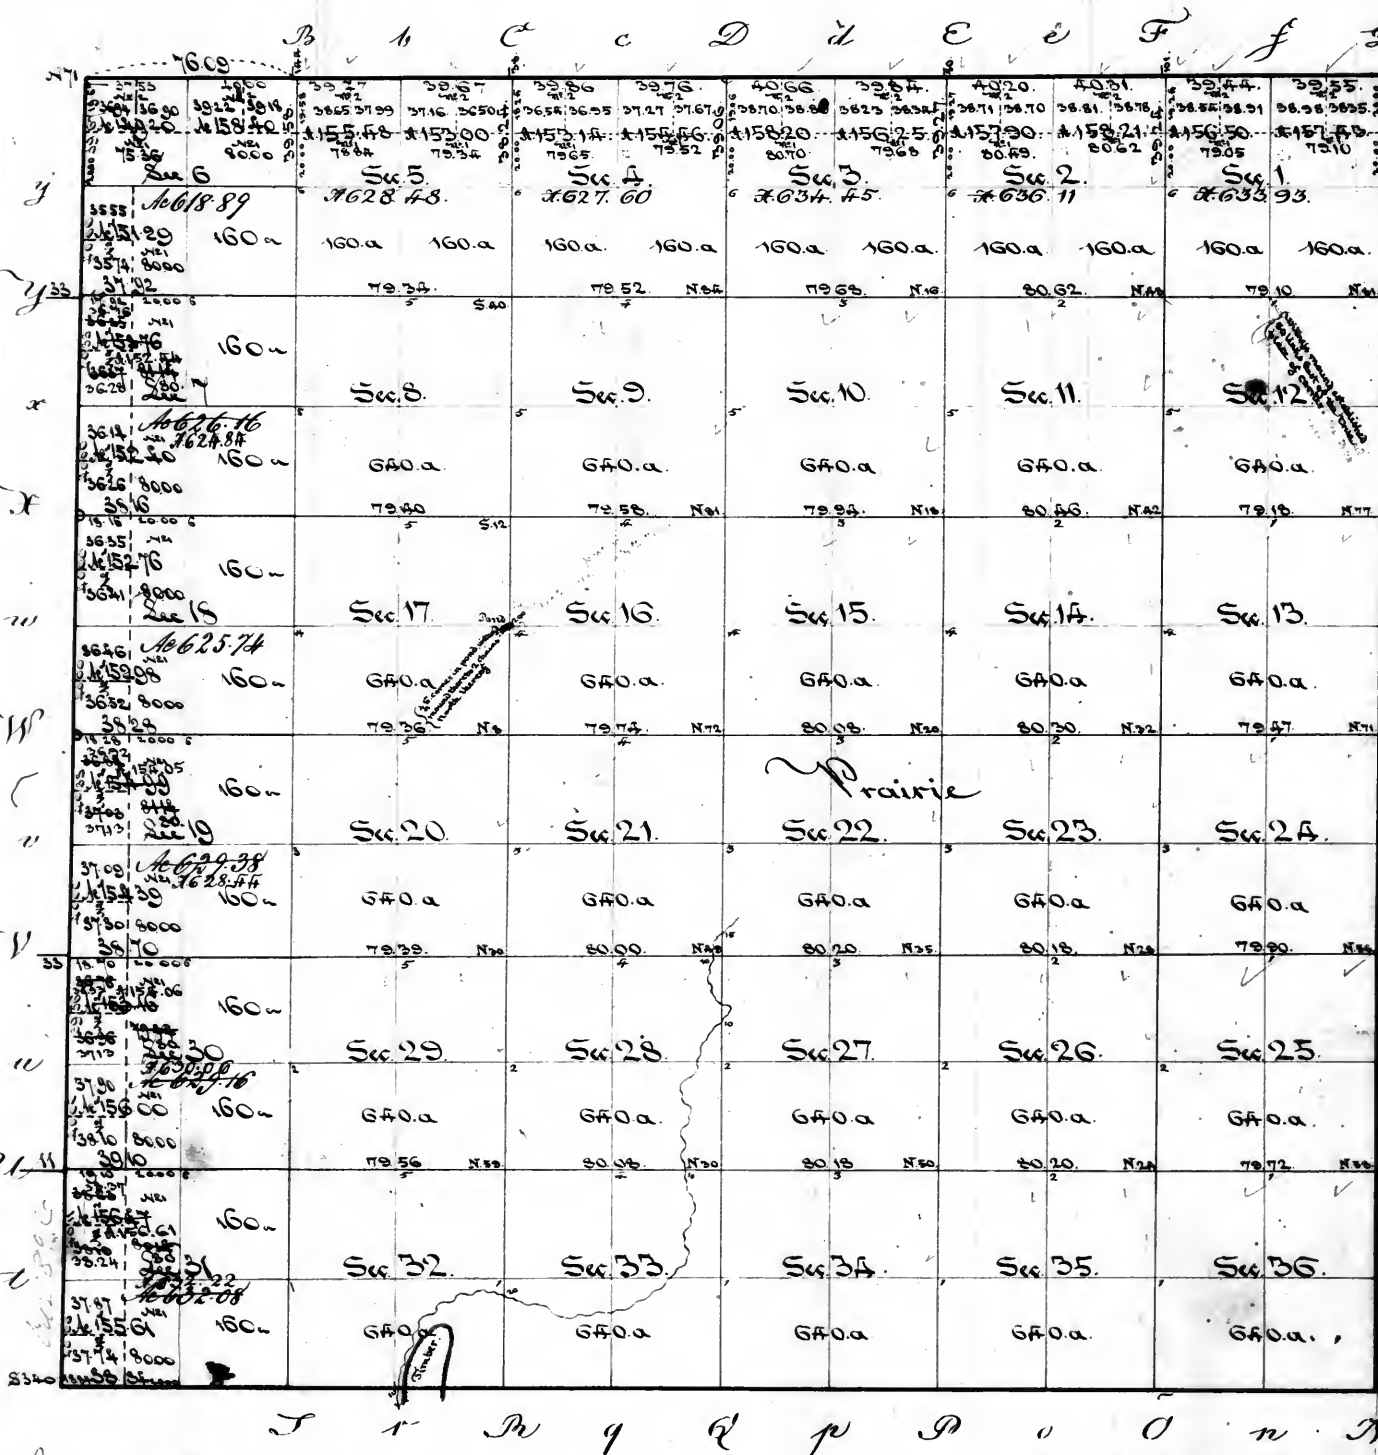

Surveyor General's Office.
Saint Louis 21 August 1850.

Scale of 20 chains to an inch

The above plat of township 28 north of the base line, range 7 east of the 3^d principal meridian; except sections 6-7, 18-19, 30 & 31, which are excepted from the survey, is strictly conformable to the field notes of the survey of said township on file in this office which have been examined and approved. The east and the south boundaries, were surveyed in the 4th quarter of 1850. The north boundary and the subdivision lines on the 2^d quarter of 1850 and 2^d quarter of 1854 - all by J. M. & T. J. Meisinger, under their contract of the 2^d of September 1850.

Office of the Surveyor General for Illinois and Missouri.
Saint Louis 12 June 1850.


William Miller
Surveyor General

Sections 6-7, 18-19, 30 & 31, of this township, which were excepted in the certificate of the approval of the survey thereof, are released from suspension, and their acreage calculated in consequence of Carl Moore having in August 1850, connected their lines with the resumed East boundary of T 28 R 6. And he \$200. that had been withheld from him on the 15 June 1850. to insure the speedy execution of this work, were paid to him on the 9th September 1850, as per voucher N 16 of account current for the 3rd of that year under the general surveying and. An authenticated copy of the plat of the above sections is this day sent to the Commissioner of the General Land Office and a duplicate to the Register at St. Louis.

M. Lewis Clark
Surveyor General.

Township 29 North of the base line Range 7 East of the 3rd principal Meridian

4

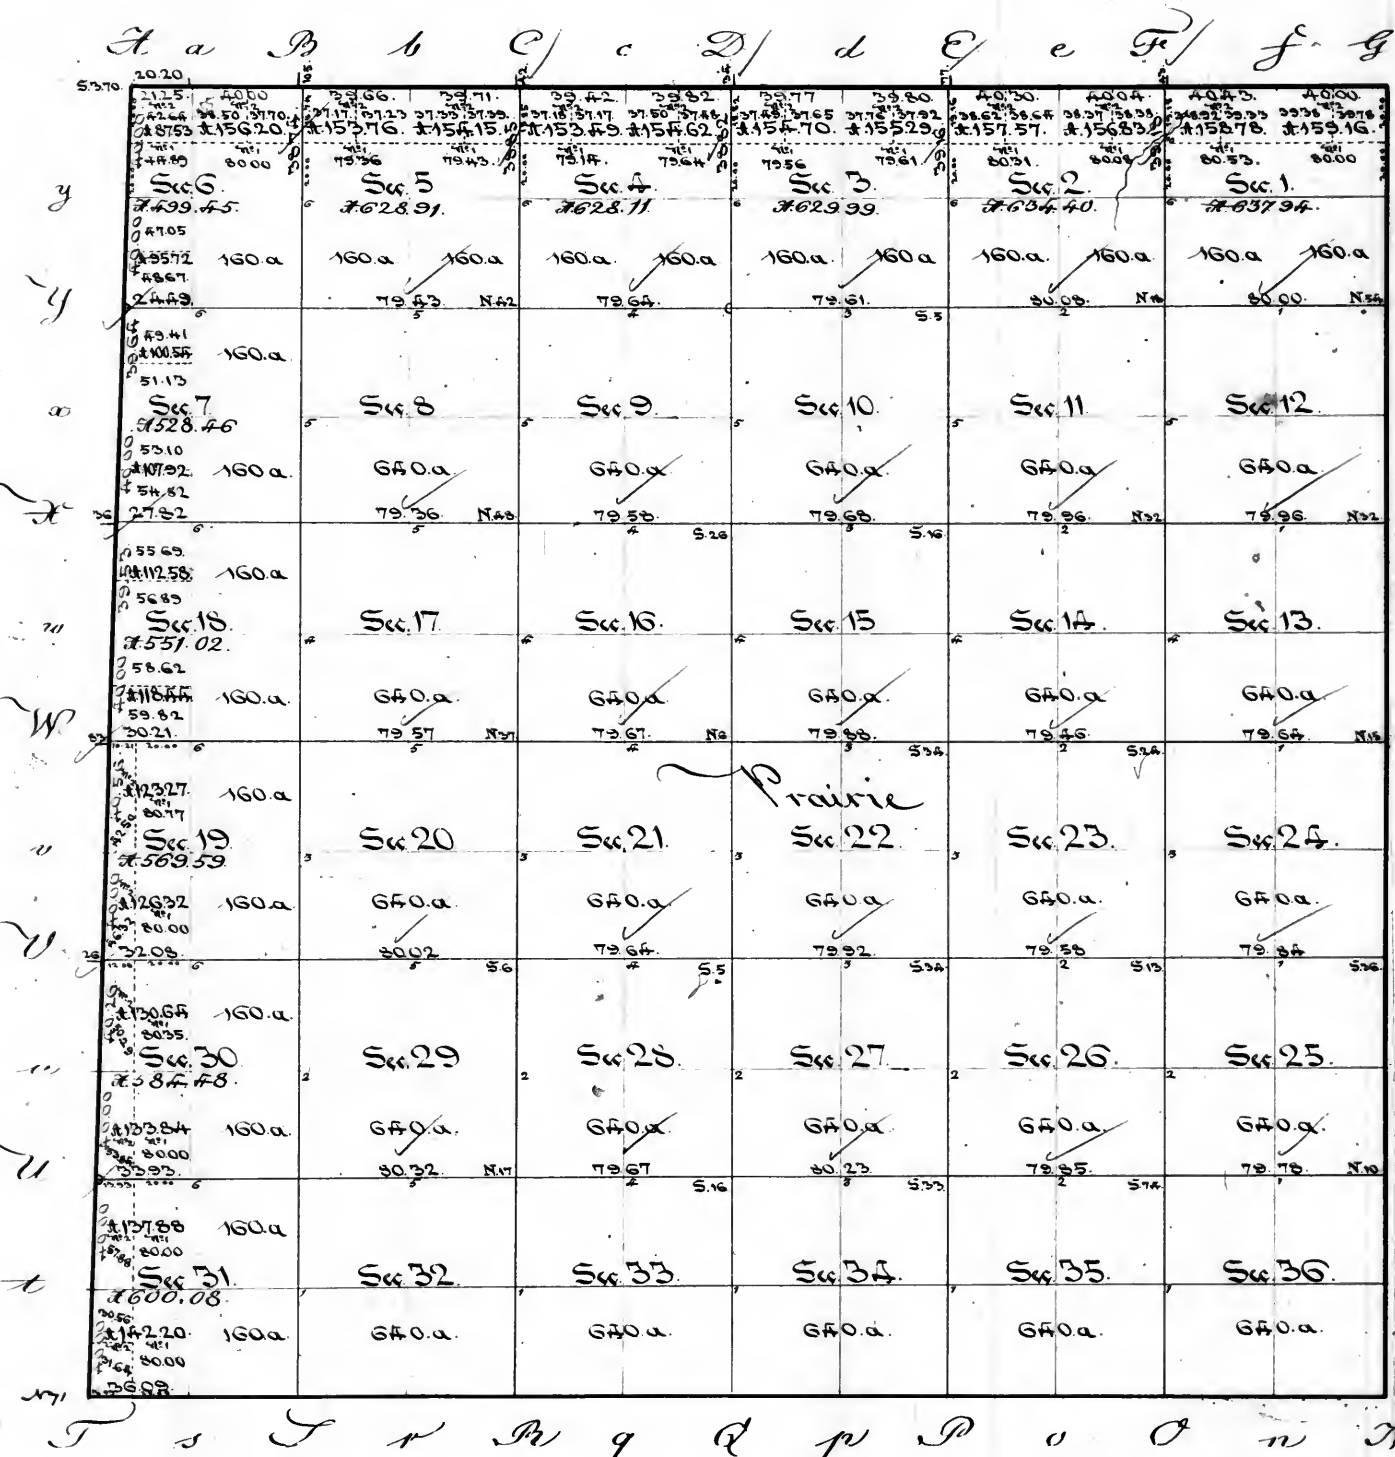

The above plat of Township 29 North of the base line range 7 east of the 3rd principal meridian is strictly conformable to the field notes of the survey thereof on file in this office, which have been examined and approved - The west boundary 6 miles, was surveyed in the 4th quarter of 1833, by Enoch Moore under contract of the 12th day of August 1833, and to the extent noted in the margin was paid for in the 2nd quarter of 1838, and charged in the account of the Surveyor General for that quarter - Voucher No 7. - The South boundary was surveyed in the 4th quarter of 1833 and 2nd quarter of 1834, by John Milton Messinger, and Benjamin Franklin Messinger, under their joint contract of the 2nd of September 1833, and the east and north boundaries and subdivision lines were surveyed in the 2nd quarter of 1834, by Benjamin Franklin Messinger, under the joint contract above designated.

Surveyors Office.
Saint-Louis 3rd of May 1839.

Scale of 40 chains to an inch
Aggregate area = 22492.43 acres.




William Melbourn
Surveyor General

Township 30 North of the base line Range 7 East of the 3rd principal Meridian

5317
 4009
 9321


Plat of Township 31 North of the base line Range 07 East of the 3rd principal Meridian.

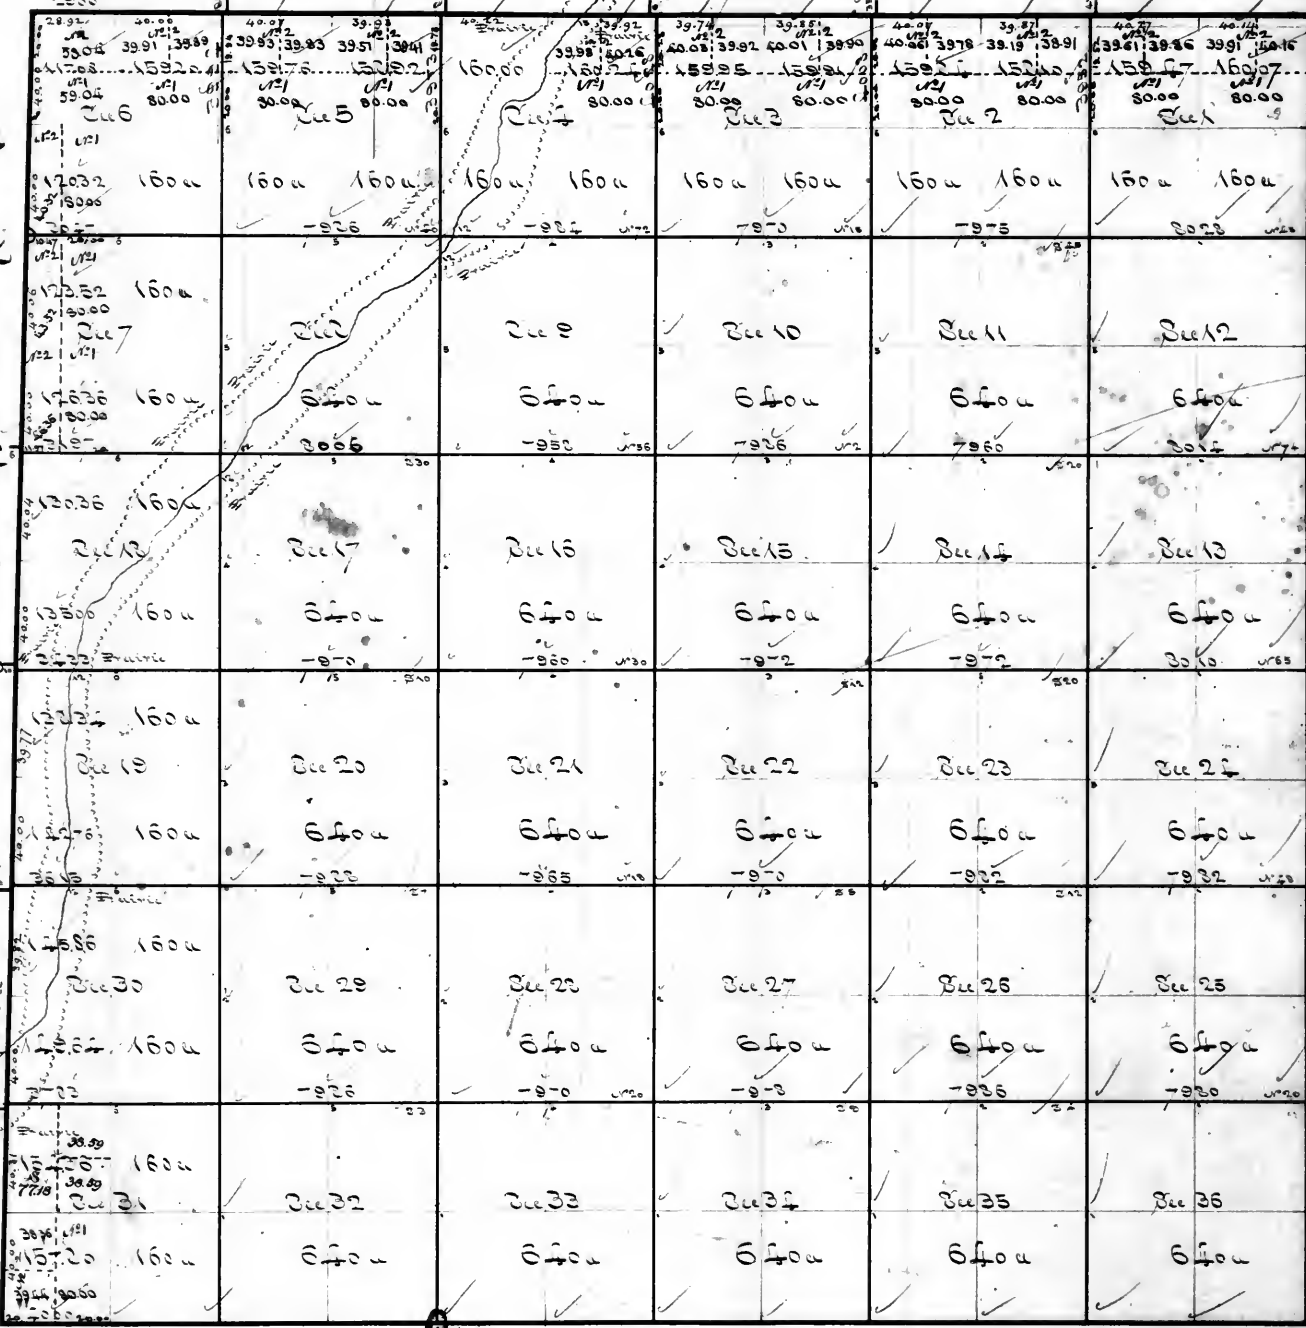

Surveyors Office
St. Louis
Subdivision under the
act of 1833, viz. at pt. of sec.
1, 2, the W. 1/2 of Sec 7, 8, 9, and to say again of the plat
thereof, one to the Register, and another
to the Commissioner.


Surveyors Office
St. Louis June 1834

The above Plat of Township 31 North of the Base line, Range 07 East
of the 3rd principal Meridian, is conformable to the field notes of the survey thereof on file in this Office.

E. J. Smyth

E. J. Langham

Township N. 33 North of the base line Range 7 East of the 3rd Principal Meridian

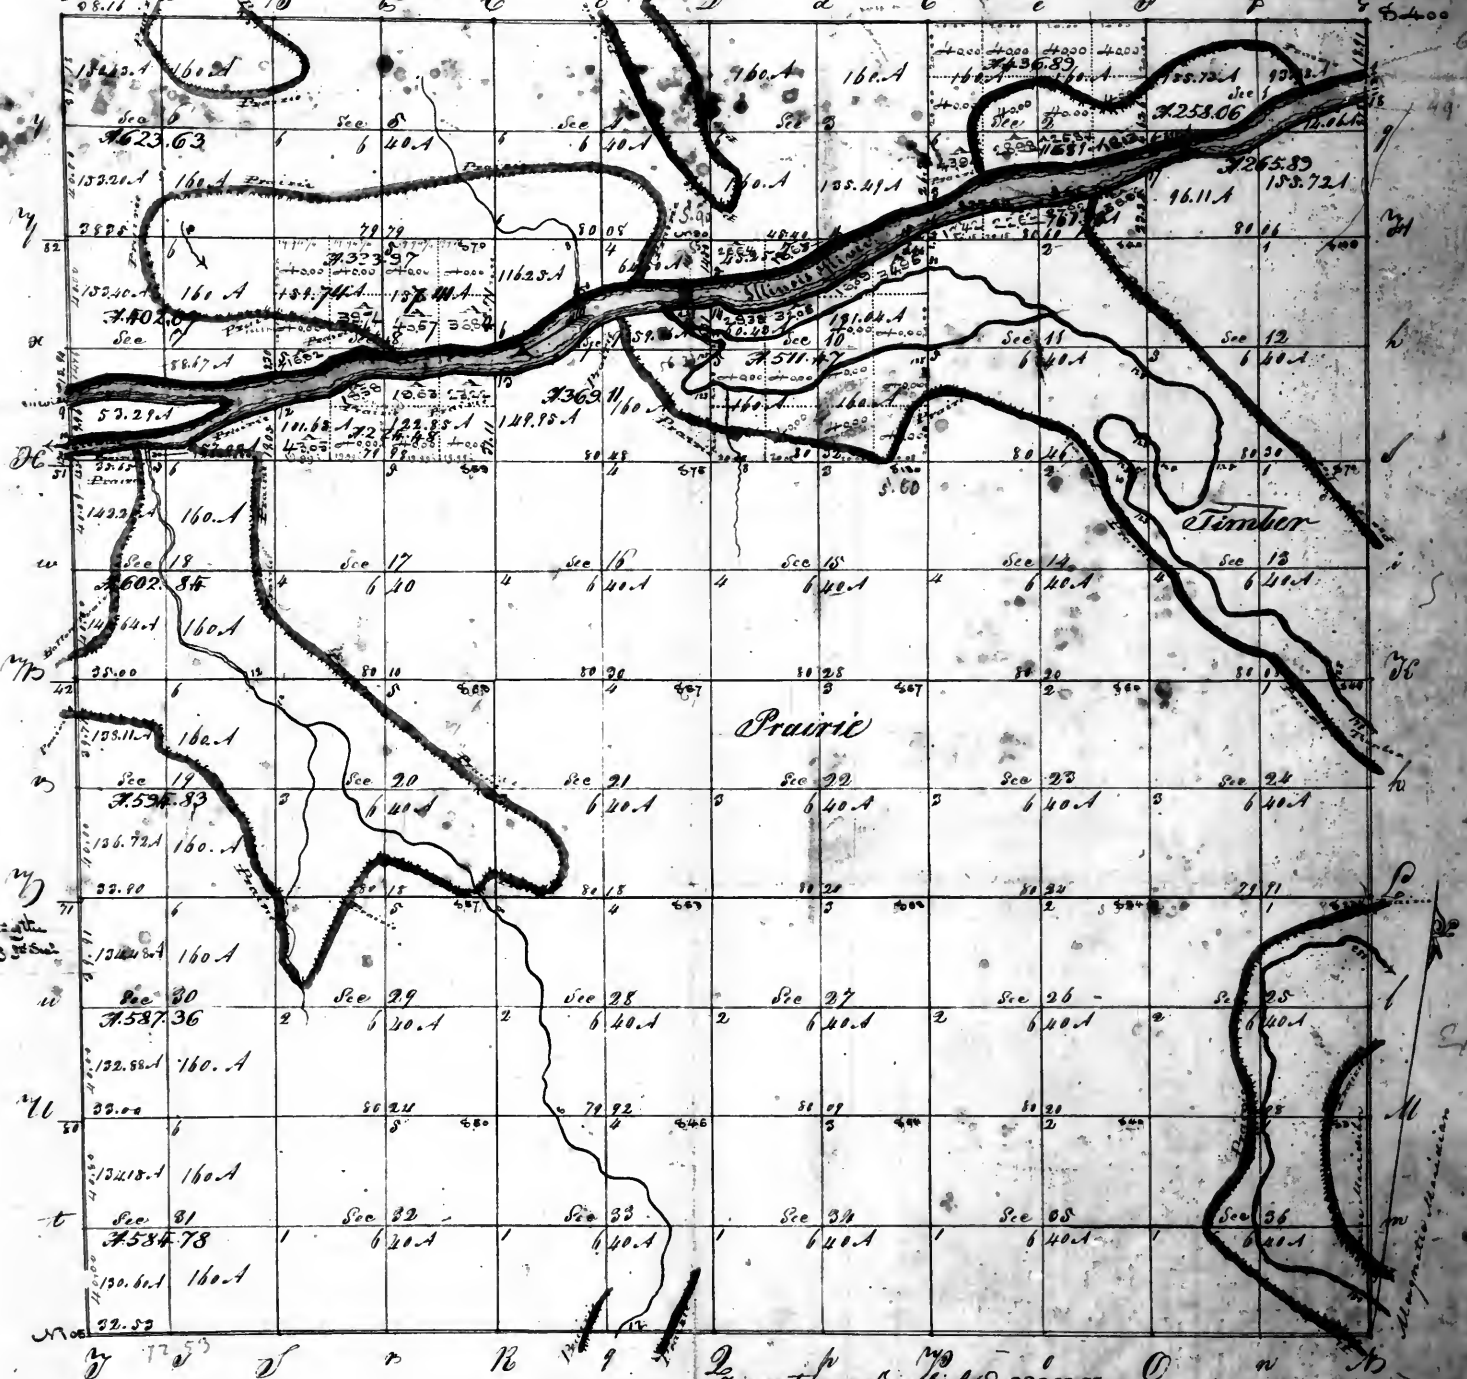

10 Sept 1834 sent to the Comdr of the
 Genl Land Office a plat of 36 Sec
 25 & 10.

Aggregate area of public land - 22203.88 acs
 Estimated area of timber - 600.00 - - - - -
 Total - 22803.88 acres

Pursuant to a contract with and instructions from William H. Rector, Surveyor of the Lands of the United States in the States of Illinois and Missouri and Territory of Arkansas, bearing date the 25th day of March 1834, I have a lineament laid out and surveyed the above described Township, and as hereby certify that it had such marks and bounds, both natural and artificial as are represented on said plat and described in the field notes made thereof and returned with this plat into the office of the Surveyor of the Lands of the United States in the States of Illinois and Missouri and Territory of Arkansas.

Surveyors Office
 St. Louis July 31st 1834.

The above Plat of Township 33 North of the base line, Range 7 East of the 3rd Principal Meridian, is conformable to the field notes of the survey thereof on file in this Office.

E. D. Smytham

[illegible]


Subsided under the
of 1897, viz the 17th of Dec 97
17th and 18th of Dec 97 and
20th of Dec 97 - and send
a copy of the plat therof, one to
the Register and another to the

Ex 2 28 June 1894

E. J. Lyham

Township 35 North of the base line. Range 7 East of the 3rd principal meridian.
South of the Old Indian boundary line.

10

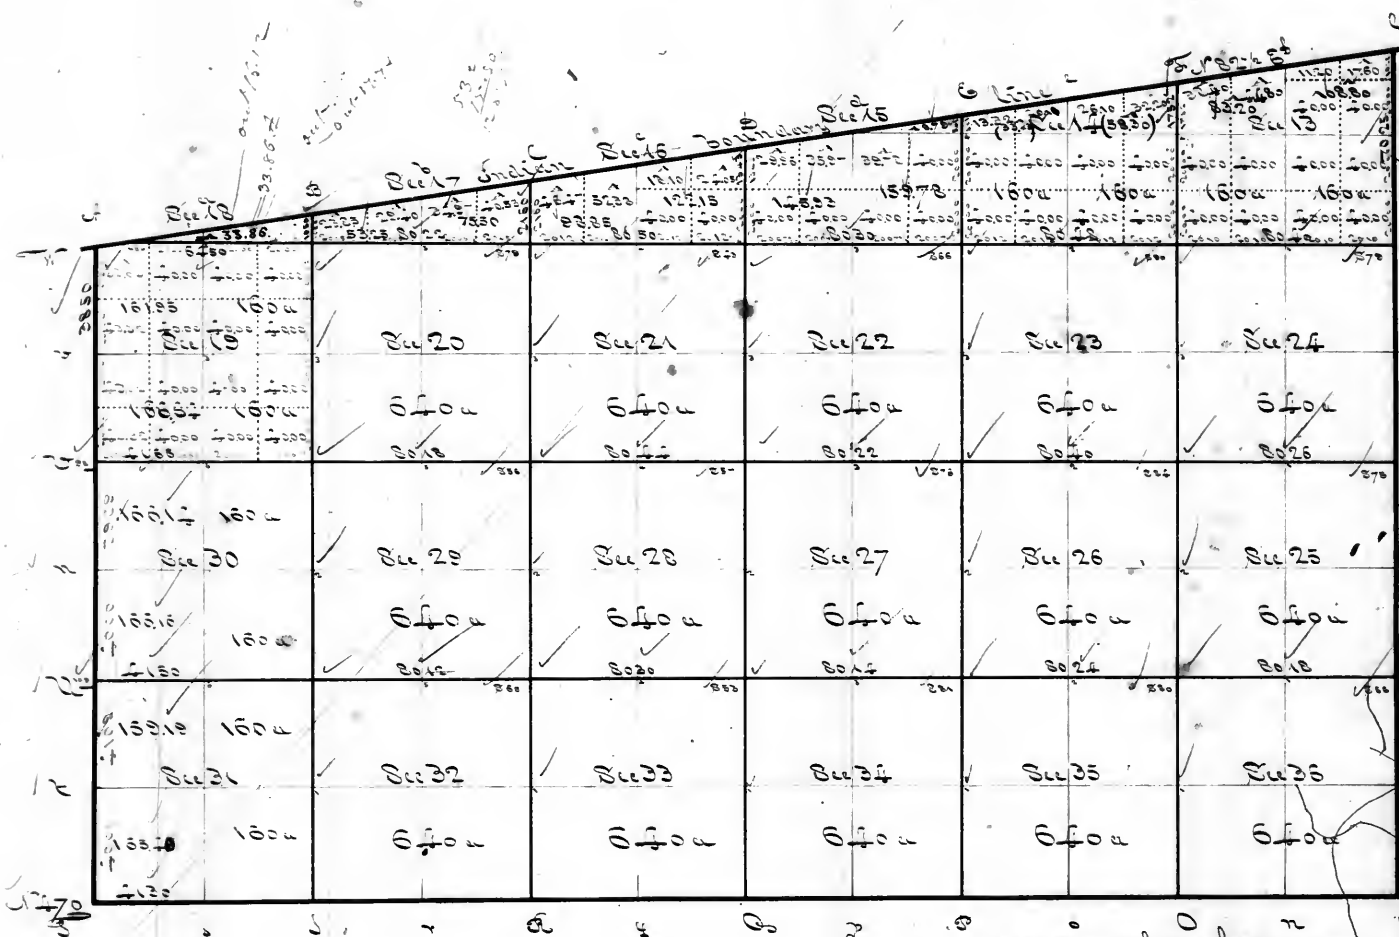


Surveyors Office
St. Louis July 1834

The above Plat of Fractional Township 35 North of the base line, Range 7 East of the 3rd principal Meridian, South of the Old Indian boundary line, is conformable to the field notes of the survey thereof on file in this Office.

E. J. Whigham

Fractional Township No. 35 North of the Base line in Range No. 7 East of the 3^d principal Meridian.

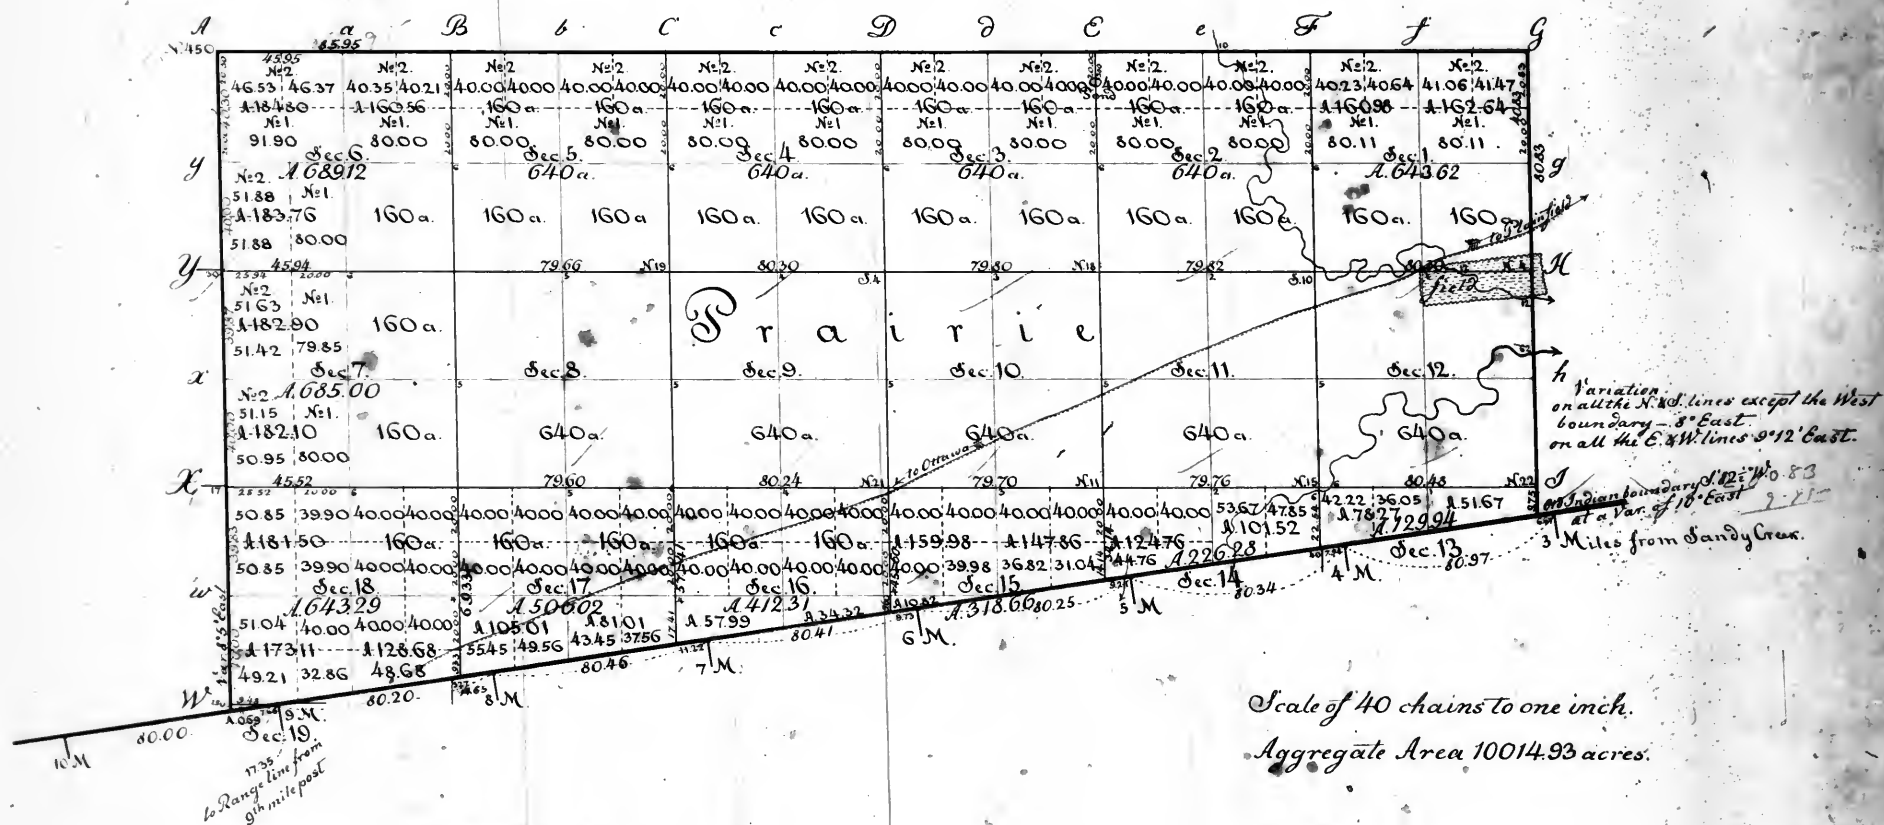


Surveyors Office.
Saint Louis 21st May 1839.

The above plat of fractional township 35 north of the base line, range 7 east of the 3^d principal meridian, and north of the old indian boundary, is strictly conformable to the field notes of the survey thereof on file in this Office, which have been examined and approved. The southern boundary which is designated "old indian boundary" was a recovery in September 1831, in order to close the surveys to the South thereto under the contract of Stephen Rector and Thomas C. Rector of the 20th of March 1831, and was intended as a recovery of the indian boundary (which could not be properly identified) that had been surveyed in the 4th quarter of 1818 by John C. Sullivan, assisted by James Mc. Duncan from a point on Sandy creek 10 miles above its mouth S. 82¹/₂° W. 2.2 miles and 66 chains to a point on Fox river, 10 miles above its mouth, under a letter of appointment dated October 18th 1818, for running the lines of the treaty at Saint Louis of the 24th of August 1816, between the United States and the United Nations of Ottawas, Chippewas and Pottawatomias. That part of said line, which forms a boundary to this fractional township 6 miles 53.31 chains, was surveyed: - the west boundary of the fractional township 2 miles 1.50 chains - the east boundary, 2 miles 10.53 chains and the north boundary 6 miles 5.95 chains, were surveyed in the 4th quarter of 1837 - and the subdivision lines 25 miles 9.62 chains, were surveyed in the 2^d quarter of 1838 - all by Eli. S. Prescott, under contract signed by the Surveyor General on the 3rd day of May, and by Prescott on the 3rd day of June 1837 - They were paid for in the 4th quarter of 1838 - and charged in the account of the Surveyor General for that quarter. Voucher No. 5.

William Milburn
Surveyor General

Township No 36 North of the Base line in Range No 7 East of the 3^d principal Meridian.

12

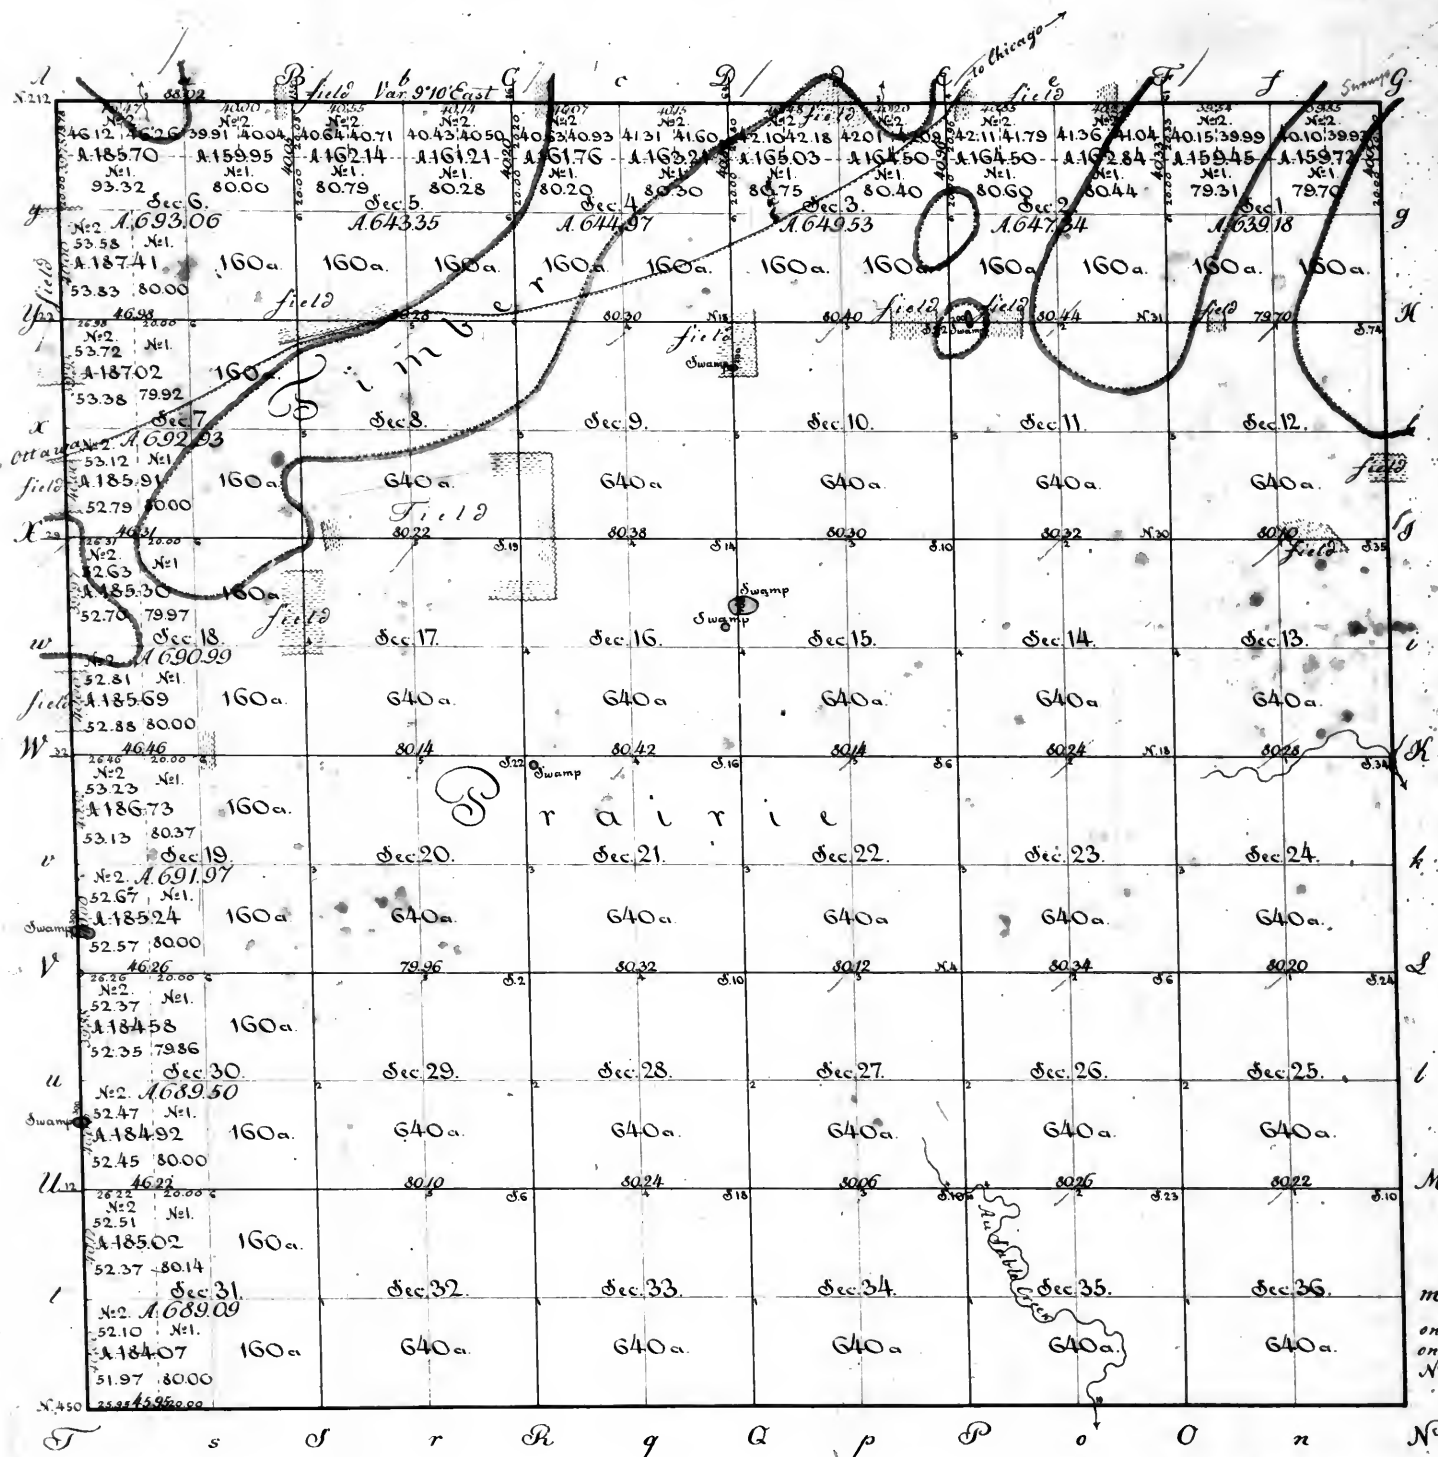


Surveyors Office.
Saint Louis 25th May 1839.

Scale of 40 chains to one inch.
Aggregate Area 23371.91 acres.

The above plat of township 36 north of the base line, range 7 east of the 3^d principal meridian is strictly conformable to the field notes of the survey thereof on file in this office, which have been examined and approved - The west and east boundaries, 6 miles each, - The south boundary 6 miles 5.95 chains - and the north boundary 6 miles 8.02 chains, were surveyed in the 4th quarter of 1837 - and the subdivision lines 60 miles 4.05 chains, were surveyed in the second quarter of 1838 - all by Ch. S. Prescott, under contract signed by the Surveyor General on the 8th May, and by the said Prescott on the 3rd of June 1837 - they were paid for in the 4th quarter of 1838, and charged in the account of the Surveyor General for that quarter - Voucher No 5.

William Melbourn
Surveyor General
D

T₃₇ N R 7 E of the 3^d p^t M.

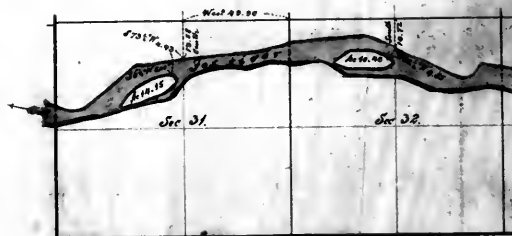

Scale of 40 chains to an inch


Office of the Surveyor General for Missouri & Arkansas.
St. Louis, February 14, 1857.

The above plot of two tracts, one in Section 31, and the other in Section 32 of Township 37 north of the base line and range 7 east of the 3rd principal meridian, is strictly conformable to the field notes of the survey. They were surveyed on December 1856, by J. N. Clarke, under instructions of 14th October of same year. The surveying account is under \$2.23 cents, which at 50 cts per mile makes \$1.12. An account for a survey by me, completed by Clarke, and transmitted to the Commissioner of the General Land Office, for a direct bill (account with the Registry, out of the appropriation for the Commission of Ordnance and Defective Lines in Illinois to Missouri), at a rate not exceeding 50 cts per mile — in conformity with instructions of 11 March 1856.

Mo Loughborough
Surgeon General

A copy of this plot was sent to the
Concord Register on 14 Feb'y 1857

Township N^o 37 North of the Base line in Range N^o 7 East of the 3^d principal Meridian.

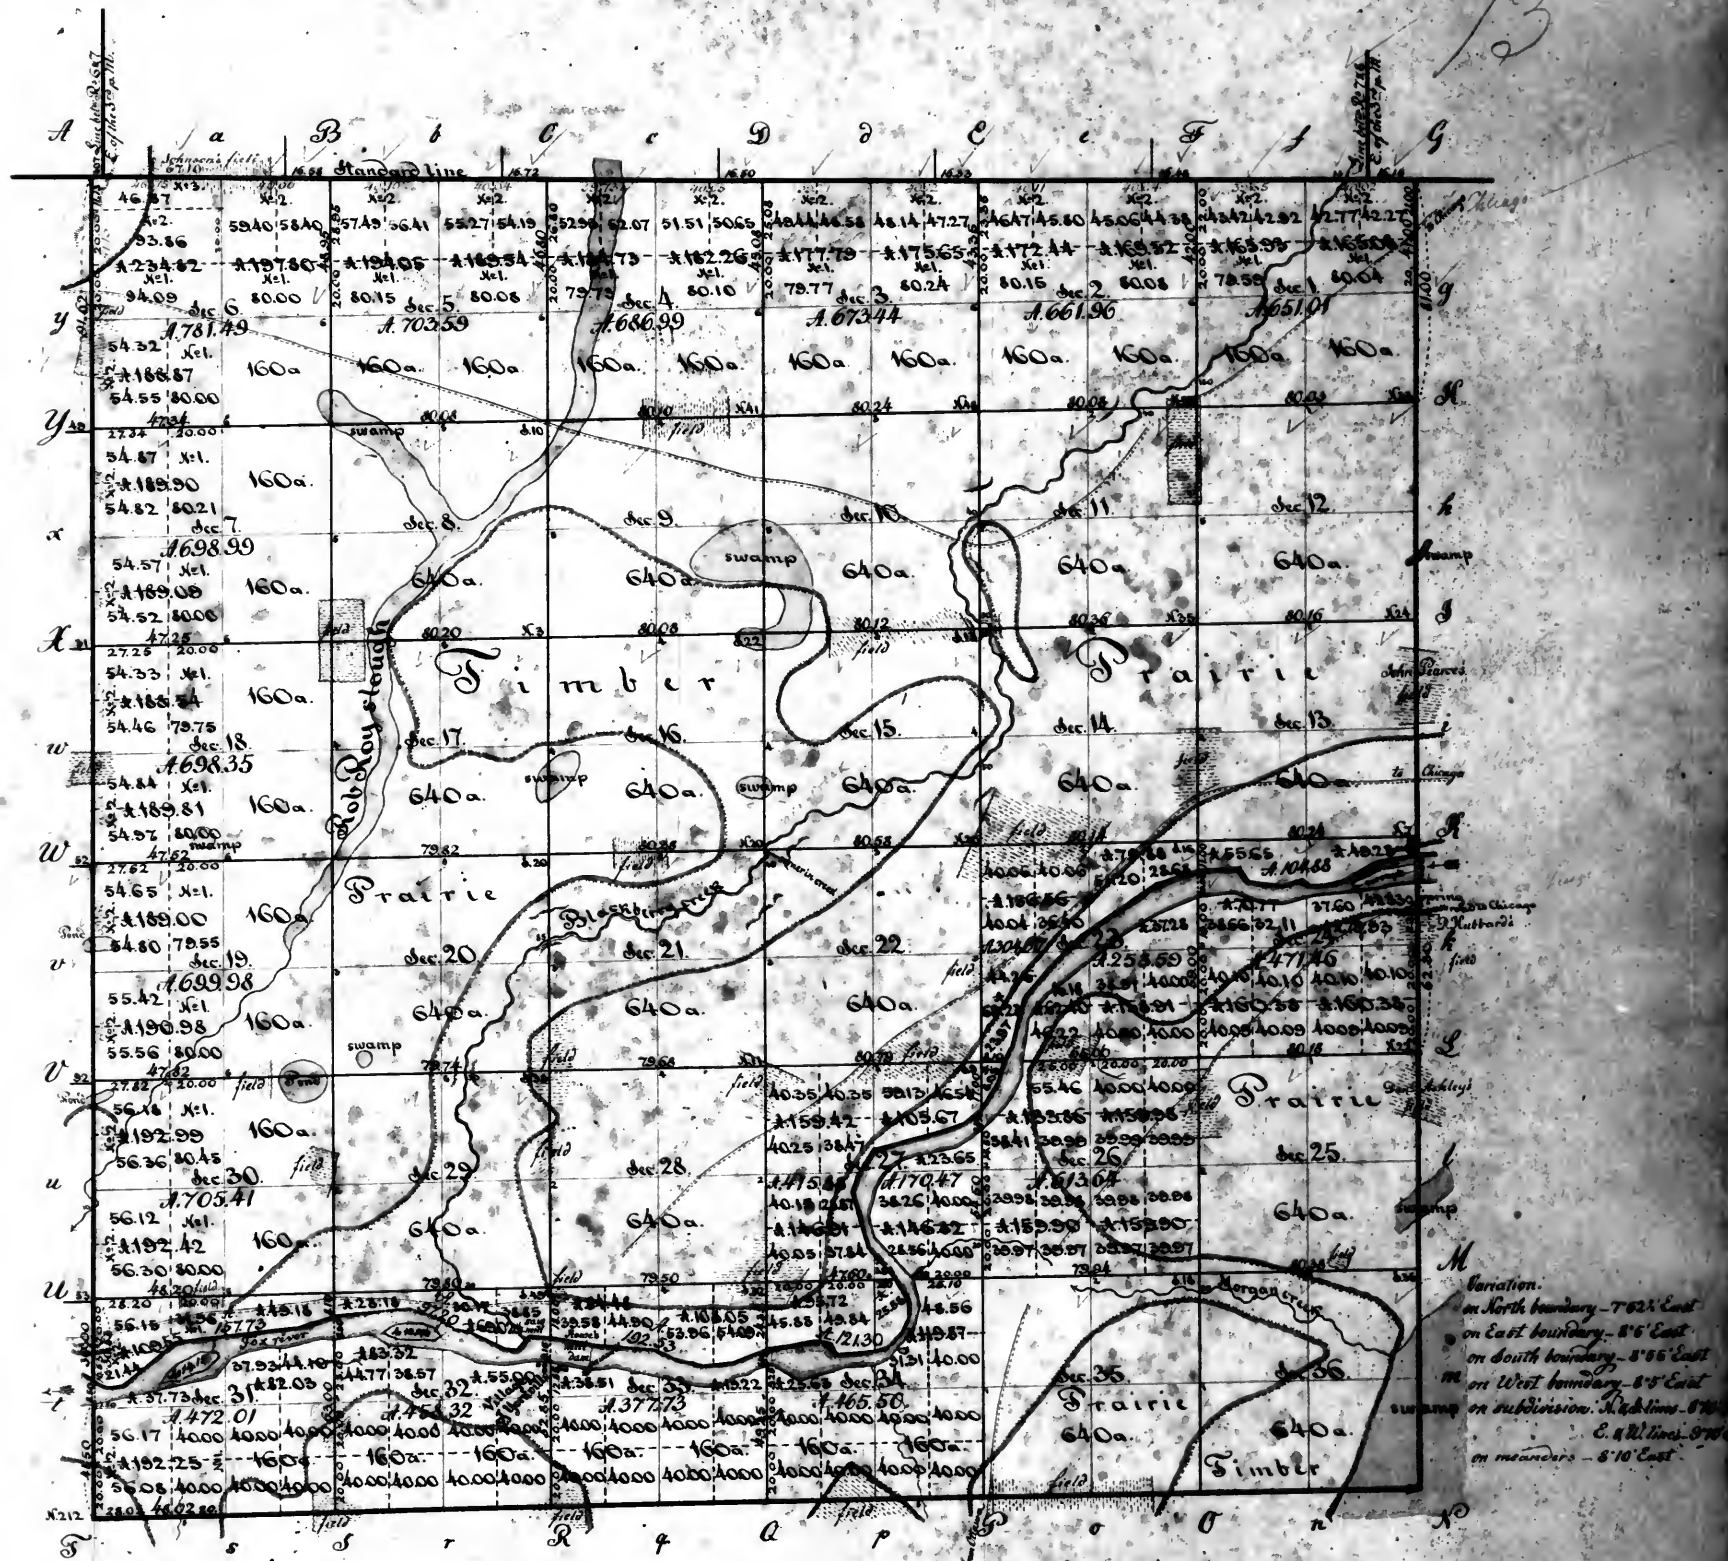


Scale of 40 chains to one inch.
 Aggregate area of public lands 23141.21 acres
 estimated area of Fox river 530.80 acres
 Aggregate area of Township 23672.01 acres

Surveyors Office, Saint Louis 25th of August 1842.

The above plat of Township 37 north of the base line range East of the 3^d principal meridian is strictly conformable to the field notes of the survey thereof on file in this office, which have been examined and approved. The south boundary 6 miles 8.02 chains - the east boundary 6 miles and 1 chain - the north boundary 6 miles 6.03 chains - and the west boundary 6 miles 11.62 chains, were all surveyed in the 4th quarter of 1837, by Eli S. Prescott, under contract signed by the Surveyor General on the 8th of May, and by W^m Stewart, on the 3rd of June 1837 - They were paid for in the 4th quarter of 1837, and charged in the account current of the Surveyor General during the said quarter, Voucher N^o 5 - The subdivision lines 60 miles 52.63 chains, and the meanders of both banks of Fox river, 16 miles 2.12 chains, were surveyed in the 3^d quarter of 1837, and 4th quarter of 1841 - by James H. Rice, for Eli S. Prescott, without authority from, or a contract with, the Surveyor General; but the field notes thereof have been received for examination upon their own merits, in virtue of the directions contained in the letter of the Commissioner of the general land office to Surveyor General Milburn, dated 3rd June 1840, and W^m Rice's notes having been examined, and some corrections made in the field; - and the Commissioner of the general land office in his letter to Surveyor General Rice, dated 6th May 1842, having authorized him to pay therefor, the said subdivision lines and meanders, were accordingly paid out of the General appropriation for surveying the public land; and charged in the account current of the Surveyor General during this 3^d quarter of 1842, Voucher N^o 1 - for the letter of the Commissioner of the public land office of the 25th of July 1842, authorizing the said payment, for the reasons herein assigned, and which do not bear upon W^m Rice's survey.

Silas Reed
 Surveyor of the public lands in
 the State of Missouri & Arkansas.

Township No 38 North of the Base line in Range No 7 East of the 3^d principal Meridian.

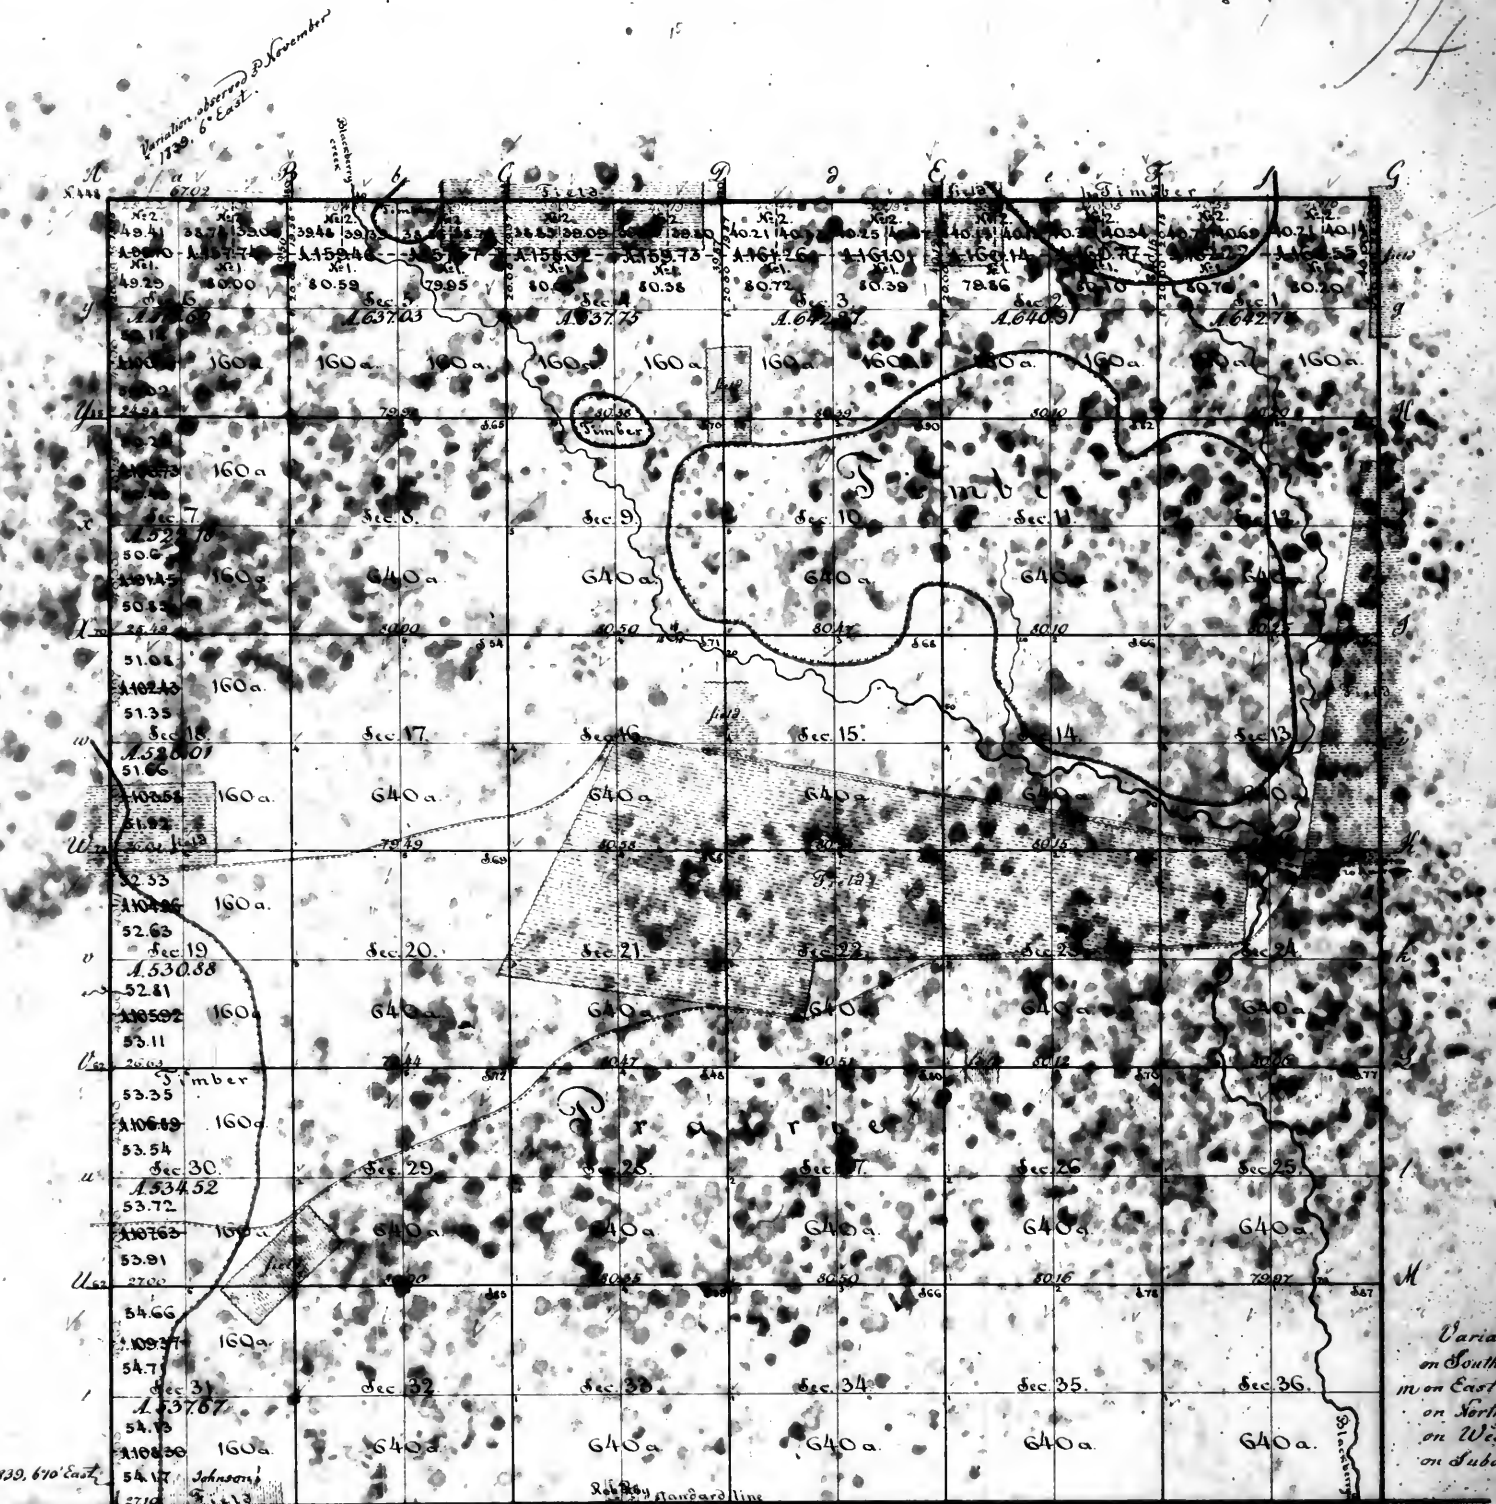


Surveyor's Office.

Saint Louis 29th of September 1840.

The above plat of township 38 north of the base line in range 7 east of the 3^d principal meridian, is strictly conformable to the field notes of the surveys thereof on file in this office, which have been examined and approved. The South boundary 5 miles 67.10 chains was surveyed by Eli S. Prescott, in the 4th quarter of 1837, under contract signed by the Surveyor General on the 8th of May, and by W^m Prescott on the 3rd of June 1837; it was paid for in the 4th quarter of 1838, and charged in the account of the Surveyor General for that quarter. Voucher No 5— The East boundary 6 miles— The West boundary 6 miles— The north boundary 5 miles and 67.02 chains— and the subdivisional lines 50 miles 14.12 chains, were all surveyed in the 4th quarter of 1839, by James Thompson and John P. Thompson, under their joint contract of the 21st of September 1839— The surveys by William Thompson were paid for in this 3^d quarter of 1840, and they will be charged in the account current of the Surveyor General, during the said quarter, under the general appropriation for surveying the public land— Voucher No 17.

William Milburn
Surveyor of the public lands in
the States of Illinois and Missouri.

15

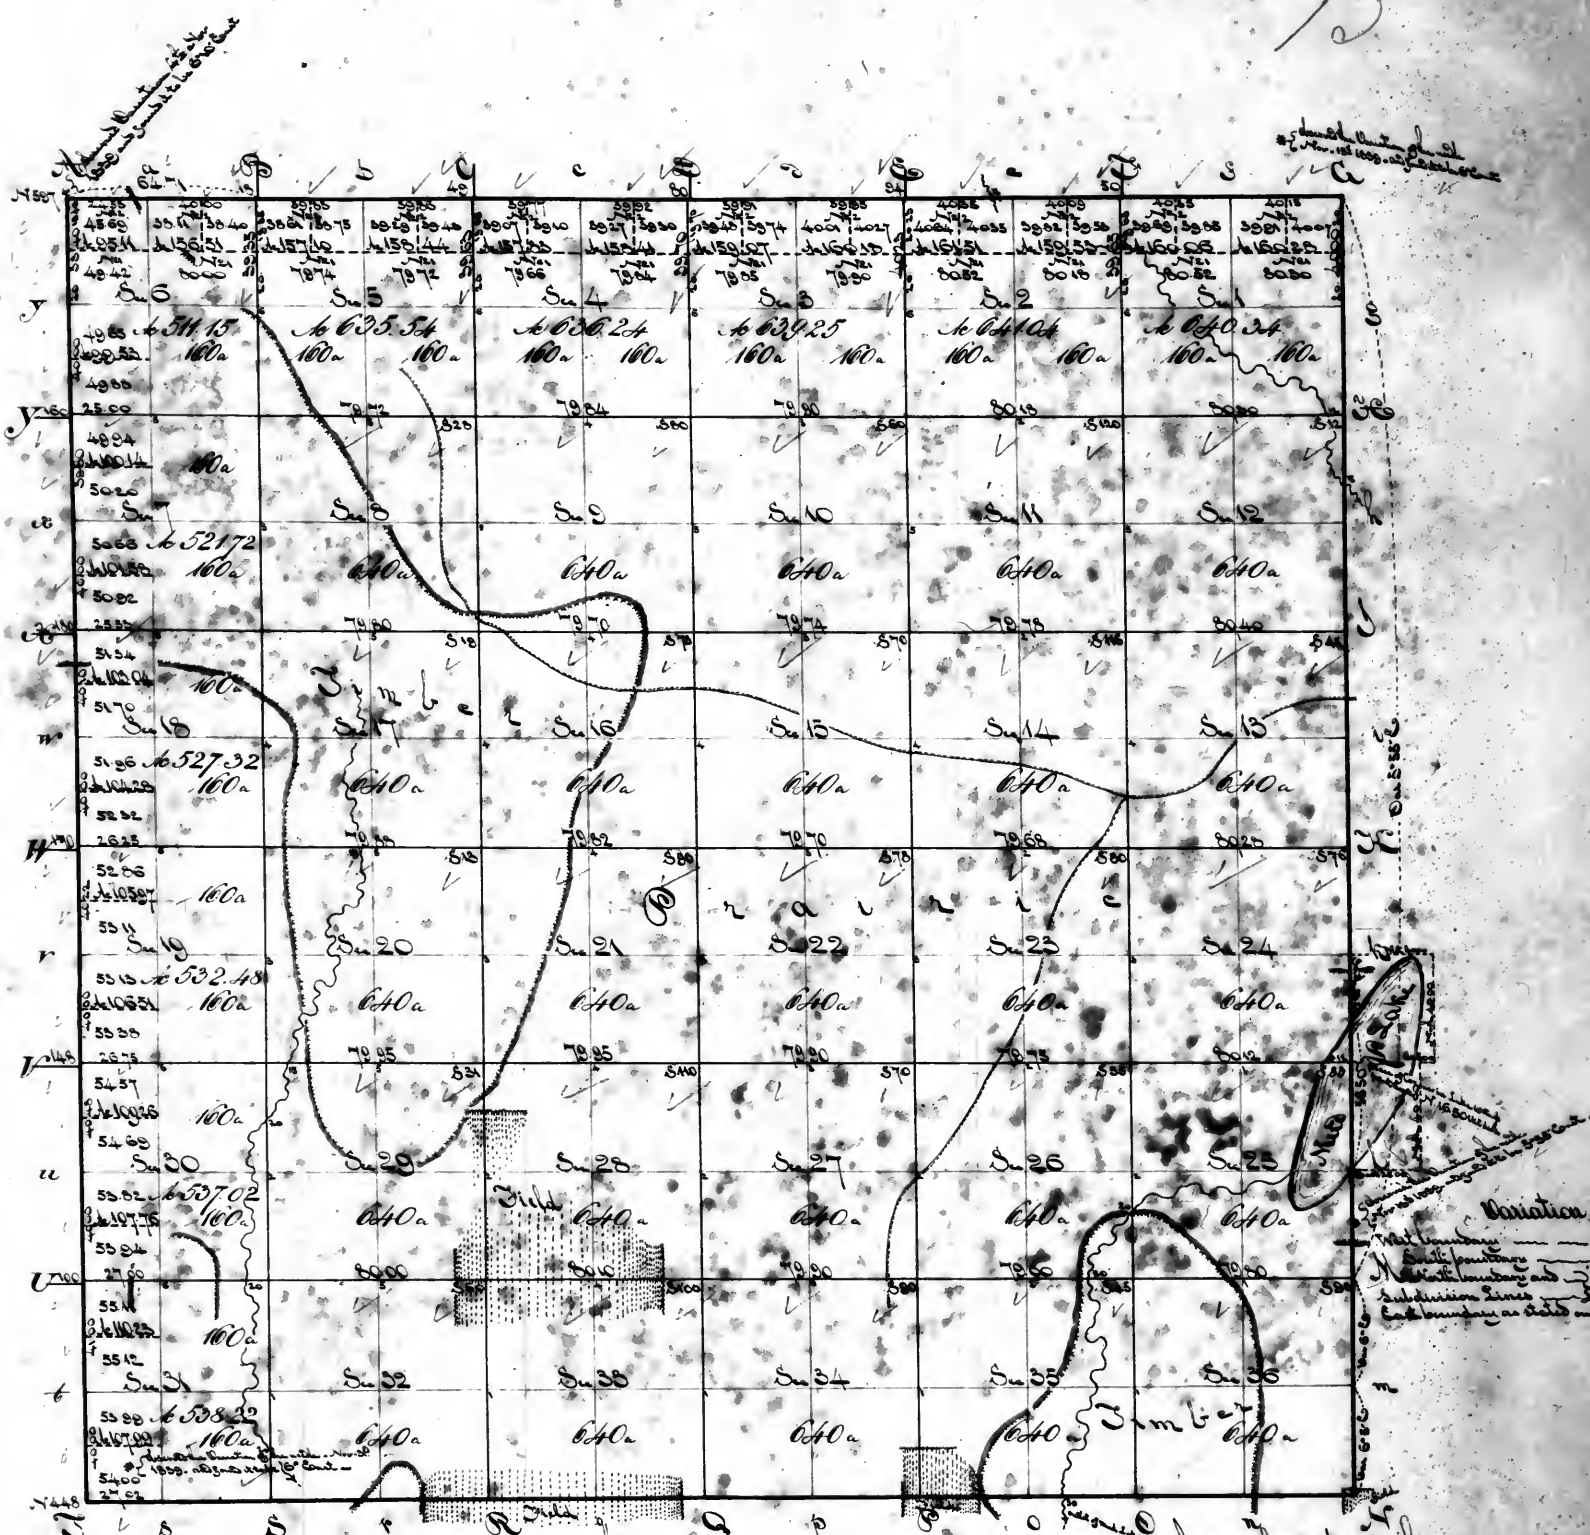

Surveyors Office Saint Louis 25th of August 1842.


The above plat of township 39 north of the base line range 7 east of the 3^d principal meridian, is strictly conformable to the field notes of the survey thereof on file in this office, which have been examined and approved - The South boundary 5 miles 67.03 chains - The east boundary 5 miles - The north boundary 5 miles 64.71 chains - and the west boundary 6 miles were surveyed in the 4th quarter of 1839, by James Thompson and John P. Thompson, under their joint contract of the 21st of September 1839 - They were paid for in the 3^d quarter of 1840, and charged in the account current of the Surveyor General during the same quarter Voucher N^o 17 - The subdivision lines 36 miles 6.38 chains, were surveyed in the 4th quarter of 1840, by James Thompson and John P. Thompson, under their joint contract of the 13th of September 1840. They were paid for in the 3^d quarter of 1842 and charged in the account current of the Surveyor General during the said quarter Voucher N^o 7.

Silas Reed

Surveyor of the public lands in
the States of Illinois & Missouri.

Township 40 North of the Base Line Range 7 East of the Principal Meridian

16

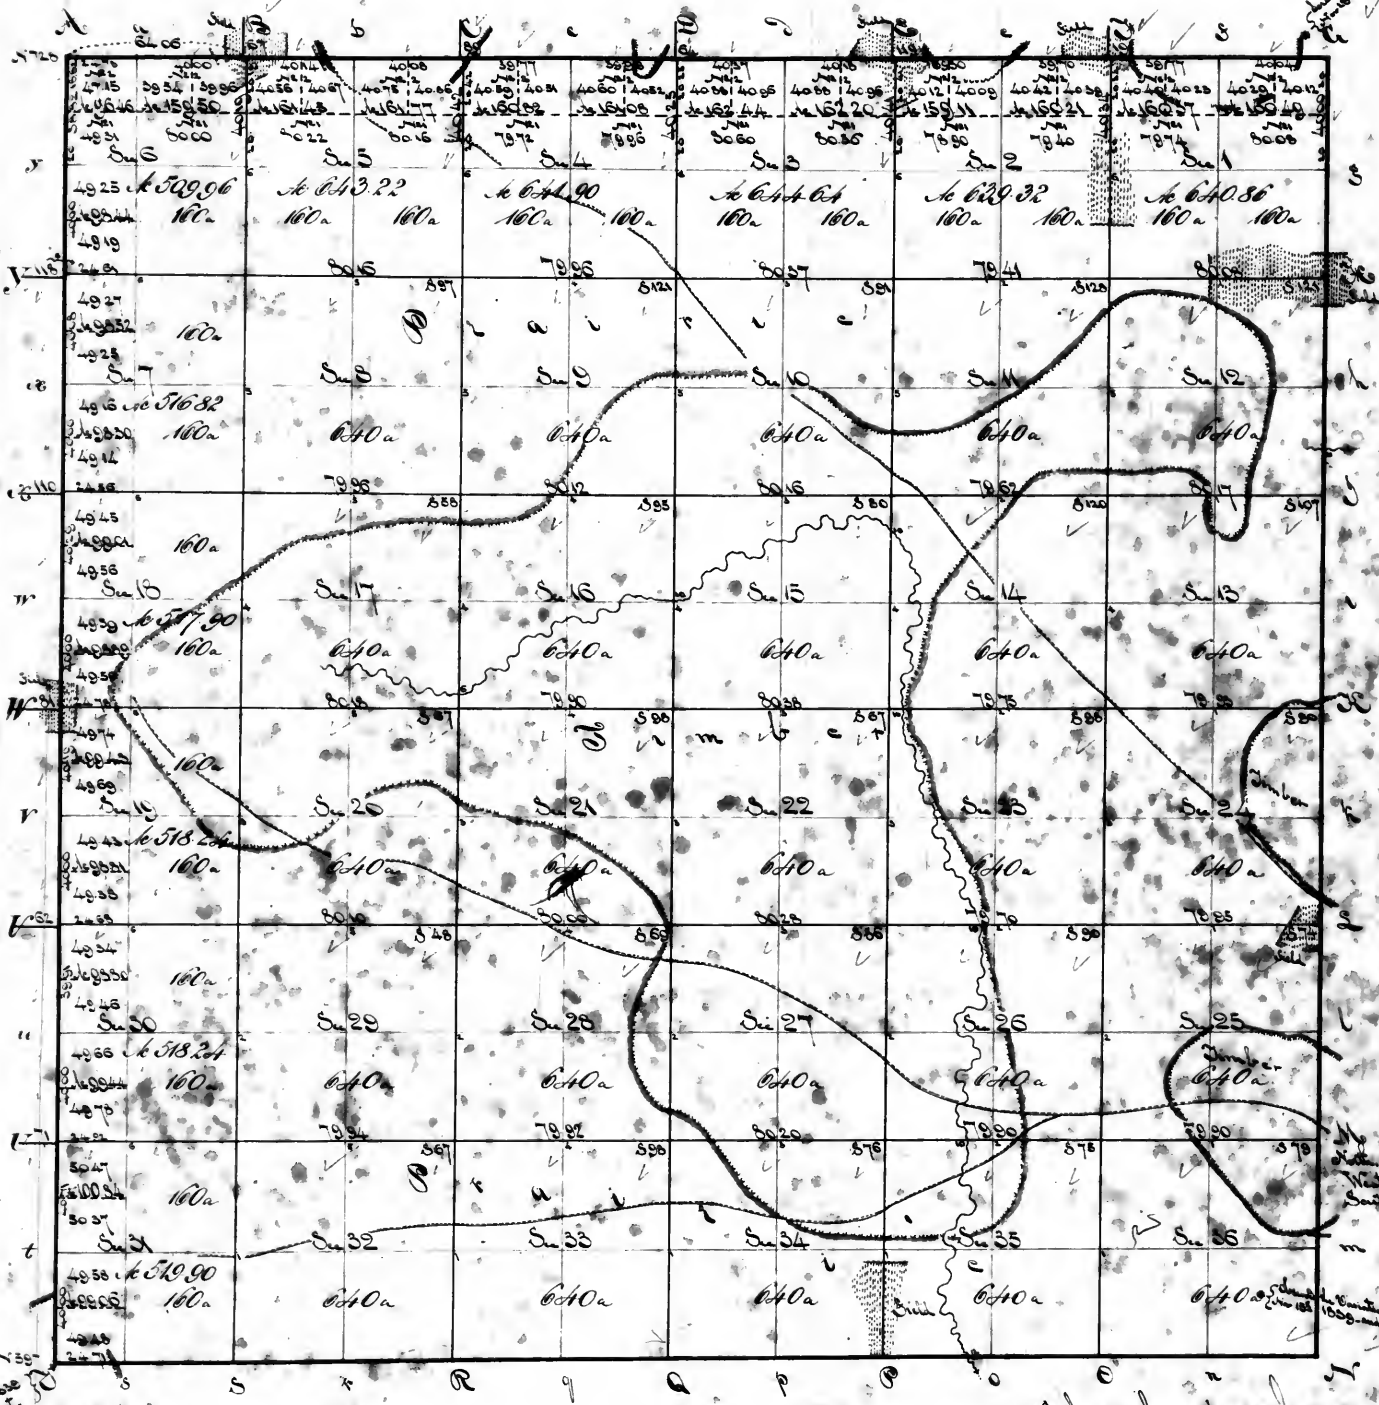

variation
 North and boundaries subdivisions 6' - East
 West boundary 6' 10" East
 South boundary 5' 55" East

Scale of 40 chains to an inch
 Aggregate Area - 2224.00 Acres.


Surveyors office, Saint Louis, 25th of August 1842.

The above plat of township 40 north of the base line range 7 east of the 3^d principal meridian is strictly conformable to the field notes of the survey the-
 recd on file in this office which have been examined and approved. The south boundary 5 miles 64.71 chains:- the east boundary 6 miles:- the north boundary
 5 miles 64.06 chains, and the west boundary 6 miles, were surveyed in the 4th quarter of 1832, by James Thompson and John P. Thompson, under their
 joint contract of the 21st of September of the same year: they were paid for in the 3^d quarter of 1840, and charged in the account current of the Surveyor
 General during the same quarter, Voucher N^o 17- The subdivision lines 59 miles 5.20 chains, were surveyed in the 4th quarter of 1840, by James
 Thompson, and John P. Thompson, under their joint contract of the 18th of September 1840:- they were paid for in the 3^d quarter of 1842, and
 charged in the account current of the Surveyor General during the said 3^d quarter Voucher N^o 7.

Silas Reed

Surveyor of the public lands in
 the States of Illinois & Missouri.

Township 41 North of the base line Range 7 East of the 3^d principal Meridian

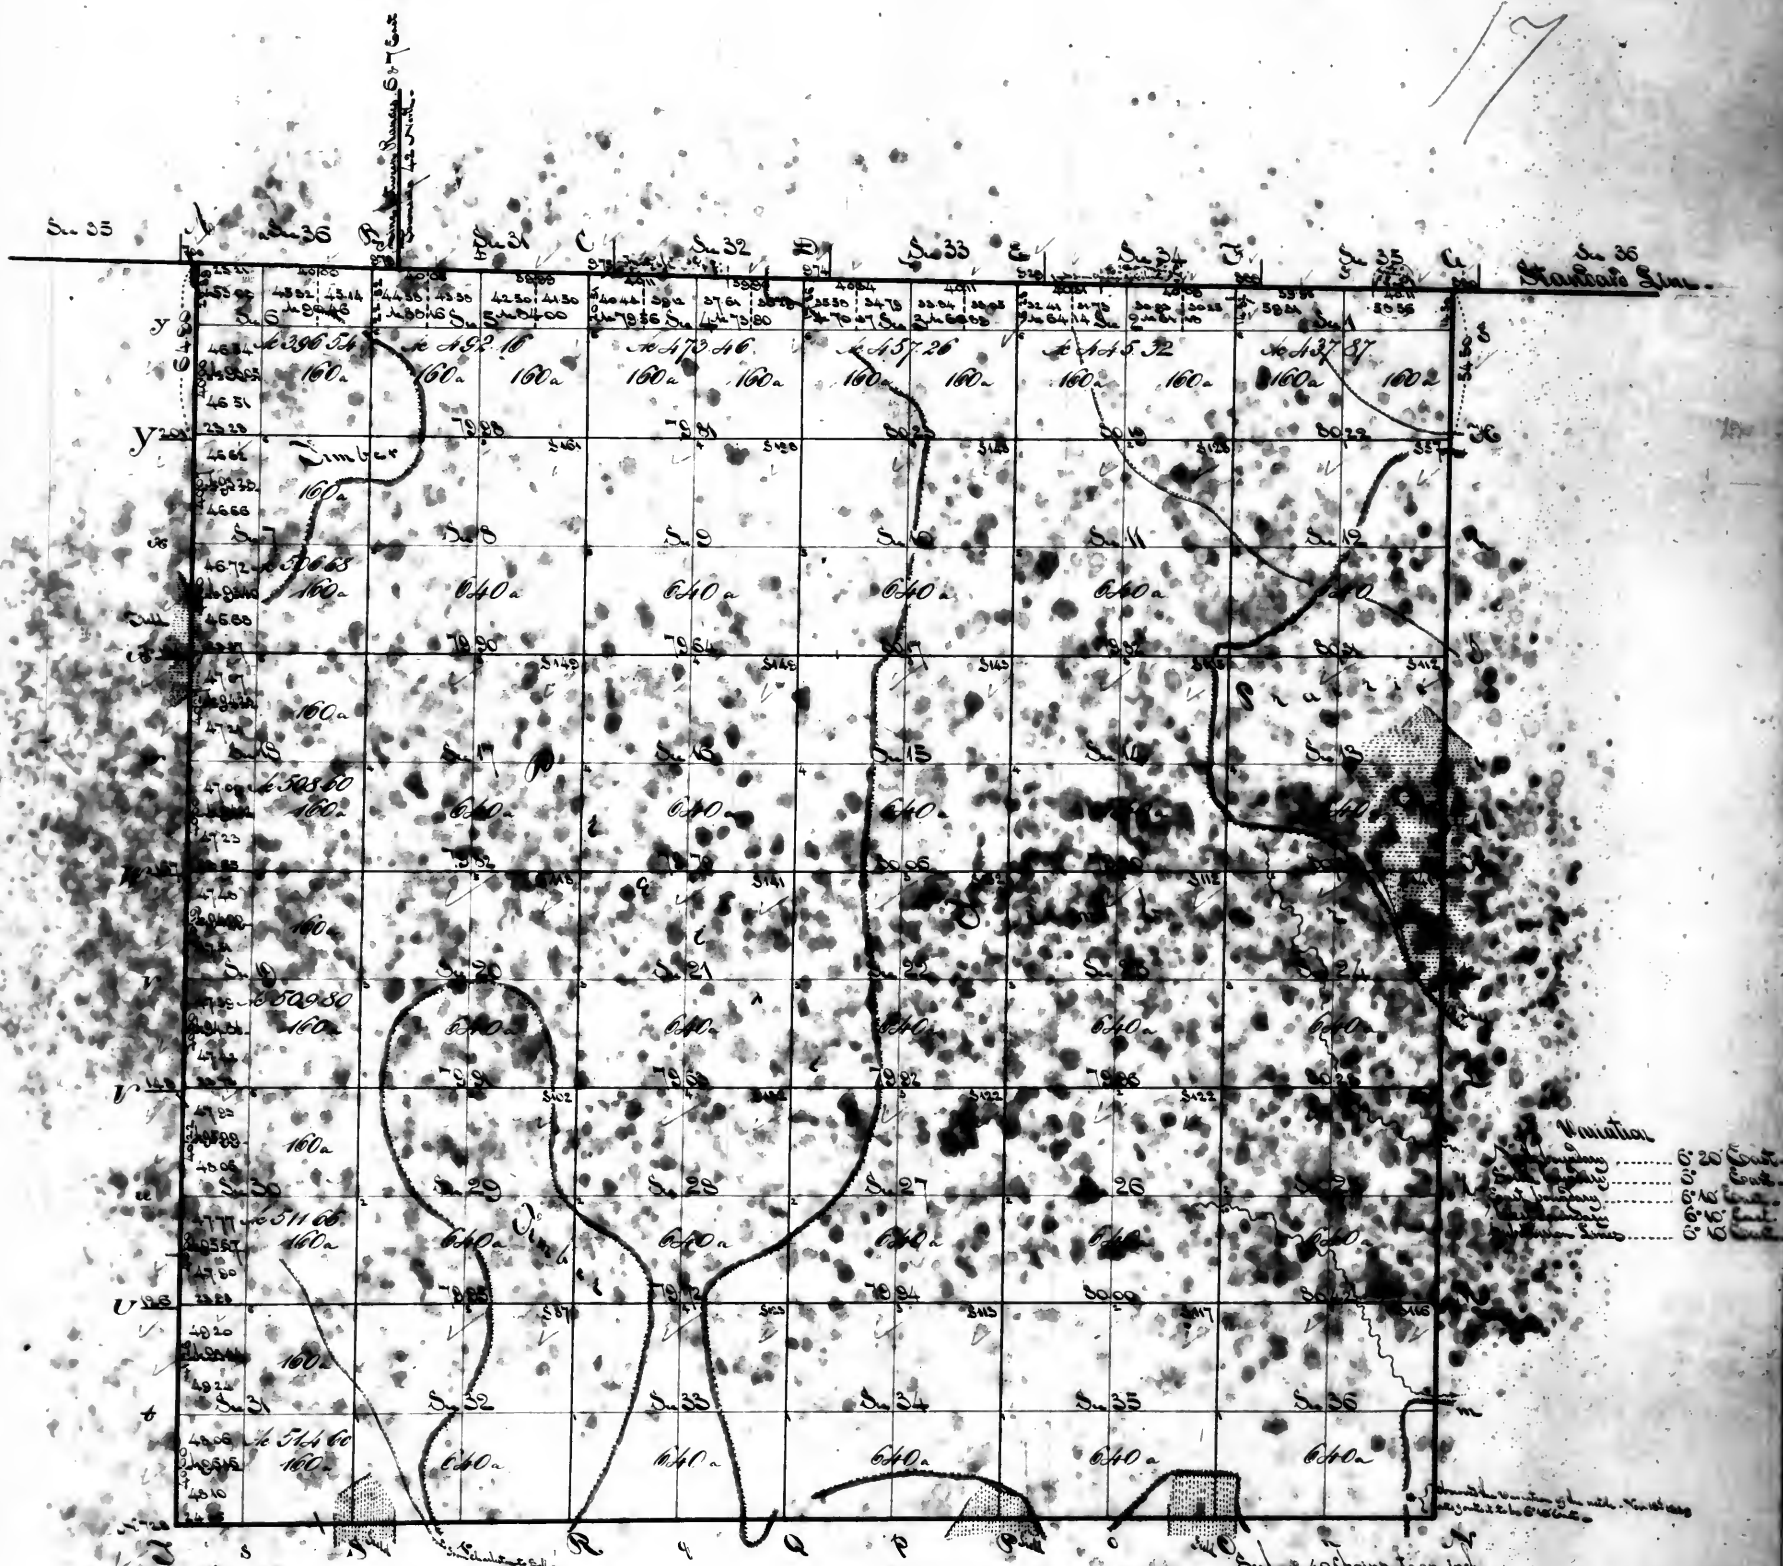


Surveyors Office. Saint Louis 25th of August 1842.

The above plat of township 41 north of the base line, range 7 east of the 3^d principal meridian is strictly conformable to the field notes of the survey thereof on file in this office which have been examined and approved. The north boundary 5 miles 64.20 chains, was surveyed in the 2^d quarter of 1837, by James Thompson, under contract signed by the Surveyor on the 21st of November and by Thompson on the 15th of December, 1836:— it was paid for in the 1st quarter of 1838, and charged in the account current of the Surveyor General during the same quarter, Voucher N° 6— The south boundary 5 miles 64.06 chains:— the east boundary 5 miles 54.50 chains—and the west boundary, 5 miles 64.00 chains, were surveyed in the 4th quarter of 1839, by James Thompson and John S. Thompson, under their joint contract of the 21st of September of the same year:— they were paid for in the 3^d quarter of 1840, and charged in the account current of the Surveyor General during the same quarter, Voucher N° 17— The subdivision lines 57 miles 48.91 chains, were surveyed in the 4th quarter of 1840, by James Thompson and John S. Thompson, under their joint contract of the 18th of September of 1840; they were paid for in the 3^d quarter of 1842, and charged in the account current of the Surveyor General during the said 3^d quarter, Voucher N° 17.

Silas Reed
Surveyor of the public lands
in the State of Missouri

Township 42 North of the base line Range 7 East of 3^d principal Meridian

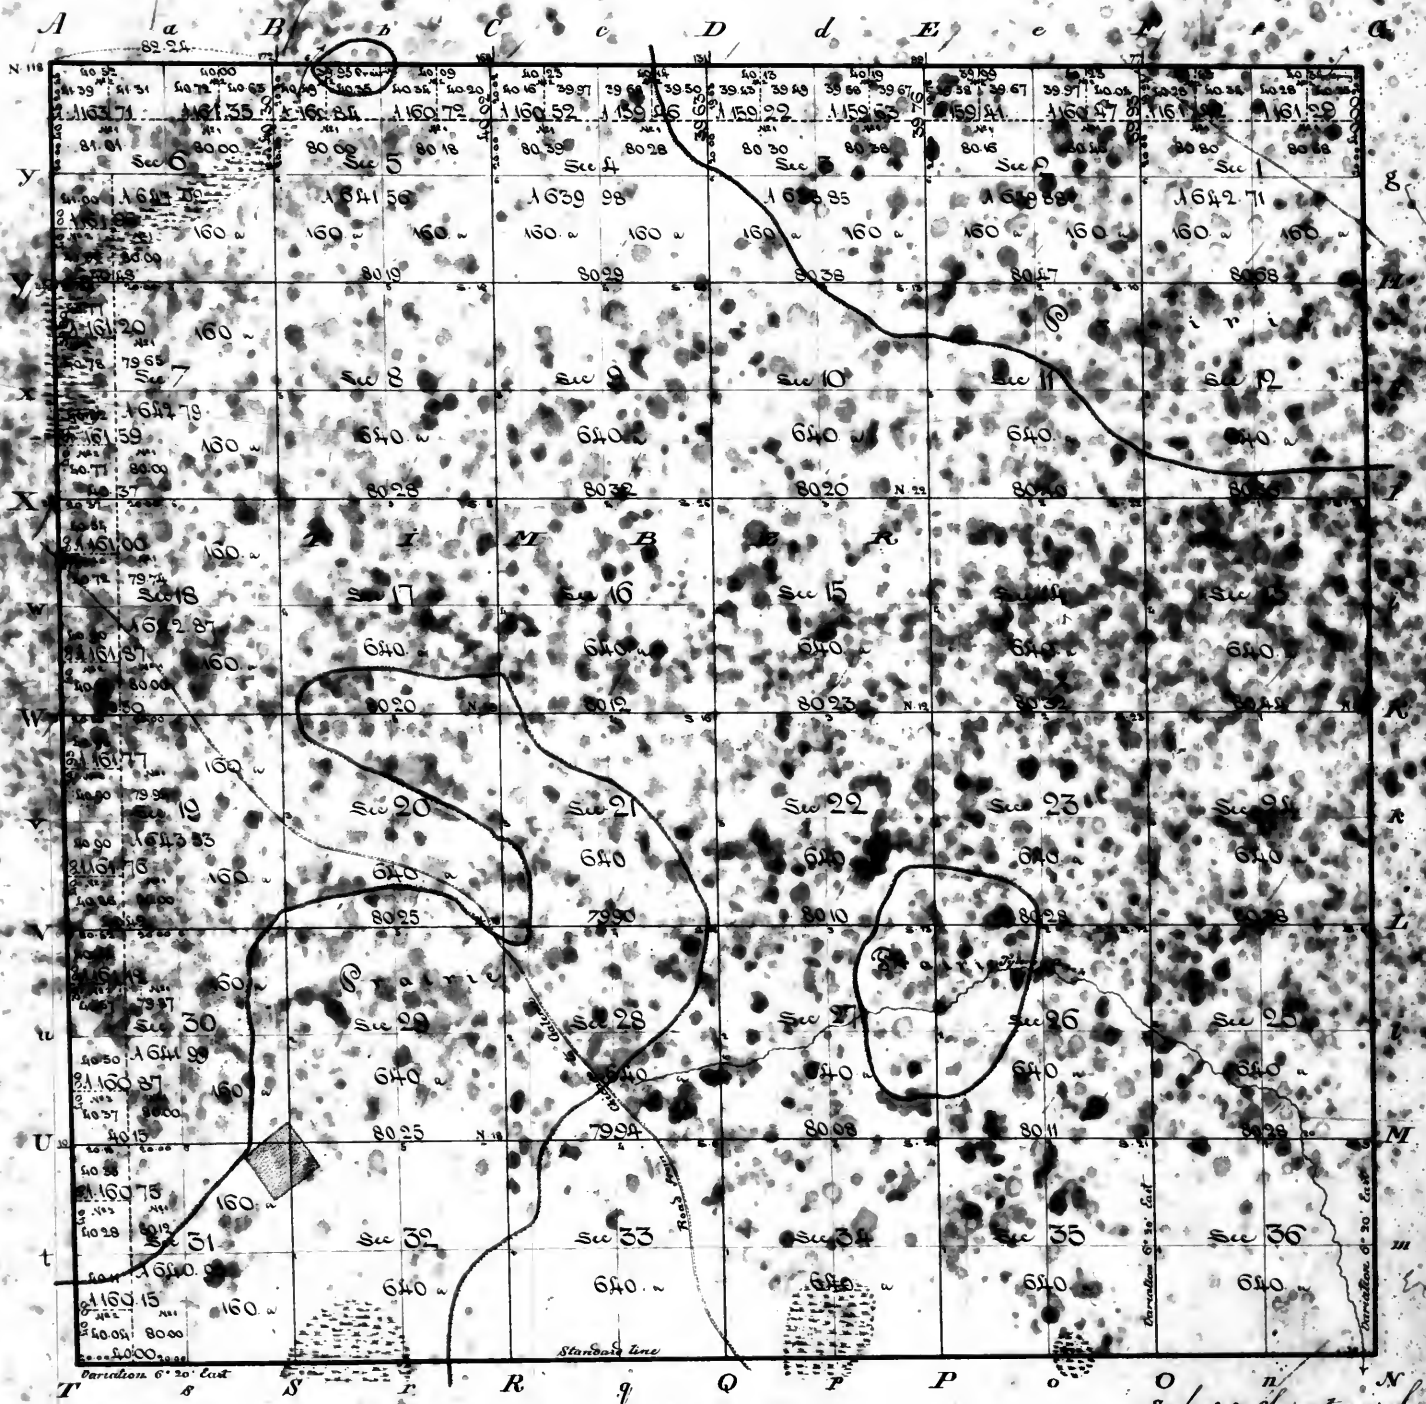

Surveyors Office.


Dated June 30th of May 1859

The above plat of Township 42 north of the base line range 7 east of the 3^d principal meridian, is strictly conformable to the field notes of the survey thereof on file in this office, which have been examined and approved. - The south boundary - the west boundary - and the east boundary (6 miles each) - and the north boundary (6 miles 2.24 chains) were surveyed in the 2^d quarter of 1857; and the subdivision lines (60 miles 8.21 chains) were surveyed in the 3^d quarter of 1857; all by James Thompson under contract, signed by the Surveyor General on the 23rd of November and by the said Thompson on the 15th day of December 1856 - the said surveys were paid for in the 3^d quarter of 1859 and charged in the account current of the Surveyor General for that quarter. - (Book 22.6)

William Milburn
Surveyor General

Scale of 40 chains to an inch.
Aggregate Area 23062.08 acres

Township 43 North of the base line Range 7 East of the 3^d principal Meridian

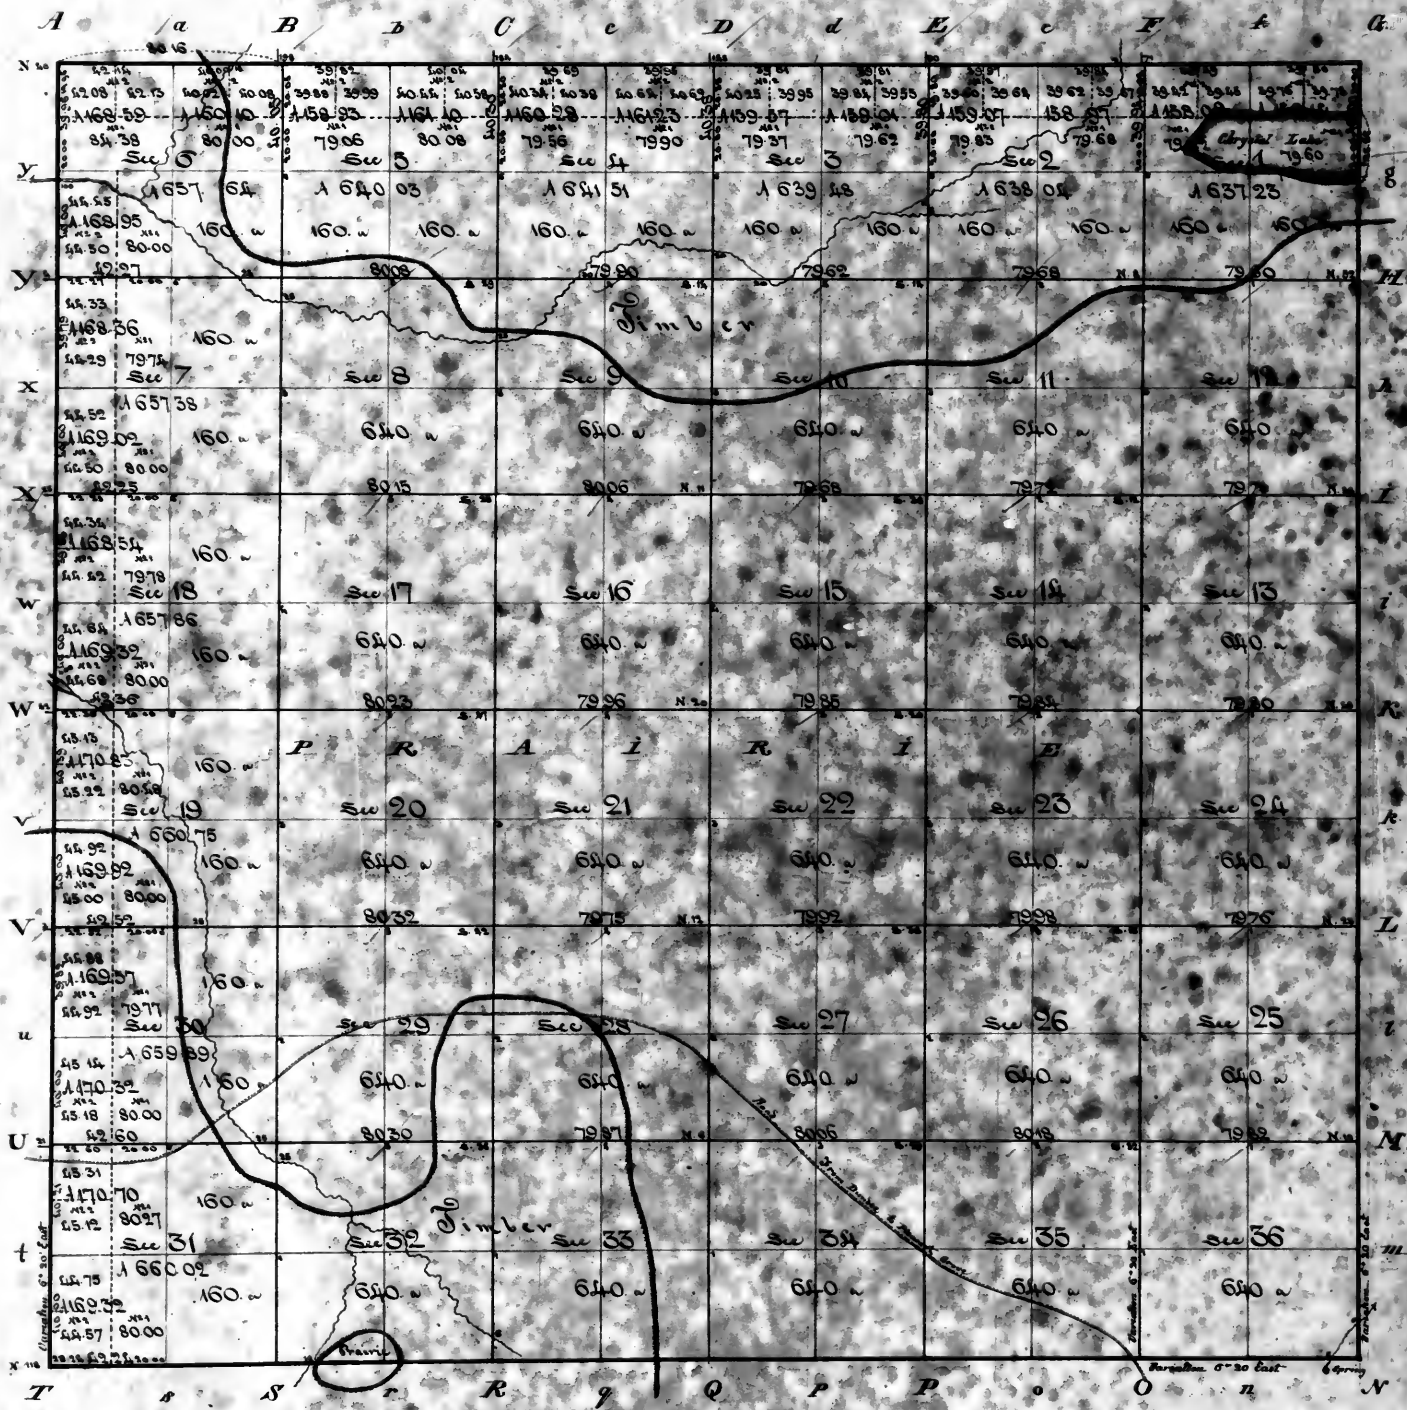

Surveyors office.

Saint Louis, 30th of May 1839

The above plat of township 43 north of the base line, range 7 east of the 3^d principal meridian, is strictly conformable to the field notes of the survey thereof, on file in this office, which have been examined and approved. The west and east boundaries, 6 miles each, the South boundary, 6 miles 2.24 chains, and the North boundary, 6 miles and 16 links, were surveyed in the 2^d quarter of 1837, and the subdivision lines, 60 miles 10.31 chains, were surveyed in the 3^d quarter of 1837 - all by James Thompson, under contract signed by the Surveyor General on the 21st of November, and by the said Thompson on the 15th of December 1836. The said surveys were paid for in the first quarter of 1839, and charged in the account of the Surveyor General for that quarter. (Voucher No. 6.)


Scale of 40 chains to an inch.

Aggregate Area 23429.83 acres

William Milburn
Surveyor General

Township 44 North of the base line Range 7 East of the 3^d principal Meridian

20

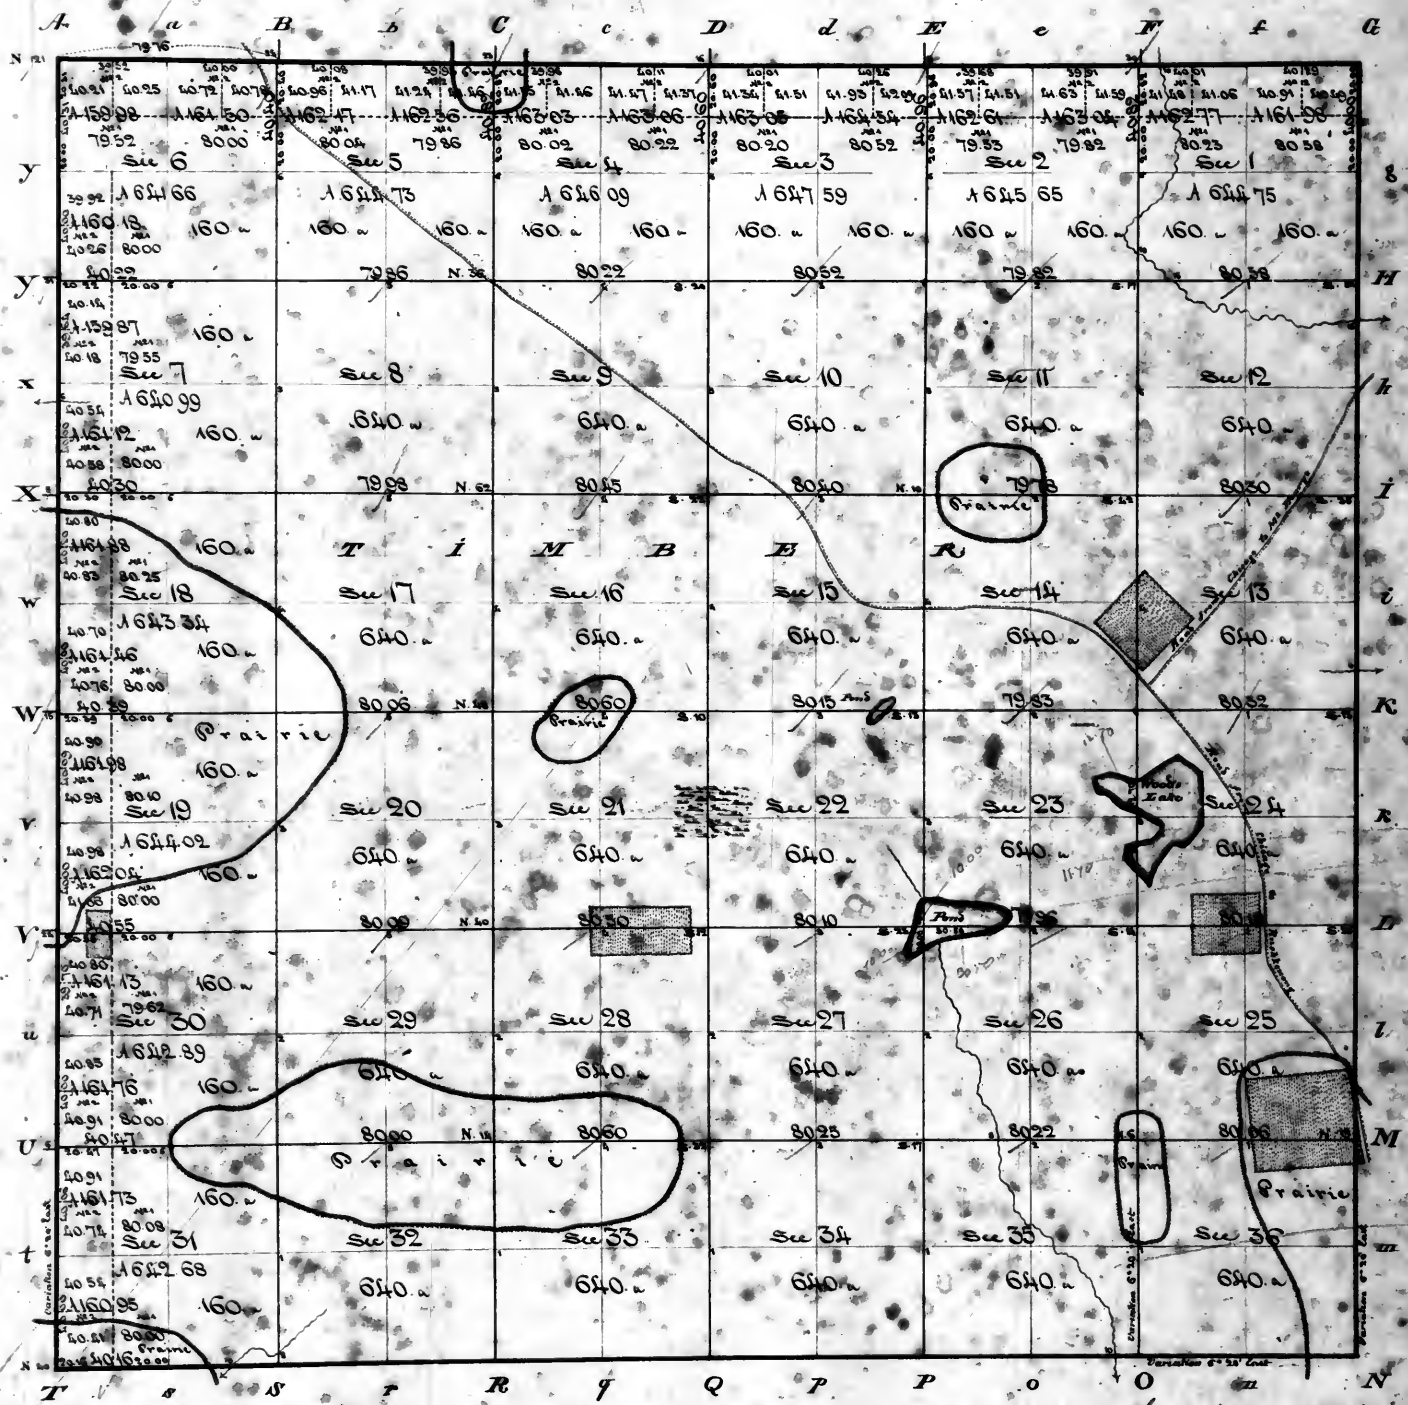

Surveyors Office.
Saint Louis 3^d of May 1839


Scale of 20 Chains to an inch.
Aggregate Area 23084.39 Acres.

The above plat of Township 44 North, of the base line, range 7 East of the 3^d principal meridian, is strictly conformable to the field notes of the survey thereof on file in this office, which have been examined and approved. — The east and west boundaries, 6 miles each, The south boundary 6 miles and 16 links — and the north boundary 5 miles 79.76 chains, were surveyed in the 2^d quarter of 1837, and the subdivision lines 60 miles 10.36 chains, were surveyed in the 3^d quarter of 1837 — all by James Thompson, under contract signed by the Surveyor General on the 25th of November and by the said Thompson on the 15th of December 1836 — The said surveys were paid for in the 3^d quarter of 1839, and charged in the account of the Surveyor General for that quarter — (Voucher 206.)

William Milburn
Surveyor General

Township 45 North of the base line Range 7 East of the 3^d principal Meridian

21

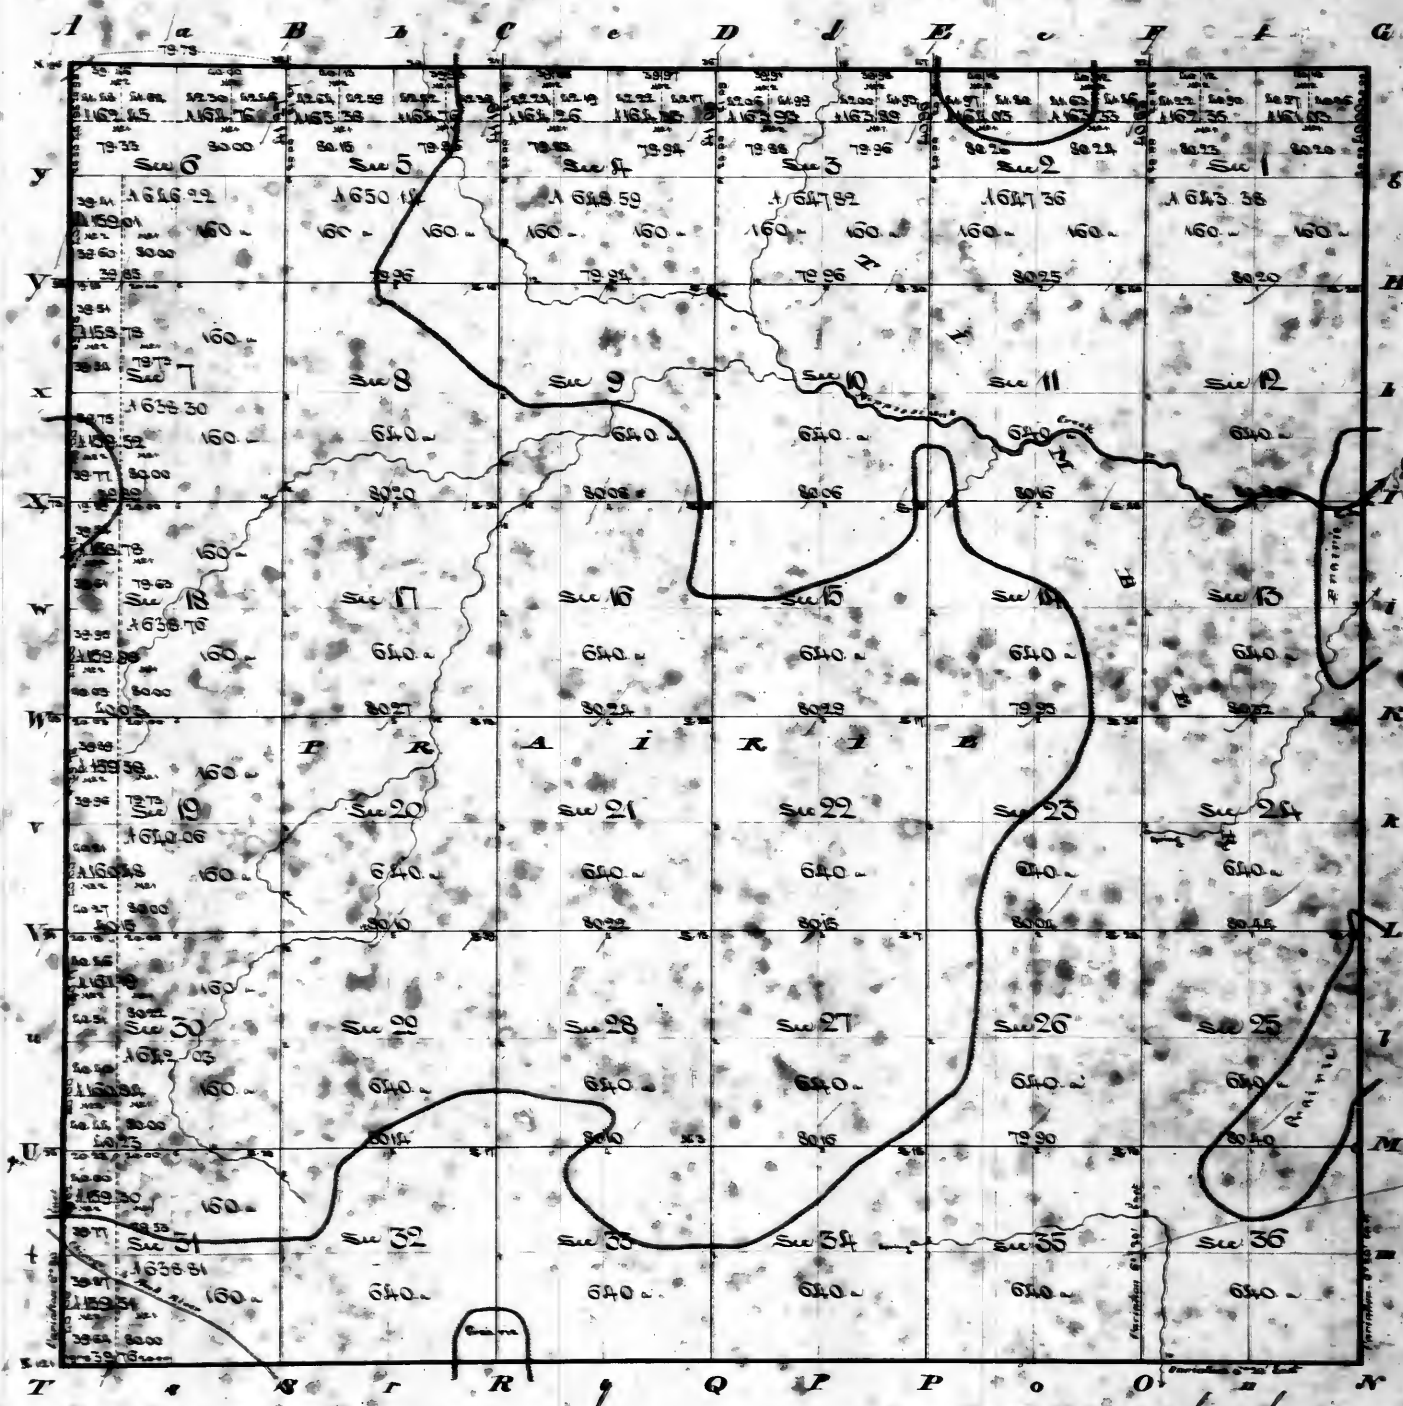

Surveyor's Office


Scale of 10 chains to an inch
Approximate Area 23000.57 acres

The above plan of township 45 north of the base line range 7 east of the 3^d principal meridian, is strictly conformable to the field notes of the survey thereof on file in this office which have been examined and approved - The west and east boundaries (6 miles each) - the south boundary (6 miles 79.76 chains) - and the north boundary (5 miles 79.78 chains) were surveyed in the 2^d quarter of 1857 - and the subdivision lines (6 miles 2.10 chains) were surveyed in the 3^d quarter of 1857; all by James Thompson, under contract signed by the Surveyor General on the 2^d of November and by the said Thompson on the 15th of December 1858 - The said survey were paid for in the 1st quarter of 1859, and charged in the account current of the Surveyor General for that quarter. (Encha 206.)

William Milburn
Surveyor General
JH

Township 26 North of the base line Range 7 East of the 3^d principal Meridian

22

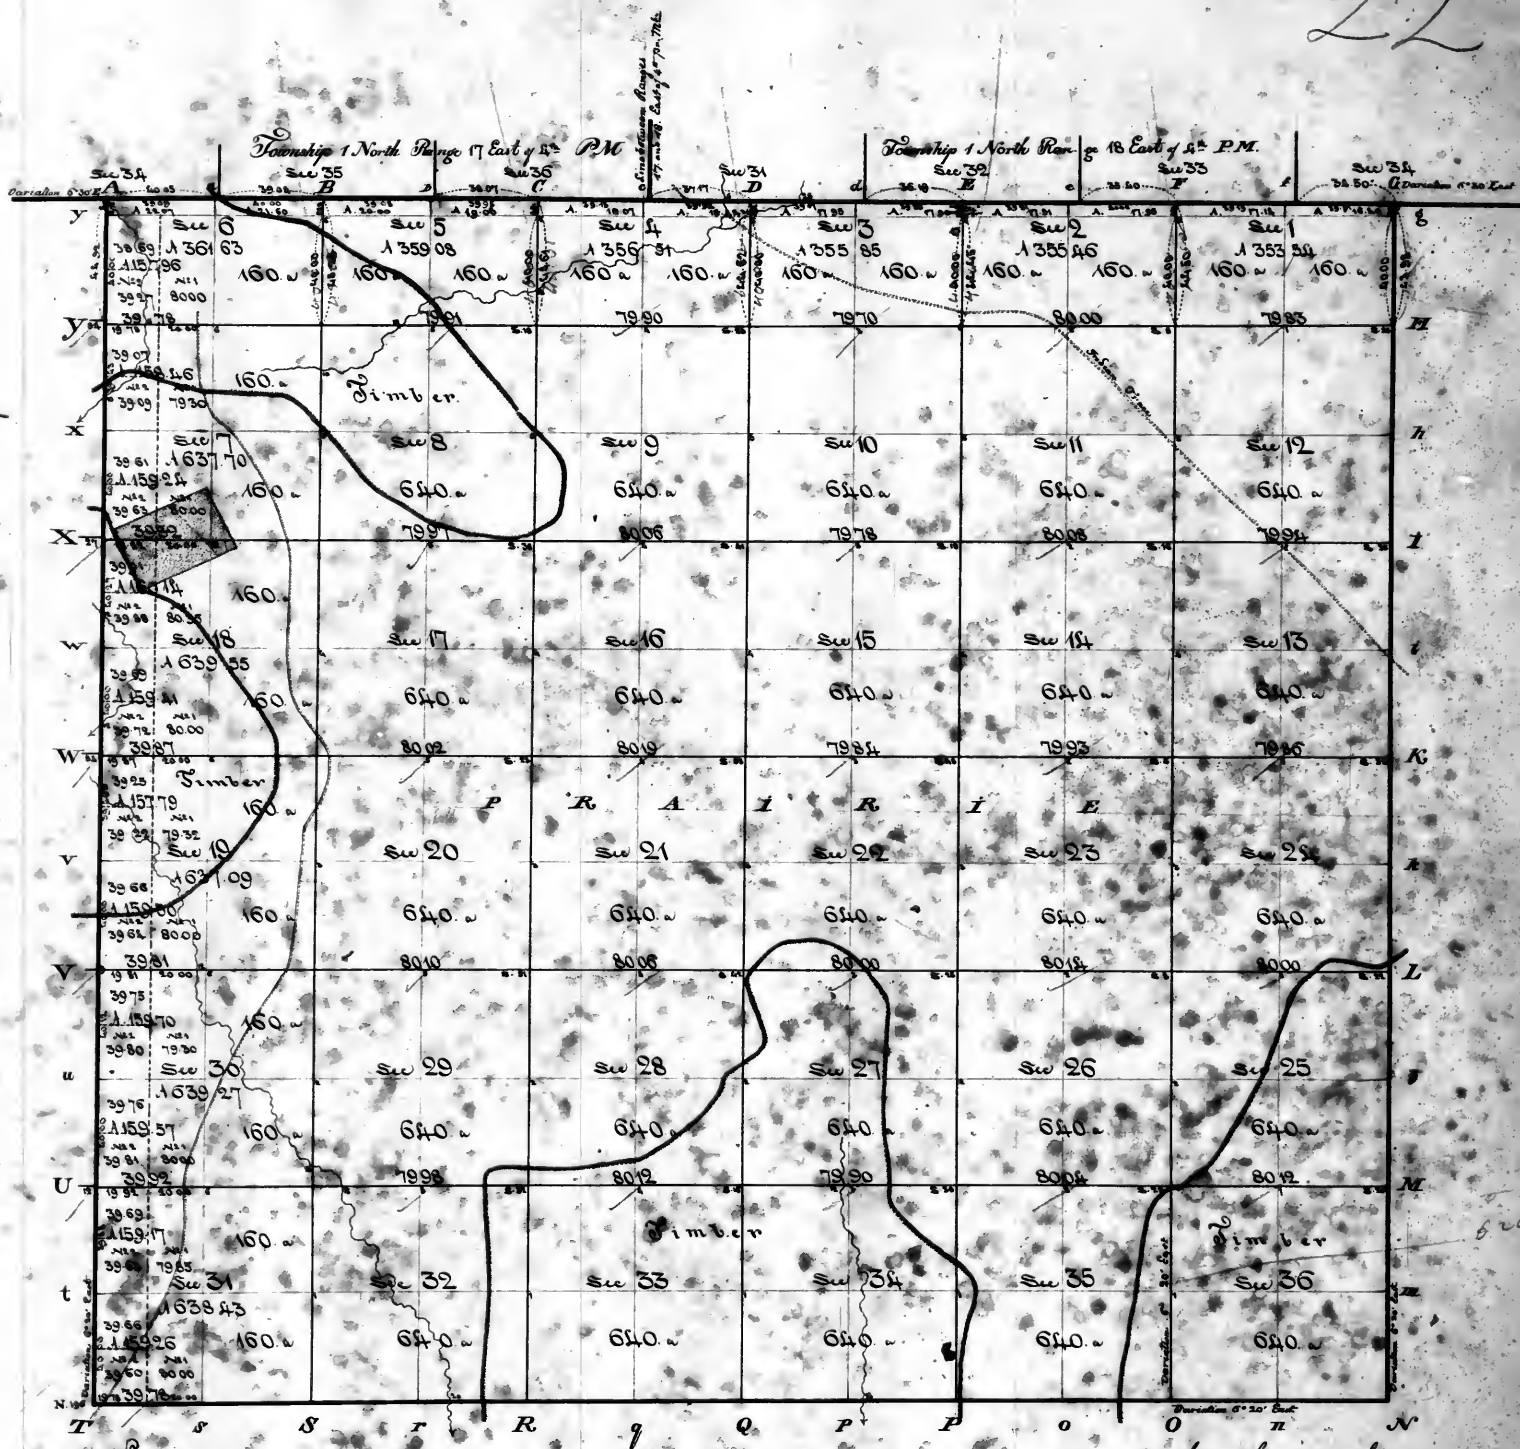

Surveyors Office.


Saint Louis 2^d of May 1859

The above plan of township 26 north of the base line range 7 east of the 3^d principal meridian, is strictly conformable to the field notes of the survey thereof on file in this office, which have been examined and approved - The north boundary, 5 miles 74.66 chains, was surveyed in 1832 and 1833, by Lewis Lyon, commissioner on the part of the United States, as certified to this office by M. J. Williams, Surveyor General of the public lands in Ohio, Indiana and Michigan - The said north boundary being a part of the boundary line between Illinois and Michigan, now Wisconsin - The west boundary 5 miles 44.02 chains and the south boundary, 5 miles 79.78 chains were surveyed in the 2^d quarter of 1837 - and the east boundary, 5 miles 43.98 chains, and the subdivision lines (57 miles 62.13 chains) were surveyed in the 3^d quarter of 1837 - all by James Thompson, under contract signed by the Surveyor General on the 21st of November, and by the said Thompson on the 15th of December 1836 - The said surveys by Thompson were paid for in the 3^d quarter of 1839, and charged in the account of the Surveyor General for that quarter (see her 256.)

William Melbourne
Surveyor General

[Signature]

23

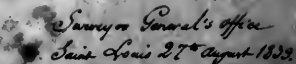

Reference to the field notes made in
the construction of this tract
of the North boundary set apart
and 28° + 28° March 1892
of the East-North & West boundary
of this division made by John M.
Wardman & Benjamin F. Mea-
dow under their contract of the
number 1833 and changed
on account of the 18° of
the
East boundary of Ward-
man the 28° of October
signifying by Wardman Mea-
dow 22° of October 1890
and 10° of October 1892
division line of Wardman
Meadow and from 18° to
October 1893 and 22° of
October 1894




William
B. Sawyer

Office
10th Sept. 1842.
North halves of Secs 1, 2, 3
the NE. quarter of Sec. 6 and
all of Secs 7, 12, 13, 20 & 31,
are to the benefit of the Genl
co.
D. of June 1842,
all the sub-
-sion mentioned
to the Register
Illinois -

Supreme Office
St. Louis 11th September 1833


The above Part of Township 25 North of the base line, Range 8 East of 2^d principal Meridian is conformable to the field notes of the survey thereof on file in this Office.

E. J. Langham

Aggregate Area... 26,437 Acres

Township 26 North of the base line Range 8 East of 3rd principal Meridian.

23

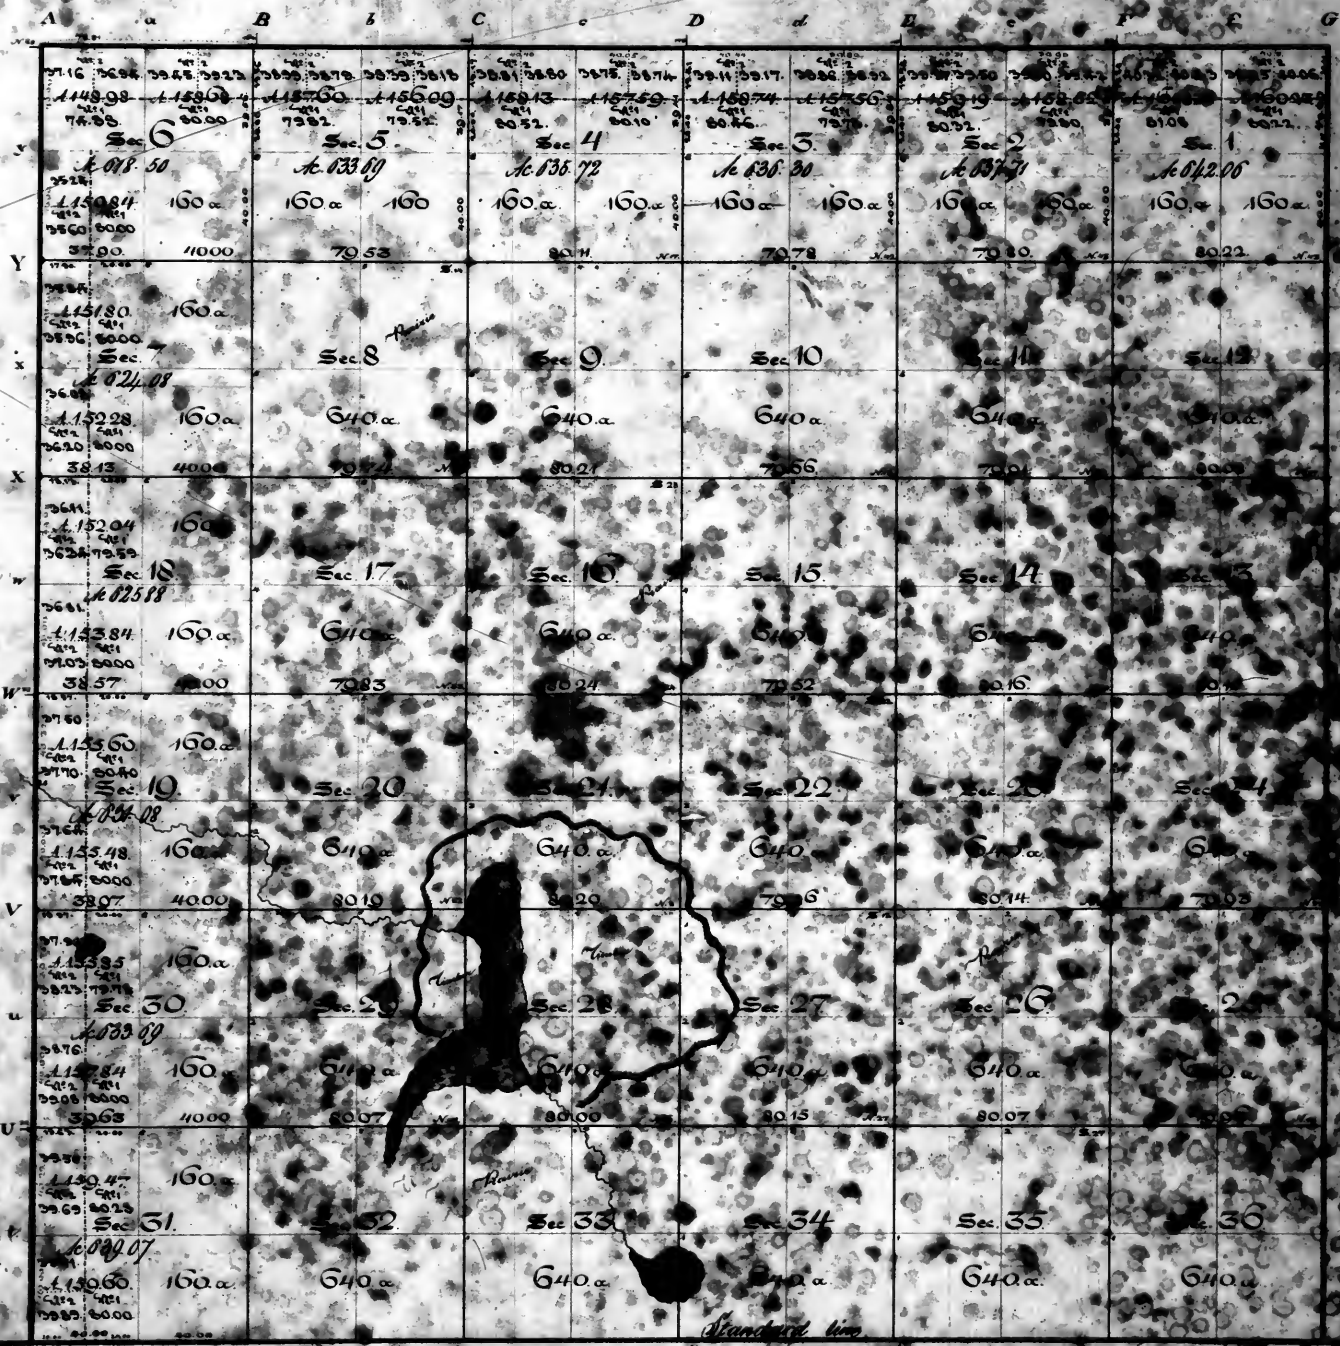

*Survey on General's office
Saint Louis 27th August 1852*

*Reference to the field notes used in
the construction of this plat
of the North boundary not signed
and 20th & 25th of March 1823
of the East North & West boundaries
& subdivision lines by John M.
Bainbridge & Benjamin F. Mc
Gowan under their contract of the
10th of October 1822 and changed
in accordance with the 10th of
October 1825*

*The North boundary of this
township was surveyed at
the corner of Sec 36 East





*Witness
James J. Davenport*

*Office
10th Sept. 1842
the North halves of Secs 12, 13
of the N.W. quarter of Sec. 6 and of
halves of Secs 7, 18, 19, 20, 21, 22,

Township 27 North of the base line Range 8 East of 3^d principal Meridian

24

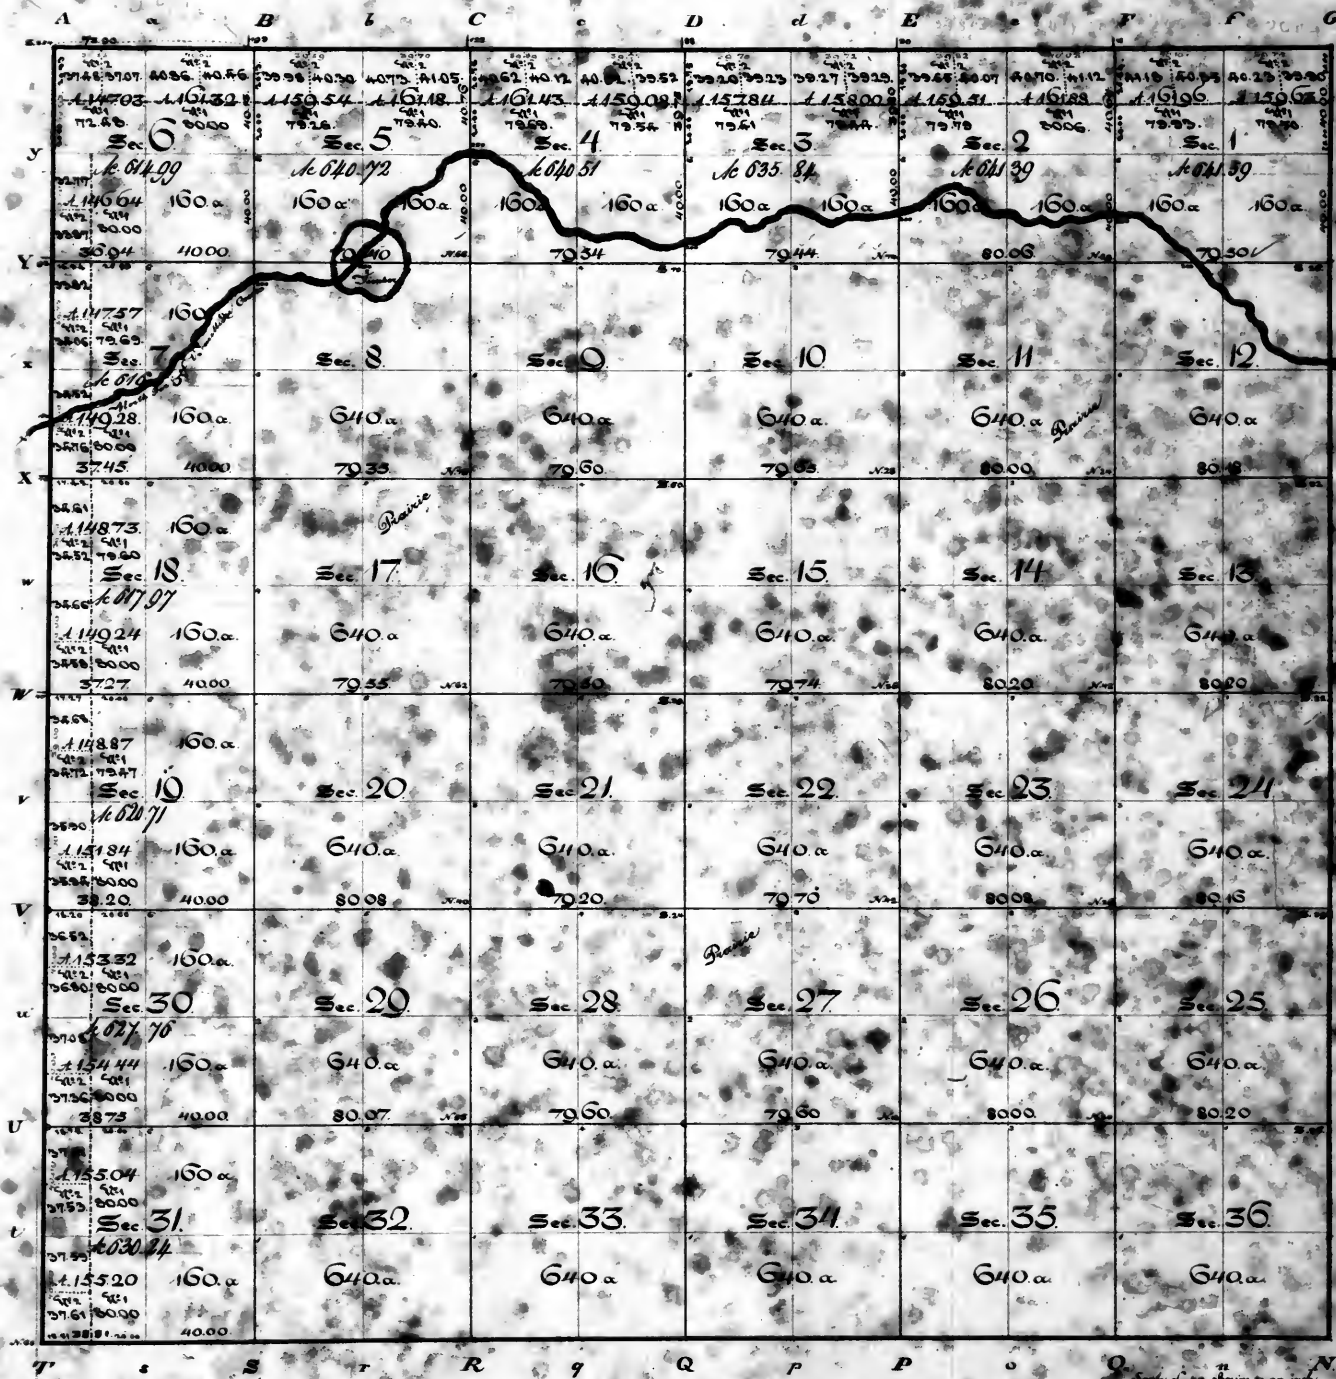

Surveyor General's Office.
St. Louis 27th August 1832.
The field notes and in the construction
of the Plat are by John W. Mason
and Benjamin F. Massinger
under their contract of the 2^d of Sep-
tember 1832 and changed for in their
account of the 14th of February 1833.
The acts of the South boundary by
John F. Massinger are dated
12th of October 1833.
East boundary by John F.
Massinger are dated 24th
of October 1833.
North boundary by John F.
Massinger are dated 28th
of October 1833.
West boundary by John W.
Mason are dated 22^d of
October 1833.
Subdivision lines by John
F. Massinger are dated
from 12th of October to
the 3^d of November 1833.

The West boundary was surveyed at
a Variation of 7th East.
The South boundary was surveyed at
a Variation of 7th East.
The East & North boundaries
& the Subdivision lines were sur-
veyed at a Variation of 7th 45'
East.
Mathewson Mathewson
River surveyor
Jt

Surveyor's Office
St. Louis 10th Sept. 1832.
Plat of Township 27 North of base line
& Range 8 East of 3^d principal Meridian
the West boundary of township 27 North of base line
and Range 8 East of 3^d principal Meridian
surveyor's office
St. Louis June 15th 1849.
Plat of the North boundary of township
1, 2, 3, 4, 5, 6, of the South West
quarter of section 6, and of the West
half of sections 7, 18, 19, 30 & 31
set this day to the Register of the
Aggregate Area 22928.57 acres land office at St. Louis.

Surveyor's Office
St. Louis 11th September 1832.
The above Plat of Township 27 North of the base line Range 8 East of 3^d principal Meridian is conformable
to the field notes of the survey thereof on file in this Office
E. J. Sangham

Township 28 North of the base line Range 8 East of 3rd principal Meridian

25


Surveyor General's Office
St. Louis 27th of August 1855.
The field notes used in the construction of this Plat are by John W. Messinger & Benjamin F. Messinger under their contract of the 2nd of Sep. 1853 and changed for in their report of the 14th of February 1855. The date of the South boundary by Benj. F. Messinger are dated 25th of October 1853.
East boundary by Benj. F. Messinger are dated 6th of November 1853.
North boundary by Benj. F. Messinger are dated 7th of November 1853.
West boundary by John W. Messinger are dated 4th of November 1853.
Subdivision lines by Benj. F. Messinger are dated for 12th & 17th of November 1853.

The West boundary was surveyed at a variation of 7th 40' East.
The South East & North boundaries of the Subdivision lines were surveyed at a variation of 7th 45' East.
William Melbourne
Surveyor General

Surveyor's Office
St. Louis 16th of Sept. 1855.
Surveyor's Office
St. Louis June 15th 1849.

Surveyor's Office
St. Louis 11th of September 1855.
This above Plat of Township 28 North of the base line Range 8 East of 3rd principal Meridian is conformable to the field notes of the Survey thereof on file in this Office.
E. J. Langham

Aggregate Area = 22706.35 acres.

Township 29 North of the base line Range 8 East of 3^d principal Meridian

26

A 638.94
1109.32
55.31
27.88
40.00 | Sec 4

318.54

Surveyor General's Office.
Saint Louis 27th of August 1839.
The field notes used in the construction of this plat, are by John Mc Messinger and J. Thompson & Messinger under their contract of the 2^d of September 1838 and changed for in their second plat of the 14th of February 1839.
The plat of the South boundary by J. Thompson & Messinger was dated 7th of November 1838.
East boundary by J. Thompson & Messinger was dated 10th of November 1838.
North boundary by J. Thompson & Messinger was dated 6th of November 1838.
West boundary by J. Thompson & Messinger was dated 22nd of April 1839.
Subdivision lines by J. Thompson & Messinger were dated for the 20th & the 24th of the month 1838 and 12th & 15th of May 1839.

William Sullivan
Surveyor General
JH


Surveyor's Office.
St. Louis 27th Sept. 1839
On plat of the North halves of Sec 12, 23, 34, 35, 36, and of the West halves of Sec 7, 18, 19, 30, 31, and this day to the Commr of the Land Office.
Surveyor's Office.
Saint Louis August 5th 1840.
Plat of the North halves of sections 1, 2, 3, 4, 5 & 6, of the South West quarter of sections 6, and of the West halves of sections 7, 18, 19, 30 & 31 and this day to the Register of the Land Office at Danville.

Surveyor's Office.
St. Louis 11th of September 1839
The above plat of Township 29 North of the base line Range 8 East of 3^d principal Meridian is conformable to the field notes of the survey thereof on file in this Office
E. J. Sangham

Aggregate Area... 22502.08. Acres

Township 30 North of the base line Range 8 East of 3^d principal Meridian

27

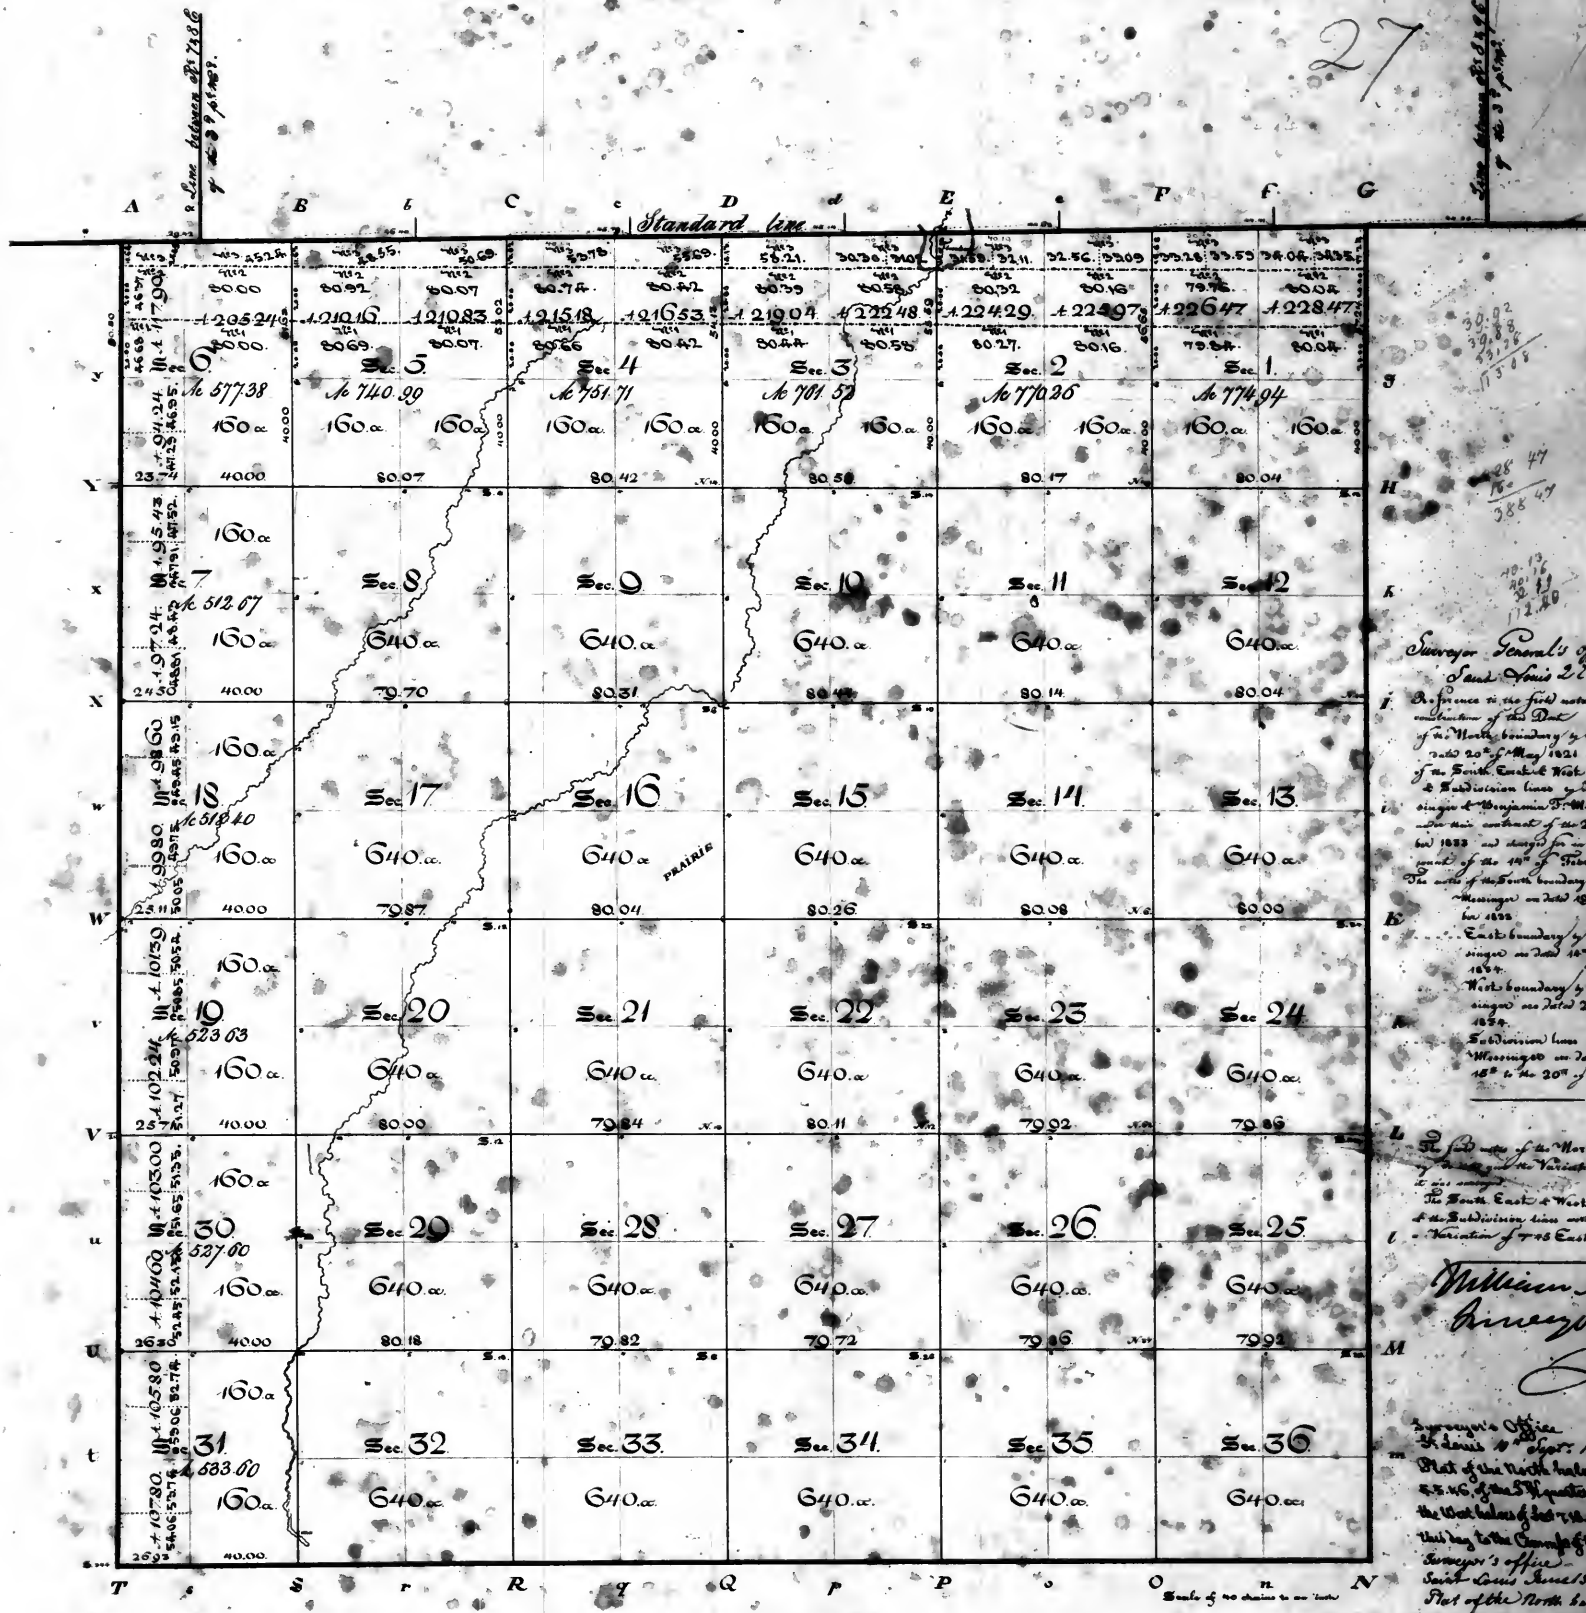

Surveyor General's Office
St. Louis 2^d of August 1854
Reference to the field notes and in the
recognition of the Plat
of the North boundary of John
and 20th of May 1851
of the South, East and West boundaries
of the subdivision lines of John M. Mos-
singuer & Benjamin B. Messinger
and their contract of the 2^d of September
1853 and changed for in their con-
tract of the 14th of February 1855
The north of the South boundary of Messinger
for 1855
East boundary of Messinger
signed on 20th of May 1854
North boundary of Messinger
signed on 20th of May 1854
Subdivision lines of Messinger
signed on 20th of May 1854

Plat of the North boundary
of the Township at St. Louis
The South, East & West boundaries
of the subdivision lines and
variation of 7th of East

William Mulburn
Surveyor General

Surveyor's Office
St. Louis 14th of Sept. 1854
Plat of the North halves of sections
5, 6, 7, of the North half of section 6, and of the West halves of sections 7, 18, 19, 30 & 31, and this plat
being to the Commission for the plat of the
Surveyor's office
St. Louis 15th of Sept. 1854
Plat of the North halves of sections
1, 2, 3, 4, 5 & 6, of the South half of section 6, and of the West halves of
sections 7, 18, 19, 30 & 31, and this plat
to the Report of the Surveyor General
at St. Louis

Surveyor's Office
St. Louis 17th of September 1854


The above Plat of Township 30 North of the base line Range 8 East of 3^d principal Meridian is conformable to the field
notes of the Survey thereof on file in this Office

E. J. Sangham

Aggregate Area 22992.70 acres

Township No 32 North of the base line Range No 8 East of the 3rd principal meridian.

29

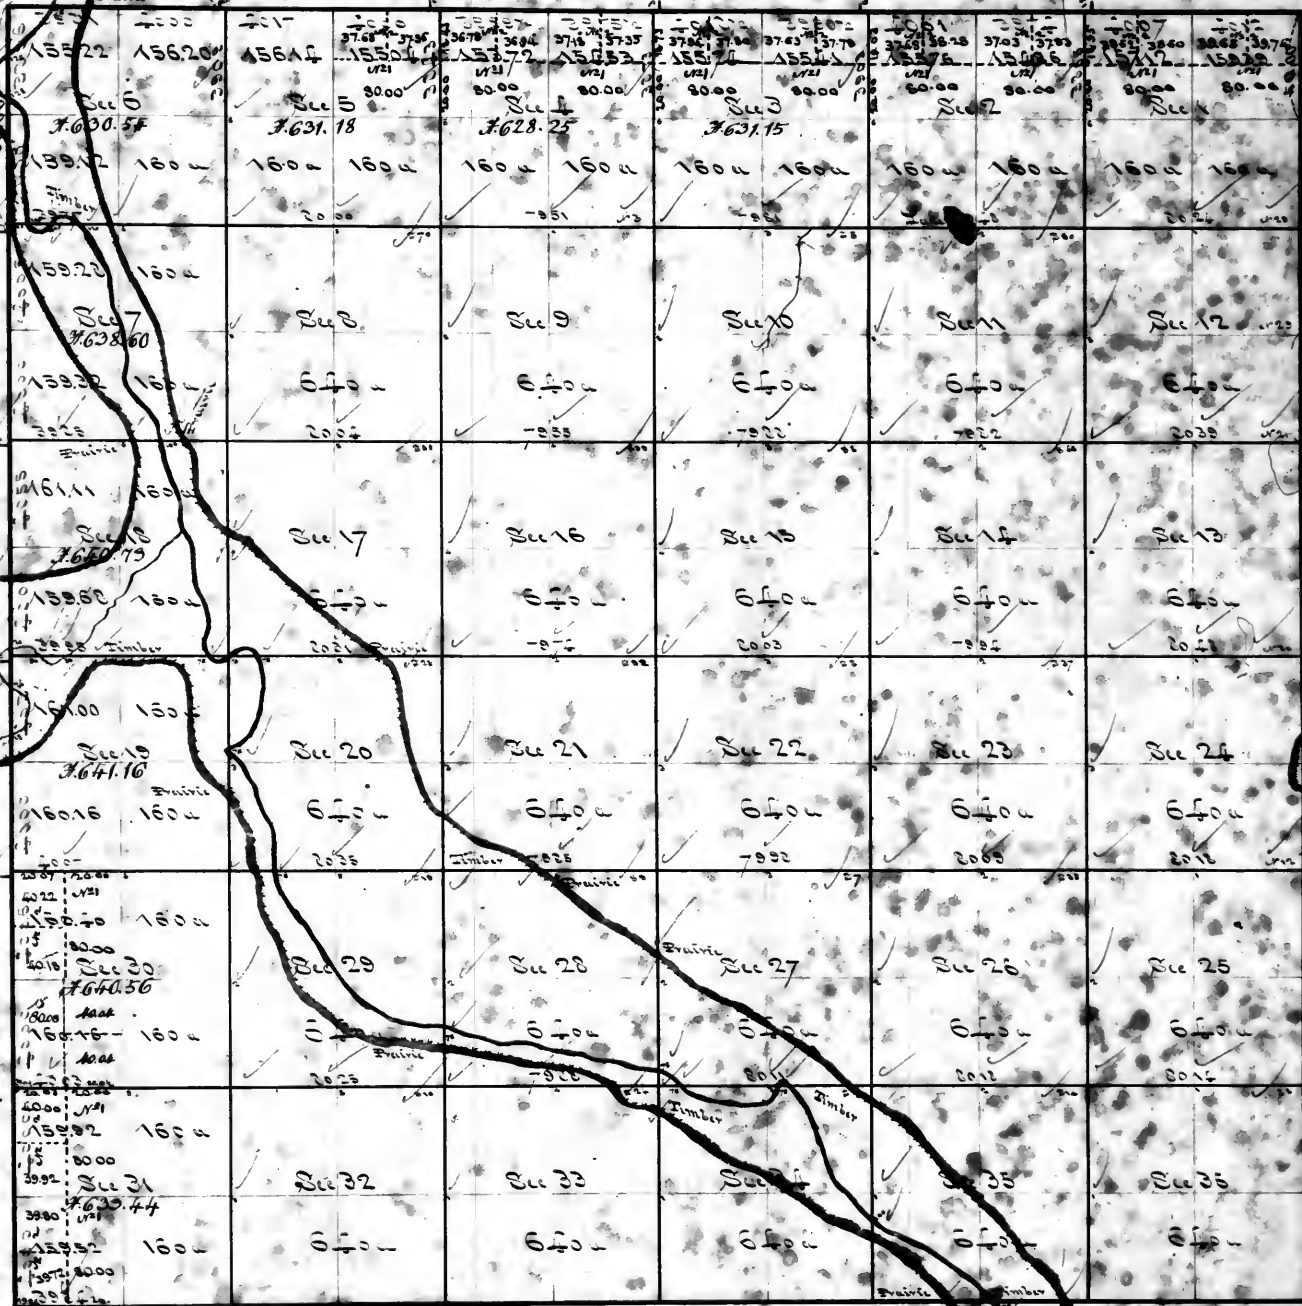


Surveyors Office
St. Louis
Subdivision made this
1st of Dec. 1834. The 1st pt. of Sec. 1
is the N.E. cor. of Sec. 5, thence
W. 1/4 of Sec. 20 and the 1st pt. of
Section 21 and sent to day a
copy of the plat thereof, one to
Hepburn and a motion to the Com.
On February 2nd 1835, a plat of
the 1st pt. of Sec. 1, thence
to conform to a previous sub. survey
to the Register and another to the
Commissioner.

Surveyors Office
St. Louis July 8th 1834

The above Plat of Township 32 North of the base line, Range 8 East of the
3rd principal meridian, is conformable to the field notes of the survey thereof on file in this Office.

E. J. Sampson

August 27th 1845
 subdivided under the Act of Congress of the
 17th of April 1832, the N. H. of Sec. 4, and
 sent copies of the plat therefore to the
 register and another to the Commissioner
 of the General Land Office.

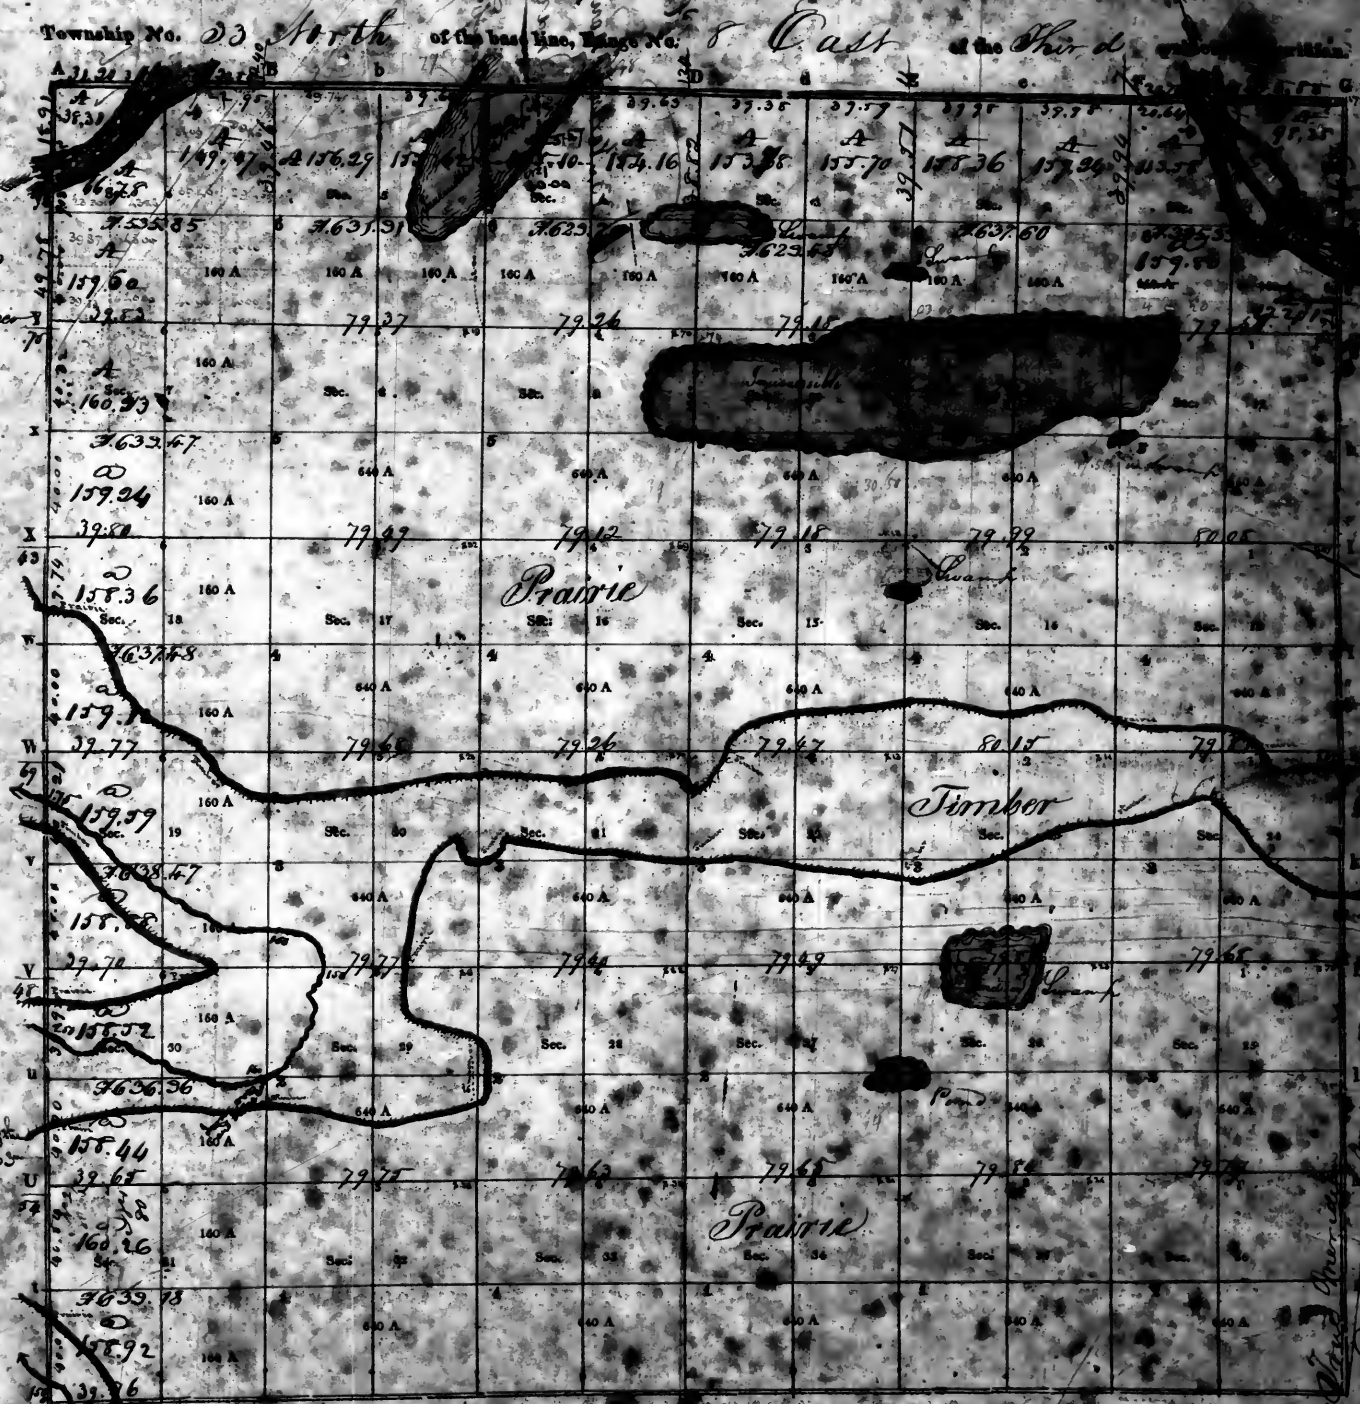

Aggregate area of public land 2274.343 acres
 Estimated area of the river 150.000 acres
 Total - 2424.343 acres

PURSUANT to a contract with, and instructions from William B. Ewing, Surveyor of the lands of the United States in the States of Illinois and
 an a Midtown and Territory of Arkansas
 I have measured, laid out and surveyed the above described Township; and do hereby certify that it had such marks and bounds, both natural and artificial,
 as are represented on said plat, and described in the field notes made thereof, and returned with this plat into the Office of the Surveyor of the Lands of the
 United States, in the State of Illinois and Territory of Arkansas.

Certified this day of 1846
 D. H. Miller, D. SURVEYOR

EXAMINED.
 Surveyors Office
 St. Louis July 1846

Enclosure, as corrected from the Station file in the Office.
 July 1846

Township 34 North of the base line, Range 8 East of the 3rd Principal Meridian

31



Survey Office
St. Louis July 1834

The above plat of Township 34 North of the base line, Range 8 East of the 3rd Principal Meridian, is conformable to the field notes of the survey thereof on file in this Office.

E. J. Langham

Survey Office
St. Louis July 1834

Aggregate area = 21081.43 acres
Estimated area of river = 1600.00
Total = 22681.43 acres

The above Plat of Township 34 North of the base line, Range 8 East of the 3rd Principal Meridian, is conformable to the field notes of the survey thereof on file in this Office.

E. J. Langham


6647
12.10
9.00



Saint Louis 21st of May 1839

It William Millburn
Inspector General


34

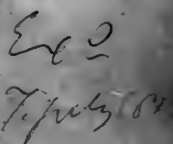

E. J. Conyham

Fractional Township 26 North of the Base line in Range 28 East of the 3^d principal Meridian.

35

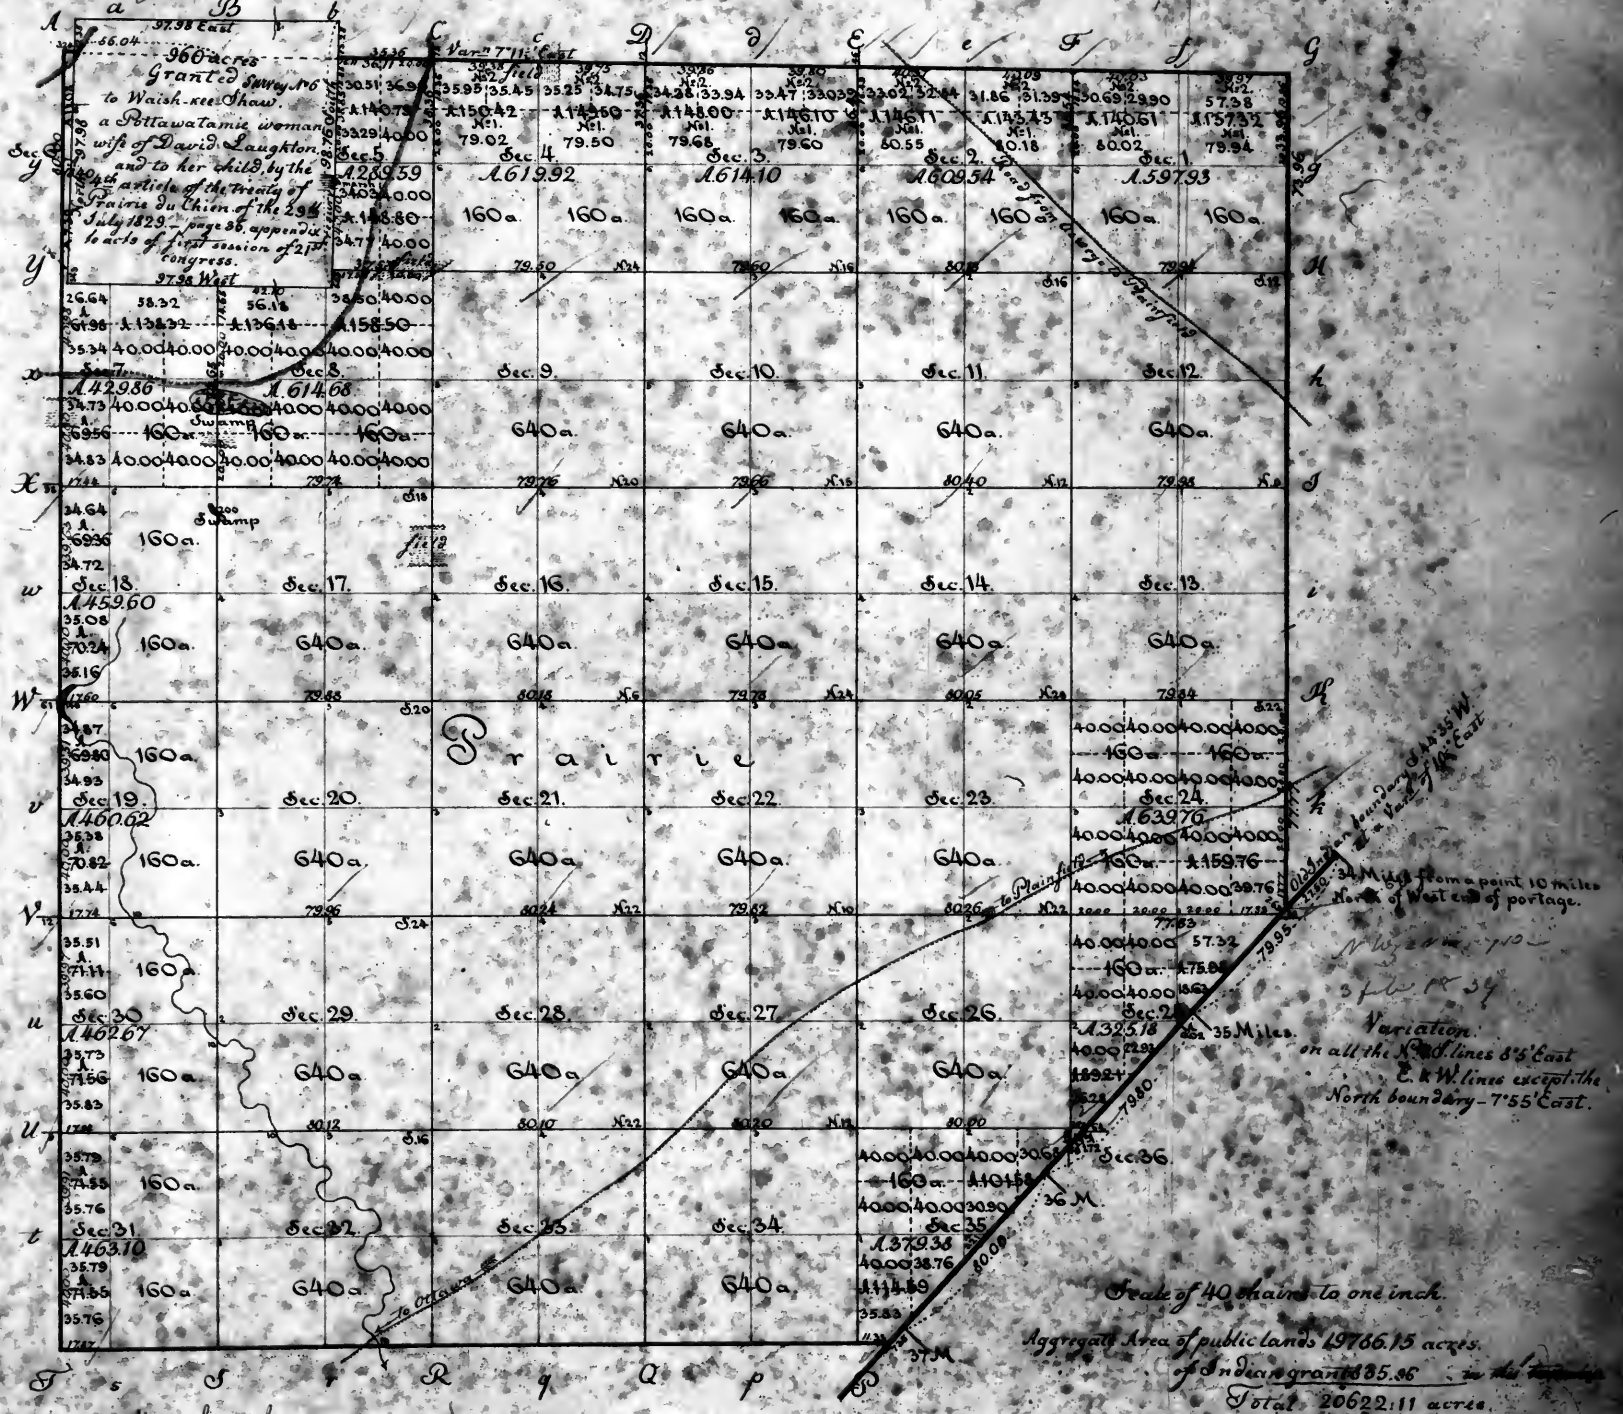

Surveyors Office. Saint Louis 25th of May 1855.

The above plan of fractional township 26 north of the base line, range 28 east of the 3^d principal meridian, with west of the old Indian boundary, is, strictly conformable to the field notes of the survey thereof, in the Office, which have been examined and approved. The South eastern boundary of this fractional township which is designated old Indian boundary, was surveyed in the 4th quarter of 1821, in order to close the surveys to the South East House, under the contract of Stephen and Thomas C. Becker of the 20th of March 1821; it was commenced at the N.W. corner of the Indian boundary, run by John C. Sullivan assisted by James M. Sullivan, in the 4th quarter of 1821, from a point 10 miles North of the prairie South west to a point 10 miles above the mouth of the prairie, and on a line of approximately 18th of October 1818, for the survey of the boundary line of the treaty of San Luis of the 20th of August 1816, between the United States and the tribes of Ottawas, Chippewas and Pottawamies, and was included as a survey in part of said survey of 1818, but changed thence to the point west - the point of said Indian boundary which forms a boundary to this fractional township, 2 miles 53.6 chains was surveyed and the South boundary 2 miles 67.25 chains - the west boundary 6 miles and the east boundary 2 miles 74.75 chains, were surveyed in the 4th quarter of 1827, and the subdivision line 54 miles 17.27 chains were surveyed, and the line was connected with the survey of the Indian grant to Waish-see Shaw 54.38 chains - in the 2^d quarter of 1828, all by Eli S. Beckett under contract signed by the Surveyor General on the 8th of May, and by the said Beckett on the 2^d of June 1828, and with the exception of the lines between sections 1 and 2 - 2 and 3 - 3 and 4 - 4 and 5, amounting to 1 mile 67.25 chains, were paid for in the 4th quarter of 1828; and charges in the account of the Surveyor General for this quarter under No. 5 - The four lines above stated were excepted from the account, because Mr. Beckett has lost the field notes of the survey of the north boundary of the township - In the 1st quarter of 1830 he completed the said north boundary - and his field notes thereof have been examined and approved, but the survey has not yet been paid for - The grant of 540 acres to Waish-see Shaw was surveyed in the 4th quarter of 1826, by Edward D. Telford, under instructions of the 22^d of January of that year.


Surveyors Office
Saint Louis 11th of February 1842

The surveying of the grant of 540 acres to Waish-see Shaw was paid in the 4th quarter of 1830 and charged in the annual account of the Surveyor General during that quarter under No. 9.

William Milburn
Surveyor General

TOWNSHIP NO. 37 NORTH, RANGE NO. 8 EAST, THIRD PRINCIPAL MERIDIAN, ILLINOIS.

PLAT OF TWO ISLANDS IN THE FOX RIVER, SECS. 18 AND 19.

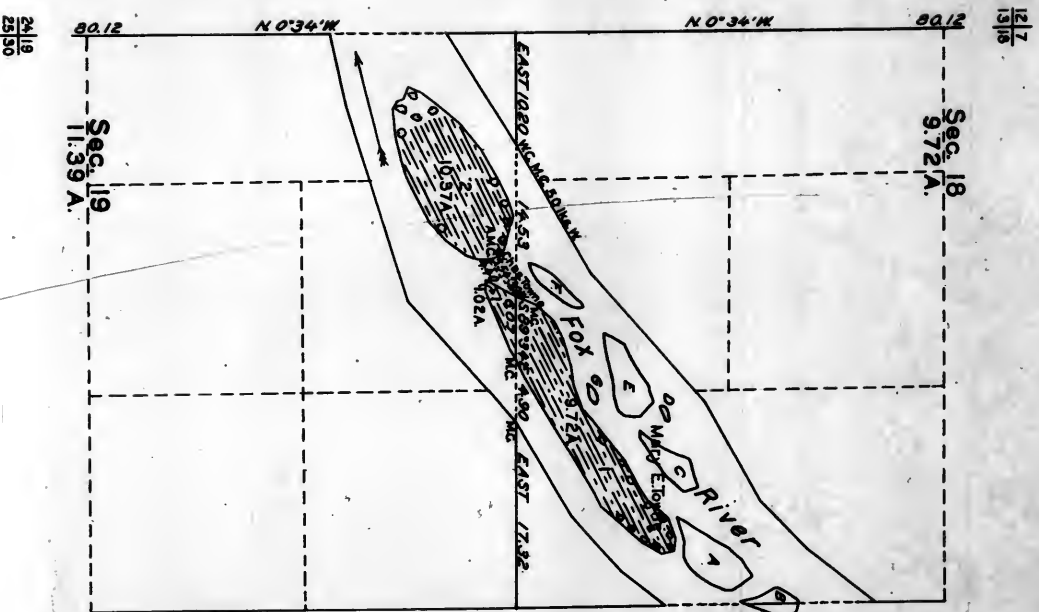

| LINE DESIGNATED | BY WHOM SURVEYED | NO. | GROUP DATE | MILEAGE M.S. CHS. | WHEN SURVEYED BEGUN | WHEN SURVEYED COMPLETED |
|------------------------------------|------------------------------|-----|-----------------|---|---------------------|-------------------------|
| EXTERIOR SUBDIVISIONAL CONNECTIONS | HAL D. CRAIG, U.S. SURVEYOR. | 7 | APRIL 18, 1933. | 2 0.24
0 53.02
1 27.58
0 11.40 | SEPT. 6, 1933. | SEPT. 14, 1933. |

SCALE: 10 CHAINS TO AN INCH.

AREA SURVEYED: 21.11 ACRES.

MEMORANDUM

THIS PLAT REPRESENTS THE SURVEY OF TWO ISLANDS IN THE FOX RIVER WHICH WERE NOT INCLUDED IN THE ORIGINAL SURVEY OF THE TOWNSHIP AS SHOWN ON THE OFFICIAL PLAT APPROVED AUGUST 25, 1912, ALTHOUGH INDICATED IN OUTLINE ON SAID PLAT.

THE SURVEY WAS EXECUTED PURSUANT TO AUTHORITY CONTAINED IN GENERAL LAND OFFICE LETTER 810598 DATED SEPTEMBER 16, 1932, WHICH BEARS DEPARTMENTAL APPROVAL UNDER DATE OF SEPTEMBER 20, 1932.

THE ISLANDS DESIGNATED AS A, B, C, D, E, F, AND G, ARE SHOWN ON THE PLAT AS ITEMS OF TOPOGRAPHY ONLY, FOR THE PURPOSE OF PORTRAYING EXISTING CONDITIONS IN THE VICINITY OF THE SURVEYED ISLANDS. THESE ISLANDS HAVE NOT BEEN SURVEYED, AS THERE IS NO SUPPORTING EVIDENCE ON THE GROUND, OR KNOWN RECORD EVIDENCE, TO ESTABLISH THE FACT THAT THEY ARE PUBLIC LANDS OF THE UNITED STATES.

OFFICE OF U.S. SUPERVISOR OF SURVEYS
DENVER, COLORADO, NOVEMBER 5, 1934
THE ABOVE PLAT OF TWO ISLANDS IN THE FOX RIVER, IN SECTIONS 18 AND 19, TOWNSHIP NO. 37 NORTH, RANGE NO. 8 EAST, THIRD PRINCIPAL MERIDIAN, ILLINOIS, IS STRICTLY CONFORMABLE TO THE FIELD NOTES OF THE SURVEY THEREOF, WHICH HAVE BEEN EXAMINED AND APPROVED.

Samuel J. Hanna
U.S. SUPERVISOR OF SURVEYS.


DEPARTMENT OF THE INTERIOR
GENERAL LAND OFFICE
WASHINGTON, D.C., NOVEMBER 16, 1934
THE SURVEY REPRESENTED BY THIS PLAT, HAVING BEEN CORRECTLY EXECUTED IN ACCORDANCE WITH THE REQUIREMENTS OF LAW AND THE REGULATIONS OF THIS OFFICE, IS HEREBY ACCEPTED.

W. C. Anderson
ACTING ASSISTANT COMMISSIONER.

DUPLICATE

TOWNSHIP NO. 37 NORTH, RANGE NO. 8 EAST, OF THE THIRD PRINCIPAL MERIDIAN, ILLINOIS.

PLAT OF AN ISLAND IN FOX RIVER, SECTION 5.

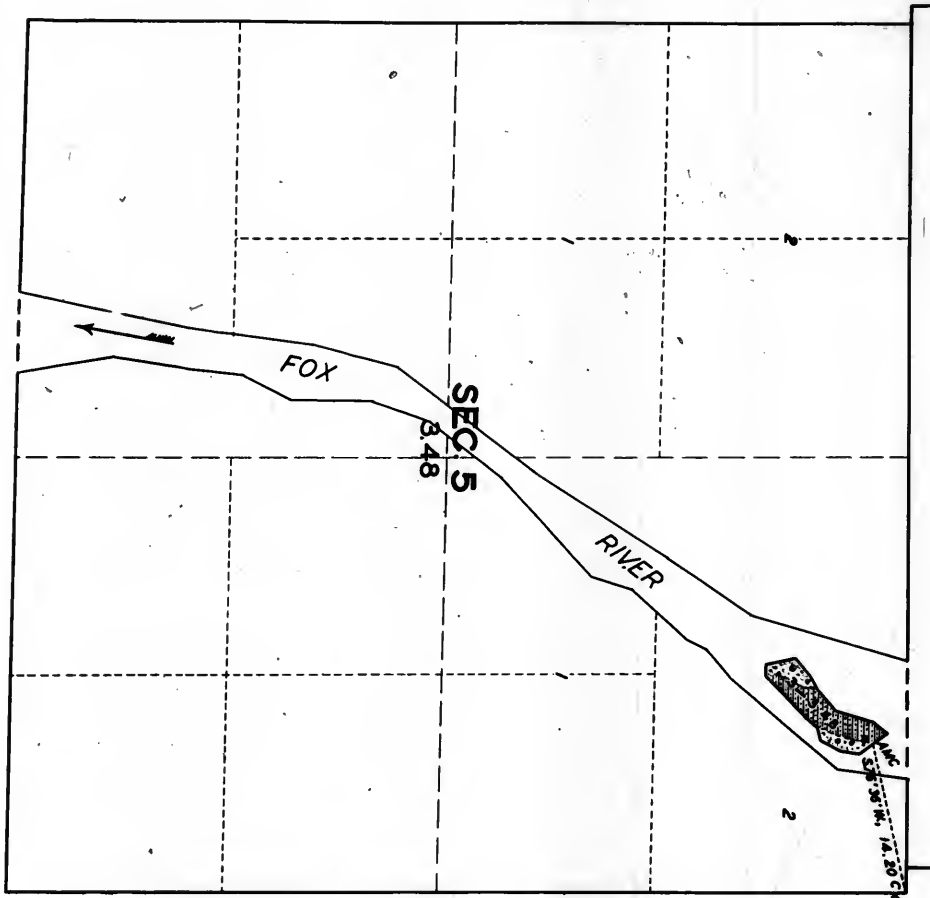

SCALE: 10 CHAINS TO AN INCH.

AREA SURVEYED: 3.48 ACRES.

| LINE DESIGNATED | BY WHOM SURVEYED | GROUP NO. | DATE | MILEAGE M.S. CHS. | WHEN SURVEYED BEGUN | WHEN SURVEYED COMPLETED |
|----------------------|-------------------------------|-----------|-----------------|-------------------|---------------------|-------------------------|
| MEANDERS CONNECTIONS | GUY R. VEAL, U.S.C. ENGINEER. | 6 | APRIL 24, 1932. | 0 14.20 30.59 | MAY 12, 1932. | MAY 13, 1932. |

MEMORANDUM.

THIS PLAT REPRESENTS THE SURVEY OF AN ISLAND IN THE FOX RIVER, IN SECTION 5, WHICH WAS NOT INCLUDED IN THE ORIGINAL SURVEY OF THE TOWNSHIP AS SHOWN UPON THE OFFICIAL PLAT APPROVED AUGUST 25, 1842.

THE SURVEY WAS EXECUTED PURSUANT TO AUTHORITY CONTAINED IN GENERAL LAND OFFICE LETTER 1120278 "C" DATED JANUARY 21, 1932, WHICH BEARS DEPARTMENTAL APPROVAL UNDER DATE OF JANUARY 23, 1932.

OFFICE OF U.S. SUPERVISOR OF SURVEYS
DENVER, COLORADO, MARCH 30, 1933.

THE ABOVE PLAT OF AN ISLAND IN THE FOX RIVER IN SECTION 5, TOWNSHIP NO. 37 NORTH, RANGE NO. 8 EAST, THIRD PRINCIPAL MERIDIAN, ILLINOIS, IS STRICTLY CONFORMABLE TO THE FIELD NOTES OF THE SURVEY THEREOF WHICH HAVE BEEN EXAMINED AND APPROVED.


Wm. H. Power
U.S. SUPERVISOR OF SURVEYS.

DEPARTMENT OF THE INTERIOR
GENERAL LAND OFFICE
WASHINGTON, D.C., APRIL 21, 1933.

THE SURVEY REPRESENTED BY THIS PLAT HAVING BEEN CORRECTLY EXECUTED IN ACCORDANCE WITH THE REQUIREMENTS OF LAW AND THE REGULATIONS OF THIS OFFICE, IS HEREBY ACCEPTED.

W. H. Power
ACTING ASSISTANT COMMISSIONER.

36

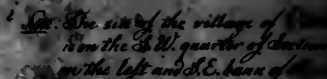

R



2

1

M

10

1

—

•

10

Surveyors Office Saint Louis 25th of August 1862

Scale of 40 chains to an inch.

Aggregate area of public lands 21458.71 acres

| | | |
|---------------------------------|-----|-------|
| estimated area of Fort River | 230 | acres |
| estimated area of Indian grants | 234 | acres |
















TOWNSHIP No. 40 NORTH, RANGE No. 8 EAST, 3RD. PRIN. MER., ILLINOIS.

PLAT OF AN ISLAND IN THE FOX RIVER, SEC. 10.

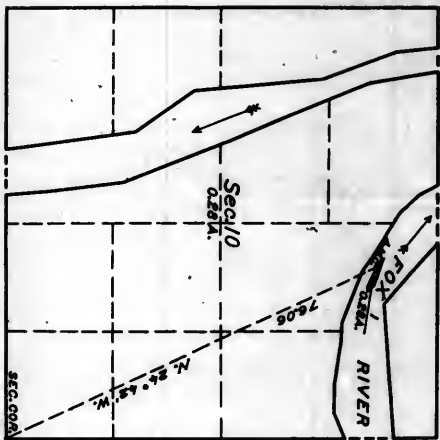

MEMORANDUM.
THIS PLAT REPRESENTS THE SURVEY OF AN ISLAND IN FOX RIVER, WHICH WAS NOT SHOWN ON THE TOWNSHIP PLAT APPROVED SEPTEMBER 29, 1840. THE SURVEY WAS EXECUTED PURSUANT TO AUTHORITY CONTAINED IN GENERAL LAND OFFICE LETTER 1190545 "E", DATED APRIL 3, 1929. THIS ACTION BEARS DEPARTMENTAL APPROVAL UNDER DATE OF APRIL 5, 1929.

OFFICE OF U. S. SUPERVISOR OF SURVEYS,
DENVER, COLORADO, OCTOBER 15, 1930.
THE ABOVE PLAT OF AN ISLAND IN FOX RIVER IN SECTION 10, TOWNSHIP NO. 40 NORTH, RANGE NO. 8 EAST OF THE 3RD PRINCIPAL MERIDIAN, IN THE STATE OF ILLINOIS, IS STRICTLY CONFORMABLE TO THE FIELD NOTES OF THE SURVEY THEREOF, WHICH HAVE BEEN EXAMINED AND APPROVED.

Wm. H. Brown
U. S. SUPERVISOR OF SURVEYS.

DEPARTMENT OF THE INTERIOR,
GENERAL LAND OFFICE,
WASHINGTON, D. C., DECEMBER 10, 1930.
THE SURVEY REPRESENTED BY THIS PLAT, HAVING BEEN CORRECTLY EXECUTED IN ACCORDANCE WITH THE REQUIREMENTS OF LAW AND THE REGULATIONS OF THIS OFFICE, IS HEREBY ACCEPTED.

Wm. H. Brown
ASSISTANT COMMISSIONER.

SCALE: 20 CHAINS TO AN INCH.

AREA SURVEYED, 0.28 ACRES.

| LINES DESIGNATED | BY WHOM SURVEYED | GROUP | | MILEAGE | | WHEN SURVEYED | |
|------------------|------------------|-------|----------|---------|-------|---------------|-----------|
| | | NO. | DATE | M.S. | CHS. | BEGUN | COMPLETED |
| MEANDER | HAL D. CRAIG, | 4 | AUG. 21, | 0 | 12.85 | NOV. 6, | NOV. 7, |
| MISCELLANEOUS | U.S. SURVEYOR. | | 1929. | 1 | 18.16 | 1929. | 1929. |

DUPLICATE



OFFICE OF U. S. SUPERVISOR OF SURVEYS
DENVER, COLORADO, FEBRUARY 24, 1933

THE ABOVE PLAT OF FOUR ISLANDS IN THE FOX RIVER IN SECTIONS 10 AND 11, TOWNSHIP NO. 40 NORTH, RANGE NO. 8 EAST, THIRD PRINCIPAL MERIDIAN, ILLINOIS, IS STRICTLY CONFORMABLE TO THE FIELD NOTES OF THE SURVEY THEREOF WHICH HAVE BEEN EXAMINED AND APPROVED.

U. S. SUPERVISOR OF SUR

DEPARTMENT OF THE INTERIOR
GENERAL LAND OFFICE

THE SURVEY REPRESENTED BY THIS PLAT HAVING BEEN CORRECTLY EXECUTED IN ACCORDANCE WITH THE REQUIREMENTS OF LAW AND THE REGULATIONS OF THIS OFFICE, IS HEREBY ACCEPTED.

W. H. Stowell
ASSISTANT COMMISSIONER.

Township 40 North of the Base line in Range 28 East of the 3rd



Surveyors Office.

Saint Louis. 28 September 1840.

The above plat of township 40 north of the base line, range 28 east of the 3rd principal meridian, is hereby confirmed to be the true and correct plat of the same as it appears on file in this office, which have been examined and approved. The South boundary 5 miles 64.22 chains - the north boundary 5 miles 64.22 chains - the subdivisions lines 51.70 chains - the measures of both halves of the river, 16 miles 9.33 chains, were all surveyed, in the 1st quarter of 1840, by James J. Thompson, under the joint contract of the 2d of September 1839. They were paid for in full in the month of 1840, in the account current, of the Surveyor General, being the said quarter under the general appropriation for surveying the public lands.


Wm. H. Thompson

Surveyor of the public lands in
the State of Illinois and Missouri.



Township 45 North of the base line Range 8 East of the 3^d principal Meridian

44

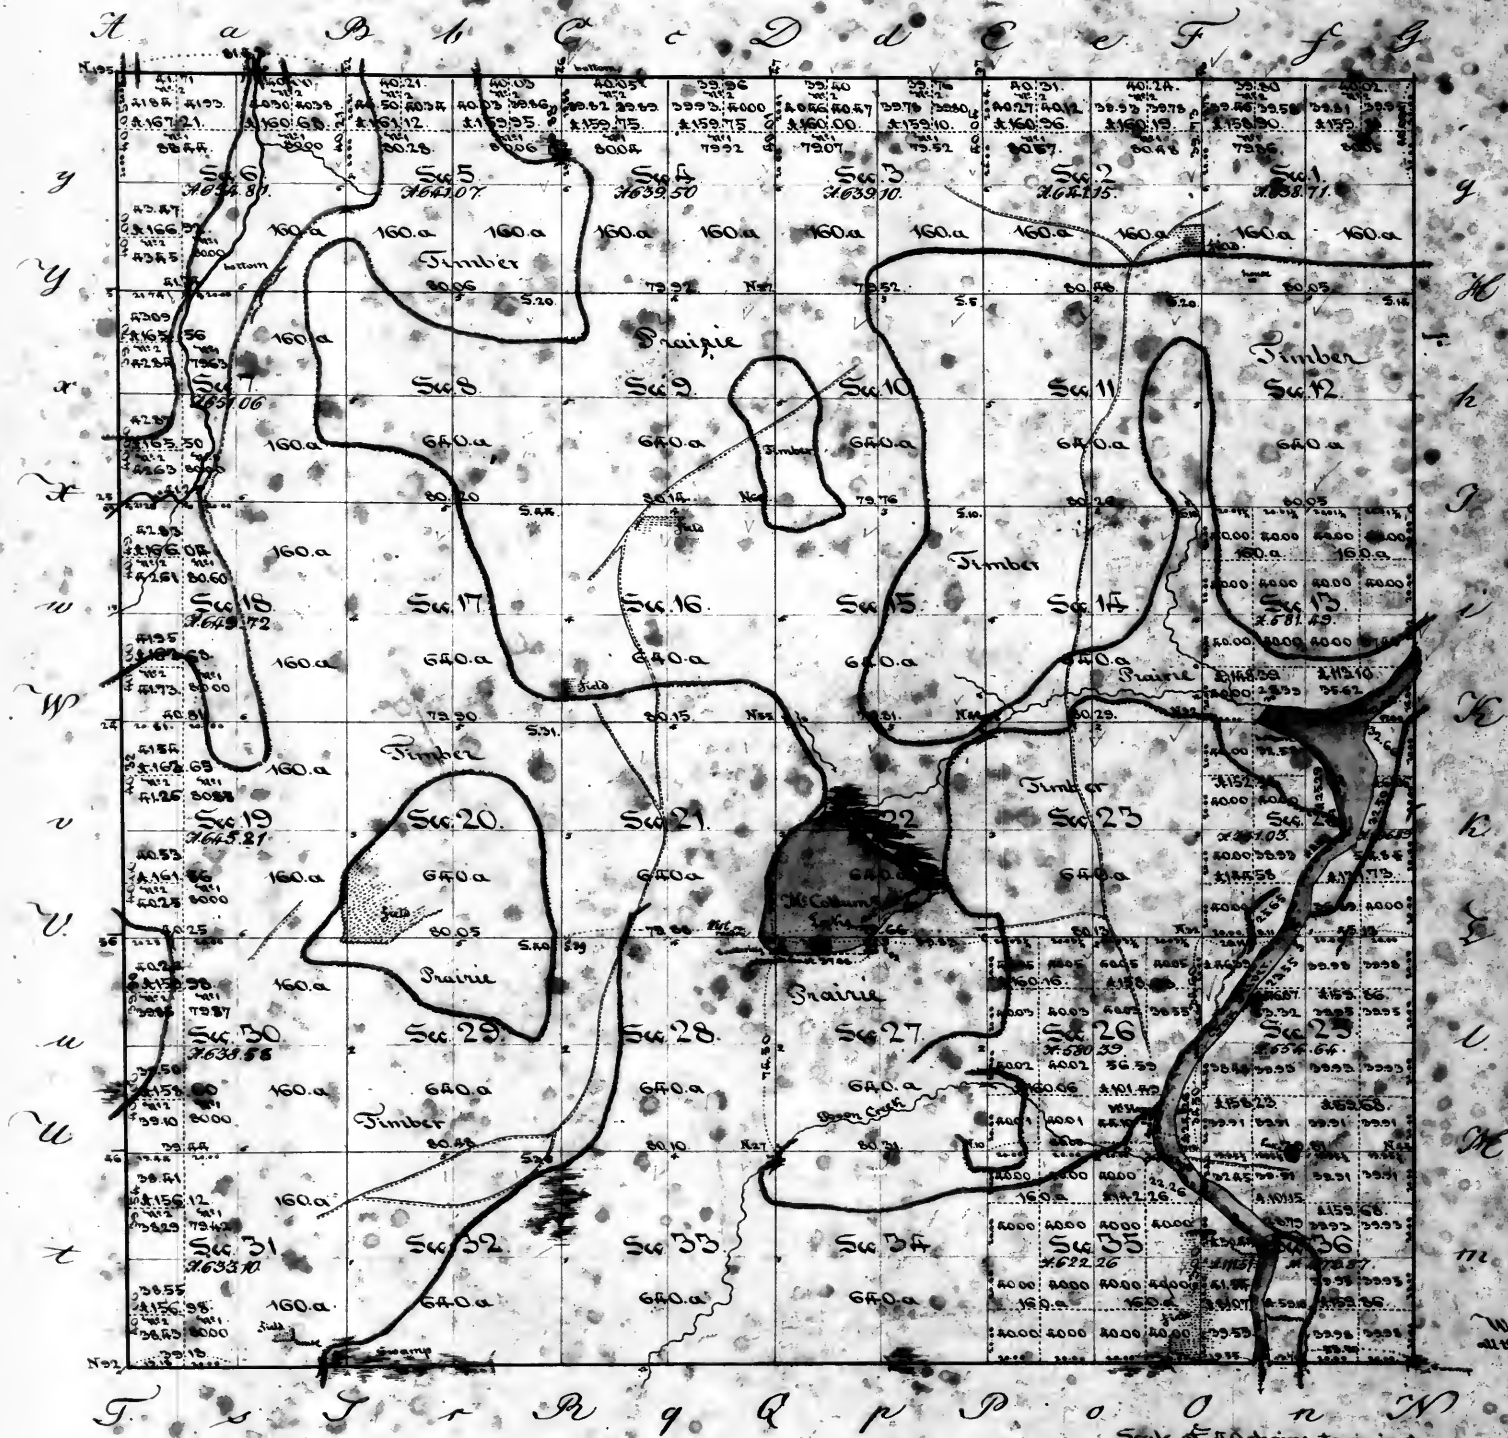

When the account of Mr. Gallows in which the Survey of the St. Louis Survey of this township is charged amounts to \$1062.95 of which \$562.50 was paid on the 23^d of November 1830 - the rest (\$500.45) having been paid on the 3^d of February of same year by David Bunker, late Surveyor General.

William Melburn

Variation
West boundary 6° 20' East
all the other lines 6° East

Surveyors Office.
Saint Louis 18th of April 1840.

Scale of 40 chains to an inch
Aggregate area of public land = 22256.21 acres
estimated area of river = 160.87 acres
Total = 22095.34 acres.

The above plat of township 45 north of the base line Range 8 east of the 3^d principal meridian is strictly conformable to the field notes of the survey thereof on file in this office which have been examined and approved. - The west boundary 6 miles was surveyed in the 2^d quarter of 1837, by James Thompson under contract signed by the Surveyor General, on the 21st of November, and by Thompson on the 15th of December 1836: it was paid for in the 1st quarter of 1839, and charged in the account current of the Surveyor General, under the General appropriation for that quarter. Voucher N^o 6 - The South boundary 5 miles, 72.18 chains - the east boundary 6 miles and the north boundary 5 miles 1.49 chains, were surveyed in the 3^d quarter of 1837, all by James Gallows, under contract signed by the Surveyor General on the 21st of November, and by Gallows on the 15th day of December 1836; they were to the extent noted in the margin paid for in the 3^d quarter of 1839, and charged in the account current of the Surveyor General, for said quarter, under the General appropriation for surveying the public lands - Voucher N^o 7 - The subdivision lines 59 miles 22.79 chains, and the meanders of Fox river 1 mile 41.54 chains, were surveyed in the 3^d and 4th quarters of 1837 - 4th quarter of 1838 - and 1st quarter of 1839 by the said Gallows under the contract before mentioned: - the subdivision lines and meanders were paid for in the 2^d quarter of 1840, and they will be charged in the account current of the Surveyor General, for said quarter under the general appropriation for surveying the public lands. Voucher N^o 1.


William Melburn
Surveyor of the public Lands in
Illinois and Missouri.

Township 46 North of the base line Range 8 East of the 3rd principal Meridian

45

T. 1. N. (of the Wisconsin survey) R. 10 E. of the 4th pr. Mer.

T. 1. N. (of the Wisconsin survey) R. 10 E. of the 4th pr. Mer.

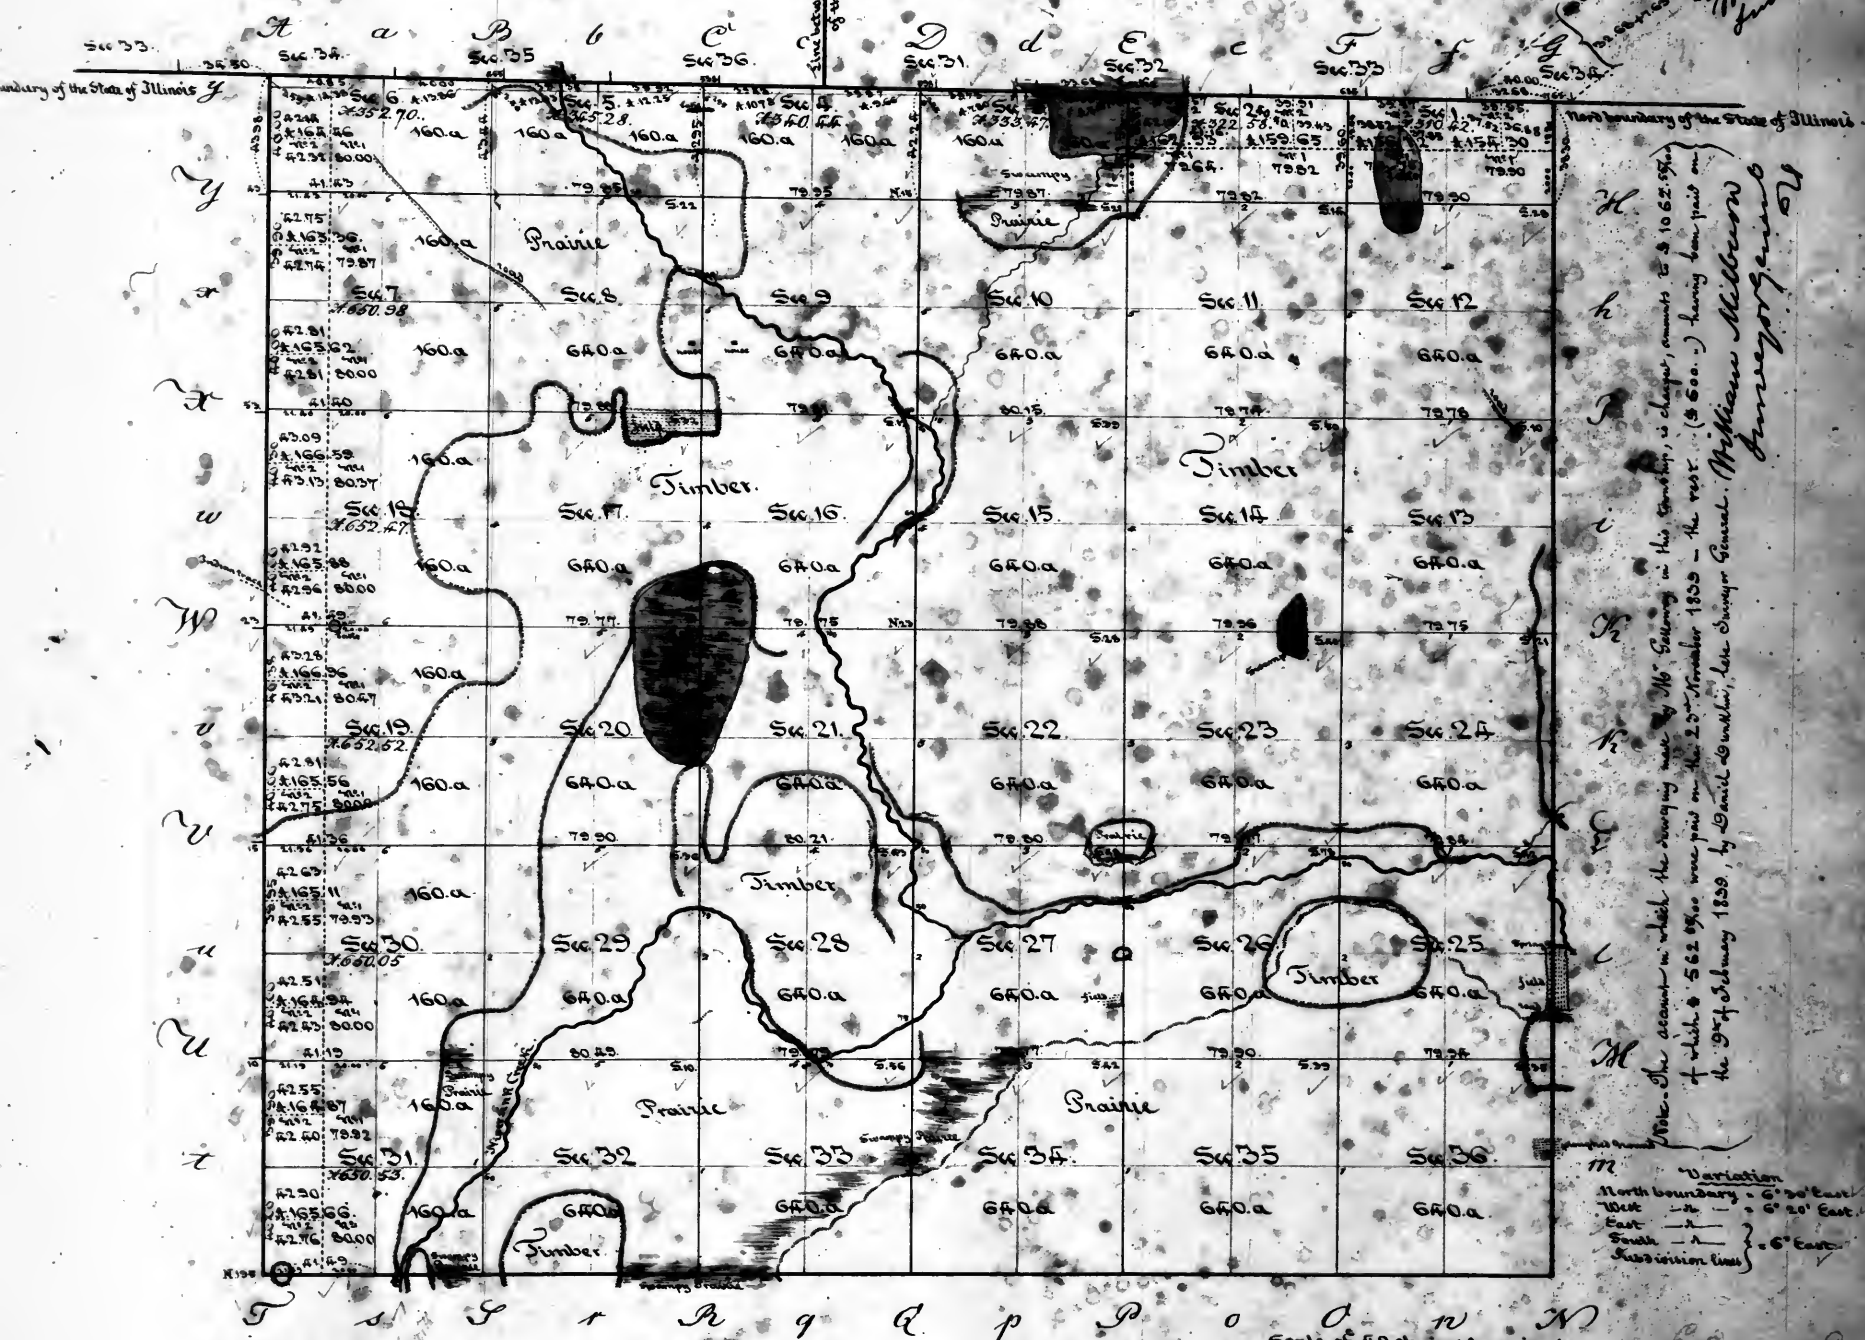


Variation
North boundary - 6° 30' East
West - 6° 20' East
East - 6° 10' East
South - 6° East

Surveyor General's office.

St. Louis 17th of December 1859.

The above plat of township 46 north of the base line, range 8 east of the 3rd principal meridian, is strictly confirmable to the field notes of the survey thereof on file in this office, which have been examined and approved. The north boundary was surveyed in 1853 and 1855 by Lucius Lyon, Commissioner on the part of the United States, as certified to this office by W. J. Williams, Surveyor General of Ohio, Indiana & Michigan; the said line being a part of the boundary between Illinois and Michigan, now Wisconsin - In the 3rd quarter of 1857, J. Galloway (under the contract below designated) resurveyed in part said boundary as represented on this plat. The west boundary 5 miles 45.58 chains, was surveyed in the 3rd quarter of 1857, by James Thompson, under contract signed by the Surveyor General on the 21st of November, and by said Thompson on the 15th of December 1856; it was paid for in the 1st quarter of 1859, and charged in the account of the Surveyor General for that quarter, Voucher N^o 6. The south boundary 6 miles 1.49 chains - the east boundary 5 miles 38.50 chains - and the lines of subdivision 57 miles 55.88 chains, were all surveyed in the 3rd quarter of 1857, by James Galloway, under a contract signed by the Surveyor General on the 21st of November, and by said Galloway on the 15th of December 1856. The surveys by Galloway, were, to the extent noted in the margin, paid for in the present quarter, being the 4th quarter of 1859, and will be charged in the account of the Surveyor General for said 4th quarter of 1859, under the general appropriation for surveying the public lands - Voucher N^o 4.

William Milburn
Surveyor General


Scale of 40 chains to an inch
Aggregate area = 21267.44 acres.

Township 46 North of the base line Range 8 East of the 3^d principal Meridian

45

T. 1. N. (of the Wisconsin survey) R. 18 E. of the 4th pr. Mer.

T. 1. N. (of the Wisconsin survey) R. 18 E. of the 4th pr. Mer.

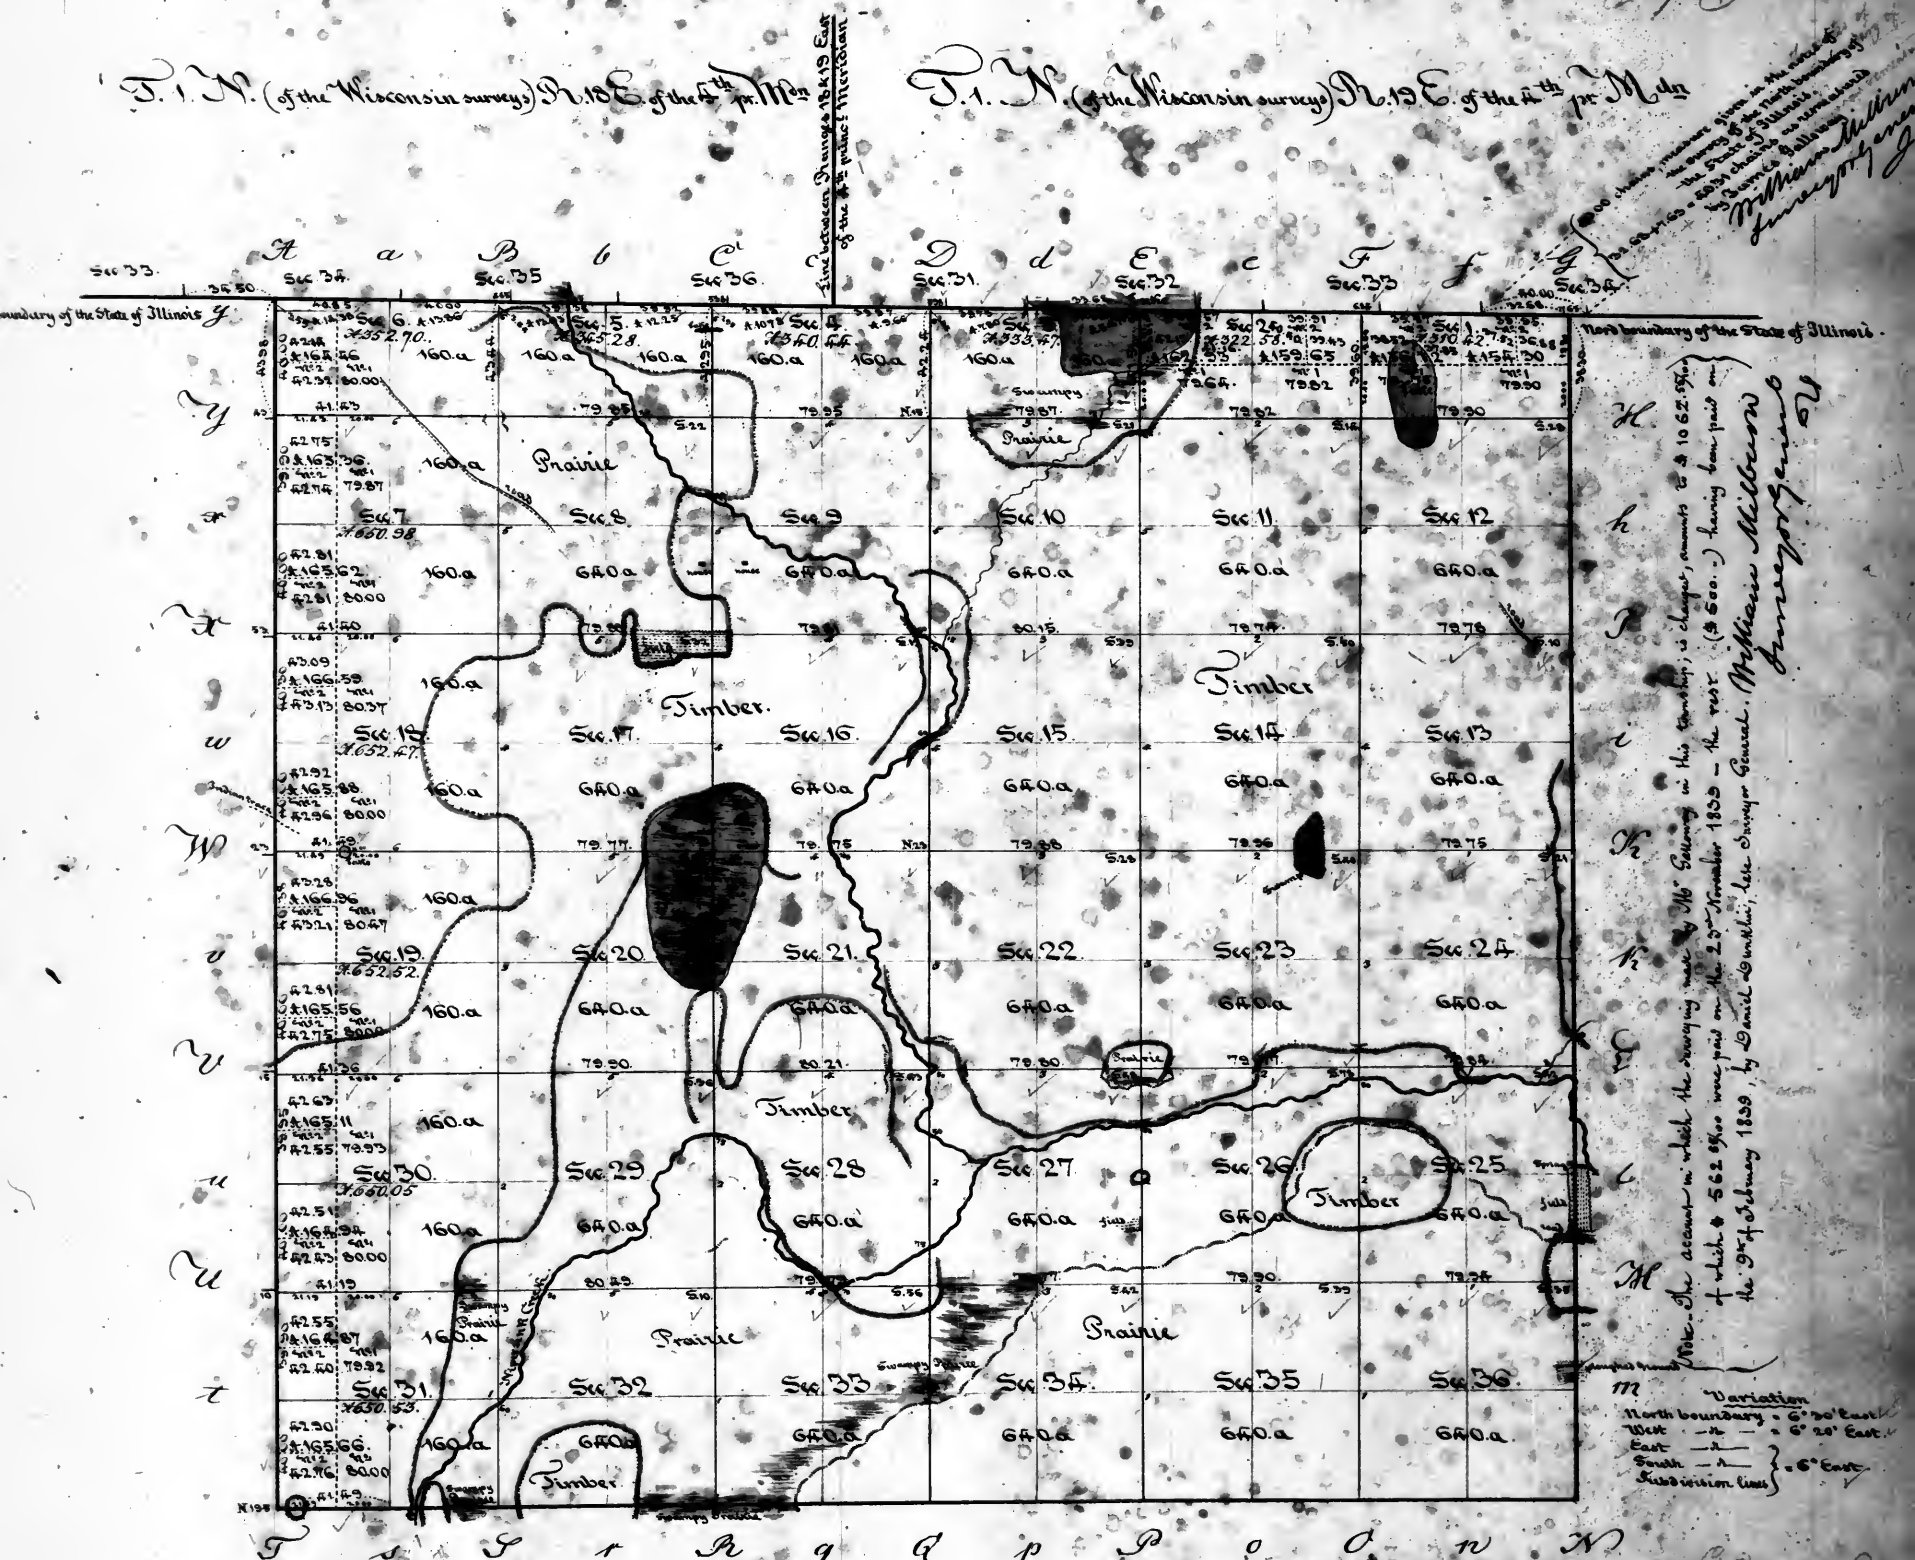


Variation
North boundary - 6° 30' East
West - 6° 20' East
East - 6° 10' East
South - 6° East
Subdivision line

Scale of 40 chains to an inch
Aggregate area = 21267.44 acres.


Surveyor General's office.

Saint Louis 17th of December 1859.

The above plat of township 46 north of the base line, range 8 east of the 3^d principal meridian, is strictly confirmable to the field notes of the survey thereof on file in this office, which have been examined and approved. The north boundary was surveyed in 1852 and 1855, by Lucius Lyon, Commissioner on the part of the United States, as certified to this office by M. J. Williams, Surveyor General of Ohio, Indiana & Michigan; the said line being a part of the boundary between Illinois and Michigan, now Wisconsin - In the 3^d quarter of 1857, J. Galloway (under the contract below designated) commenced in part said boundary, as represented on this plat. The west boundary 5 miles 45.38 chains, was surveyed in the 3^d quarter of 1857, by James Thompson, under contract signed by the Surveyor General on the 21st of November, and by said Thompson on the 15th of December 1856; it was paid for in the 1st quarter of 1859, and charged in the account of the Surveyor General for that quarter, Voucher No. 6. The South boundary 6 miles 1.49 chains - the east boundary 5 miles 38.50 chains - and the line of subdivision 57 miles 55.38 chains, were all surveyed in the 3^d quarter of 1857, by James Galloway, under a contract signed by the Surveyor General on the 21st of November, and by said Galloway on the 15th of December 1856. The surveys by Galloway, were, to the extent noted in the margin, paid for in the present quarter, being the 4th quarter of 1859, and will be charged in the account current of the Surveyor General for said 4th quarter of 1859, under the general appropriation for surveying the public lands - Voucher No. 4.

William Miller
Surveyor General

Township 27 North of the base line Range 9 East of 3rd principal Meridian

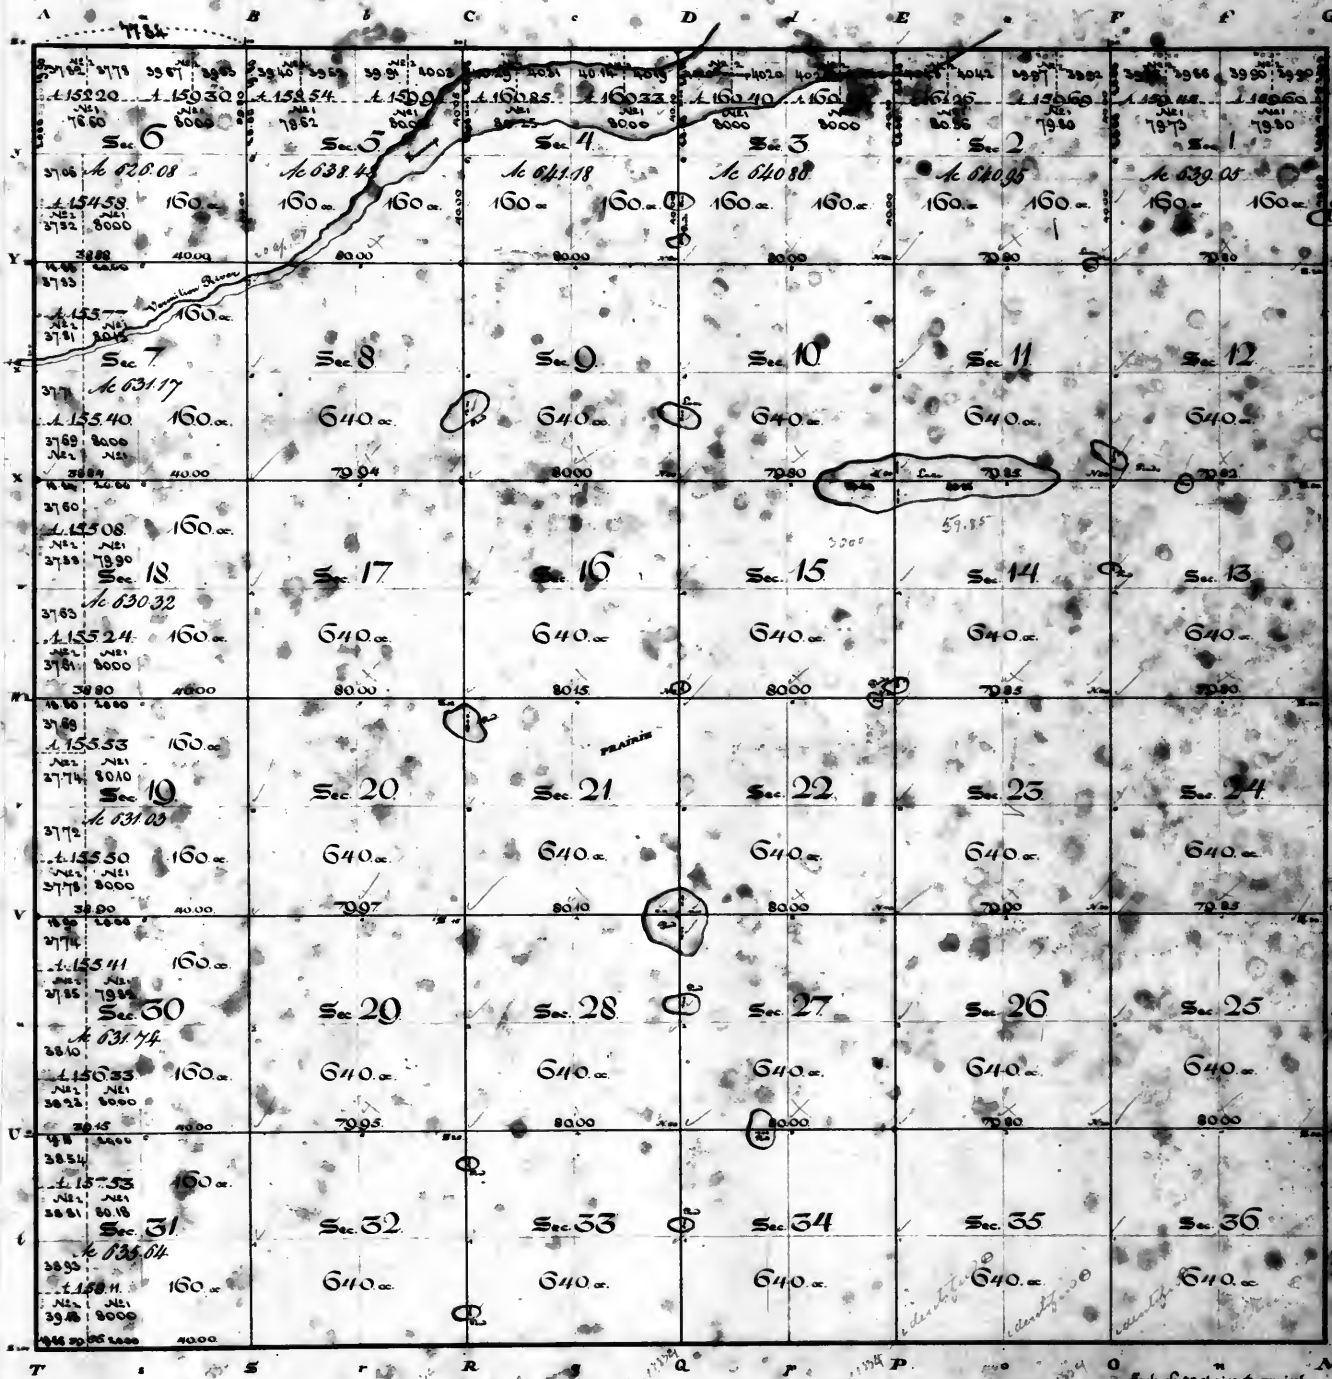

(Note: The account of Dr. Conroy in which the surveying in this township is charged amounts to \$2,432.13, of which \$603.21 was paid on the 22nd of February 1840 - the rest (\$1,828.92) having been paid by Elias S. Thompson, from Surveyor General.

William Millburn

Section
North East boundary } T. 27 N.
and Section lines } R. 9 E.
West boundary } 3rd P. M.
South boundary } 4th S. 1840

Aggregate Area - 23016.44 acres

Surveyor's Office
St. Louis, Mo. March 1840.


The said Map of Township 27 North of the base line Range 9 East of 3rd principal Meridian was filed in the Surveyor's Office in this Office, which has been examined and approved. The said boundary 5 miles 78.68 chains was surveyed under the contract of Wm. S. Thompson and Elias S. Thompson, of the 15th of March 1832. - The west boundary 6 miles was surveyed in the 4th quarter of 1833, by D. F. Murringer, under the contract of John M. Murringer and D. F. Murringer of the 2nd of September 1833. - The east boundary 6 miles and the North boundary 5 miles 77.78 chains was surveyed in the 4th quarter of 1833, and the subdivision lines 53 miles and 20 chains were surveyed in the 2nd quarter of 1834, all by William Lee B. Conroy, under contract of the 15th day of August 1833. - The surveys by Conroy were, to the extent, what in the margin, paid for on the 22nd day of February 1840, and will be charged in the account current of the Surveyor General for the present quarter (being the 1st quarter of 1840) under the general appropriation for surveying the public lands. Voucher N^o 7

William Millburn

Surveyor of the public lands
in the State of Missouri

Township 28 North of the base line Range 9 East of 3^d principal Meridian

47

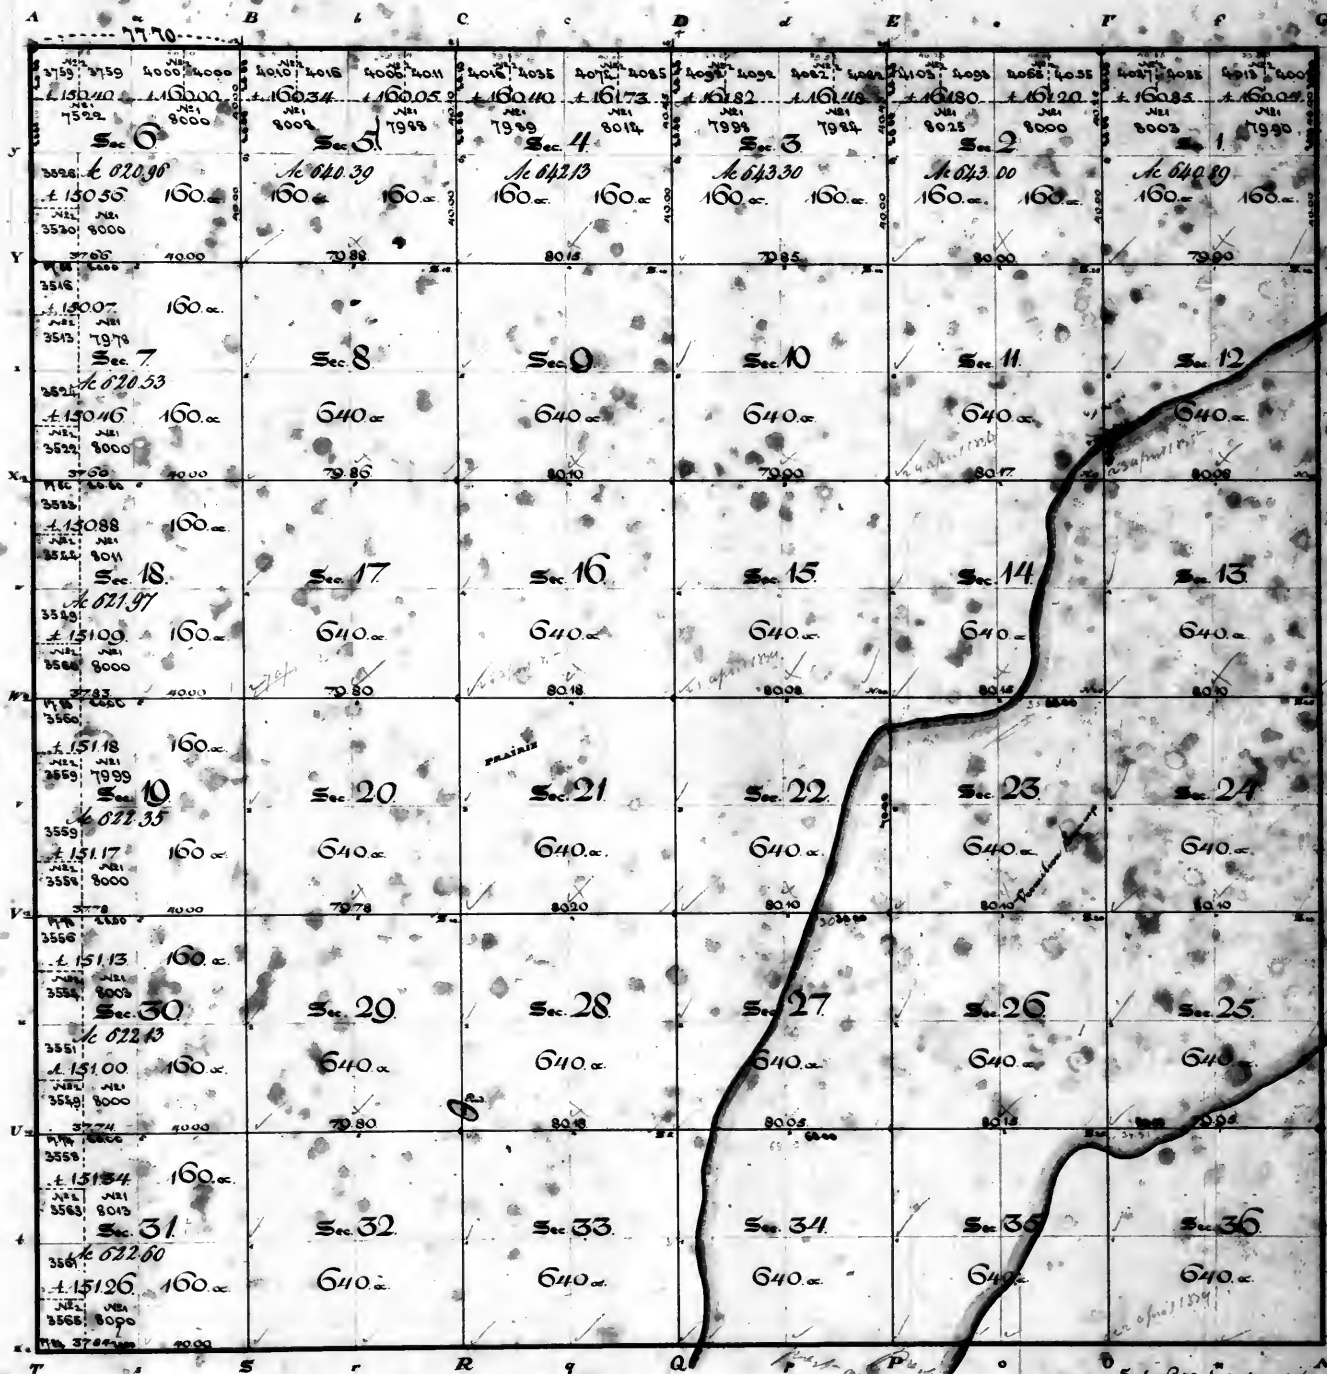

(Note: The account of Dr. Emory in which this surveying in this township is charged amounts to \$2427.12, of which \$608.74 was paid on the 22^d of February 1840 - the rest (\$1818.38) having been paid by E. D. Langhorne, former Surveyor General.
 William Milburn

Surveyors Office
St. Louis 18th March 1840.

The above plat of Township 28 North of the base line Range 9 East of 3^d principal Meridian, is made to the field notes of the survey thereof on file in this Office, which have been examined and approved. The West boundary 6 miles was surveyed in the 4th quarter of 1833, by R. F. Meigs, under the contract of John W. Meigs and J. S. Meigs of the 2^d of September 1833. The South boundary 6 miles 77.84 chains, the east boundary 6 miles and the north boundary 5 miles 77.70 chains were surveyed in the 4th quarter of 1833 - and the subdivision lines 59 miles 70.47 chains were surveyed in the 3^d quarter of 1834, all by William Lee D. Emory under contract of the 15th day of August 1833. These surveys by Emory were, to the extent noted in the margin, paid for in the 2^d of February 1840, and they will be charged in the account current of the Surveyor General for the present quarter (being the 1st quarter of 1840) under the general appropriation for surveying the public lands. Voucher N^o 7

William Milburn
Surveyor of the public lands
in the State of Missouri

Township 29 North of the base line Range 9 East of 3rd principal Meridian

48


This Township is all dry rolling to mostly rich Prairie

(Note: The account of Dr. Enig in which he surveys in this township is charged. Amount is \$222.75, of which \$60.75 was paid on the 22nd of February 1840 - the rest (\$162.00) having been paid by G. S. Loughman from Dr. Enig's General Account.

William Maltburn

Approximate Area - 22944 51. acs.

Surveyors Office
St. Louis Mo March 1840


The above plat of Township 29 North of the base line Range 9 East of 3rd principal Meridian is conformable to the field notes of the survey thereof on file in this Office, which have been examined and approved. The north boundary 6 miles was surveyed in the 4th quarter of 1833, by B. C. Messinger under the contract of John W. Messinger and B. C. Messinger of the 2nd of September 1833 - The south boundary 5 miles 77.70 chains, was surveyed in the 4th quarter of 1833 - The east boundary 6 miles - the north boundary 5 miles 78.30 chains - and the subdivision lines 59 miles 70.56 chains, were surveyed in the 2nd quarter of 1834, all by William de D. Enig, under contract of the 1st day of August 1833 - The surveys by Enig, were to the extent noted in the margin, paid for on the 22nd of February 1840; and they will be charged in the account current of the Surveyor General for the present quarter (being the 3rd quarter of 1840) under the general appropriation for surveying the public lands, under 28th

William Maltburn
Surveyor of the public lands in
the States of Illinois and Missouri.

7035

Township 30 North of the base line Range 9 East of 3^d principal Meridian

49

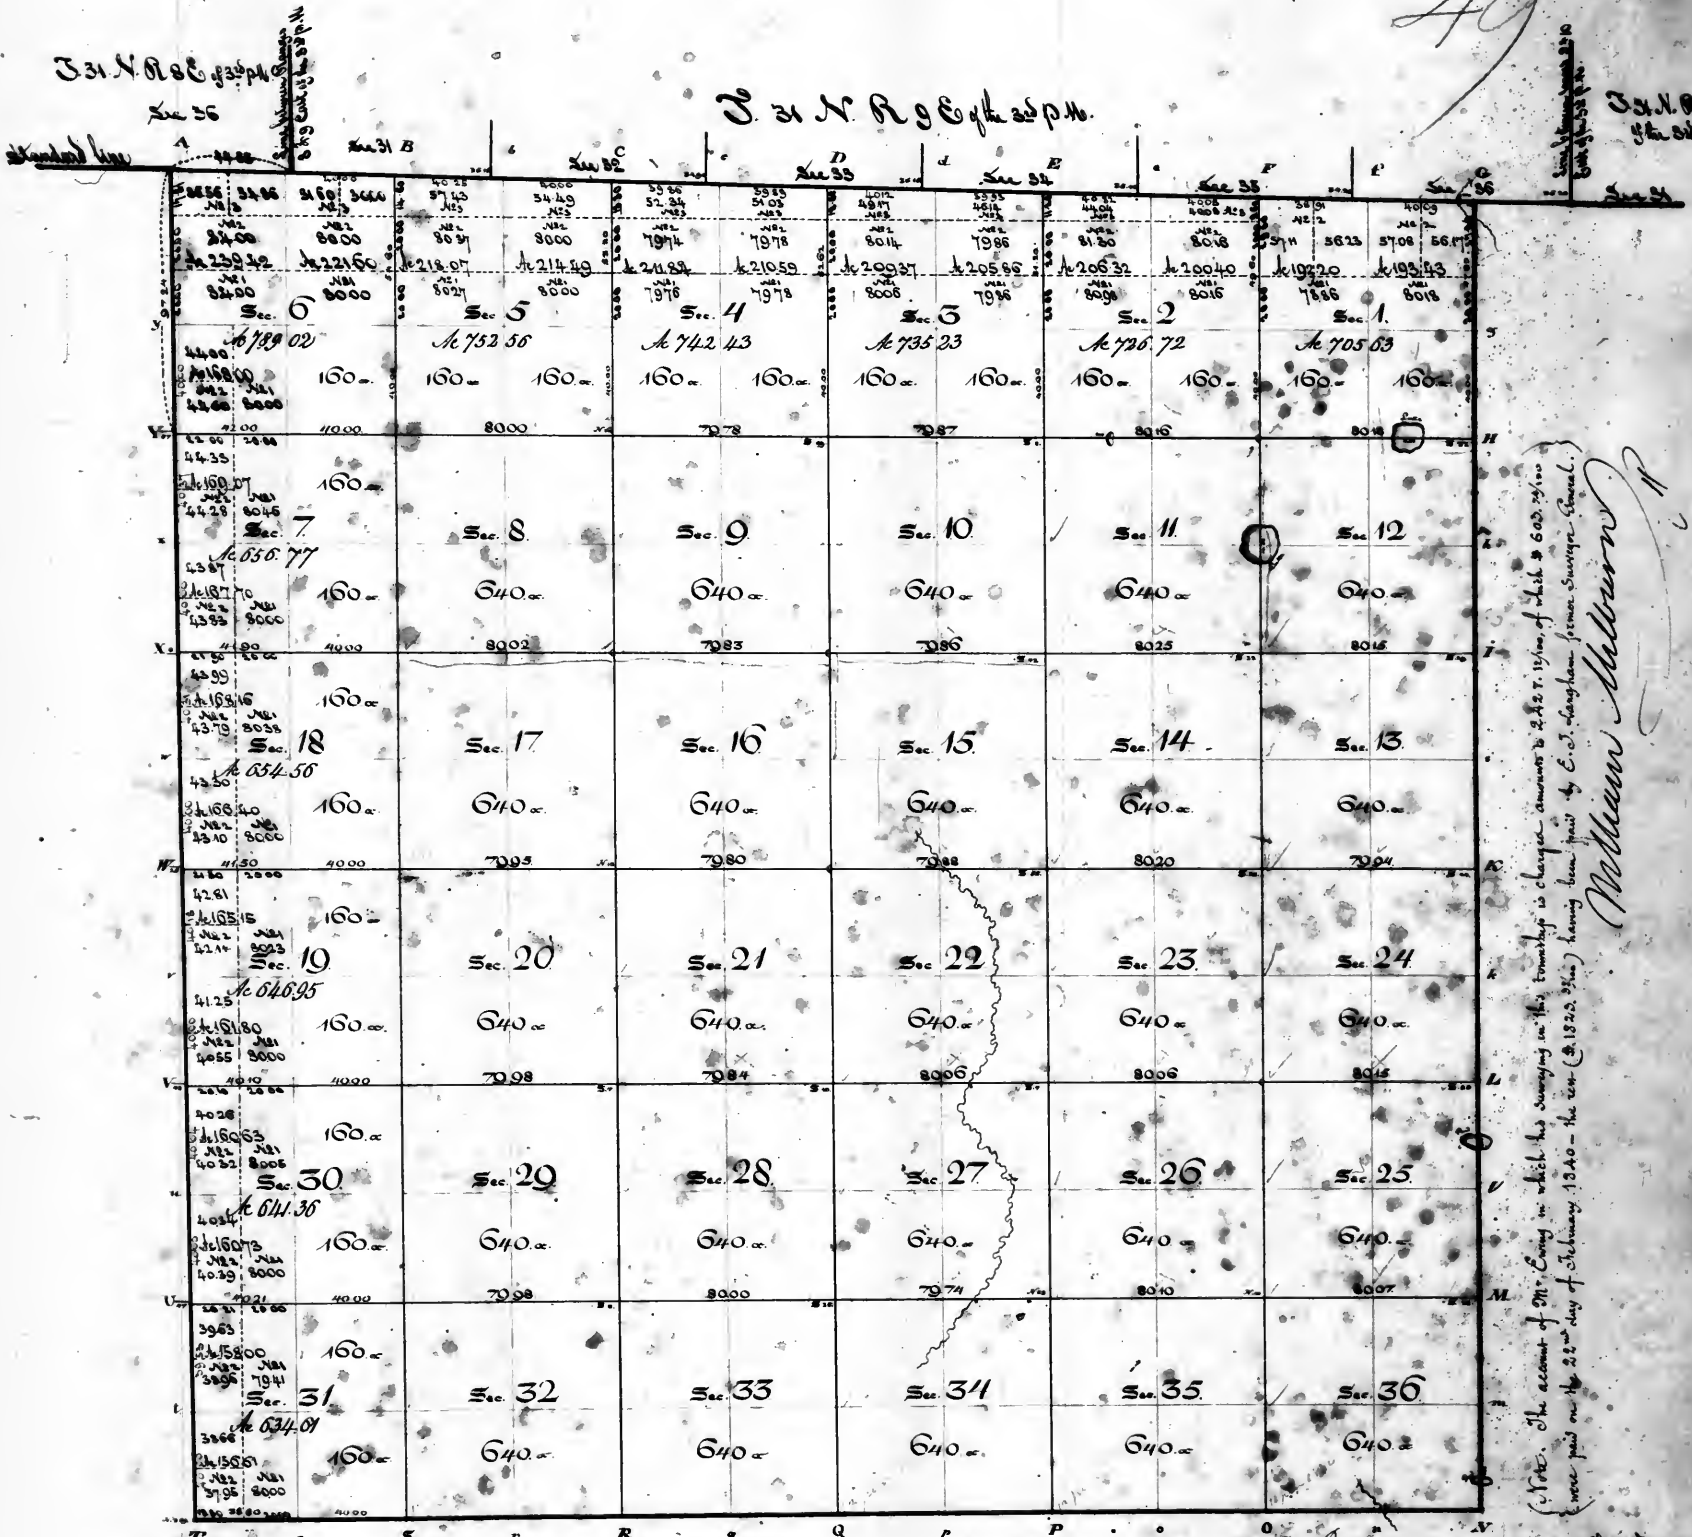

(Note: The account of Mr. Eny in which his surveying in this township is charged amounts to \$2,457.19, of which \$600.00 was paid on the 22nd day of February 1840 - the rest (\$1,857.19) having been paid by E. J. Langham, former Surveyor General.)

William Millburn

Section
Subdivision line 7 35 E
West boundary not stated in field notes
West boundary 7 45 E


Surveyors Office
St. Louis 20th March 1840.

The above plat of Township 30 North of the base line Range 9 East of 3^d principal Meridian is the first plat of the survey thereof on file in this Office, which have been examined and approved. The north boundary was surveyed in the 2^d quarter of 1821 by Daniel Miller under the joint contract of Stephen Rector and Thomas C. Rector, dated 20th of March 1821 - The west boundary 6 miles 17.24 chains was surveyed in the 2^d quarter of 1824, by B. J. Menzies under contract of J. M. Menzies and B. J. Menzies of the 2^d of September 1823 - The south boundary 5 miles 78.80 chains - the east boundary 6 miles 7.80 chains and the subdivision lines 60 miles 66.88 chains were surveyed in the 2^d quarter of 1824, all by William Lee D. Eny, under contract of the 16th day of August 1823 - When surveys by Eny, were to the extent noted in the margin, paid for on the 22nd of February 1840; and they will be charged in the account current of the Surveyor General for the present quarter (being the 1st quarter of 1840) under the general appropriation for surveying the public lands, Voucher N^o 7.

William Millburn
Surveyor of the public lands in
the States of Illinois & Missouri.

Downship N^o 31 North of the base line Range N^o 9 East of the 3rd principal meridian.

50

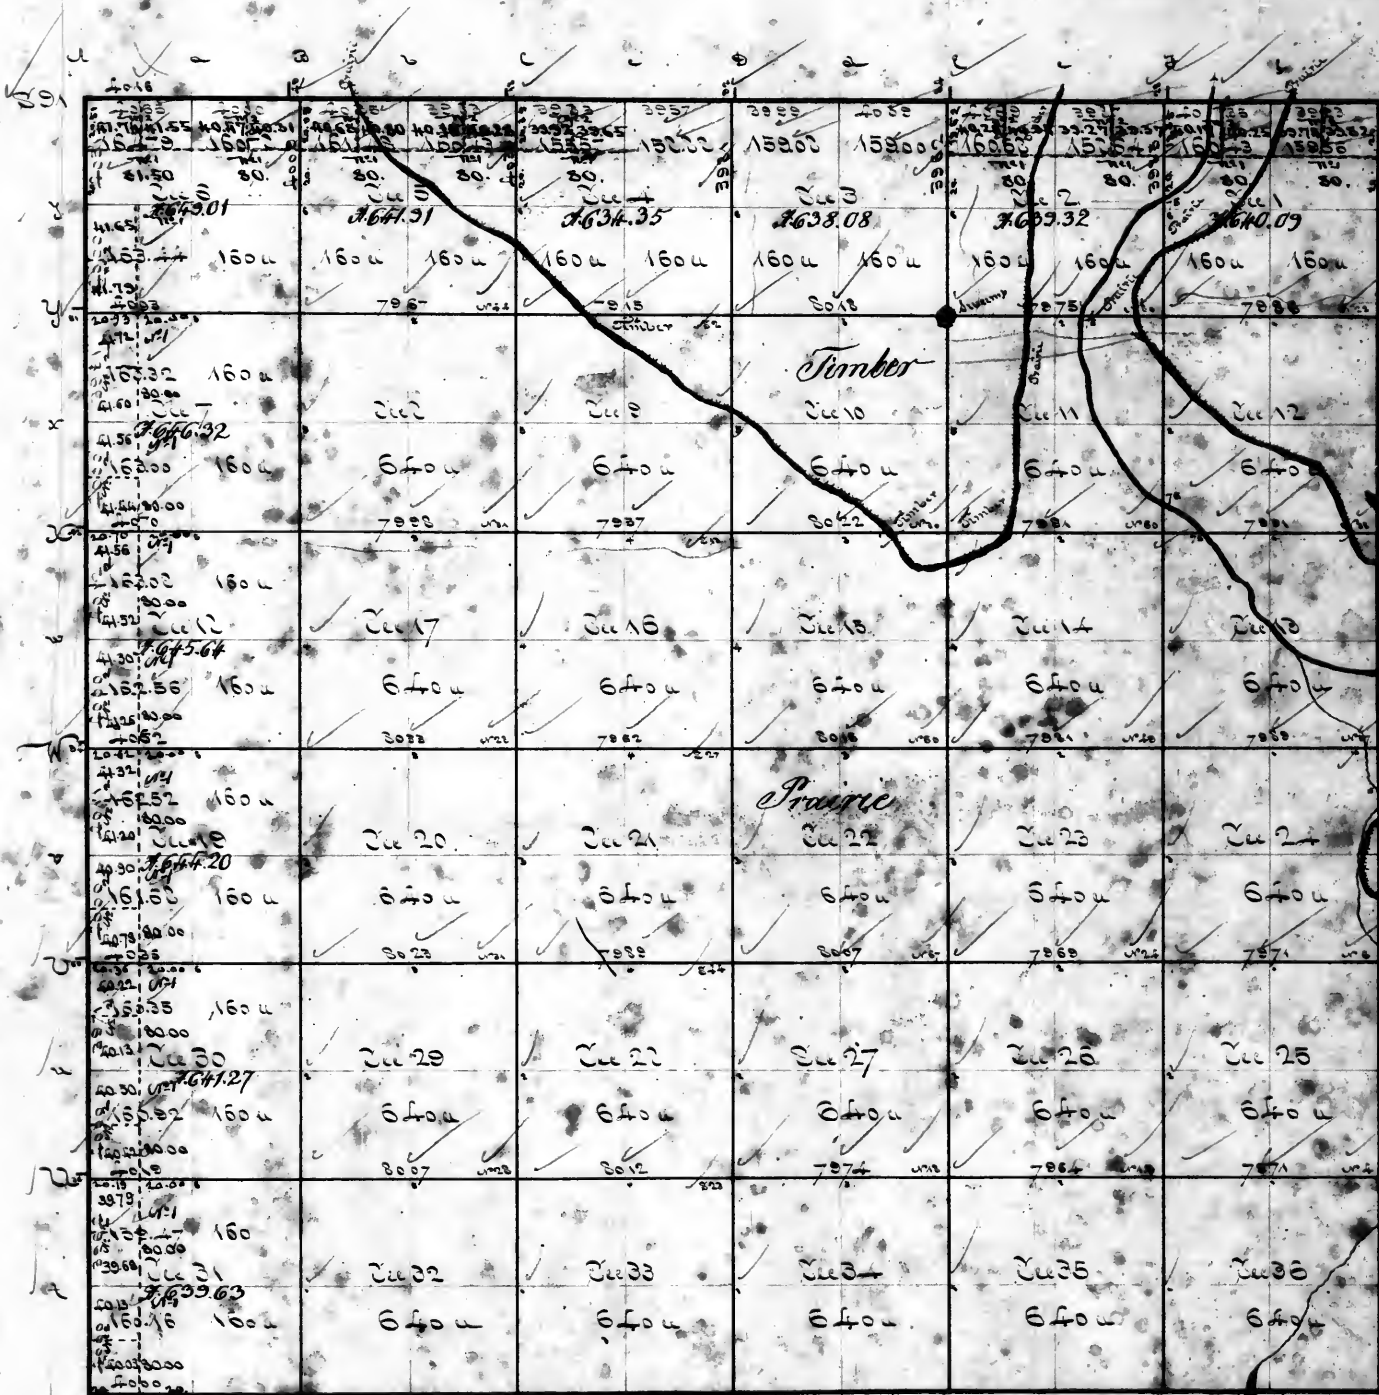

Surveyor's Office
St. Louis, Mo.
Subdivision made
the act of 1832, viz. the 10th sec.
of sec. 1, 11, 19, 30 and 31, and on
today, copying the plat thereon
to the Register and making
a duplicate and official copy.

Surveyor's Office
St. Louis, 27th August 1835
Subdivided under the Act of
Congress of the 5th of April 1832
the North halves of sec. 12, 15 and
the N.W. 1/4 of sec. 4, 11, the S.W. 1/4
of sec. 6, and sent a copy to
the Register and another copy
to the Comptroller of the General
Land Office.

Aggregate area = 23053.82 acres

Surveyor's Office
St. Louis July 3rd 1834


The above Plat of Township 31 North of the base line, Range 9 East of the 3rd principal meridian, is conformable to the field notes of the survey thereof on file in this Office.

E. J. Sangham

51A

to be pasted in opposite p. 51

Fractional Township 32 North of the base line, Range 9 East of the 3^d Principal Meridian

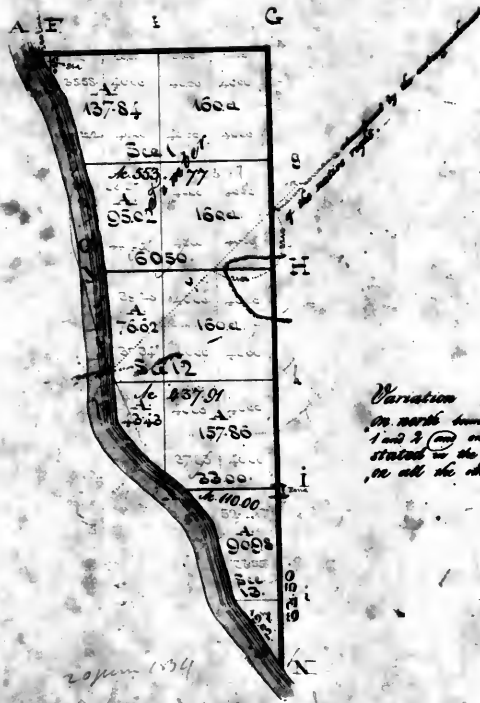

Variation
On north boundary, — on line between sections
1 and 2 (10) on meander along section 2 not
shown in the field notes.
on all the other line 7' East.


Surveyor General's Office.
Saint Louis 16 August 1850.

The above plat of fractional township 32 north of the base line, range 9 east of the 3^d principal meridian, is strictly conformable to the field notes of the survey thereof on file in this office, which have been examined and approved. The north boundary was surveyed by John Wells in the 2^d quarter of 1821, under the contract of Stephen and Thomas C. Rector of the 20th of March 1821 — the east boundary North of the township line 14.2, and the meander along section 2, one of the Indian boundary line surveyed by Daniel Miller in the 2^d quarter of 1821, under the aforesaid contract of Stephen and T. C. Rector. The meander and the balance of said east boundary, the subdivision lines and meanders, were surveyed in the 1st quarter of 1834 by Capt. W. Beckwith, under contract of the 20th of October 1833.

William M. McKim
Surveyor General
24

of Township 32 North of the Base Line, Range 9 East of the 3rd Principal Meridian
 except that part thereof which lies East of the Kanabakee River, is conformable to the field notes of the Survey thereof on file in this Office.

51

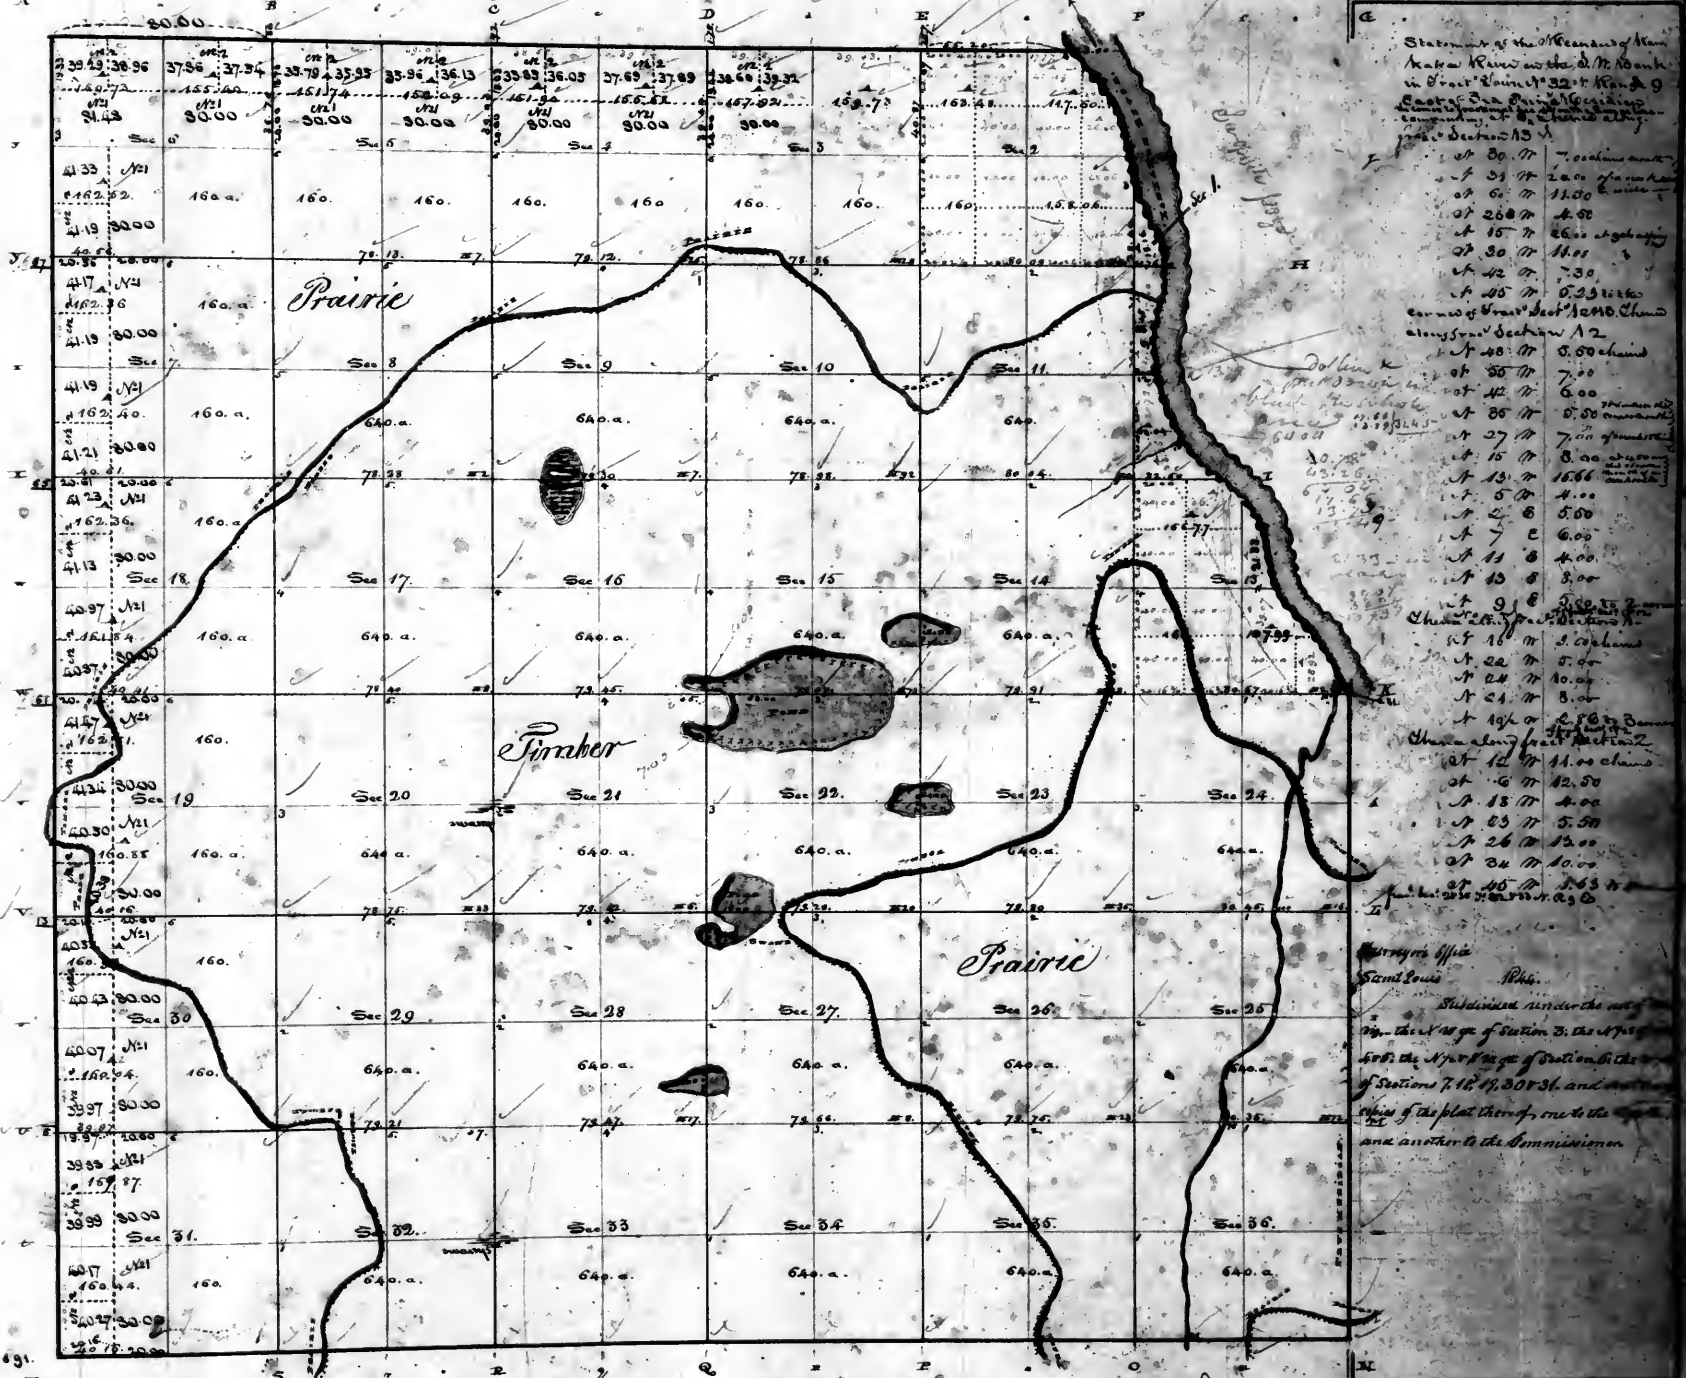



Surveyors Office
 St. Louis July 3, 1834

The above Plat of Township 32 North of the base line, Range 9 East of the 3rd principal meridian except that part thereof which lies East of the Kanabakee River, is conformable to the field notes of the Survey thereof on file in this Office.

E. O. Vaughan

T. 33. N. 3. E. of the 3^d pl. Mon

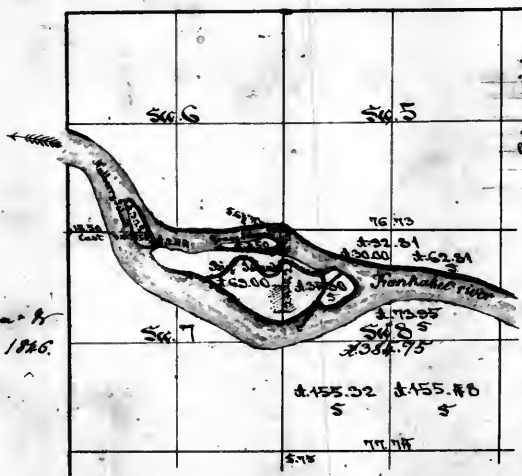

St. Louis, 2nd June 1851
This day set down on this plat
the area of Sec. 8, reported as
sold (marked S) from the
Register at Chicago. See his
letter May 15th 1851

Copy sent to the Comm^r &
Register on August 1846.

Variation 2^d.
Scale of 30 chains to
an inch.

Statement of the lines run by A. S. Mathewson, as set forth in
the certificate below.

| | |
|--|---------------|
| Big island. Line between section 743 from south shore of island to north bank of river | 36.07 |
| Measure around the island | 2.06 |
| Grape island. - Connecting line from corner to foot of 546 on the north bank of the river. 56 1/2 to the east end of the island | 7.83 |
| Measure around the island | 20.75 |
| Malberry island. The line between sections 647, from the corner on the W. boundary of the township, East to the East shore of the island | 28.46 |
| Measure around the island | 39.26 |
| Total | 126.37 |

Copy sent to the Commissioner & Register on
19th August 1846.


Surveyor's Office.
St. Louis 15th August 1846.

The above plat of these islands in the Kaskaskia river, to wit: of Big island in section 743, of Grape island in section 744, and of Malberry island, in section 647, in township 33 north of the base line range 9 East of the 3^d P^m meridian, is strictly conformable to the first sale of the survey made on file in this office, which have been examined and approved. The township was surveyed in July 1821, under the contract of Thomas C. Reister and Stephen Reister of St. Louis 1821 - but it having been represented to the Commissioner of the General Land Office, that there was an island unsurveyed in the section aforesaid, he, on the 20th March 1846, instructed the surveyor General to have it surveyed, and in consequence thereof, an order of survey, was on the 18th May 1846, given to A. S. Mathewson, to that effect - The same was done in June 1846, the three islands above designated. The surveying is detailed in the above statement. The islands 743, 744, 745, which are paid for on this day, and charged to the United States, in Voucher No. 1, of account current of the surveyor General during the 3^d quarter 1846, under the appropriation of \$1200, of the 3^d of March 1845, for the purchase of surveys & defective surveys in Illinois & Missouri, at a rate not exceeding 50¢ dollars a mile. See page 65, note of 2^d session of 28 Congress.

J. R. Cowan
Surveyor of the public land in
the State of Missouri & Wisconsin.

Pursuant to a Contract with and instructions from William Proctor Surveyor of the lands of the
the States of Missouri and Illinois and Territory of Arkansas bearing date the twentieth day of
1821 We have advanced and laid out and surveyed the above described Township and do hereby Certify
has such marks and bounds both natural and artificial as are ascertained on said plat
described in the field notes made thereof and returned unto this Plat into the office of the Surveyor
lands of the United States in the States of Missouri and Illinois and Territory of Arkansas
Certified this First day of Nov 1823
Surveyors Office
St. Louis July 1824
Examined
The above Plat of Township 33 North of the baseline, Range 9 East of the 3rd principal meridian; is a full and correct
on file in this Office.

Reverencing at the corner

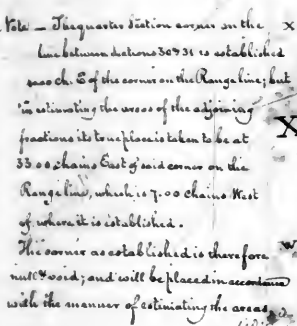


to 5
Co. on
... 30
... 25
... 20
... 15
... 10

| | |
|-------------------------|--------|
| 7. 59. 10. 3 | 2. 27 |
| 8. 15 | |
| How long continued | |
| 7. 57. 3 | 6. 35 |
| 7. 26. 3 | 4. 11 |
| 8. 14 | |
| How long continued | |
| 7. 52. 3 | 9. 36 |
| 7. 34. 3 | 16. 34 |
| 7. 6. 3 | 6. 2 |
| 7. 11. 3 | 4. 70 |
| 7. 46. 3 | 6. 45 |
| 7. 14. 3 | 4. 50 |
| 7. 6. 3 | 7. 30 |
| 7. 7. 3 | 6. 50 |
| 7. 5. 3 | 7. 10 |
| 7. 16. 3 | 12. 57 |
| 7. 23. 3 | 2. 97 |
| 7. 11. 30. 3 | 2. 27 |
| was 16 | |
| How long continued | |
| 7. 2. 3 | 11. 11 |
| 7. 5. 3 | 24. 60 |
| 7. 15. 3 | 16. 25 |
| 7. 23. 3 | 3. 2 |
| 7. 19. 3 | 37 |
| 7. 11. 3 | 11. |
| the crew of. fractional | |
| 20. 10. 55. 4. Range | |

The above Plat of Township 34 North of the base line, Range 9 East of the 3^d principal meridian, with the exception stated in the margin, is conformable to the field notes of the survey thereof as filed in this office.

Township No 35 North of the base line of Range No 9 East of Principal meridian

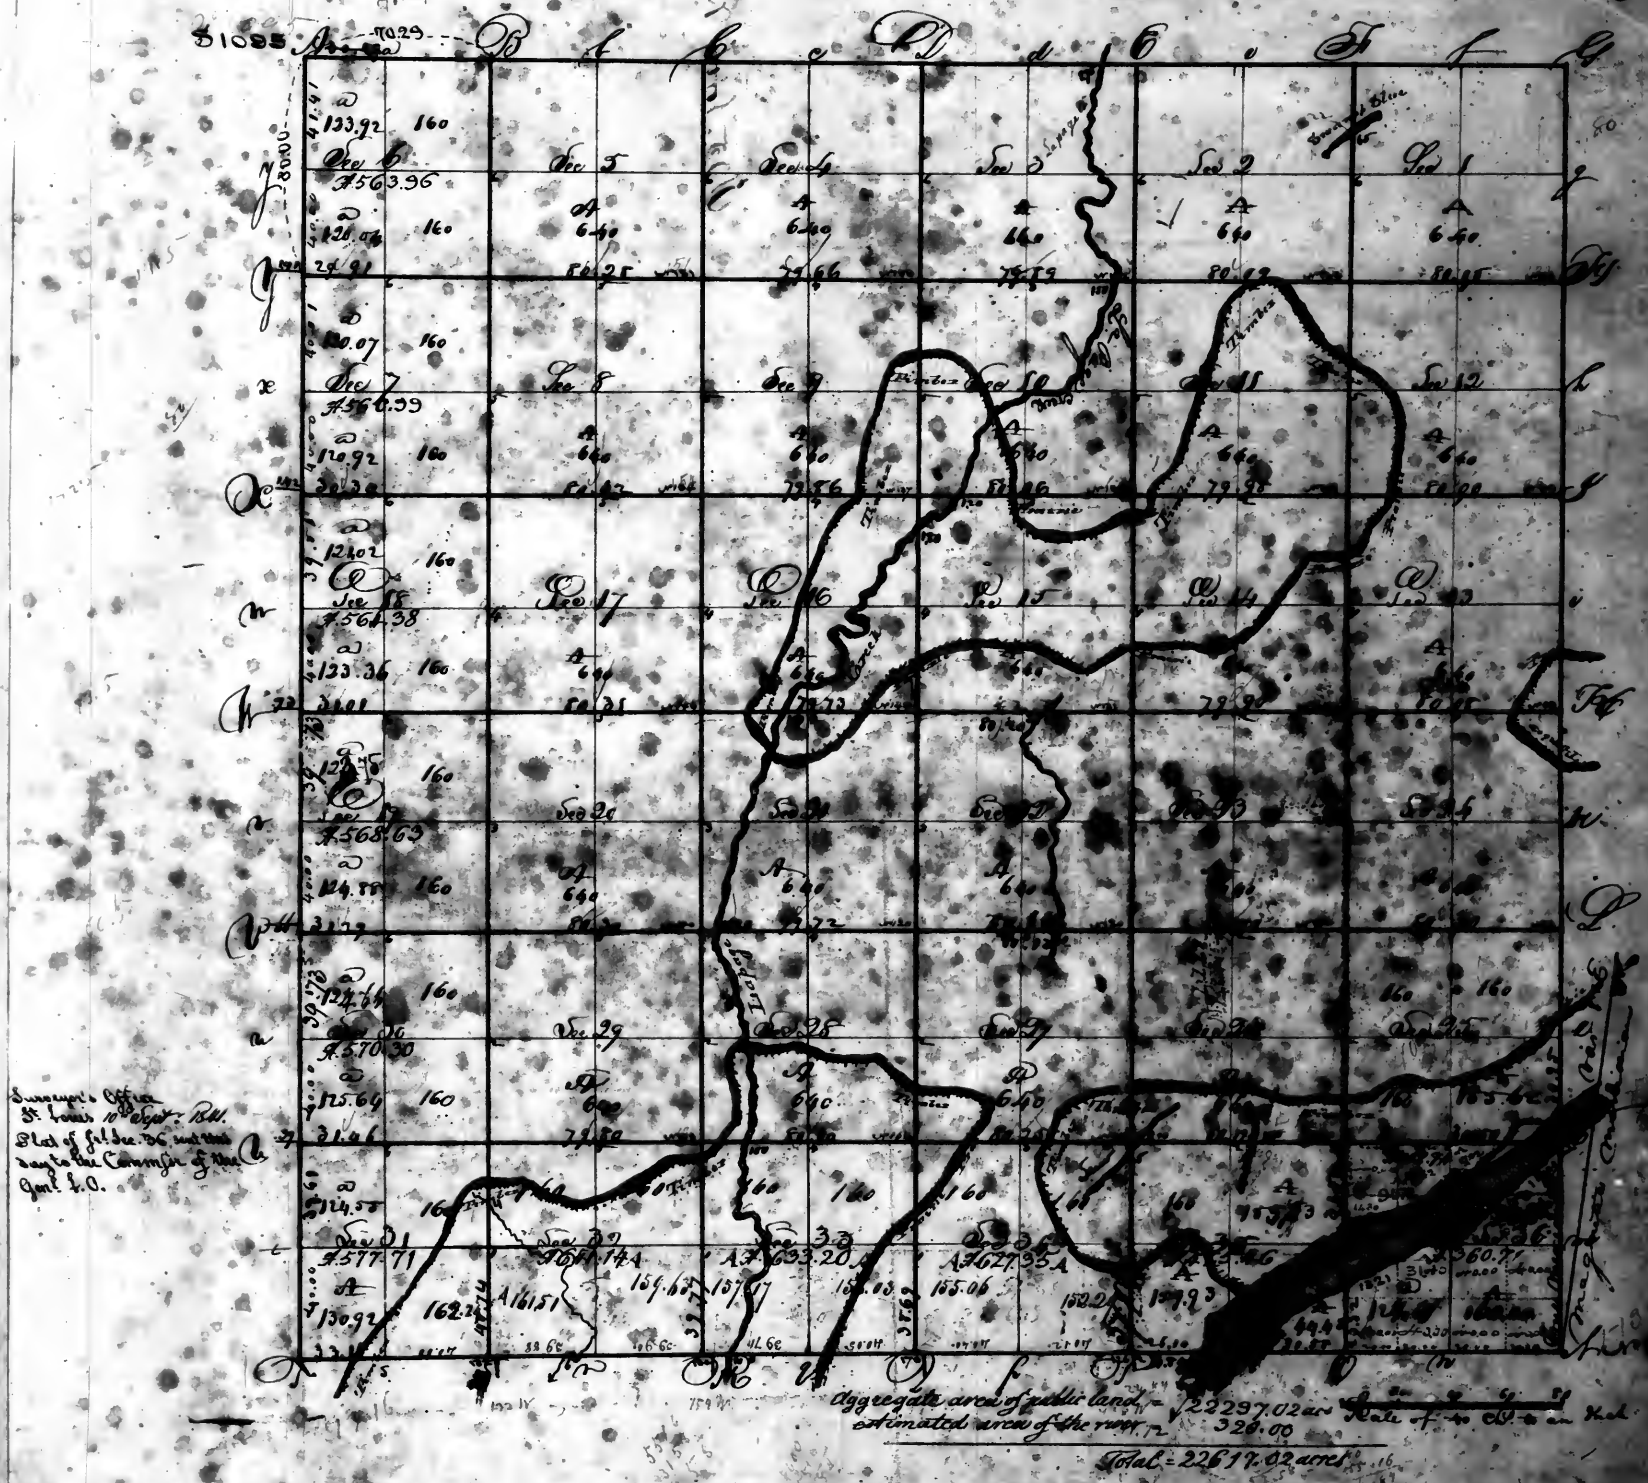

Surveyor's Office
 St. Louis Mo. Sept. 18th.
 Plat of Twp. 35 North
 Range 9 East of the
 Principal Meridian
 Genl. L.O.


Pursuant to a contract with and instructions from William H. Reector Surveyor of the Lands of the United States in the States of Illinois and Missouri and Territory of Arkansas bearing date the twentieth day of March 1854 we have measured laid out and surveyed the above described Township and do hereby certify that it has been measured and bounds both natural and artificial as are represented on said plat and described in the field notes thereof and returned with the plat into the office of the Surveyor of the Lands of the United States for the States of Illinois and Missouri and Territory of Arkansas.

Verified this day of Nov 1854
 Examined
 Surveyor's Office
 St. Louis July 31 1854
 The above Plat of Township 35 North of the base line, Range 9 East of the Principal Meridian, is confirmed to the field notes of the survey thereof on file in this Office.

Wm. H. Reector
 Surveyor

Township 36 North of the base line, Range 9 East of the 3rd principal Meridian.
South West of the old Indian boundary.

55

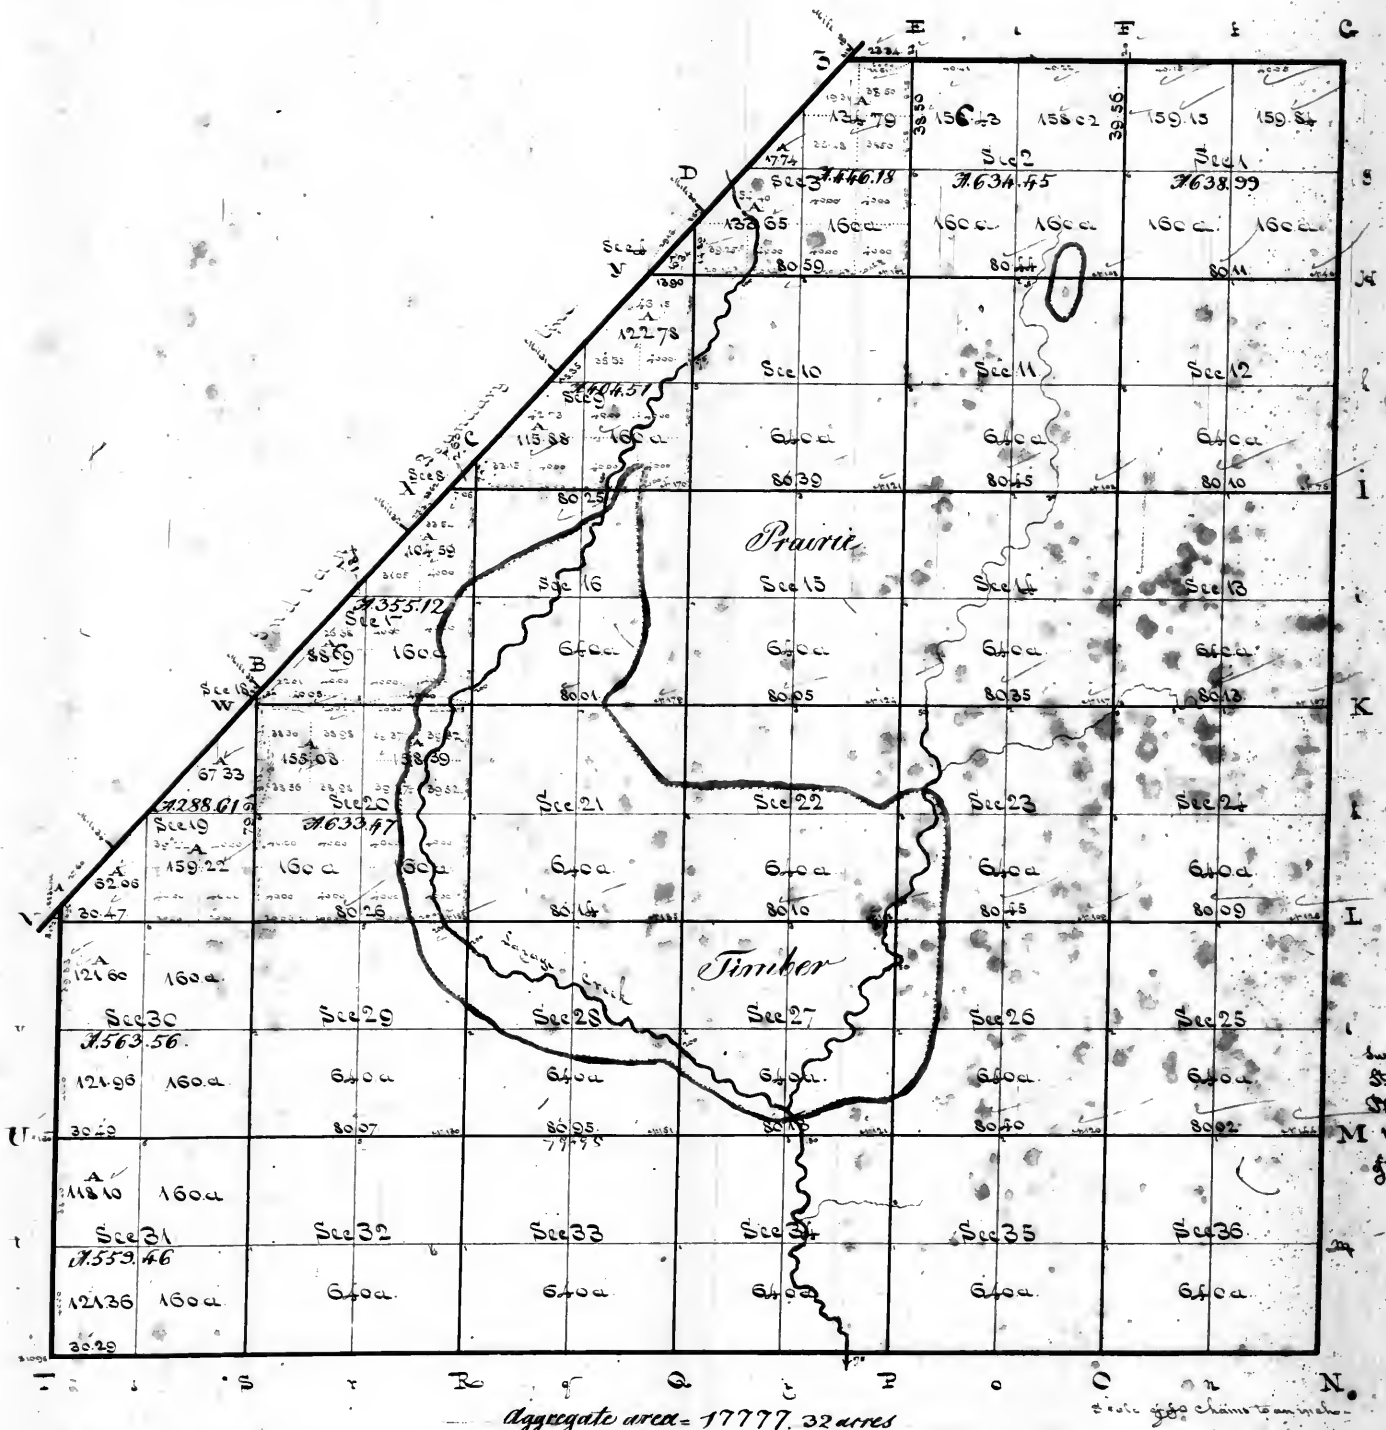

Surveyor's Office
St. Louis 10th Apr 1834
Plat of final sections 2, 3, 4, 5, 6, 7, 8, 9, 10, 11, 12, 13, 14, 15, 16, 17, 18, 19, 20, 21, 22, 23, 24, 25, 26, 27, 28, 29, 30, 31, 32, 33, 34, 35, 36, out this day to the
of the General Land Office.


Surveyor's Office
St. Louis 10th Apr 1834

The above Plat of Township 36 North of the base line, Range 9 East of the 3rd principal meridian, South west of the old Indian boundary, is conformable to the field notes of the survey thereof on file in this office.

E. J. Sanborn

Fractional Township No. 36 North of the Base line in Range No. 9 East of the 3rd pr. Meridian.

56

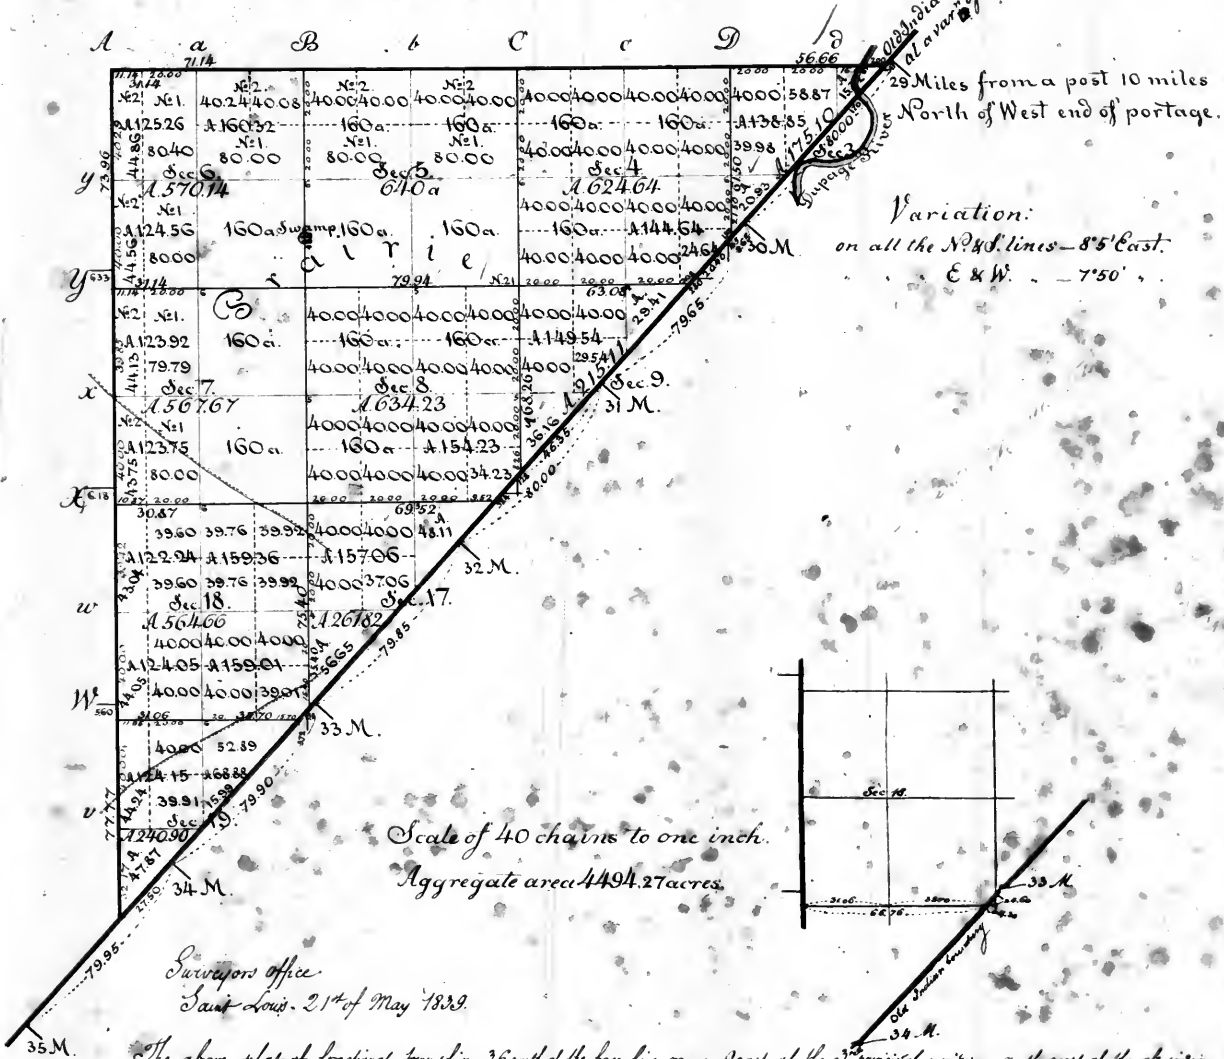


The above plat of fractional township 36 north of the base line range 9 east of the 3rd principal meridian, north west of the old indian boundary, is strictly conformable to the field notes of the survey thereof on file in this Office, which have been examined and approved - The South eastern boundary of this fractional township which is designated 'old indian boundary' was surveyed in the 4th quarter of 1821, in order to close the surveys to the South east thence, under the contract of Stephen and Thomas C. Pector, of the 20th of March of 1821; it was commenced at the 17th mile of the indian boundary run by John C. Sullivan, assisted by James Mc. Duncan, in the 4th quarter of 1818, from a point 10 miles North of the postage South west to a point 10 miles above the mouth of Sandy creek, under a letter of appointment dated 18th of October 1813, for the survey of the boundary lines of the treaty of Saint Louis of the 24th of August 1816 between the United States and the united tribes of Ottawas, Chippewas and Pottowattomies and was intended as a reserve in part of said survey of 1818, but diverged therefrom to the North west - That part of said indian boundary which forms a boundary to this fractional township 5 miles 23.73 chains was surveyed - and the west boundary 3 miles 71.73 chains - and the north boundary 3 miles 47.50 chains, were surveyed in the 4th quarter of 1827, and the subdivision lines 10 miles 70.68 chains, were surveyed in the 2nd quarter of 1838 - all by Eli. S. Prescott under contract signed by the Surveyor General on the 8th of May - and by the said Prescott on the 3rd of June 1837 - and with the exception of the subdivision line between sections 18 and 19 (which in the first survey was 70.34 chains) they were paid for in the 4th quarter of 1838, and charged in the account of the Surveyor General for that quarter - Voucher N^o 5 - The line between sections 18 and 19 was resurveyed in the 2nd quarter of 1839: the field notes have been examined and approved - but the Survey has not yet been paid for.

William Milburn
Surveyor General

37
 Townships North of the Base line Range No. 9 East of the 3rd Principal Meridian
 South East of the Old Indian boundary line.

Surveyed by
 H. C. Jones 10th Sept 54
 at copy of the plat of said land 25
 26. 34. 35 and this day to the land
 of the Genl Land Office.

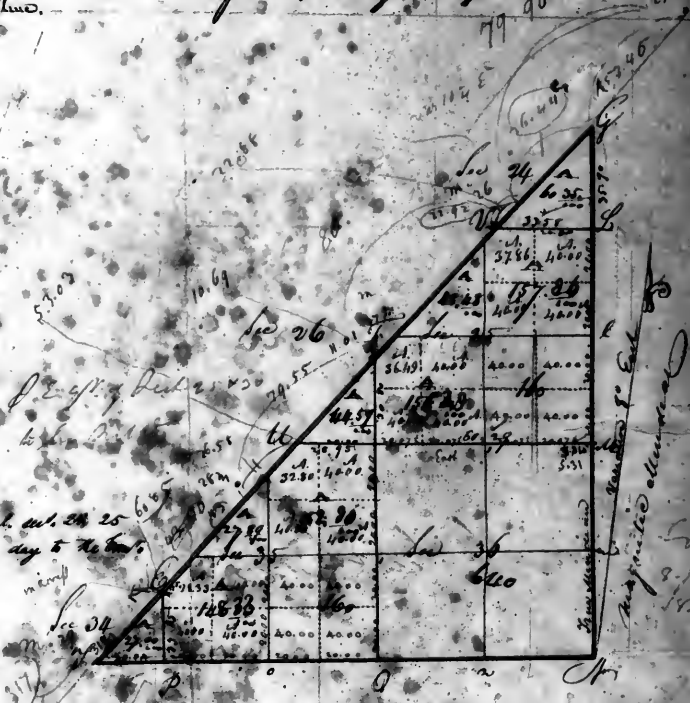


Pursuant to a contract with and instruction from Wm. P. Jones Surveyor of the Land of the
 United States for the States of Illinois, Wisconsin and Territory of Arkansas, bearing date the 25th
 March 1834. I have accordingly laid out and surveyed the above described
 Townships and as hereby certified that it has been made and been both measured and
 certified as true and correct on said plat and as such in the field notes made
 thereof and returned with this plat into the Office of the Surveyor of the Land of the
 United States for the States of Illinois, Wisconsin and Territory of Arkansas.

Ed.
 Surveyors Office
 St. Louis July 3rd 1834

The above Plat of fractional Township 37 North of the base line, Range 9 East
 of the 3rd Principal Meridian, South East of the Old Indian boundary line, is conformable to the field notes of the
 Survey thereof on file in this Office.

E. J. Conyhar

Fractional Township N^o 37 North of the Base line in Range N^o 9 East of the 3^d pr^l Meridian.

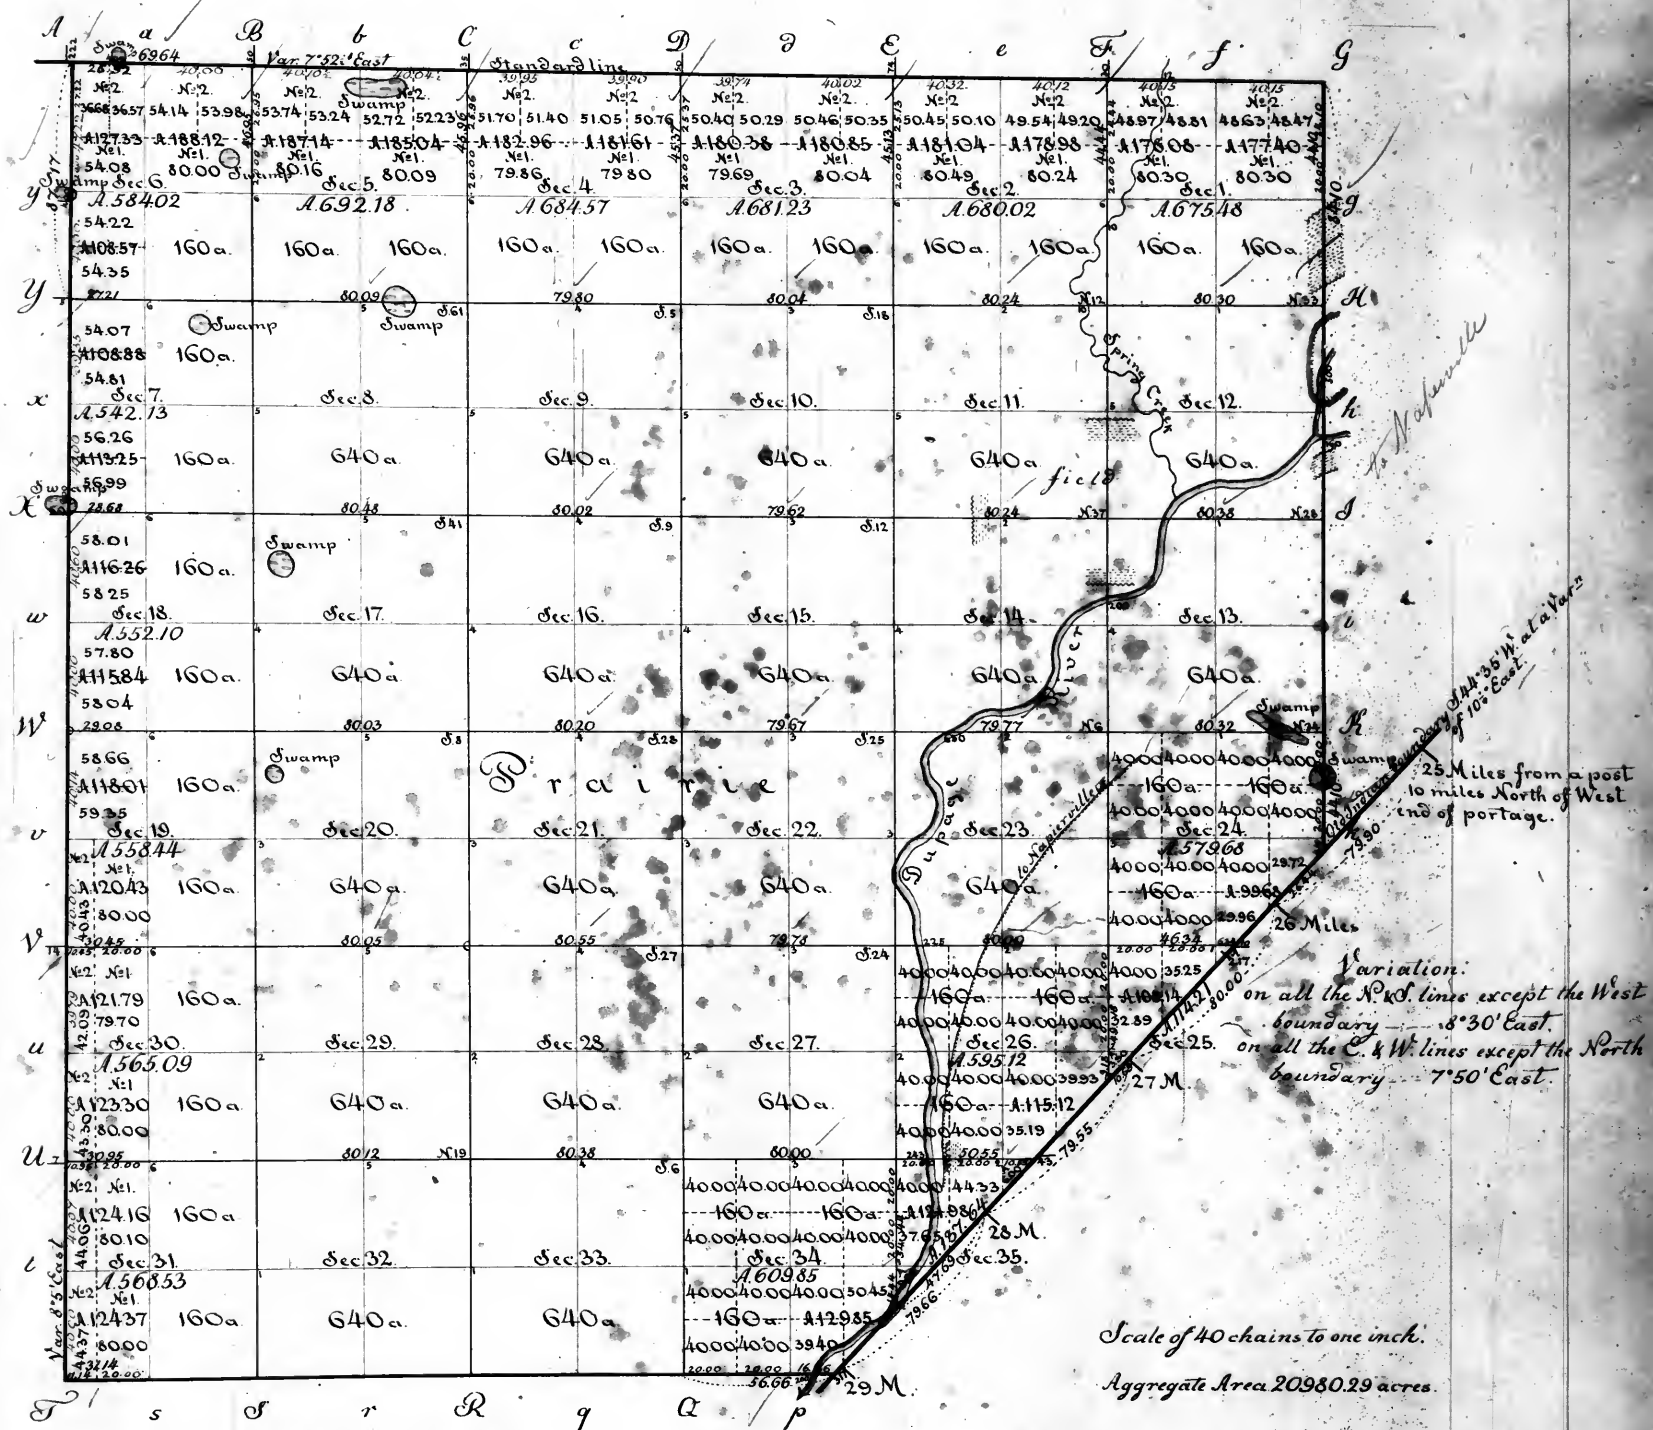


Surveyors Office, Saint Louis 21st of May 1839.

The above plat of fractional township N^o 37 north of the base line, range 9 east of the 3^d principal meridian, north west of the old indian boundary, is strictly conformable to the field notes of the surveying office in this office, which have been examined and approved. The South eastern boundary of this fractional township which is designated "old indian boundary" was surveyed in the 4th quarter of 1821, in order to close the survey to the South east thence, under the contract of Stephen and Thomas C. Foster, of the 20th of March 1821; it was commenced at the 17th mile of the indian boundary run by John C. Sullivan assisted by James M. Duncan, in the 4th quarter of 1818, from a point 10 miles North of the portage South west to a point 10 miles above the mouth of Sandy creek, under a letter of appointment dated 18th of October 1818, for the survey of the boundary lines of the treaty of Sand Lake of the 26th of August 1816, between the United States and the United Tribes of Ottawas, Chippewas and Ojibwas, and was intended as a return in part of said survey of 1818, but diverged thence to the North West - That part of said Indian boundary which forms a boundary to this fractional township 28.82 chains, was resurveyed, and the west boundary 6 miles 7.17 chains the South boundary 2 miles 47.80 chains - the east boundary 2 miles 48.20 chains - and the north boundary 5 miles 63.64 chains were surveyed in the 4th quarter of 1827 - and the subdivisions lines 56 miles 18.80 chains were surveyed in the 5th quarter of 1828 - all by Eli S. Prescott, under contract signed by the Surveyor General and by said Prescott on the 3^d of June 1827, and with the exception of the subdivisional lines between sections 6 and 7 - and said 6 amounting, according to the first survey to 1 mile 76.07 chains, they were paid for in the 4th quarter of 1828, and charged in the accounts of the Surveyor General for that quarter voucher N^o 5 - The survey of the line between sections 6 and 7 was corrected in the 1st quarter of 1829, and the field notes thereof, and of the line between sections 5 and 6 have been examined and approved; but the survey of the said line has not yet been paid for.

William Milburn
Surveyor General

Township 38 North of the base line Range 9 East of the 3^d principal Meridian

59

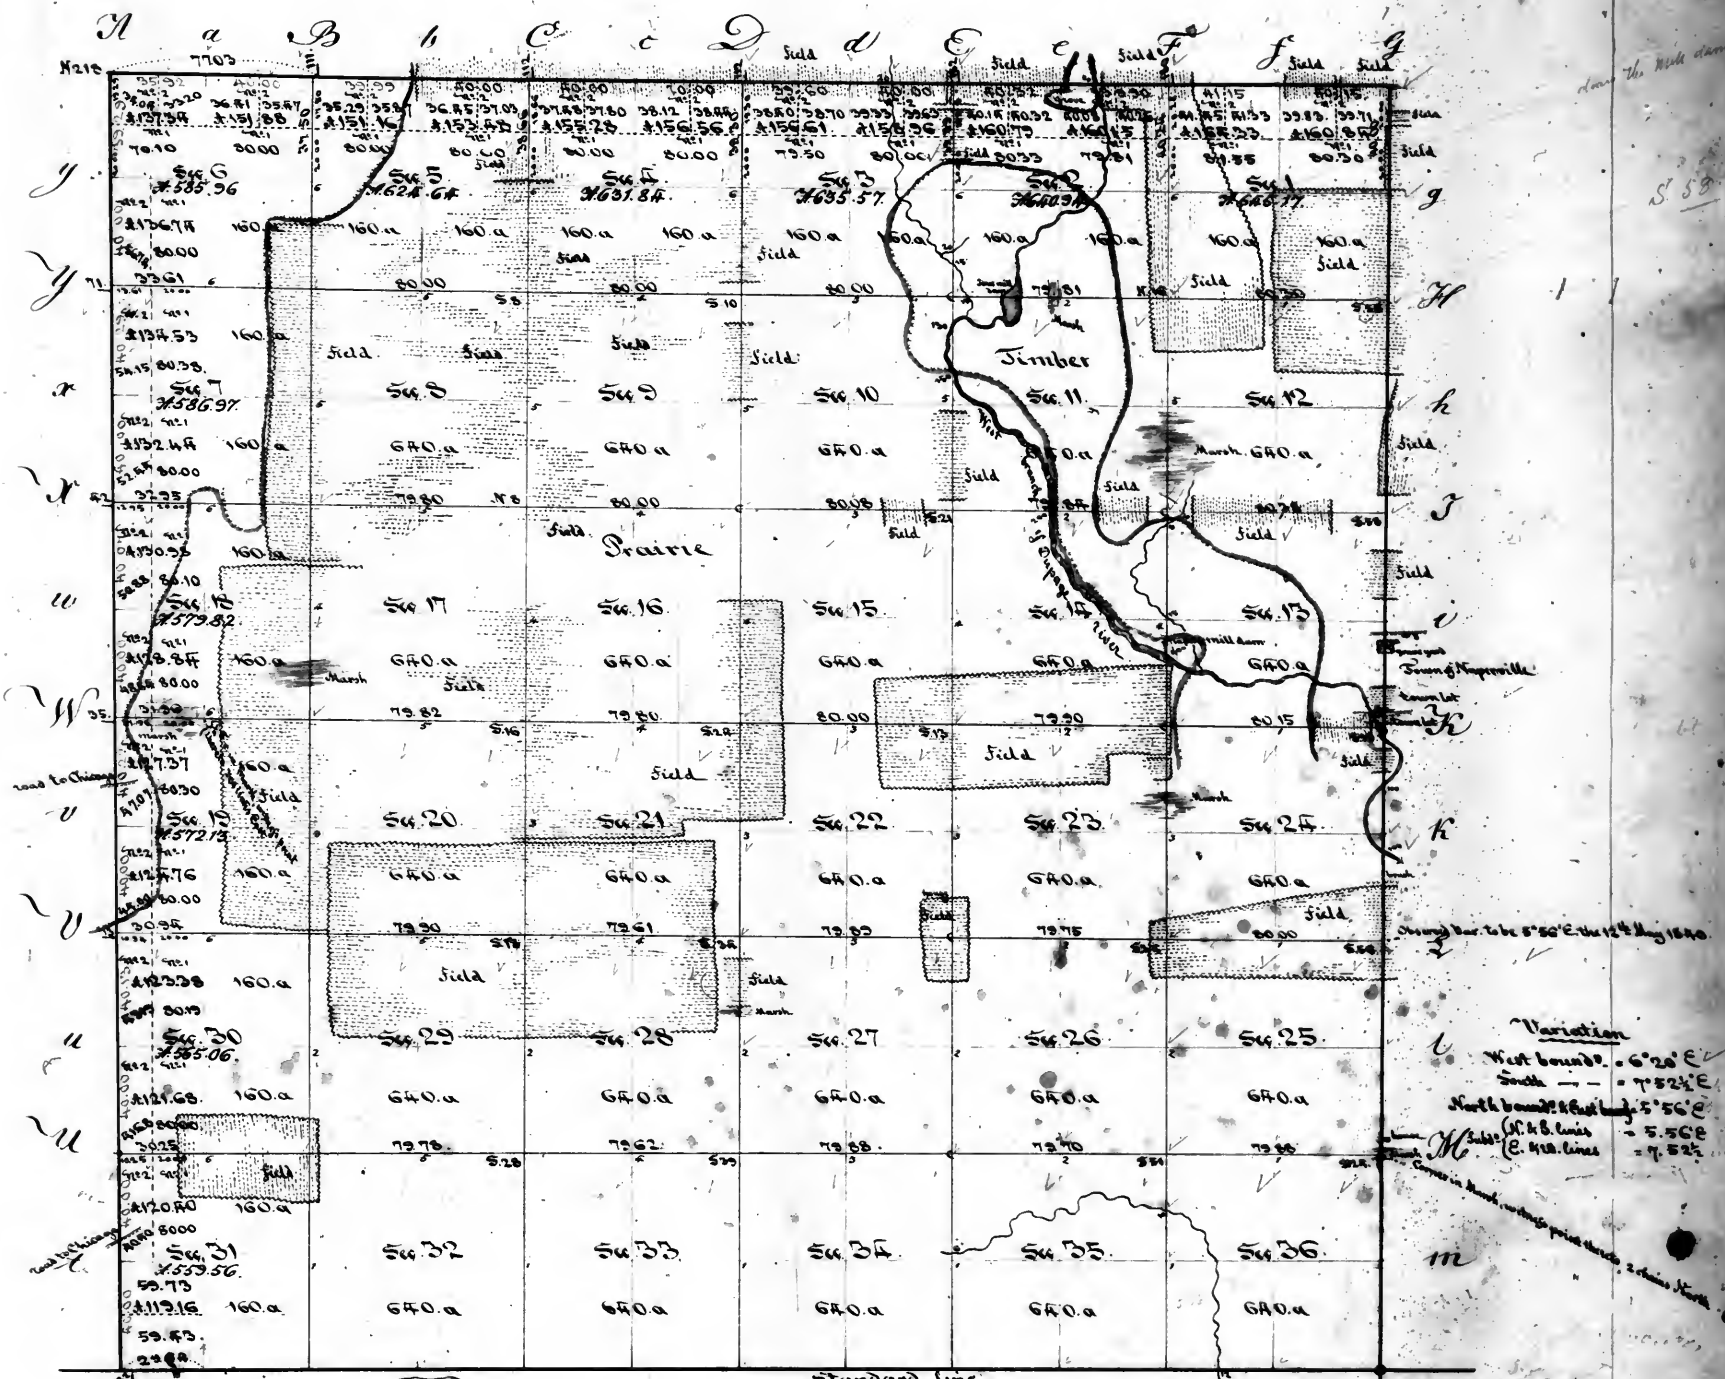

Variation
 West bound. 6° 28' E
 South — — — 7° 52' E
 North bound. 5° 56' E
 (N. & S. lines)
 (E. & W. lines)
 = 7° 52'


Surveyor's Office
 Jan^y 4th of January 1842

Scale of 40 chains to an inch
 Aggregate area = 22627.63 acres.

The above plat of township 38 north of the base line, range 9 east of the 3^d principal Meridian is strictly conformable to the field notes of the Survey thereof on file in this Office, which have been examined and approved. The South boundary 5 miles by 40 chains, was surveyed in the 4th quarter of 1837 by Eli S. Pratt and under contract signed by the Surveyor General on the 8th May 1837 and by said Pratt on the 3^d June 1837, — it was paid for in the 4th quarter of 1838 (and charged in the account current of the Surveyor General during that quarter, voucher 1817). — The East boundary, 6 miles, was surveyed in the 4th quarter of 1839 by James Thompson (and John T. Thompson under their joint contract, of the 21st September 1839, — it was paid for in the 3^d quarter of 1840 and charged in the account current of the Surveyor General during that quarter, voucher 1817). — The North boundary, 5 miles 77.03 chains, was surveyed in the 2^d quarter of 1840 by the said Ewing under his before said contract, — the 6 miles which form the North boundary of sec^s 32, 33, 34, 35, 36 and 37, 38, 39, 40 were paid for in the 2^d & 4th quarters of 1841 (and charged in the account current of the Surveyor General during those quarters, vouchers 1818 & 1819). — The remaining 77.03 chains were paid for in the 4th quarter of 1841 and charged in the account current of the Surveyor General for that quarter voucher 1815. — The subdivision lines, 59 miles 23.19 chains, were surveyed in the 2^d quarter of 1840 by said Ewing under the said contract, — they were paid for in the 2^d & 4th quarters of 1841 and charged in the account current of the Surveyor General during those quarters under the general appropriation for surveying the public lands, vouchers 1818 & 1819.

Jos. C. Brown
 Surveyor of the public lands for the
 District of Illinois (and Missouri).

Township 39 North of the base line Range 9 East of the 3rd principal Meridian

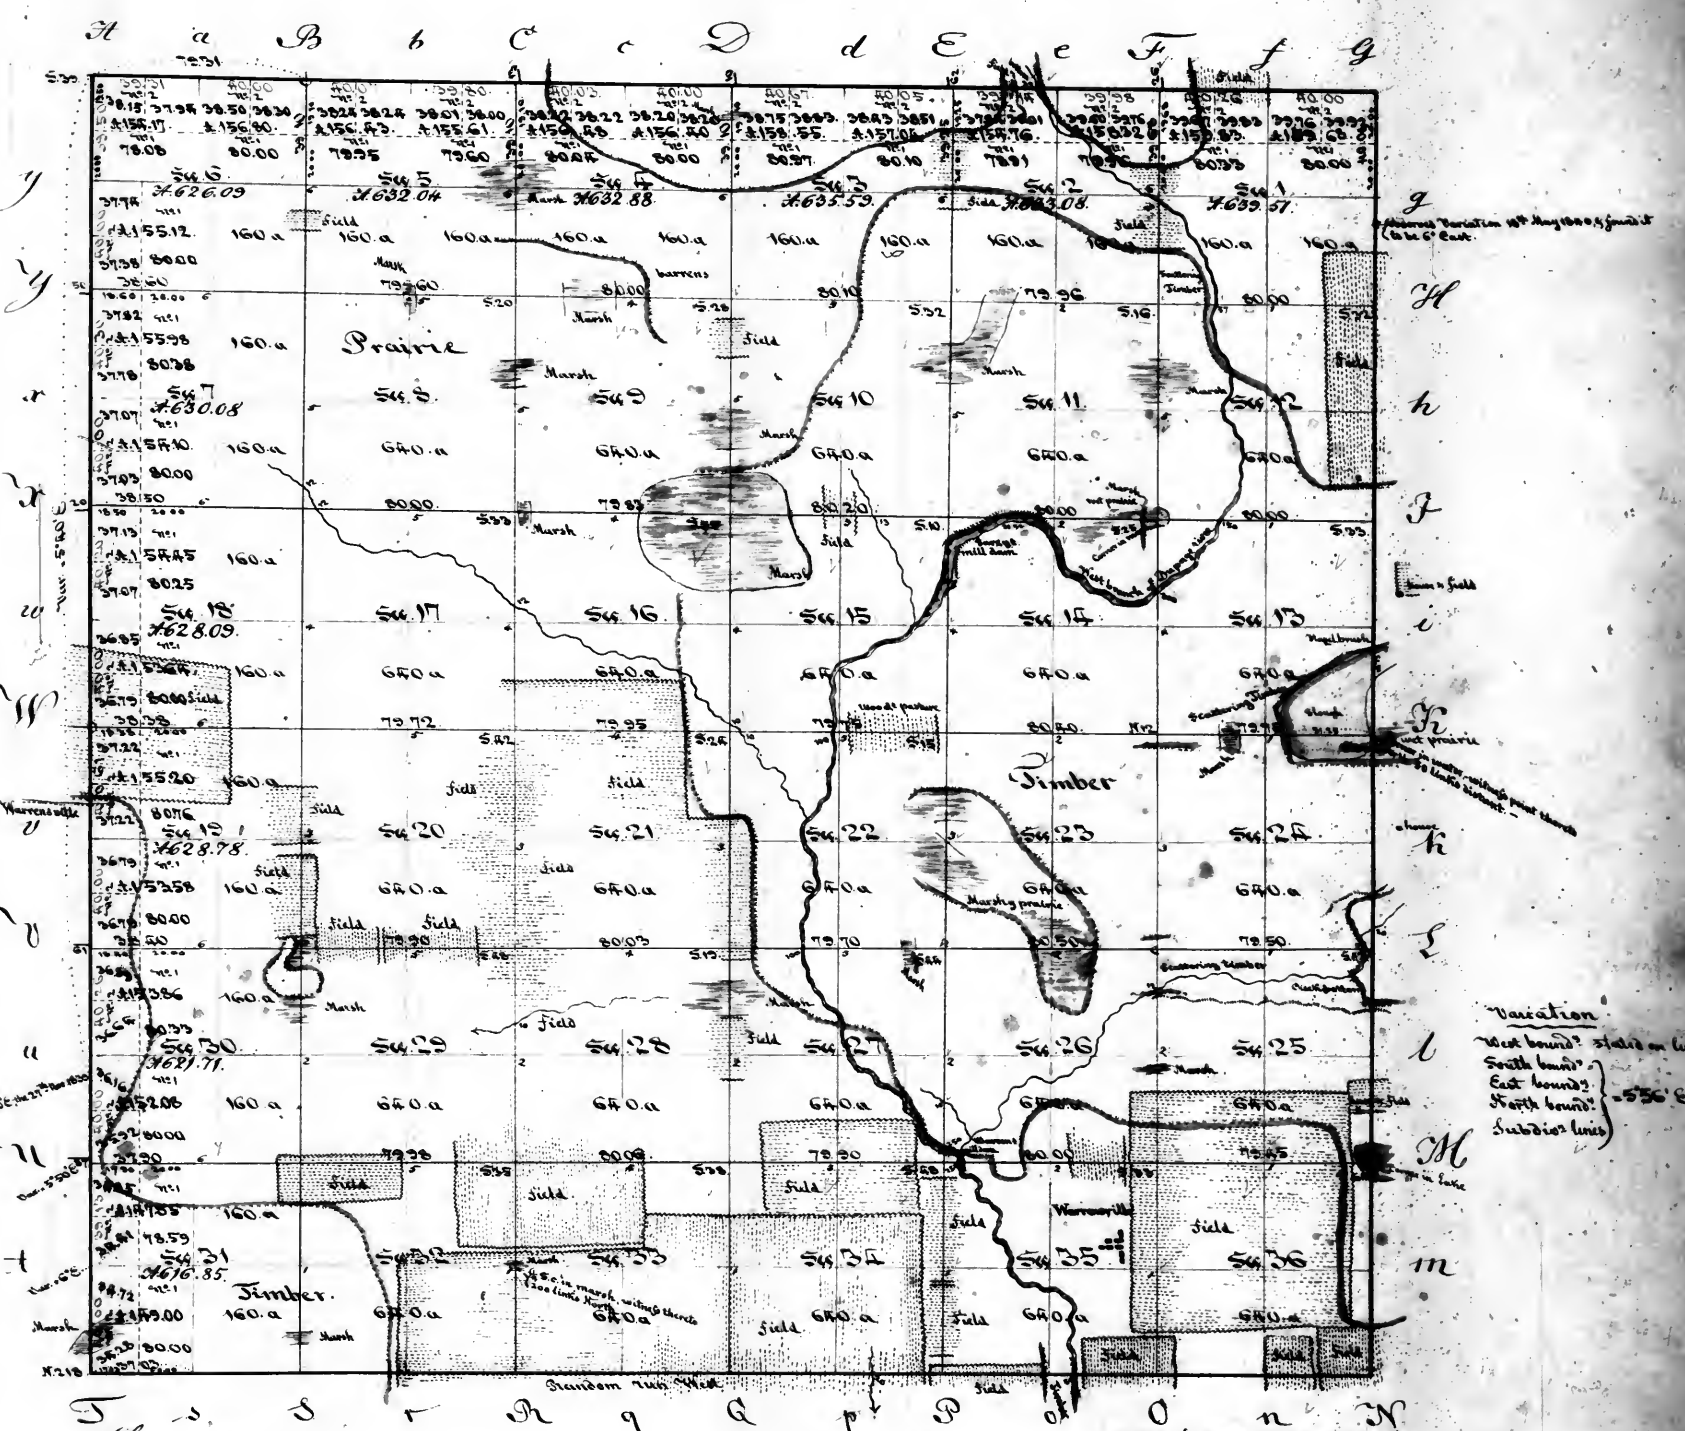

Surveyor's Office
St. Louis 14th of January 1843.


Scale of 40 chains to an inch
Aggregate area - 22924.70 acres.

along plat of township 39 north of the base line, range 9 east of the 3rd principal Meridian is strictly conformable to the field notes of the survey thereof on file in this office, which have been examined and approved. The West boundary, 6 miles, was surveyed in the 4th quarter of 1839 by James Thompson and John P. Thompson under their joint contract of the 31st September 1839, - it was paid for in the 3rd quarter of 1840 and charged in the annual current of the Surveyor General during that quarter voucher No. 17; - the South boundary, 5 miles 77.03 chains, was surveyed in the 2nd quarter of 1840 by W. L. D. Ewing under contract of the 23rd September 1839, - the 5 miles which form the South boundaries of sections 32, 33, 34, 35 and 36 were paid for in the 2nd & 4th quarters of 1840 and charged in the accounts current of the Surveyor General during those quarters, vouchers No. 2 & 4; - the remaining 77.03 chains were paid for in the 4th quarter of 1840 and charged in the annual current of the Surveyor General during that quarter voucher No. 15; - the East boundary, 6 miles and the North boundary, 5 miles 79.31 chains were surveyed in the 2nd quarter of 1840 by said Ewing under contract of the 23rd Sept. 1839 - they were paid for in the 2nd and 4th quarters of 1840 and charged in the annual current of the Surveyor General during those quarters vouchers No. 2 & 4; - The Subdivision lines 59 miles 66.29 chains were surveyed in the 2nd quarter of 1840 by the said Ewing under the said contract and 38 miles 68.39 chains thereof were paid for in the 2nd and 4th quarters of 1840 and charged in the annual current of the Surveyor General during those quarters vouchers No. 2 & 4; - 77.90 chains being the line between sections 30 & 31 were paid for in the 4th quarter of 1840 and charged in the annual current of the Surveyor General during that quarter under the general appropriation for surveying the public lands, voucher No. 15.

Jos. C. Brown,
Surveyor of the public lands for the
1st district of Illinois (and Missouri).

Township 40 North of the base line Range 9 East of the 3^d principal Meridian

61

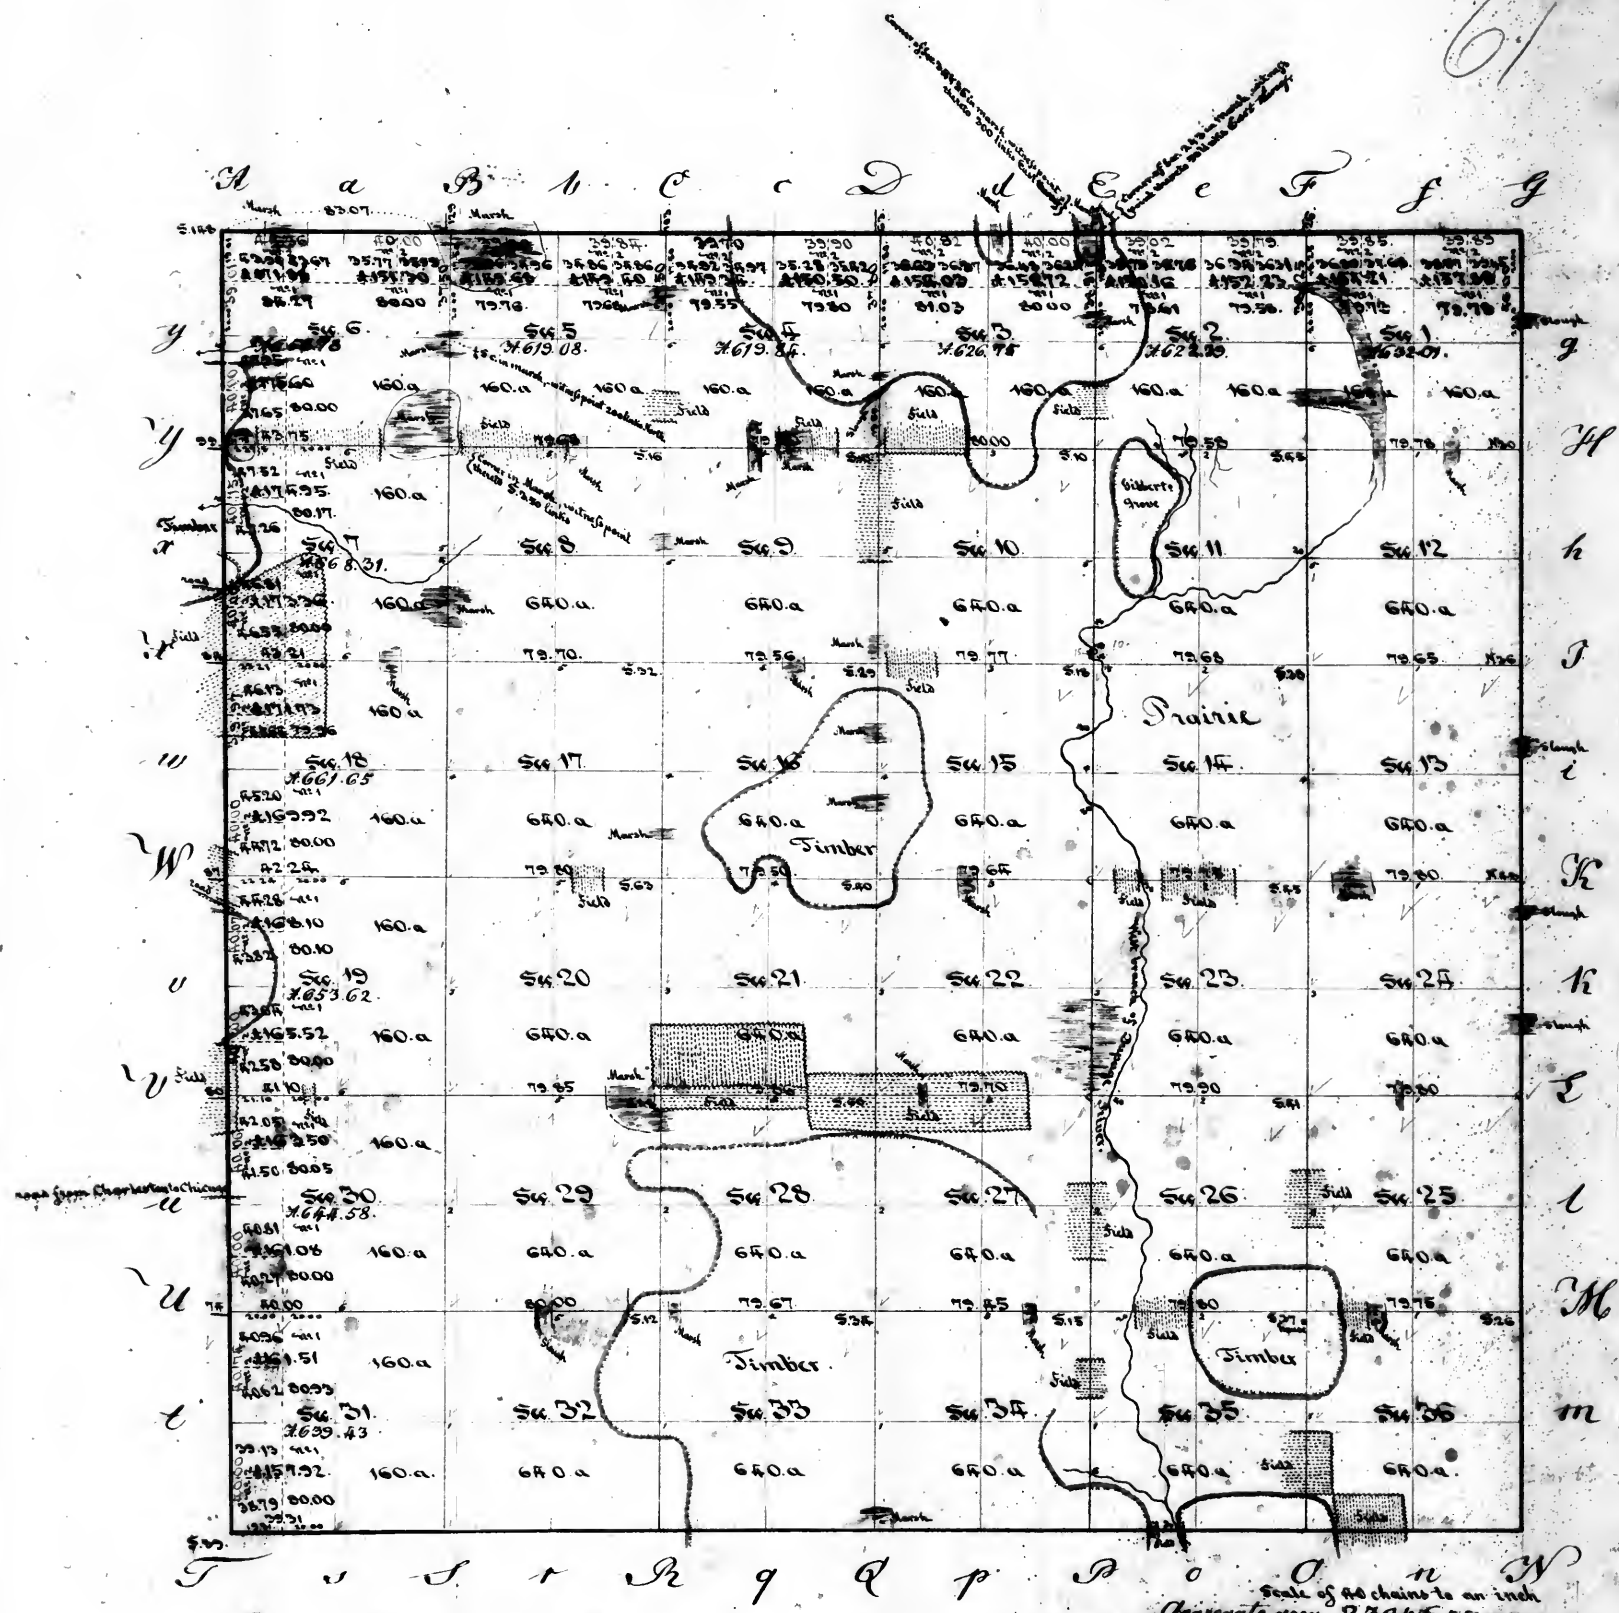


Variation.
West boundary - 5° 55' E
South - - - 5° 56' E
East - - - 5° 57' E
North - - - 5° 58' E
Subdiv. lines

Surveyors Office. Saint Louis 4th of January 1842.

The above plat of township 40 north of the base line, range 9 east of the 3^d principal meridian, is hereby confirmed to the field notes of the Survey thereof on file in this office, which have been examined and approved. The west boundary 6 miles was surveyed in the 4th quarter of 1839, by James Thompson and John P. Thompson, under their joint contract of the 21st of September of the same year: it was paid for in the 3^d quarter of 1840, and charged in the account current of the Surveyors General, during that quarter, Voucher N^o 17. The south boundary 5 miles 73.31 chains - the east boundary 6 miles - the north boundary 6 miles 3.07 chains - and the subdivision lines 52 miles 13.13 chains, were surveyed in the 2^d quarter of 1840, all by W. L. B. Enry, under contract of the 23rd of September 1839 - They were paid for in the 2^d & 4th quarters of 1841, and charged in the account current of the Surveyors General, during those quarters, under the general Surveying appropriation, Voucher N^o 24 19.

Jos. C. Brown
Surveyor of the public lands for
the district of Illinois & Missouri.

62 Township #1 North of the base line Range 9 East of the 3rd principal Meridian

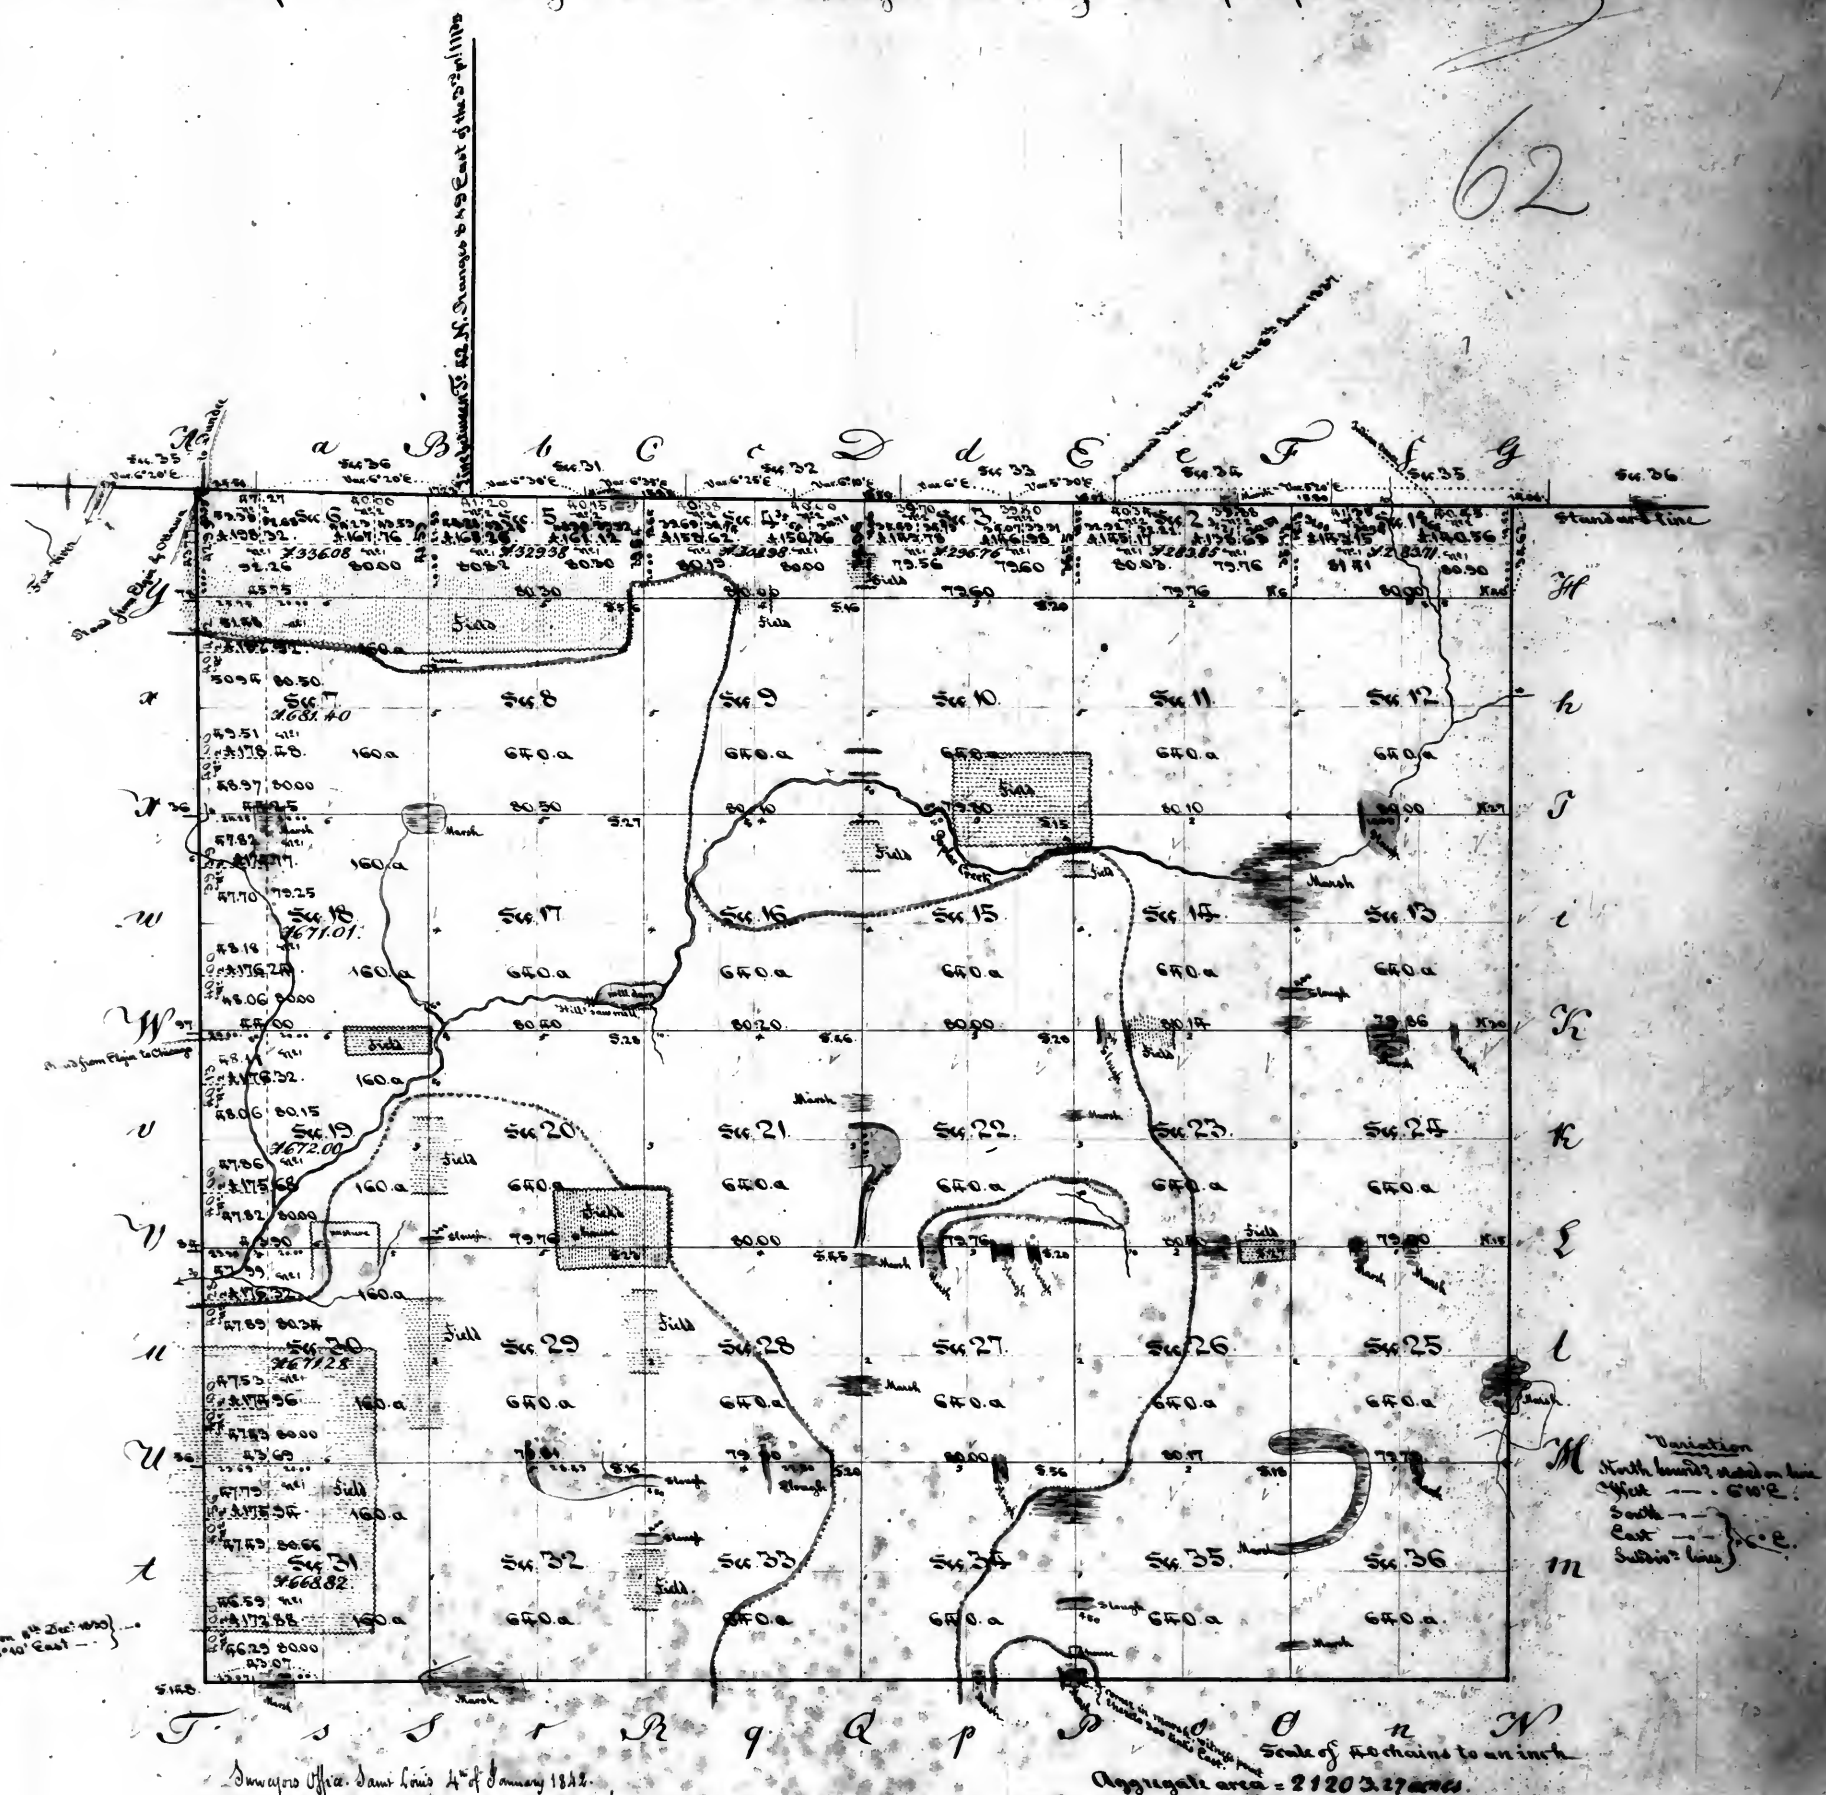

Surveyors Office, Saint Louis 4th of January 1842.



The above plat of township #1 north of the base line range 9 east of the 3rd principal meridian is strictly conformable to the field notes of the survey thereof on file in this office, which have been examined and approved. The north boundary was surveyed in the 2nd quarter of 1837, by James Thompson, under contract signed by the Surveyor General on the 21st of November and by W. Thompson, on the 15th of December 1838 - it was paid for in the 1st quarter of 1839, and charged in the account of the Surveyor General during that quarter, Voucher #6 - The west boundary 5 miles 42.71 chains, was surveyed in the 4th quarter of 1839, by James Thompson and John P. Thompson, under their joint contract of the 21st of September of that year - it was paid for in the 3rd quarter of 1840, and charged in the account current of the Surveyor General during that quarter, Voucher #17. The south boundary 6 miles 3.07 chains - and the east boundary 5 miles 34.62 chains, were surveyed in the 2nd quarter of 1840, by W. C. Ewing, under contract of the 23rd of September 1839 - they were paid for in the 2nd quarter and the 4th quarter of 1841, and charged in the account current of the Surveyor General during those quarters, Vouchers #2 & #12 - The subdivision lines, 37 miles 51.32 chains, were surveyed in the 2nd and 3rd quarters of 1840, by W. C. Ewing, under contract of the 23rd of September 1839 - 55 miles 21.36 chains, thereof, were paid for in the 2nd and the 4th quarters of 1841, and charged in the account current of the Surveyor General during those quarters, Vouchers #2 & #12 - and the rest 2 miles 30.37 chains, the lines between sections 14 & 2 - 24 & 25 - 34 & 35 - and 5 & 6, were paid for in the 4th quarter of 1841, and charged in the account current of the Surveyor General, during the said quarter, under the General Surveying appropriation, Voucher #15.

Jos. C. Brown,
Surveyor of the public lands for the
district of Missouri.

Township 42 North of the base line Range 9 East of 3^d principal Meridian

63

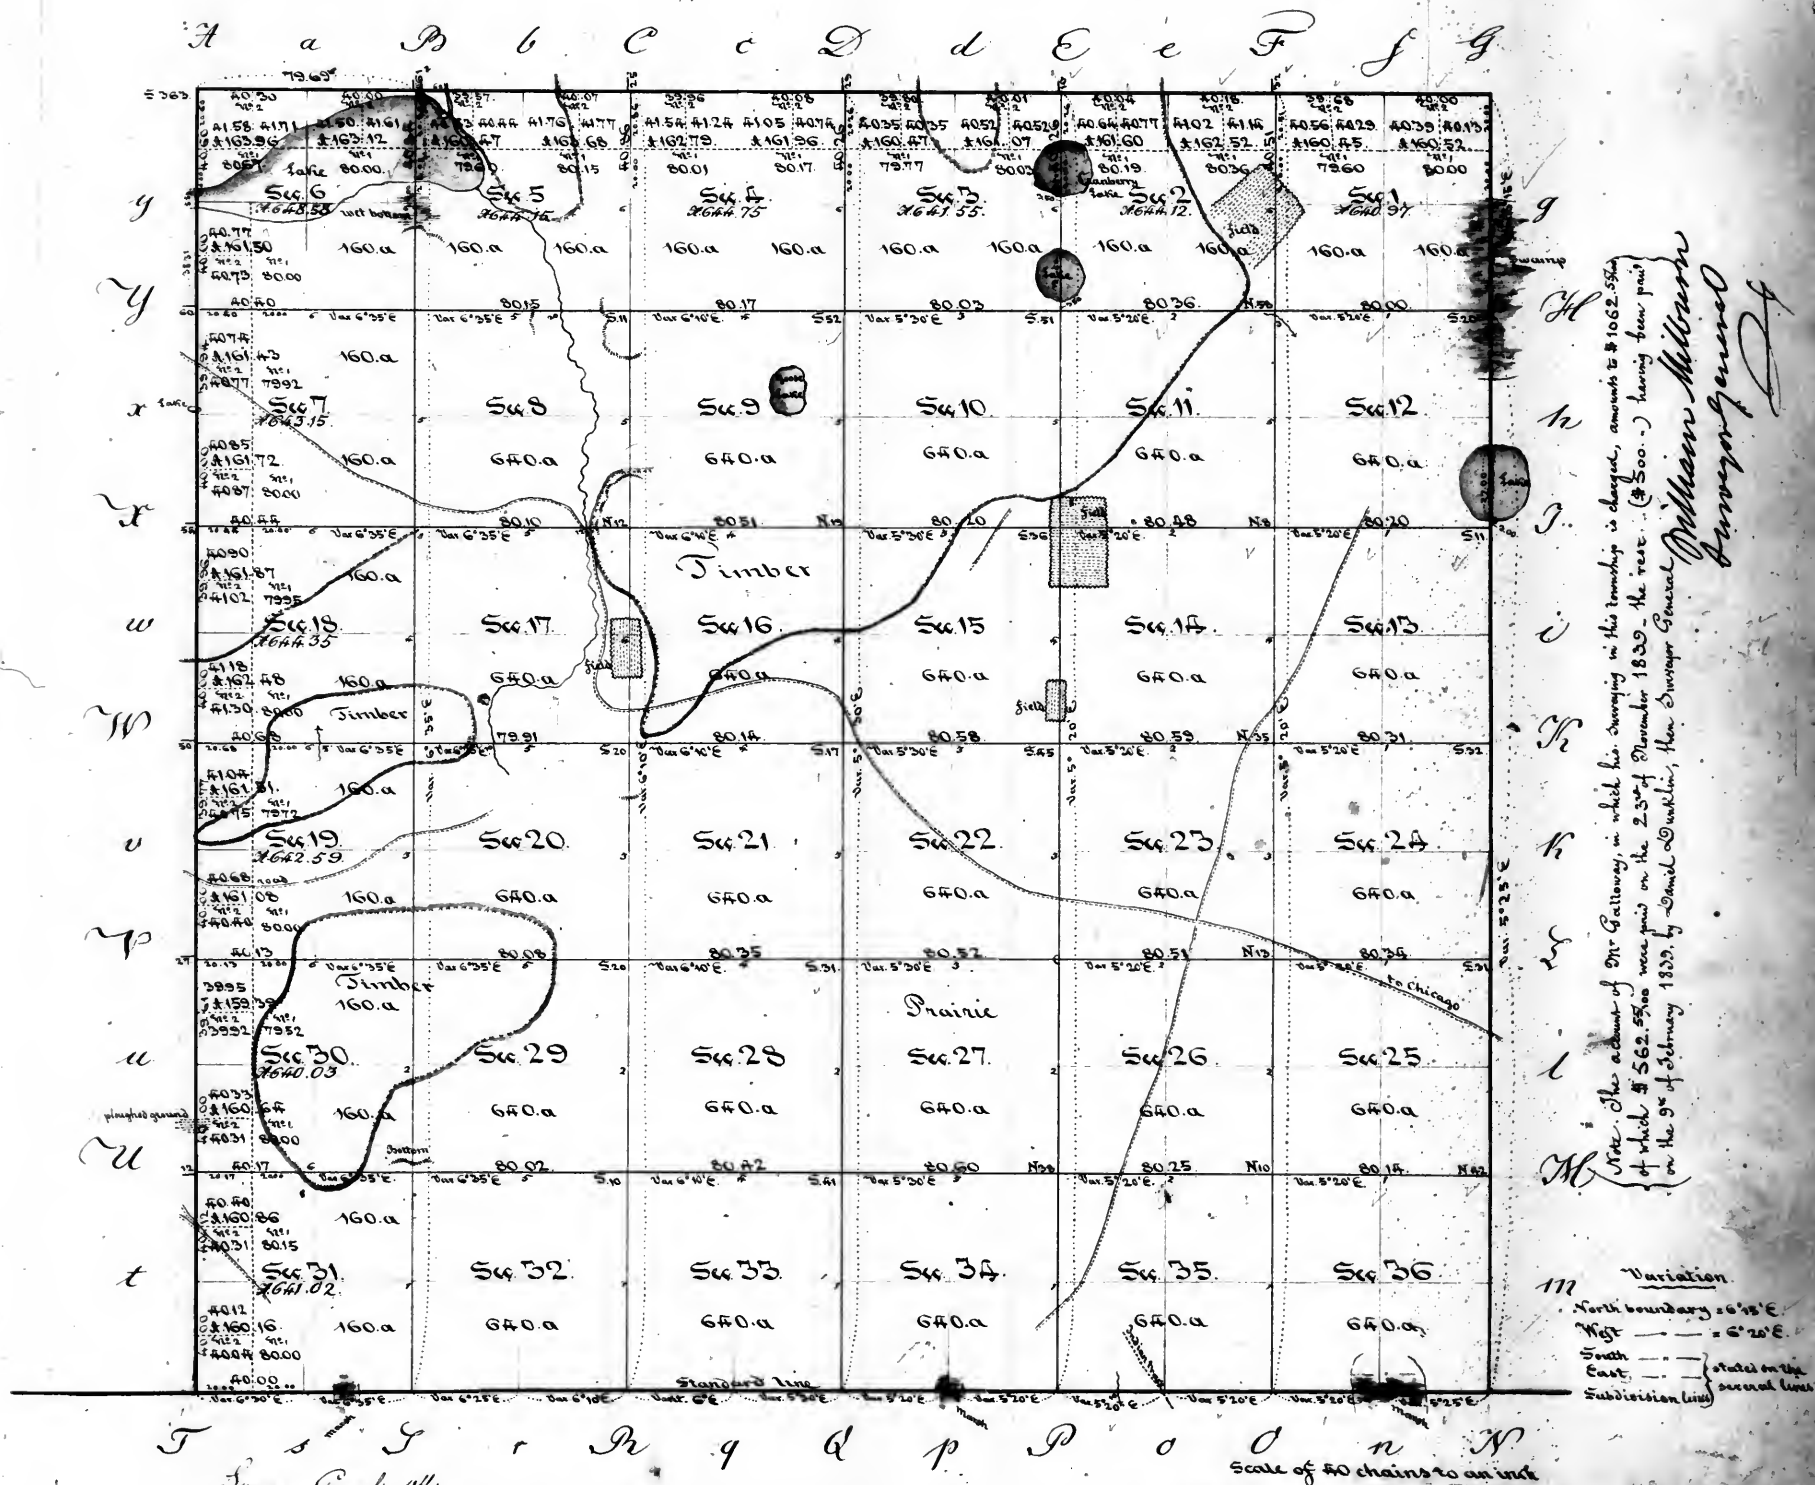

Note: The amount of Mr. Gallows, in which his surveying in this township is charged, amounts to \$1062.50, of which \$562.50 was paid on the 23rd of November 1839 - the rest (\$500.-) having been paid on the 9th of February 1839, by Daniel D. Perkins, then Surveyor General.

William Millburn
Surveyor General


Surveyor General's Office.
Saint Louis 17th of December 1839.

The above plat of township 42 north of the base line, range 9 east of the 3^d principal meridian, is strictly conformable to the field notes of the survey thereof on file in this office which have been examined and approved - The South boundary 6 miles, was surveyed in the 2^d quarter of 1837, by James Thompson, under contract signed by the Surveyor General on the 21st of November, and by said Thompson on the 15th day of December 1837; it was paid for in the 1st quarter of 1839, and charged in the account of the Surveyor General for that quarter, Voucher N^o 6 - The west boundary 6 miles - the east boundary 6 miles, and the North boundary 5 miles 79.63 chains, were surveyed in the 3^d quarter of 1837 - and the lines of subdivision 60 miles 11.51 chains, were surveyed in the 4th quarter of 1837 - all by James Gallows under contract signed by the Surveyor General on the 21st of November, and by said Gallows on the 15th of December 1837 - The surveys by Gallows, were to the extent noted in the margin, paid for in the present quarter, being the 4th quarter of 1839, and will be charged in the account of the Surveyor General for said 4th quarter of 1839, under the general appropriation for surveying the public lands, Voucher N^o 4.

William Millburn
Surveyor General

Township 43 North of the base line Range 9 East of the 3rd principal Meridian

64

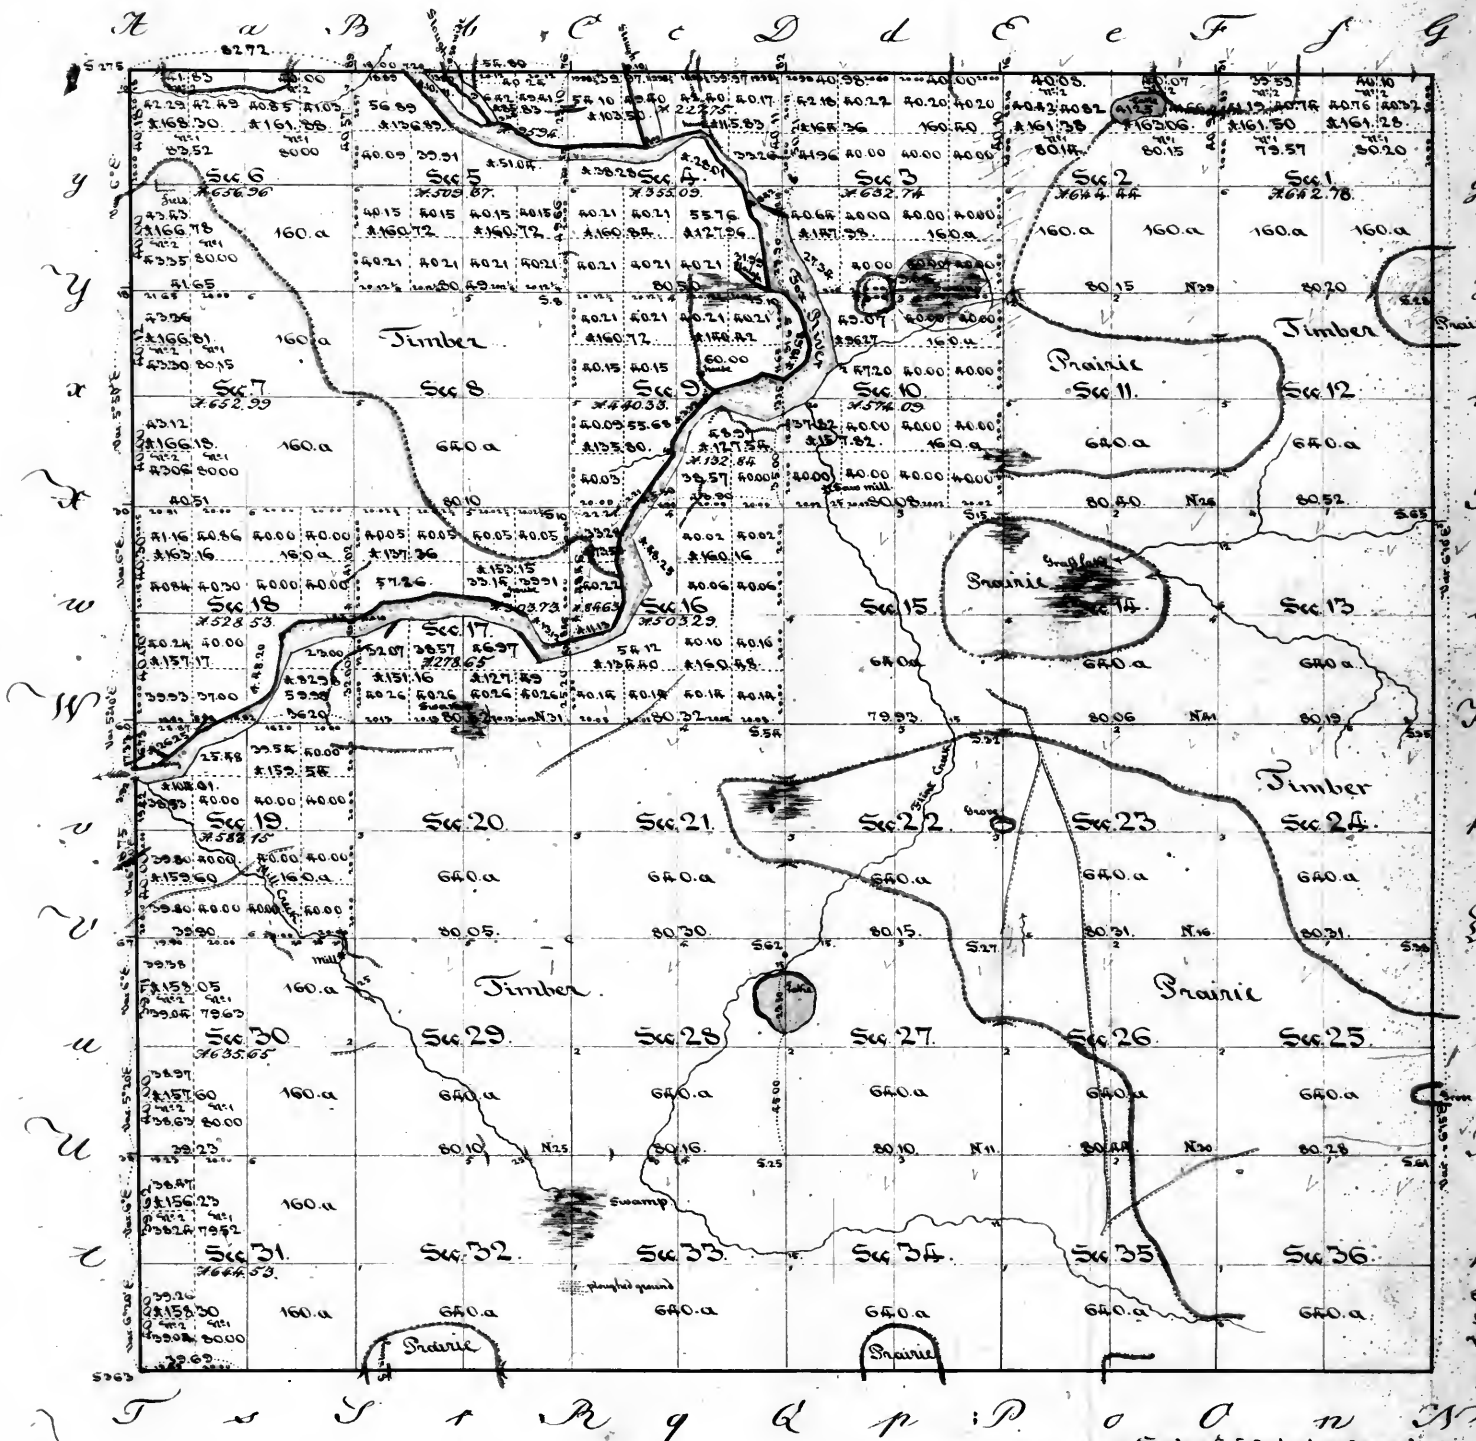

Note. The account of Mr. Galloway in which the surveying of the eastern line of this township is charged amounts to \$1062.50 for which \$562.50 was paid on the 23rd of November 1839. The sum of \$500 being then paid on the 3rd of February of same year by mail order, the balance of \$62.50 was paid by Mr. William Melburn.

177. Variation
 East bound? shall on line
 North bound? 6° 10' E
 West bound? shall on line
 South bound? 6° 15' E
 Subdivision line 6° 15' E

Surveyors Office.
 Saint Louis 18th of April 1840.


Scale of 40 chains to an inch
 Aggregate area of public land = 22656.25 acres
 Estimated area of river = 405.62 acres
 Total = 23101.91 acres.

The above plat of township 43 north of the base line, range 9 east of the 3rd principal meridian is strictly conformable to the field notes of the survey thereof on file in this Office which have been examined and approved. — The west boundary 6 miles — The south boundary 5 miles 79.69 chains — The east boundary 6 miles — and the north boundary 6 miles 2.72 chains, were all surveyed in the 3rd quarter of 1837, by James Galloway, under contract signed by the Surveyor General in the 21st of November, and by the said Galloway on the 15th of December 1836 — They were to the extent noted in the margin paid for in the 4th quarter of 1839, and charged in the account of the Surveyor General for that quarter, under the general appropriation for surveying the public lands — Voucher No. 4 — The subdivision lines 59 miles 68.72 chains, and the meanders of Fox river 14 miles 45.33 chains were surveyed in the 4th quarter of 1837 — 4th quarter of 1838, and 4th quarter of 1839, by said James Galloway, under the contract before mentioned — The subdivision lines and meanders were paid for in this 2nd quarter of 1840; and they will be charged in the account current of the Surveyor General for said quarter, under the General appropriation for surveying the public lands — Voucher No. 4.

William Melburn
 Surveyor of the public lands
 in the States of Illinois and Missouri.

Township 44 North of the base line Range 9 East of the 3^d principal Meridian

65

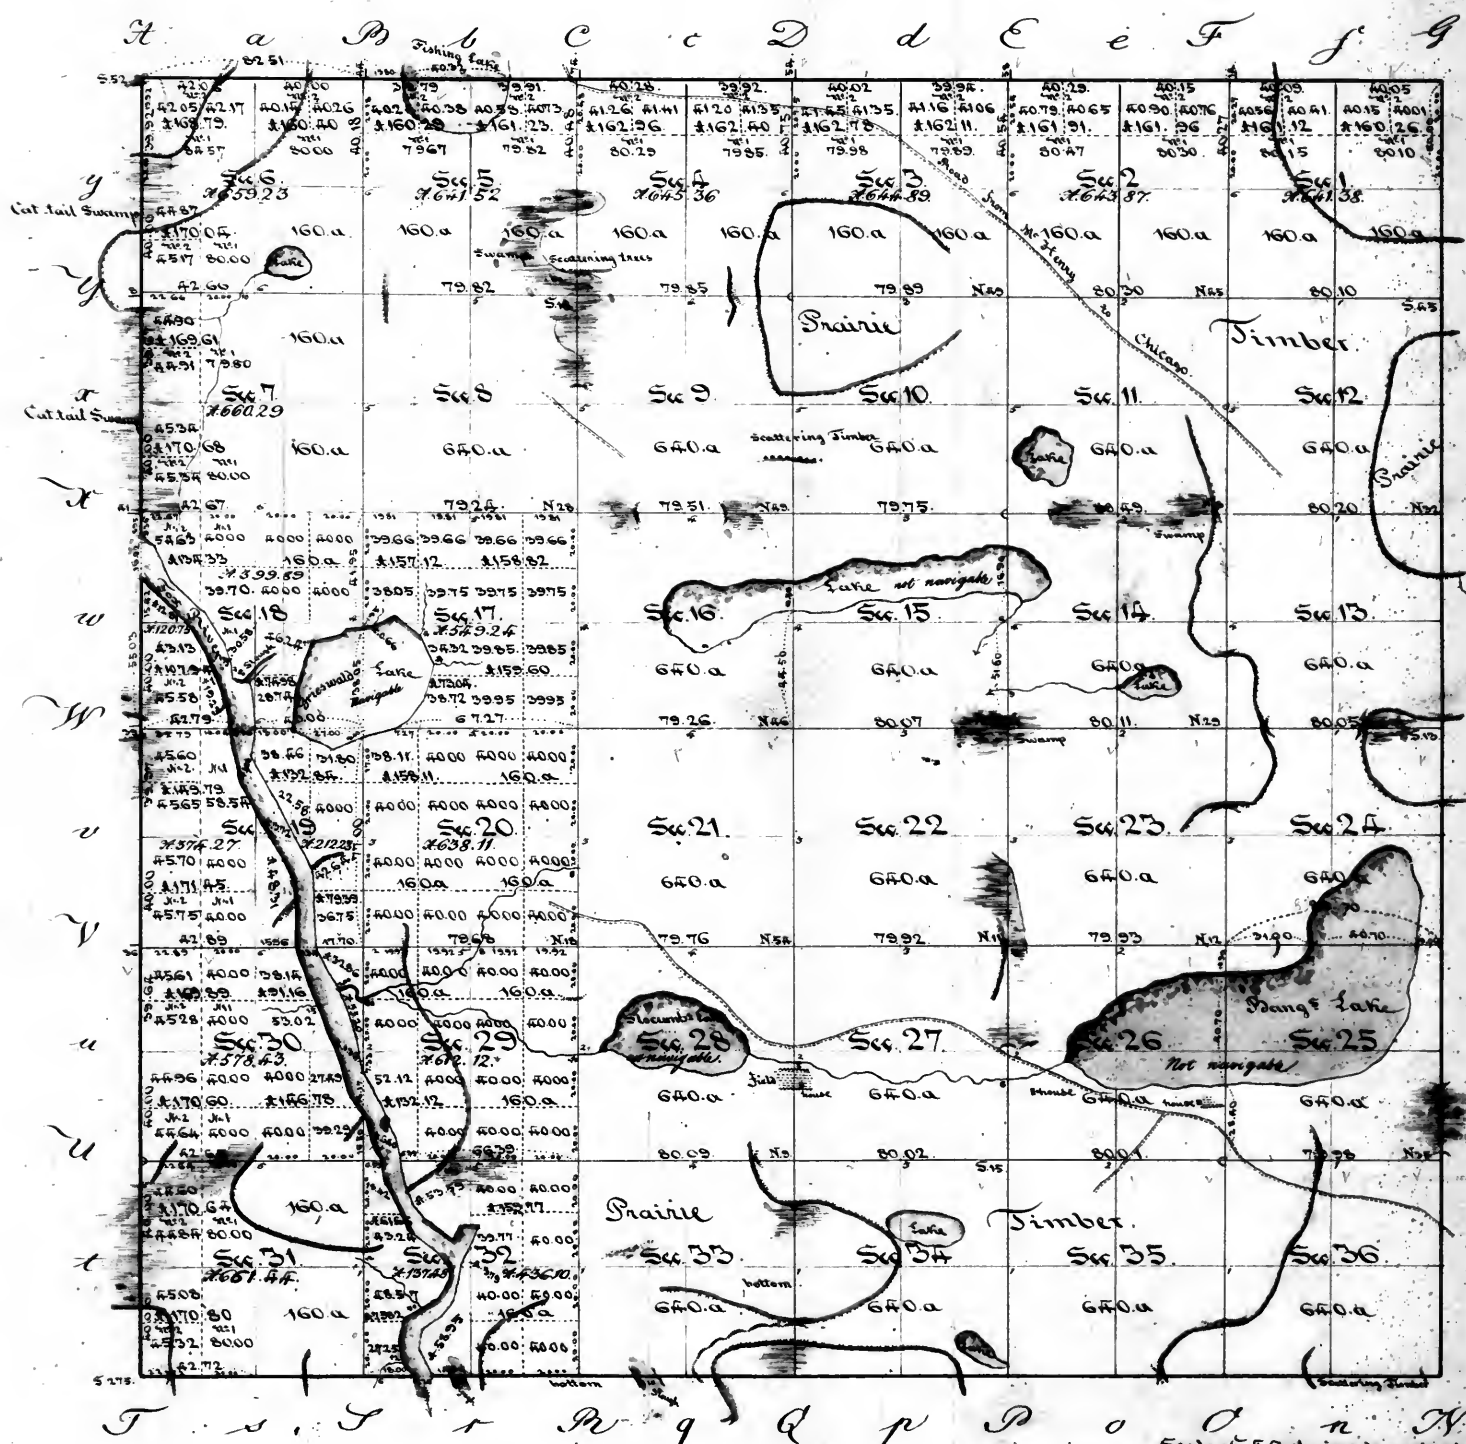

Mr. The account of Mr. Gallows in which the surveying of the entire line of this township is charged amounts to \$1062.55, of which \$562.55 was paid on the 25th of November 1839. - the rest (\$500.) having been paid on the 9th of February of same year by Daniel Davidson, late Surveyor General. William Milburn

Variation.
West boundary - 6' East
all the other lines - 6' 10' East.

Surveyors Office.
Saint Louis 18th of April 1840.

Scale of 40 chains to an inch.
Aggregate area of public land = 2273620 acres.
estimated area of Fox river & Missouri lake = 25536 acres.
Total = 23036.16 acres.

The above plat of township 44 north of the base line range 9 east of the 3^d principal meridian, is strictly conformable to the field notes of the survey thereof on file in this office which have been examined and approved. The west boundary 6 miles - the south boundary 6 miles 2.72 chains - the east boundary 6 miles - and the north boundary 6 miles 2.51 chains, were all surveyed in the 3^d quarter of 1837, by James Gallows under contract signed by the Surveyor General on the 21st November and by said Gallows on the 15th of December 1836. They were, to the extent noted in the margin paid for in the 4th quarter of 1839, and charged in the account current of the Surveyor General, for that quarter, under the general appropriation for surveying the public lands - Tranche N^o 4 - The subdivision lines 60 miles 27.50 chains and the meanders of Fox river 8 miles 72.50 chains were surveyed in the 4th quarter of 1837, 4th quarter of 1838, and 4th quarter of 1839. The subdivision lines and meanders were paid for in this 2nd quarter of 1840; and they will be charged for in the account current of the Surveyor General for said quarter, under the general appropriation for surveying the public lands, Voucher N^o 1.

William Milburn
Surveyor of the public lands
in the States of Illinois and Missouri.

Original.

52787

DIAGRAM
showing location of
WATT'S ISLAND


in
LAKE PISTAKEE,

Sec. 4, T. 45 N. R. 9 E. 34 P. M.,

ILLINOIS.

1890.

Scale: inch to 10 chains

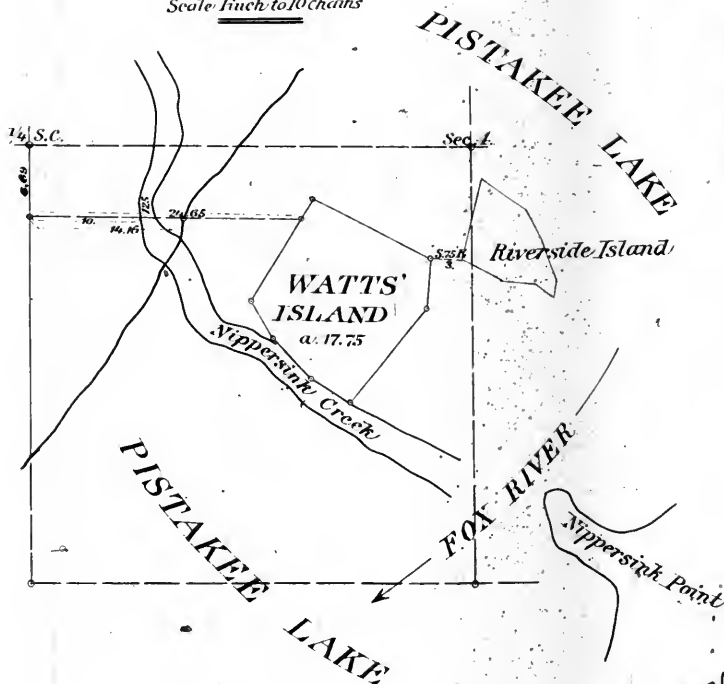

W.D. 1890
m.m.

Department of the Interior,
General Land Office,
Washington, Sept. 12, 1890.

The above diagram of Watt's Island, in Sec. 4, T. 45 N. R. 9 E. 34 P. M., in the State of Illinois, is a correct plat of the survey executed by Charles H. Dixon, U. S. Deputy Surveyor, in pursuance of instructions from the Commissioner of the General Land Office, bearing date May 15th 1890, and is strictly conformable to the field notes thereof, which have been examined and approved.


See Original Field notes 52787
with Lake Survey's Page 15. Same date.
See letter of Commissioner as filed with return Sept. 26, 1890
17.75 acres

James T. Groves
Commissioner of the General Land Office
For Genl. of Ill.

Original

DIAGRAM
OF
RIVERSIDE ISLAND
IN
Sec. 4. T 45 N. R 9 E. 3rd P.M.
ILLINOIS
Scale 1 inch to 10 Chains.


Report 52.109

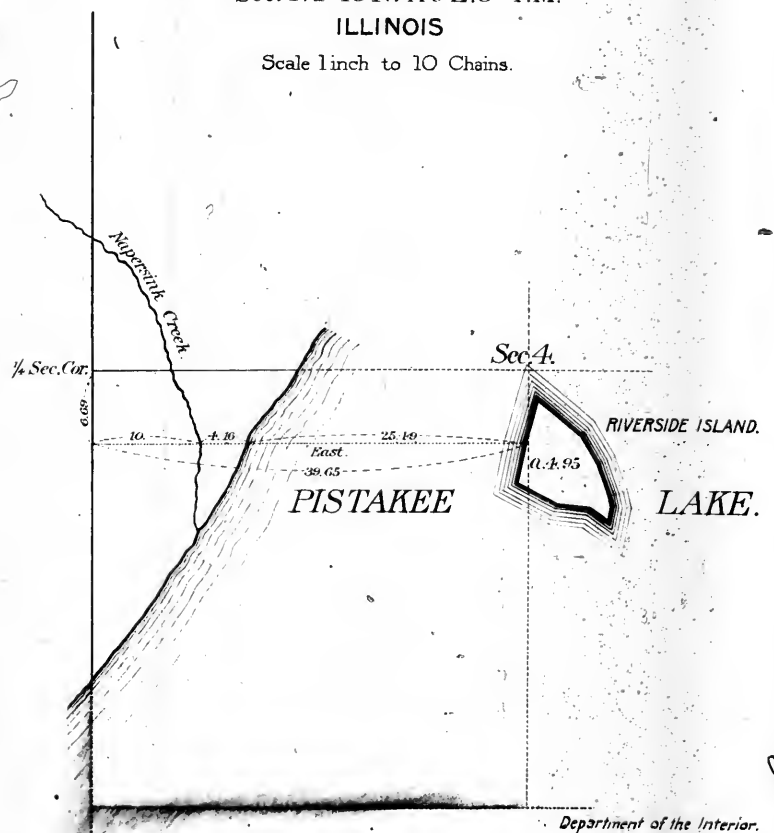

Department of the Interior,
General Land Office
Washington D.C. April 26, 1890
The above diagram of RIVERSIDE ISLAND in Sec. 4 T 45 N. R 9 E. 3rd P.M. in the State of Illinois is a correct plat of Survey executed by C.H. Tryon U.S. Deputy Surveyor in pursuance of instructions from the Commissioner of the General Land Office bearing date the 13th day of Nov. 1889 and is strictly conformable to the field notes thereof which have been examined and approved.

Charles H. Tryon
Commissioner & Ex Officio
Surveyor General of Illinois.

See Original Field Notes
which accompany this Plat
and marked Report 52.109
in Package of Lake Survey in Box No. 15-85
See Letter Commissioner filed up here April 26, 1890.

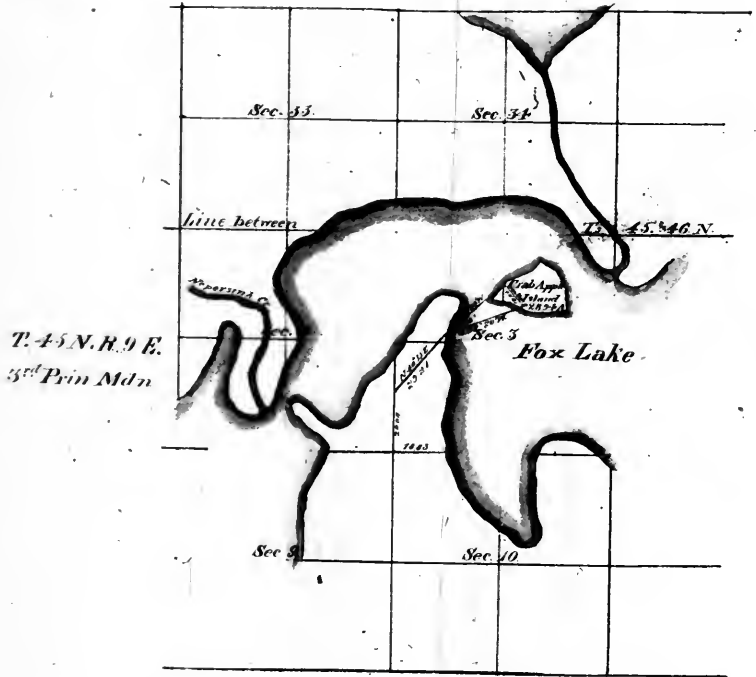


The above diagram of Crab Apple Island in Fox Lake Sec. 3. T 45 N. R 9 E. 3rd P.M. in the State of Illinois is strictly conformable to the field notes of the survey thereof which have been examined and approved.

General Land Office
February 18th 1876
John W. Nelson
Commissioner

Vol 28 P 66

DIAGRAM
of the SURVEY of FOX ISLAND
In Sec. 16, T. 45 N., R. 9 E. 3rd P.M. Mdn.
IN THE STATE OF ILLINOIS.

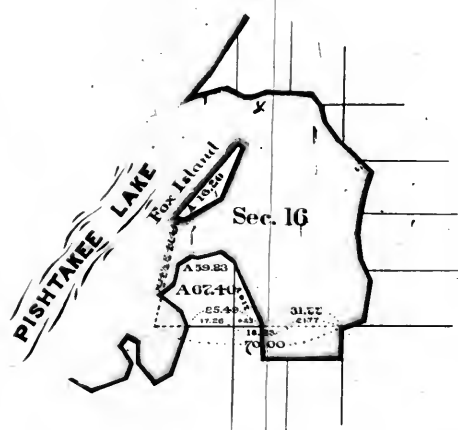


Department of the Interior,
General Land Office,
Washington, D. C., May 6th 1875.
The above Diagram of FOX ISLAND, in Section 16, Township 45 North, Range 9 East of the 3rd P.M. Mdn in the State of Illinois, is a correct Plat of survey executed by George Wago, Deputy Surveyor, in pursuance of a contract entered into with the Commissioner of the General Land Office bearing date the 12th day of October 1874, and is strictly conformable to the field notes of the survey thereof which have been examined and approved.

John W. Nelson
Commissioner and Ex Officio
Surveyor General of the
State of Illinois.

66c

Original

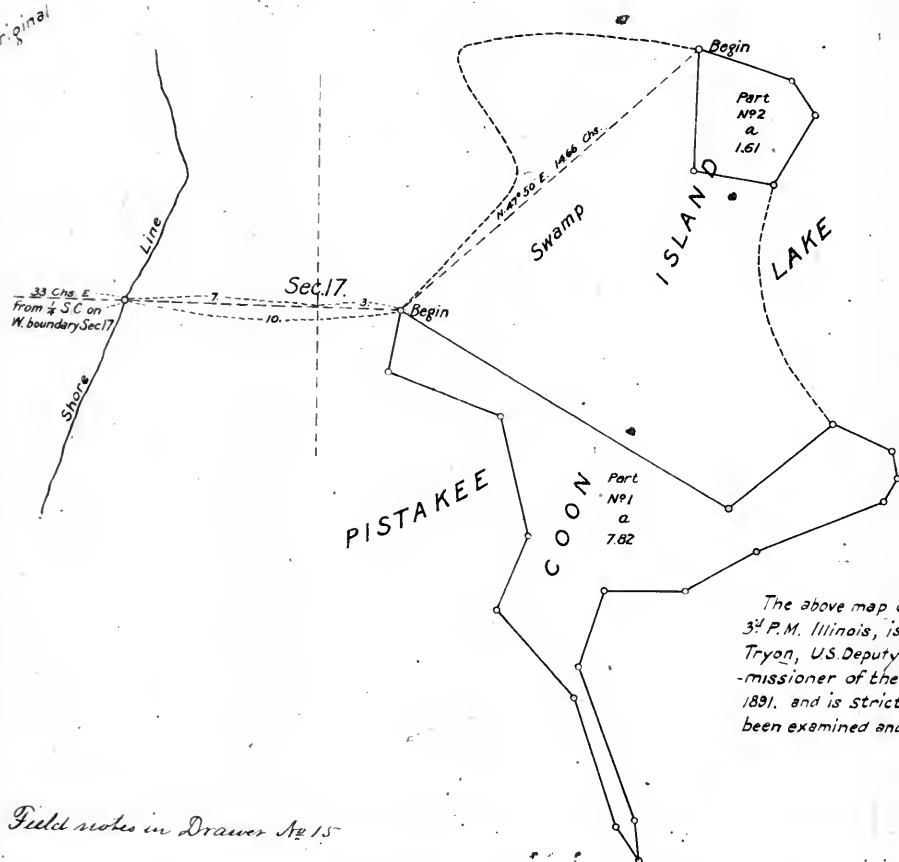

MAP
of
COON ISLAND
IN
PISTAKEE LAKE.
Sec. 17, T. 45 N., R. 9 E. 3^d P.M.
ILLINOIS.
1891
Scale, 1 Inch to 4 Chains.

Department of the Interior
General Land Office
Washington D.C. Oct. 31, 1891

The above map of Coon Island, in Lake Pistakee Sec. 17, T. 45 N., R. 9 E. 3^d P.M. Illinois, is a correct plat of survey executed by Charles H. Tryon, U.S. Deputy Surveyor, in pursuance of instructions from the Commissioner of the General Land Office bearing date the 18th day of May 1891, and is strictly conformable to the field notes hereof which have been examined and approved.

Wm. Stone
Acting Commissioner and Ex officio
Surveyor General for Illinois

Field notes in Drawer No 15

DIAGRAM
OF
NETT'S ISLAND

ILLINOIS
1890

DIAGRAM
OF
NETT'S ISLAND
IN
Sec. 4. T 45 N. R 9 E 3rd P.M.
ILLINOIS
1890
Scale 1 inch to 40 Chains.

Architect 53478
Date February 16 1891

Sec. 5

Original meander line survey of 1839.

South 28° 50'

East 10° 75'

Original meander line during high water

Watts' I.

Creek

Shore line

Milne or Riverside I.

PISTAKEE LAKE

Nett's I.

2371

Present FOX

Nippersink Pt.

Shore line

East

(approximate)

The above diagram of an Island in PISTAKEE LAKE, Sec. 4. T. 45 N. R. 9 E.,
3^d P.M. Illinois is a correct plat of survey executed by Charles H. Tryon U.S. Deputy
Surveyor, pursuant to instructions from this office dated September 16, 1890,
and is strictly conformable to the field notes thereof which have been examin-
ed and approved.


Leam V. Gnaiff
Commissioner & Ex Officio
Surveyor General for Illinois.

See 1. 1st notes filled with late surveys.

See letter from Genl Land Office dated Feby. 20, 1891
Filed in its stems.

Township 45 North Range 9 East of the 3^d principal Meridian

66

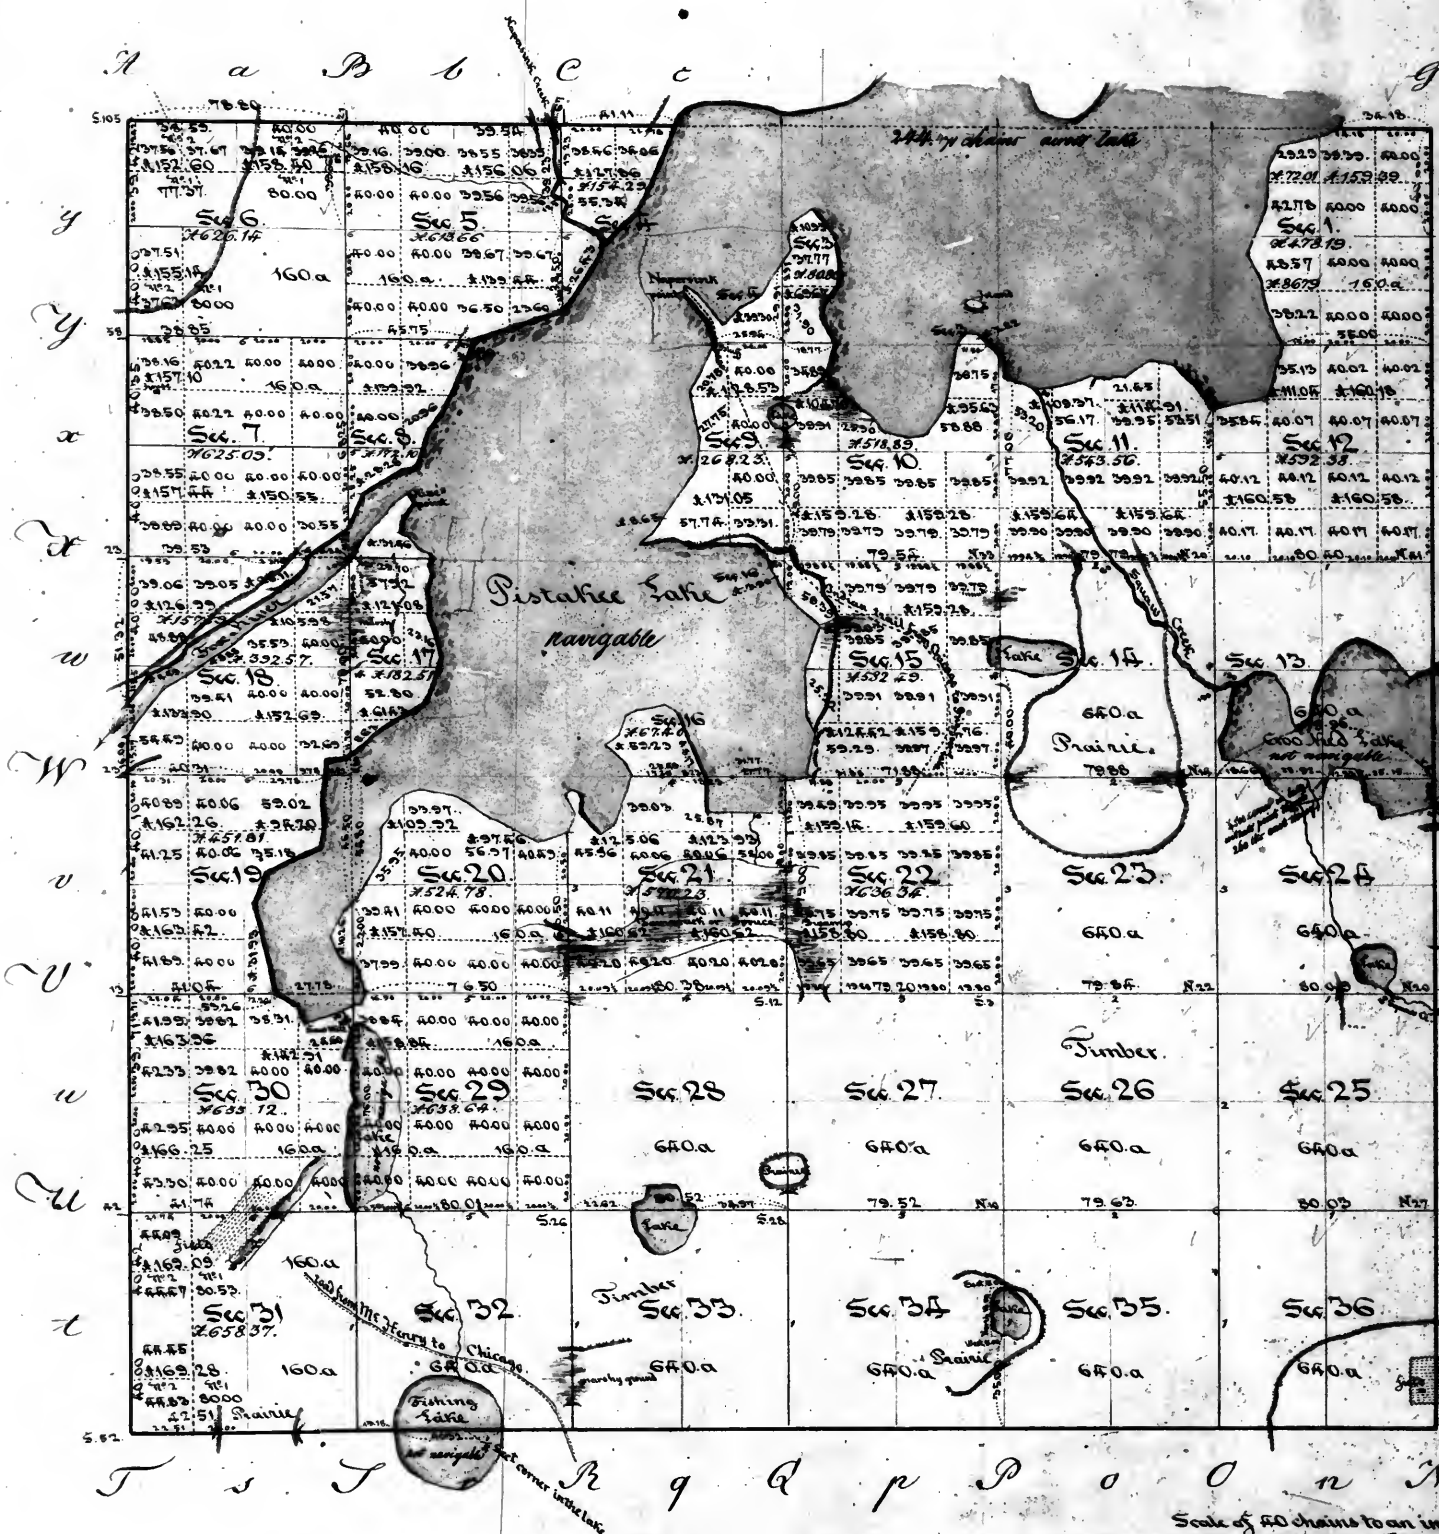


Variation
West boundary - 6° East
all the other lines - 6° 40' East

Surveyors Office
Saint Louis 18th April 1840.

Scale of 40 chains to an inch
Aggregate area of public land = 18567.32 acres
estimated area of Fox river & lake Pistakee = 4653.03 acres
Total = 23220.35 acres


The above plat of township 45 north of the base line range 9 east of the 3^d principal meridian is strictly conformable to the field notes of the Survey thereof on file in this Office which have been examined and approved. The West boundary 6 miles - The South boundary 6 miles 2.51 chains were surveyed in the 3^d quarter of 1837 - The East boundary 6 miles, was surveyed in the 3^d quarter of 1838 and the north boundary 5 miles 78.60 chains was surveyed in the 4th quarter of 1838 - by James Gallows, under contract signed by the Surveyor General on the 21st November, and by Gallows on the 15th of December 1836 - They were, to the extent noted in the margin, paid for in the 4th quarter of 1839, and charged in the account current of the Surveyor General, under the general appropriation for surveying the public lands, for said quarter - Voucher No. 4 - The subdivision lines 46 miles 6.02 chains - and the meanders of Pistakee lake and of Fox river, 22 miles 51.01 chains were surveyed in the 4th quarter of 1838, and 4th quarter of 1839, by the said James Gallows under the contract before mentioned - The subdivision lines and meanders were paid for in this 2^d quarter of 1840, and they will be charged in the account current of the Surveyor General for said quarter, under the general appropriation for surveying the public land - Voucher No. 5.

William Melburn
Surveyor of the public lands in
the States of Illinois and Missouri.

Original

DIAGRAM OF FORMER BED OF PISHTAKEE LAKE IN

TOWNSHIP N: 46 North of the Base Line RANGE N: 9 EAST OF THE 3rd PRINCIPAL MERIDIAN ILLINOIS.

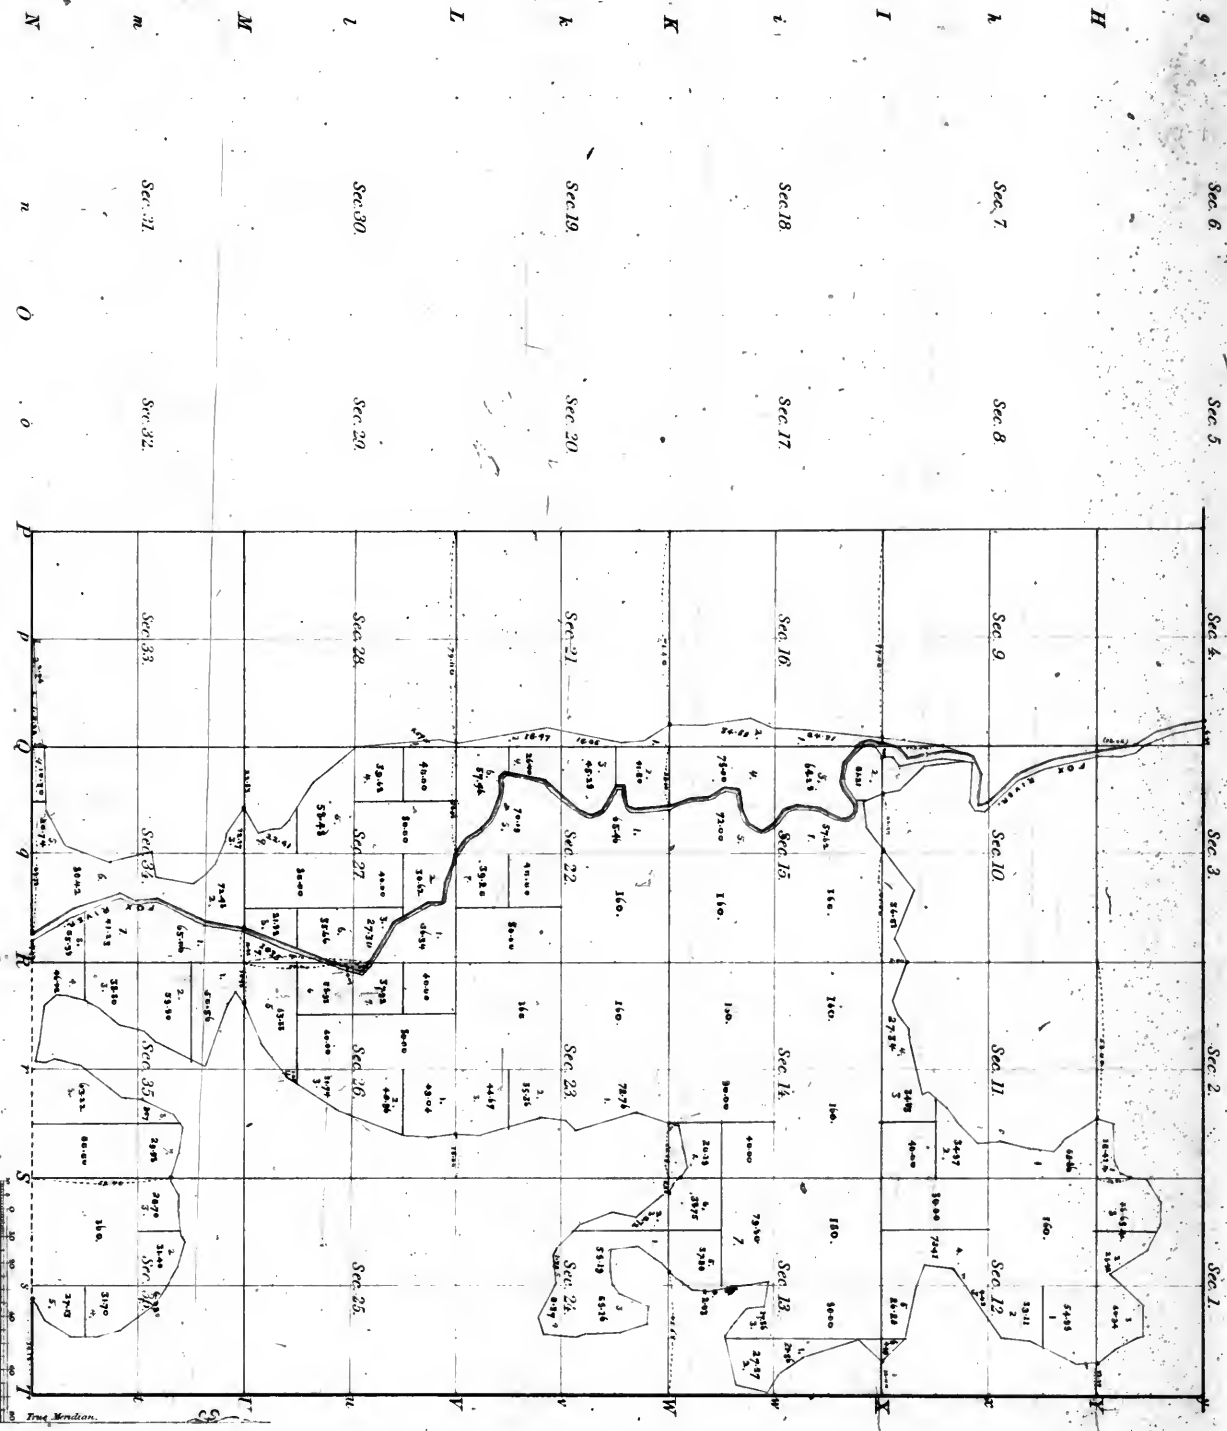






Township 46 North of the base line Range 9 East of the 3^d principal Meridian

67

T. 1 N. (with Wisconsin survey) R. 13 E. of the 4th pr. Mer.

T. 1 N. (of the Wisconsin survey) R. 20 E. of the 4th pr. Mer.

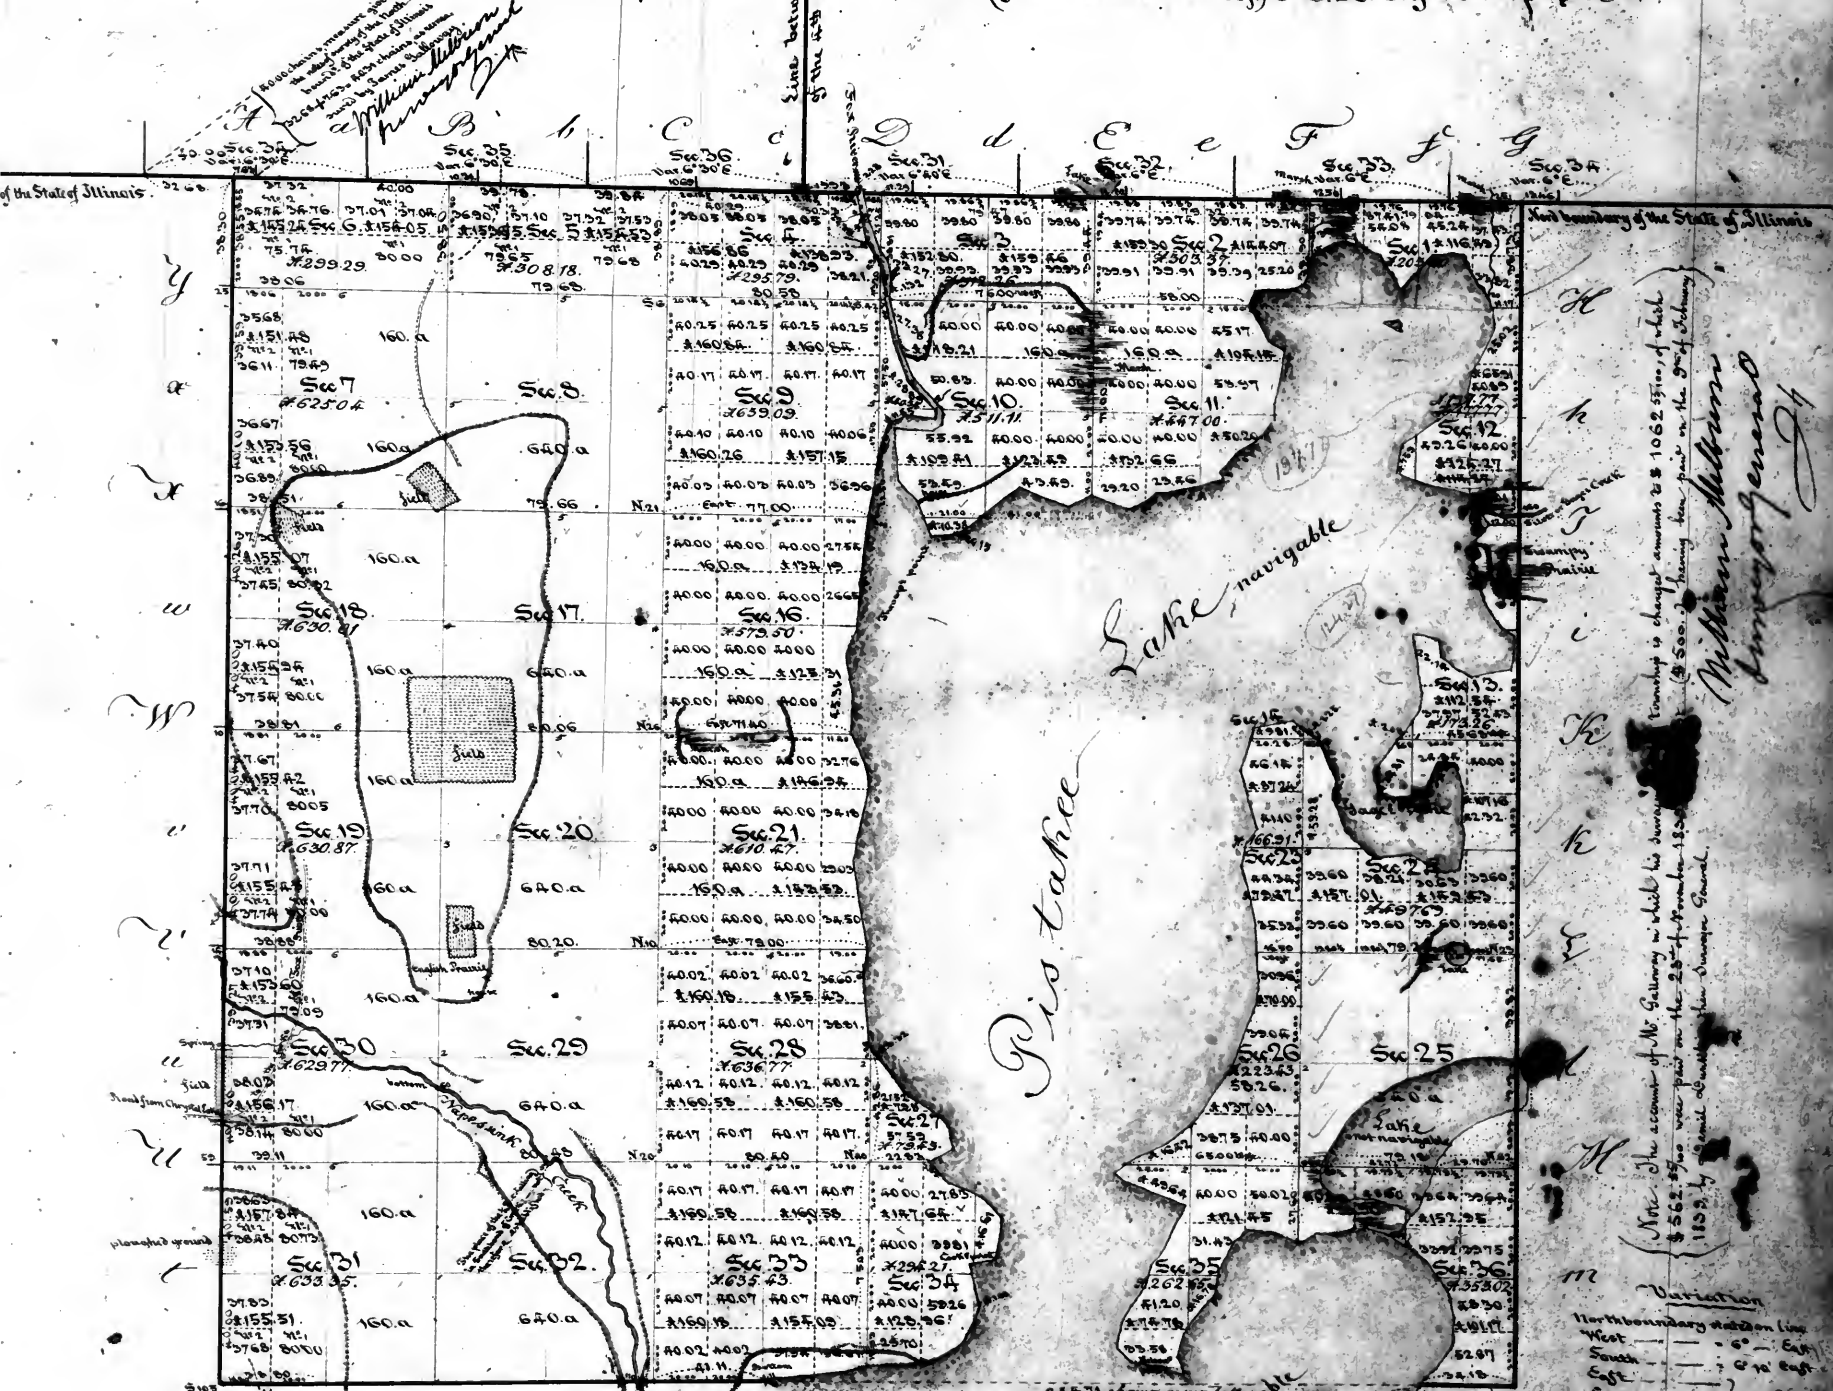

William Milburn
Surveyor General

Note: The account of Mr. Galloway in which his survey of the township is charged amounts to \$1062.50, of which \$562.50 was paid on the 28th of November 1836, and \$500.00 being then paid on the 9th of February 1837, by depositing the same in the Surveyor General's Office.

Variation
North boundary station line
West — — — 6° East
South — — — 6° East
East — — — 6° East
Subdivision line — 6° East

Surveyor General's Office.
Saint Louis 17th of December 1839.

The above plat of township 46 north of the base line range 9 east of the 3^d principal meridian is exactly conformable to the field notes of the survey thereof on file in this office, which have been examined and approved. The North boundary was surveyed in 1832 & 1833, by Julius Lyon, Commissioner on the part of the United States, as certified to this office, by Mr. J. Williams, Surveyor General of Ohio, Indiana & Michigan: the said line being a part of the boundary between Illinois & Michigan, now Wisconsin. In the 3^d quarter of 1837, James Galloway, (under the contract before designated) remeasured in part said north boundary, as represented on this plat. The west boundary 5 miles 38.30 chains, was surveyed in the 3^d quarter of 1837. The south boundary (including the line crossing Pistakee lake 5 miles 4.71 chains) 5 miles 78.80 chains — the East boundary 5 miles 38.73 chains — the subdivision lines 38 miles 76.21 chains — and the meanders of both banks of Fox river, and of Pistakee lake, together 25 miles 29.56 chains, were surveyed in the 4th quarter of 1838, by James Galloway, under a contract signed by the Surveyor General on the 31st of November, and by said Galloway on the 15th of December 1836. The surveys by J. Galloway were, to the extent noted in the margin, paid for in the present quarter, being the 4th quarter of 1839, and will be charged in the account current of the Surveyor General for said 4th quarter of 1839, under the general appropriation for surveying the public land, Voucher No. 4.


Aggregate area of public land — 1503083 acres
estimated area of the Fox River & Pistakee Lake — 583411
Total 2086494 acres

William Milburn
Surveyor General

VOL. 29

Vol 29
No back

Township 27 North of the base line Range 10 East of 3rd principal Meridian

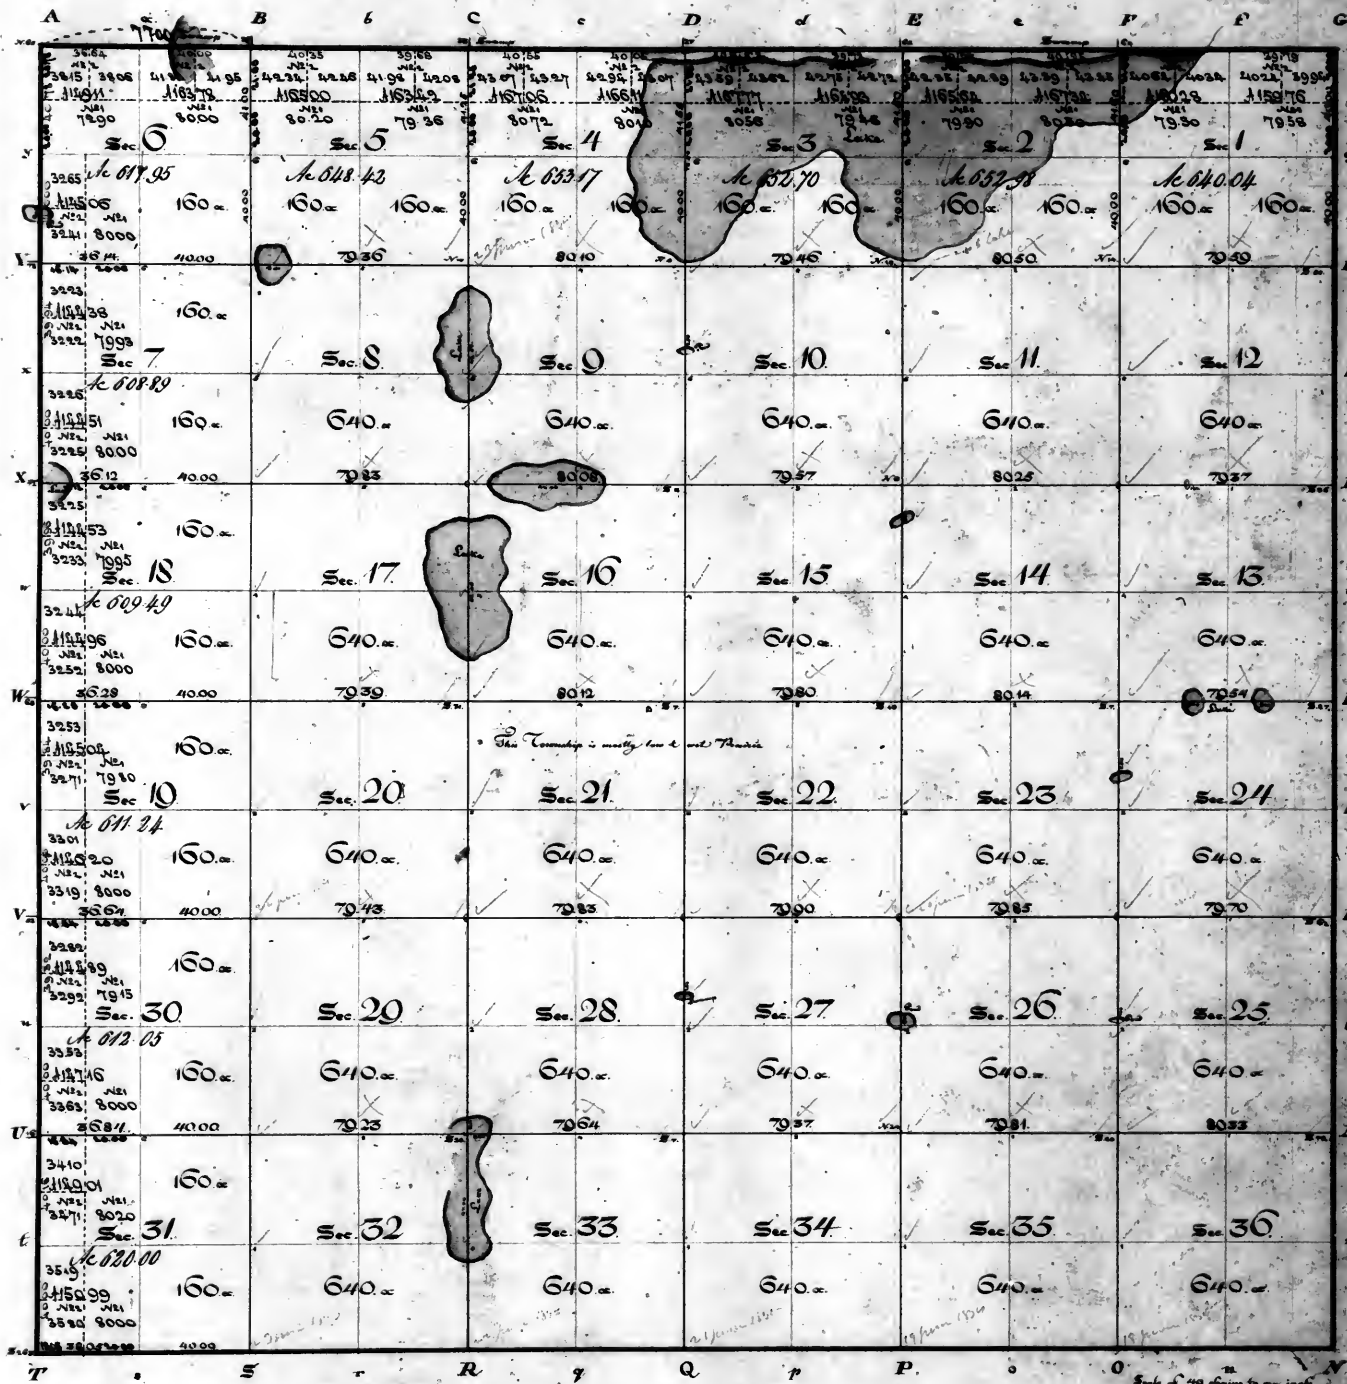

Aggregate Area - 22926.93 acres

(Note: The account of this survey in this township is charged amounts to \$2427.15, of which \$603.14 was paid on the 22nd of February 1840 - the rest (\$1823.01) having been paid by Mr. Stephen, former Surveyor General.

William Melbourne

Surveyors Office
St. Louis 2nd March 1840


The above plat of Township 27 North of the base line Range 10 East of 3rd principal Meridian is specially conformable to the field notes of the survey thereof on file in this Office, which have been examined and approved. The east boundary lines 11-15 chains were surveyed by W. S. Hamilton & Elias Packer, Junior, under contract of 15th of March 1834. The West boundary lines; the north boundary lines and 7 chains - and the East boundary lines, were surveyed in the 4th quarter of 1833 - and the subdivision lines 59 miles. 63.11 chains, were surveyed in the 2nd quarter of 1834 - all by William Lee D. Ewing, under contract of the 15th day of August 1833. The surveys by Ewing, were, to the extent noted in the margin, paid for on the 22nd of February 1840; and they will be charged in the account current of the Surveyor General for the present quarter, (being the first quarter of 1840) under the general appropriation for surveying the public lands, Chapter 17.

William Melbourne
Surveyor of the public lands in
the State of Missouri & Minnesota

Township 28 North of the base line Range 10 East of 3rd principal Meridian

3✓

2

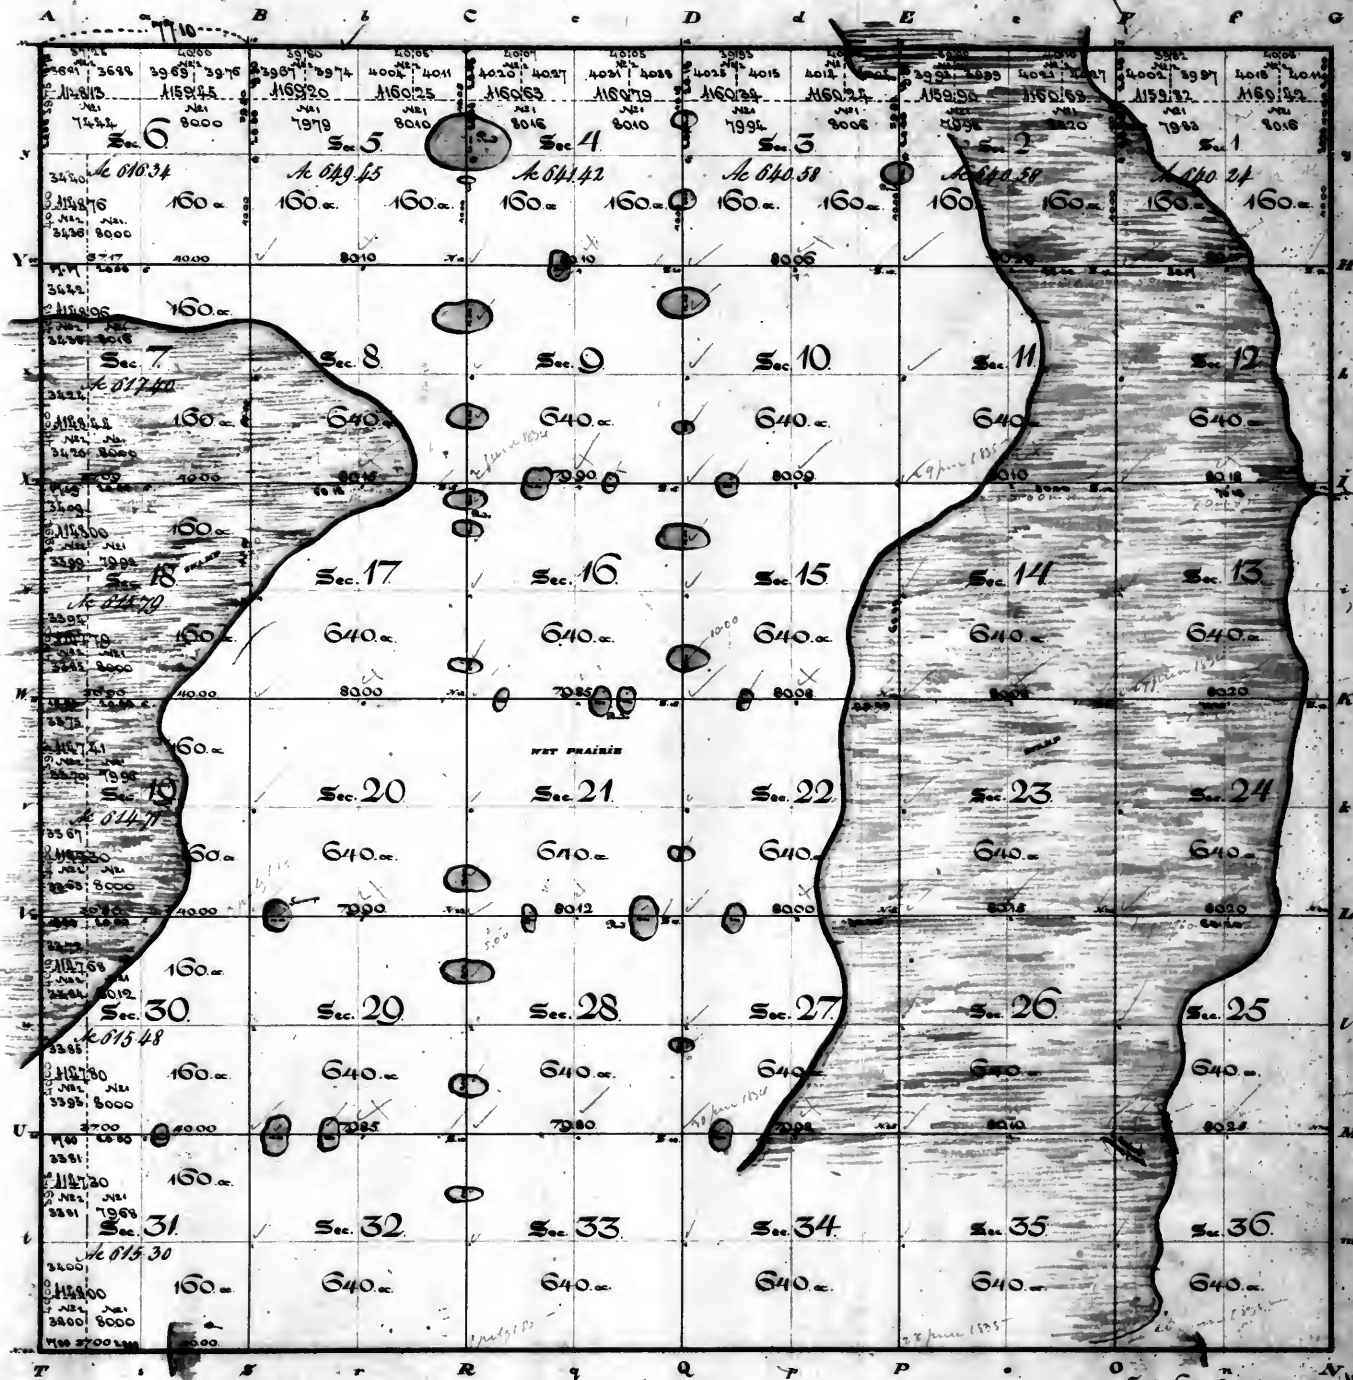

(Note: The account of Mr. Erving in which this surveying is the township is charged amounts to \$2,447.15, of which \$602.34 was paid on the 22nd of February 1840 - the rest (\$1,844.81) having been paid by C. J. Erving from Surveyor General.

William Melburn


Aggregate Area - 22907.29 acres.

Surveyor's Office
St. Louis, 20th March 1840.

The above Plat of Township 28 North of the base line Range 10 East of 3rd principal Meridian is hereby confirmed to the field notes of the survey thereof on file in this Office, which have been examined and approved. The West boundary 6 miles; the South boundary 5 miles 8.77 chains; the East boundary 6 miles, more survey in the 4th quarter of 1833; the North boundary 5 miles 77.10 chains was surveyed in the 2nd quarter of 1834 - and the Section lines 59 miles 66.78 chains, more survey in the 2nd & 3rd quarters of 1834, all by William Lee D. Erving, under contract of the 15th day of August 1833; They were paid for, to the extent noted in the margin, on the 22nd day of February 1840; and they will be charged in the account current of the Surveyor General for the present quarter (being the 1st quarter of 1840) under the general appropriation for surveying the public lands, Chapter 22.

William Melburn
Surveyor of the public lands in
the State of Missouri & Minnesota.

Township 29 North of the base line Range 10 East of 3^d principal Meridian

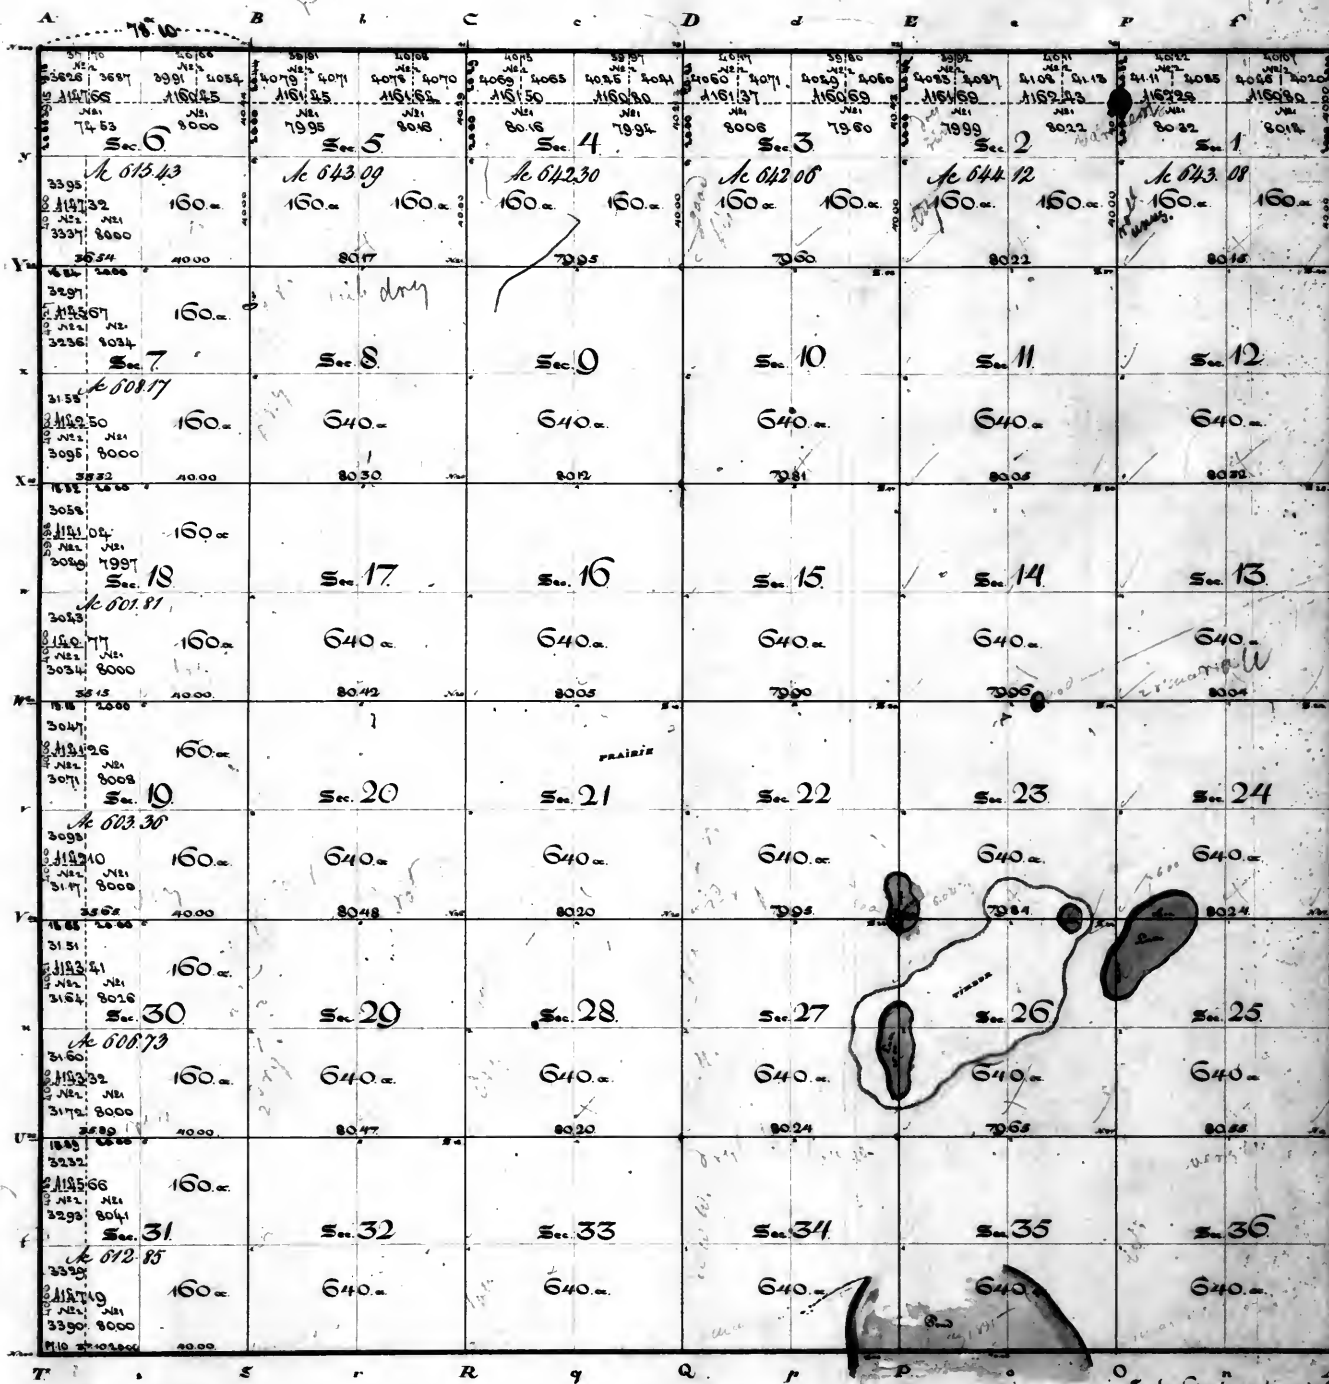

(Note: The account of Mr. Ewing in which this surveying is charged amounts to \$2,422.12, less of which \$602.75/100 was paid on the 22nd of February 1840. The rest (\$1,819.37) being here paid by C. S. Langham, former Surveyor General.

William Melburn

Surveyors Office
St. Louis 20 March 1840.

This plan of Township 29 North of the base line Range 10 East of 3^d principal Meridian, conformable to the field notes of the survey, thereon in file in this Office, which have been examined and approved. The west boundary 6 miles, the North boundary 5 miles 77.10 chains, the east boundary 6 miles, the South boundary 5 miles 77.10 chains, and the subdivision lines 63 miles 63.32 chains, were all surveyed in the 3^d quarter of 1834, by William Lee D. Ewing, under contract of the 15th day of August 1833. They were, to the extent noted in the margin, paid for on the 22nd day of February 1840, and they will be charged in the account current of the Surveyor General for the present quarter (being the 1st quarter of 1840) under the general appropriation for surveying the public lands. Voucher 22.

William Melburn
Surveyor of the public lands
in the State of Illinois & Missouri.


4025
5824
9649

Township 30 North of the base line Range 10 East of 3rd principal Meridian

T. 30 N. R. 10 E. of the 3rd p. M.

T. 30 N. R. 10 E. of the 3rd p. M.

T. 30 N. R. 10 E. of the 3rd p. M.

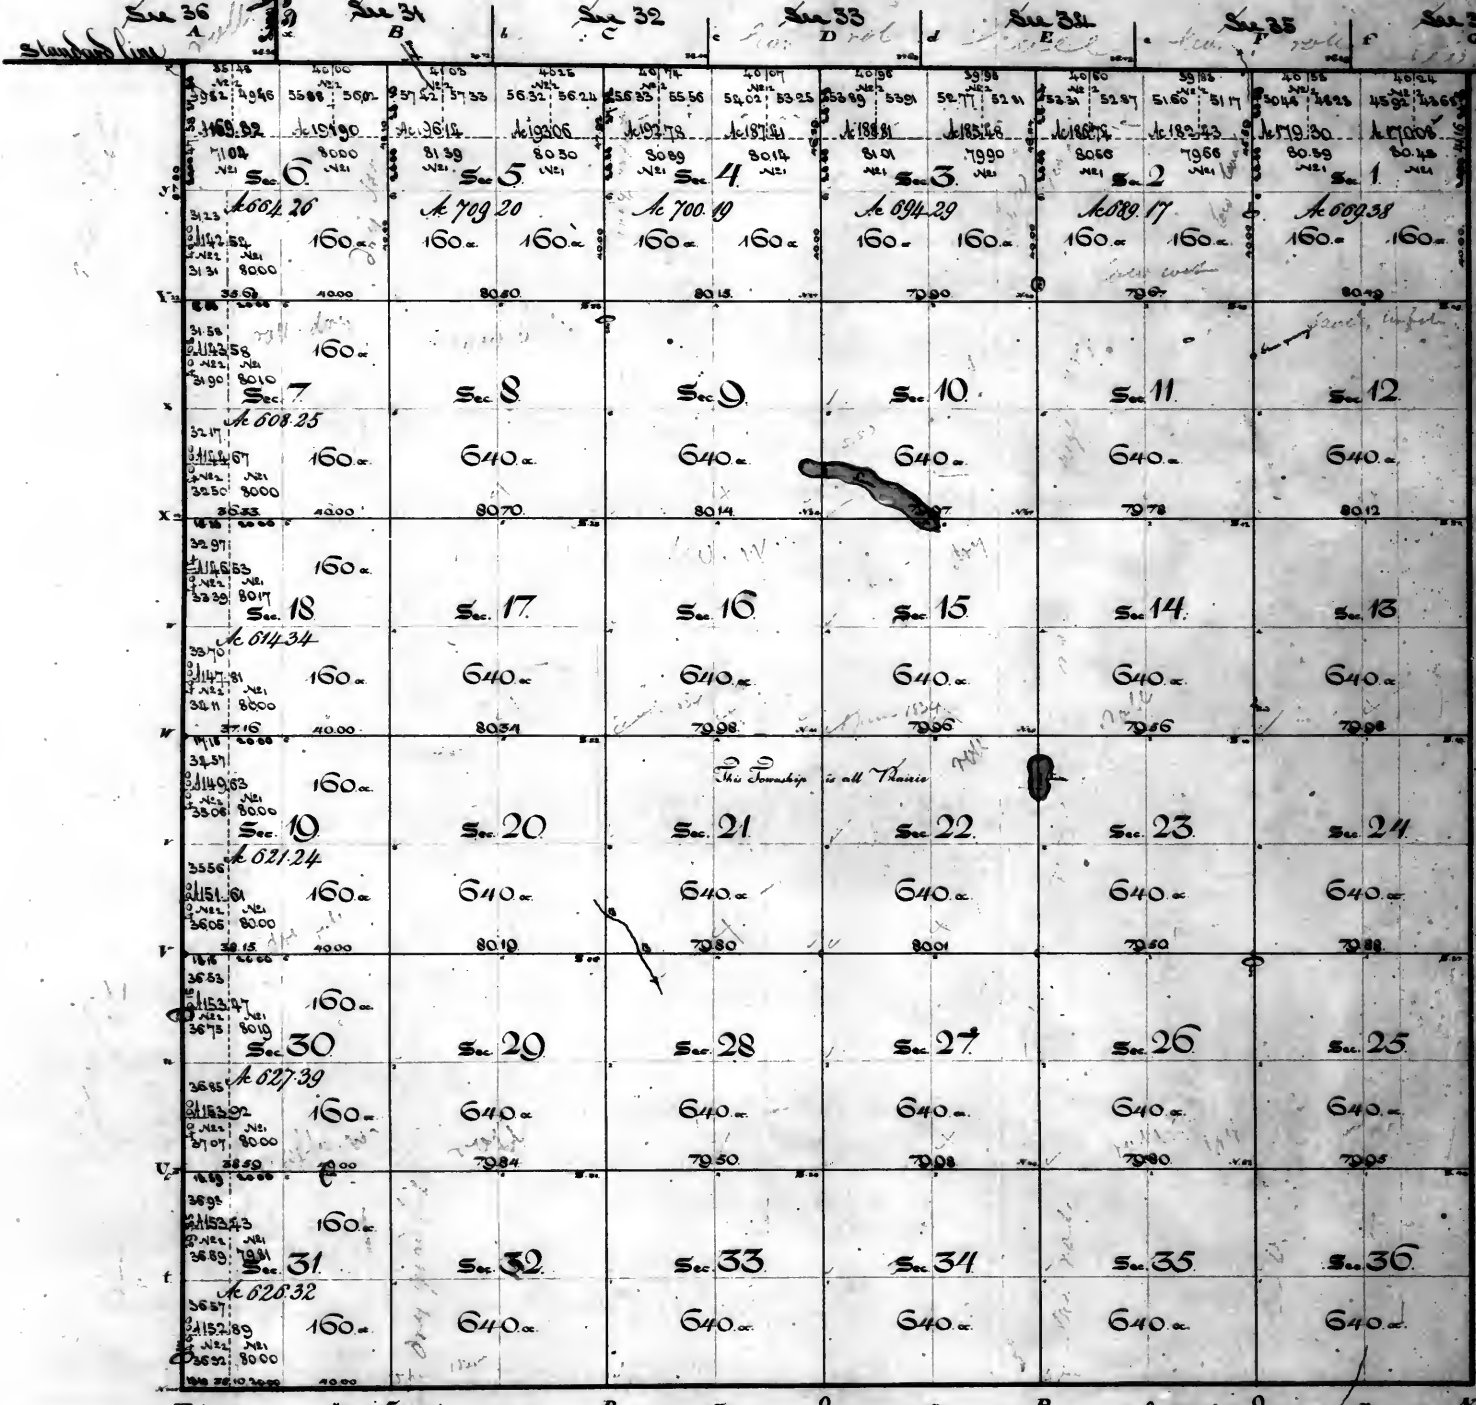

Note: The account of 37th Entry in which this township is charged amounts to \$2,227.15, of which \$603.74 was paid on the 22nd of February 1840; the rest (\$1,623.41) having been paid by S. J. Langham, former Surveyor General.

William Milburn


Scale of 100 chains to an inch. Aggregate Area = 23224.03 acres

Surveyors Office
St. Louis 20th March 1840.

The above Map of Township 30 North of the base line Range 10 East of 3rd principal Meridian is hereby confirmed to the field notes of the survey thereof on file in this Office, which have been examined and approved. The north boundary was surveyed in the 4th quarter of 1835, by Daniel W. Reel, under contract of the 29th October of that year - except so much of the north boundary of section 6, as was with the South boundary of section 36, Township 31 north range 9 east, which was surveyed by Daniel Miller, under the joint contract of Stephen Recker and Thomas C. Recker, dated 20th of March 1831 - the west boundary 6 miles 7.80 chains, the South boundary 5 miles 78.10 chains - the east boundary, 6 miles 116.40, and the subdivision line 6.9 miles 14.07 chains, were surveyed in the 2nd quarter of 1834, by William H. C. Coring under contract of the 15th day of August 1833. These surveys by Coring, were, to the extent noted in the margin, paid for on the 22nd of February 1840; and they will be charged in the account current of the Surveyor General for the present quarter (being the 1st quarter of 1840) under the general appropriation for surveying the public lands. Under No. 7

William Milburn
Surveyor of the public Lands in the
States of Illinois and Missouri.


Wm. B. Wood

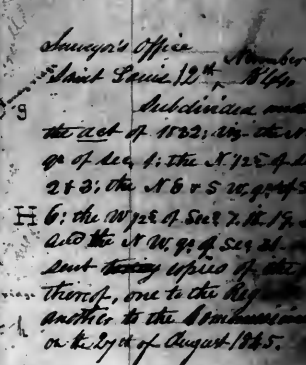

Scale of 40 chains to an inch.
Aggregate area 23032.10 acres

William Miller
Surveyor General

Township 32 north of the base line, Range 10 East of the 3rd principal meridian.

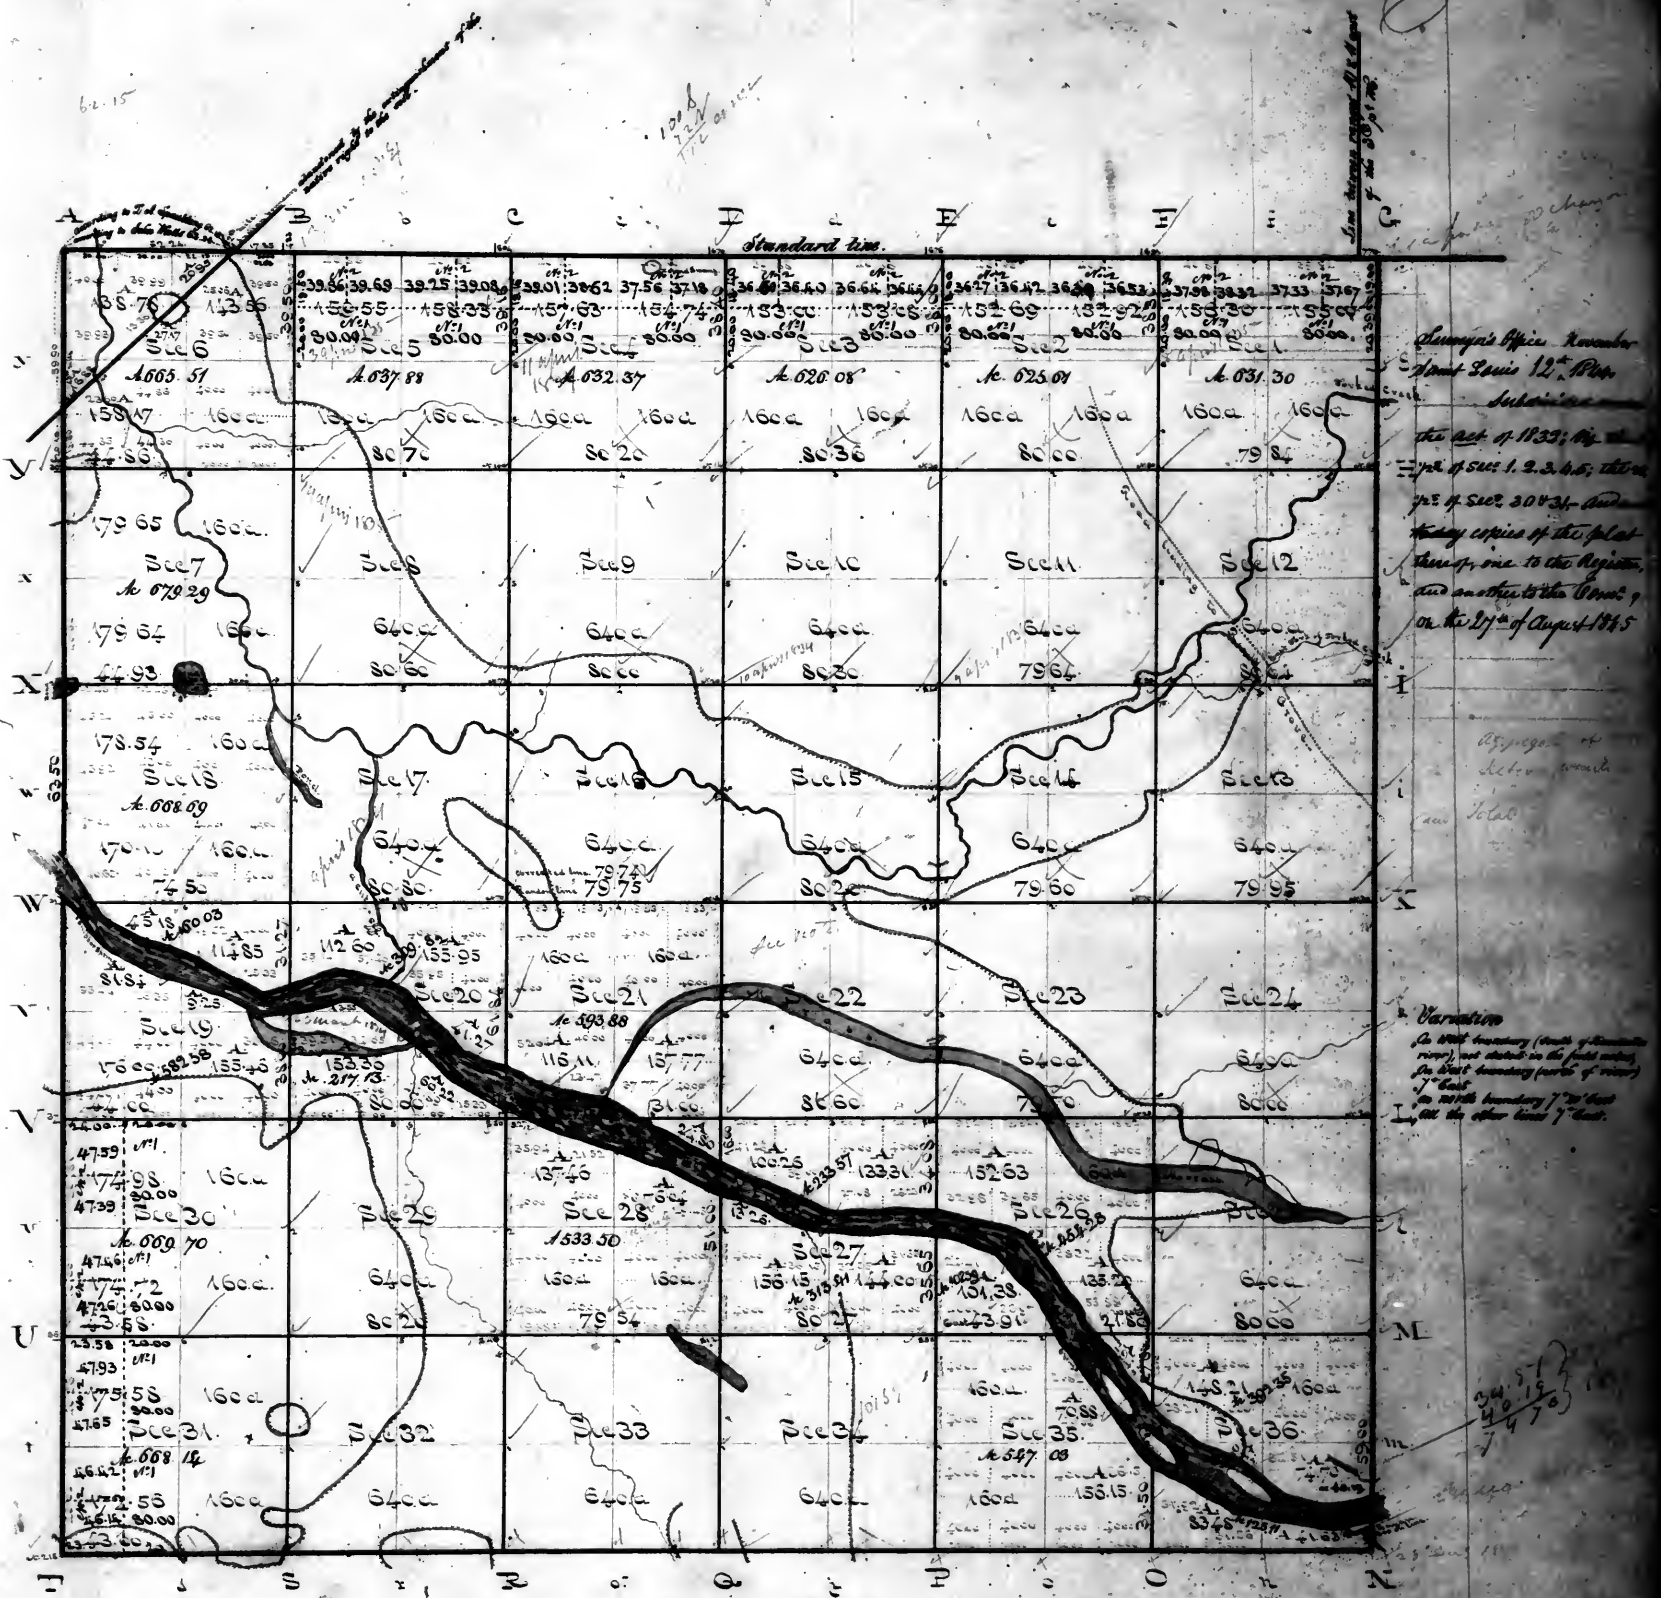

Surveyor General's Office.
Saint Louis 16 August 1823.

Public Land 22484.65 acres
(22484.65)

The above plat of township 32 north of the base line range 10 east of the 3rd principal meridian, is strictly conformable to the field notes of the Survey thereof on file in this Office which have been examined and approved - Those fractional parts of the west boundary which lie north of the old indian boundary and south of the Kankakee river were surveyed by Daniel Miller, and that part of the north boundary which lies west of the old indian boundary was surveyed by John Wallis, all in the 2nd quarter of 1821, under the contract of Stephen Rector and Thomas C. Rector of the 20th of March 1821 - The said fraction of the west boundary which lies north of the old indian boundary was renewed and the fraction of the line down south to the river was surveyed in the 2nd quarter of 1824, by D. W. Dickworth, under contract of the 25th of October 1823 - The above designated fraction of the North boundary was renewed and the balance of the line was surveyed by D. W. Dickworth in the 2nd quarter of 1824, under his contract of 5th Decr. 1823. The south boundary was surveyed in the 4th quarter of 1823 - and the east boundary - the subdivision lines and meanders were surveyed in the 1st and 2nd quarters of 1824, by Daniel W. Dickworth, under contract of the 29th of October 1823.

William Miller
Surveyor General
24


Daniel W. Dickworth

Fractional Township 33 North of the base line Range 10 East of 3^d principal Meridian


Surveyor General's Office, Saint Louis 26 August 1833.

The mile points designated on the 'old Indian boundary line' are, the points perpetuated one mile apart, according to the measurement on the said line, at the time of the recovery thereof by Wells, - their numbers are progressive from Lake Michigan: - The distances set down between said mile points are according to the measurement of D^o Spaulding

Surveyor General
J₄

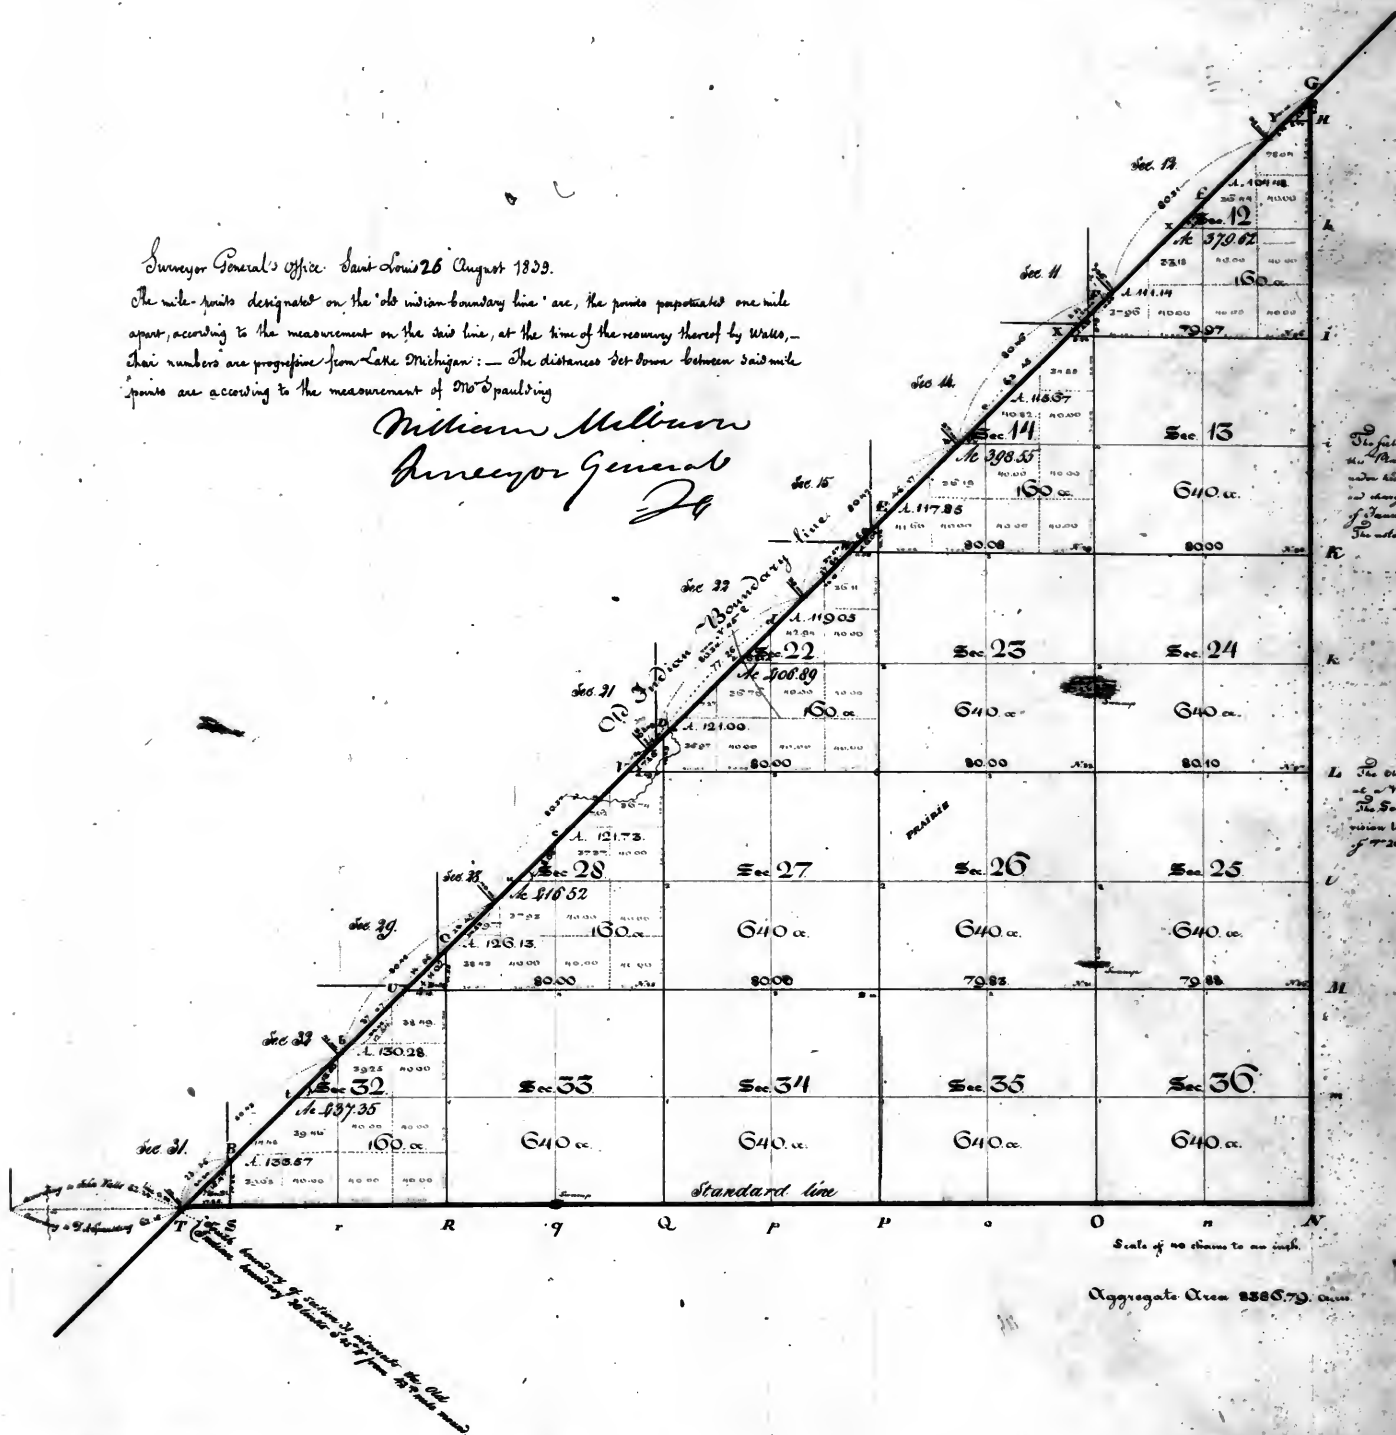

Fractional Township 32 & 33 North of Range 10 East & Town 33 N. Range 10 East of 3rd principal meridian
 N. 11g in 3rd Indian Boundary

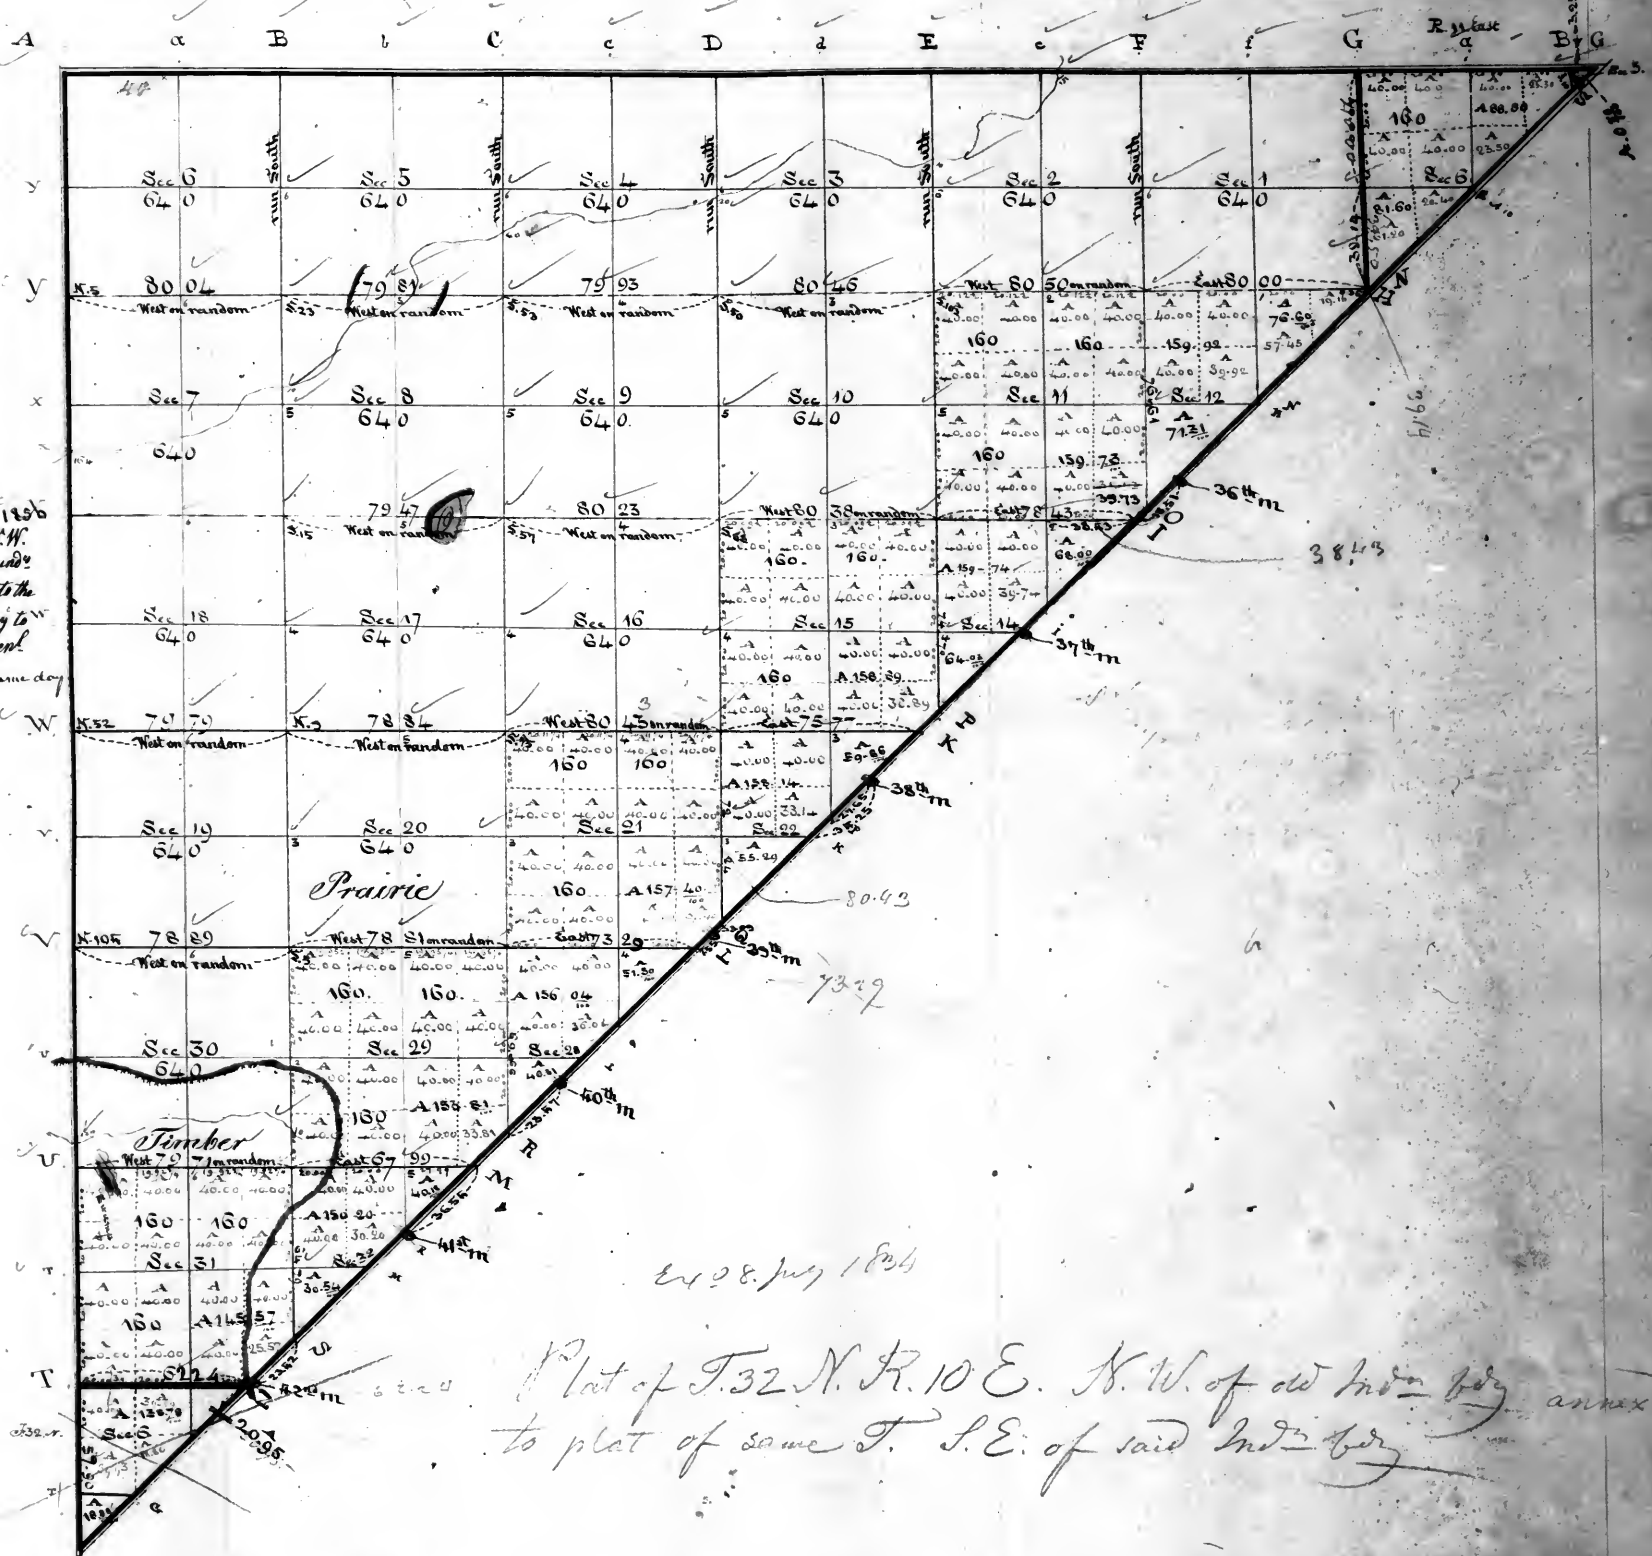

Surveyor's Office
 St. Louis 25th April 1834
 A Copy of all plat goes S.W.
 along the Old Indian boundary
 line was sent this day to the
 Register & another copy to
 the Commr of the Genl
 Land Office on the same day

Scale of 40 Ch to an inch.


Surveyors Office
 St. Louis July 1834

Plat of T. 32 N. R. 10 E. N.W. of old Ind- bdy annexed
 to plat of same T. S.E. of said Ind- bdy

The above Plat of fractional Townships 32 & 33 North of the baseline, Range 10 East & Township
 33 North of the baseline, Range 11 East of the 3rd principal meridian, North West of the Old Indian boundary, is conformable to
 the field notes of the survey thereof on file in this Office.

E. J. Sangdon

Township N. 35 North of the base line Range N. 10 East of the 3rd principal Meridian

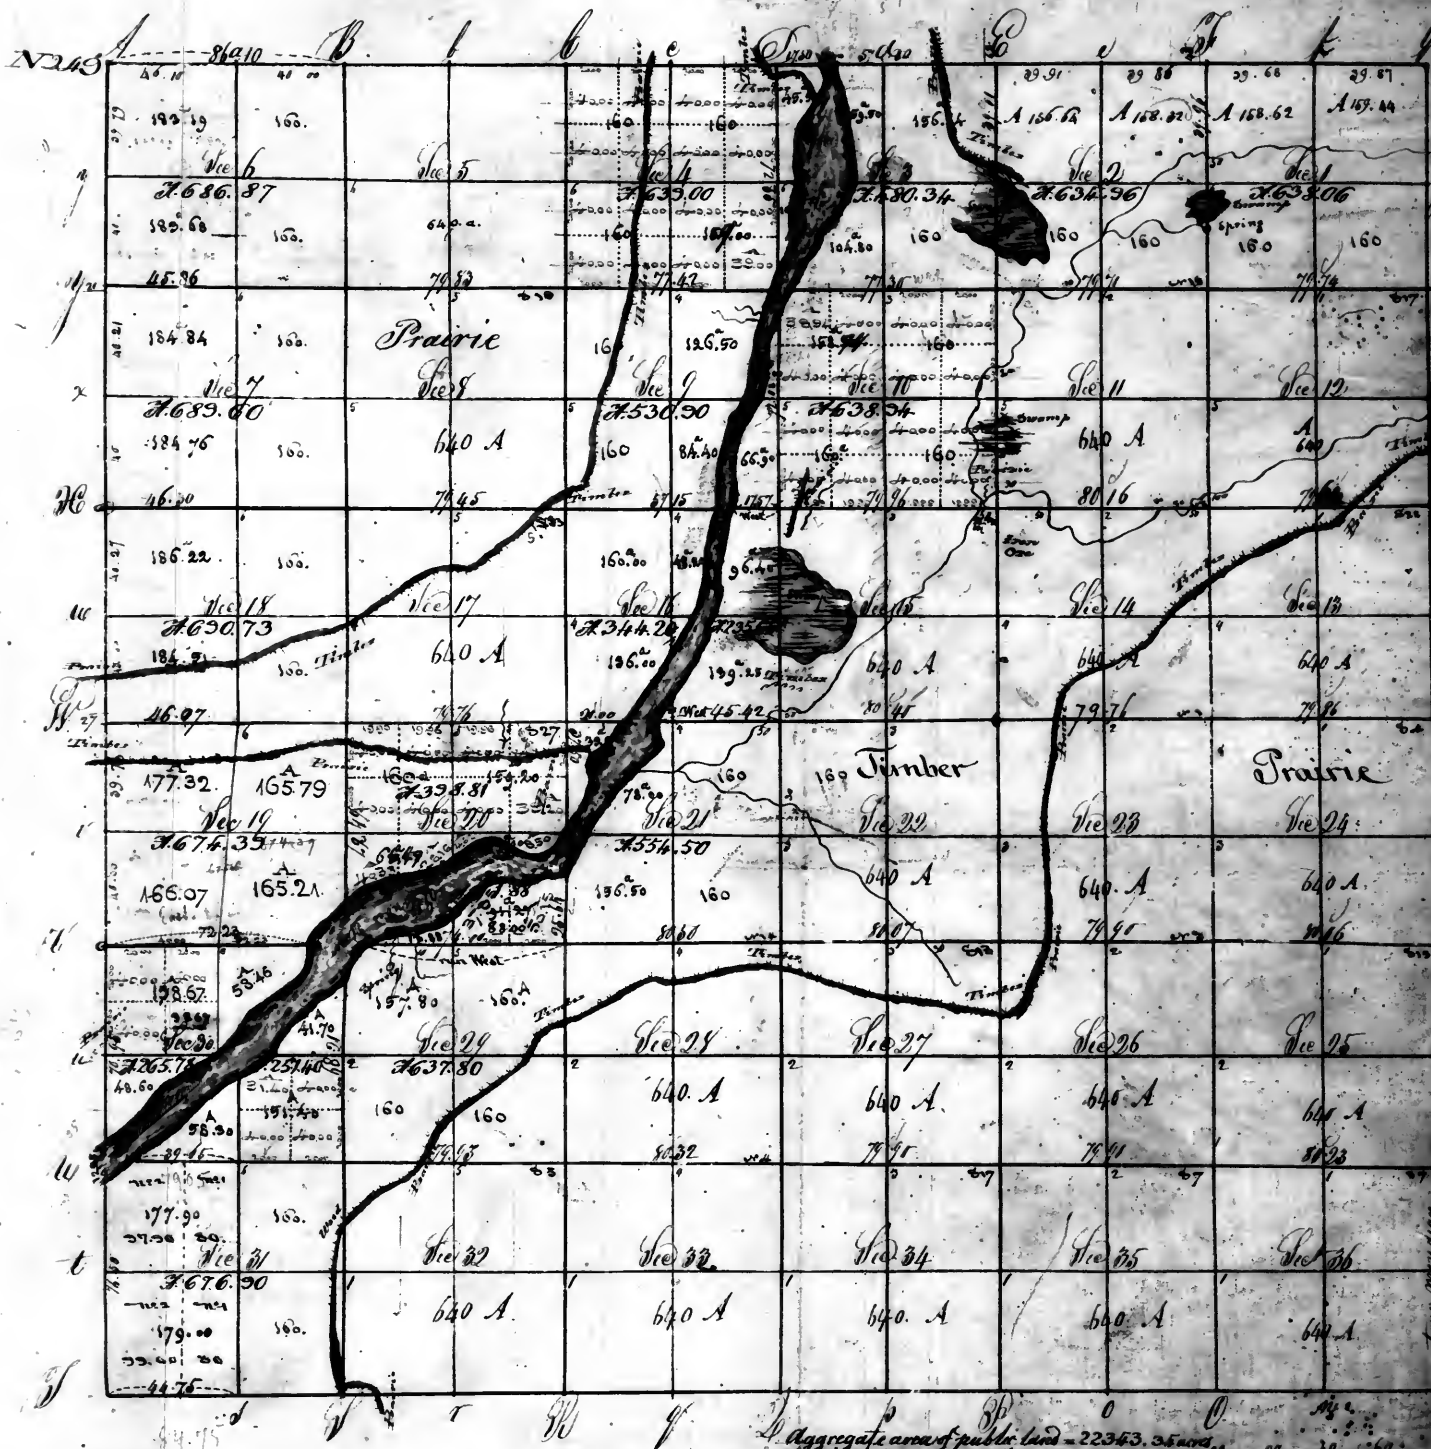

Aggregate area of public land - 22343.35 acres
 estimated area of the river - 520.00
 Total - 22823.35 acres

Pursuant to a contract with and instructions from William Recker Surveyor of the lands of the United States in the States of Illinois, Missouri and Territory of Arkansas bearing date the twentieth day of March 1834 I have measured laid out and surveyed the above described Township and do hereby certify that it has such marks and bounds both natural and artificial as are represented on said plat and described in the field notes made thereof and returned with this plat into the Surveyors Office of the lands of the United States in the States of Illinois, Missouri and Territory of Arkansas.


Examined
 Surveyors Office
 St. Louis July 21st 1834

The Clerk
 Stephen Hubbs

The above plat of Township 35 North of the base line, Range 10 East of the 3rd principal meridian, is conformable to the field notes of this survey thereof on file in this Office.

E. J. Smyth

Township N. 36. North of the Base line Range N. 10 East of the 3rd Principal Meridian

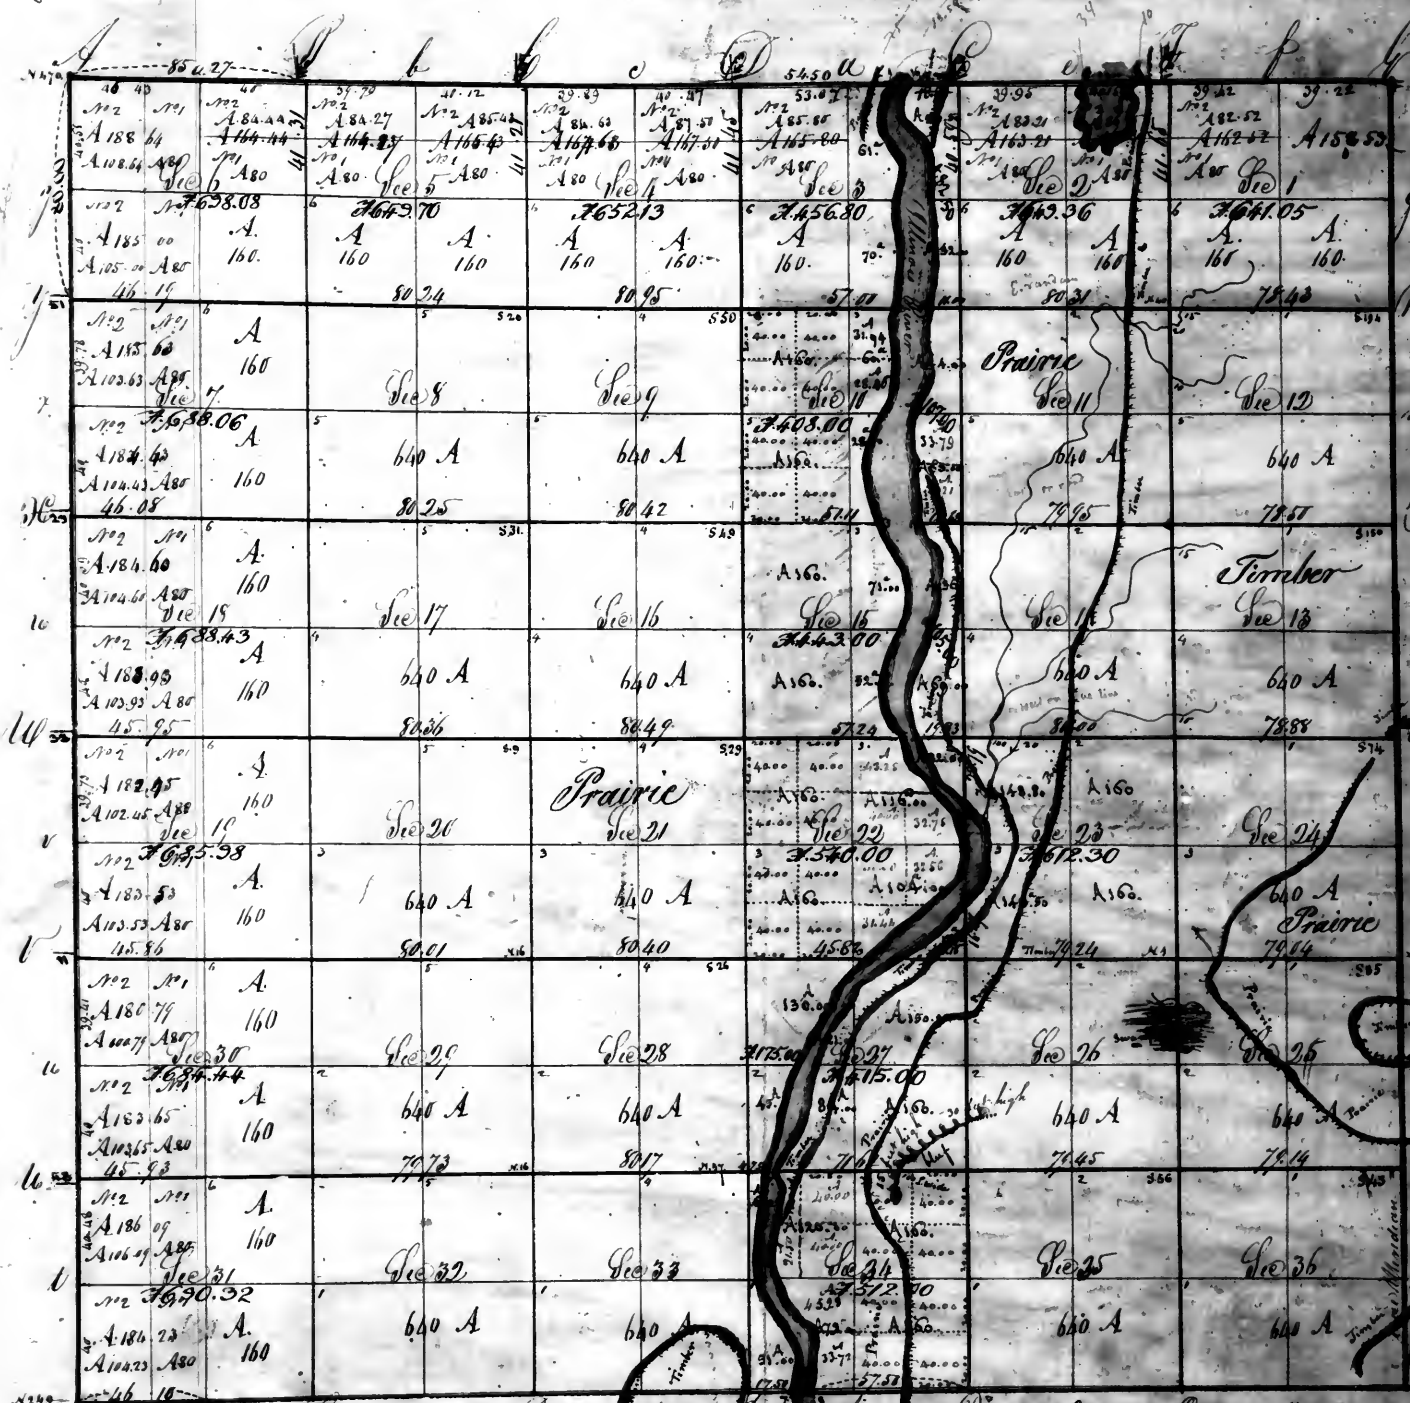

Aggregate area of public land = 22846.95 ac
Estimated area of the river = 400.00 ac
Total = 23246.95 ac

Scale of the chain to an inch





Surveyors Office
St. Louis July 31 1834

N. 144

S. 144

E. 144

The above Plat of Township 36 North of the base line, Range 10 East of the 3rd Principal Meridian, is conformable to the


field notes of the Survey thereof on file in this office.

Wm. V. Surveys

Thos. C. Victor
Stephen Victor, D. Surveys

E. J. Surveys

Township N. 37 North of the Base Line Range N. 10 East of the 3rd Principal Meridian
 South East of the Old Indian Boundary line.

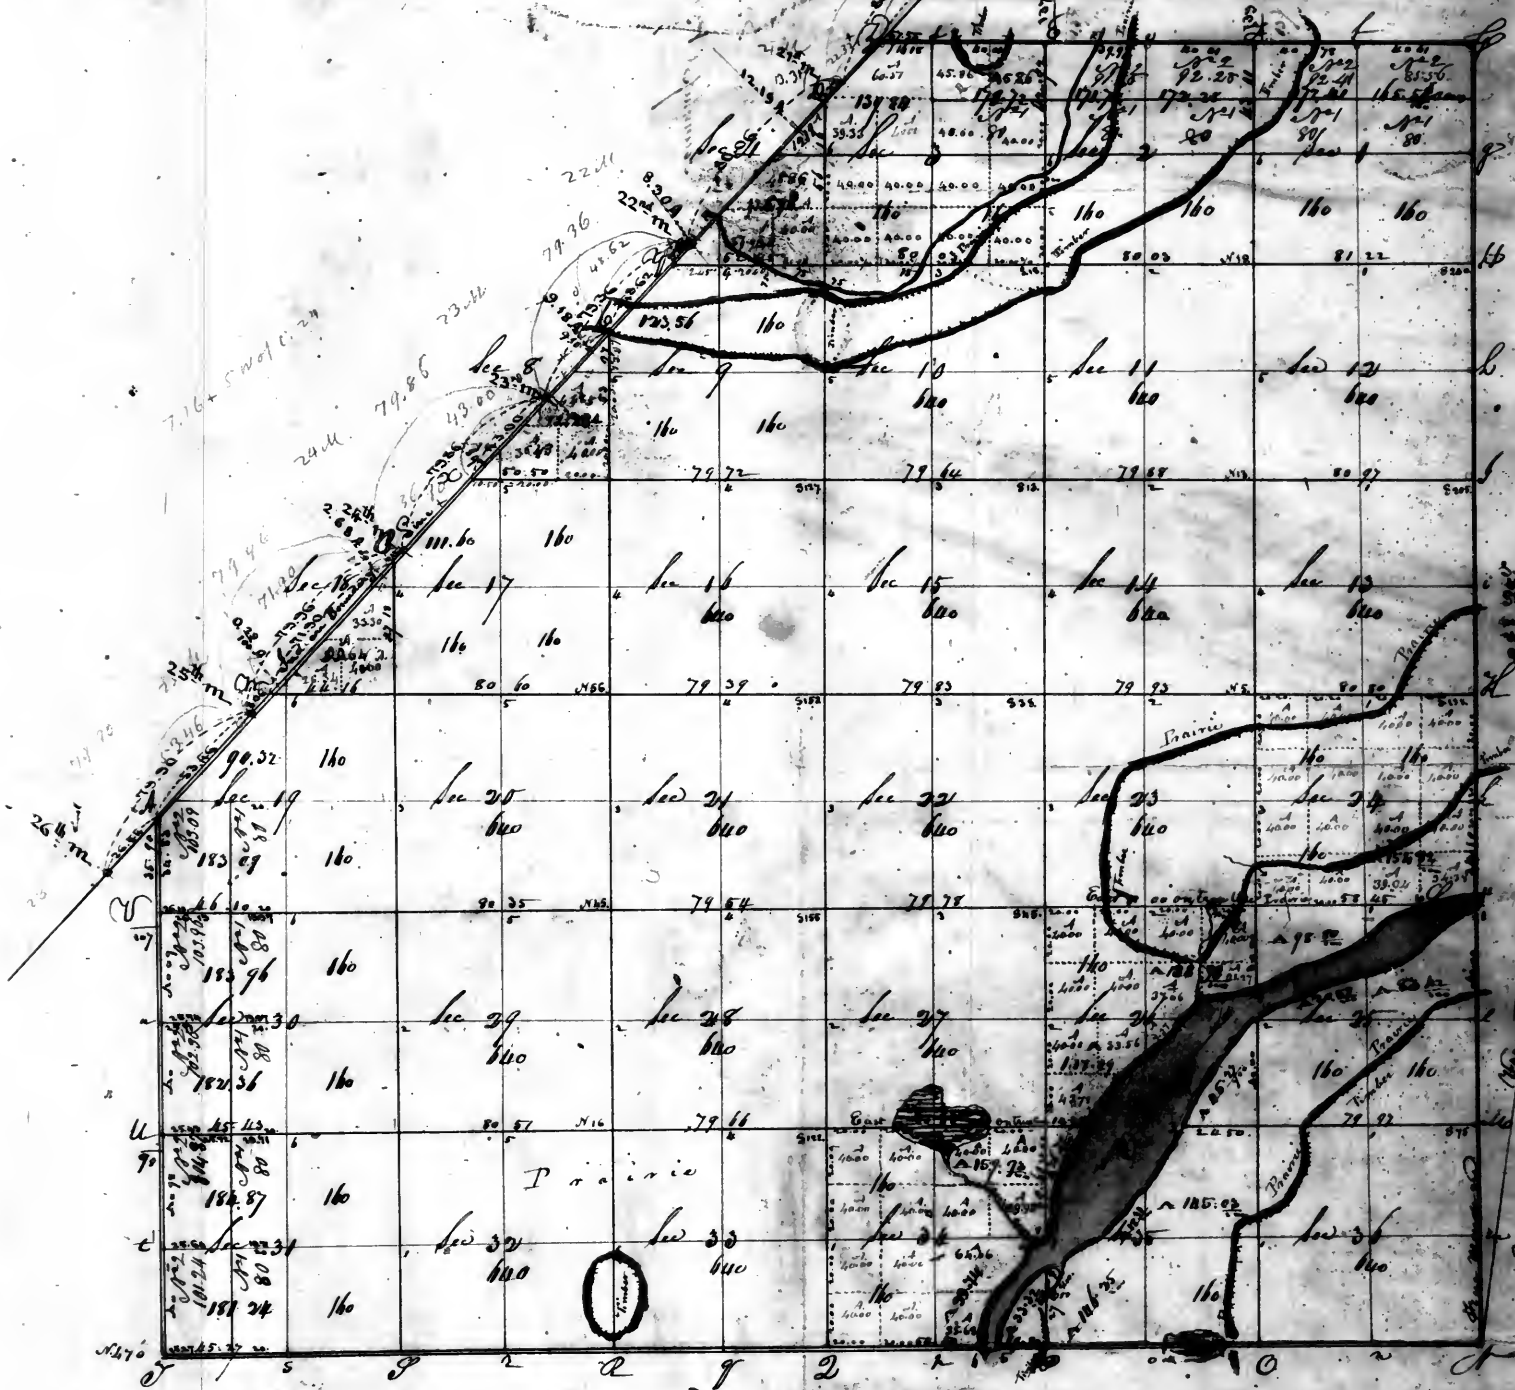


Surveyors Office
 St. Louis July 3, 1834

The above Plat of fractional Township 37 North of the base line, Range 10 East of the 3rd principal meridian, South East of the Old Indian Boundary line, is conformable to the field notes of the survey thereof on file in this Office.

E. J. Mayham

Fractional Township N^o 37 North of the Base line in Range N^o 10 East of the 3^d principal Meridian.

73

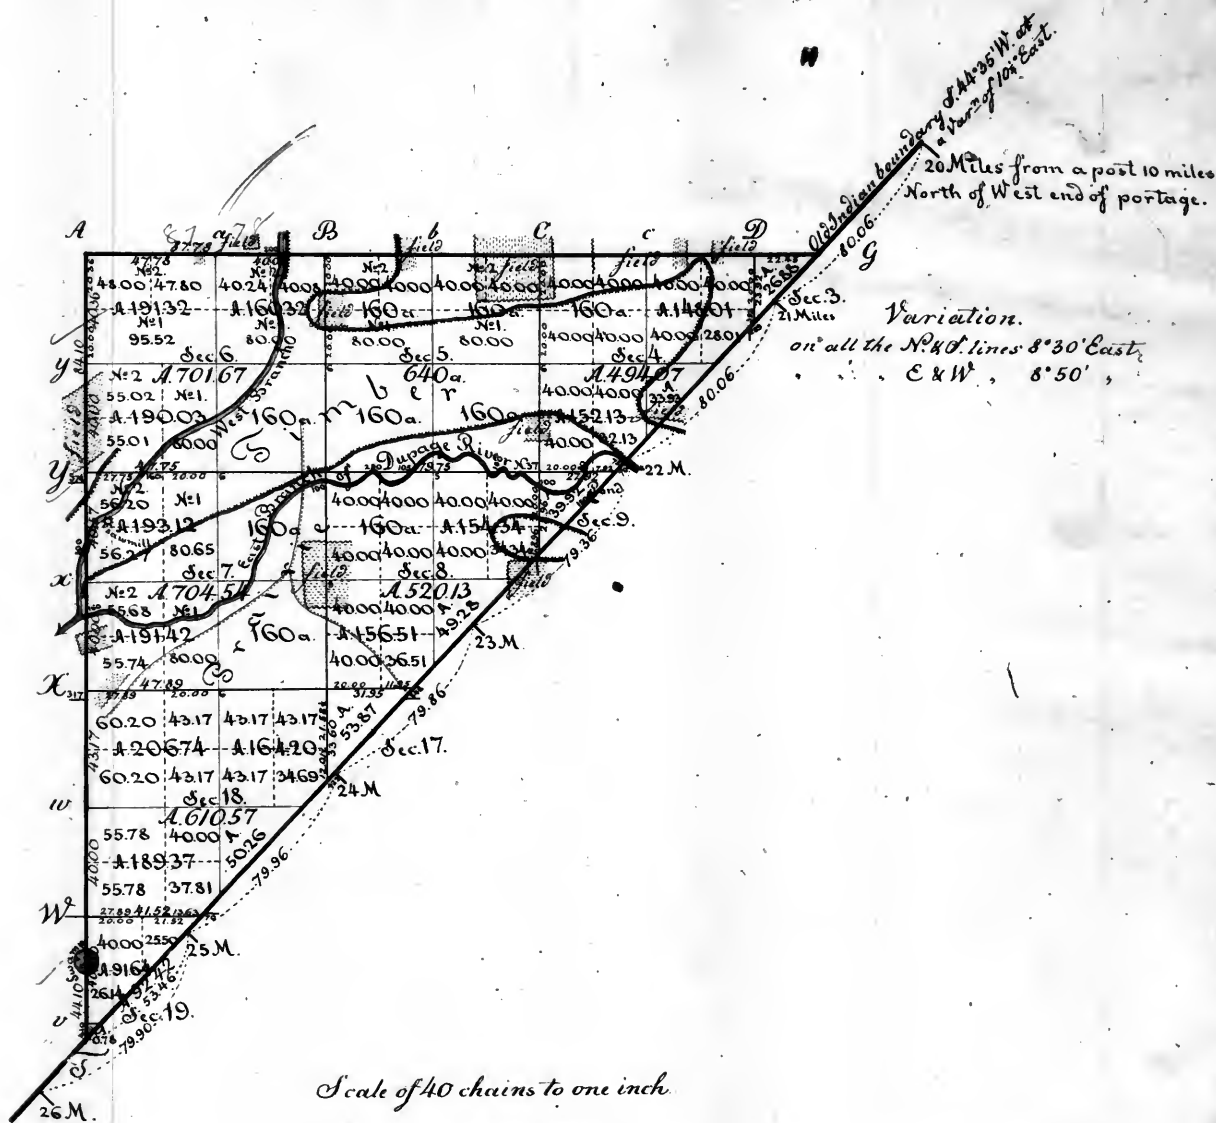

Scale of 40 chains to one inch.

Aggregate area 3884.07 acres


Surveyors Office.

Saint Louis 21st of May 1839.

The above plat of fractional township 37 north of the base line, range 10 east of the 3^d principal meridian, north west of the old indian boundary, is strictly conformable to the field notes of the Survey thereof on file in this office, which have been examined and approved— The South eastern boundary to this fractional township, which is designated "Old indian boundary" was surveyed in the 4th quarter 1834, in order to close the surveys to the South east thereof, under the contract of Stephen and Thomas C. Rector of the 20th of March 1831; it was commenced at the 17th mile of the indian boundary run by John C. Sullivan, assisted by James Mc. Duncan, in the 4th quarter of 1818, from a point 10 miles North of the portage S. W. to a point 10 miles above the mouth of Sandy creek, under a letter of appointment dated 18th of October 1818, for the survey of the boundary lines of the treaty of Saint Louis of the 24th of August 1816, between the United States and the united tribes of Ottawas, Chippewas and Pottawatomias, and was intended as a reserve in part of said survey of 1818, but diverged therefrom to the Northwest— That part of said indian boundary which forms a boundary to this fractional township 4 miles 75.08 chains, was recovered— and the west boundary 3 miles 48.20 chains— and the north boundary 3 miles 30.25 chains were surveyed in the 4th quarter of 1838— and the subdivision lines 8 miles 43.26 chains were surveyed in the 3^d quarter of 1838— all by Eli S. Prescott under contract signed by the Surveyor General on the 8th of May, and by the said Prescott on the 3^d of June 1837;— they were paid for in the 4th quarter of 1838— and charged in the account of the Surveyor General for that quarter— Voucher N^o 5.

William Miller
Surveyor General

14

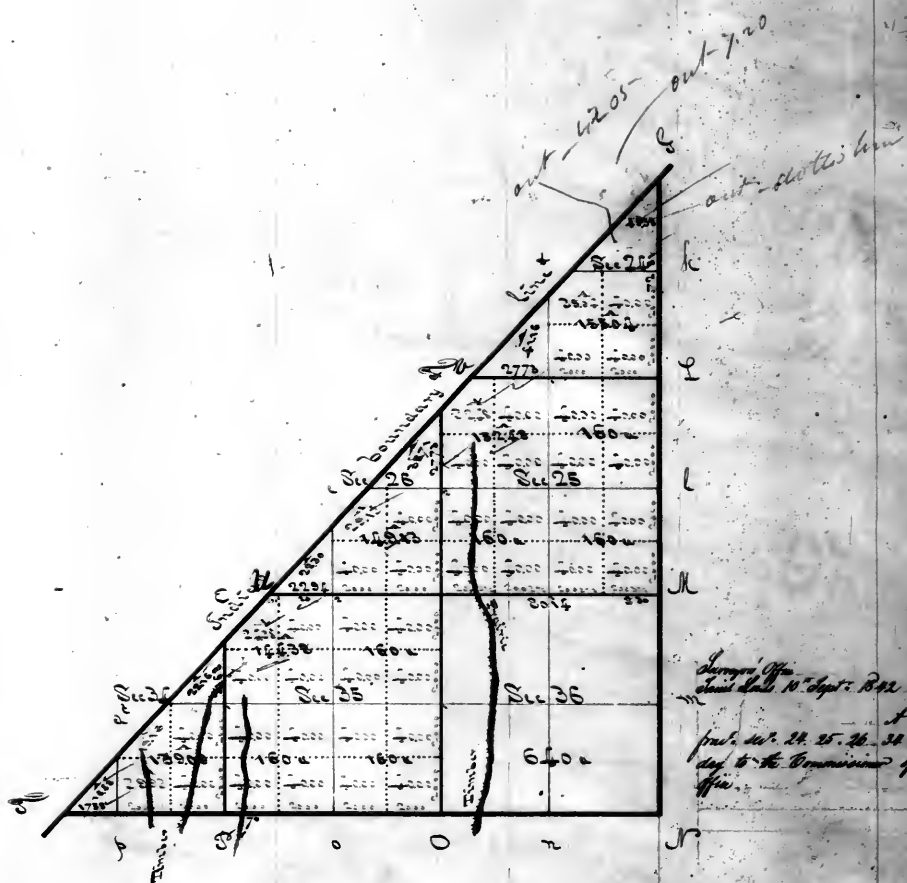


2 3 4 0.12

E. J. Langhorne

Township 38 North of the base line Range 10 East of the 3^d principal Meridian

15

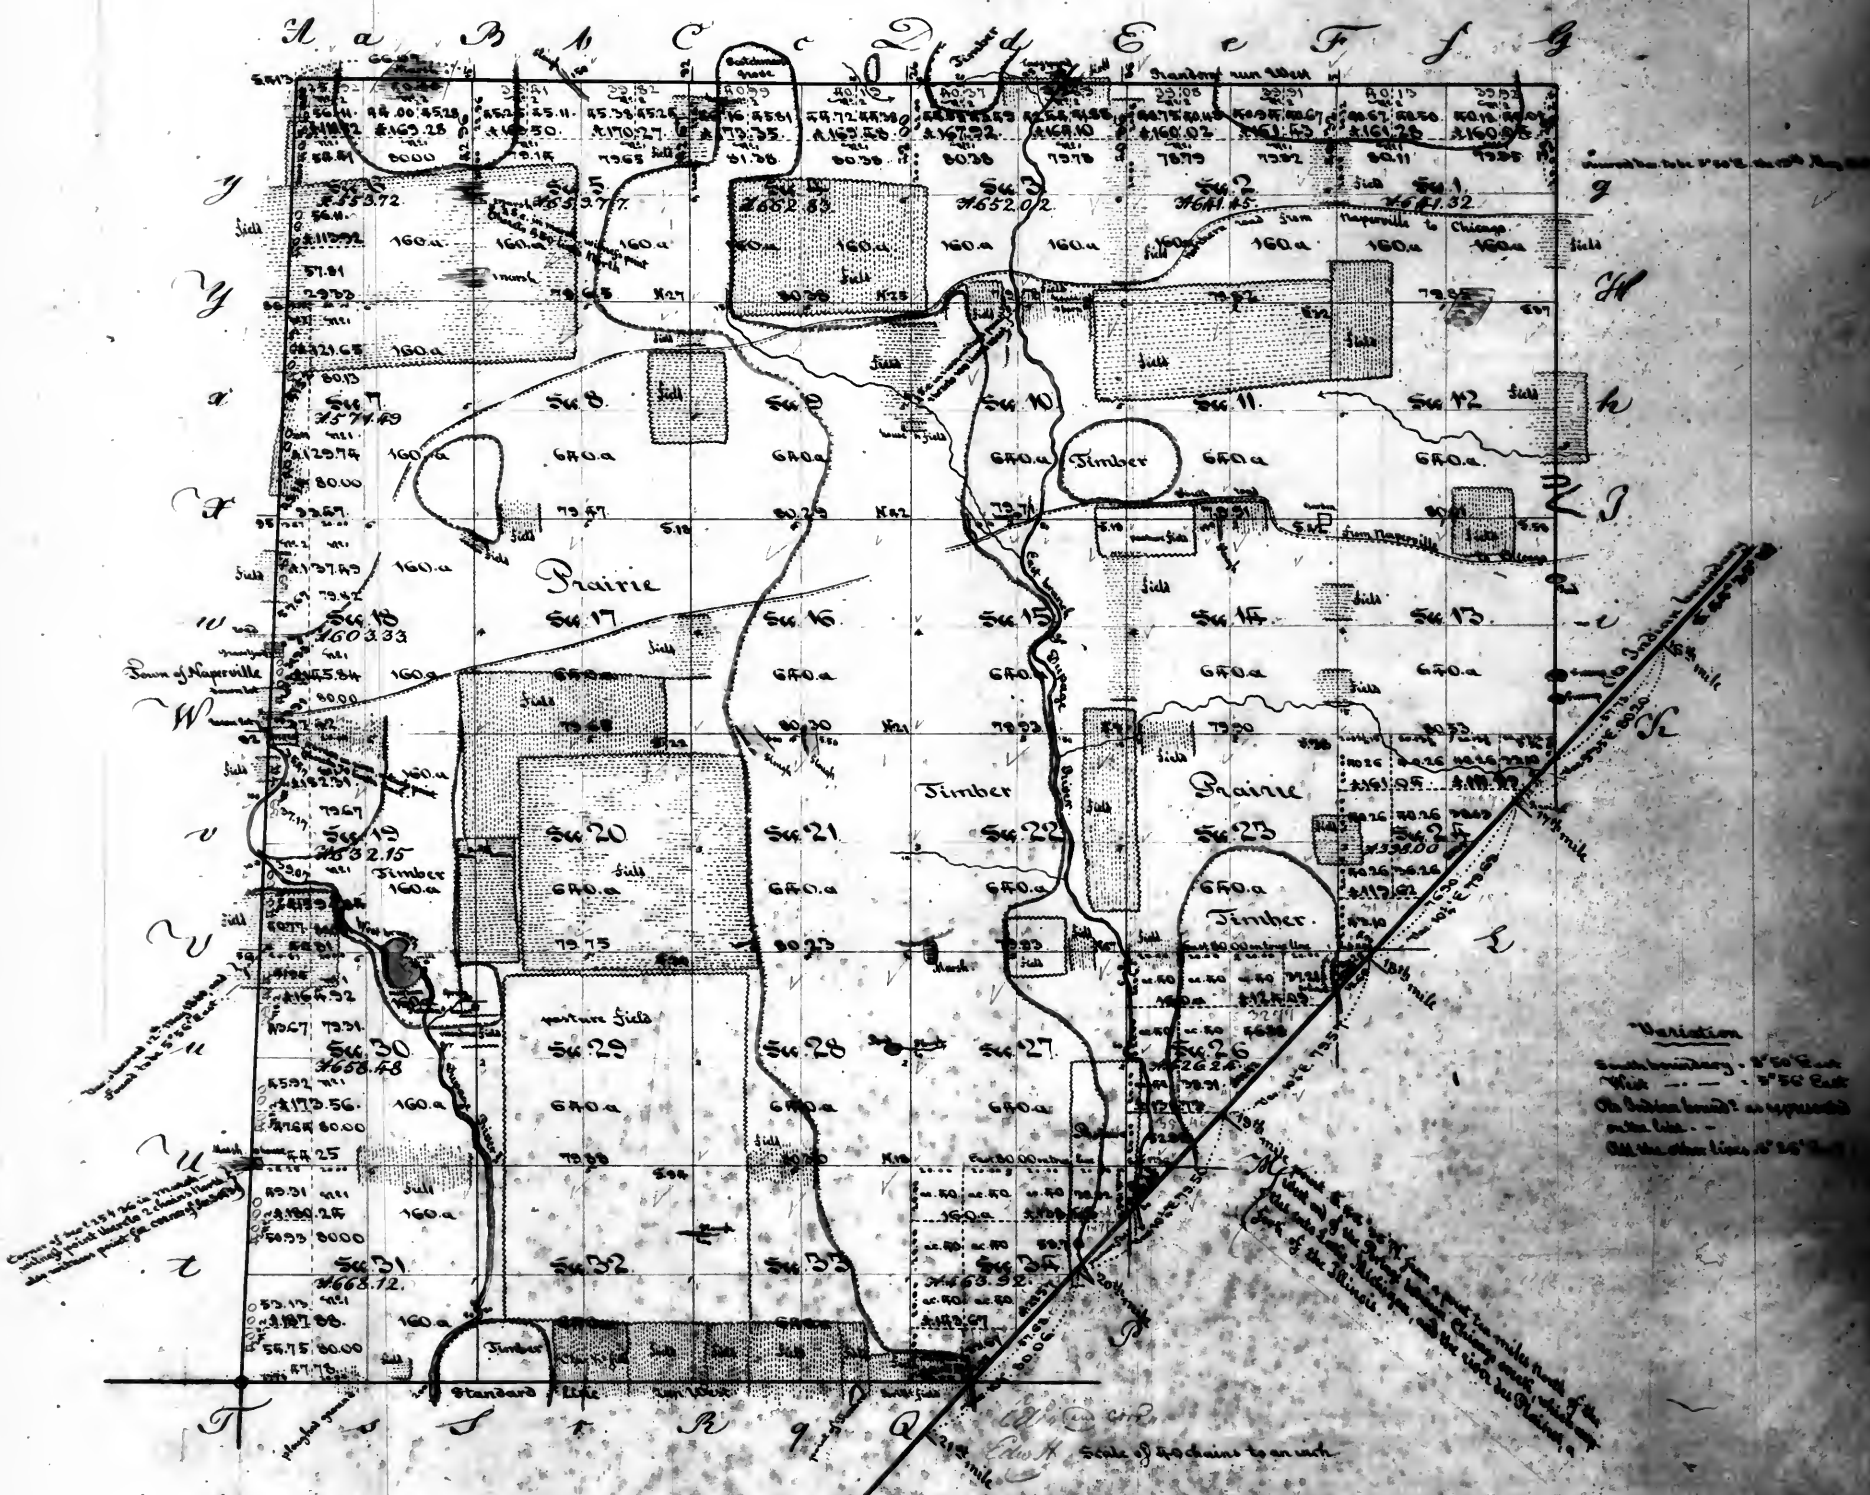


Surveyors Office. Saint Louis 4th of January 1842.

The above plat of township 38 north of the base line, range 10 east of the 3^d principal meridian, north west of the 16th section boundary line, is strictly conformable to the first notes of the survey thereof, on file in this office which have been examined and approved. The southwestern boundary of the township begins at the corner of the 16th section boundary line, was surveyed in the 1st quarter of 1818, by John C. Sullivan, as principal surveyor, and claims to be the true line, as certified by a letter from William Redd, surveyor of the public lands in the territory (now States) of Illinois and Missouri, dated the 15th of October 1818, authorizing said Sullivan and Buchanan, to survey under the direction of Commissioner Nathan B. Phelps, appointed by the President of the United States to run the lines of the tract ceded by the treaty of St. Louis of the 24th August 1816 (page 177 and following, land laws, edition of 1828) - This being the line, agreed to be run from a point on the line of the tract ceded by the treaty of St. Louis north of the west end of the Portage between Chicago Creek which empties into Lake Michigan, and the River des Plaines, a fork of the Illinois, and was run by the said Sullivan and Buchanan from the said point 10 miles north of the west end of the Portage, S. 44° 35' W. 38 miles and 20 chains to a point 33.75 chains at right angles to the west of the corner established on Sandy Creek 10 miles from its mouth - On the 3^d quarter of 1821, John Wells, under the contract of Stephen and Thomas Redd of the 20th of March of that year, resurveyed this line for the purpose of closing the public surveys on the south east side thereof - The whole of the line was retraced and the fractional section corners for the surveys on the South east side thereof, were re-established in the 3^d quarter of 1827, by Eli S. Brown, under contract signed by the Surveyor General on the 8th of May, and by Eli S. Brown on the 2^d of June 1827 - On the 1st quarter of 1838, and charged on the account current of the Surveyor General, during that quarter, section 15 - The east boundary 3 miles 7.50 chains - The north boundary 5 miles 58.07 chains - The west boundary 6 miles - and the subdivision lines 38 miles 53.22 chains, were resurveyed in the 2^d quarter of 1840, all by Wm. L. Brown, under contract of the 20th of September 1839 - They were paid for in the 2^d and 4th quarters of 1841, and charged on the second account of the Surveyor General, during those quarters under the general appropriation for surveying the public land. Vouchers A 2 & 12.

Jos. C. Brown
Surveyor of the public lands for
the District of Illinois & Missouri.

Township 29 North of the base line Range 10 East of the 3rd principal Meridian

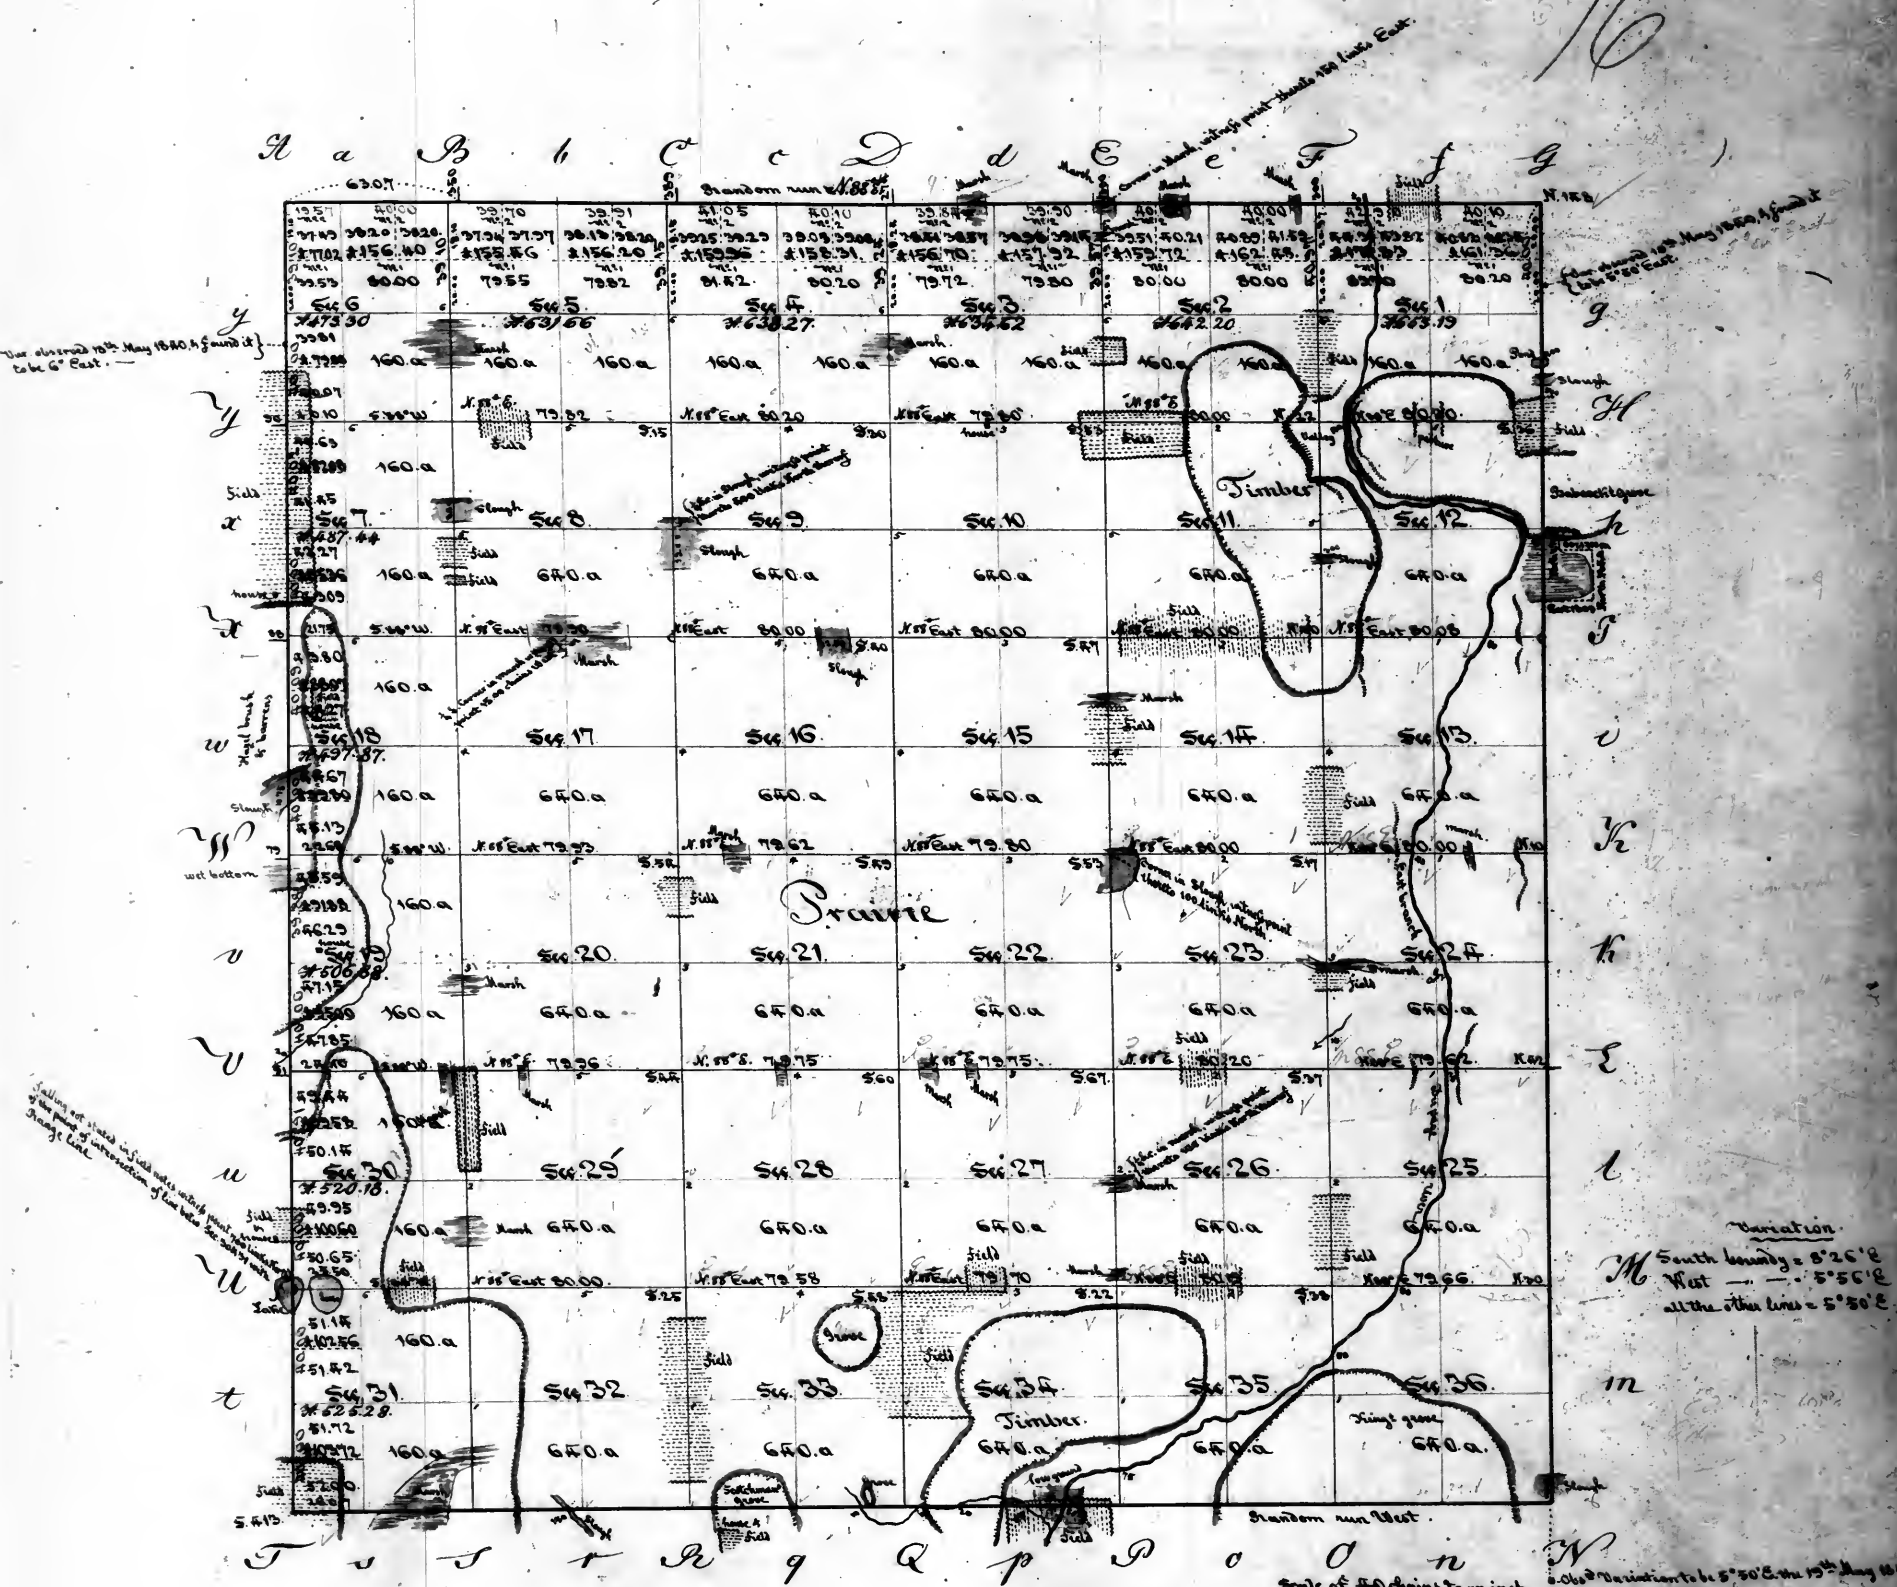

Var observed 10th May 1840, found it to be 6' East.

Variation.
South boundary = 8° 26' E
West — — — 5° 56' E
all the other lines = 5° 50' E

falling on stated in field notes which point to the intersection of line with the base line.


Surveyors Office. Saint Louis 4th of January 1842.

The above plat of Township 29 North of the base line, range 10 East of the 3rd principal meridian, is strictly conformable to the field notes of the survey thereof on file in this office which have been examined and approved. The south boundary 5 miles 68.07 chains — the west boundary 5 miles — the north boundary 5 miles 63.07 chains — and the east boundary 5 miles, were surveyed in the 2nd quarter of 1840 — and the subdivision lines 36 miles 69.98 chains, were surveyed in the 3rd quarter of 1840, all by W. A. D. Irving, under contract of the 23rd of September 1839 — The surveying of the exterior lines, was paid for in the 2nd and the 4th quarter of 1841, and charged in the accounts current of the Surveyors General for those quarters, Voucher N^o 2 & 12. — and the subdivision lines, were paid for in the 4th quarter of 1841, and charged in the account current of the Surveyor General, during that quarter, Voucher N^o 15.

Jos. C. Brown,
Surveyor of the public land for

Township 40 North of the base line Range 10 East of the 3rd principal Meridian

17

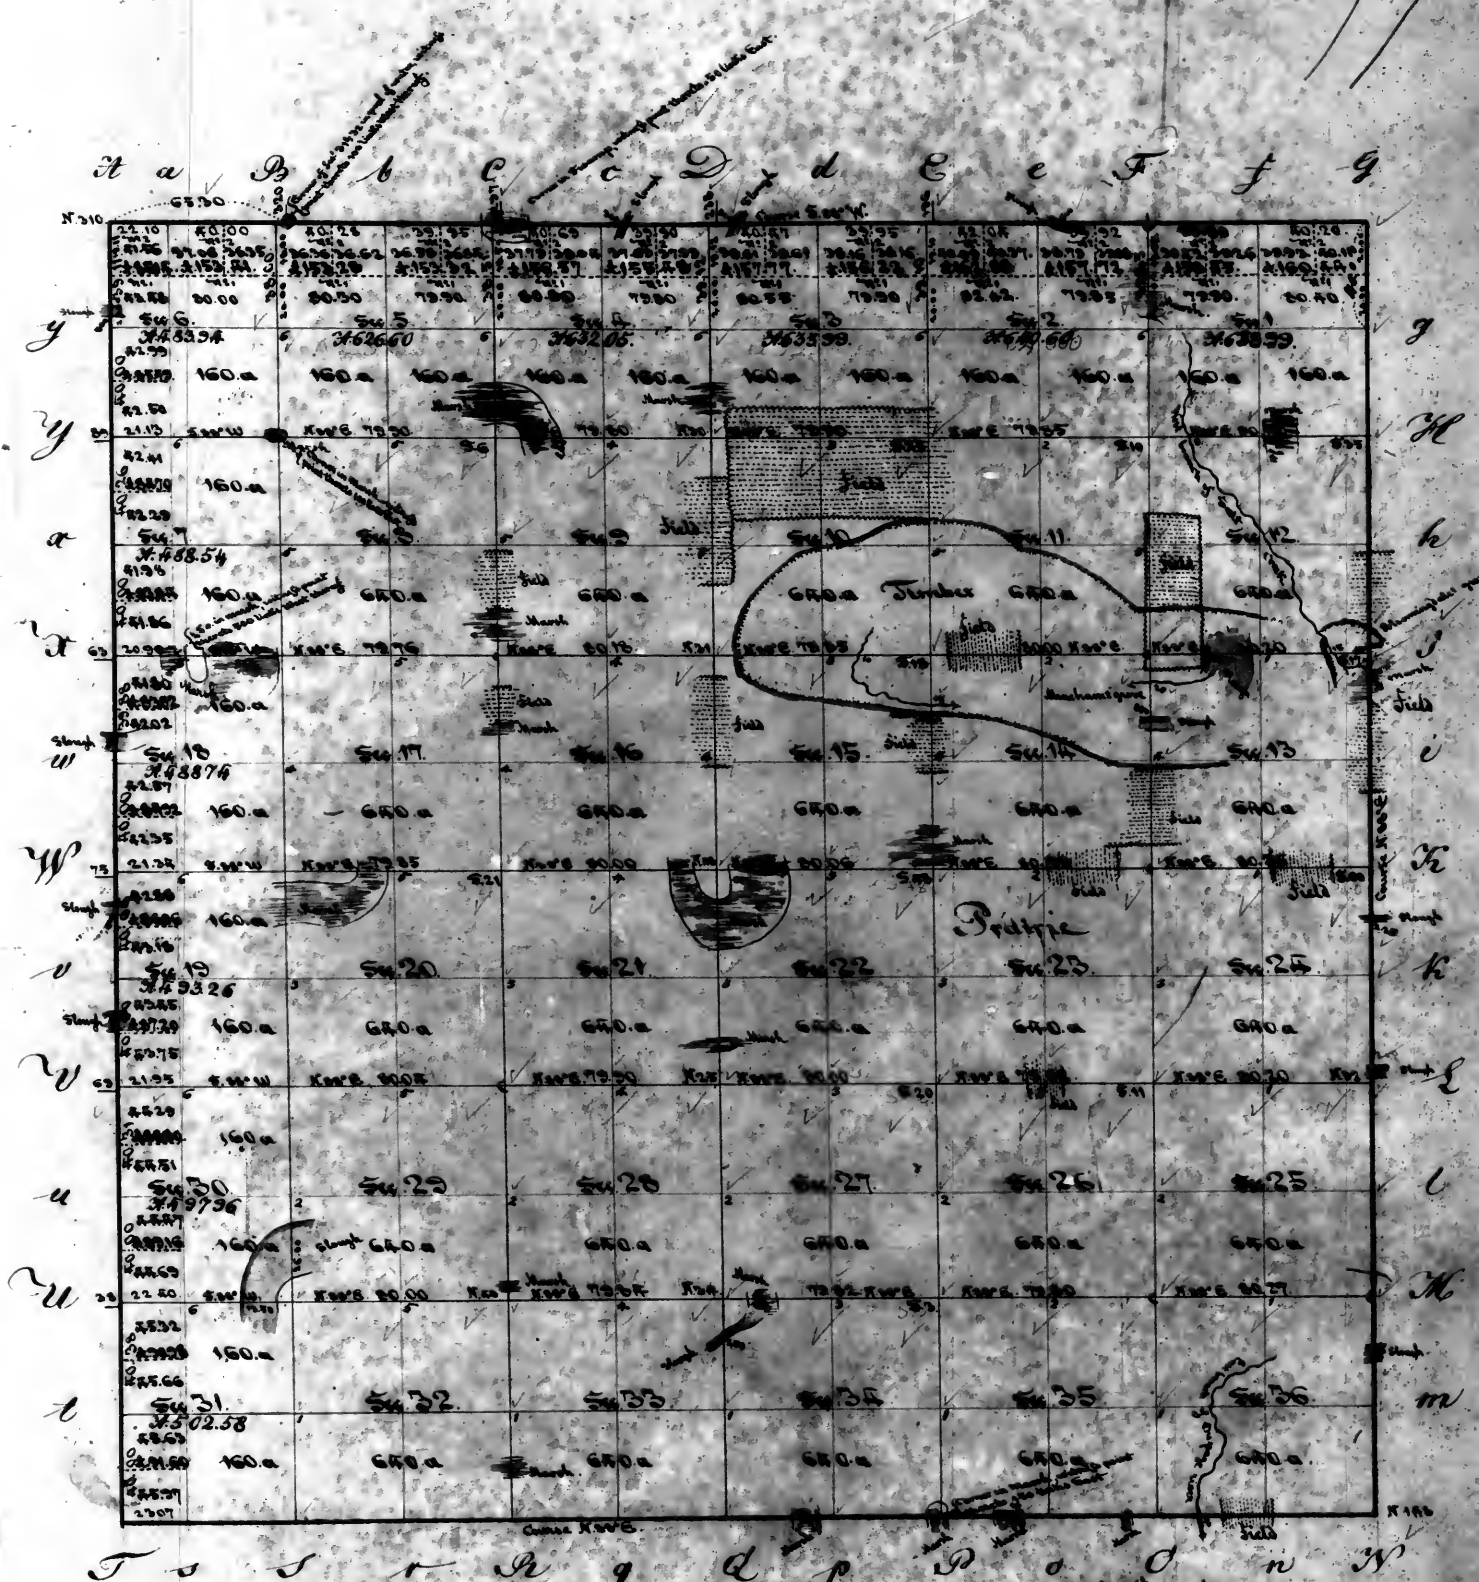


Surveyors Office. Saint Louis 4th of January 1844.

Aggregate area = 22127.25 acres.

The above plat of township 40 north of the base line, range 10 east of the 3rd principal meridian, is strictly conformable to the field notes of the survey thereof on file in this office, which have been examined and approved. The South boundary 5 miles 62.07 chains - the west boundary 6 miles - the north boundary 5 miles 62.08 chains, and the east boundary 6 miles, were surveyed in the 2nd quarter of 1840, - and the subdivision lines 58 miles 62.09 chains, were surveyed in the 3rd quarter of 1840, all by W^m C. Loring, under contract of the 23rd of September 1839 - This surveying was paid for in the 2nd and 4th quarters of 1841, and charged in the accounts current of the Surveyors General during those quarters, Vouchers A^o 2 & 19.

Jos. C. Brown
Surveyor of the public lands for

Township 41 North of the base line Range 10 East of the 3^d principal Meridian

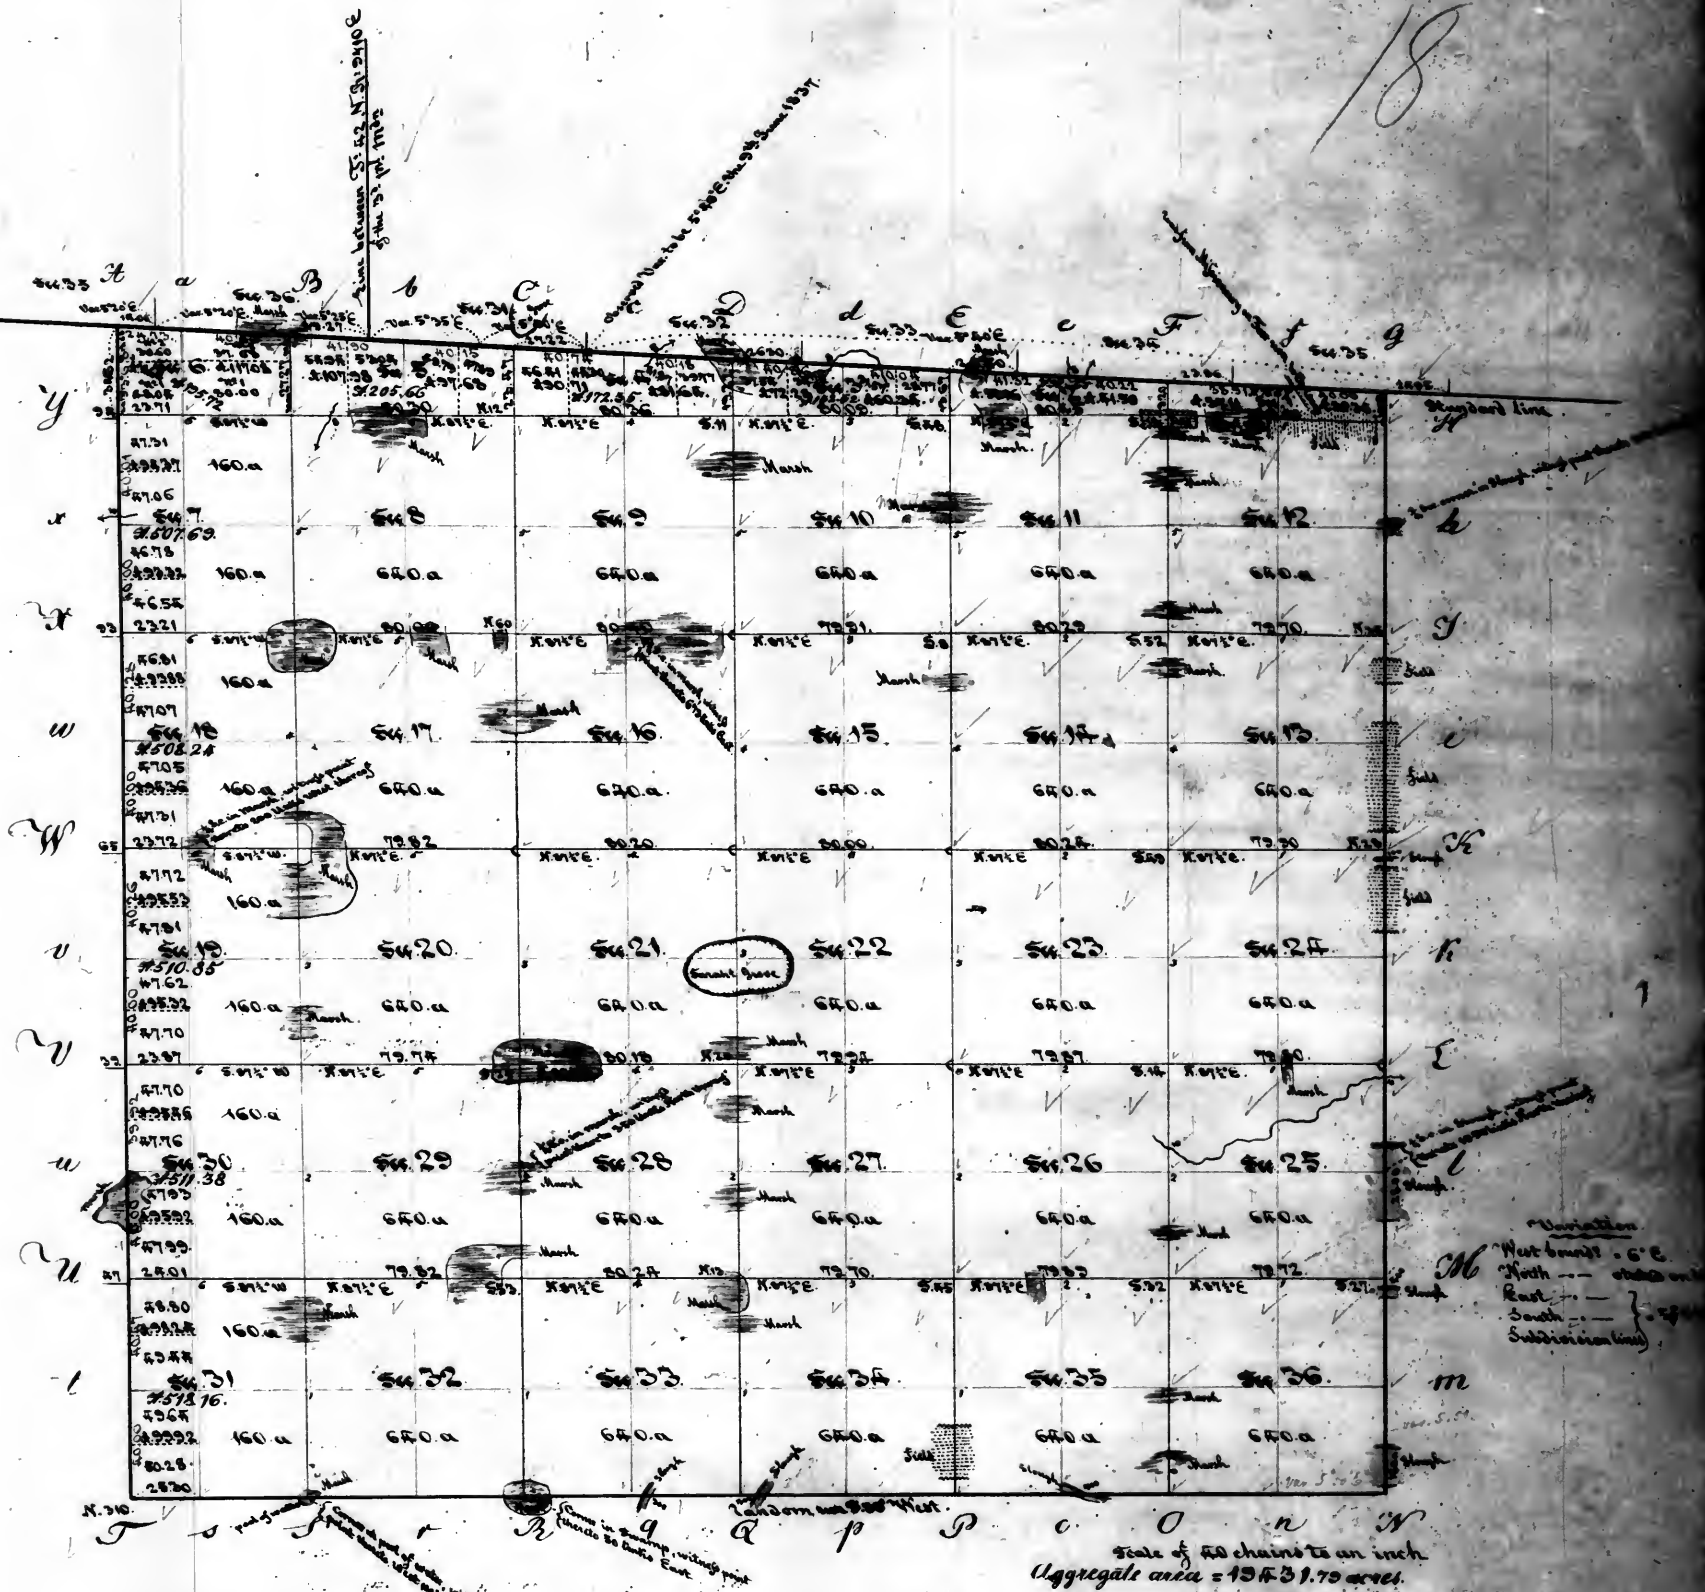


Surveyors Office. Saint Louis Mo. of January 1842.

The above plat of township 41 north of the base line, range 10 east of the 3^d principal meridian, is strictly conformable to the field notes of the survey thereof on file in this office, which have been examined and approved. The north boundary was surveyed in the 2^d quarter of 1837, by James Thompson, under contract signed by the Surveyor General on the 21st of November, and by Wm. Thompson, on the 15th of December 1836 - This surveying was paid for in the 1st quarter of 1839, and charged in the account current of the Surveyor General, during the same quarter, Voucher N^o 6 - The South boundary 5 miles 65.30 chains - the west boundary 5 miles 24.62 chains - and the east boundary 5 miles 10.05 chains, were surveyed in the 2^d quarter of 1840 - and the subdivision lines 55 miles 11.36 chains, were surveyed in the 3^d quarter of 1840, all by Wm. L. B. Ewing, under contract of the 23rd of September 1839 - They were paid for in the 2^d and the 4th quarters of 1841, and charged for in the accounts current of the Surveyor General, during three quarters, under the general appropriation for surveying the public lands, Vouchers N^{os} 2 & 19.

Jos. C. Brown
Surveyor of the public lands for
the District of Illinois & Missouri.

Township N. 42 North of the Base line in Range N. 10 East of the 3^d principal Meridian.

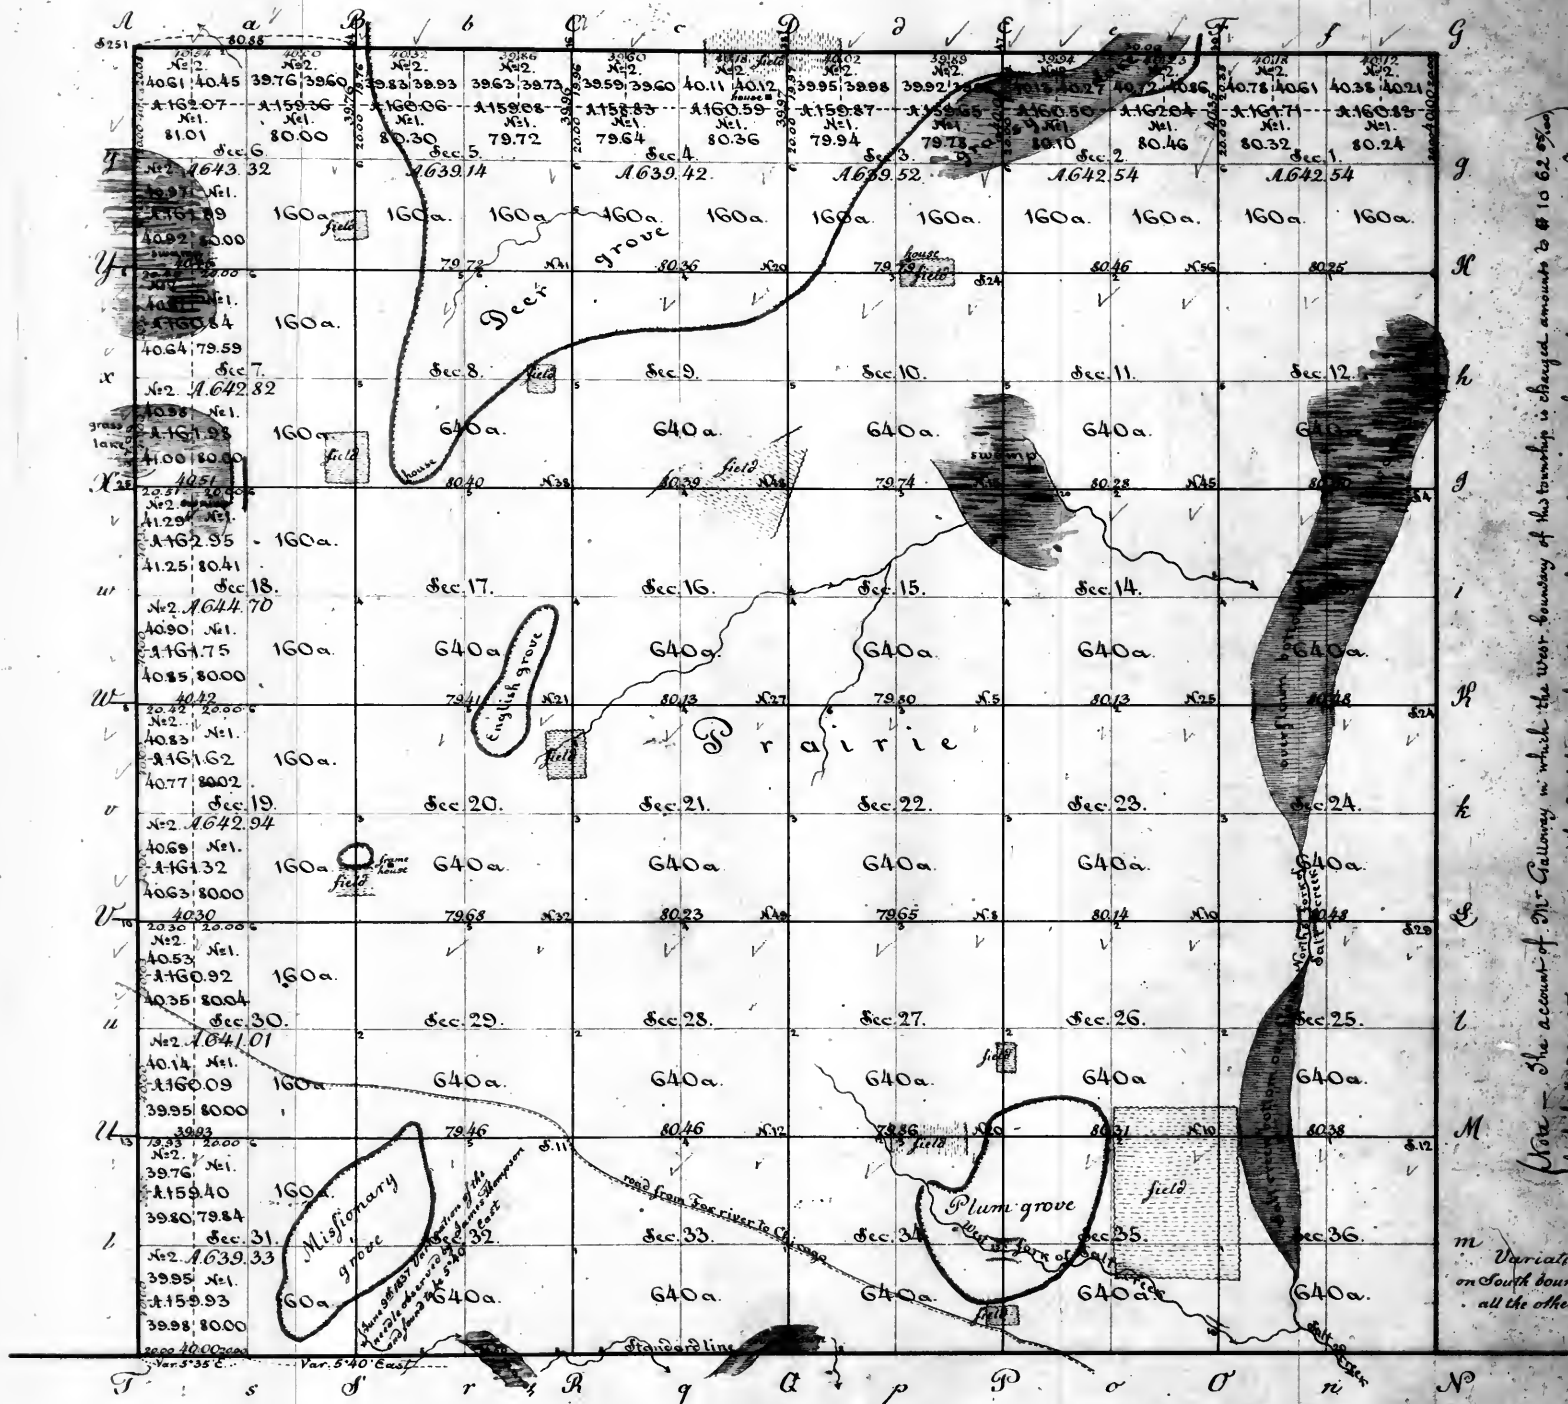

Note - The account of Mr. Galloway in which the West boundary of this township is charged amounts to \$10 62 00 of which \$562 50 were paid on the 2^d of November 1839 - the rest (\$500.) having been paid on the 9th of February of the same year by Daniel Smith, late Surveyor General. (William Melvorn Surveyor of the public lands in Missouri and Wisconsin)

Surveyors Office
Saint Louis 24 June 1840.


Scale of 40 chains to one inch.
Aggregate area 23057.28 acres

The above plat of township 42 north of the base line, range 10 east of the 3^d principal meridian is strictly conformable to the field notes of the survey thereof on file in this office which have been examined and approved. The South boundary 6 miles was surveyed in the 2^d quarter of 1837 by James Thompson, under contract signed by the Surveyor General on the 21st of November and by Mr. Thompson on the 15th of December 1836 - it was paid for in the 1st quarter of 1839, and charged in the account current of the Surveyor General for that quarter - Voucher N. 6 - The West boundary 6 miles was surveyed in the 3^d quarter of 1837, by James Galloway under contract signed by the Surveyor General on the 21st of November, and by Mr. Galloway, on the 15th of December 1836 - it was, to the extent noted in the margin paid for in the 4th quarter of 1839, and charged in the account current of the Surveyor General for that quarter, Voucher N. 4 - The east boundary 6 miles and the north boundary 6 miles and 83 lines, were surveyed in the 2^d quarter of 1838 - and the subdivision line 6 miles 3.98 chains, were also surveyed in the 2^d quarter of 1838 - all by E. C. Berry, under contract dated the 9th of September 1837 - The surveys by Mr. Berry, were paid for in this 2^d quarter of 1840, and they will be charged in the account current of the Surveyor General for said quarter, under the general appropriation for surveying the public lands. Voucher N. 11.

William Melvorn
Surveyor of the public lands in
the States of Illinois and Missouri.

Township No 43 North of the Base line in Range No 10 East of the 3^d pr. Mer.

20

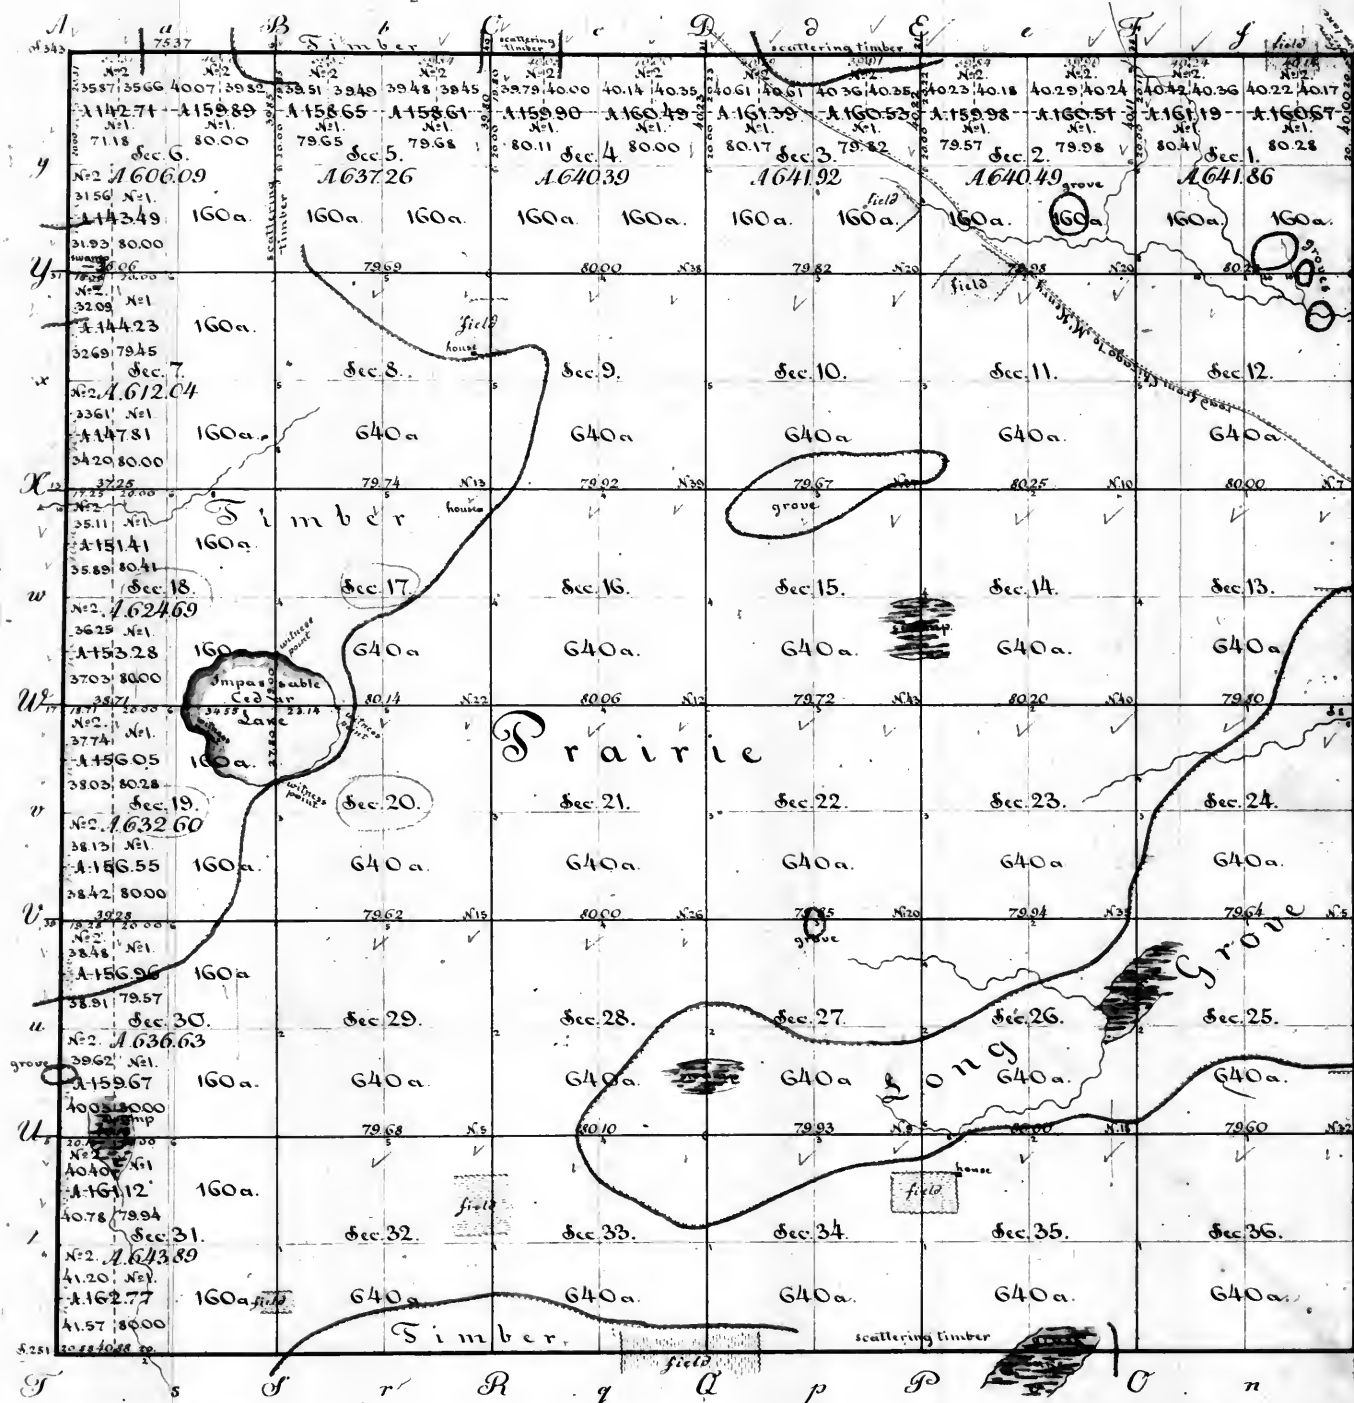

Note: The account of M^r. Gallows, in which the west boundary of this township is charged, amounts to \$1062.50, of which \$562.50 was paid on the 15th of November 1839 - the rest (\$500.00) having been paid on the 1st of February of the same year by Samuel Dunklin, late Surveyor General. William Milburn, Surveyor of the public lands in the State of Missouri.

on West boundary - 6'15" East
on all the other lines 5'45" East.


Surveyors Office,
Saint Louis 24 June 1840.

Scale of 40 chains to one inch.
Aggregate area 22956.86 acres.

The above plat of township 43 north of the base line range 10 east of the 3^d principal meridian is strictly conformable to the field notes of the survey thereof on file in this office which have been examined and approved. The West boundary 6 miles, was surveyed in the 3^d quarter of 1837, by James Gallows, under contract signed by the Surveyor General on the 21st of November 1836, and by M^r. Gallows on the 15th of December of the same year; - it was, to the extent noted in the margin, paid for in the 4th quarter of 1839, and charged in the account current of the Surveyor General for that quarter - Voucher No 4 - The South boundary 6 miles and 38 links, the east boundary 6 miles the north boundary 5 miles 37 chains, and the subdivision lines 59 miles 69.27 chains, were surveyed in the 2^d quarter of 1838, all by C. C. Berry, under contract of the 9th of September 1837 - They were paid for in this 2^d quarter of 1840; and they will be charged in the account current of the Surveyor General, during said quarter, under the general appropriation for surveying the public lands, Voucher No 11.

William Milburn
Surveyor of the public lands in
the States of Missouri and Wisconsin

Township 44 north of the base line, range 10 east of the 3rd principal meridian.

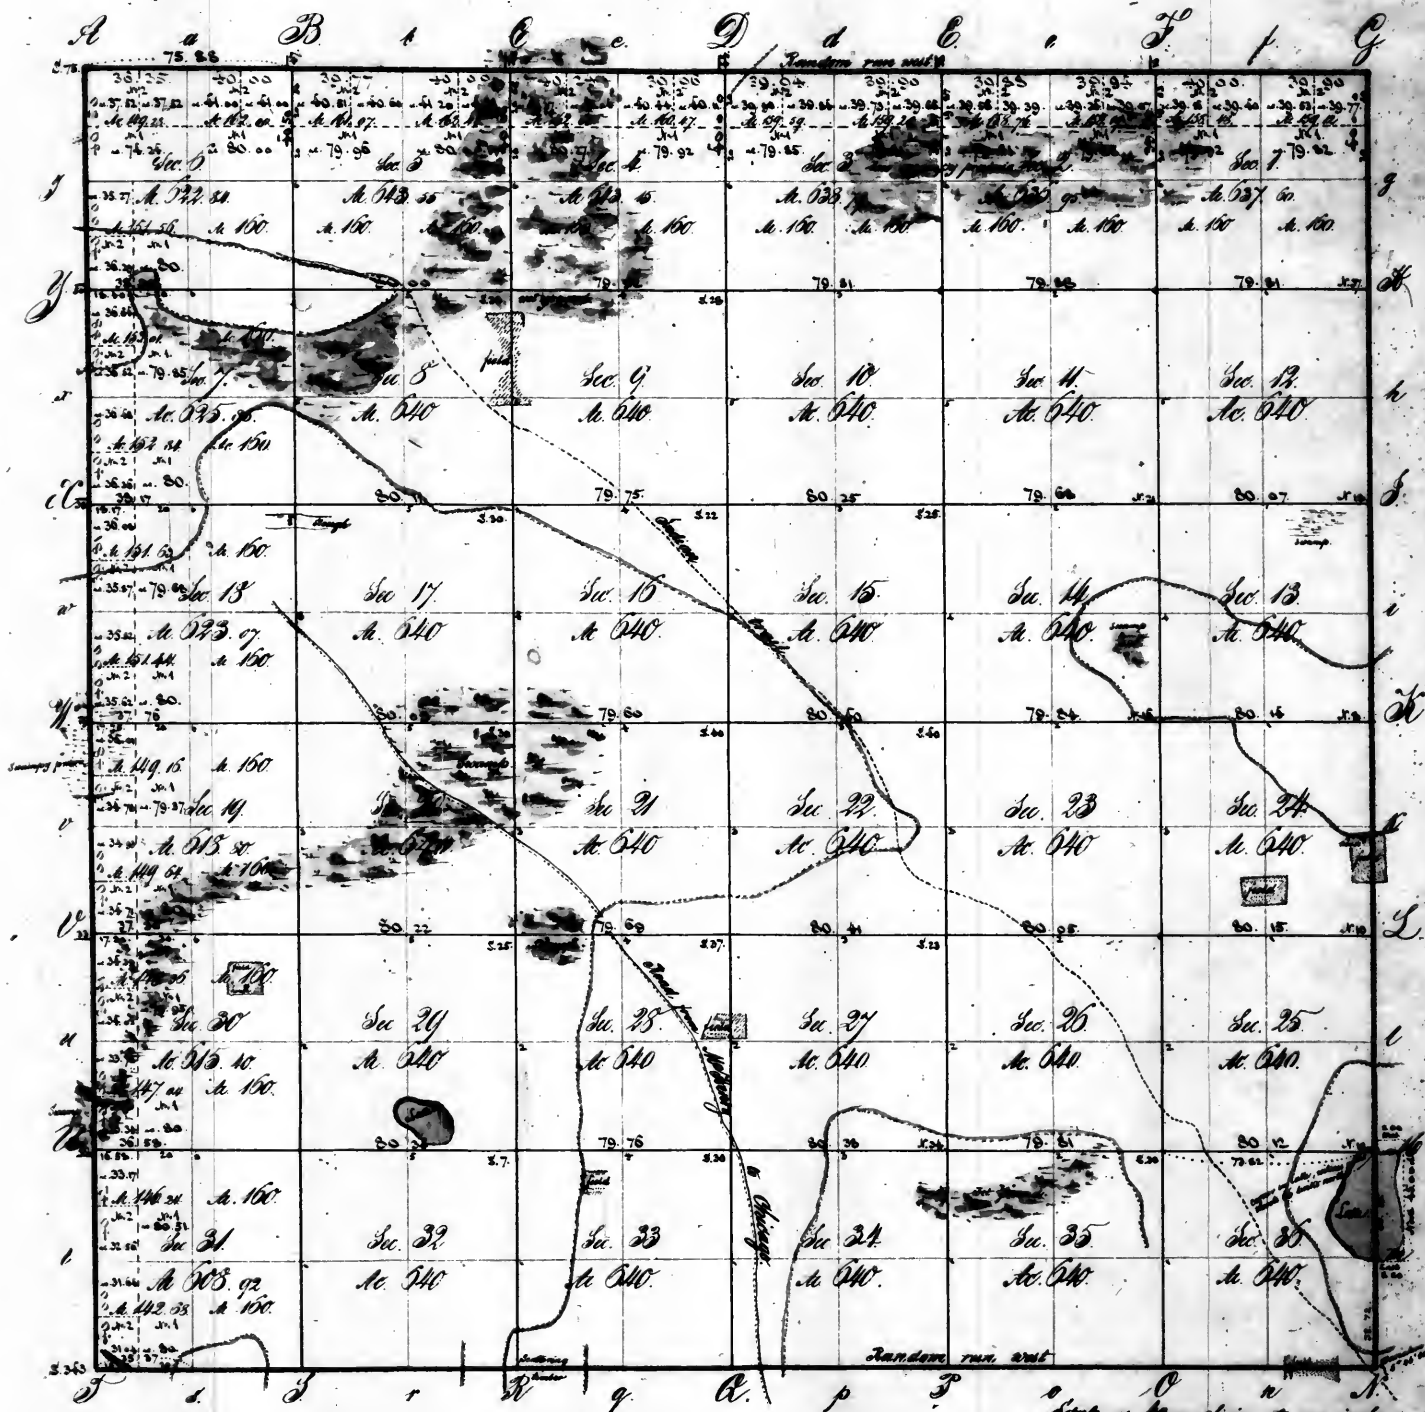

Note—The account of 20th Gallows, in which the west boundary of this township is charged amounts to \$1062.05, of which \$562.95, was paid on the 23rd of November 1839—the rest (\$500.00) having been paid on the 3rd of February of the same year by Daniel Dinklin, late Surveyor General.

William Milburn
Surveyor of public lands

Variation.
West boundary 6° 10' east
East, North and South boundaries
no variation less 5° 16' east.

Surveyor's Office.
Saint-Louis 24 June 1840.



The above plat of township 44 north of the base line, range 10 east of the 3rd principal meridian is strictly conformable to the field notes of the survey thereof on file in this office which have been examined & approved. The west boundary 6 miles was surveyed in the 3rd quarter of 1837, by James Gallows, under contract signed by the Surveyor General on the 21st of November, and by R. Gallows, on the 15th of December 1836:—it was, to the extent noted in the margin paid for in the 4th quarter of 1839, and charged in the account current of the Surveyor General for said quarter, voucher 76:4—The south boundary 5 miles 75.37 chains—the east boundary 6 miles—the north boundary 5 miles 75.38 chains—and the subdivision lines 59 miles 62.04 chains, were surveyed in the 2nd quarter of 1838—all by E. C. Berry, under contract of the 9th of September 1837.—They were paid for in this 2nd quarter of 1840; and they will be charged in the account current of the Surveyor General, during said quarter, under the general appropriation for surveying the public land.—Voucher 76:11.

William Milburn
Surveyor of the public lands in

Township 45 North of the base line Range 10 East of the 3d principal Meridian

22

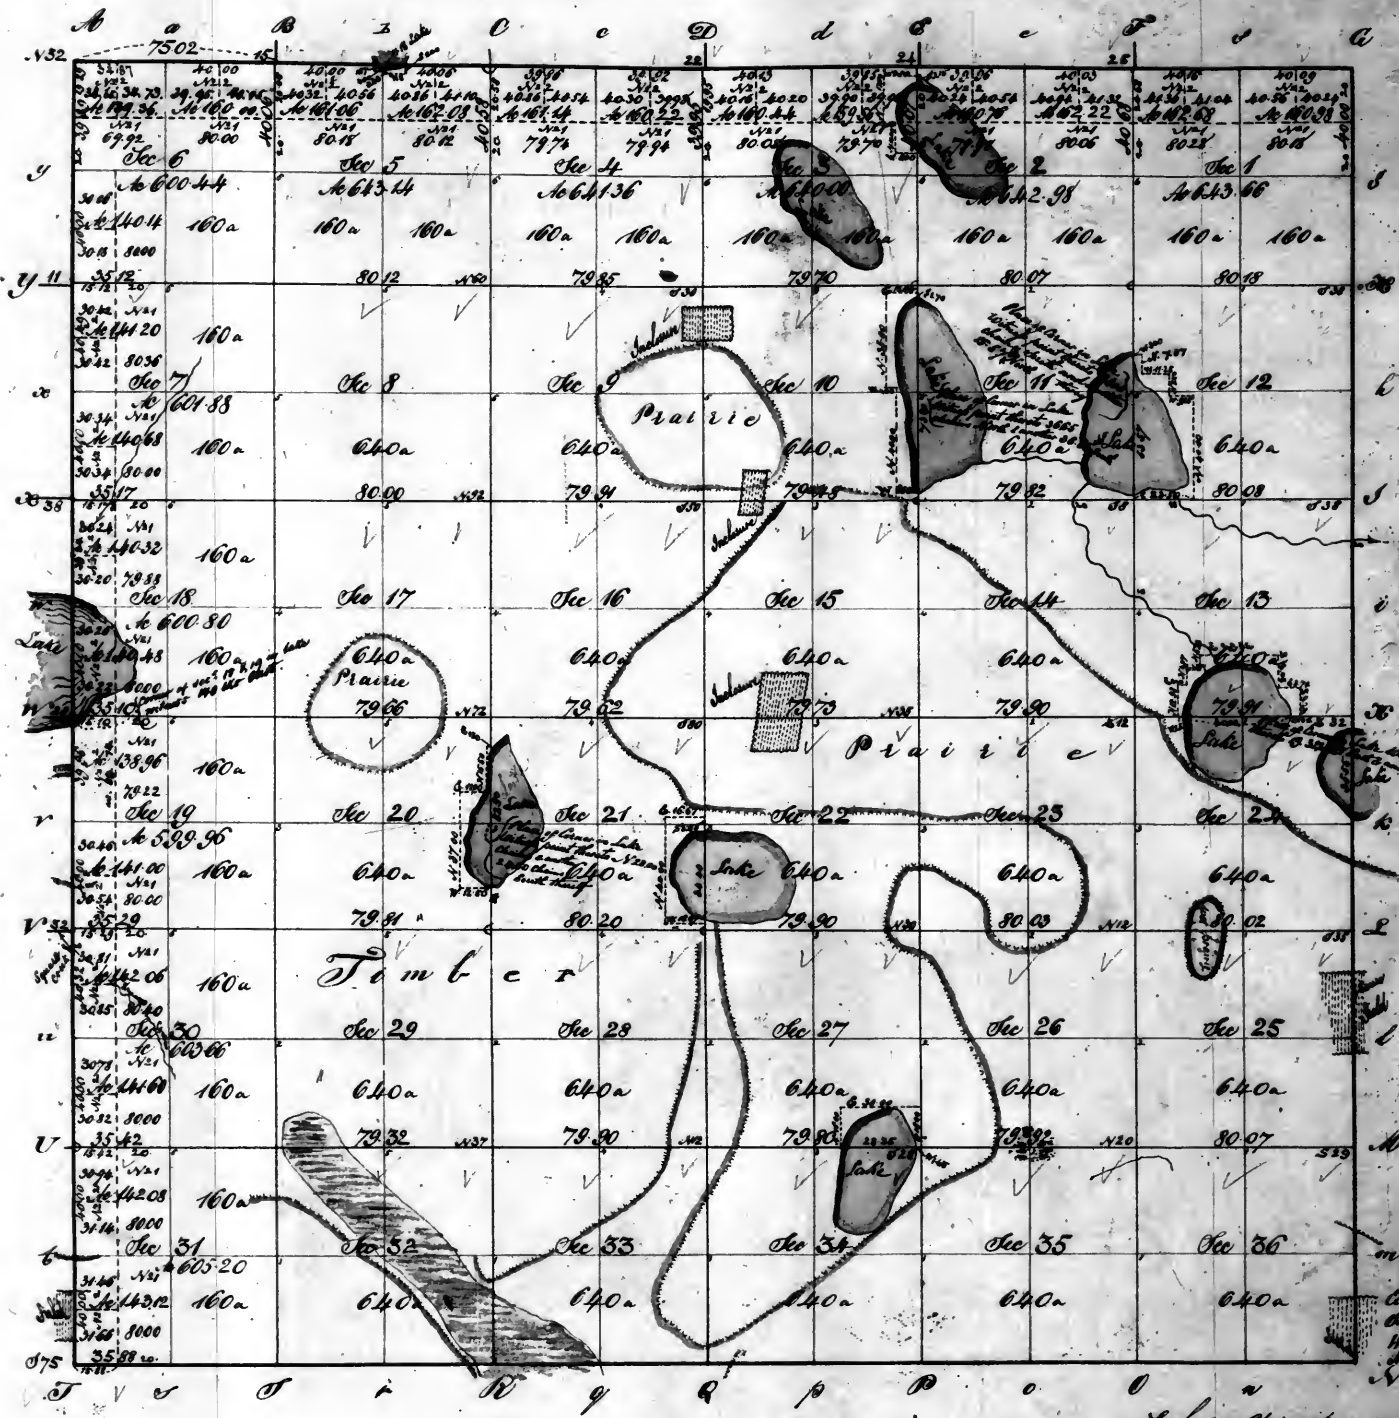

Note: The account of Dr. Galloway in which the west boundary of this township is charged, amounts to 1062.65 a., of which \$562.99 was paid on the 25th of November 1838 - the remainder of the account, \$500.00, having been paid on the 9th of February 1839, paid to Dr. Galloway by General Galloway, late Surveyor General.

William Milburn
Surveyor of the public lands
in the State of Illinois

Surveyors Office.
St. Louis 8th of December 1840.

Scale of 30 chains to an inch
Aggregate Area - 22825.08 acres.


The above plat of township 45 north of the base line, range 10 east of the 3d principal meridian, is truly conformable to the field notes of the survey thereof on file in this office which have been examined and approved. - The South boundary 5 miles 75.38 chains, was surveyed in the 2d quarter of 1838, by C. C. Derry, under contract of the 9th of September 1837 - it was paid for in the 2d quarter of 1840, and charged in the account current of the Surveyor General for that quarter, Voucher No. 11. - The west boundary 6 miles, was surveyed in the 4th quarter of 1838, by James Galloway, under contract signed by the Surveyor General on the 21st of November, and by Galloway on the 15th of December 1838 - it was, to the extent noted in the margin, paid for in the 4th quarter of 1839, and charged in the account current of the Surveyor General. During the said quarter, Voucher No. 12. The east boundary 6 miles, the north boundary 5 miles 75.02 chains, and the subdivision lines 59 miles 54.44 chains, were surveyed in the 3d quarter of 1840, by George W. Harrison, under instructions of the 17th of February 1840 authorizing said Harrison to complete the unfinished abovementioned contract of C. C. Derry, of the 9th of September 1837 - The survey by Harrison was paid for in this 4th quarter of 1840, and they will be charged in the account current of the Surveyor General, during the said quarter, under the general appropriation for surveying the public lands, Voucher No. 12.

William Milburn
Surveyor of the public lands
in the State of Illinois

[Signature]

Township 46 North of the base line Range 10 East of the 3^d principal Meridian.

T. 1 N. (of the Wisconsin survey) R. 20. E. of the 4th p. M. T. 1 N. (of the Wisconsin survey) R. 21. E. of the 4th p. M.
 Meridian 6° East Mer. 5° 30' E

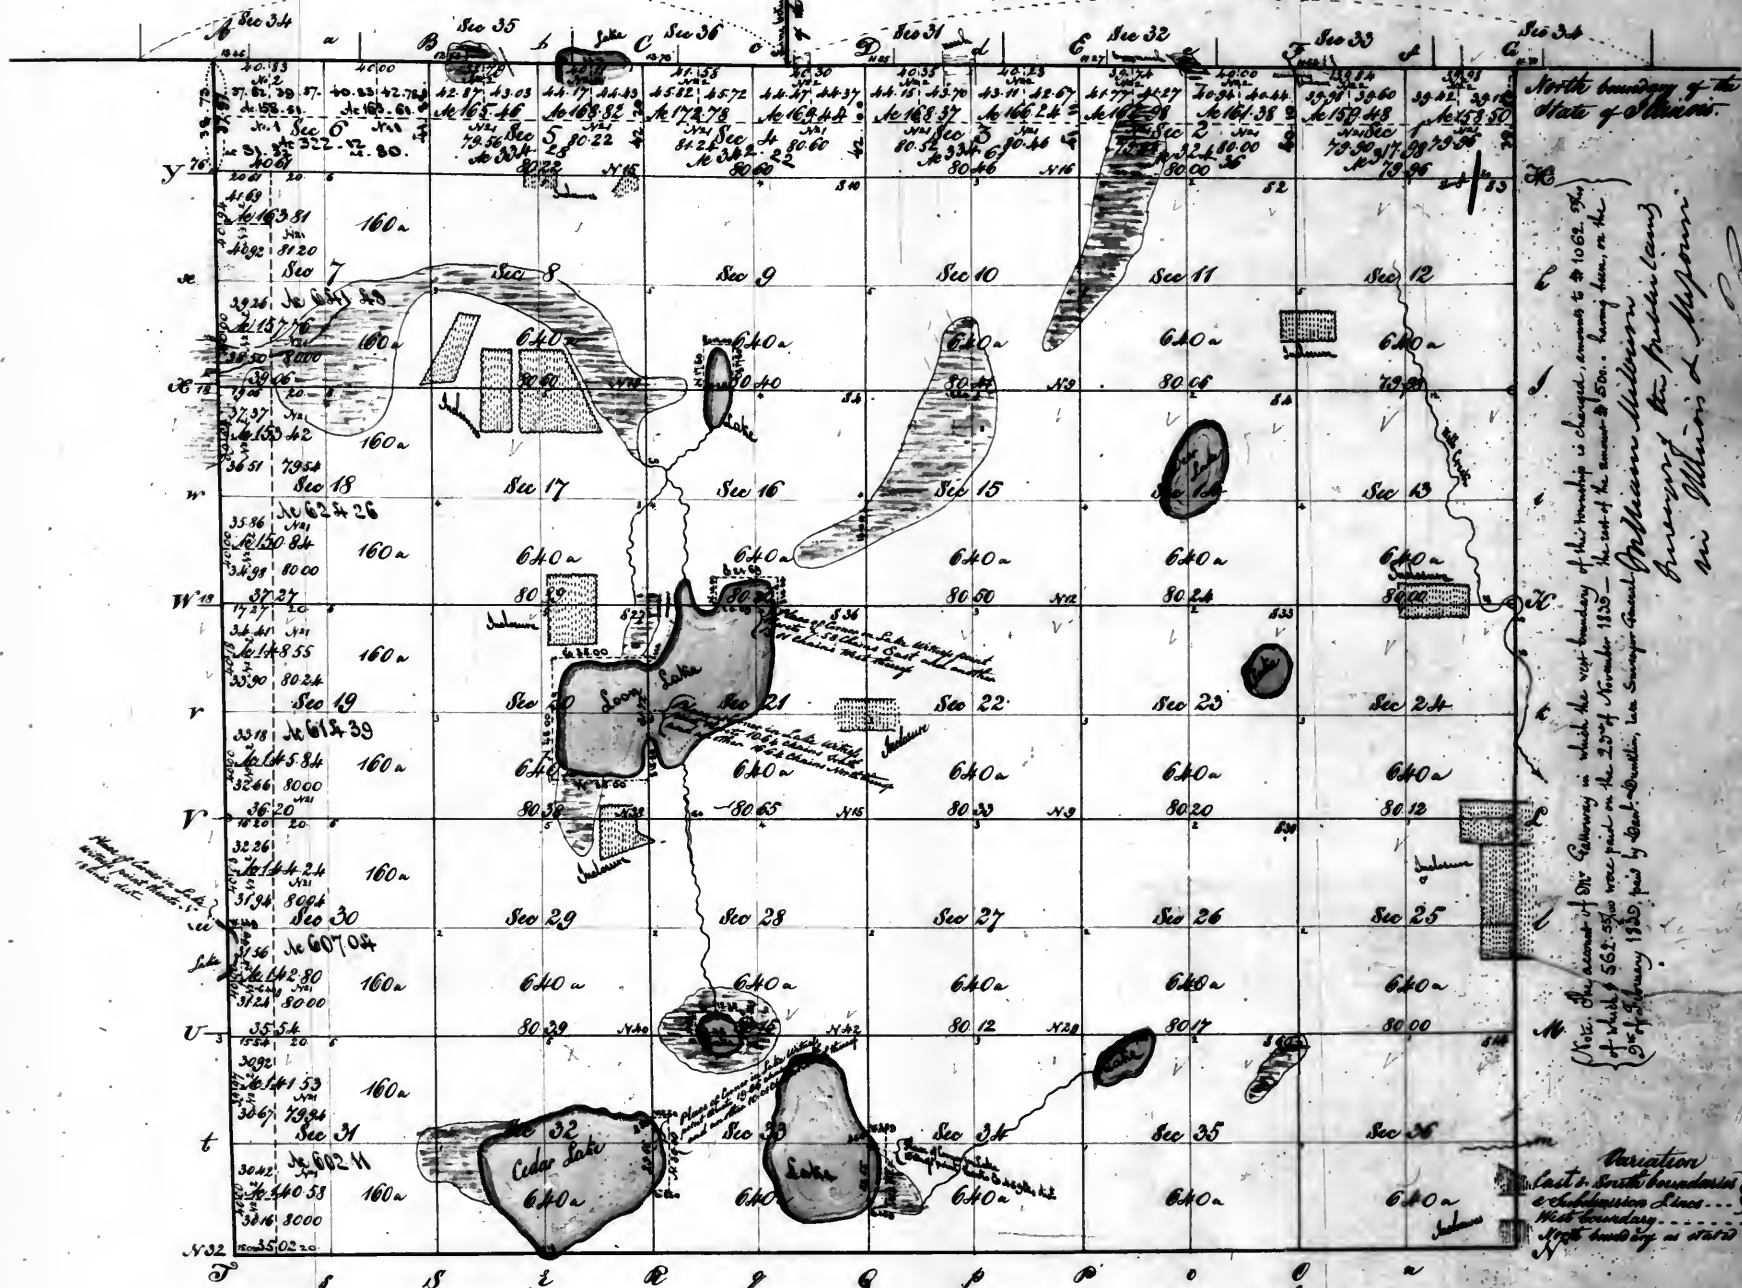

Surveyors Office.
 Saint Louis 8th of December 1840.

The above plan of Township 46 north of the base line, range 10 east of the 3^d principal meridian, is strictly conformable to the field notes of the Survey thereof on file in this office, which have examined and approved. The North boundary was surveyed in 1832 & 1833 by Lucius G. Combs on the part of the United States, as certified by A. J. Williams, Surveyor General of Ohio, Indiana & Michigan; the said line being a part of the treaty between Illinois and Michigan, now Wisconsin; the west boundary was surveyed in the 4th quarter of 1833, by James Gallows, under contract signed by the Surveyor General on the 21st of November, and by Gallows on the 15th of December 1836; it was to the extent noted in the margin paid for in the 4th quarter of 1839, and charged in the account current of the Surveyor General during the said quarter, Voucher N^o 4; The South boundary 5 miles 75.02 chains, the east boundary 5 miles 33.50 chains; and the Subdivision lines 57 miles 43.16 chains, were surveyed in the 3^d quarter of 1840, by George W. Harrison, under instructions of the 17th of February, 1840, authorizing said Harrison to complete the unfinished contract of G. C. Berry of the 5th of September 1837. These surveys by Harrison were paid for in the 4th quarter of 1840, and they will be charged in the account current of the Surveyor General; during the said quarter, under the general appropriation for surveying the public lands, Voucher N^o 12.

William Milburn
 Surveyor of the public lands in
 the States of Illinois and Wisconsin.

North boundary of the State of Illinois.
 (Note: The account of Dr. Gallows in which the west boundary of this township is charged, amounts to \$1062.50, of which \$562.50 was paid on the 25th of November 1833 - the rest of the amount \$500.00 being due, on the 5th of February 1839, paid by Genl. Dutton, late Surveyor General of Illinois.)
 Survey of the public lands in Illinois & Wisconsin.


Variation
 East to North boundaries... 5.40 chains
 North boundaries... 6.40 chains
 West boundary... 6.40 chains
 North boundary as stated on the map.

Scale of 40 chains to an inch
 Aggregate Area - 21064.85 acres.

Fractional Township 27 North of the base line Range 11 East of 3^d principal Meridian

17

24

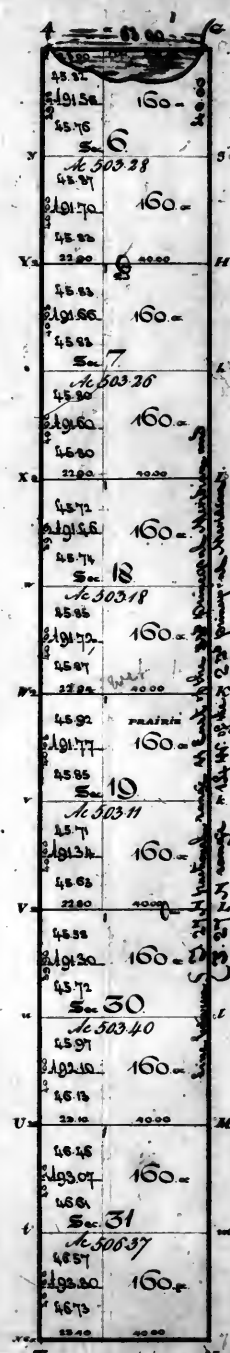

Variation
North boundary and subdivision line - 7° 30' East
West boundary - 7° 38' East
South & East boundary not stated in field notes.

(Note: The amount of 20th Envy in which the surveying of this section is charged amounts to \$4.25, of which \$4.00 was paid on the 22nd of February 1840 - the rest (\$0.25) having been paid by C. J. Longham, from Surveyor General William Melbourne.)

Surveyors Office
St. Louis, 26 March 1840


Aggregate Area - 3022.50 acres

The above plat of Fractional Township 27 North of the base line Range 11 East of 3^d principal Meridian is hereby confirmed to the first notes of the survey thereof in file in this Office, which have been examined and approved. The said boundary 63 chains and 40 links was surveyed in 1832, by W. S. Hamilton and Chas. Smith, under contract of 15th of March 1831. The west boundary 6 miles was surveyed in the 4th quarter of 1832; by J. B. McCall, under contract of the 15th of April 1831. The west boundary 6 miles, and the north boundary 63 chains, were surveyed in the 4th quarter of 1833, and the subdivision line 3 miles, 74.64 chains, were surveyed in the 3^d quarter of 1834 - all by William Lee D. Envy, under contract of the 15th day of August 1833. The survey by Envy, was, to the extent noted in the margin, paid for on the 22nd of February 1840; and they will be charged in the account current of the Surveyor General for the present quarter (being the 1st quarter of 1840) under the general appropriation for surveying the public lands, Voucher No. 7.

William Melbourne
Surveyor of the public lands in

Fractional Township 28 North of the base line Range 11 East of 3^d principal Meridian

25

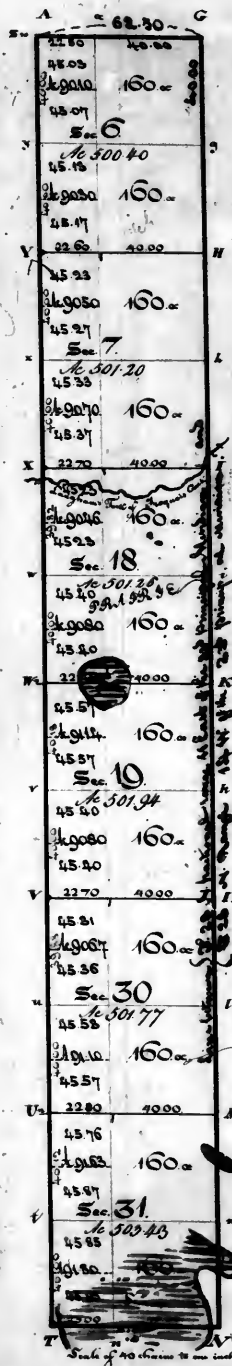

North line of land boundaries and subdivisions lines
North boundary


William Milburn

Aggregate Area - 3040.00. acres


Surveyors Office
St. Louis, Mo. March 1840.

The above plat of fractional Township 28 North of the base line Range 11 East of 3^d principal Meridian is strictly conformable to the field notes of the survey thereof on file in this Office, which have been examined and approved. The north boundary 62.50 chains, the west boundary 6 miles - the south boundary 6 chains, and the east boundary 6 miles, were surveyed in the 4th quarter of 1833 - and the subdivisions lines 3 miles 70.50 chains were surveyed in the 3^d quarter of 1834, all by William J. D. Erving, under contract of the 15th day of August 1833 - they were to the actual notes in the margin, paid for on the 22^d day 1840; and they will be charged in the account current of the Surveyor General for the present quarter (being the 1st quarter of 1840) under the general appropriation for surveying the public lands, Chapter 21.

William Milburn
Surveyor of the Public Lands
in the State of Illinois & Missouri

Fractional Township 29 North of the base line Range 11 East of 3rd principal Meridian

26

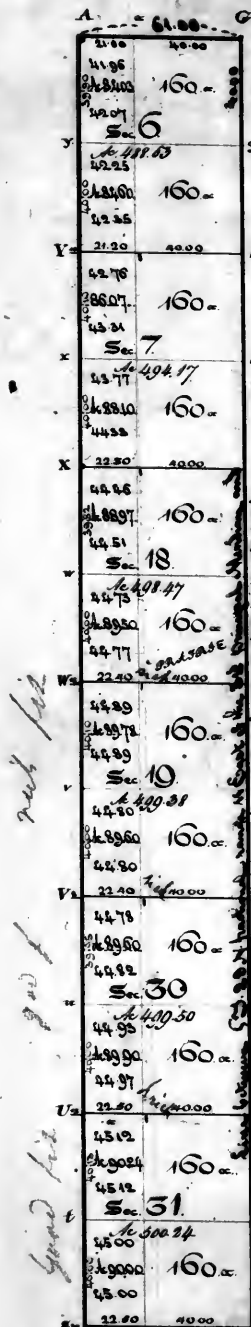

Scale of 10 chains to an inch.
Aggregated area - 2880.59 acres.

Surveyors Office
St. Louis 20th March 1870

The above Part of fractional Township 29 North of the base line Range 11 East of 3rd principal Meridian is hereby confirmed to the field notes of the survey, made in this Office, which have been examined and approved. The whole boundary 62 chains 350 rods. The east boundary 6 miles, with survey in the 4th quarter of 1855 - the west boundary 6 miles, and the north boundary 61 chains were surveyed in the 2nd quarter of 1854 - and the subdivision lines 3 miles 70.50 chains, were surveyed in the 3rd quarter of 1854 - all by William M. Milburn, being under contract of the 15th day of August 1853 - they were to the cash notes in the margin paid for on the 22nd of February 1860; and they were to be changed in the account current of the Surveyor General for the present quarter (being the 1st quarter of 1860) under the general appropriation for surveying the public lands, Voucher N^o 7.

William M. Milburn
Surveyor of the public lands in the States
of Illinois and Michigan

(Note. The account of 711th Entry in which the surveying of this fractional township is charge amounts to \$2425.15, of which \$605.25 was over paid in the 22nd day of February 1860 - the rest (\$1820.90) having been paid by Elias J. Chapman, James Dwyer, Samuel.

William M. Milburn

27



Scale of 40 chains to an inch.
Aggregate Area = 2931.00. acres

Variation
 East to back boundary ----- } 7. 20 East
 Subdivision line ----- } 7. 35 East
 Well boundary ----- } 7. 00 East
 North boundary ----- }


William Mulburn

Surveyors Office
St. Louis 10th March 1840.


Surveyors Office
St. Louis 26th March 1840.



William McBurn
Surveyor of the Public Lands in
the States of Illinois & Missouri.

Surveyor of the Public Lands in
the States of Illinois & Wisconsin

MAP
OF
LANGHAM'S ISLAND
T 31 N. R 11 E. 32 P.M.
Area 12.39 A.

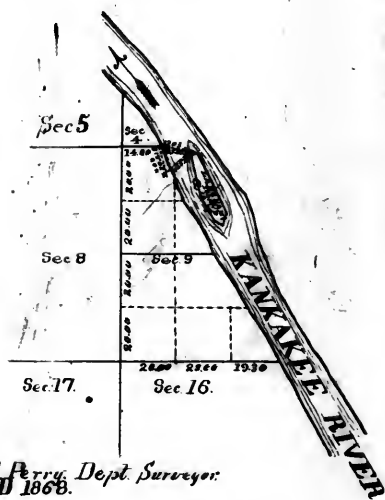

| Meanders around
Langham's Island | | | |
|-------------------------------------|--------------|-------|------|
| Post | Course | Dist. | Like |
| | S 10 1/2° E. | 6 | 23. |
| | S 15° 17' E. | 12 | 31 |
| | S 30° 39' E. | 4 | 24 |
| | S 32° 50' E. | 5 | 08 |
| | S 51° 43' E. | 3 | 50 |
| | N 16° 39' E. | 4 | 27 |
| | N 24° W. | 9 | 05 |
| | N 25° 20' W. | 7 | 96 |
| | N 31° 51' W. | 5 | 30 |
| | N 37° 51' W. | 2 | 45 |

Surveyed by Thos. H. Perry, Dept. Surveyor,
on the 4th day of June A.D. 1868.

Variation of the Needle 6° 55'

Scale 40 chains = 1 inch


General Land Office,
Washington D.C. August 18th 1868
The above Diagram of Langham's Island, in Kankakee River,
in Sec. 9 Town 32 N. R 11 E. 32 P.M. State of Illinois, is strictly
conformable to the field notes of the survey thereof on file in this
Office, which have been examined and approved.

[Signature]

Commissioner and Ex-Officio
Surveyor General of Illinois.

Township 31 North of the base line, Range 11 East of the 3^d principal meridian.

28

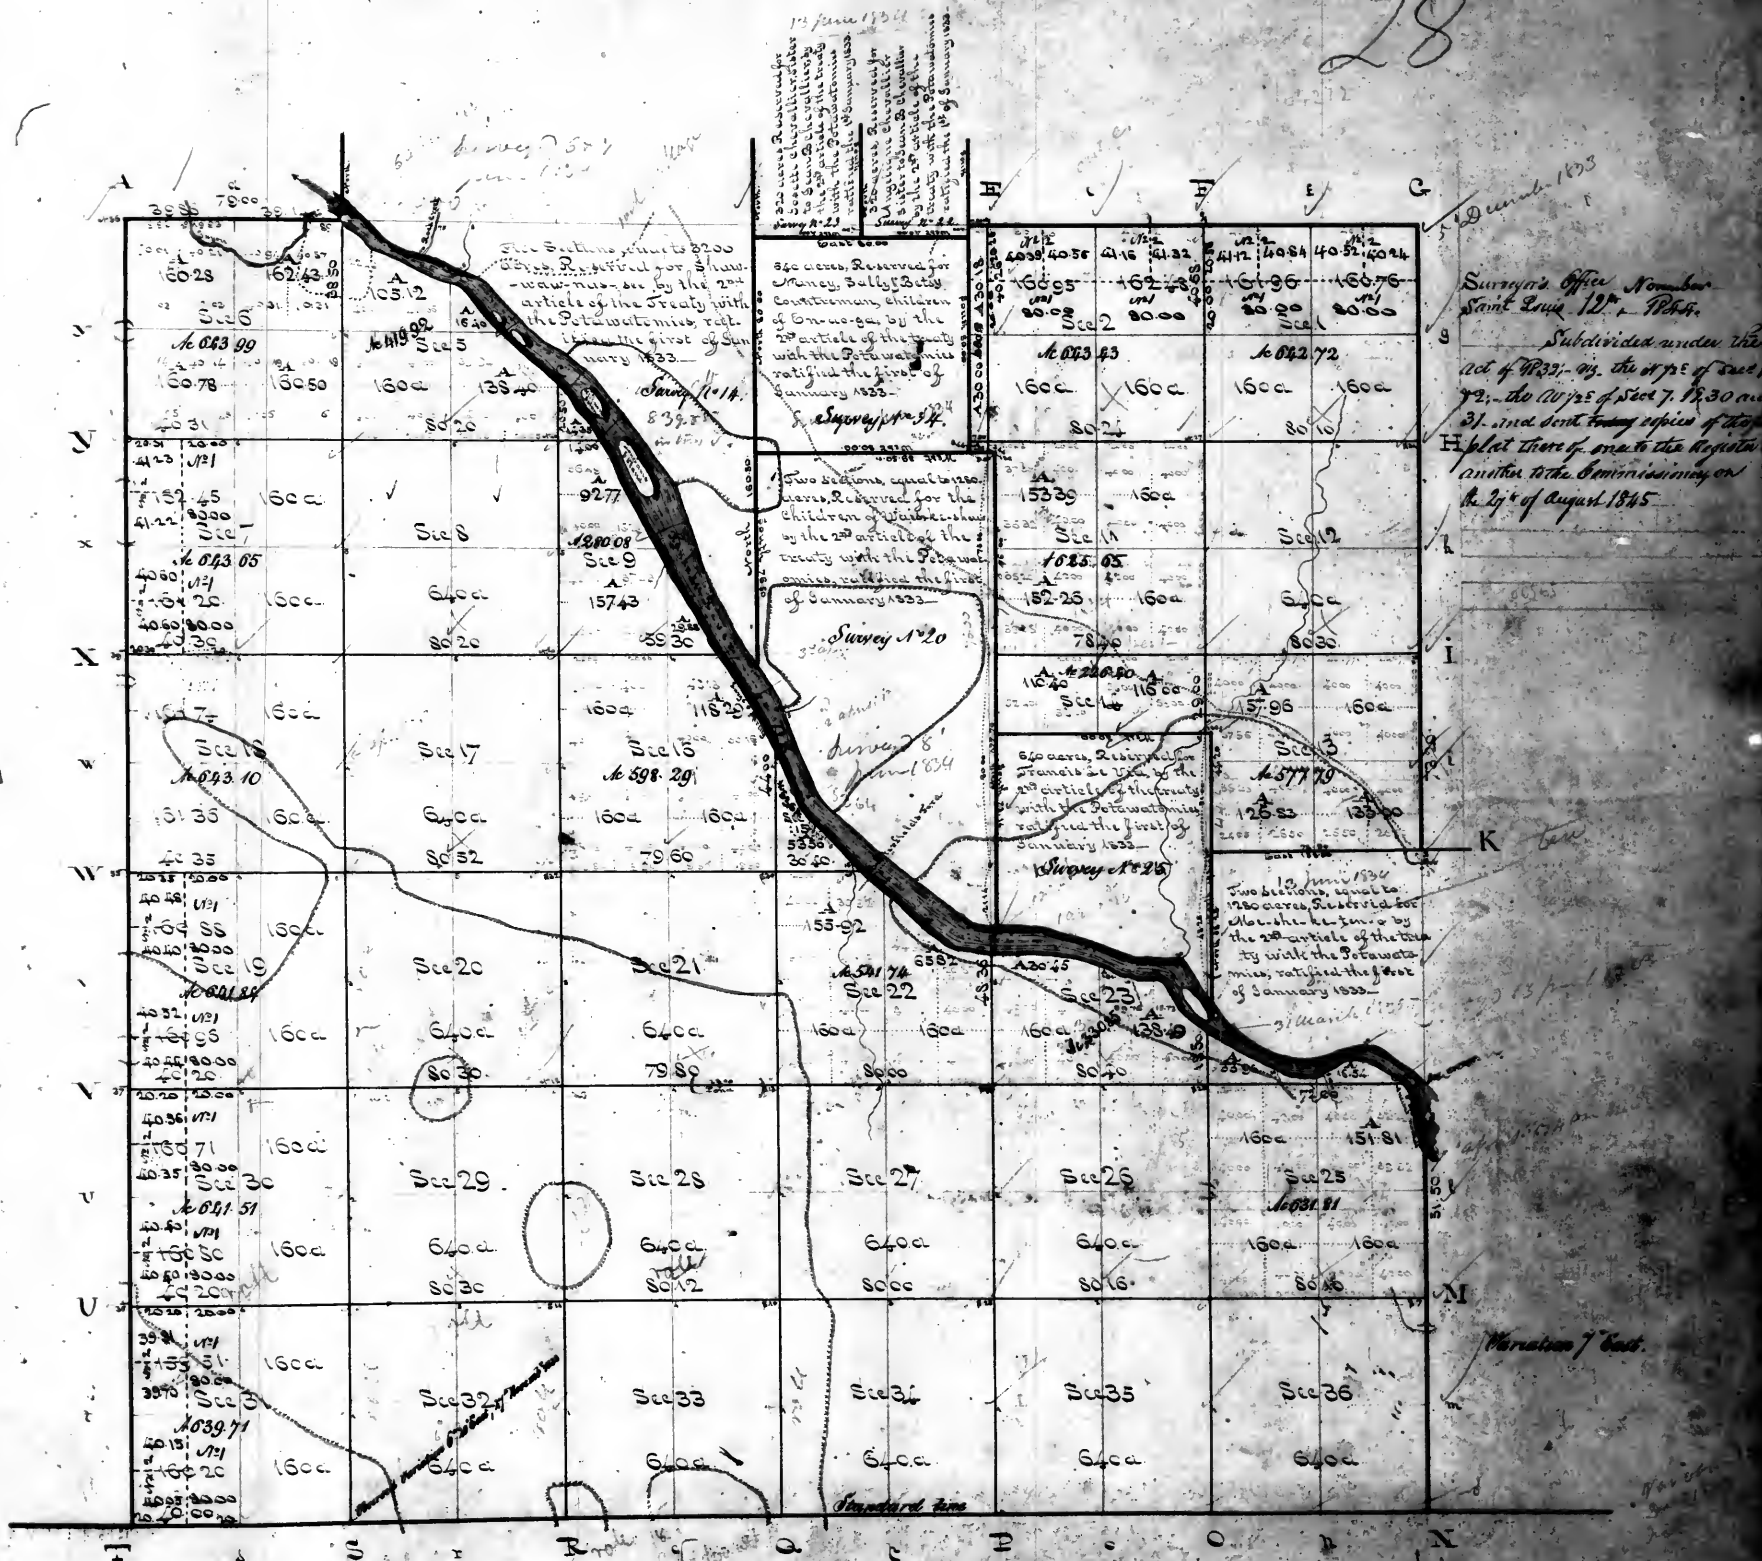

Surveyor's Office, St. Louis, Mo.
Subdivided under the
act of 1837, by the 17th of sec. 1,
72, the 10th of sec. 7, 1830 and
31, and sent to the register
and to the Commissioner on
the 24th of August 1845.

Surveyor General's Office.
St. Louis 16th August 1849.


Public Land 155371 acres
Indian Reservations 1019.19 acres
Total 22532.90 acres

The above plat of Township 31 North of the base line, range 11 East of the 3^d principal meridian is truly conformable to the field notes of the Survey thereof on file in this office, which have been examined and approved. The exterior boundary lines were surveyed on the 4th quarter of 1830. The sectional lines, Indian reservations, and meanders on the 1st and 2^d quarters of 1844, all by Genl. W. Beckwith under orders of the 28th of October 1830.

William Milburn
Surveyor General
D.

Sec. N. P. M. Eng. & P. M.

new plat

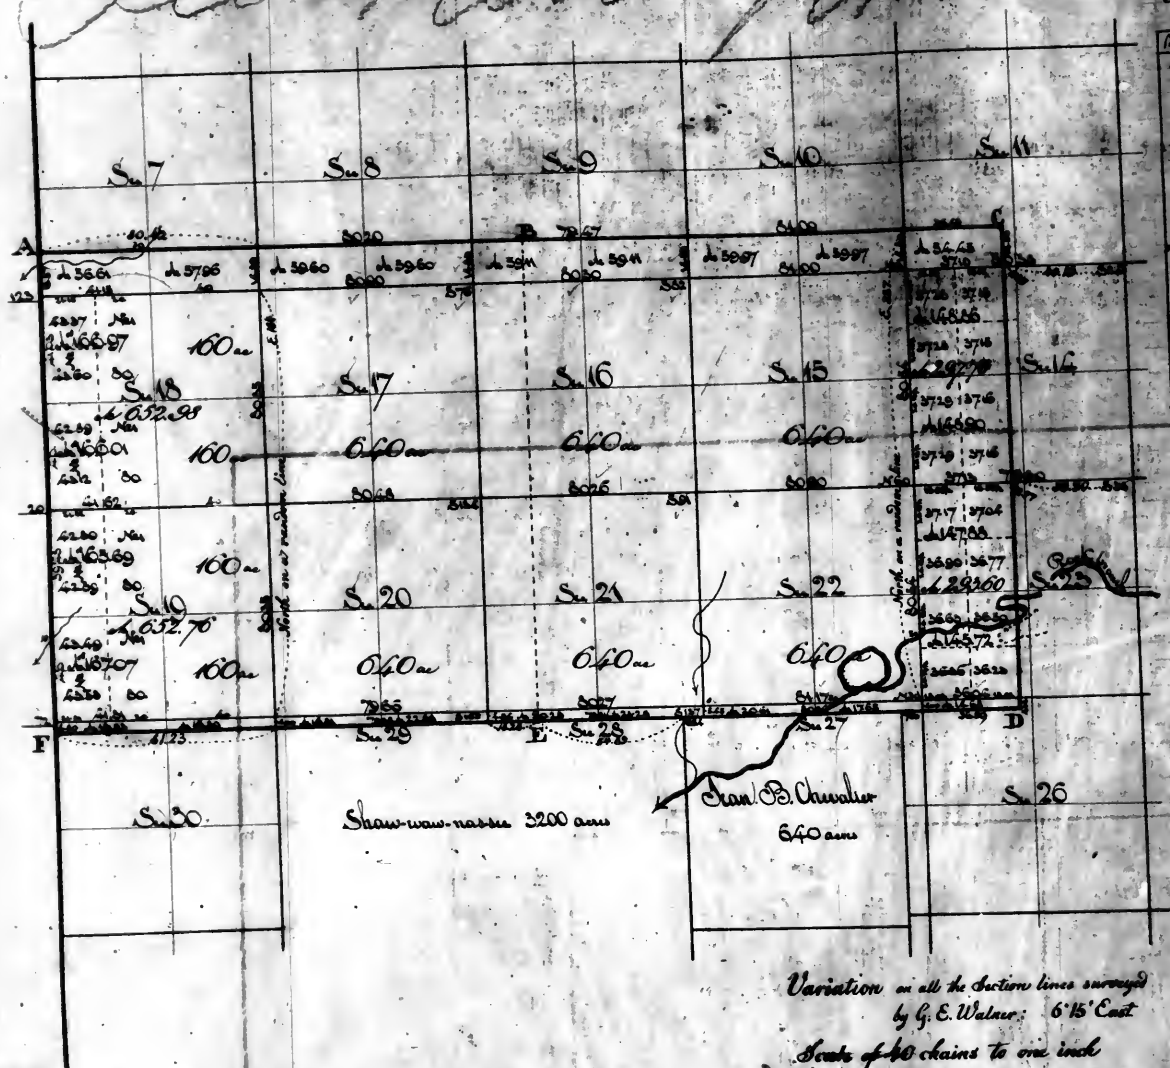

Statements referred to in the certificate to this plat.

Variation in all the section lines surveyed by G. E. Walker: 6' 15" East
Scale of 40 chains to one inch


Surveyor's Office, Saint Louis 26th of July 1844.

The above plat of sections 15, 16, 17, 18, 19, 20, 21, 22, and parts of sections 7, 8, 9, 10, 11, 14, 23, 24, 25, 26, 27, 28, by H. 30, within the lines A, C, D, E, in township 32 north of the base line, range 11 east of the 3^d principal meridian, is strictly conformable to the field notes of the survey thereof on file in this office which have been examined and approved. The township was formerly subdivided, and the Indian reservations therein laid out, in the 3^d quarter of 1834, by David, to Red Jacket, under contract of the 29th of October 1833. The lines A, B, C, D, E, represent the survey of the five sections of land, reserved for Wah-pa-ah in the prairie near Rock village, by the 2^d article of a treaty made & concluded at Camp Dispersal in the State of Indiana, on the 20th of October 1832, between the Commissioners of the United States and the Chiefs and Headmen of the Potawatamie tribe of Indians of the Prairie and Kankakee, and the lines B, C, D, E, show the survey of the five sections of land reserved for Quia-gui-tio in the prairie near Rock village by the 2^d article of the same treaty. On the 11th of September 1840, the Commissioner of the General Land Office, informed the Surveyor General, at Saint Louis, that the Indian title had been relinquished to the two above reservations, and instructed him to have the lands within the lines hereby laid out as public land by extending through them the lines of the public survey, closing thereon. In consequence of these directions, Geo. E. Walker, under instructions of the 4th of August 1843, surveyed in September of the same year, the lines delineated in the margin of this plat. 23 miles. 45.77 chains, which were paid for in the 1st quarter of 1844, and charged on the account current of the same quarter, under the general appropriation, Voucher N^o 2.

Silas Reed
Surveyor of the public land in the
State of Illinois & Missouri.

Township 32 North of the base line, Range 11 East of the 3^d principal meridian

Vol 35 page 08

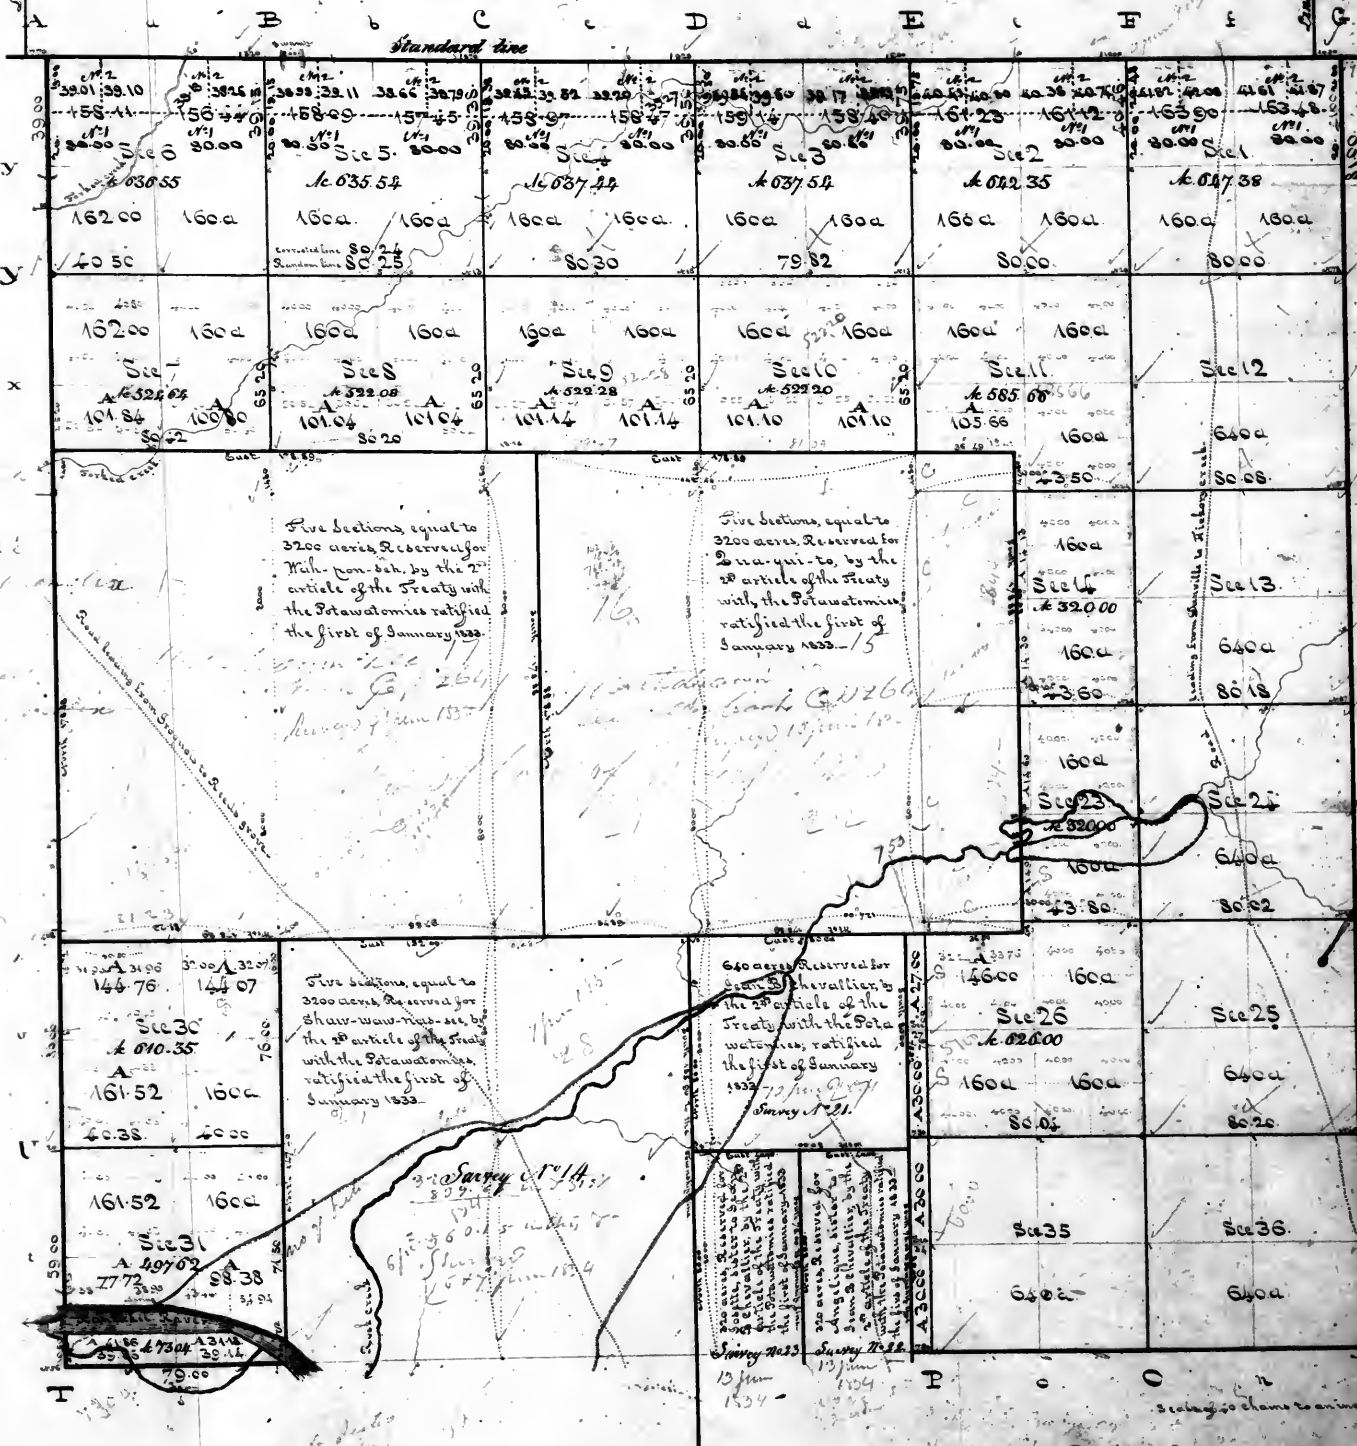

For statement of value of land reserved for the Shawnee Indians, see letter of 22 July 1863 from Register at Chicago
 Surveyor's Office
 Saint Louis 17th March
 Old division under the 1st of 1832, viz. the 1st of 1832, 2, 3, 4,1000.

Surveyor General's Office
 Saint Louis 16th August 1853.

Public Land 12975.62 acres
 Indian Reservations 10008.15 acres
 Total 22983.77 acres

The above plat of Township 32 north of the base line range 11 east of the 3^d principal meridian is strictly conformable to the field notes of the survey thereof on file in this Office, which have been examined and approved. The north boundary was surveyed in the 2^d quarter of 1854 by Don Alonzo Spaulding, under contract of the 3^d of October 1853. The south boundary was surveyed in the 3^d quarter of 1853 by Don Alonzo Spaulding, under contract of the 3^d of October 1853. The west boundary in the 1st and 2^d quarters of 1854 and the east boundary the subdivision lines, meanders and Indian reservations in the 2^d quarter of 1854, all by Genl W. Beckwith, under contract of the 29th of October 1853.


William McIlwain
 Surveyor General

The Section lines through the plat are in accordance with the instructions of the 7th of July 1853 by G. E. Wolcott in Sept. 1853 in the instructions of the 7th of July 1853 by G. E. Wolcott I p. 271

Fractional Township 33 North of the base line Range 11 East of 3rd principal Meridian

Plot of T. 33 N. R. 11 E. N.W. of old Ind. l^y annexed to
plot of T. 33 N. R. 10 E. N.W. of old Ind. l^y

30

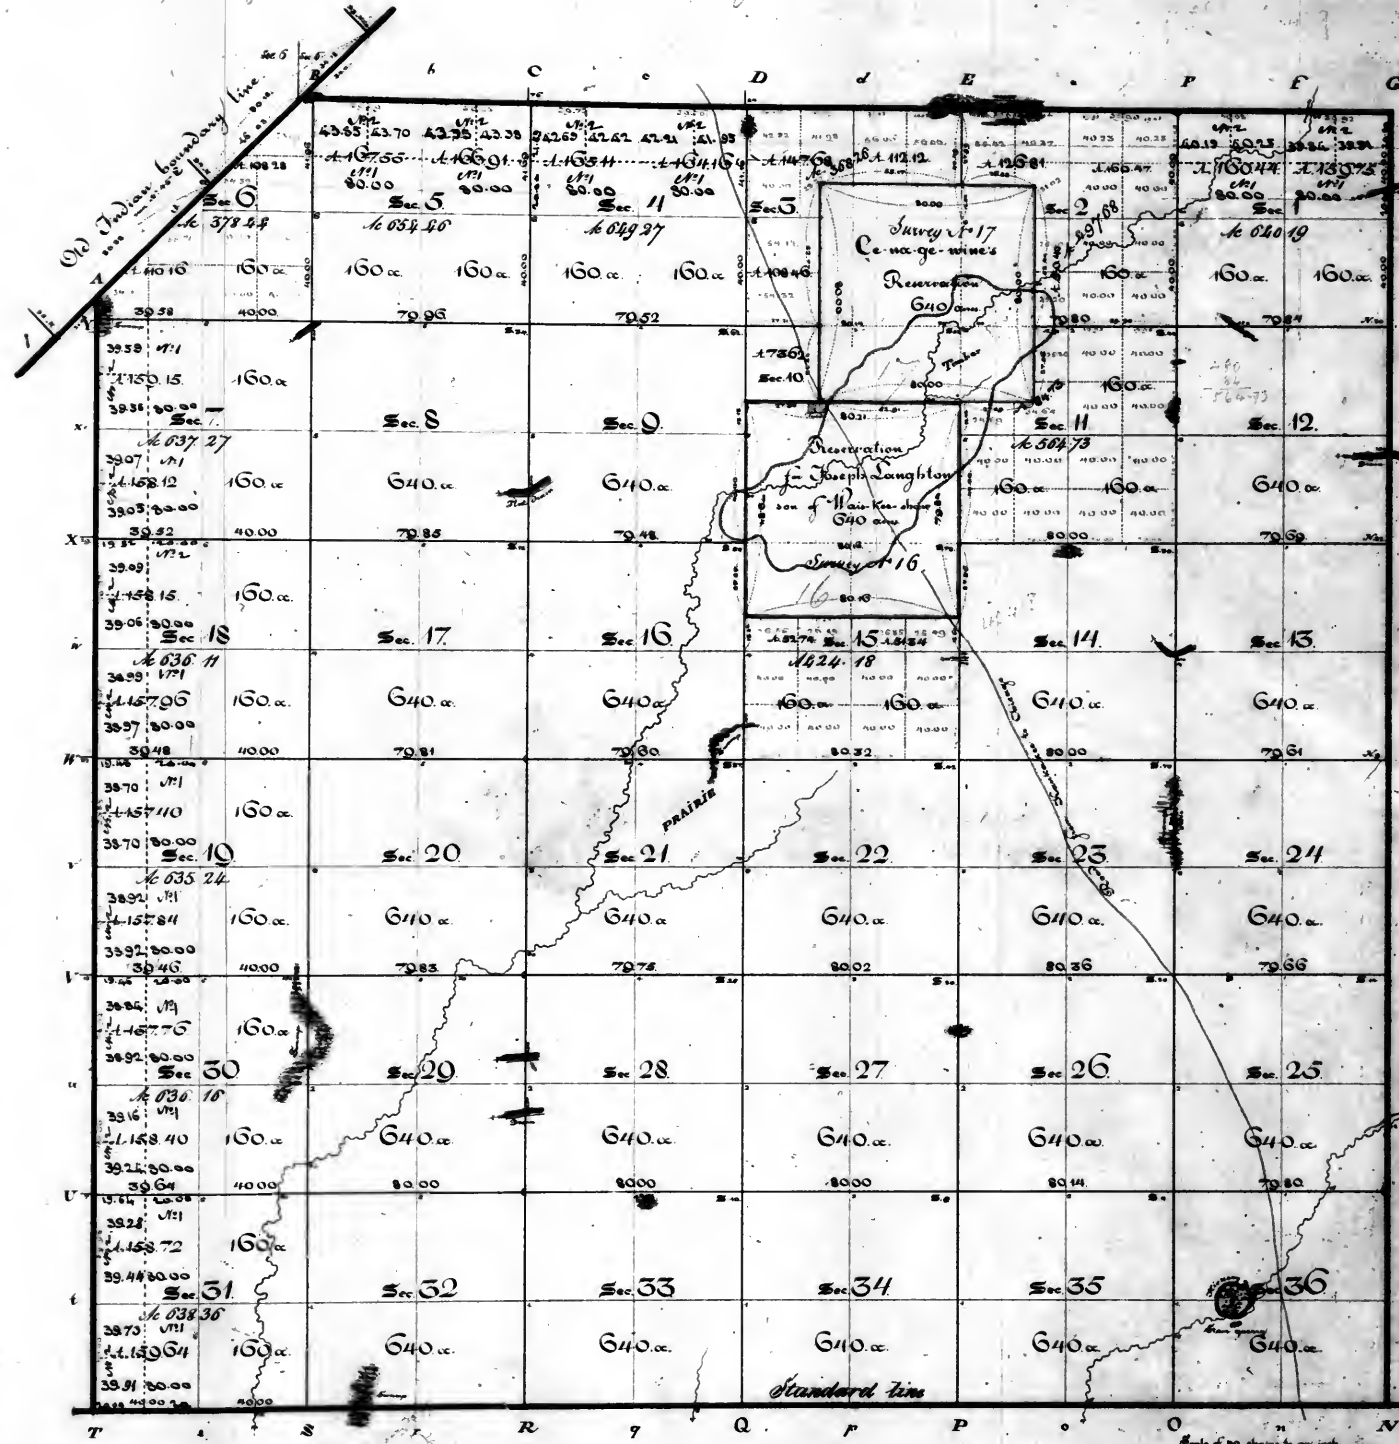

Surveyor's Office, St. Louis, Mo.
August 1845

1833. By the 1st sec. of Sect. 1, 1833.
the 1st sec. of Sect. 7, R. 11, 30 24th are
not being copied of this plot there-
fore to the Register, and another
the Commissioner, on 14th
August 1845

The field notes used in the construction of
this plot are by Don O'Leary Spaulding
under his contract of the 3rd of October 1833
and changed for in his report of the 20th
of January 1834

The line of the South & East boundary
on 15th of May 1834

North boundary on 20th of
May 1834

Old Indian boundary line being the
North West boundary of the frac-
tional Township on 25th of
April 1834

North boundary on 15th of
May 1834

Indian Reservation on 20th
of June 1834

Subdivision line on 15th of
June 1834

The South East North & West boundaries
on Subdivision line & the Indian Reservation
lines were surveyed on a Variation of 72°
East

The Old Indian boundary line was surveyed at
a Variation of 6° 45' East









Surveyor's Office
St. Louis 17th August 1845

Plotted
The above Part of Township 33 North of the base line Range 11 East of 3rd principal Meridian, conformable to the field notes
of the survey thereof on file in this Office, which have been examined and approved. The line designated 'Old Indian boundary line' was retraced and the corner
and mile points thereon were uncovered by Don O'Leary Spaulding in the 2nd quarter of 1834, under contract of the 3rd of October 1833 - The said 'Old Indian boundary
line' was originally surveyed in the 1st quarter of 1810, by James M. Duncan, assisted by John C. Sullivan, under a letter of appointment from 10th March 1810, Surveyor of the
lands of the United States, in Illinois and Missouri, dated October the 18th 1813, authorizing Sullivan as Surveyor, and Duncan as assistant to survey under the
direction of Commissioners Graham and Phillips, appointed by the President of the United States to run the lines of the tracts ceded by the treaty of San Lorenzo of the
24th of August 1816 (page 177) and following - said lands within of 1821 - This being the line agreed to be run - from a point on Lake Michigan 10 miles Southward
of the mouth of the Chicago river, in a direct line to a point on the Kankakee 10 miles above its mouth - and was first by said Sullivan and Duncan to run
S. 45° 2' W. 45 miles and 13 chains - In the 3rd quarter of 1821, John Wells, whilst assisting Stephen Rector and Thomas C. Rector in the resurvey of their contract
of the 20th of March 1821, being unable to find and properly identify this line and the mile points thereon, further Southward from the latter than the 3rd
mile point, commenced thereat and resurveyed S. 45° 2' W. and struck the base of the Kankakee 130 miles South of the old line, but about 5 chains further
South westward - It was this resurveyed line to which the Surveyors to the N.W. were closed, and which was retraced and renewed by Spaulding just as laid down
on this map in accordance with the title of Spaulding in the South, east, with its most boundary lines - the subdivision lines and Indian reservations, were all
surveyed in the 2nd quarter of 1834, by D. O. Spaulding, under his special contract of the 3rd of October 1833.

William Millburn
Surveyor General

Aggregate Area { This L. 21012.97
Indian Reservation 1230.00
Total 22242.97 acres


Fractional Township 34 North of the base line Range 11 East of 3rd principal Meridian

31

Surveyor General's Office.
St. Louis 26th August 1839.

The mile points designated on the 'old Indian boundary line' are, the points perpetuated one mile apart according to the measurement on the said line, at the time of the survey thereof by Wells. Their numbers are progressive from Lake Michigan - The distances set down between said mile-points are according to the measurement of Mr. Spaulding.

William Miller
Surveyor General
JH

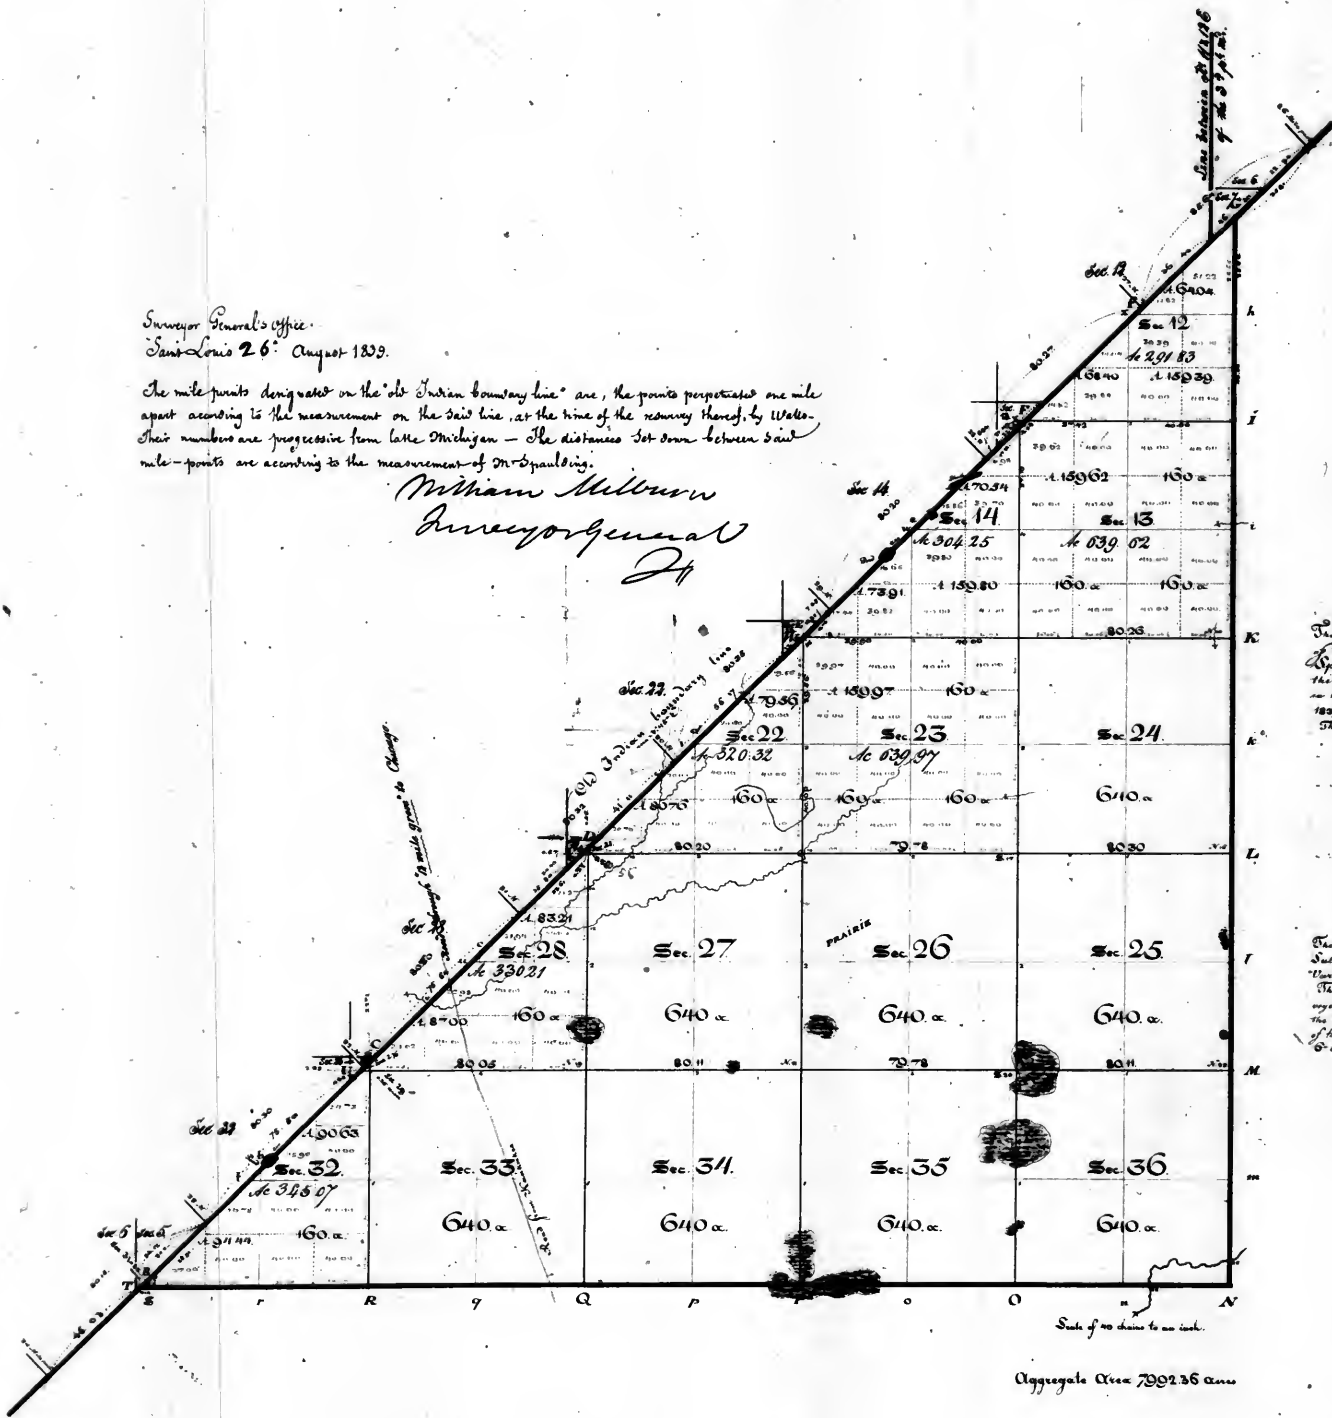

The field notes used in the construction of this Plat are by Don Alougo Spaulding with the contract of the 3rd of October 1833 and also for an account of the 25th of February 1835.
The notes of the South boundary are dated 20th of May 1834.
East boundary as dated 10th of May 1834.
Old Indian boundary line being the North-West bound line of the fractional Township line dated 28th of April 1834.
Subdivision lines are dated from the 25th to the 30th of June 1834.

The South & East boundaries of the Subdivision lines were surveyed at a variation of 7th 20' East.
The Old Indian boundary line was surveyed at a variation of 6th 45' East till the 30th mile post. From that post the survey of the line was carried at a variation of 6th 50' East.


Surveyor's Office
St. Louis 17th August 1839

The above Plat of Fractional Township 34 North of the base line Range 11 East of 3rd principal Meridian South east of 'Old Indian boundary line' is mostly conformable to the field notes of the survey thereof on file in this Office, which have been examined and approved: - The line designated 'Old Indian boundary line' was retraced, and the corners or mile-points therein were surveyed by Don Alougo Spaulding in the 2nd quarter of 1834, under contract of the 3rd day of October 1833 - The said 'Old Indian boundary line' was originally surveyed by James M. Duncan, assistant to John C. Sullivan, under a letter of appointment from William Recker, Surveyor of the lands of the United States in Illinois and Missouri, dated October the 18th 1818, authorizing Sullivan as Surveyor, and Duncan as assistant to carry, under the direction of Commissioners Graham and Phelps, appointed by the President of the United States to run the lines of the tracts ceded by the treaty of Saint Louis of the 24th of August 1816 (page 177 and following - Land laws - edition of 1828) - This being the line agreed to be run 'from a point on Lake Michigan 10 miles Southwest of the mouth of the Chicago creek, in a direct line to a point on the Kankakee 10 miles above its mouth' and was found by said Sullivan and Duncan to run S. 48° 2' W. 43 miles and 18 chains - In the 3rd quarter of 1831, John Wells, whilst assisting Stephen Recker and Thomas C. Recker, in the execution of their contract of the 20th of March 1831, being unable to find and properly identify this line and the mile-points therein, further Southwestward from the lake than the 3rd mile-point, commenced thereat, and ran S. 48° 2' W. and struck the head of the Kankakee 180 miles South of the old line, but about 5 chains further Southwestward - It was this surveyed line to which the surveys to the N. W. were closed, and which was retraced and removed by Spaulding; and is laid down on this map in accordance with his notes - The South and east boundaries - and the sectional lines were surveyed on the 2nd quarter of 1834, by the said Spaulding, under his contract above designated.

William Miller
Surveyor General
JH

Fractional Township No. 34 North of the base line Range No. 11 East of the 3rd principal meridian.
North West of the Old Indian boundary

Surveyor's Office
St. Louis 25th April 1850
A copy of plat of full 36th quarters,
N.W. of the Old Indian boundary,
was sent to the Register, and an
other copy was sent to the Comptroller
of the Genl Land Office.

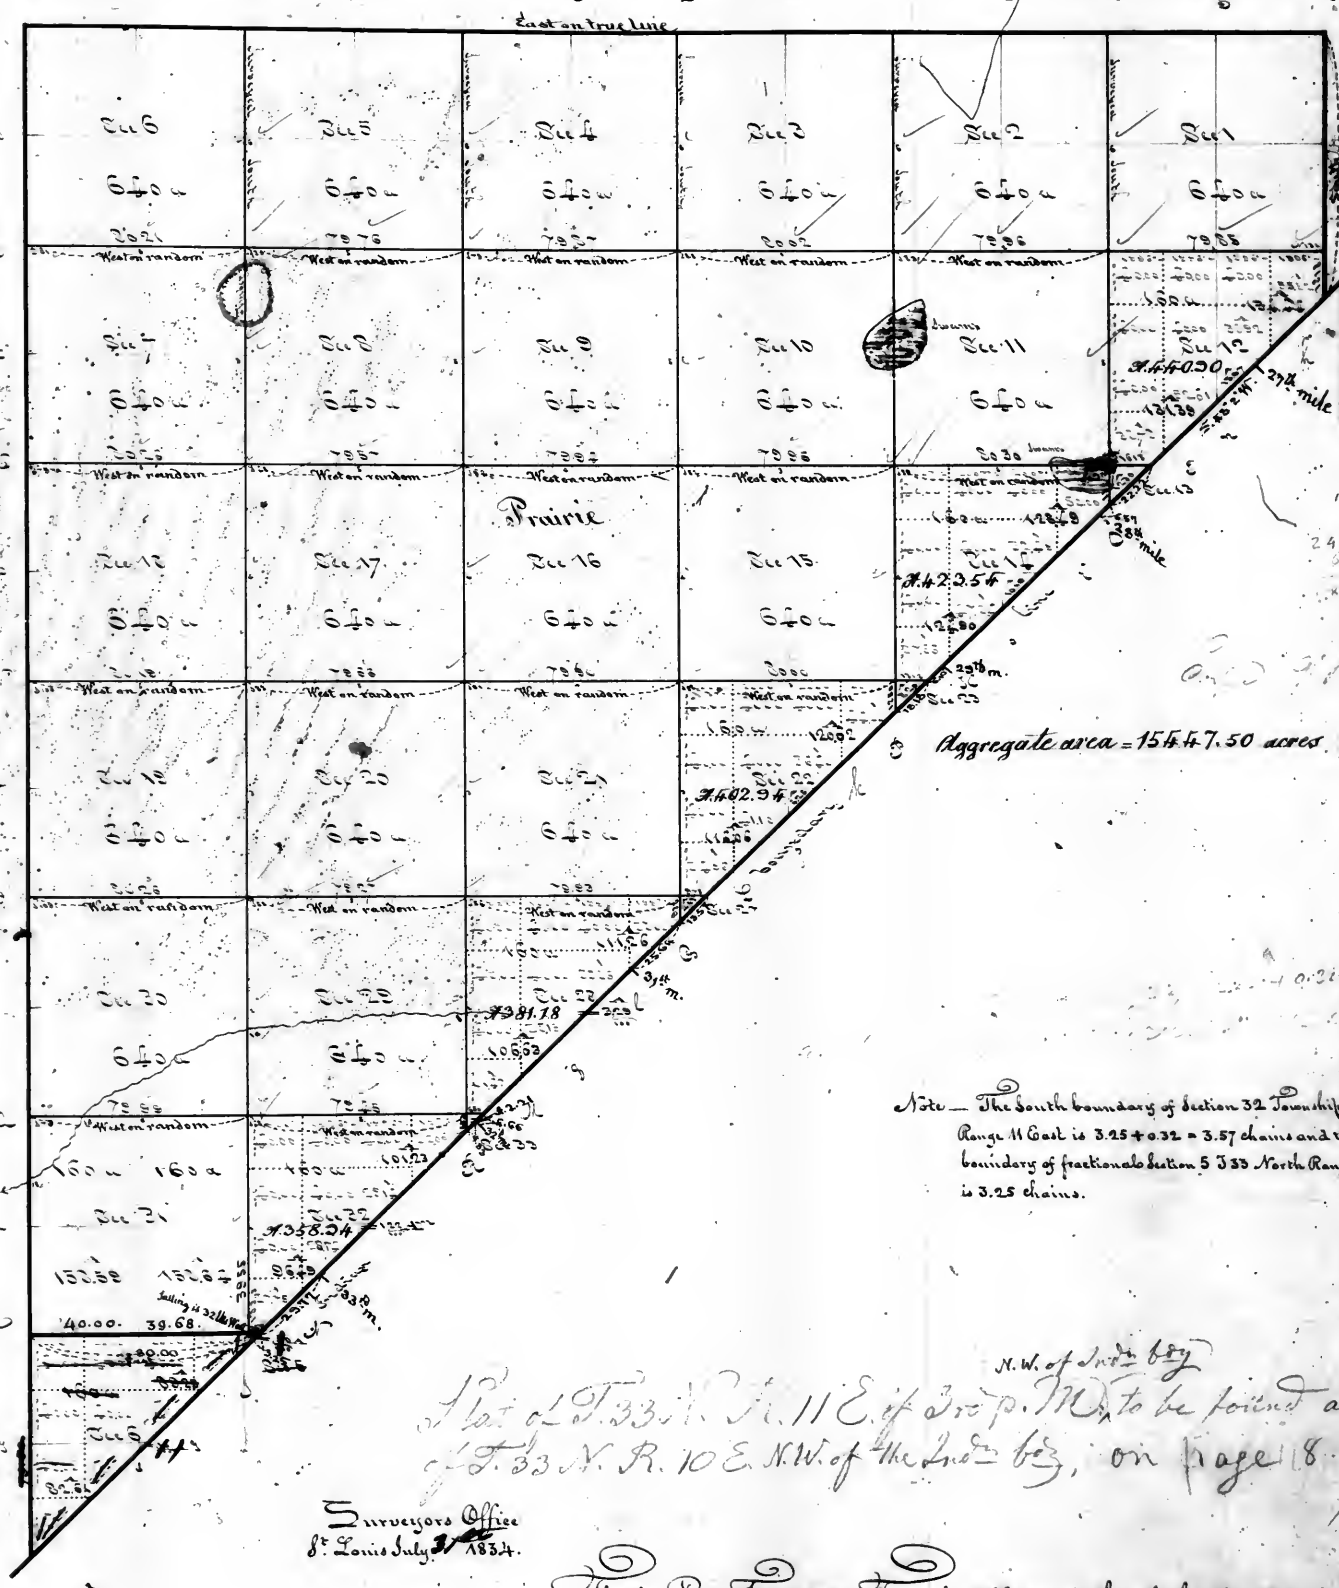


Note - The South boundary of section 32 Township 34 North, Range 11 East is 3.25 + 0.32 = 3.57 chains and the North boundary of fractional section 5 33 North Range 11 East is 3.25 chains.

Surveyor's Office

The above Plat of Fractional Township No. 34 North of the base line, Range 11 East of the 3rd principal meridian, North West of the Old Indian boundary, is conformable to the field notes of the survey thereof on file in this Office.

E. J. Sanborn

Plat of Township 35 North of the base line Range 11 East of the 5th Principal Meridian.

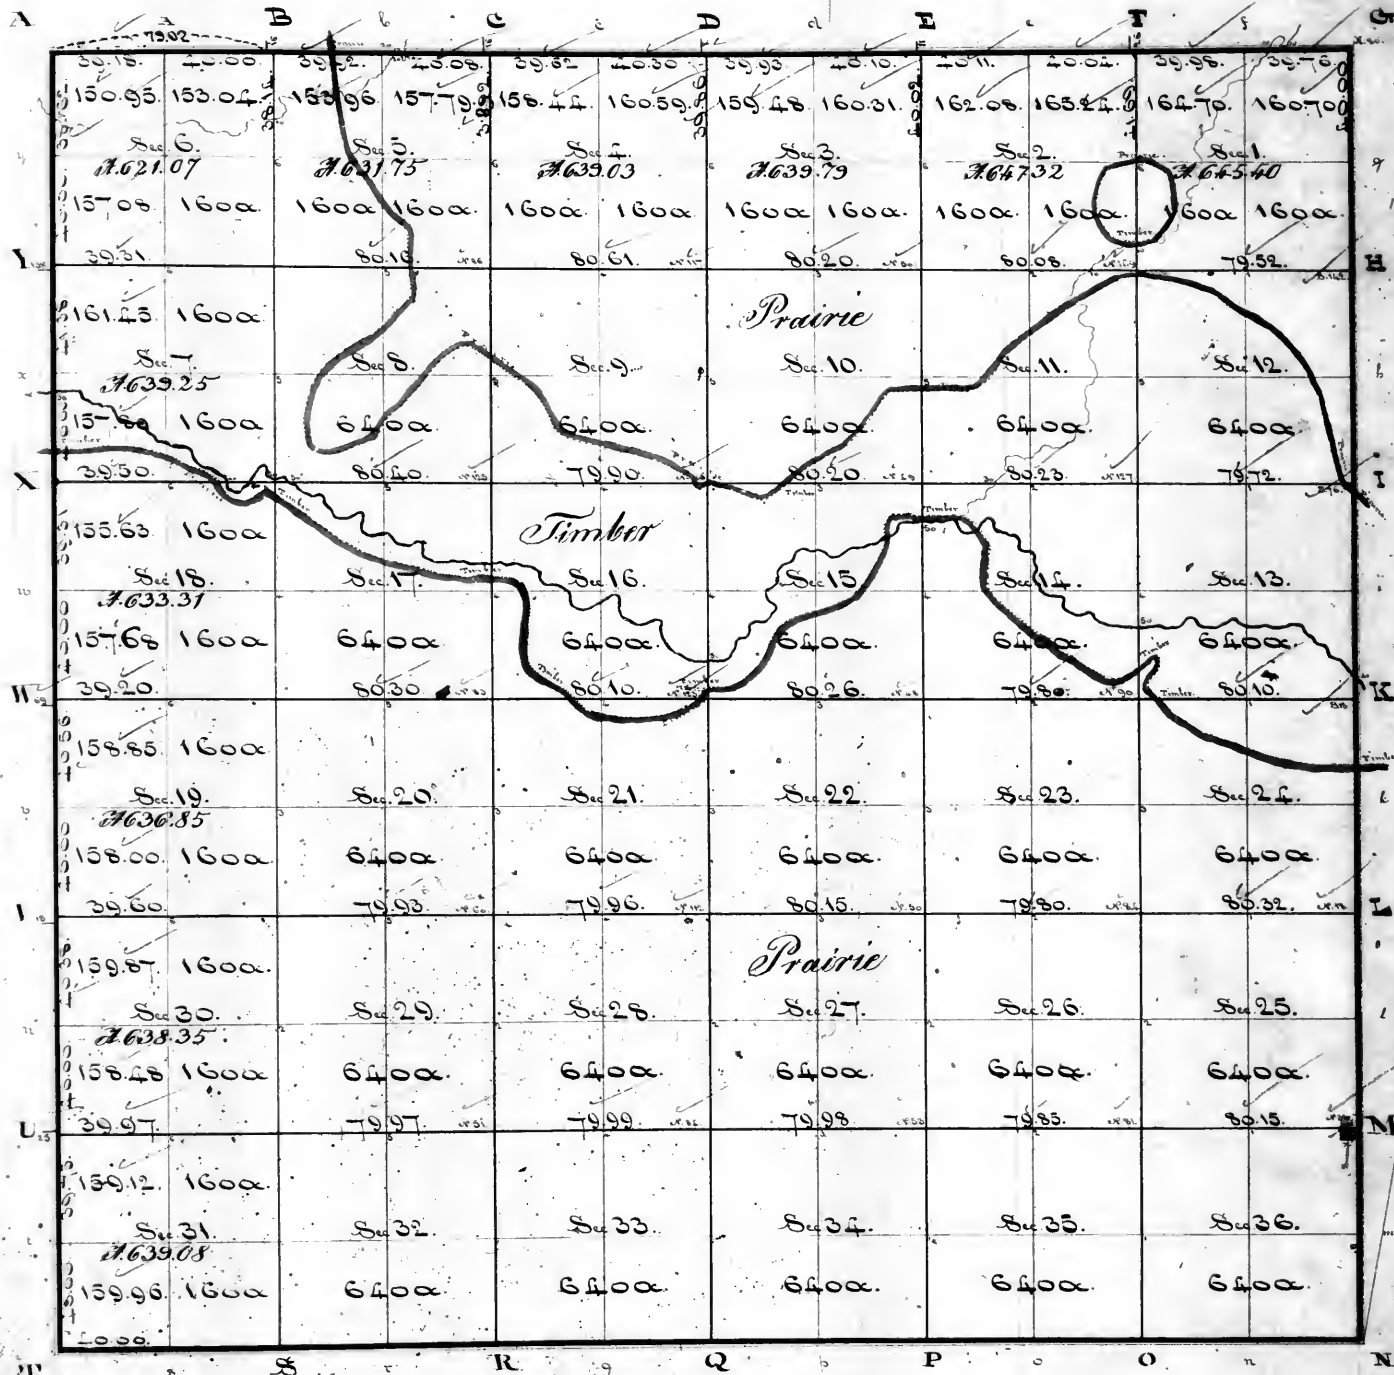

Areas of the several sections of
Twp 35 N R 11 E of the 5th principal M.


Total 23011.20 acres


Aggregate area = 23011.20 acres Scale of 40 chains to an inch.

Surveyors Office
St. Louis July 31st 1854

The above Plat of Township 35 North of the base line, Range 11 East of the 5th principal meridian, is conformable to the field notes of the survey thereof on file in this Office

E. J. Smytham

Plat of Township 36 North of the Base line Range 11 East of the 3^d Principal Meridian

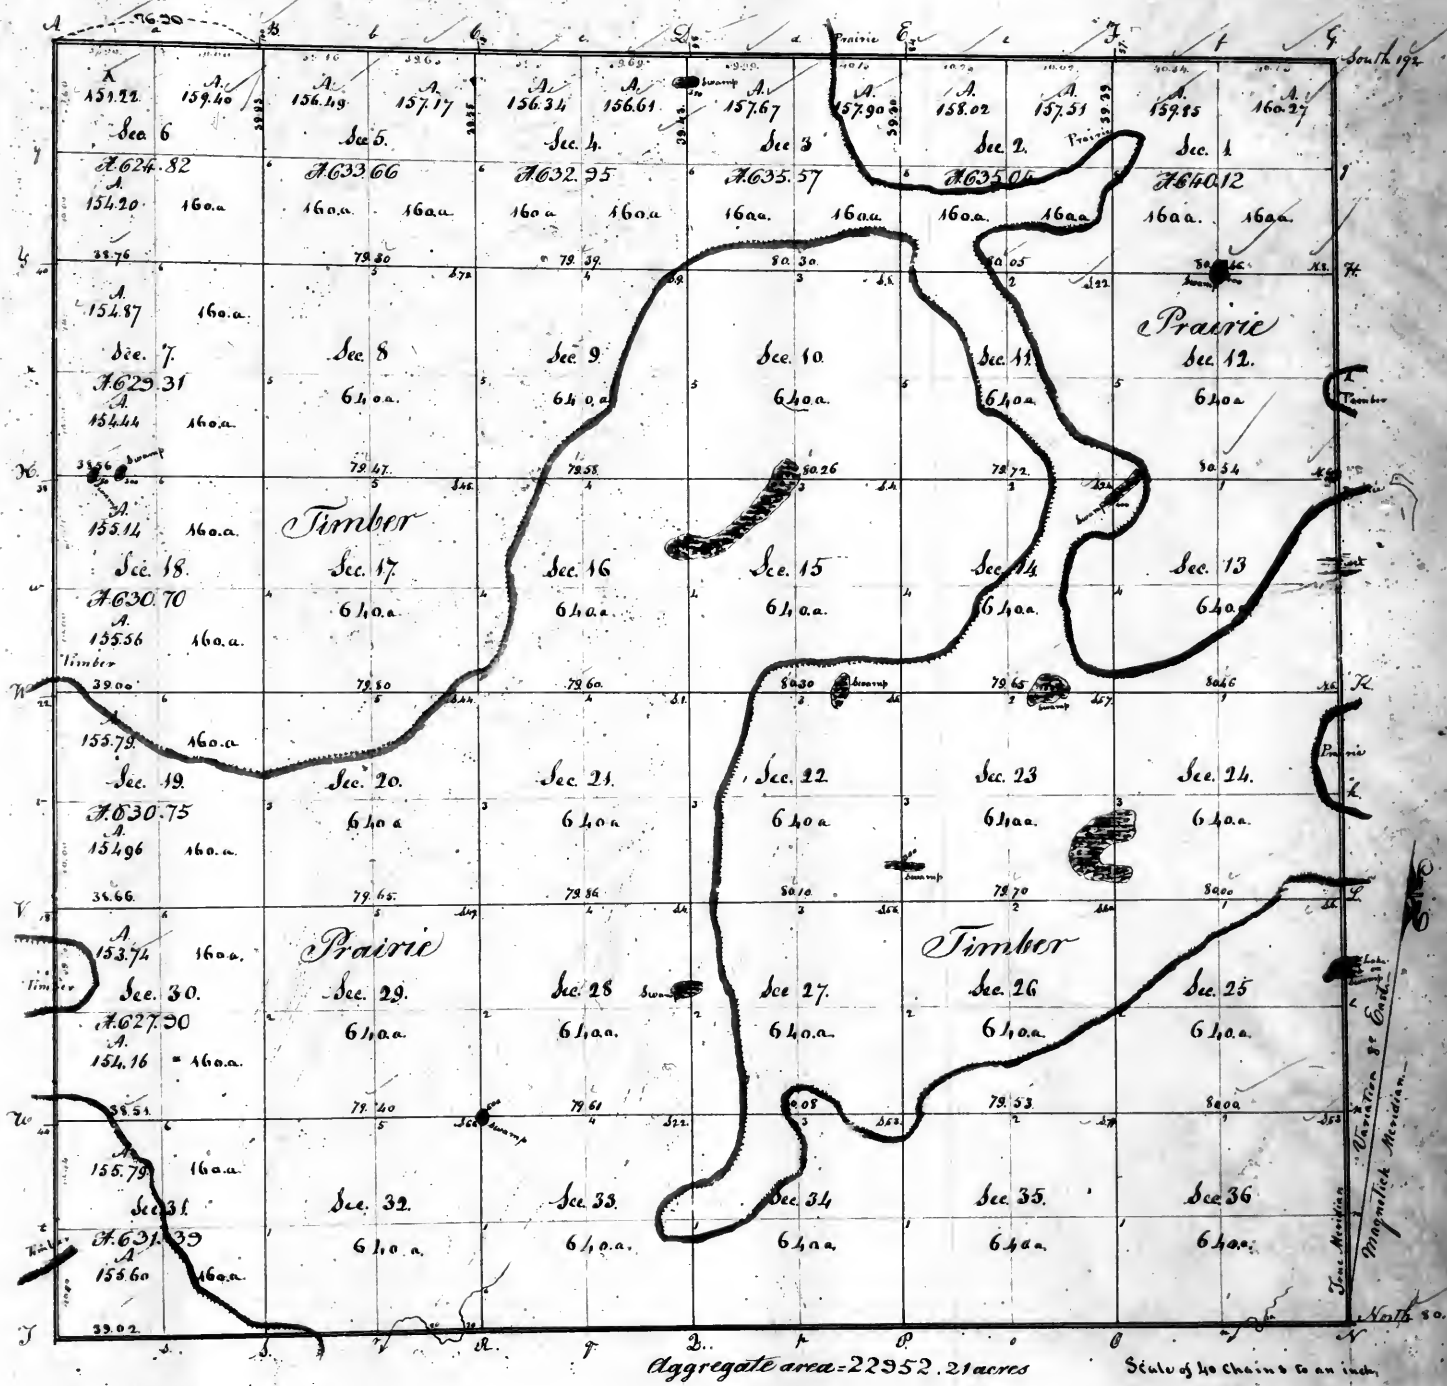

Surveyors Office
St. Louis July 31 1834

The above Plat of Township 36 North of the base line, Range 11 East of the 3^d principal meridian, is conformable to the field notes of the survey thereof on file in this Office.


E. J. Langham

T. 37. N. R. 11. E. of the 3^d pl. Mon

p. Vano 34
oppos p. 34

Statement of the lines run by A. D. Mathewson
as set forth in the Certificate below
The line betw. sec. 11 & 15. W. of Range
do 11 & 14 E. of Range 13.00
do 14 & 15 - from river bank
of river E. & W. line of Range 32.31
do 15 & 16 - from river bank
of river E. & W. line of Range 15.00

Acres
Total 537.00

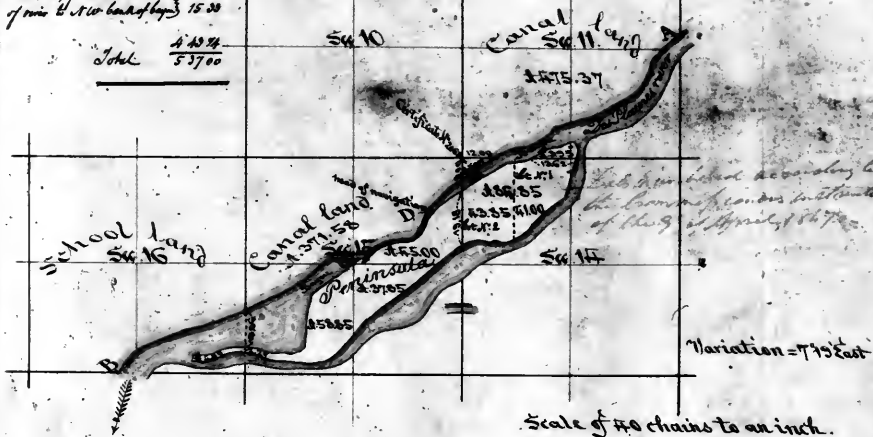

Note: The yellow lines from A to B on this Plot represent those surveyed on the 12th of October 1821 by John Walls under the contract of Silas C. Rector and Stephen Rector, dated the 20th of March 1821, and according to Walls' field notes the said lines were run with the N.W. bank of the river Des Plaines.

It probably to the field notes of the Peninsula, as surveyed by A. D. Mathewson, in the said Mathewson ran from C to D, with Walls' old lines. The Register at Chicago in a letter of the 17th of April last to this Office, stated that fractional Sections 11 & 15, N.W. of what Walls called the N.W. bank of the Des Plaines river, were Canal lands and that fractional Section 16 was School land. The Register gives the Aggregate area of fractional Section 11 as 535.37 acres and of fractional Section 15 as 371.53 acres, but according to two State (in this Office) of 1827, N.W. 11 & 15 of the 3^d pl. Mon, fractional Section 11 contains 535.37 acres and fractional Section 15 - 232.12 acres.

Surveyor's Office
St. Louis, August 15 1846

J. R. Donnan
Surveyor of the public lands in the
States of Illinois & Missouri.

Surveyor's Office. St. Louis 15 August 1846.

The above plot of a peninsula in sections 11, 14, 15 & 16 in Township 37 and of the base line, range 11 east of the 3^d principal meridian, is strictly conformable to the field notes of the survey thereof on file in this Office which have been examined and approved. The distance from A to B, on the plot was run in the survey of the township as the northern bank of the River des Plaines; but as it has been represented to the Commissioner of the General Land Office, that there was an island unsurveyed in the vicinity aforesaid, he, on the 20th of March 1846, instructed the Surveyor General to have it surveyed; - and in consequence thereof, an order, was, on the 18th of May 1846, issued to A. D. Mathewson to that effect. He ran, in June 1846, the lines detailed in the marginal Statement, 5 miles 37.00 chains - This surveying is paid for on this day, and charged to the United States, in Voucher No. 1, of account current of the Surveyor General during the 3^d quarter 1846, under the appropriation of \$ 1200, of the 3^d of March 1845, for the erection of creosote & depots in surveys in Illinois & Missouri, at a rate not exceeding 25¢ dollars a mile. See page 65, etc. of 2^d volume of 28th Congress.

J. R. Donnan
Surveyor of the public lands
in the States of Illinois & Missouri.

Plot sent to the Commissioner & Register 19th August 1846.




Surgeon's Office
St. Louis July 2nd 1834

Examined


Downship 38 North of the base line Range 11 East of the 3^d principal Meridian,

37

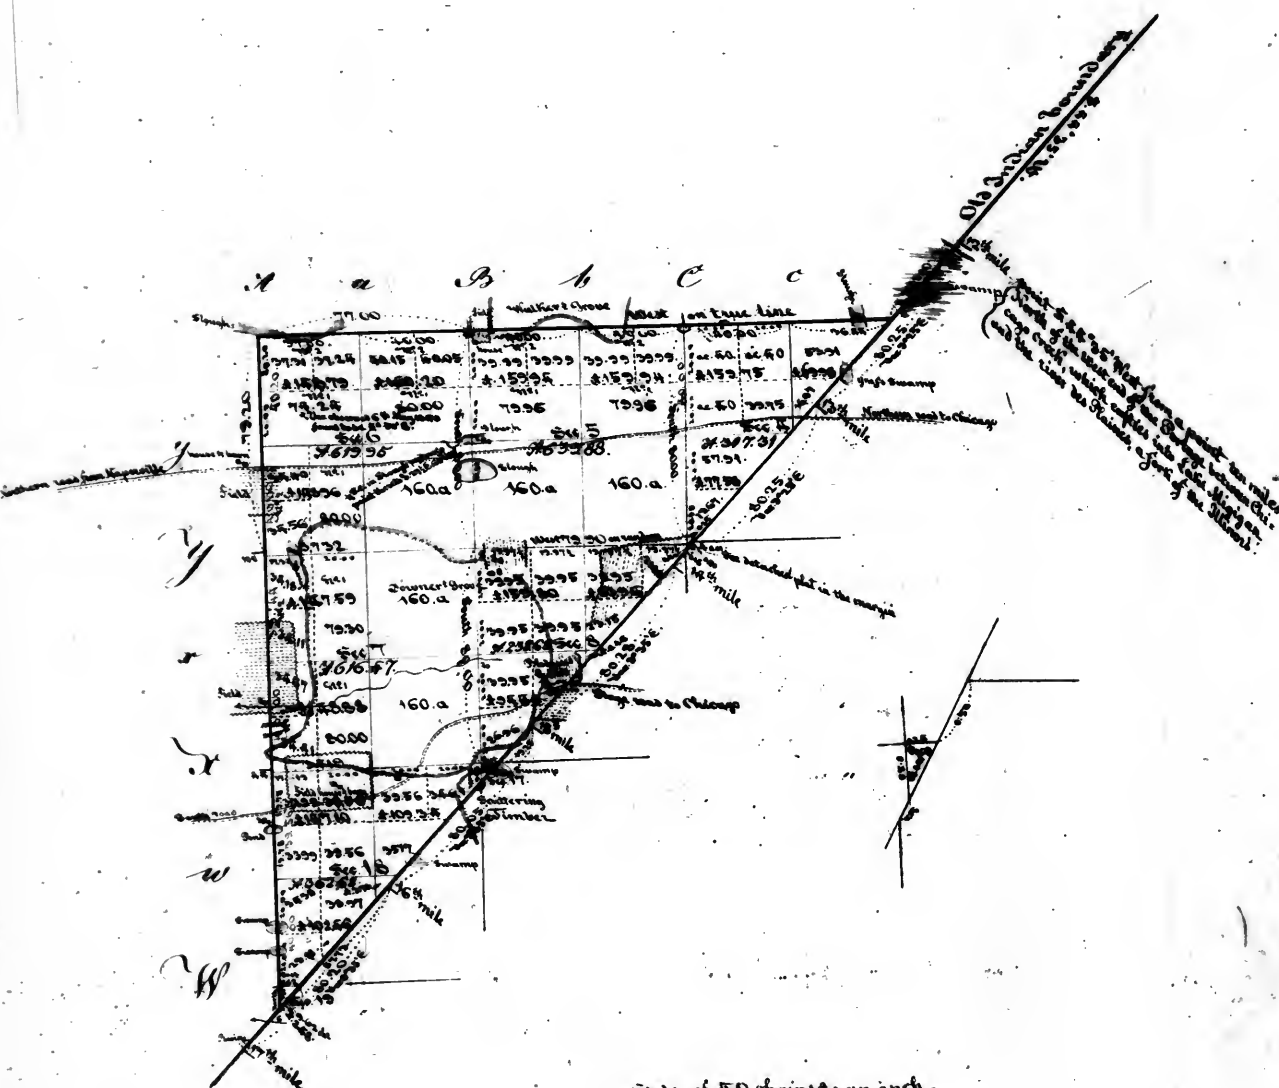

Scale of 40 chains to an inch.
Aggregate area = 2783.83 acres.

On Old Indian boundary as shown on the line
on all the other lines - 5° 15' East


Surveyors Office. Saint Louis 4th of January 1842.

The above plat of Township 38 north of the base line, range 11 east of the 3^d principal meridian, with west of the old Indian boundary, is strictly conformable to the field notes of the survey thereof, which have been examined and approved, and are on file in this office. The southern boundary congruent "Old Indian boundary" was surveyed in the 1st quarter of 1819, by John C. Sullivan, as principal surveyor, and James M. Duncan, as assistant surveyor, under the authority of a letter from William Recker, surveyor of the public lands in the Territories (now States) of Illinois and Missouri, dated the 18th of October 1818, authorizing said Sullivan and Duncan, to survey under the direction of Commissioners Graham and Miller, appointed by the President of the United States, to run the line of the tract ceded by the treaty of Saint Louis of the 24th of August 1816 (page 177 and following, Laws of 1818) - This being the line agreed to be run from a point on Sainty Creek ten miles above its mouth in a direct line to a point ten miles north of the west end of the Portage between Chicago Creek which empties into Lake Michigan and the River des Plaines a point of the Illinois; and was run by the said Sullivan and Duncan from the said point, 10 miles north of the west end of the Portage, S 44° 35' W, 28 miles and 70 chains to a point, 22.75 chains at right angles to the west of the corner established on Sainty Creek (10 miles from its mouth) In the 3^d quarter of 1821, John Willis, under the contract of Stephen and Thomas Recker, of the 20th of March of that year, re-surveyed this line for the purpose of closing the public surveys on the south east side thereof. The whole line was retraced and the fractional section corners for the surveys on the south east side thereof, and the mile points thereon, were renewed, in the 3^d quarter of 1827, by Eli S. Parrott, under contract signed by the Surveyor General on the 8th May, and by Mr. Parrott, on the 3^d of June 1827. This re-measurement was paid for in the 4th quarter of 1828, and charged in the account current of the Surveyor General, during the said quarter Voucher N° 5 - The west boundary 2 miles 73.44 chains - the north boundary 2 miles 73.44 chains - and the subdivision lines 6 miles 12.12 chains were surveyed in the 2^d quarter of 1840, by W. L. D. Ennis, under contract of the 23rd of September 1839 - They were paid for in the 2^d and the 4th quarters of 1841, and charged in the account current of the Surveyor General, during those quarters, Vouchers N° 2 & 12

Jos. C. Brown
Surveyor of the public lands for the
district of Illinois & Missouri.

Township 39 North of the base line Range 11 East of the 3^d principal Meridian

39

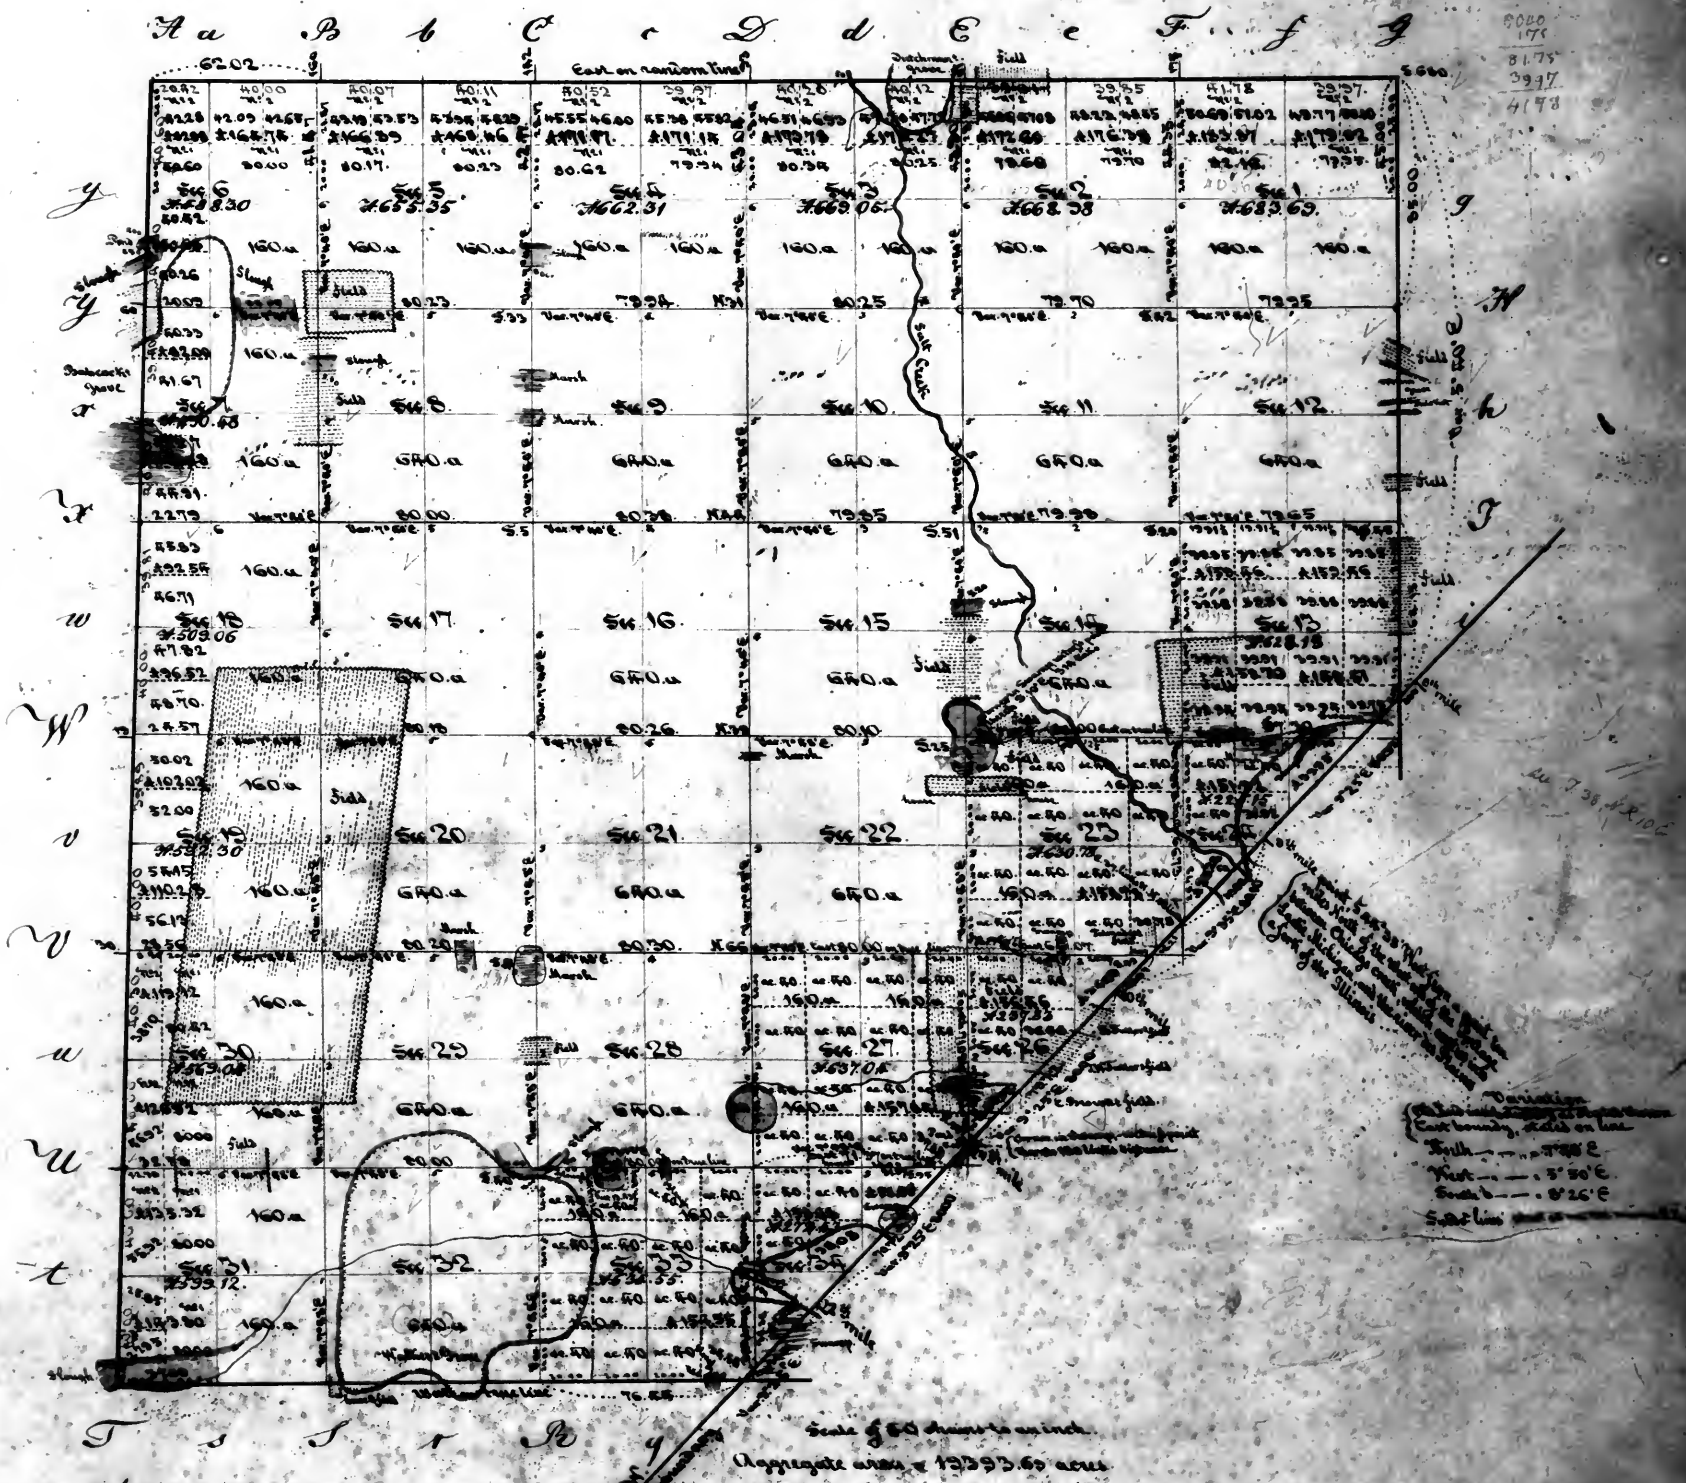



The southeastern boundary beginning at its intersection with the 3^d principal meridian, was surveyed in the 1st quarter of 1819, by John C. Sullivan, as principal surveyor, and James M. Donnan, as assistant surveyor, under the authority of a letter from William Rector, Surveyor of the public lands in 1818. The acquisition (two states) of William M. McHenry, dated the 1st of October 1818, establishing the land sold to William Rector to survey under the provision of Commissioners Graham & Phillips, appointed by the President of the United States to run the lines of the lands ceded by the treaty of St. Louis of the 20th of August 1804 (page 177, and following 4-6, a. of 1804) this being the line agreed to be run from a point on Henry creek ten miles above its mouth in a direct line to a point ten miles north of the point out of the Survey between Chicago creek which empties into Lake Michigan and the River des Plaines, a fork of the St. Vrain, and was run by the said William M. Donnan from the said point 10 miles north of the north end of the Portage 5th 35' 10" 31 miles and 10 chains to a point 25.75 chains at right angles to the west of the corner established on Henry Creek (10 miles from its mouth) - On the 3^d quarter of 1821, John Rector, under the contract of Stephen and Thomas Lister of the 22^d of March of that year, ran across this line, for the purpose of clearing the public surveys on the southeast side thereof - the work of the line was observed and the fractional section corners for the surveys on the creek and side thereof, and the mile posts thereon were renewed in the 3^d quarter of 1827, by Ed. S. Henshaw, under contract signed by the Surveyor General on the 8th of May, and by 70th Henshaw on the 3^d of June 1827. This renewal was paid for in the 4th quarter of 1828, and charged in the account current of the Surveyor General during that quarter, Voucher A 24 15 - The east boundary 2 miles 22.15 chains was surveyed in the 1st quarter of 1823, by George W. Kinnison, under contract of the 3^d of September 1823 - it was paid for in the 2^d quarter of 1828, and charged in the account current of the Surveyor General during that quarter, Voucher A 13 - The other lines of the township were surveyed by W. L. D. Carey, under contract of the 23^d of September 1823, to wit: - The north boundary 2 miles 73.45 chains & the west boundary 5 miles in the 2^d quarter of 1820. They were paid for in the 2^d and 3^d quarters of 1821 and charged in the accounts current of the Surveyor General for those quarters, Vouchers A 24 19 - The north boundary in the 2^d quarter of 1828 - the 1/4 miles along the north boundary of lat. 38.33.29.35.42.56.57.40 to N, were paid for in the 2^d and 3^d quarters of 1821, and charged in the accounts current of the Surveyor General for those quarters, Voucher A 24 12 - the 63.22 chains along the S. E. of lat. 38.34.28.11, were paid for in the 3^d quarter of 1821 & charged in the accounts current of the Surveyor General for that quarter, Voucher A 15 - The subdivision line 2 miles 22.59 chains in the 2^d and 3^d quarters of 1820 - They were paid for in the 1st quarter of 1821, and charged in the account current of the Surveyor General, during that quarter, Voucher A 15

1/2
Jos. C. Brown,
Surveyor of the public lands for

Township 40 North of the base line Range 11 East of the 3^d principal Meridian

40

5056
79.00

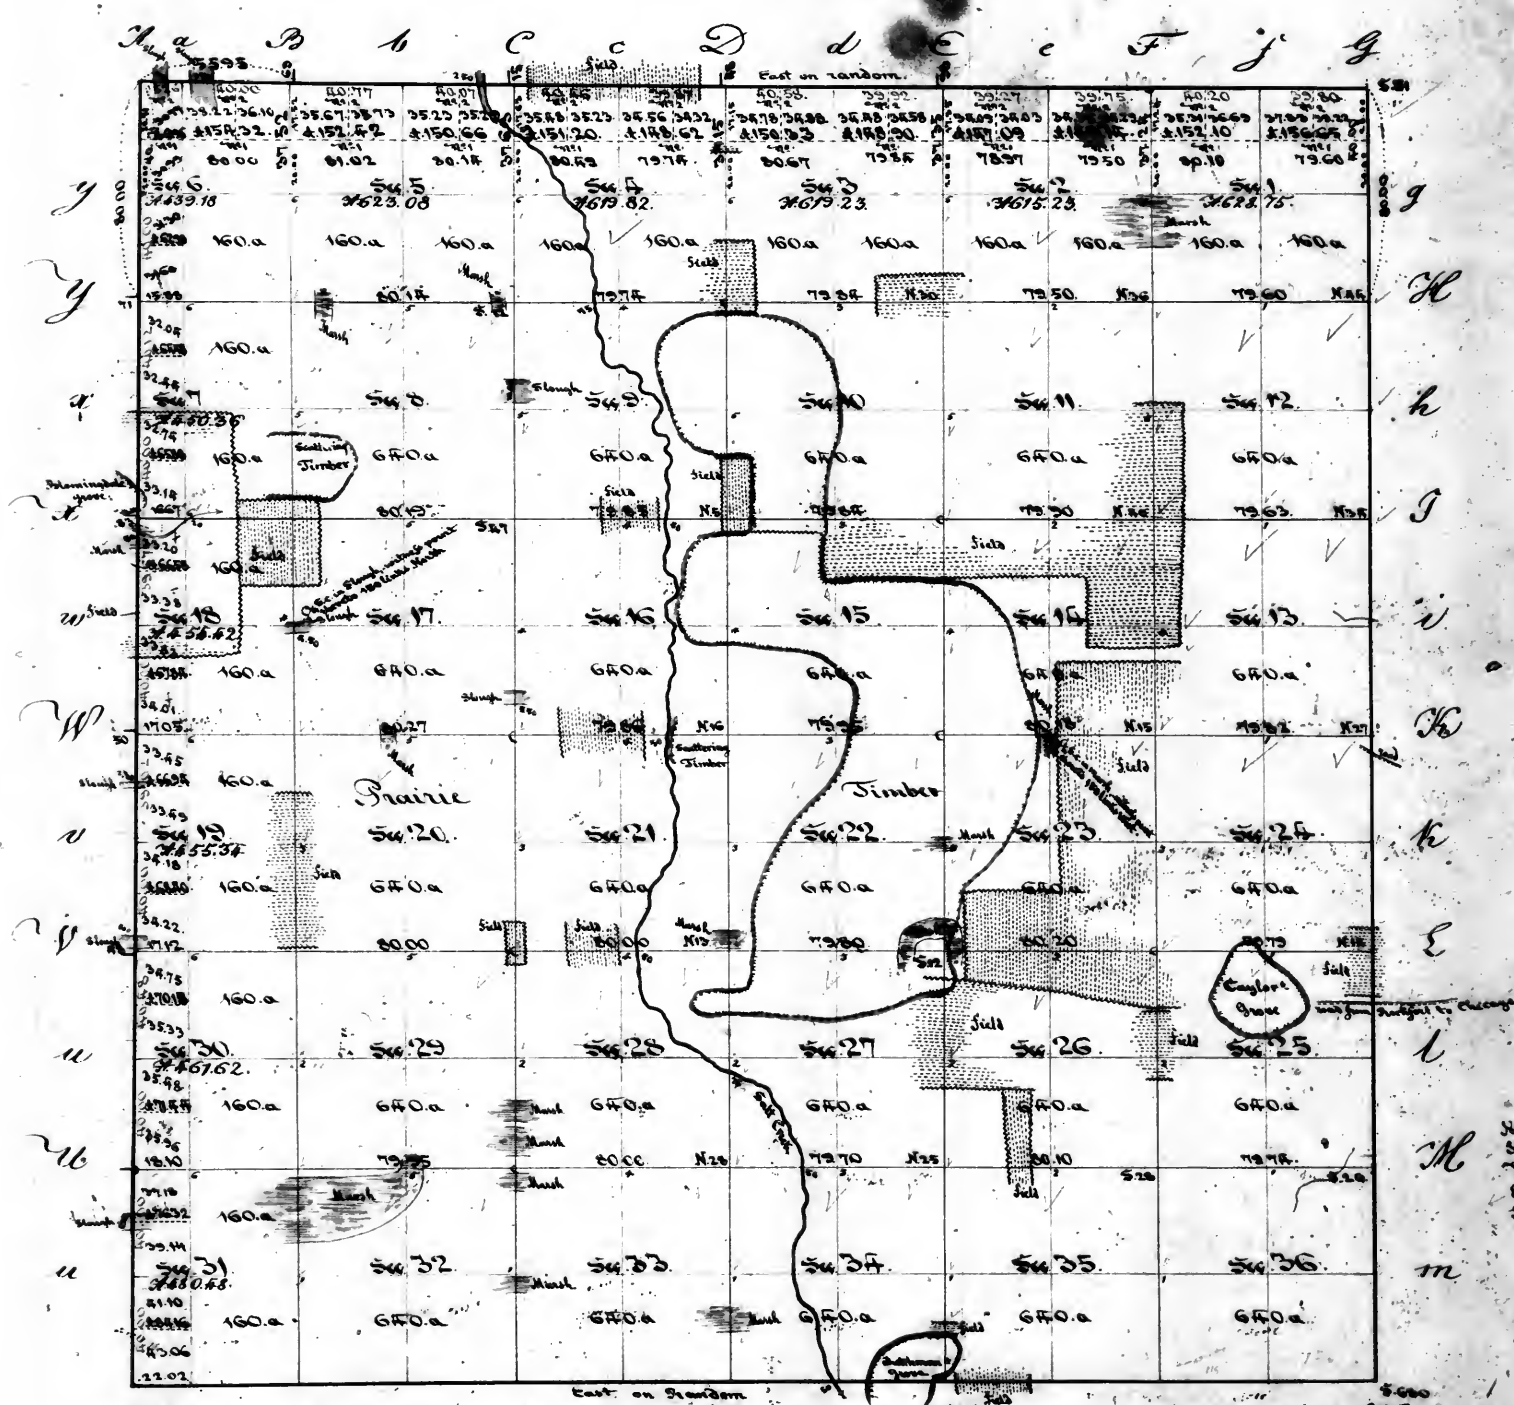

Variation


Surveyor's Office. Saint Louis 4th of January 1842.
Scale of 40 chains to an inch
Aggregate area = 21877.50 acres.

The above plat of Township 40 north of the base line, range 11 east of the 3^d principal meridian, is strictly conformable to the field notes of the survey thereof on file in this office, which have been examined and approved. The east boundaries of sections 36, 25, 24, 13 & 12, 5 miles were surveyed in the 4th quarter of 1839, by George W. Harrison, under contract of the 21st of September 1839. They were paid for in the 2^d quarter of 1840, and charged in the account current of the Surveyor General, during that quarter, Voucher N^o 12. The east boundary of section 1, 30 chains, was surveyed in the 3^d quarter of 1840, by the said Harrison, under the same contract, and it was paid for in the 4th quarter of 1840, and charged in the account current of the Surveyor General, during that quarter, Voucher N^o 10. The west boundary 6 miles was surveyed in the 3^d quarter of 1840 by W^m L. B. Ewing, under contract of the 23rd of September 1839. It was paid for in the 2^d and the 4th quarters of 1841, and charged in the account current of the Surveyor General, during those quarters, Vouchers N^{os} 2 & 12. The south boundary 5 miles 62.25 chains, was surveyed in the 2^d quarter of 1840 by W^m L. B. Ewing under his said contract: the 5 miles, along the South boundaries of sections 32 to 36, were paid for in the 2^d and the 4th quarters of 1841, and charged in the account current of the Surveyor General, during those quarters, Voucher N^o 2 & 12. — and the 62.25 chains, along the South boundary of section 31, were paid for in the 4th quarter of 1841, and charged in the account current of the Surveyor General, during that quarter, Voucher N^o 15. The north boundary 5 miles 55.95 chains, and the subdivision lines 51 miles 29.30 chains, were surveyed in the 3^d quarter of 1840, by the said Ewing, under his said contract: they were paid for in the 2^d and the 4th quarters of 1841, and charged in the account current of the Surveyor General, during those quarters Voucher N^o 2 & 12.

Jos. C. Brown,
Surveyor of the public lands for the
District of Mines & Missouri.

Township 41 North of the base line Range 11 East of the 3rd principal Meridian

41

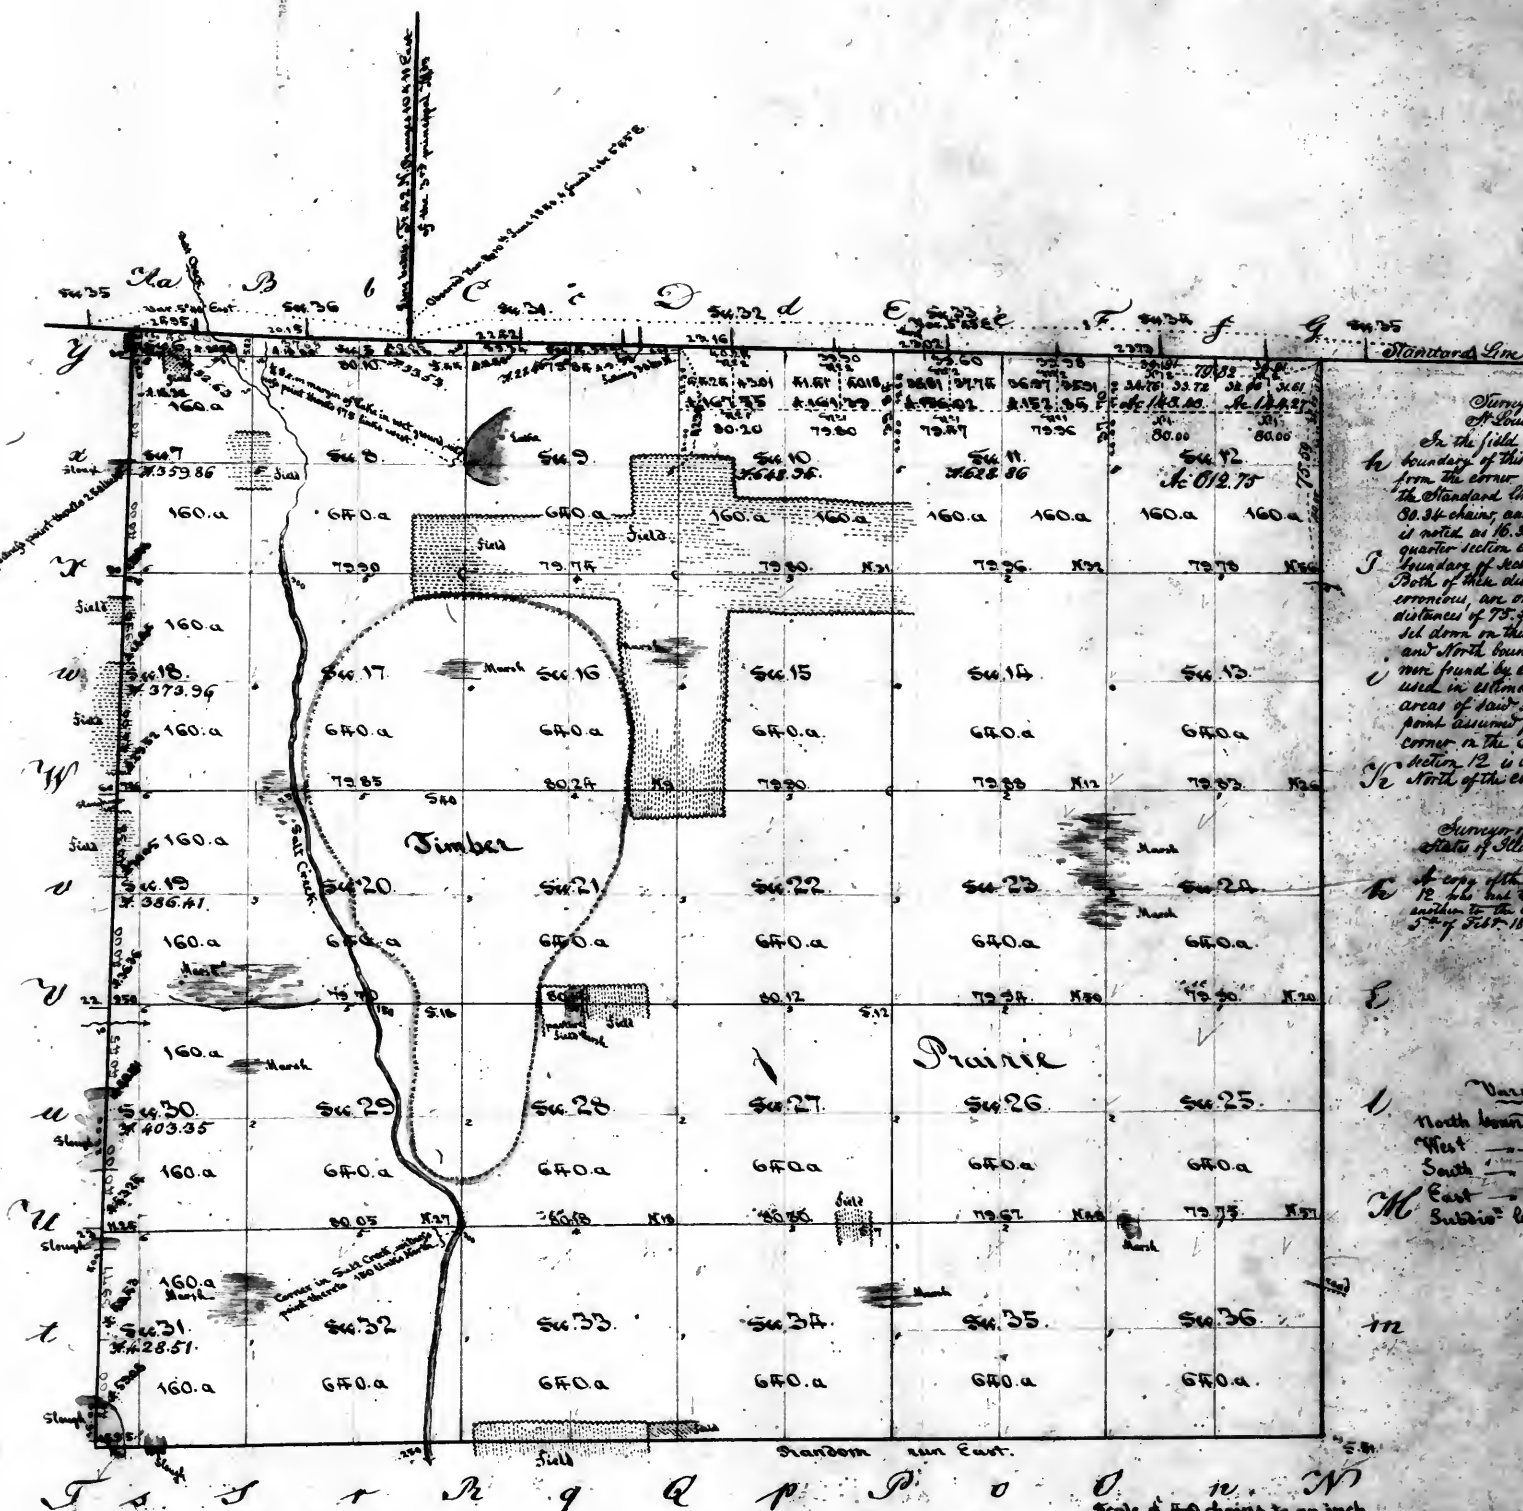

Surveyor's Office
St. Louis January 20th 1849
In the field notes of the East
boundary of this Township, the distance
from the corner of sections 12 & 13 to
the Standard line, is entered as
80.34 chains, and the following thereon
is noted as 16.30 chains. Half of the
quarter section corner on the South
boundary of Sec. 35 is 112.16
Both of these distances, being evidently
erroneous, are omitted. The
distances of 75.33 and 73.52 chains
set down on this plat, on the East
and North boundaries of section 12,
were found by calculation and
used in estimating the several
areas of said section. The
point assumed for the quarter-section
corner on the East boundary of
section 12 is at 81.00 chains
North of the corner of section 12 & 13.

Survey of the public lands in the
State of Illinois and adjacent
territories
A copy of the plat of said section
12, 13, 14, 15, 16, 17, 18, 19, 20,
21, 22, 23, 24, 25, 26, 27, 28,
29, 30, 31, 32, 33, 34, 35, 36,
is on file in the Surveyor's Office
St. Louis, Mo. 1849

Variation
North bound: states on line
West — 5° 40' E
South — 7° 40' E
East — 5° 40' E
Subsidiary lines — 7° 40' E


Surveyor's Office, Saint Louis 4th of January 1842.
The above plat of township 41 north of the base line, range 11 east of the 3rd principal meridian, except the north half of section 12 which is omitted on account of an error, in the survey of the east boundary thereof, is strictly conformable to the field notes of the survey of said township on file in this office, which have been examined and approved. The north boundary was surveyed in the 2nd quarter of 1837, by James Thompson, under contract signed by the Surveyor General on the 21st of November, and by M. Thompson on the 15th of December 1836 — it was paid for in the 1st quarter of 1839, and charged in the account current of the Surveyor General, issuing that quarter, Voucher No. 6. The east boundaries of sections 36, 25, 24, 13, 4 miles, were surveyed in the 3rd quarter of 1840, by F. W. Harrison, under contract of the 21st of September 1839 — they were paid for in the 4th quarter of 1840 and charged in the account current of the Surveyor General, issuing that quarter, Voucher No. 10. The West boundary 5 miles 10.05 chains, was surveyed in the 2nd quarter of 1840. The South boundary 5 miles 53.35 chains, and the subsidiary lines 50 miles 5.44 chains, were surveyed in the 3rd quarter of 1840 — by W. L. Drury, under contract of the 23rd of September 1839. They were paid for in the 2nd and the 4th quarters of 1841, and charged in the accounts current of the Surveyor General for those quarters, Vouchers No. 2 & 13.

Scale of 40 chains to an inch
Aggregate area = 177 1/2 Townships, except 1/2 Sec. 12.

Jose Brown
Surveyor of the public lands for
the District of Kansas & Missouri.

Township No 42 North of the Base line in Range 11 East of the 3^d principal Meridian.

42

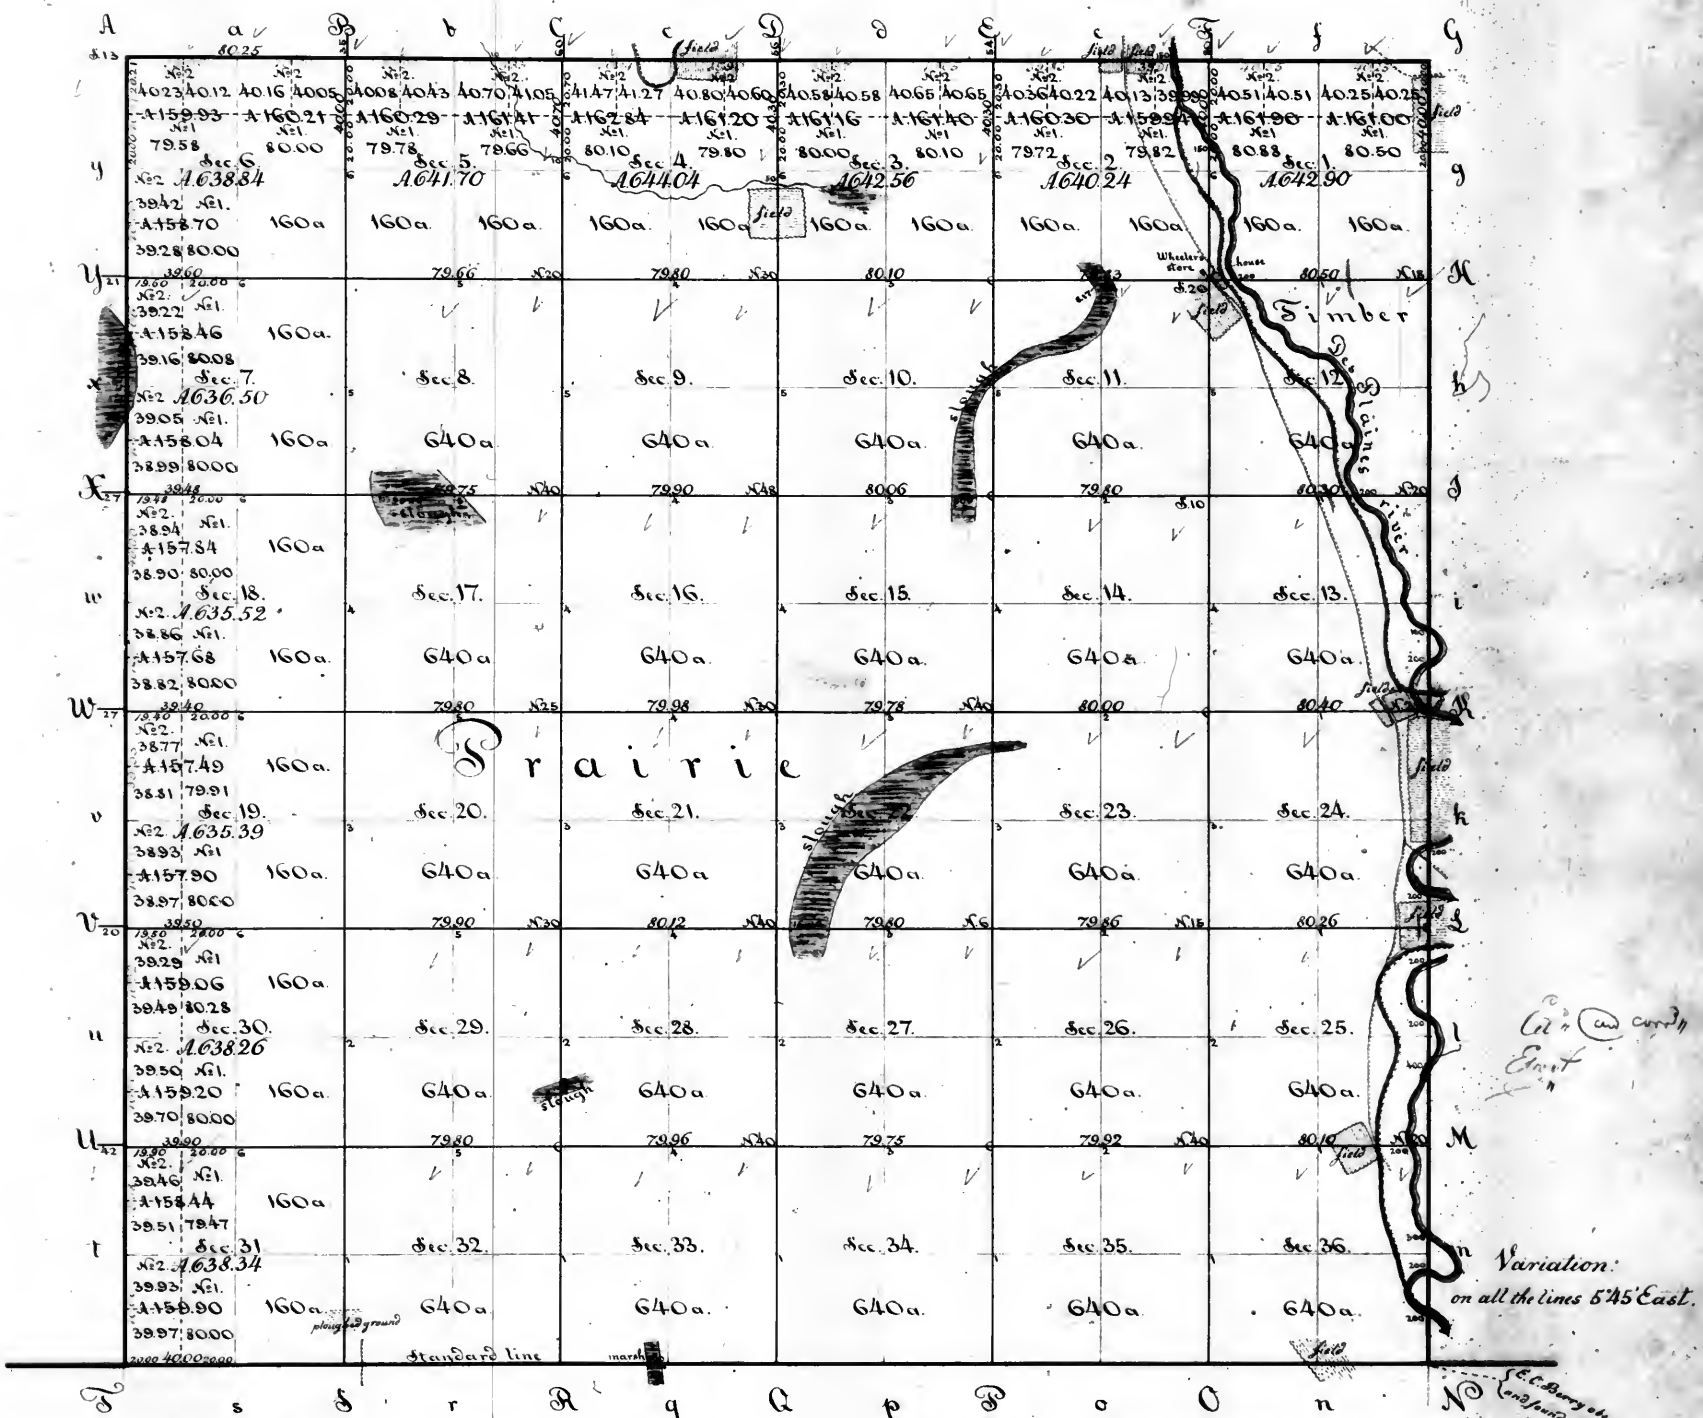

Surveyor's Office.
Saint Louis 24 June 1840.


Scale of 40 chains to one inch.
Aggregate area 23134.29 acres

The above plan of township No 42 north of the base line range 11 east of the 3^d principal meridian is strictly conformable to the field notes of the survey of said township on file in this office which have been examined and approved. The South boundary 6 miles was surveyed in the 2^d quarter of 1837, by James Thompson under contract signed by the Surveyor General on the 21st of November 1836, and by the said Thompson on the 15th of December of the same year; it was paid for in the 3^d quarter of 1839, and charged in the accounts current of the Surveyor General for said quarter, Voucher No 6. The West boundary 6 miles, was surveyed in the 2^d quarter of 1838 - the east boundary 6 miles - the north boundary 6 miles and 25 links - and the subdivision lines 59 miles 78.31 chains, were surveyed in the 3^d quarter of 1838, all by E. C. Berry, under contract dated the 9th of September 1837; they were paid for in this 2^d quarter of 1840, and they will be charged in the account current of the Surveyor General, during said quarter, under the general appropriation for surveying the public lands. Voucher No 11.

William Wilson
Surveyor of the public lands in
the States of Illinois and Missouri.

Township N^o 43 North of the Base line in Range N^o 11 East of the 3^d principal Meridian.

43

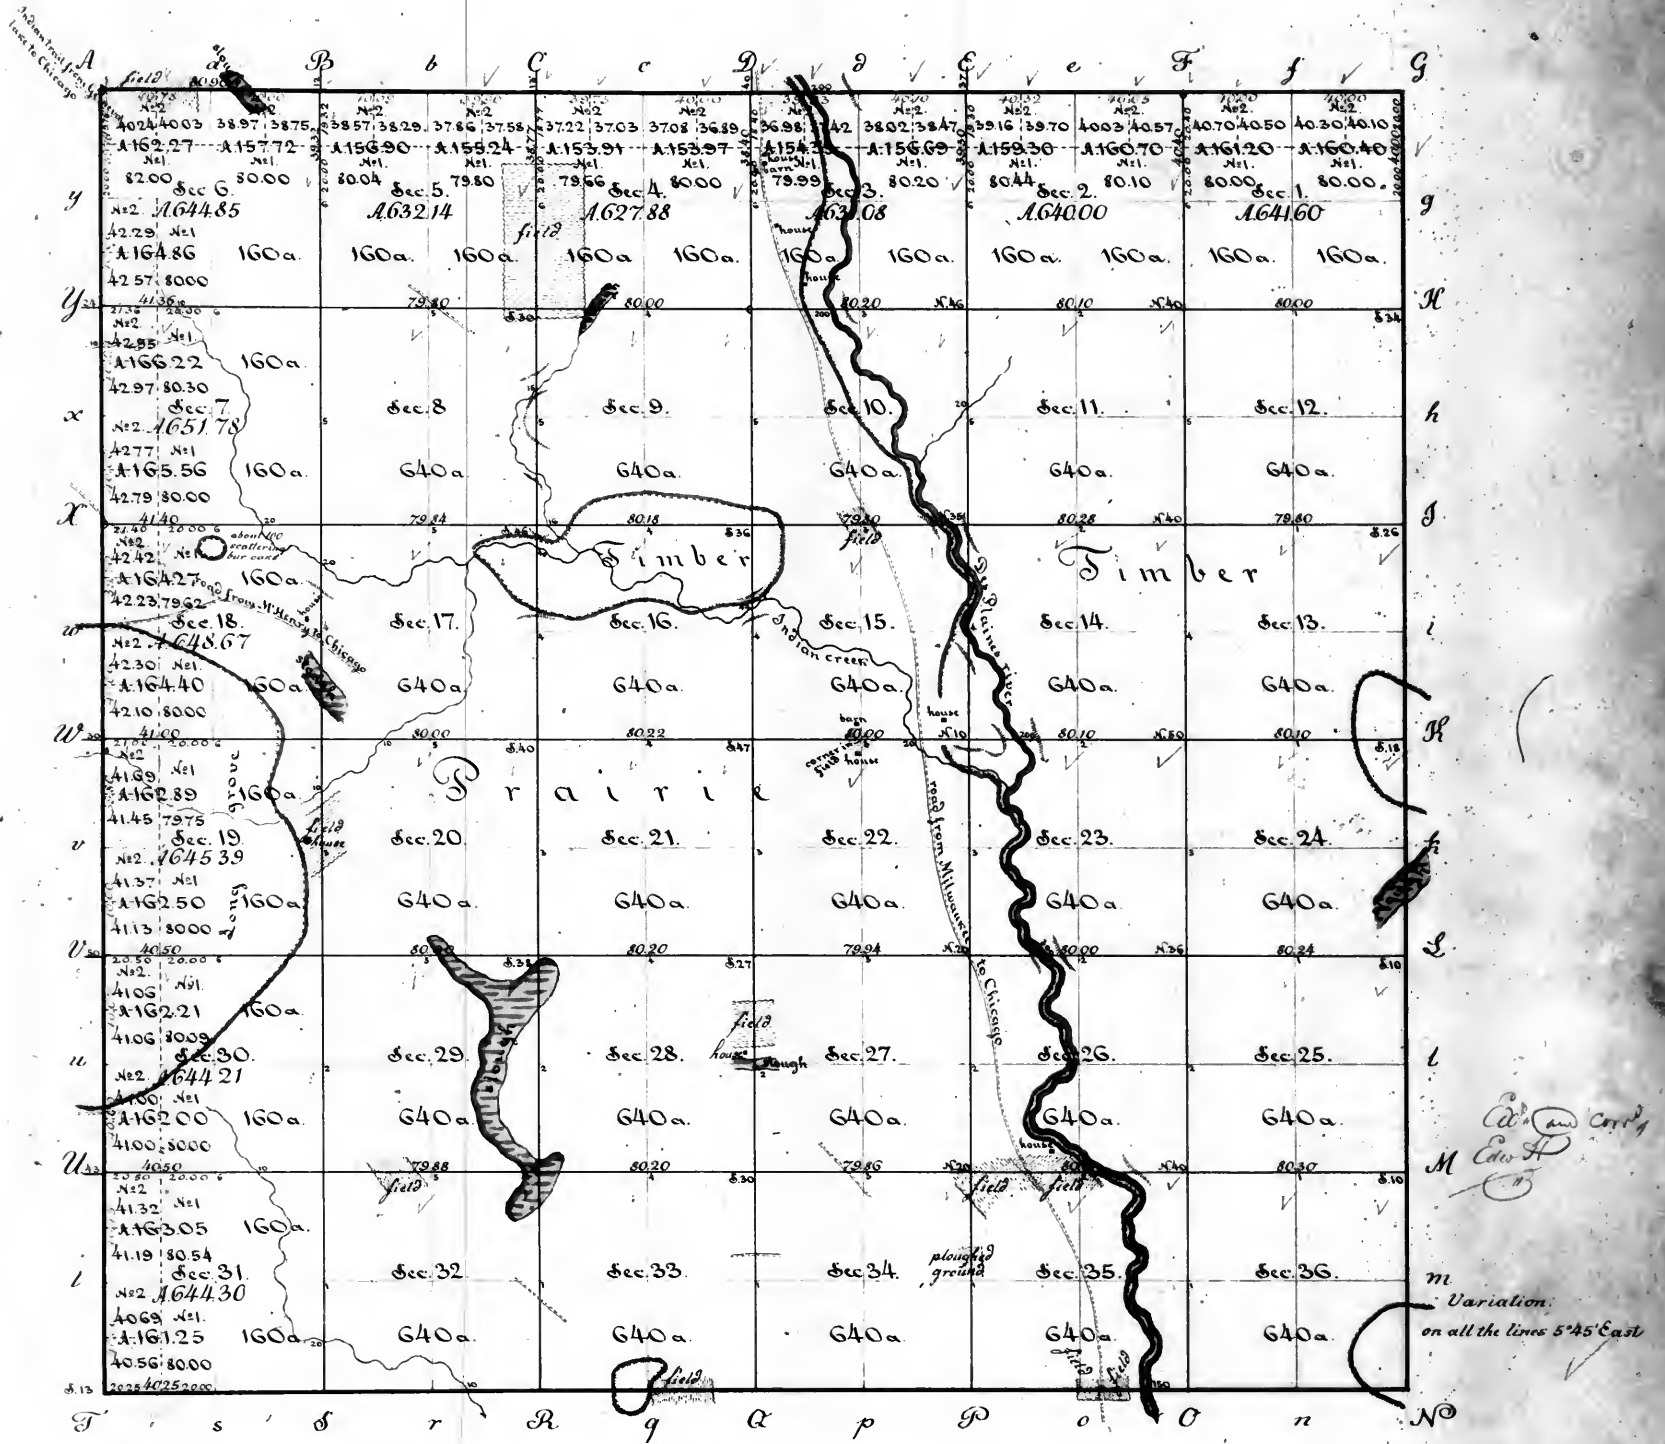

Surveyors' Office.

Saint Louis 24 June 1840.

Scale of 40 chains to one inch.


Aggregate area 23051.90 acres.

The above plat of township 43 north of the base line, range 11 east of the 3^d principal meridian is strictly conformable to the field notes of the Survey thereof on file in this office which have been examined and approved. The west boundary 6 miles was surveyed in the 2^d quarter of 1838 - the south boundary 6 miles and 25 links - the east boundary 6 miles - the north boundary 6 miles and 90 links, and the subdivision lines 60 miles 1.99 chains, were surveyed in the 3^d quarter of 1838, all by E. C. Berry, under contract of the 9th of September 1837. - They were paid for in this 2^d quarter of 1840; and they will be charged in the account current of the Surveyor General, during said quarter, under the general appropriation for surveying the public land, Voucher N^o 11.

William Wilson
Surveyor of the public lands in
the States of Illinois and Missouri.

Township 44 North of the base line Range 11 East of the 3^d principal Meridian

44

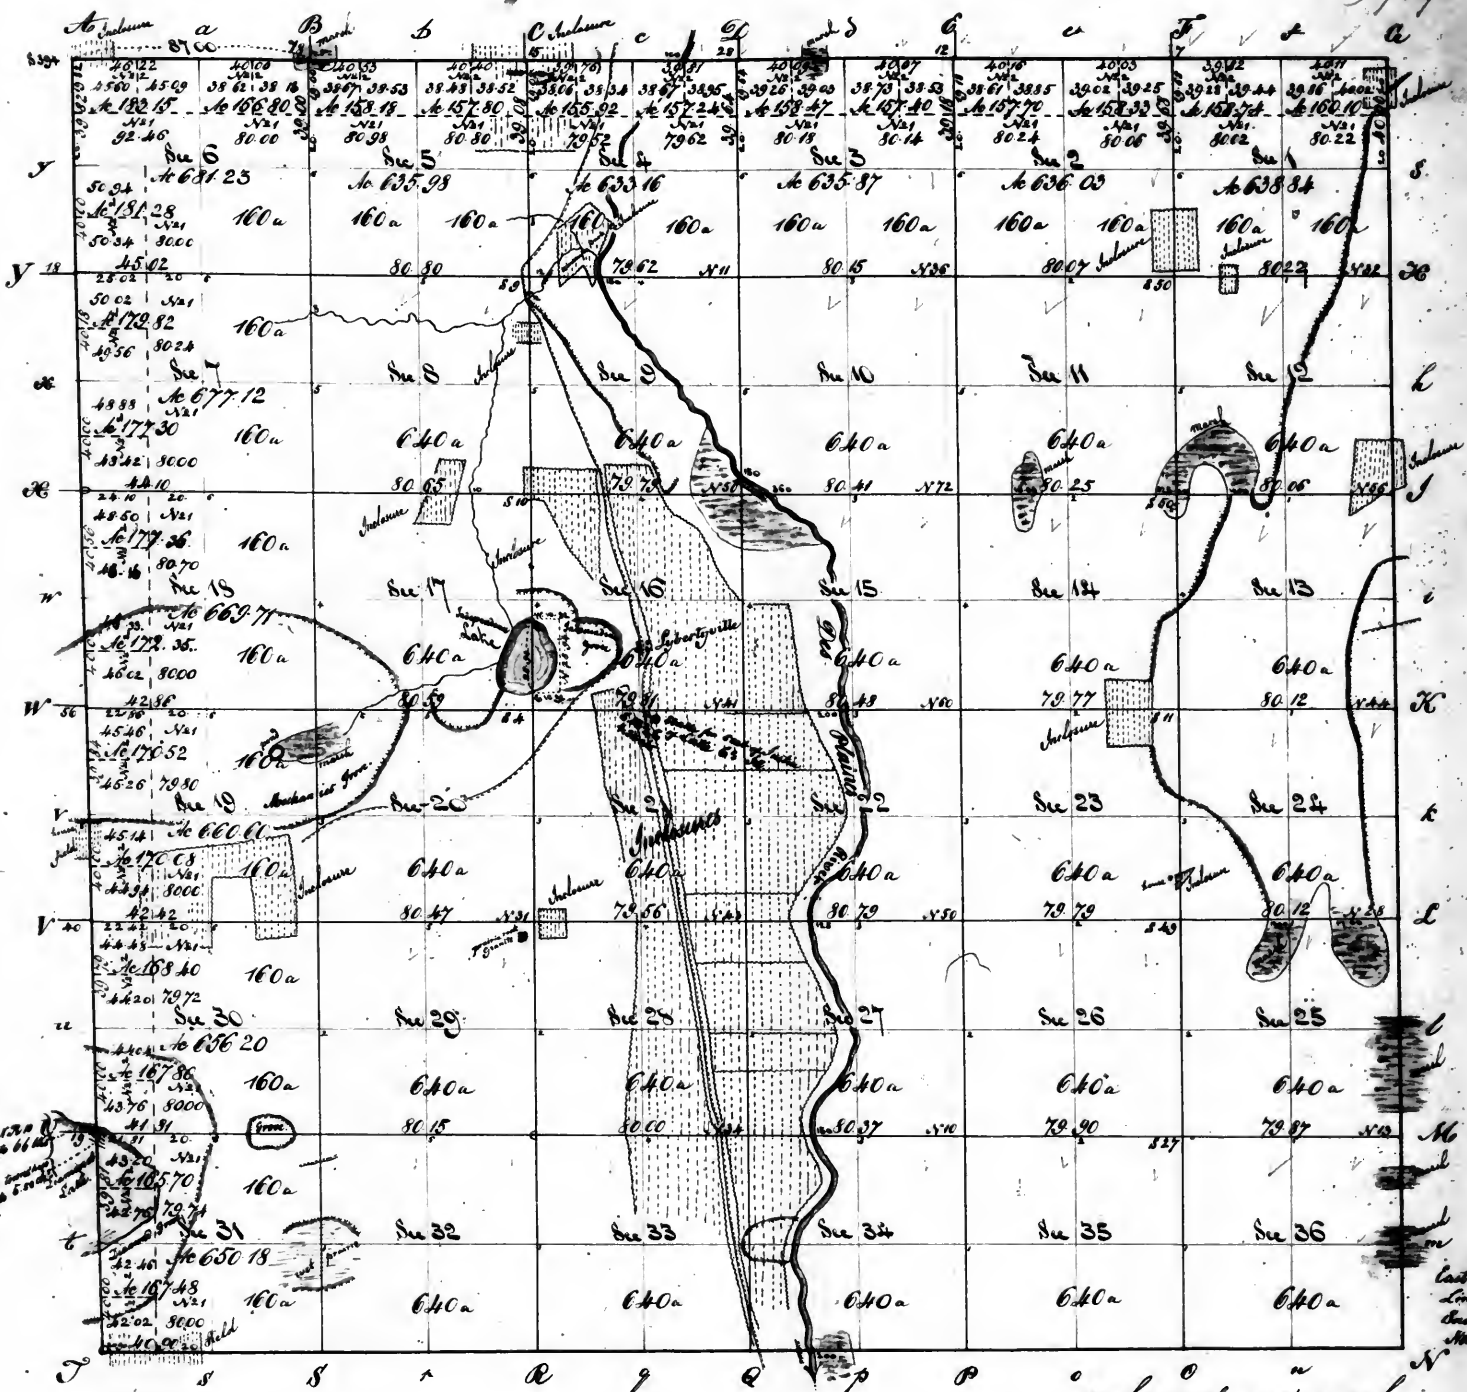

East boundary and subdivision lines
South and West boundaries
North boundary

Surveyors Office.
Saint Louis 8th of December 1840.

Scale of 40 Chains to an inch
Aggregate Area - 2317.92 acres.


The above plat of township 44 north of the base line, range 11 east of the 3^d principal meridian, is strictly conformable to the field notes of the Survey thereof on file in this office which have been examined and approved: - The west boundary 6 miles was surveyed in the 2^d quarter of 1838; and the South boundary 6 miles and 70 chains, was surveyed in the 3^d quarter of 1838, by E. C. Berry under contract of the 9th of September 1837: - they were paid for in the 2^d quarter of 1840 and charged in the account current of the Surveyor General, during the said quarter, Voucher N^o 11 - The east boundary 6 miles was surveyed in the 4th quarter of 1838 by W. J. Hill for George W. Harrison, under his contract of the 26th of September 1839: - it was paid for in this 4th quarter of 1840; and it will be charged in the account current of the Surveyor General, during the said quarter, Voucher N^o 11 - The north boundary 6 miles and 7 chains, and the subdivision lines, 60 miles 16-60 chains, were surveyed in the 3^d quarter of 1840, by George W. Harrison, under instructions of the 17th of February 1840, authorizing said Harrison to complete the unfinished above mentioned contract of E. C. Berry of the 9th of September 1837. - These surveys by Harrison, were paid for in this 4th quarter of 1840; and they will be charged in the account current of the Surveyor general, during the said quarter, under the General appropriation for surveying the public land, Voucher N^o 12 -

M. Milburn
Surveyor of the public lands in
the States of Illinois and Missouri.

[Signature]

Township 45 North of the base line Range 11 East of the 3^d principal Meridian

45

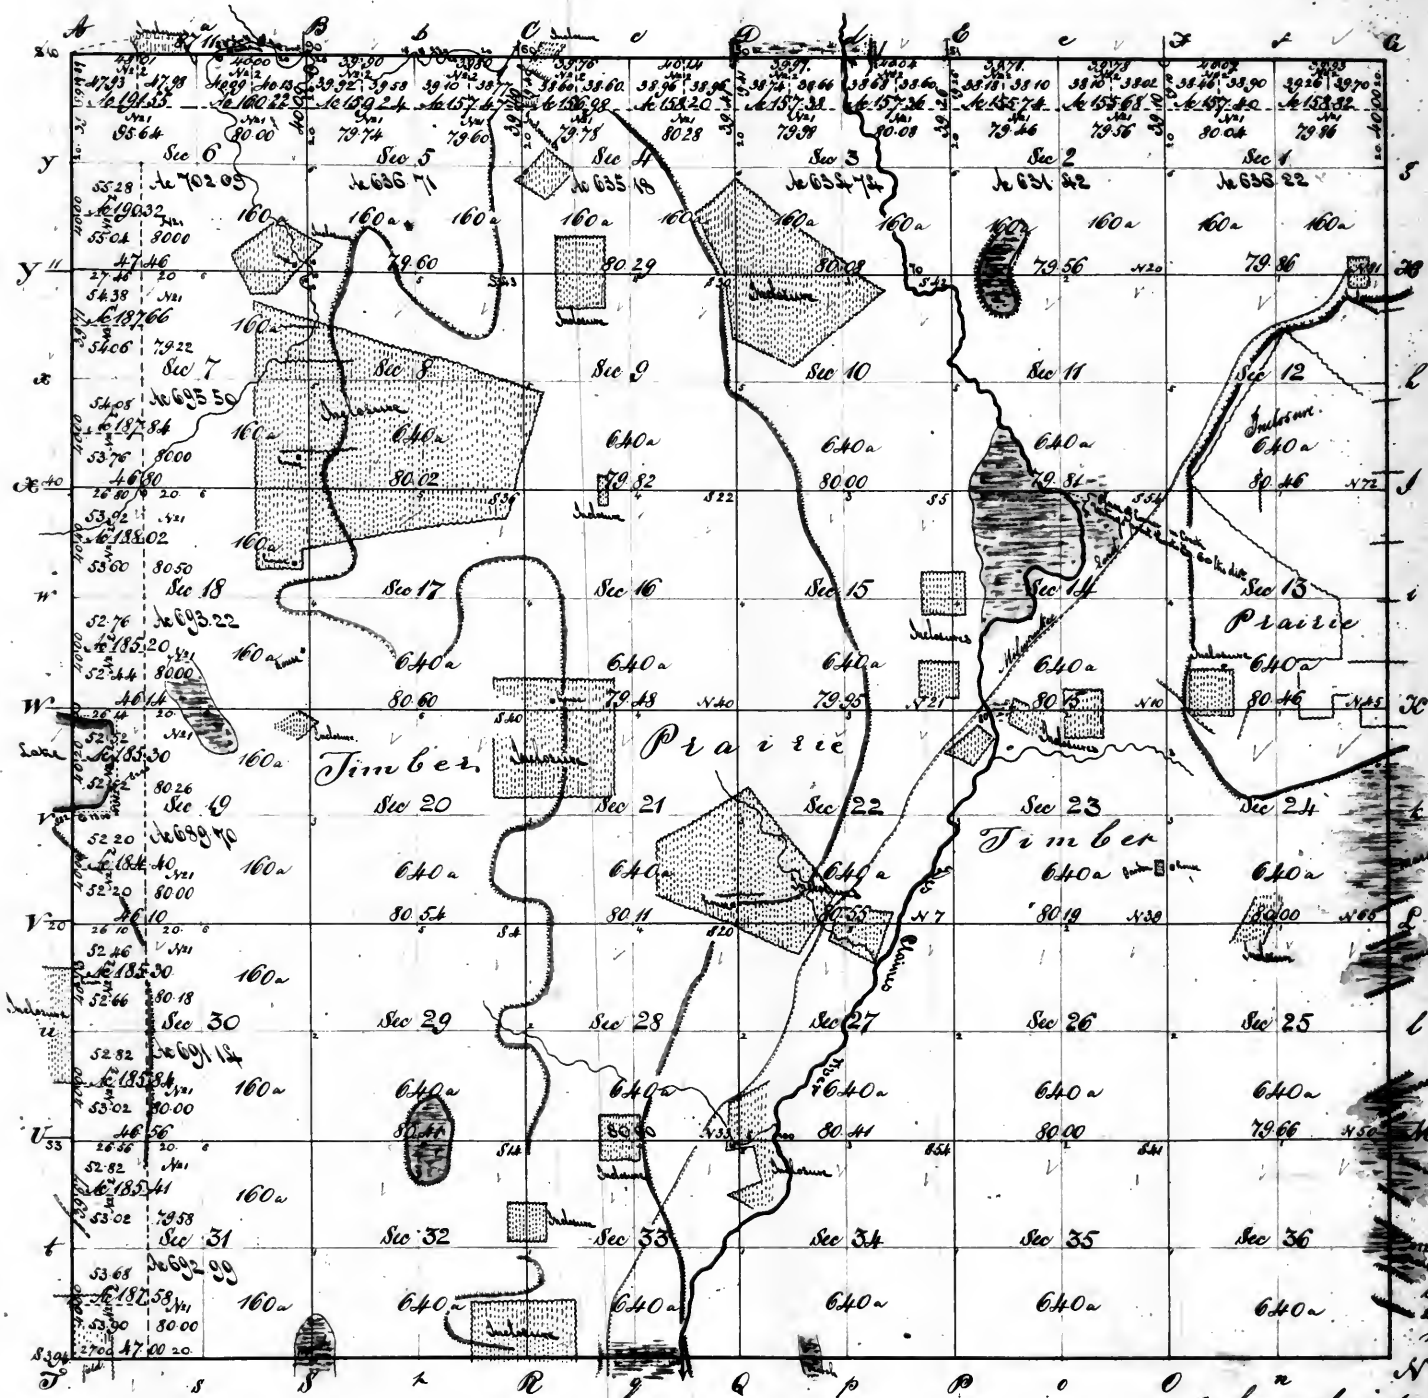

Surveyor's office.
Saint Louis 8th of December 1840.

The above plat of township 45 north of the base line, range 11 east of the 3^d principal Meridian is strictly conformable to the field notes of the Survey thereof on file in this office which have been examined and approved - The east boundary 6 miles, was surveyed in the 4th quarter of 1839, by William P. Hull, under the contract of George W. Harrison of the 26th of September 1839 - it was paid for in this 4th quarter of 1840, and it will be charged in the account current of the Surveyor general, during the said quarter, Voucher N^o 11 - The north boundary 6 miles - The west boundary 6 miles - The South boundary 6 miles and 7 chains - and the Subdivision lines 60 miles 32.55 chains, were surveyed in the 3^d quarter of 1840, by George W. Harrison, under instructions dated the 17th February 1840, authorizing said Harrison to complete the unfinished contract of G. C. Dwyer of the 3rd of September 1837. These surveys by Harrison were paid for in this 4th quarter of 1840, and they will be charged in the account current of the Surveyor General during the said quarter, under the general appropriation for surveying the public lands, Voucher N^o 12.


William Milburn

Surveyor of the public lands in
the State of Missouri.

2339.91

F

Section of the Williamson range R 22 C of the 4th p. M

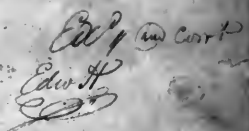


Scale of 40 chains to an inch.
Aguante Area = 21455.99 acres

94

the States of Illinois and Missouri.

Township 31 North of the base line, Range 12 East of the 3rd Principal Meridian.

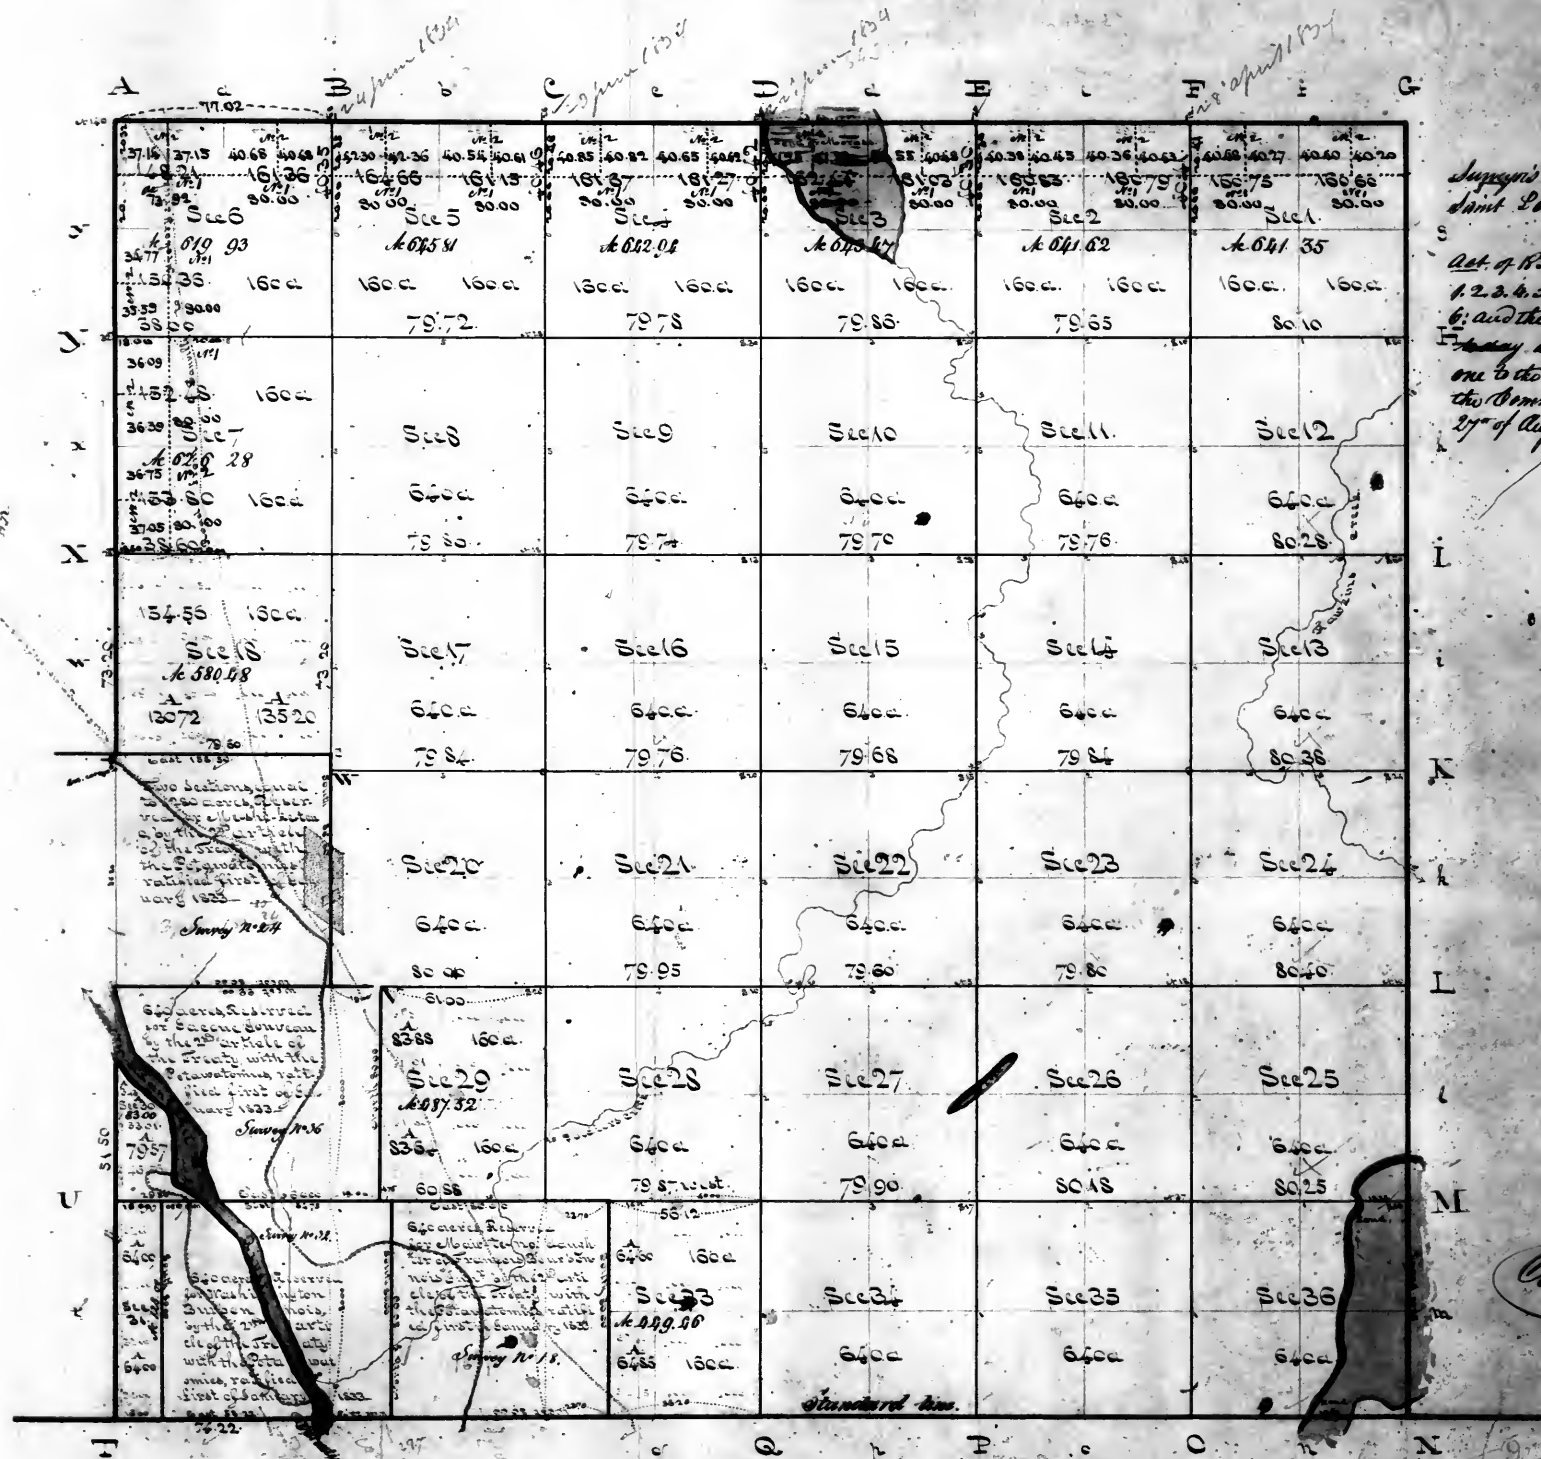

Surveyor's Office
Saint Louis, Mo. 1834
Subdivided under the
Act of 1832, 1833, the 4th & 5th of 1834
1, 2, 3, 4, 5, the 4th & 5th of 1834
6, and the 1st of 1837, and
the 1st of 1837, and
one to the Register, and another
to the Commissioner, on the
27th of August 1845.

Carroll's Title


Surveyor General's Office
Saint Louis, Mo. August 1839.

Public Land 20265.88 acres
Indian Reservations 2642.66 acres
Total 22882.52 acres

The above plat of township 31 north of the base line, range 12 east, of the 3rd principal meridian, is strictly conformable to the field notes of the survey thereof on file in this office, which have been examined and approved. The exterior lines were surveyed in the 4th quarter of 1839 - and the subdivision lines, meanders, and Indian reservations, were surveyed in the 2nd quarter of 1834, by Genl. W. Beckwith under contract of the 25th of October 1833.

William Miller
Surveyor General

Township 32 North of the base line, Range 12 East of the 3^d principal meridian

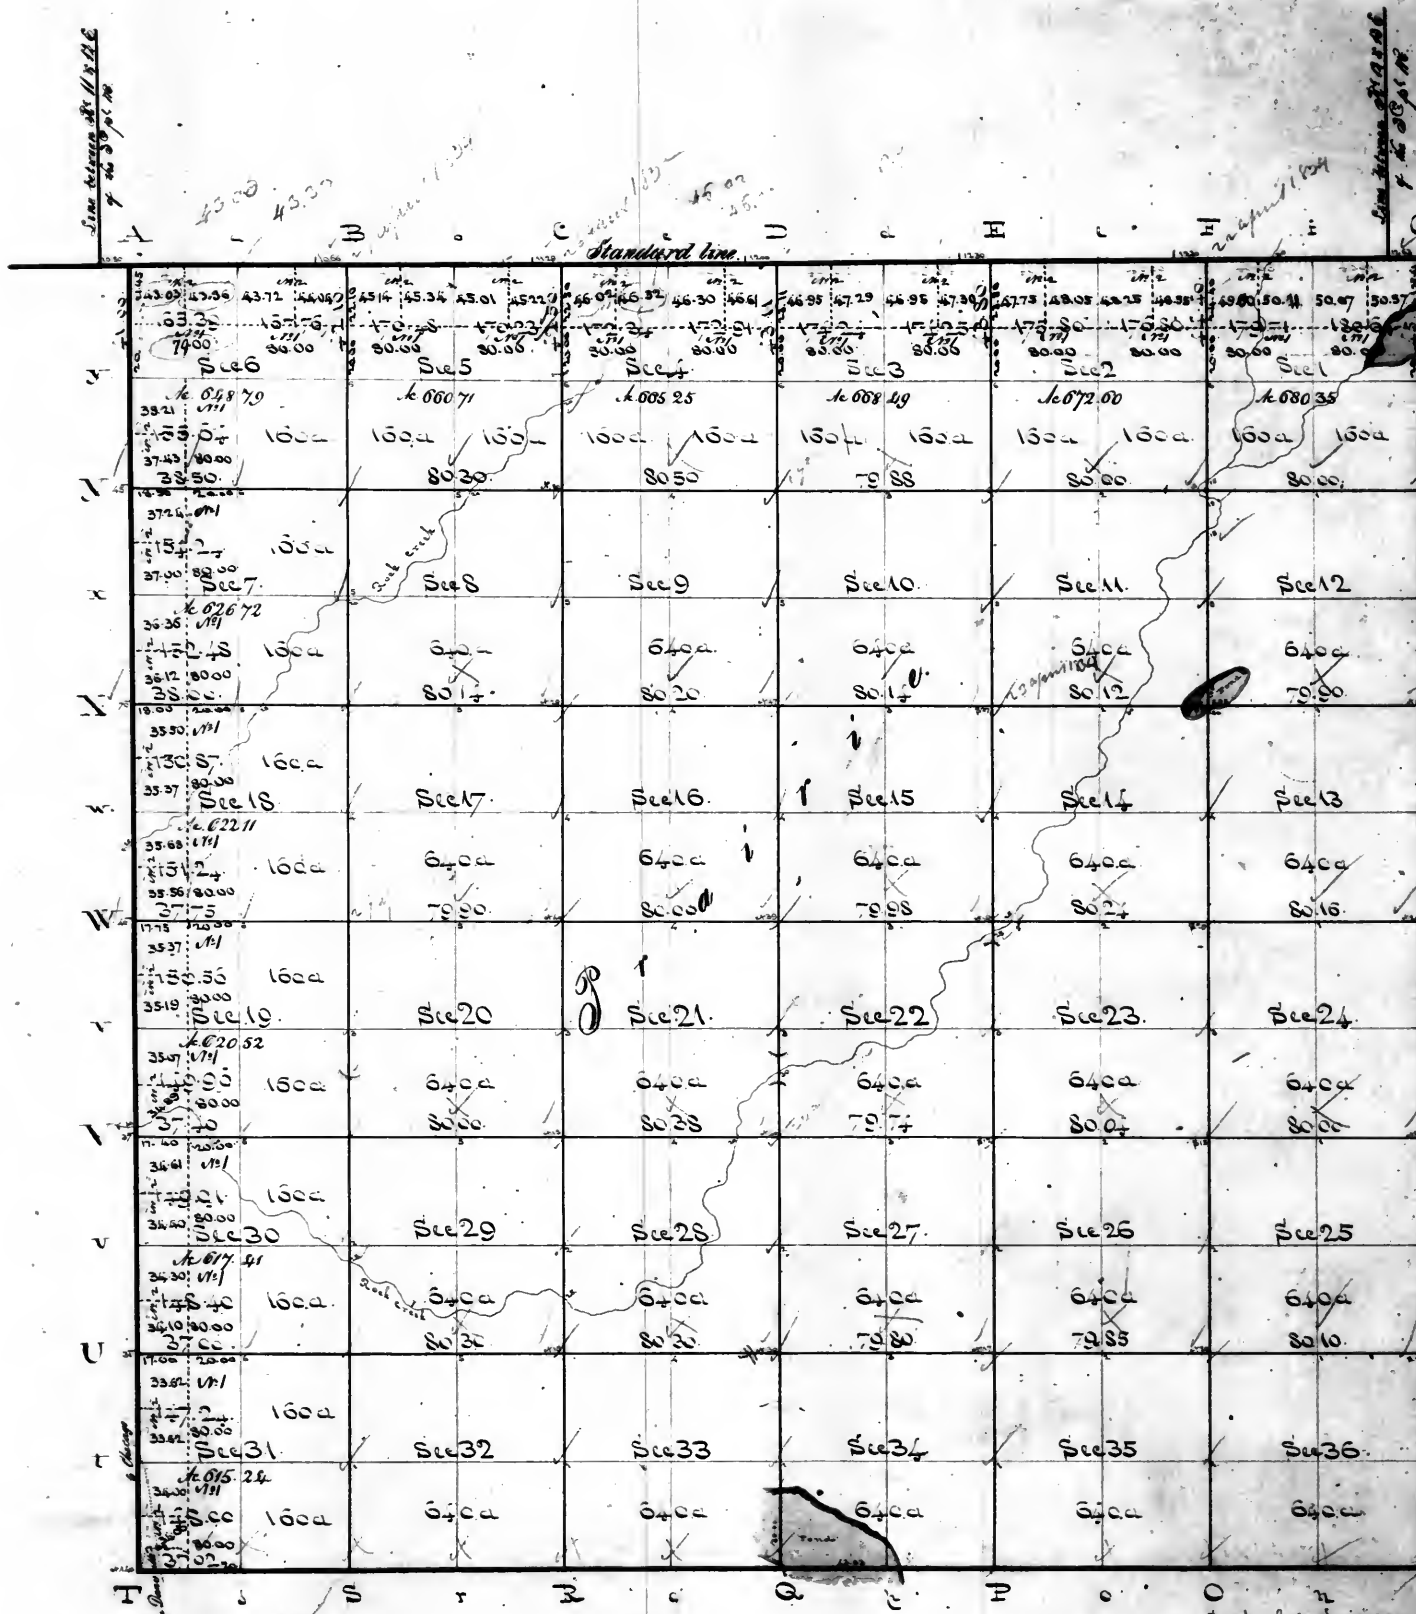

Surveyor's Office
Saint Louis 16th August 1859
Subdivided under
the act of 1832, by the N. E. of
Secs. 1, 2, of the plat the of one to the Regt.
and another in the same, on
the 17th of August 1845.

Variation
North boundary 7' 30" East.
All the other lines 7' East.

Surveyor General's Office.
Saint Louis 16th August 1859.


The above plat of Township 32 north of the base line, range 12 east of the 3^d principal meridian is strictly conformable to the field notes of the survey thereof on file in this Office, which have been examined and approved - The north boundary was surveyed in the 2^d quarter of 1834, by O. A. Spaulding, under contract of the 27th of October 1833 - And the South boundary was surveyed in the 4th quarter of 1833 - the East and west boundaries - and the subdivision lines were surveyed in the 2^d quarter of 1834, by Cash W. Deekwith under contract of the 29th of October 1833.

William Milburn
Surveyor General
Jt

Scale of 60 chains to an inch.
Aggregate area 23098.19 acres.

Township 33 North of the base line Range 12 East of 3^d principal Meridian

49

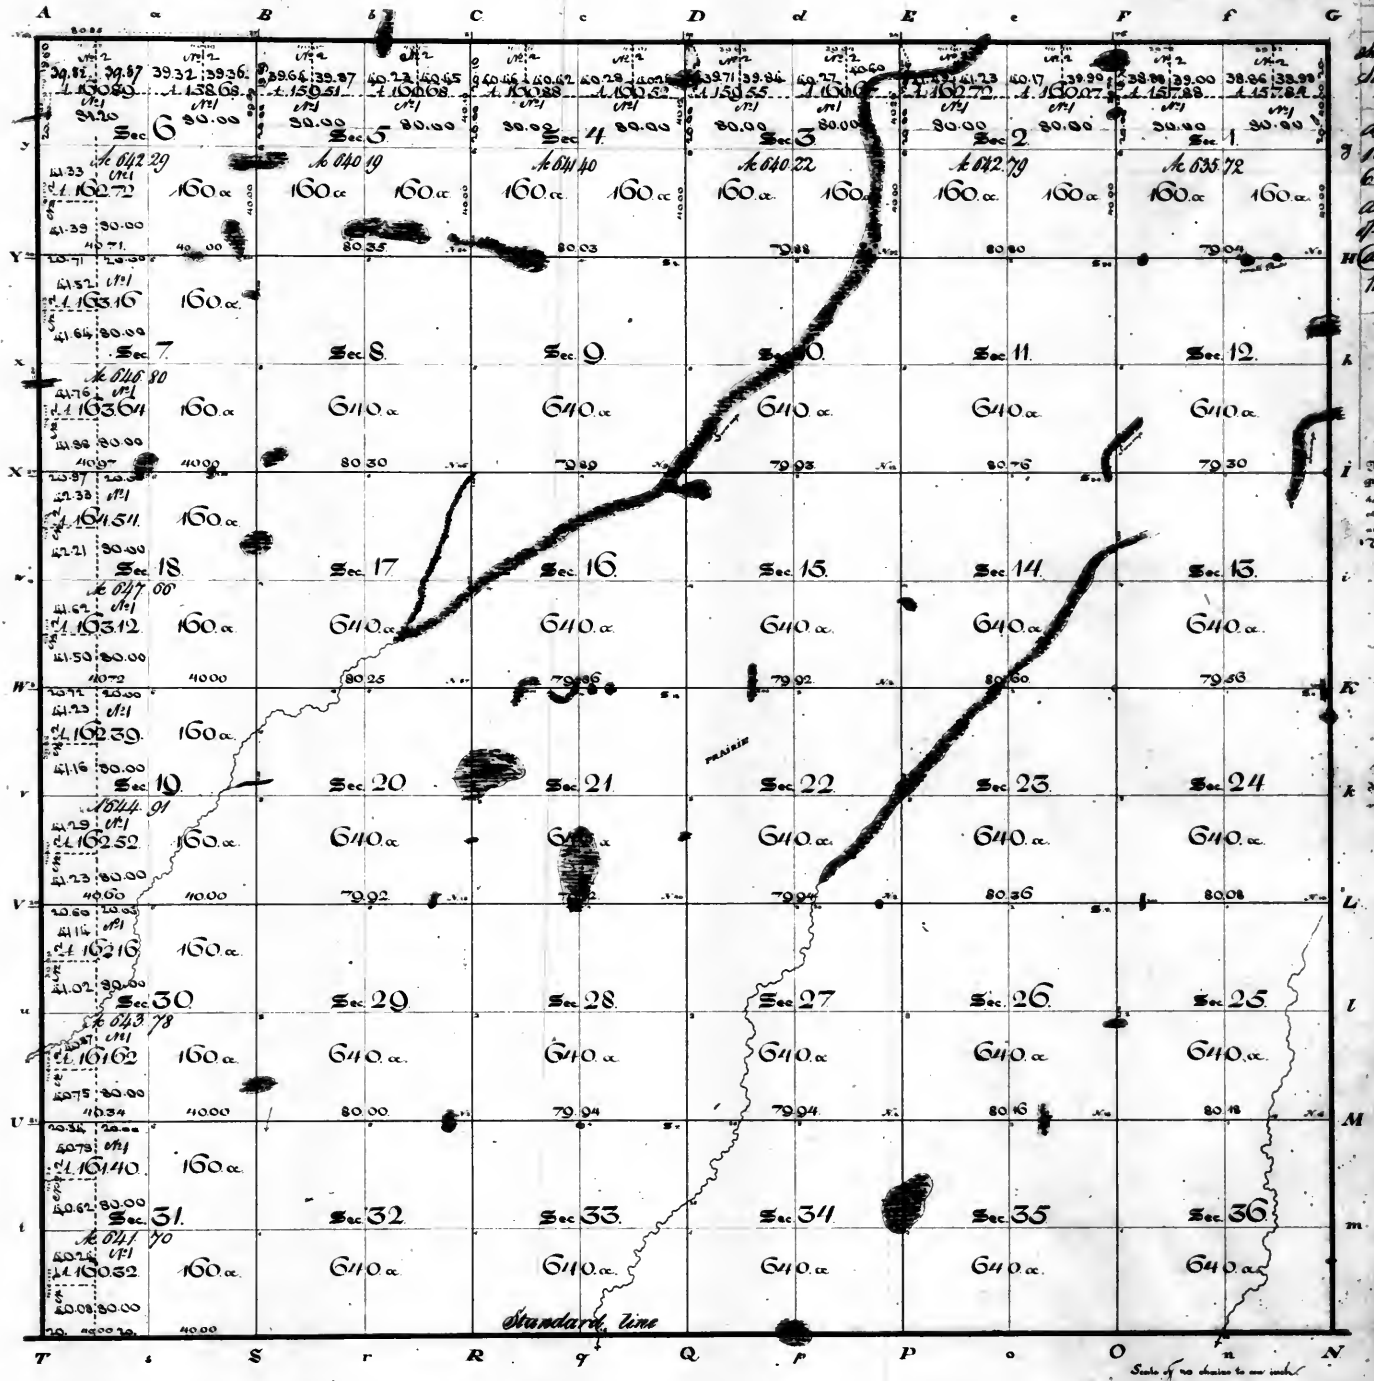

Surveyor's Office November
Saint Louis 12th 1853
Subdivided under
East and another to the West, on the
27th of August 1845.

The field notes and the construction of the
Plat were by Dea George Spaulding under
his contract of the 2^d of October 1833 and
changed for his account of the 20th of the
month 1836
The notes of the South boundary on 2^d 23^d
of May 1834
East boundary on 22^d of May 1834
North boundary on 22^d of May 1834
West boundary on 22^d of May 1834
Subdivision lines on 22^d of May 1834
20th of May 1834 from the
2^d to the 20th of July 1834

The South East North & West lines
divided the subdivisions lines were
changed at a distance of 100 East.


Aggregate Area 23067.46 ams

Surveyor's Office
St Louis 17th August 1853

This is a Plat of Township 33 North of the base line Range 12 East of 3^d principal Meridian, conformable to the field notes
of the survey thereof on file in the Office, which have been examined and approved. The colour boundary lines, were changed in the 2^d
quarter of 1834 - and the subdivision lines in the 2^d and 3^d quarters of 1834, - all by D. George Spaulding, under contract of
the 3^d of October 1833.

William Miller
Surveyor General
A4

Fractional Township 34 North of the base line Range 12 East of 3rd principal Meridian

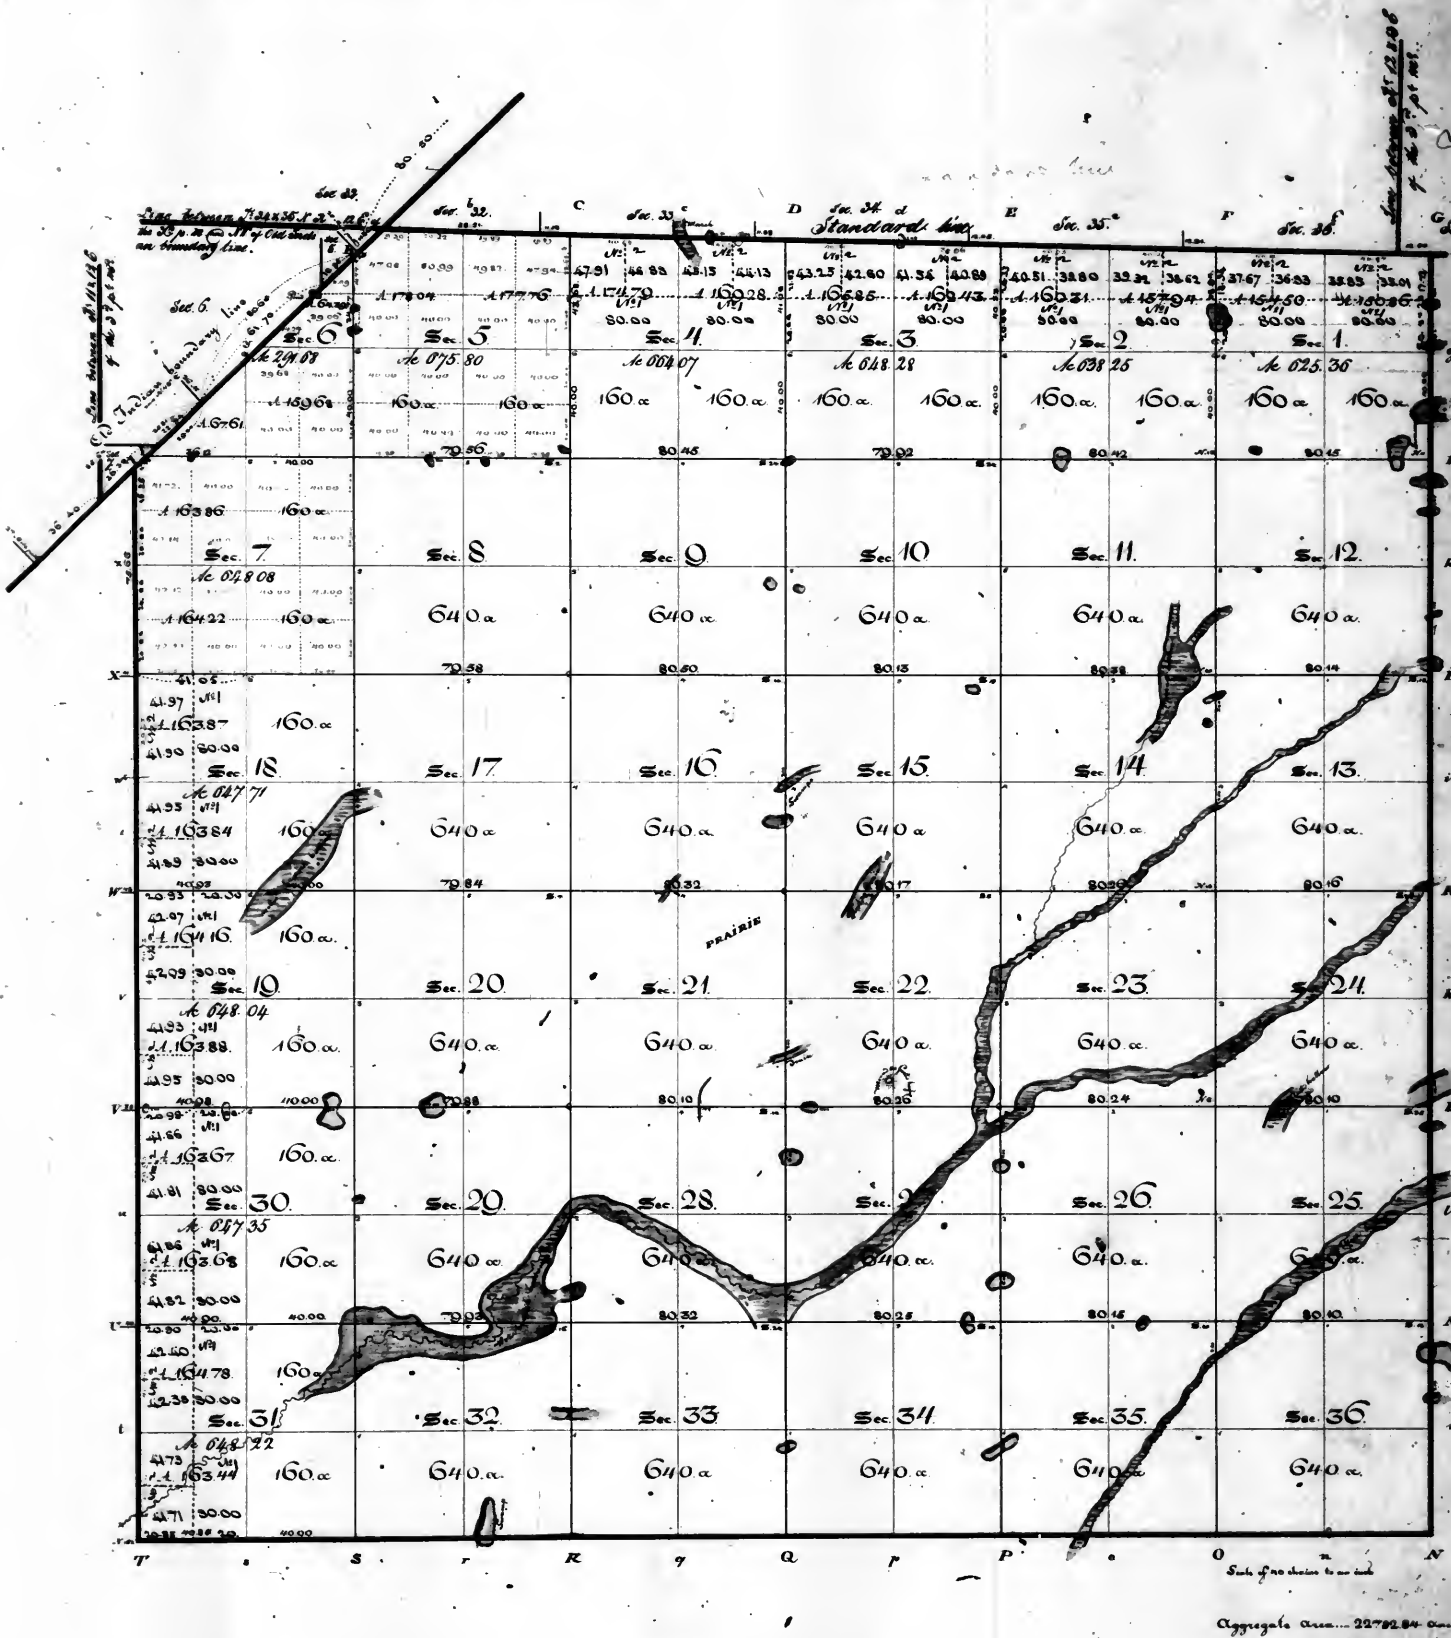

Surveyor's Office
St. Louis, Mo. August 1833.
27th of August 1845.

Reference to the field notes used in the construction of this Map of the North boundary by John Clark dated 15th of May 1834 of the South East & West boundaries, the Old Indian boundary line & Subdivision lines by Don Alving Spaulding under his contract of the 3rd of October 1833 and changed for in his account of the 19th of January 1835. The notes of the South boundary in vol. 22nd of May 1834. East boundary as dated 28th of May 1834. Old Indian boundary line as dated 29th of April 1834. West boundary as dated 19th of May 1834. Subdivision lines as dated from the 8th to the 17th of July 1834.

The South East & West boundaries of the Subdivision lines were surveyed at a bearing of 7th 30' East. The North boundary was surveyed at a bearing of 6th 40' East. The Old Indian boundary line was surveyed at a bearing of 6th 50' East.


Surveyor's Office
St. Louis, Mo. August 1833.

The above Map of Fractional Township 34 North of the base line Range 12 East of 3rd principal Meridian is, in conformity to the field notes of the survey thereof on file in this Office which have been examined and approved. The line designated 'Old Indian boundary line' was retraced and the corners or mile-points thereon were removed by Don Alving Spaulding in the 2nd quarter of 1833, under contract of the 3rd day of October 1833. The said 'Old Indian boundary line' was originally surveyed in the 1st quarter of 1819, by James M. Duncan, assistant to John C. Sullivan, under a letter of appointment from William Recker, Surveyor of the lands of the United States in Illinois and Missouri, dated October the 17th 1818, authorizing Sullivan as Surveyor and Duncan as assistant to survey under the direction of Commissioners Graham and Phelps, appointed by the President of the United States to run the line of the treaty ceded by the treaty of Ghent, signed of the 2nd of August 1816 (page 177 and following - land laws edition of 1833) - This being the line agreed to be run from a point on Lake Michigan 10 miles Southward of the mouth of the Chicago river, in a direct line to a point on the Kankakee 10 miles above its mouth - and was followed by John Sullivan and Duncan to run S. 87th 2' W. As on the 10th of March 1821 - being unable to find and properly identify this line and the mile-points thereon further Southward from the latter than the 8th mile-point, commenced thereon, and retraced S. 87th 2' W. and struck the banks of the Kankakee 130 miles South of the old line, but about 5 chains further Southward. It was this retraced line to which the Surveyor's line of the 10th of March 1821 was closed and which was retraced and removed by Spaulding; and is laid down on this map according to his notes. The north boundary was surveyed in the 2nd quarter of 1834 by John Clark, under contract of the 22nd of September 1833. The south, east, and west boundaries, were surveyed in the 2nd quarter of 1834 - and the Subdivision lines in the 3rd quarter of the same year - all by the said Spaulding, under his contract above mentioned.

William Miller
Surveyor General


Township 35 North of the base line, Range 12 East of the 3rd Principal Meridian

51

Surveyor General's Office
Saint Louis 26th August 1859.

The mile points designated on the old Indian boundary line are the points proper - marked one mile apart, according to the measurement on the said line at the time of the survey thereof, by Wells - Their numbers are progressive from Lake Michigan - The distances set down between said mile points are according to the measurement of W. C. Spaulding.

William Millman
Surveyor General
OK

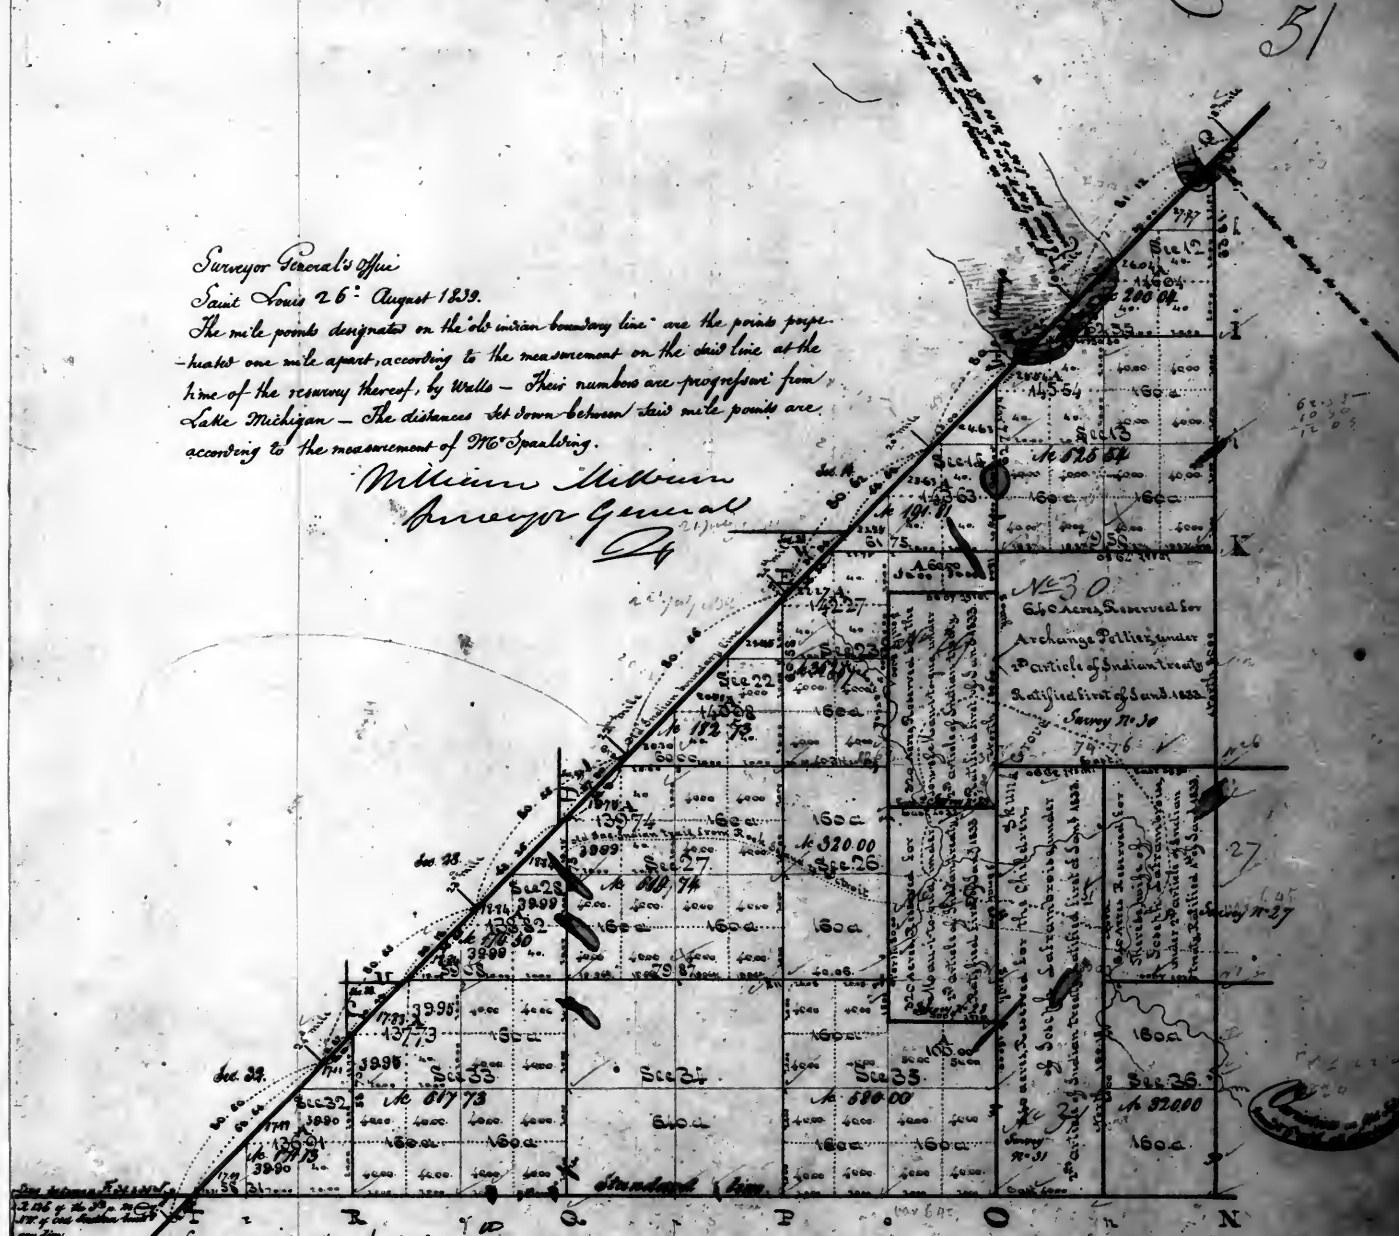


Surveyor General's Office. Saint Louis 26th August 1859.

The above plan of fractional township 35 north of the base line, range 12 east of the 3rd principal meridian, and the aggregate area of Public Land 5007.297 East of Old Indian boundary line is strictly conformable to the files and of the survey of said fractional township - Indian Reservations 2246.000
file in this Office, which have been examined and appeared on the line designated 'Old Indian boundary line' was returned and the errors on mile points therein corrected
was returned by Wm. A. Spaulding in the 2nd quarter of 1854, under contract of the 8th day of October 1855 - The said 'Old Indian boundary line' was originally surveyed
by James M. Duncan, assistant to John C. Sullivan, under a letter of appointment from William Rector, Surveyor of the lands of the United States in Indiana and Wisconsin
dated October the 18th 1818, authorizing Sullivan as Surveyor and Duncan as assistant to survey, under the direction of Commissioner Graham and Phelps, appointed by the
President of the United States to run the line of the treaty ceded by the treaty of Saint Louis of the 26th of August 1816 (page 177 and following) and line - which
of 1828) - This being the line agreed to be run - from a point on Lake Michigan 10 miles south of the mouth of the Chicago river, in a general line to a point
on the Kentucky 10 miles above its mouth - and was done by this Sullivan and Duncan to run S. 45° E. 2nd W. 40 miles and 18 chains - On the 8th quarter of 1821,
John Wells, whilst assisting Stephen Rector and Thomas C. Rector, in the execution of this contract of the 26th of March 1821, being unable to find and properly
locate this line and the mile points therein further South-westward from the latter than the 8th mile point, commenced thereat, and surveyed S. 45° E. 2nd W. and
marked the south of the Kentucky 120 miles South of the old line, but about 5 chains further South-westward - It was this erroneous line to which the survey
to the N. W. corner of the tract, and which was returned by Spaulding, and is laid down on this map, in accordance with his notes - The South boundary was
surveyed in the 2nd quarter of 1824 - the east boundary, in the 2nd and 3rd quarters of 1824 - and the subdivision line and Indian reservations, were surveyed in
the 3rd quarter of the same year - as by the C. Clerk, under contract of the 22nd of September 1855.

William Millman
Surveyor General
OK

52

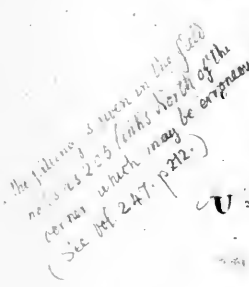

Areas of the several nations of
F. T. 35 N. R. 12 E. of the 3^d principal Meridian

Aggregate area in fl. T. 35. N. 12 E. = 16148.96 acres

Note. The line between Sections 12 & 13 was
"in line with the old survey."


Note. The line between Sections 12 & 13 was surveyed East 20.25 chains to an
inaccessible point in the area of the adjoining fraction and therefore
determined, not from the actual measurement of the said line
between Sections 12 & 13, but from its estimated length.
The tower between 12 & 13 had been
estimated length

The above Plat of fractional Township, 34 & 35 North of the base line, Range 12 East of the 3^d Principal meridian, North West of the Old Indian Boundary line; with the exception stated in the above note; is conformable to the field notes of the survey thereof on file in this Office.


Surveyors Office: Saint Louis 18th of January 1841. L.

[illegible]

53

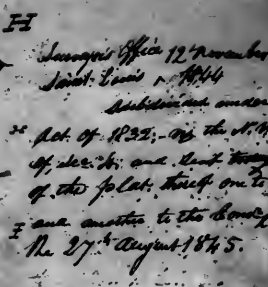

dentures on N.W. 1/4
Range 12 East of the 3.
E. J. Dwyer

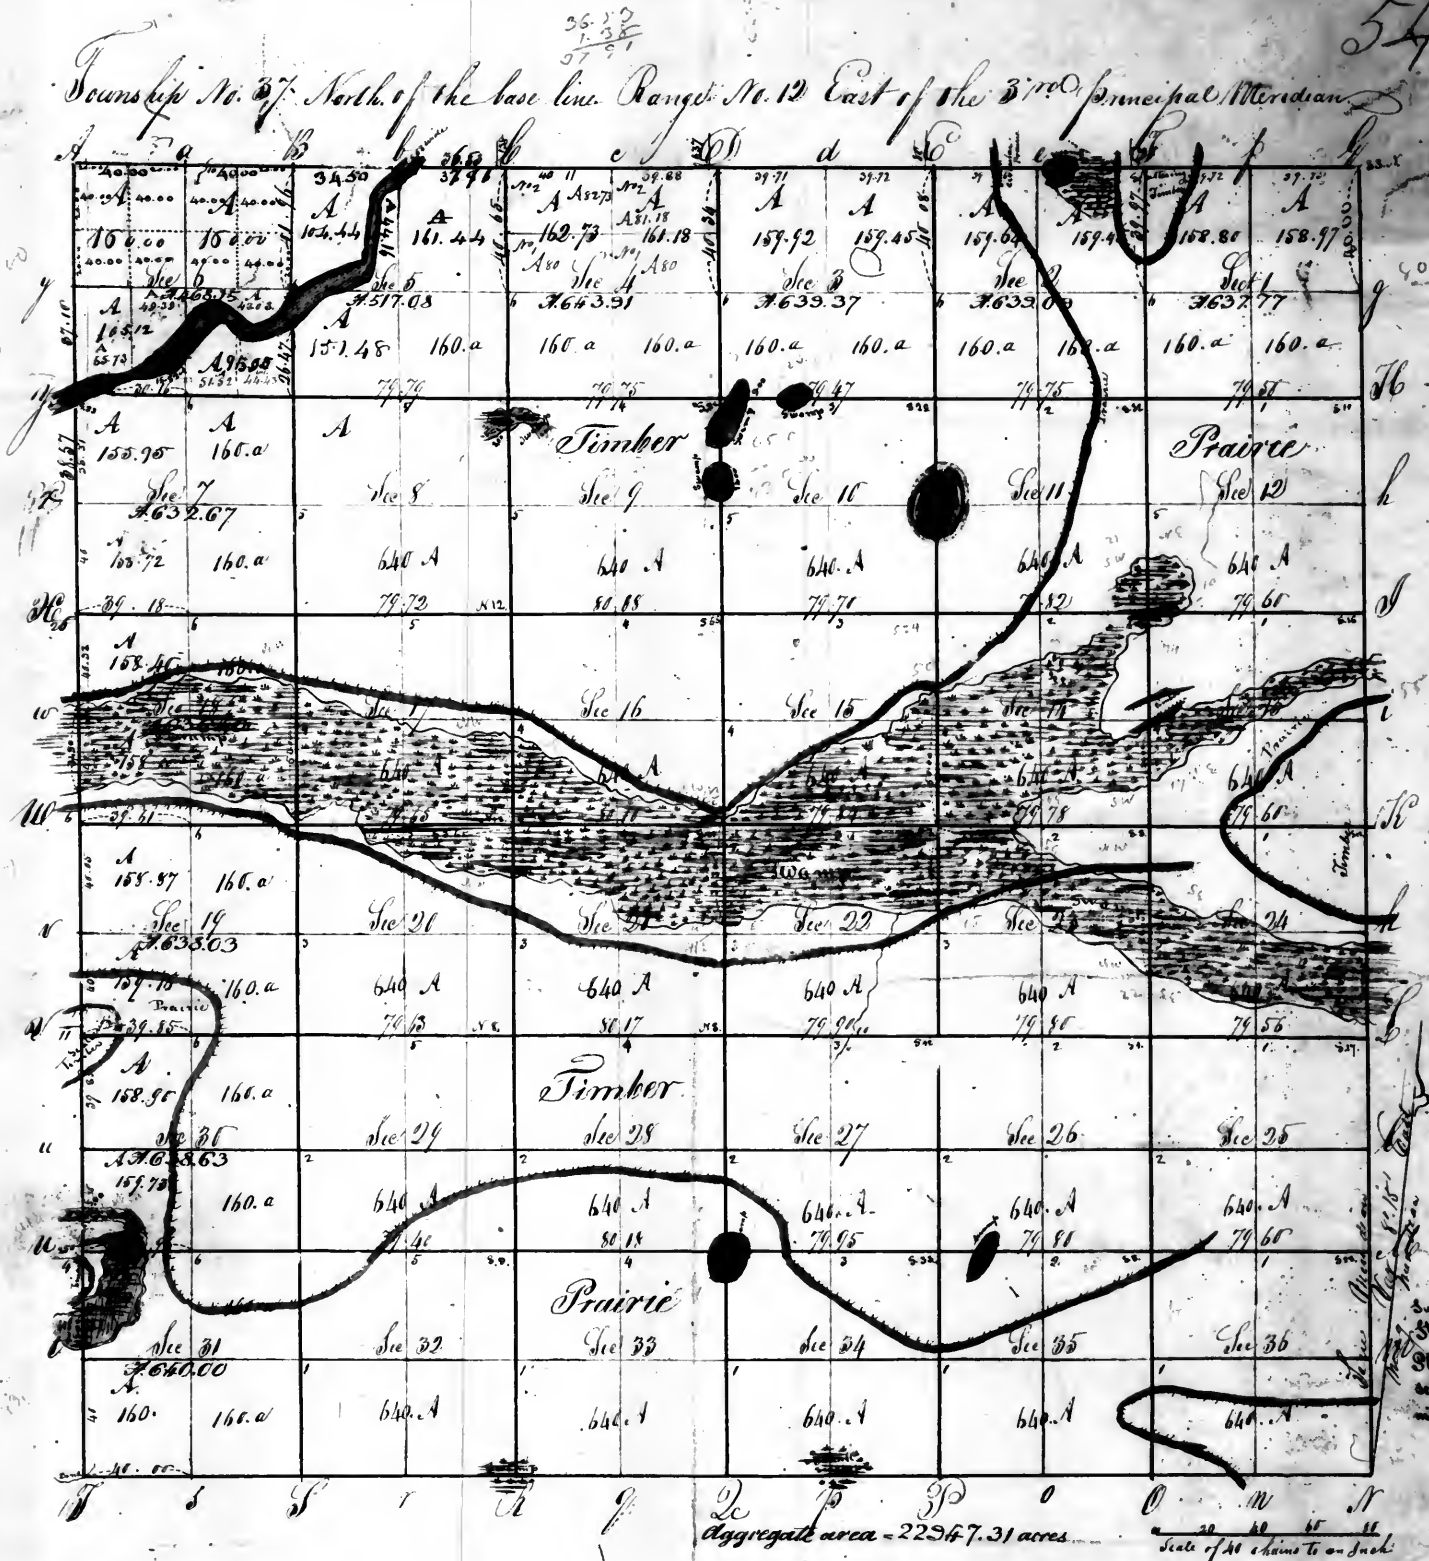

Pursuant to a contract with and instructions from William Rector, Surveyor of the lands of the United States in the States of Illinois, Missouri and Territory of Arkansas bearing date the twenty-sixth day of March 1821 we have admeasured, laid out and surveyed the above described Township and do hereby certify that it had such marks and bounds, both natural and artificial as are represented on said plat, and described in the field notes made thereof and returned with this plat into the office of the Surveyor of the lands of the United States in the States of Illinois, Missouri and Territory of Arkansas

Subscribed this 1st day of Nov 1822

Surveyors Office
St. Louis July 27 1834

Stephen Rector Deputy Surveyor


The above Plat of Township 37 North of the base line, Range 12 East of the 3rd Principal Meridian is conformable to the field notes of the Survey thereof on file in this Office.

W 140

E. J. Gentryham

55

Township 38 North of the base line, Range 12 East of 3^d principal Meridian.

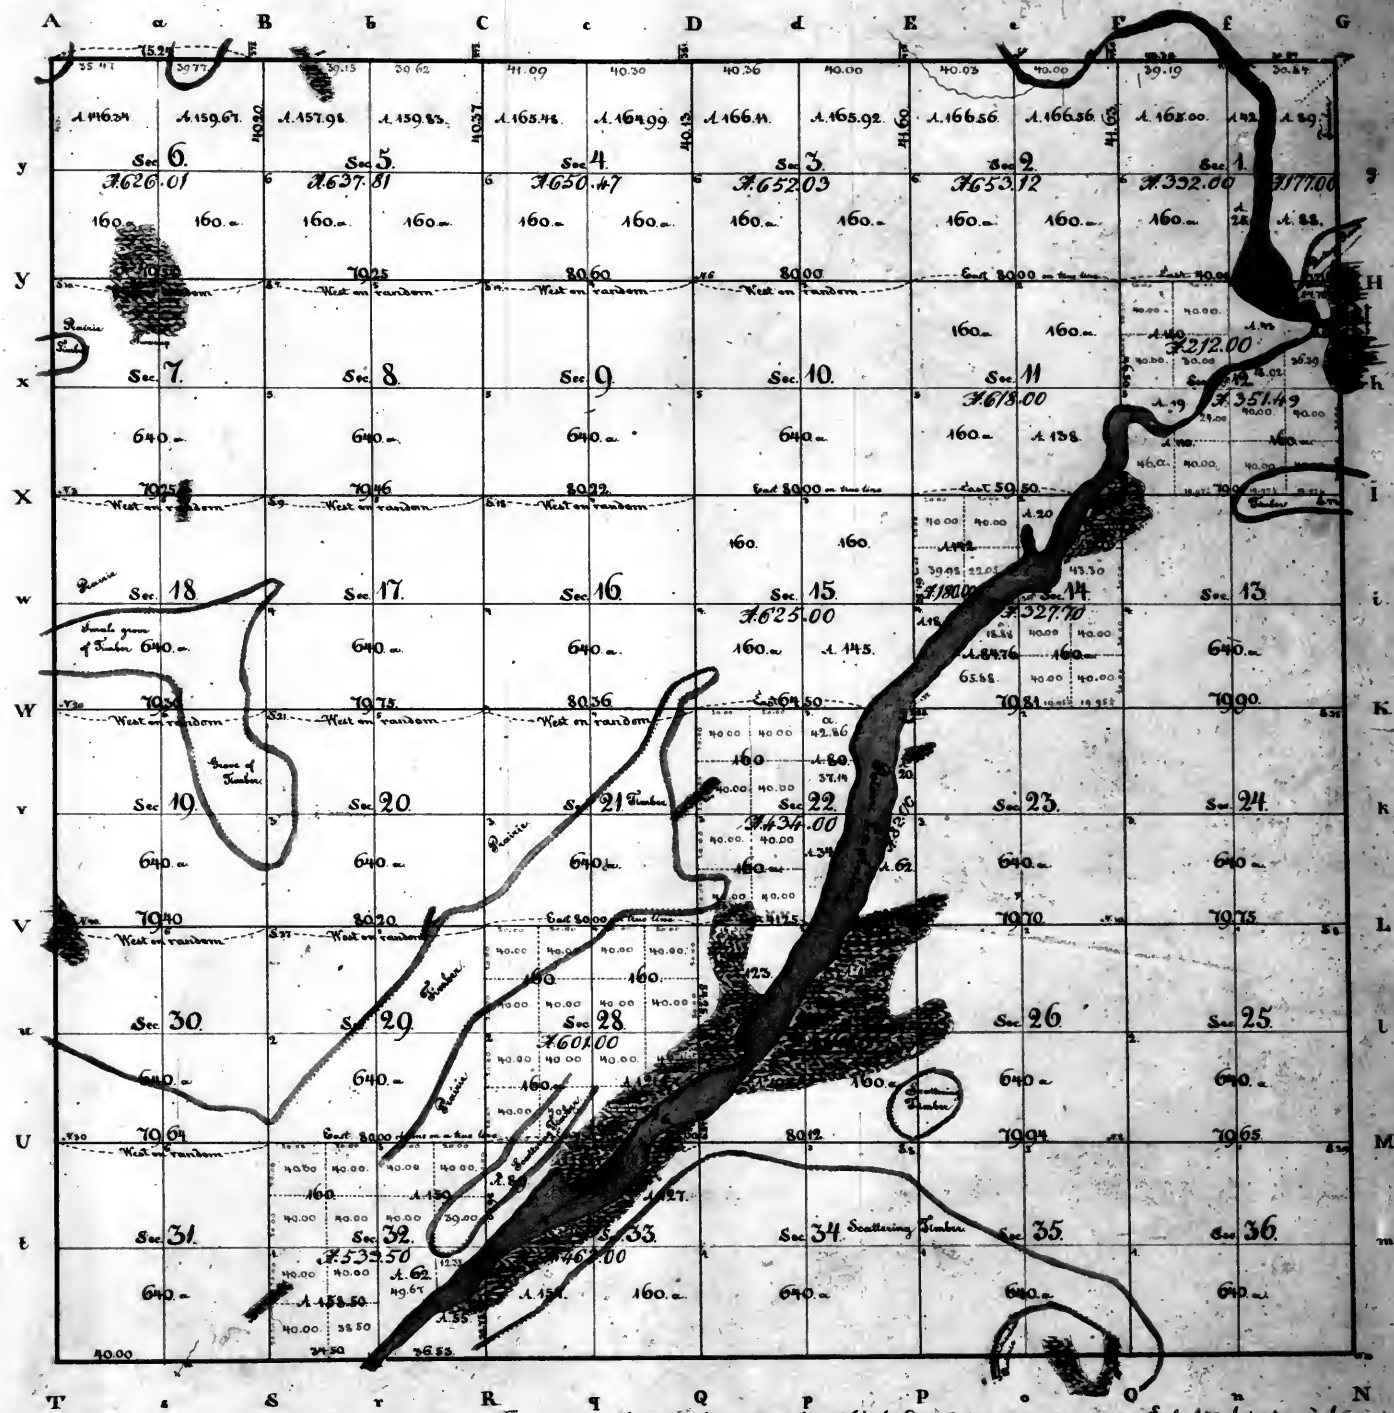


Aggregate area of public land = 22362.50 acres
 estimated area of the river = 550.00
 Total = 22912.50 acres

Surveyors Office
 St Louis Nov-29-1833

The above Plat of Township 38 North of the base line, Range 12 East of 3^d principal Meridian, is conformable to the field notes of the Survey thereof on file in this Office.

E. J. Smytham

Township No 39 North of the Base line Range No 12 East of the 3rd principal Meridian
South East of the old Indian boundary line.

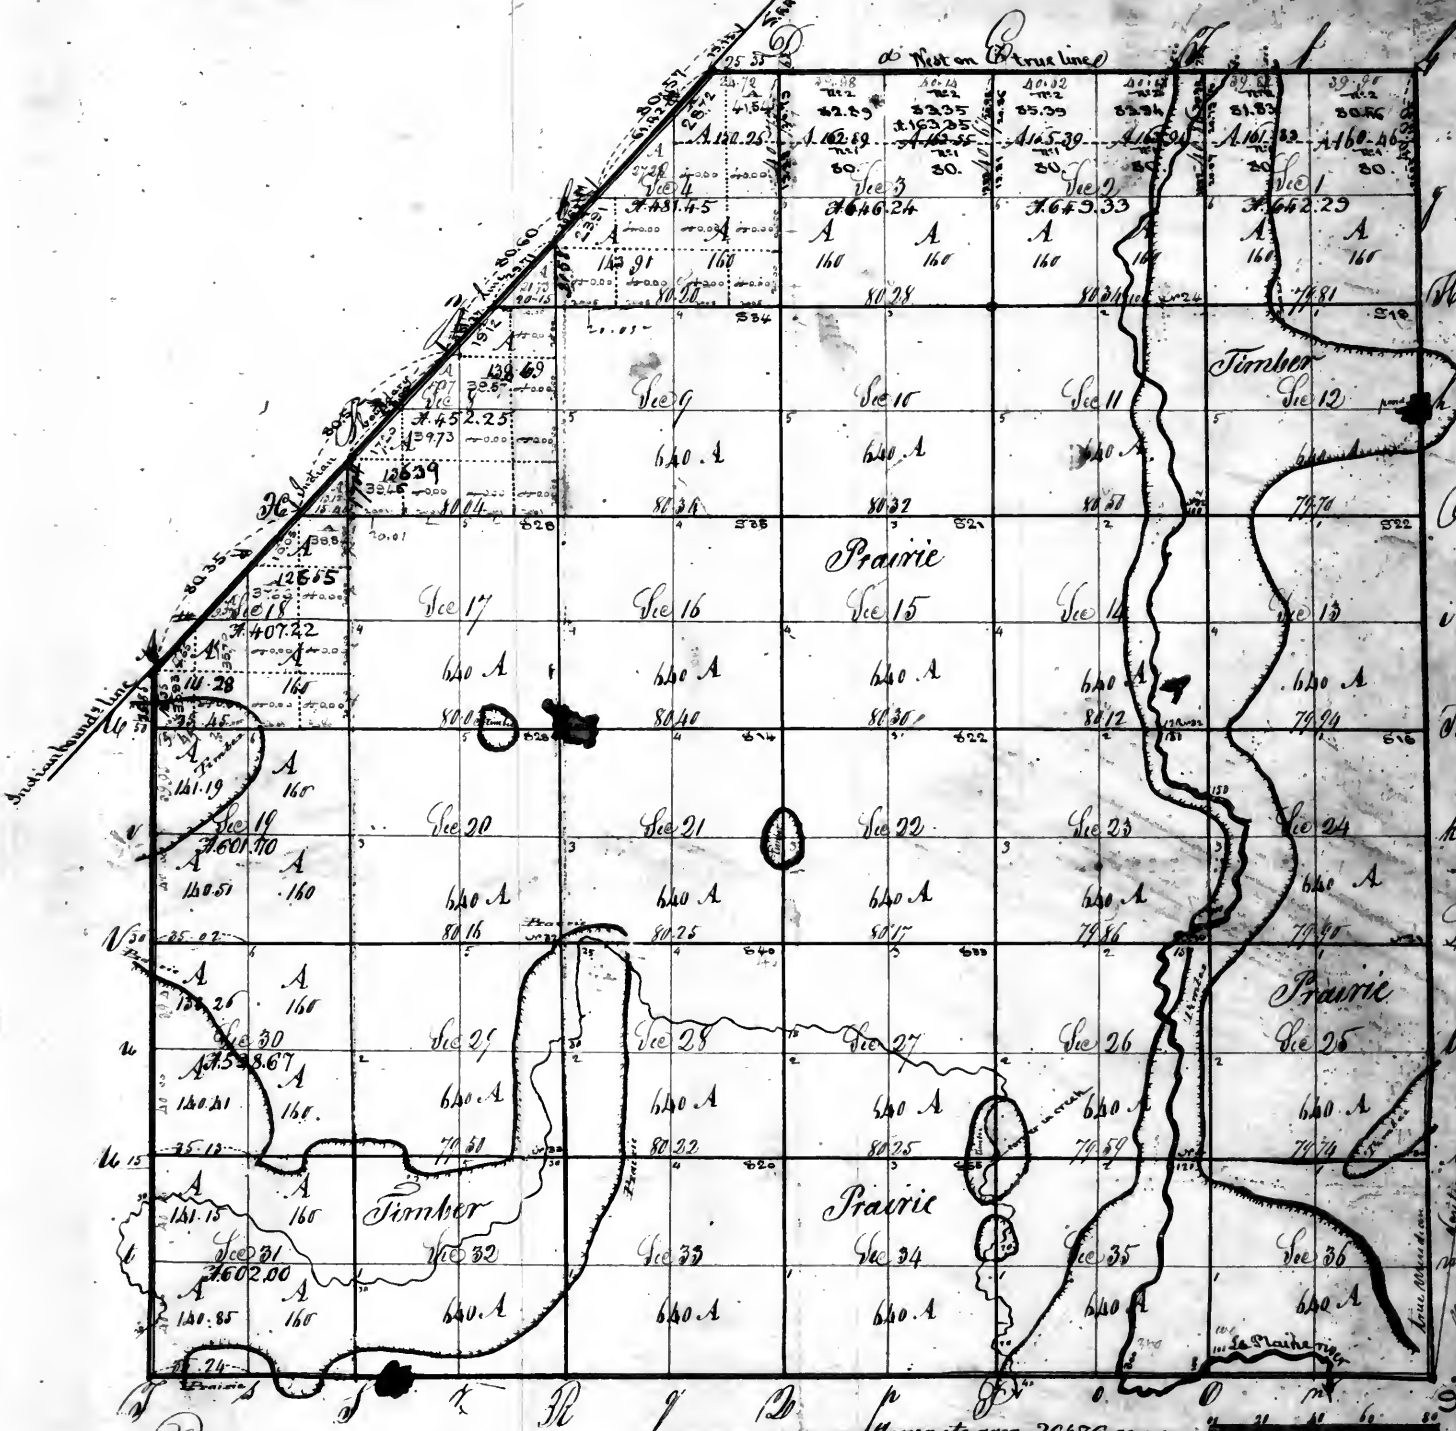

Pursuant to a contract with, and Instructions from William Hector Surveyor of the Lands of the United States in the States of Illinois Missouri and Territory of Arkansas bearing date the twentieth day of March 1834 we have administered said act and surveyed the above described fractional Township and do hereby certify that it has such marks and bounds both natural and artificial as are represented on said plat and described in the field notes made thereof and returned with this plat into the office of the Surveyor of the Lands of the United States in the States of Illinois Missouri and Territory of Arkansas

Examined
Surveyors Office
St. Louis July 31 1834

The above Plat of Township 39 North of the base line, Range 12 East of the 3rd principal Meridian is conformable to the field notes of the Survey thereof on file in this Office

E. J. Longham

Township 39 North of the base line Range 12 East of the 3^d principal Meridian.
(North of the Old Indian boundary line)

57



Surveyor's Office. Saint Louis 15th of August 1843.


The above plat of fractional township 39 north of the base line, range 12 east of the 3^d principal meridian, north of the old Indian boundary line, is strictly conformable to the field notes of the survey thereof on file in this office, which have been examined and approved. The Indian line was surveyed in 1818, by John C. Sullivan, as principal surveyor, and James M. Duncan, as assistant surveyor, under the authority of a letter from W. Rector, Surveyor of the public lands in the territories (now states) of Illinois & Missouri, dated the 18th October 1818, authorizing the said Sullivan & Duncan to survey under the direction of Commissioner Graham and Phelps, appointed by the President of the United States to run the lines of the tracts ceded by the treaty of St Louis of the 24th of August 1804 (1777 and following c. Laws edition of 1828) - this being the line agreed to be run from a point on Sandy creek ten miles above its mouth, in a direct line to a point ten miles north of the west end of the postage 544° 35' W. 28 miles and 70 chains to a point 23.75 chains at right angles to the west of the corner established on Sandy creek (10 miles from its mouth) - On the 3^d quarter of 1823, John Wells, under the contract of Stephen and Thomas C. Rector of the 20th of March of that year, remeasured this line for the purpose of closing the public surveys on the South and side thereof - the whole of the line was retraced and the fractional section-corners for the surveys on the Southeast side, and the mile-points were renewed in the 3^d quarter of 1827, by Eli S. Prescott, under contract signed by the Surveyor General on the 8th May and by Mr. Prescott on the 3^d of June 1827. This remeasurement by Prescott was paid for in the 4th quarter of 1828, and charged in the account current of the Surveyor General during that quarter, Voucher N° 5. The west boundary 2 miles 63.15 chains, and the north boundary 2 miles 45.66 chains were surveyed in October 1829, by Geo. W. Harrison, under contract of 21 September 1829. They were paid for in the 2^d quarter of 1840, and charged in the account of the Surveyor General during that quarter, Voucher N° 12. The subdivision lines 4 miles 79.26 chains were surveyed in July 1842, by Geo. E. Walker, under instructions of the 5th of July of the same year, which instructions were issued under the approved contract of Harrison. These subdivisions will be paid for during this quarter & charged in the account current of the Surveyor General therefor.

Silas Reeds
Surveyor General

Fractional Township 40 North of the base line Range 12 East of the 3rd principal meridian.
 South East of the Old Indian boundary except fractional sections 13 & 24 which are omitted on account of errors in the survey thereof, 3429.56 ac.
 an error on account of error in the survey thereof.

58

Note. The field notes of the survey of the south boundary of this Township call for running East, along the south boundary of sections 36, 35, 34 & 33 in the order here specified which is impracticable.
 In the construction of this Plat, it is considered that the south boundaries of the several sections were run West; but stated through mistake to have been run East.

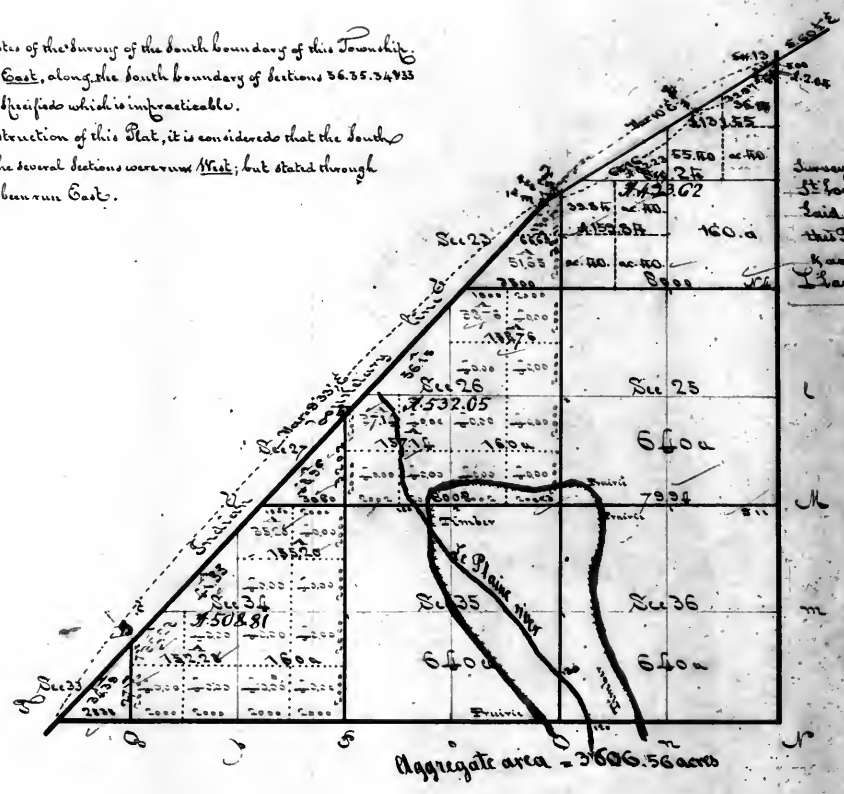

Surveyor's Office
 St. Louis May 24 1850
 Laid down this day of Sect 25 & 36 on this Plat, and sent a copy to the Register & another copy to the Commr of the General Land Office.

Comp.
 10 July 1851

Surveyor's Office
 St. Louis 10 Apr 1851
 Plat of each Sect 25, 26 & 36, and this day to the Commr of the General Land Office.


Surveyor's Office
 St. Louis July 31 1854

The above Plat of Fractional Township 40 North of the base line, Range 12 East of the 3rd principal meridian, South East of the Old Indian boundary line, except sections 13 & 24 which are omitted on account of errors in the survey thereof, is conformable to the field notes of the survey thereof on file in this Office.

E. J. Smytham

5

109-16
 110-10
 111-16
 112-5
 113-11
 114-16
 115-5
 116-11

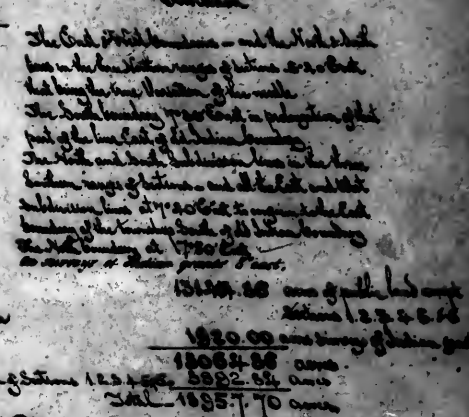




Township N^o 41 North of the Base line in Range N^o 12 East of the 3^d principal Meridian.


60

Surveyor's Office.
St. Louis January 20th 1849

In the field notes of the survey of the East boundary of Twp. N. 41 E. 12 R. 12 the distance from the corner of Section 12 to the Standard line is entered as 80.34 chains, which being evidently erroneous, is omitted on this plat. The distance of 75.55 chains, set down on this plat, as the length of the said boundary of Section 7, of this Township, was found by calculation, and used in estimating the several areas of said section.

Surveyor of the public lands in the State of Missouri & Illinois.

A copy of the plat of said section 7, was sent to the Register, and another to the Commissioner in the 3^d of Feb^y 1849.

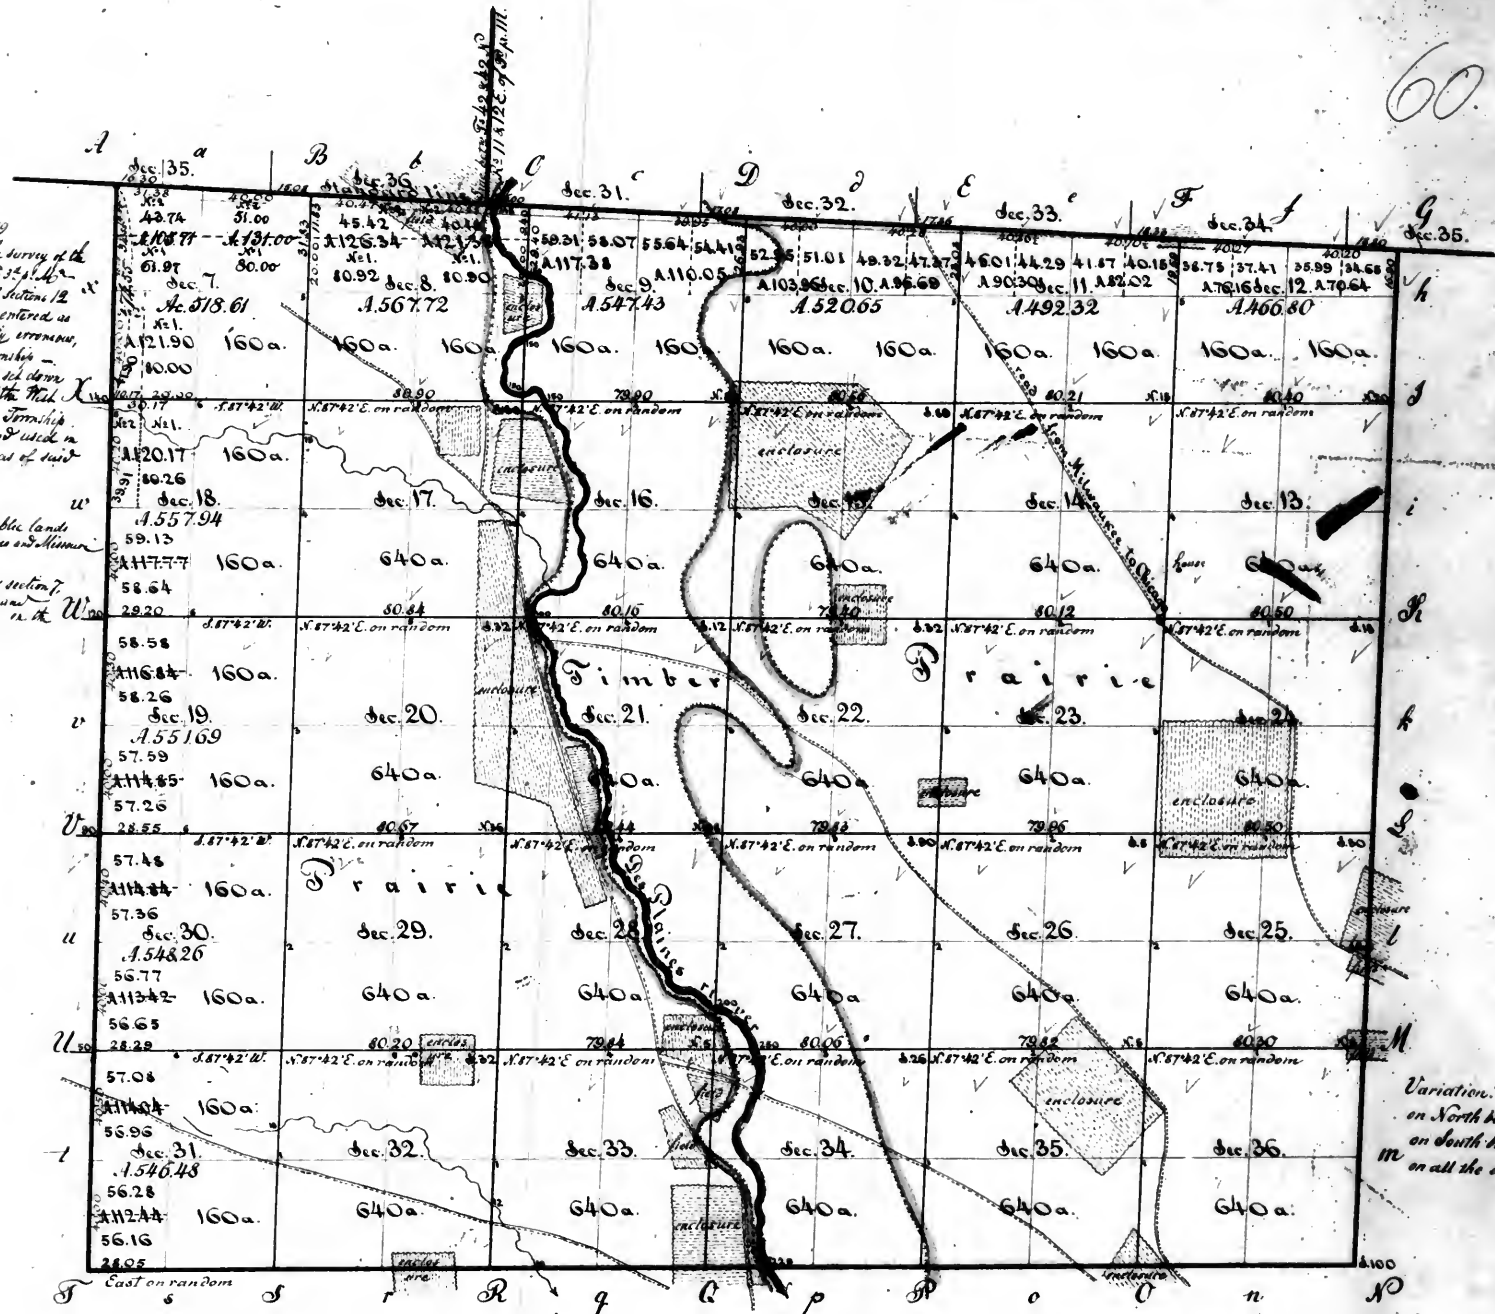

Variation:
on North boundary - 5° 45' East
on South boundary - 7° 50' East
on all the other lines - 5° 40' East.

Surveyor's Office.
St. Louis 6th of January 1841.

Scale of 40 chains to one inch.

Aggregate area 17881.19 acres, except the NE. & NW. quarters of sec. 7.


The above plat of township 41 north of the base line, range 12 east of the 3^d principal meridian, is strictly conformable to the field notes of the survey thereof on file in this office, which have been examined and approved. The north boundary was surveyed in the 2^d quarter of 1837, by James Thompson, under contract signed by the Surveyor General on the 21st of November and by 216th Thompson on the 15th of December 1836; it was paid for in the 1st quarter of 1839, and charged in the account current of the Surveyor General during that quarter, Voucher N^o 6. The east boundary 4 miles 56.90 chains was surveyed in the 4th quarter of 1839, by George W. Harrison, under contract of the 21st of September 1839; it was paid for in the 3^d quarter of 1840, and charged in the account current of the Surveyor General during that quarter, Voucher N^o 12. The west boundary 5 miles and 34 links was surveyed in the 3^d quarter of 1840, by George W. Harrison, under contract of the 21st of September 1839 - the 4 miles of the said west boundary, which form the east boundaries of sections 36, 25, 24 & 13 T. 41 R. 11, were paid for in the 4th quarter of 1840, and charged in the account current of the Surveyor General during that quarter, Voucher 10. The south boundary 5 miles 68.05 chains, and the subdivision line 4 miles 51.60 chains, were surveyed in the 3^d quarter of 1840, by the said Harrison under his above mentioned contract. They were paid for in the 4th quarter of 1840, and charged in the account current of the Surveyor General during the same quarter Voucher N^o 10.

William Milburn
Surveyor of the public lands
in the States of Missouri & Illinois.

[Signature]

Township 42 North of the base line Range 12 East of the 3d principal meridian

61

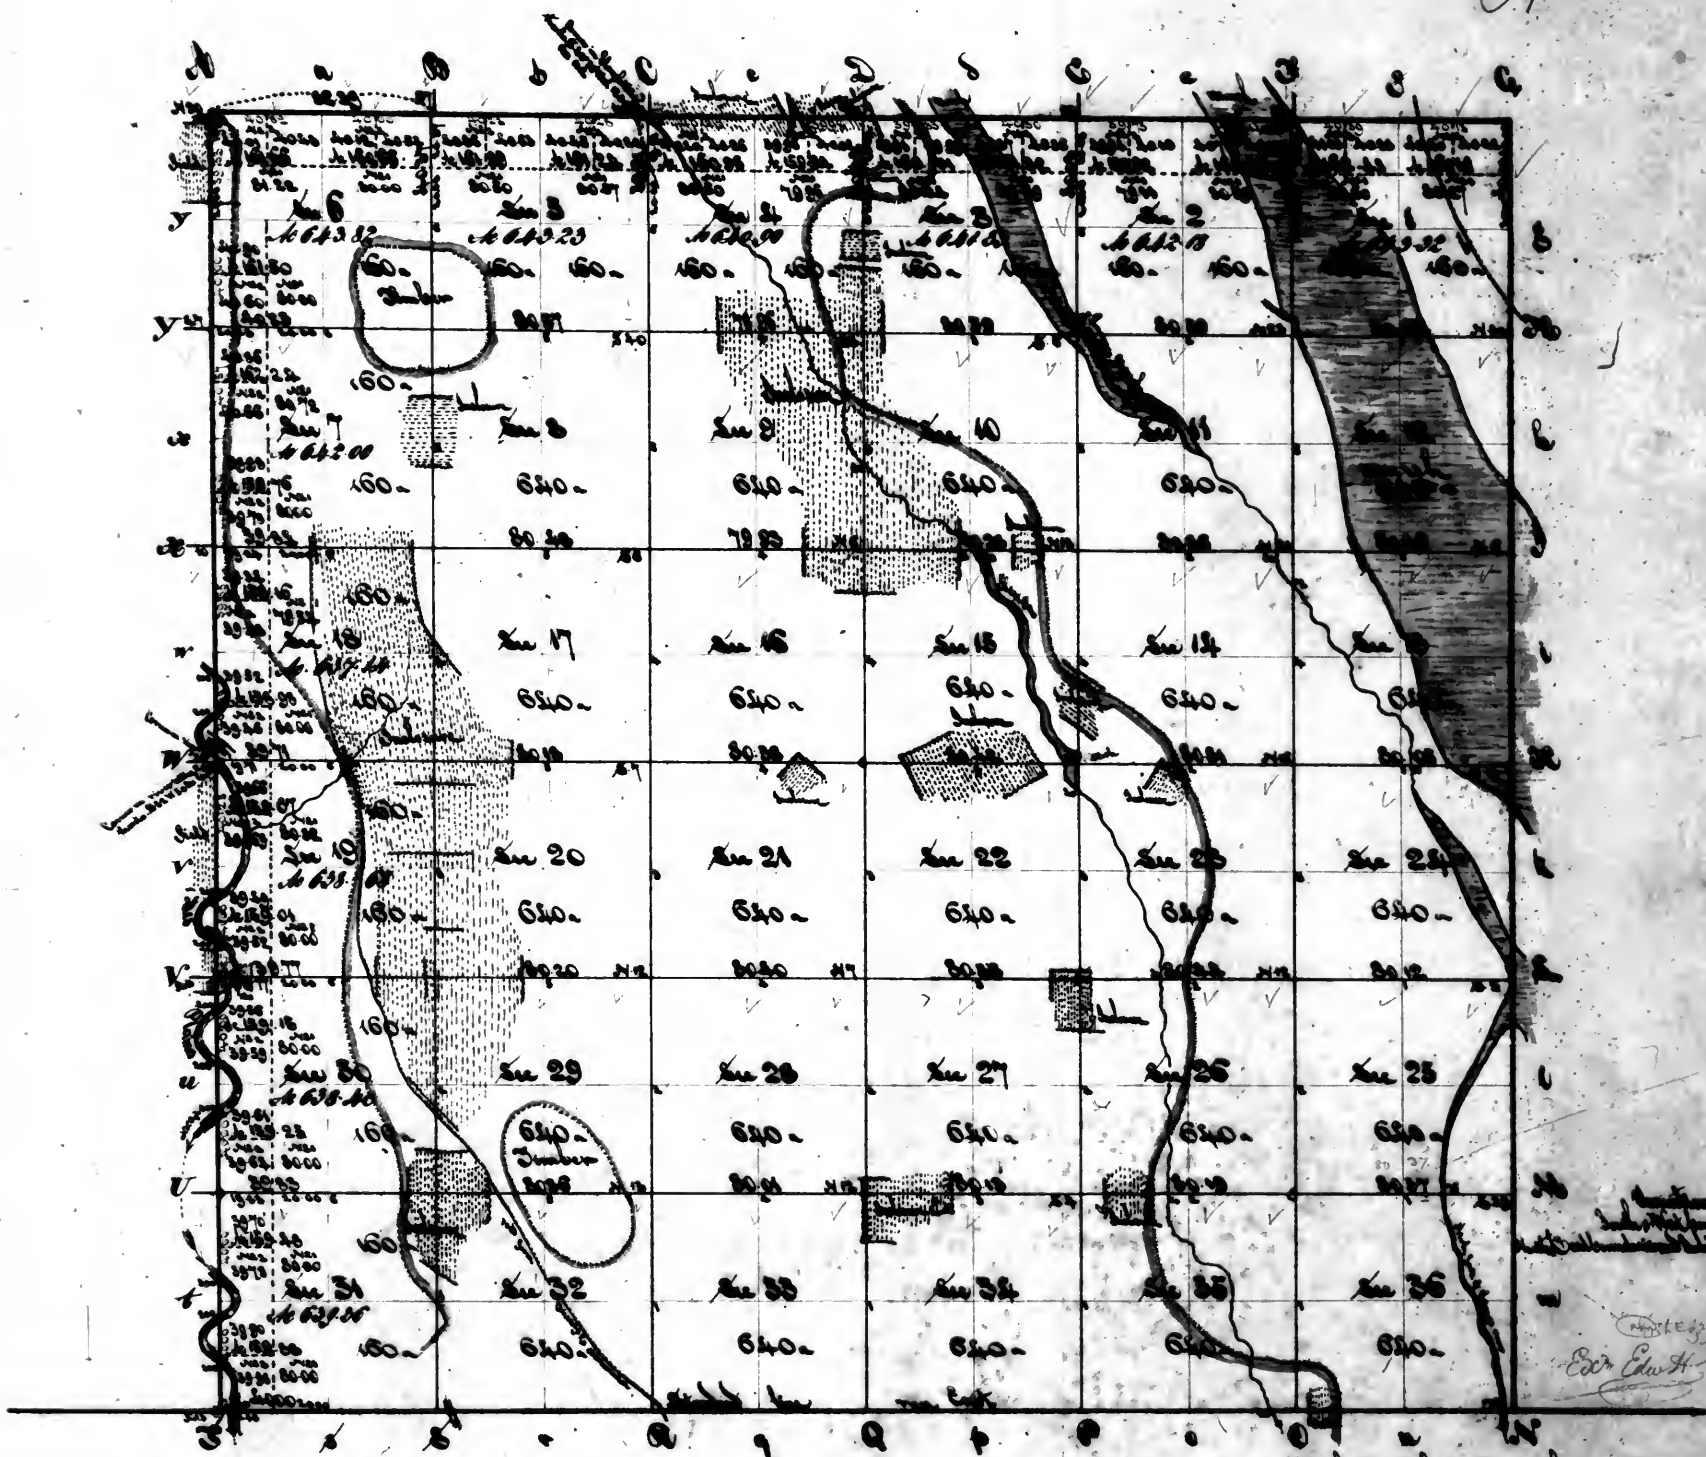

Surveyors' Office.
Saint Louis 24th June 1840.

The above plat of township 42 north of the base line range 12 east of the third principal meridian is strictly conformable to the field notes of the survey thereof on file in this office, which have been examined and approved. The south boundary 6 miles, was surveyed in the 2nd quarter of 1837, by James Thompson, under contract, signed by the Surveyor General on the 21st of November 1836, and by Mr. Thompson on the 15th of December of that year; it was paid for in the 1st quarter of 1839, and charged in the account current of the Surveyor General for that quarter, Voucher N^o 6. The west boundary 6 miles was surveyed in the 3rd quarter of 1838, by E. C. Barry, under contract of the 9th of September 1837; it was paid for, in this 2nd quarter of 1840, and will be charged in the account current of the Surveyor General, during the said quarter, Voucher N^o 11. The east boundary 6 miles - the north boundary 6 miles 2.59 chains, and the subdivision lines 60 miles S. 54 chains, were surveyed in the 4th quarter of 1839, all by George W. Harrison, under contract dated the 21st of September 1839. These surveys by Mr. Harrison, were paid for in this 2nd quarter of 1840; and they will be charged in the account of the Surveyor General, for said quarter, under the general appropriation for surveying the public lands - Voucher N^o 12.

William Melburn
Surveyor of the public lands in
the States of Illinois and Missouri.

[Signature]

62








Township N. 44 North of the Base line in Range N. 12 East of the 3^d principal Meridian.

63

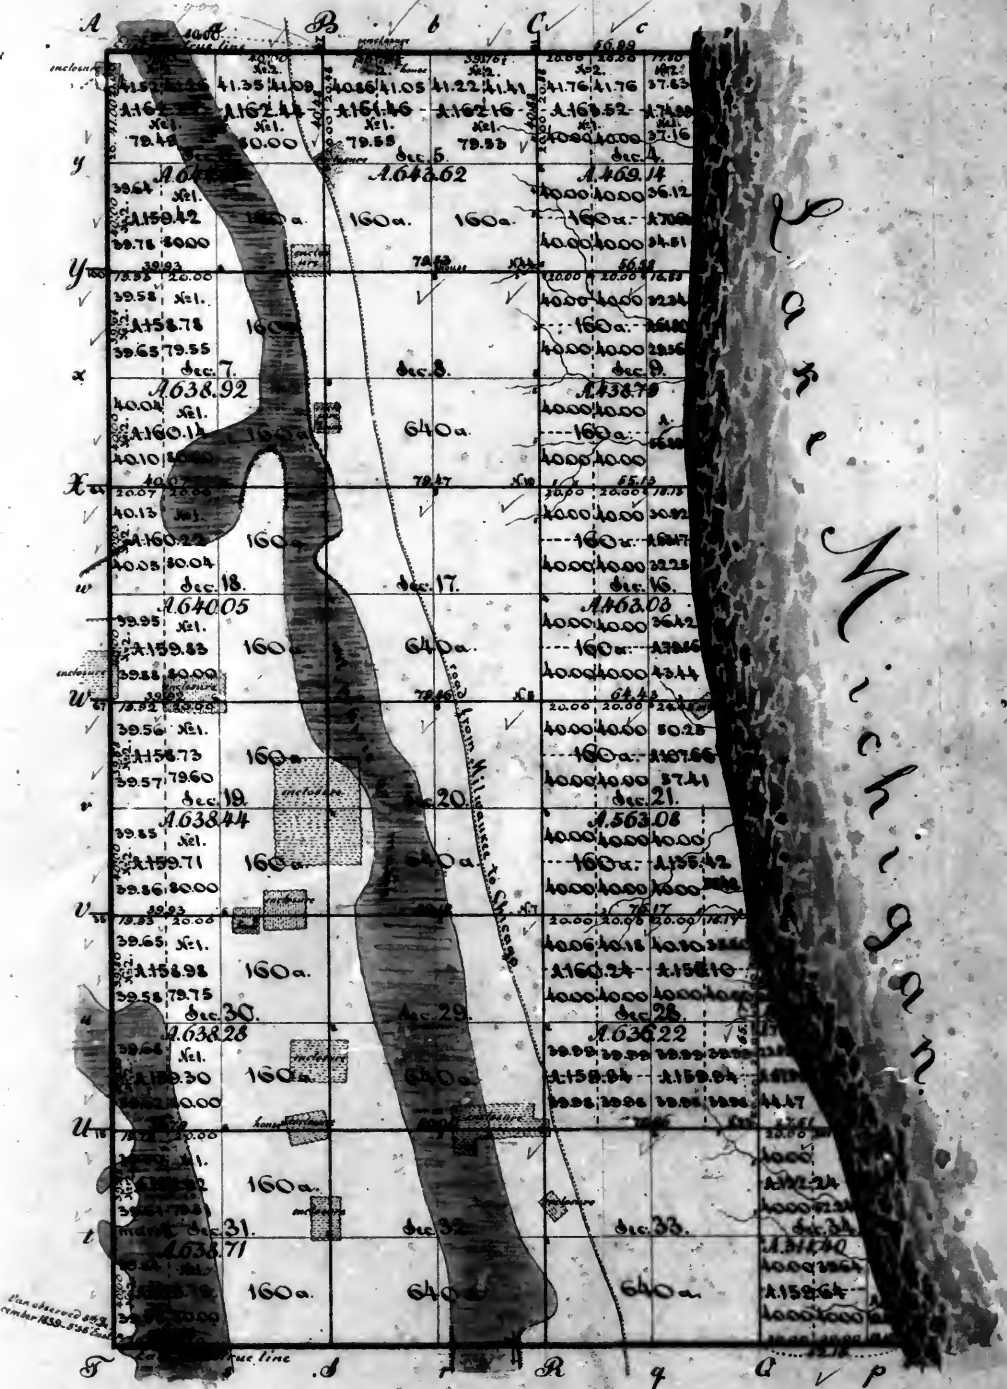

Variation:
on South boundary - 5'40" East
on all the other lines - 5'35" East
Scale of 40 chains to one inch.
Aggregate area 11281.11 acres.

Surveyor's Office.
Saint Louis 19th of December 1840.

The above plat of fractional township 44 north of the base line in Range 12 East of the 3^d principal meridian, is strictly conformable to the field notes of the Survey thereof on file in this office, which have been examined and approved. The south boundary 3 miles 52.16 chains, was surveyed in the 4th quarter of 1839, by George W. Harrison, under contract of the 21st of September of the same year. It was paid for in the 2^d quarter of 1840, and charged in the account current of the Surveyor General, during the said quarter, Voucher N. 12. The west boundary 6 miles: - the north boundary 2 miles 56.39 chains: - the subdivisional lines 28 miles 24.33 chains, and the margins of the western margin of Lake Michigan 6 miles 17.74 chains, were surveyed in the 4th quarter of 1839, by William S. Hall, under the contract of George W. Harrison, of the 21st of September 1839. - They were paid for in this 4th quarter of 1840, and they will be charged in the account current of the Surveyor General, during the said quarter, under the general appropriation for surveying the public lands, Voucher N. 11.

William Miller
Surveyor of the public lands in
the States of Illinois and Missouri.

[Signature]

Fractional Townships 43 North Range 12 & 13 East of the 2d principal Meridian

63












62

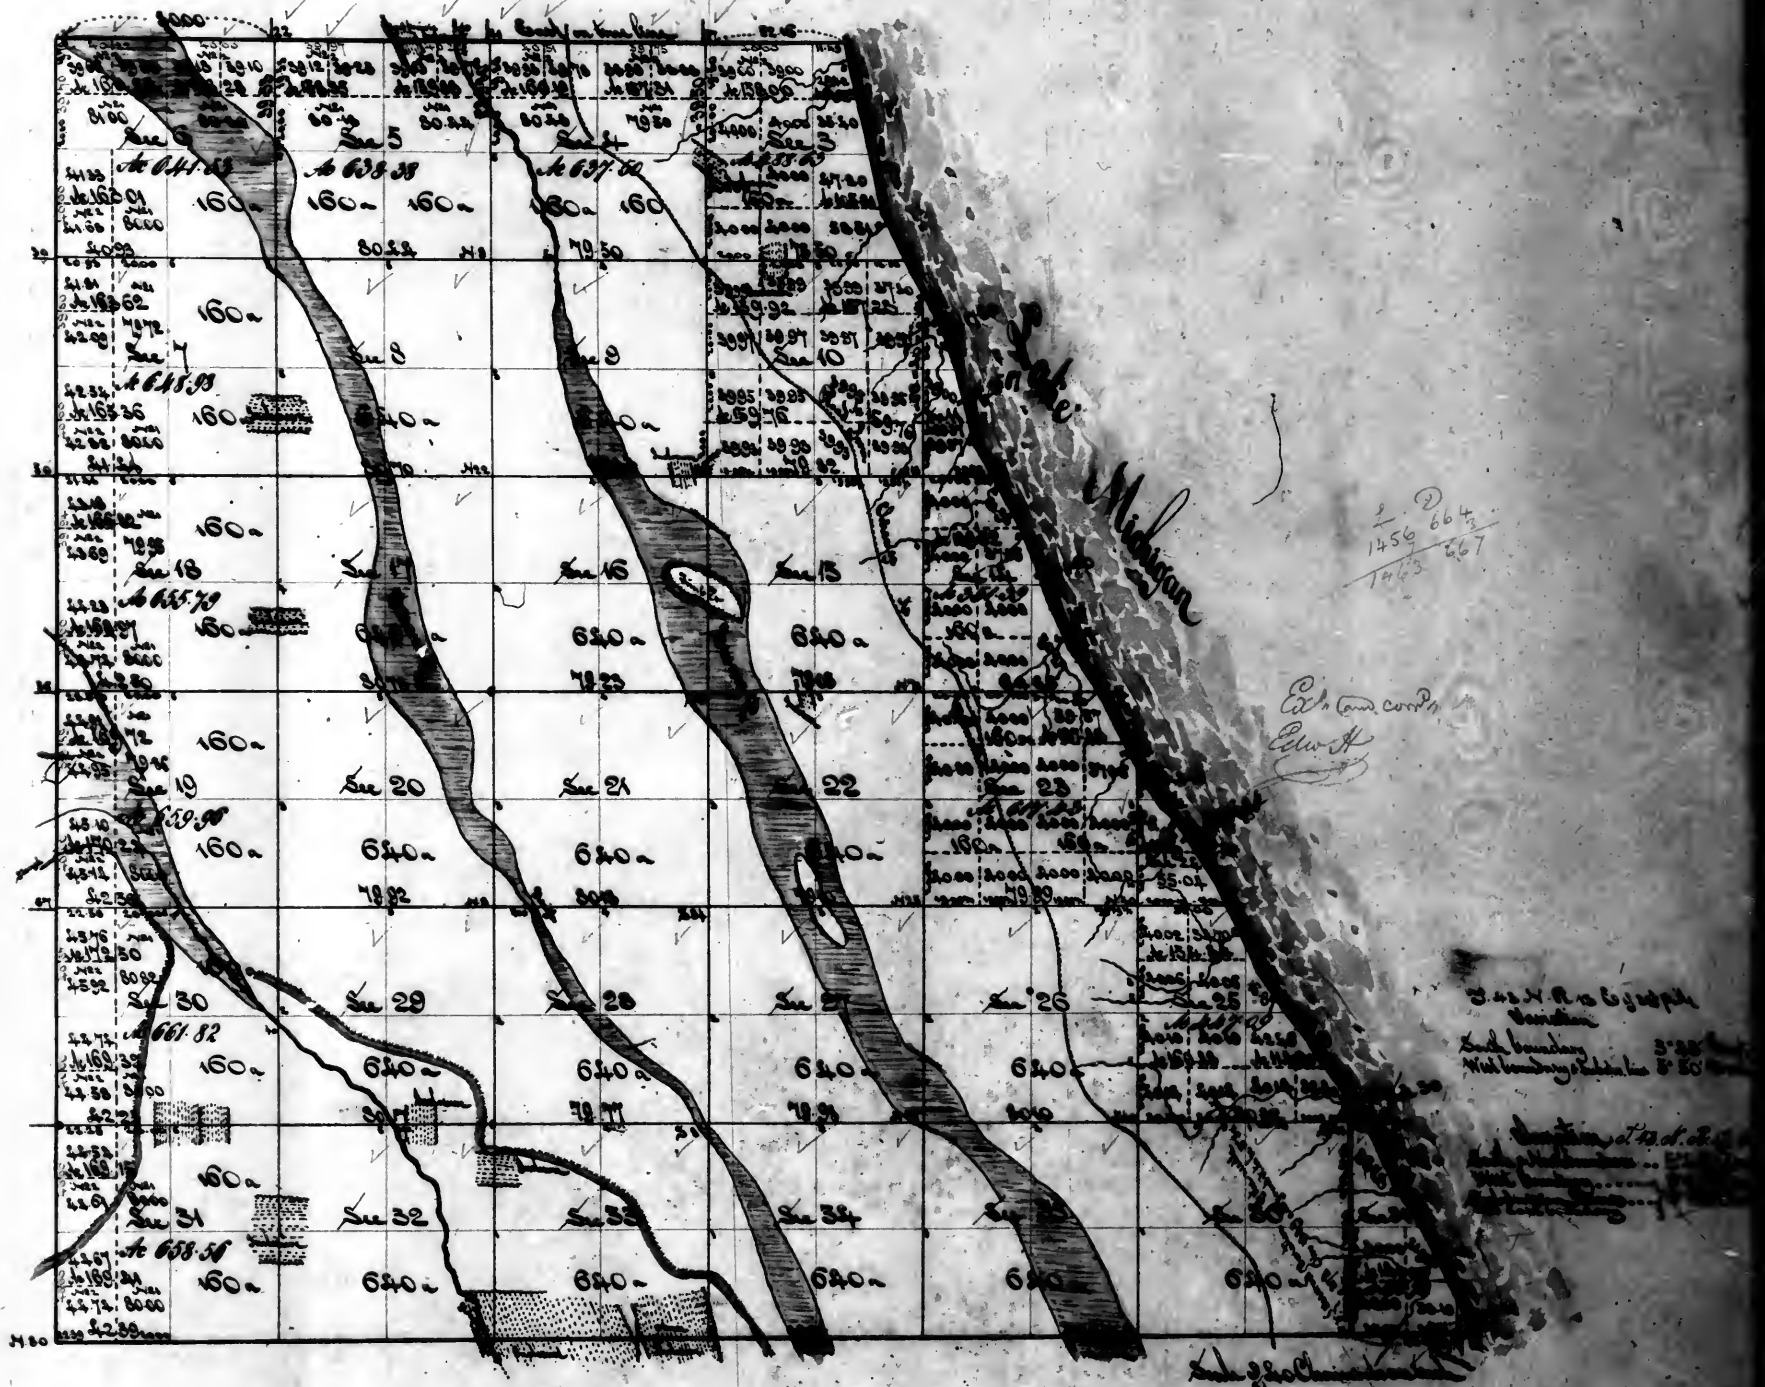

Surveyor's Office, St.
Saint Louis, 24 June 1840.

The above plat of fractional townships 43 north of the base line, ranges 12 & 13 east of the 3^d principal meridian, on the western side of Lake Michigan, except of the north fractional quarter of section 10 & 43 R. 12, is strictly conformable to the field notes of the survey of said fractional townships in this office, which have been examined and approved. Fractional township 43 north range 12, was surveyed as follows: - The east boundary 1 mile 5.74 chains - the south boundary 6 miles 2.33 chains - the west boundary 6 miles - the north boundary 5 miles 53.16 chains - the subdivision lines 50 miles 1.39 chains, and the meanders of the western margin of Lake Michigan, along fractional sections 3, 11, 14, 23, 24, 25, 5 miles 28.26 chains, were surveyed in the 4th quarter of 1839 - and fractional township 43 north range 13 east was surveyed to wit: The south boundary 43.66 chains - the subdivision line, 3.40 chains (between fractional sections 30 & 31) and the meanders of the western margin of Lake Michigan along said fractional sections 30 & 31, 1 mile 16.78 chains, were surveyed in the 4th quarter of 1839 - all by George W. Harrison, under contract of the 13th of September of the same year - These surveys were paid for in this 2^d quarter of 1840 and they will be charged in the account current of the Surveyor General, during the said quarter, under the general appropriation for surveying the public lands, October 20th 1840.

Surveyor's Office, Saint Louis, 1st of January 1841.

The above plat of fractional township 43 north range 12 & 13 East of the 3^d principal meridian, has been this day completed by laying down thereon, the north east quarter of fractional section 10, T. 43, R. 12, strictly conformable to the field notes of the survey thereof on file in this office which have been examined and approved. The meander of the western margin of Lake Michigan, along the said north east quarter of section 10, 16 chains and 11 links, were surveyed in the 3^d quarter of 1840, by George W. Harrison, under contract of the 21st of September 1839. They were paid for in the 4th quarter of 1840, and charged in the account current of the Surveyor General, during that quarter, October 15th 1840.

William Harrison
Surveyor of the public lands in
the State of Illinois & Missouri.

William Harrison
Surveyor of the public lands in the
States of Illinois and Missouri.

W. H. Harrison

2 2 664
1450 664
1453 667

J. W. Harrison
Surveyor





Township No 46 North of the Base line in Range No 12 East of the 3^d principal Meridian.

64

65
J. H. Williams

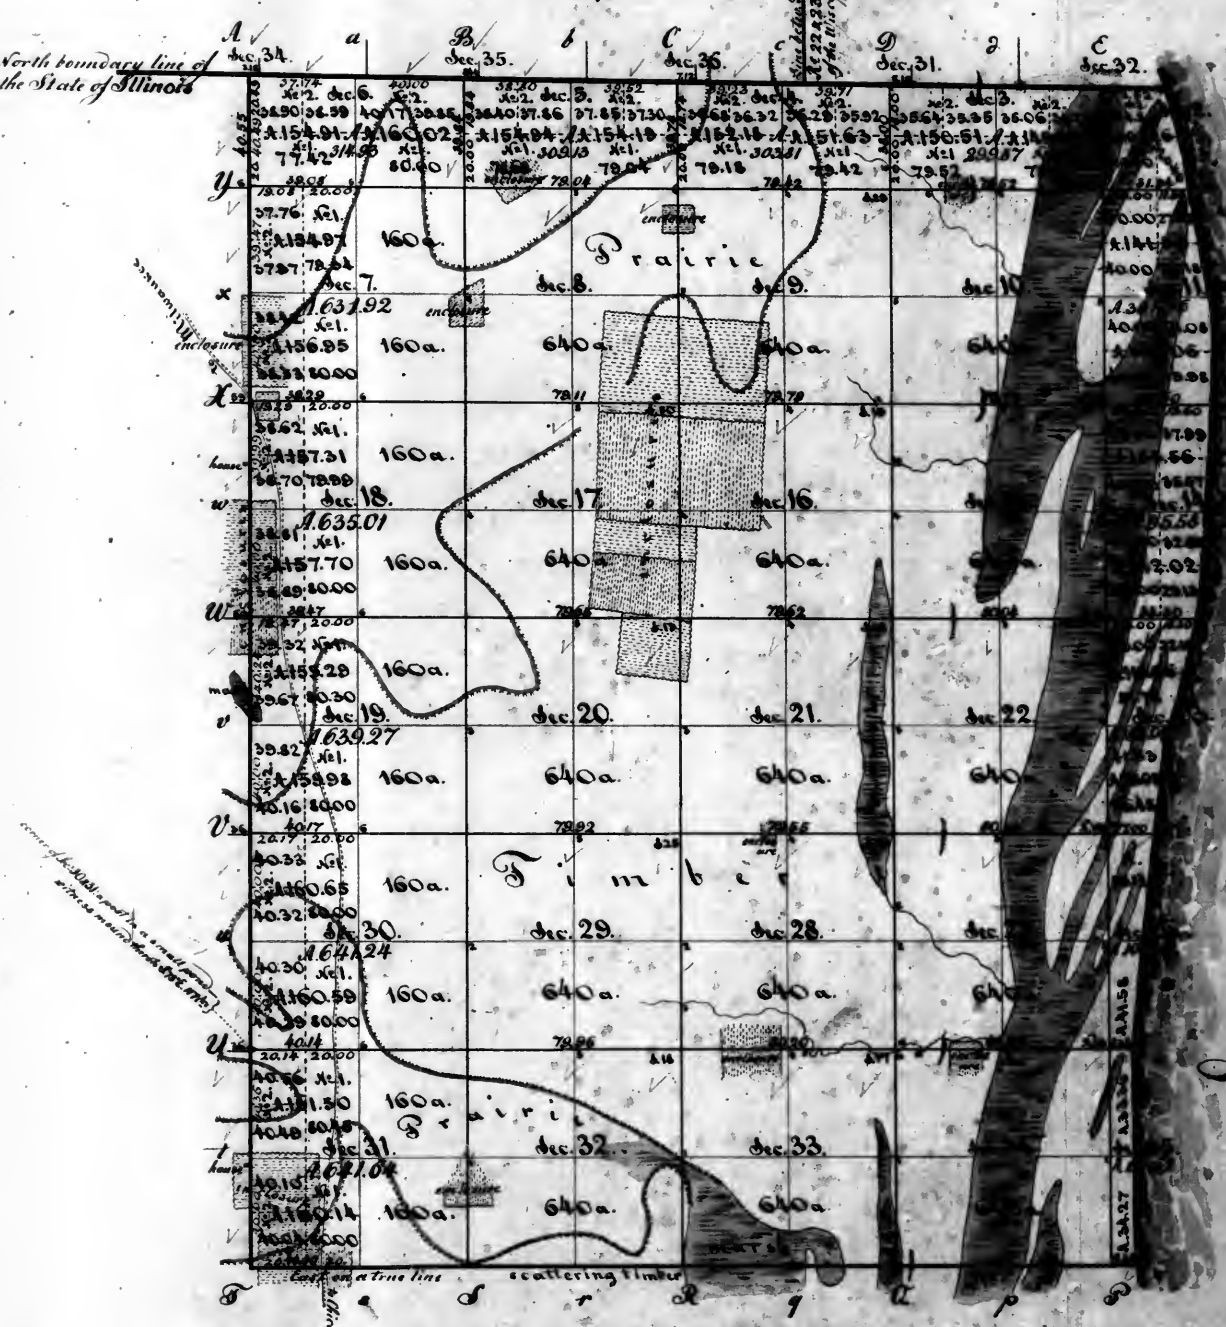

are Michigan

Variation:
on North boundary - 5°30' East
on all the other lines - 5°35' East.
Scale of 40 chains to one inch.
Aggregate area 14079.57 acres.


15079.57

Surveyors Office
Saint Louis 13th of December 1840.


The above plat of township 46 north of the base line Range 12 east of the 3^d principal meridian is hereby conformable to the field notes of the Survey thereof on file in this office which have been examined and approved:— The north boundary was surveyed in 1832 and 1833, by Lewis Lym, Commissioner on the part of the United States, as certified to this office by Mr. J. Williams, Surveyor General of Ohio, Indiana & Michigan:— The said line being a part of the boundary between Illinois and Michigan, now Wisconsin:— The south boundary 4 miles 9.34 chains — the west boundary 5 miles 40.55 chains:— The subdivision lines 4 miles 38.50 chains, and the meanders of the western bank of Lake Michigan 5 miles & 42.34 chains, were all surveyed in the 4th quarter of 1839, by William P. Hull, under the contract of George W. Hornum of the 26th of September 1839 — They were paid for in this 4th quarter of 1840, and they will be charged in the account current of the Surveyor General, during the said quarter, under the general appropriation for surveying the public lands, Voucher No 11.

William Melburn
Surveyor of the public lands in
the States of Illinois & Wisconsin.


R. 12

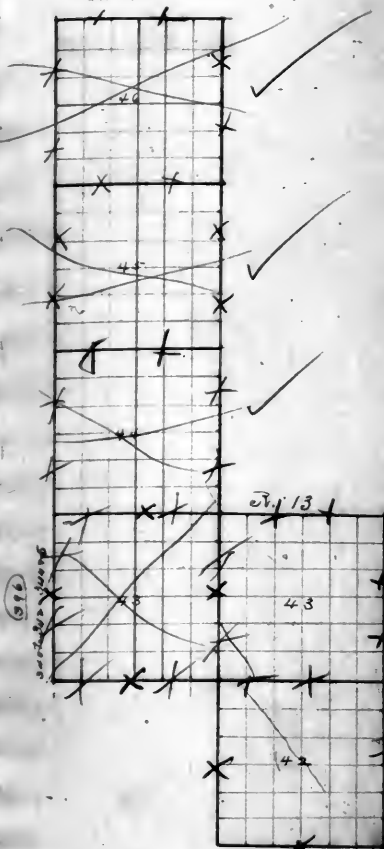

R. 14

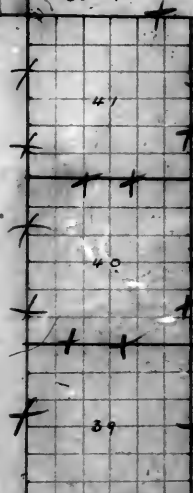


R. 15

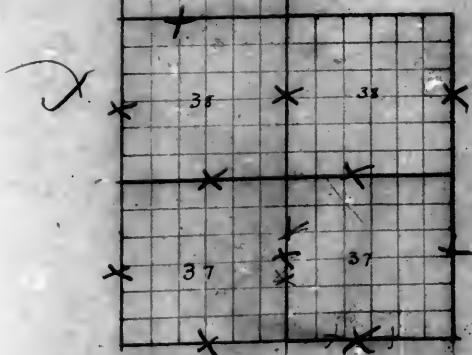

Rec'd with sun. Sub. Act of 10 Sept. 1842

T. 41 N. of the base line R. 14 E. of the 3rd pl. Mer.
South East of the Old Indian boundary line

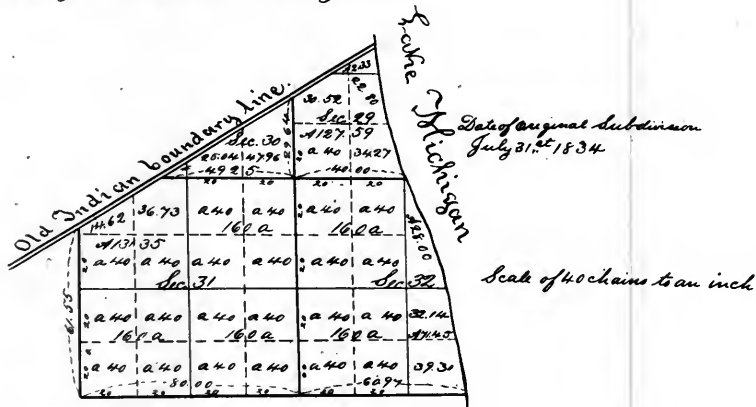

Surveyors Office
St. Louis 10th Sept. 1842

The above Plat of fractional Sections 29, 30, 31 & 32 in Township 41 North of the base line Range 14 East of the 3rd principal Meridian, & South East of the Old Indian boundary line, subdivided under the Act of Congress of the 5th of April 1832, is correctly copied from the Plat of said Township on file in this Office


Silas Reed

Surveyor of the public lands in the
States of Illinois & Missouri
Quantities marked in tract books
Jan'y 21. 1843

To the Commissioner
of the General Land Office
at
Washington City

Rec'd with sun. Sub. Act of 10 Sept. 1842

T. 40 N. of the base line R. 14 E. of the 3rd pl. Mer.

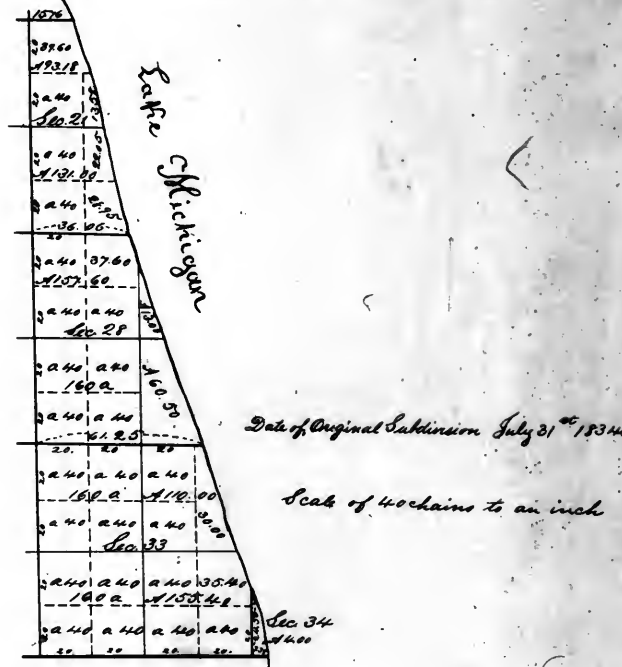

Surveyors Office
St. Louis 10th Sept. 1842

The above Plat of fractional Sections 21, 22, 33 & 34 in Township 40 North of the base line, Range 14 East of the 3rd principal Meridian, subdivided under the Act of Congress of the 5th of April 1832, is correctly copied from the Plat of said Township on file in this Office


Silas Reed

Surveyor of the public lands in the
States of Illinois & Missouri
Quantities marked in tract books
Jan'y 21. 1843

To the Commissioner
of the General Land Office
at
Washington City

Rec'd with sun. Sub. Act of 10 Sept. 1842

T. 40 N. of the base line R. 14 E. of the 3rd pl. Mer.

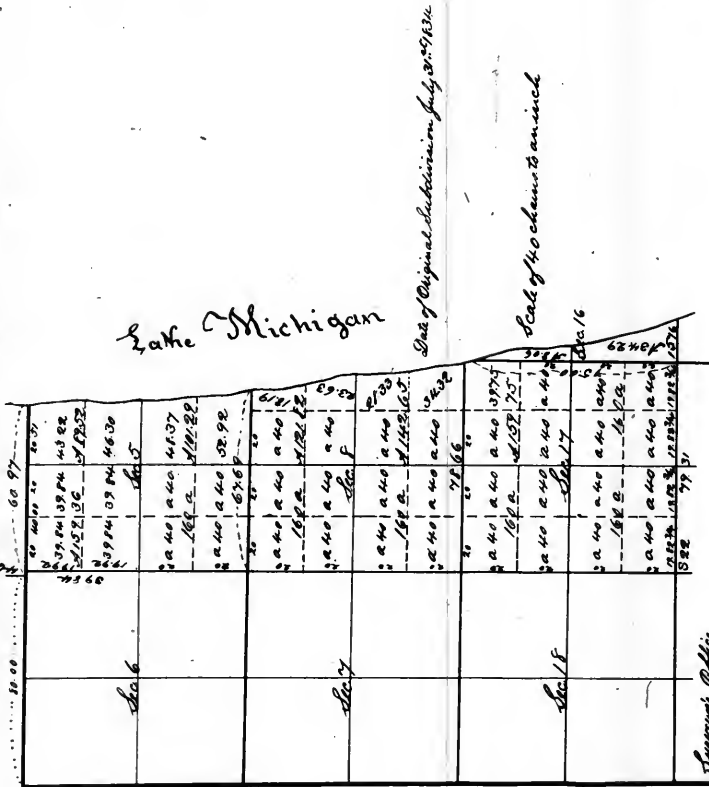

Surveyors Office
St. Louis 10th Sept. 1842



Silas Reed

Surveyor of the public lands in the
States of Illinois & Missouri
Quantities marked in tract books
Jan'y 21. 1843

To the Commissioner
of the General Land Office
at
Washington City

Township N^o 45 North of the Base line in Range N^o 12 East of the 3^d principal Meridian.

64

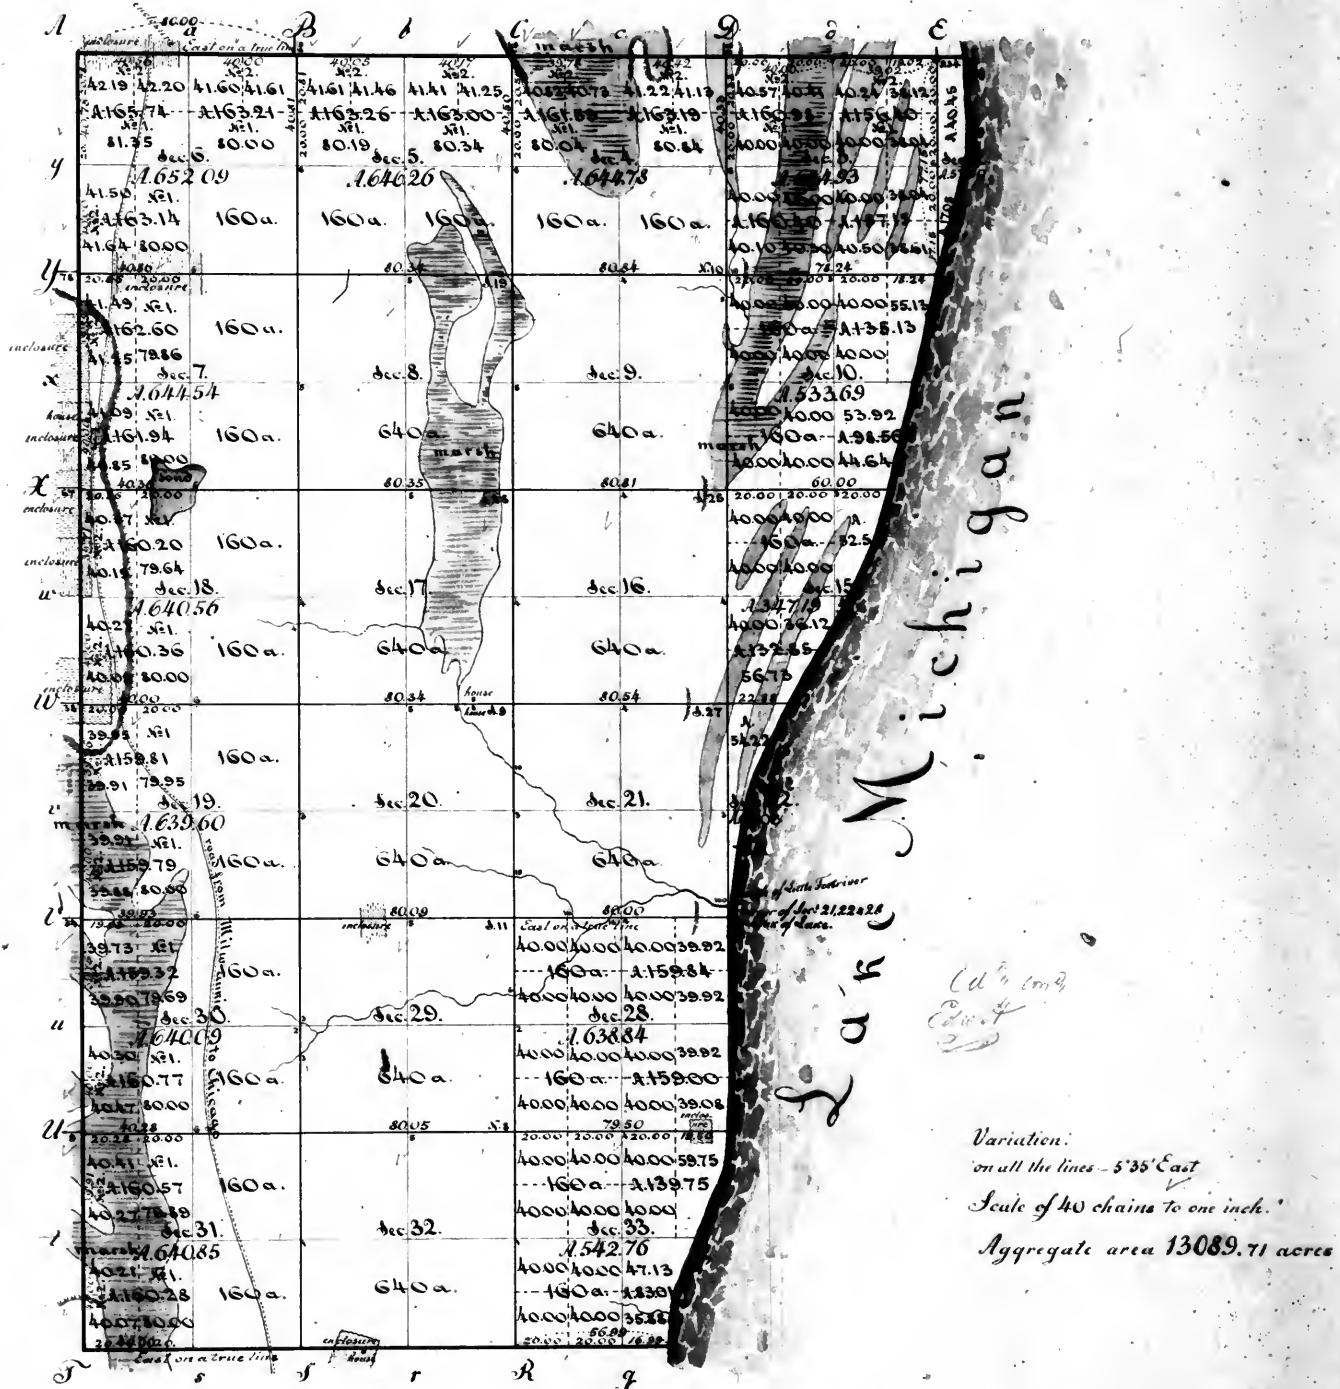


Surveyor's Office.
19th of December 1840.

The above plat of fractional Township 45 north of the base line range 12 east of the 3^d principal meridian is strictly conformable to the field notes of the survey thereof on file in this office which have been examined and approved - The South boundary 2 miles 56.99 chains: - the west boundary 6 miles: - the north boundary 4 miles 3.24 chains - the Subdivision lines 34 miles 4.20 chains, and the meanders of the western bank of Lake Michigan, 6 miles 21.04 chains, were all surveyed in the 4th quarter of 1839, by William P. Hull, under the contract of George W. Harwood of the 26th of September 1839: - They were paid for in this 4th quarter of 1840, and they will be charged in the account current of the Surveyor General, during the said quarter, under the general appropriation for surveying the public land, Voucher N^o 11.

William Milburn
Surveyor of the public lands
in the State of Illinois

VOL. 30

Township 31 North of the base line, Range 13 East of the 3rd principal meridian

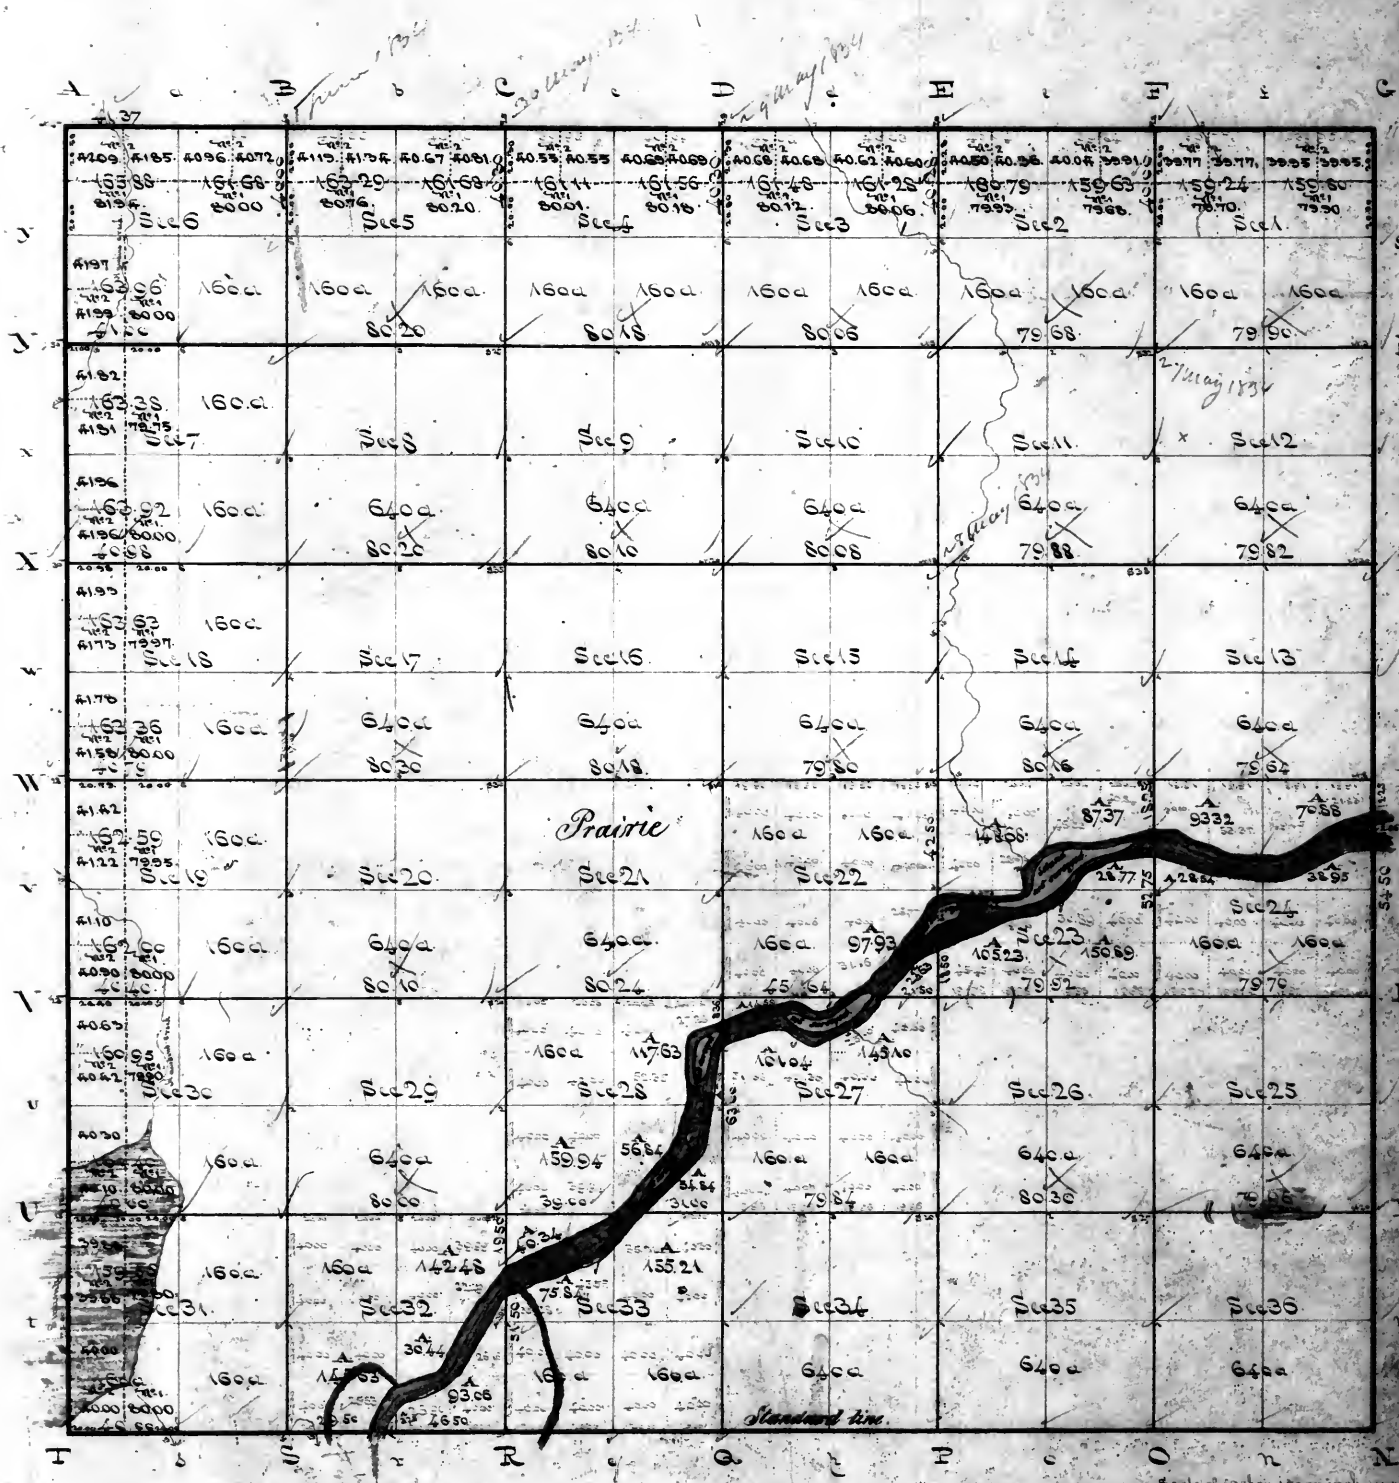

Surveyor General's Office
St. Louis, the 7th of April 1850
The survey of that part of an island which lies in Section 24, including the connections thereof with the levee on the main shore, has this day been laid down on this plat, to the field notes thereof on file in this office, which have been examined and approved. Said survey was made by Addison Collins in the 4th quarter of 1840, under instructions from this office, dated the 12th of December 1839, issued in conformity with the letter of the Commissioner of the General Land Office, dated the 17th of July 1837, and a plat of fractional Section 24 on island has this day been sent to the General Land Office, and a plat thereof to the Register of the District Land Office.
William H. Johnson
Surveyor of the land in Missouri, and Agent

A copy of the plat of the island, showing the meander line, and the location of the plat, has been sent to the Register of the District Land Office.

Aggregate area 22,586.41 acres, based on the mean value.
Estimated area of river and unurveyed island 183.69. Island in Sec. 24.

Total 22,770.10 acres
Variation 7' east in all the lines.

Surveyors Office
Saint Louis 23rd November 1838

The above plat of Township 31 north of the base line, range 13 East of the 3rd principal meridian is strictly conformable to the field notes of the survey thereof on file in this Office, which have been examined and approved. The exterior boundary lines, were surveyed in the 4th quarter of 1835, and the subdivision lines, and meanders, in the 2nd quarter of 1834, — all by Daniel W. Deekwisch, under contract of the 29th day of October 1833.

Daniel W. Deekwisch
Sur. Genl.

2



24th August 1845. Taberina 4th
Said a plot of N^o 1st. 2. 3. 4. 5
to the Comr & Register.


Variation 7° East.

Scale of 2 chains to an inch
 Aggregate area 234 03.63 acres

William Millburn
Brynorthen
J4

Township 33 North of the base line Range 13 East of 3rd principal Meridian

3

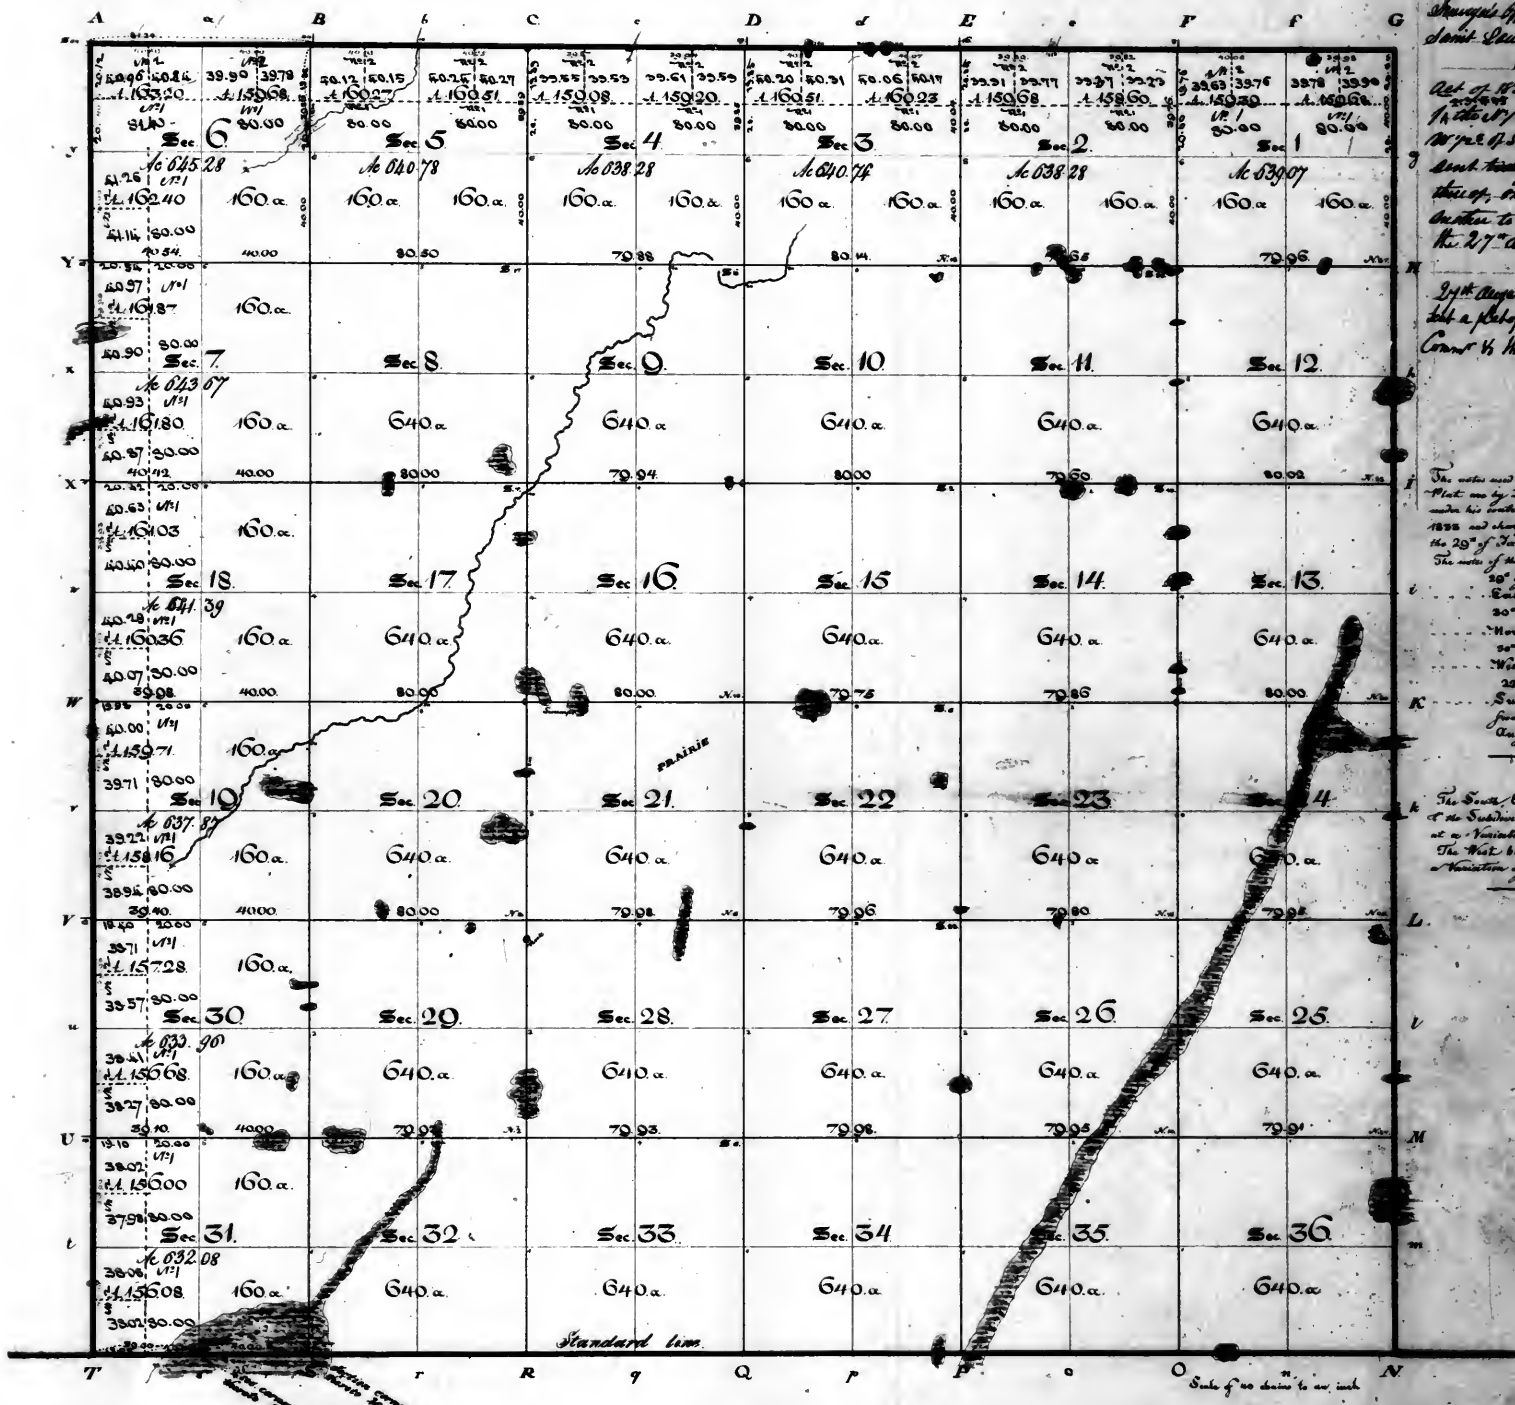

Surveyors Office
St. Louis 17th August 1823
Subdivided under
Act of 1820: viz. that of 36
1/4 sections & 5/8 of 324 1/2
1/4 sections & 7/16 of 324 1/2
and having copies of the plat
thereof, one to the Register and
another to the Commissioner, on
the 27th August 1825

The notes used in the construction of this
Plat are by Don Alving Spaulding
under his contract of the 2^d of October
1822 and changed for in his account of
the 28th of January 1823
The note of the South boundary was dated
20th of May 1824
East boundary was dated
20th of May 1824
North boundary was dated
20th of May 1824
West boundary was dated
20th of May 1824
Subdivision lines are dated
from the 2^d to the 10th of
August 1824

The South, East & North boundaries
of the Subdivision lines were surveyed
at a Variation of 7th East
The West boundary was surveyed at
a Variation of 7th East


Aggregate Area 23031.40 Acres

Surveyors Office
St. Louis 17th August 1823

This is a true Plat of Township 33 North of the base line Range 13 East of 3rd principal Meridian, as conformable to the field notes
of the survey thereof on file in this Office, which have been examined and approved. The actual boundary lines were changed in the
2^d quarter of 1824 - and the subdivisional lines in the 3^d quarter of the same year - all by Don Alving Spaulding, under contract
of the 2^d of October 1822.

William Miller
Surveyor General

Township 34 North of the base line Range 13 East of 3^d principal Meridian.

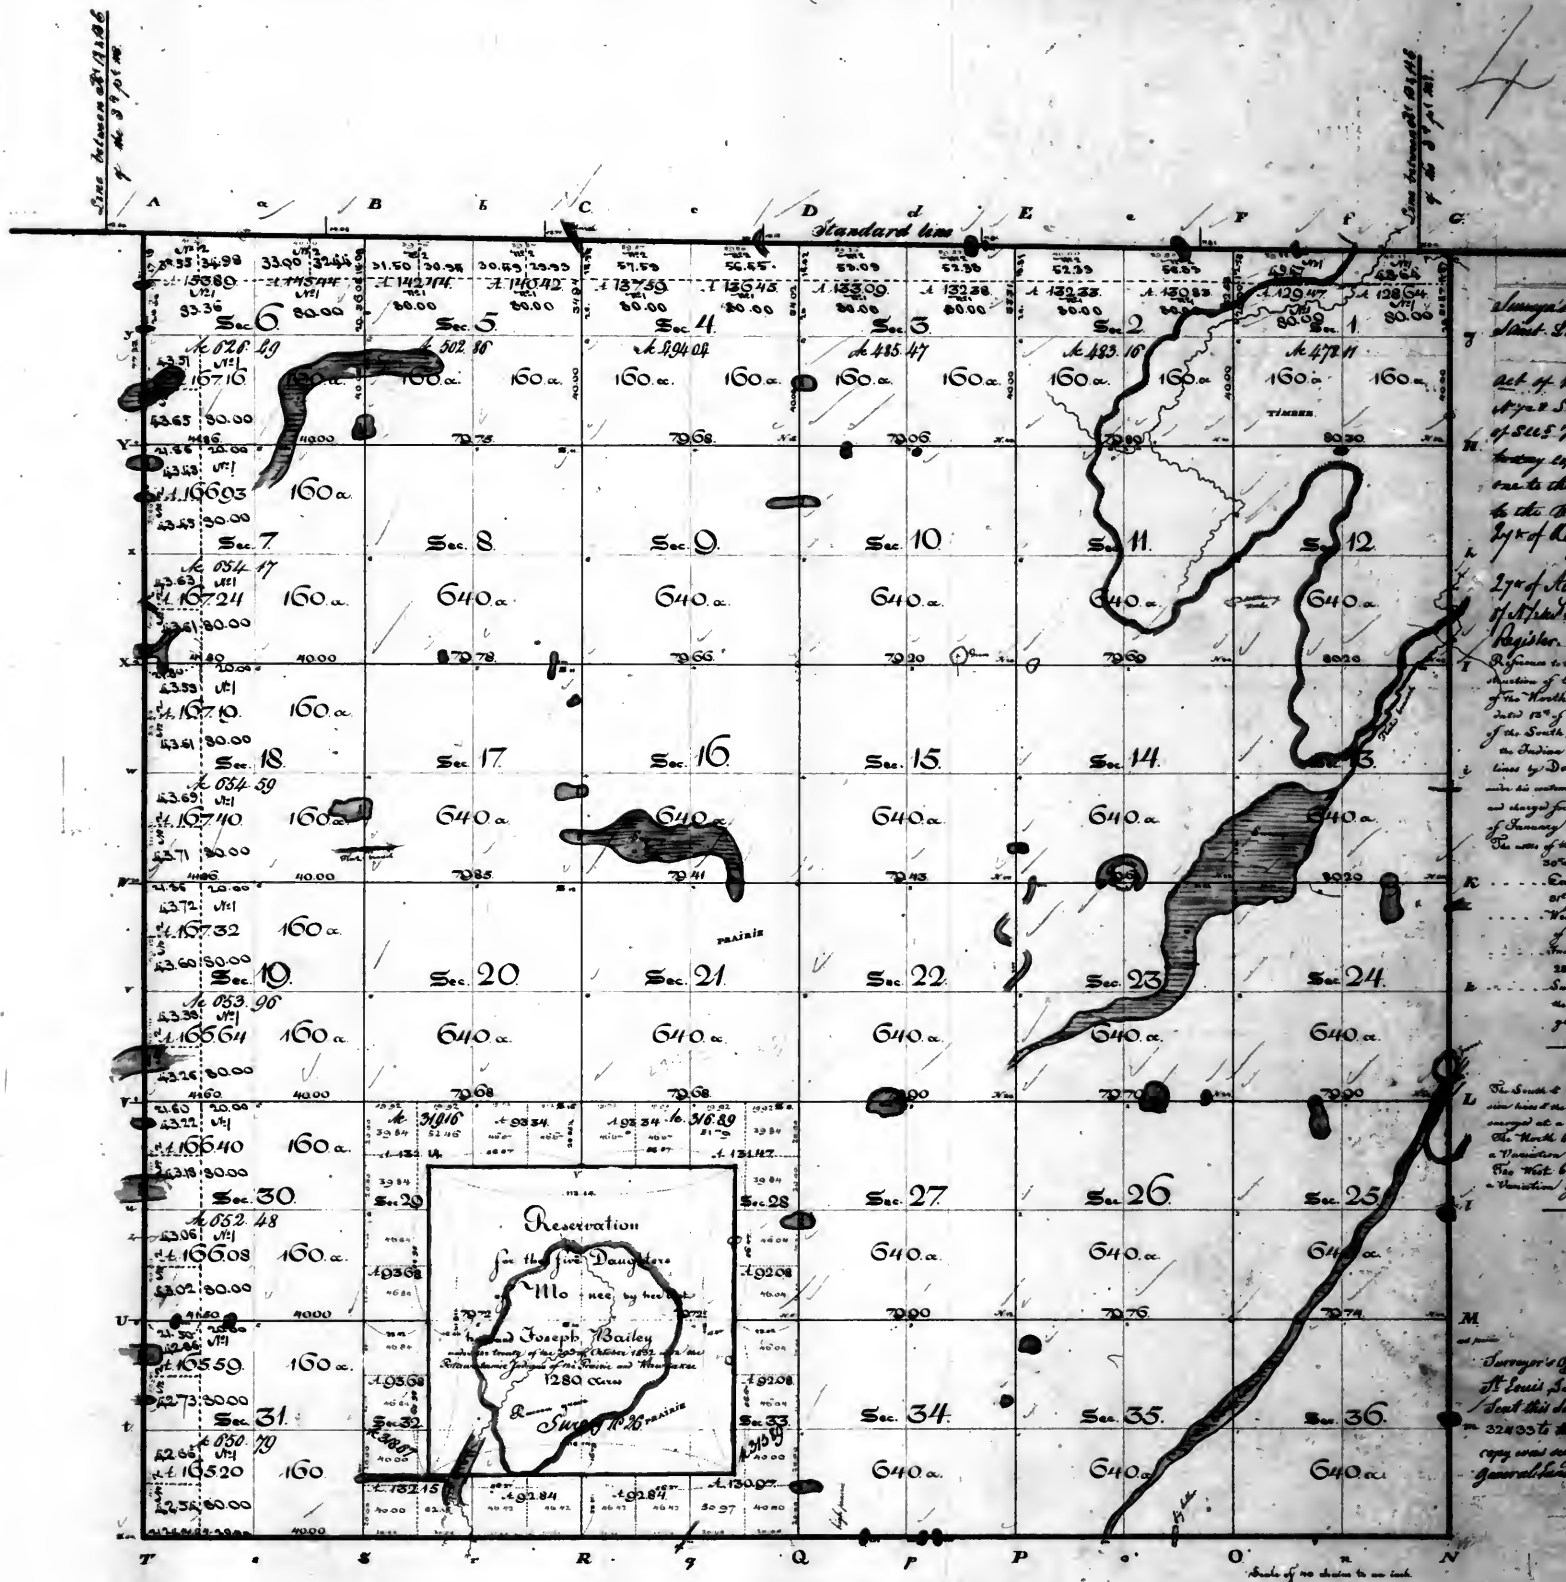

Surveyor's Office
St. Louis 12th Nov 1846
Subdivided under the
act of 1832; the lot 17.5 ac. of
the 5th 1/4 pt of Sec 6; the
of Sec 7. 1/4 14.30 23.6 and land
being copies of the plat thereof
sent to the Register, and sent there
to the Commissioner, on the
24th of August 1845.

27th of August 1845. Sent a plat
of the plat to the Commissioner
Register.

Reference to the field notes used in the
survey of the North boundary of the
North boundary is to the plat
dated 15th of May 1844
of the South East & West boundaries
the Indian Reservation & Subdivision
line by Don Alonzo Spaulding
in his report of the 5th of October 1844
and changed for in his report of the 25th
of January 1845.

The line of the South boundary on dated
25th of May 1844.
East boundary on dated
25th of May 1844 & 2nd of June 1844.
West boundary on dated 25th
of May 1844.
Indian Reservation on dated
25th of July 1844.
Subdivision line on dated for
the 25th of July 1844 to the 1st of Aug.
1844.

The South & East boundaries the Subdivision
line have the Indian Reservation line
surveyed at a Variation of 7th East.
The North boundary was surveyed at
a Variation of 6th 45 East.
The West boundary was surveyed at
a Variation of 7th 20 East.

Surveyor's Office
St. Louis June 12th 1850
Sent this day a copy of plat 26.0
32.400 to the Register, and another
copy was sent to the Comptroller of the
General Land Office on the same day.

Surveyor's Office
St. Louis 17th August 1823


The above Plat of Township 34 North of the base line Range 13 East of 3^d principal Meridian is, according to the field notes
of the survey thereof, in file in the Office, which have been examined and approved. The said boundary was surveyed in the 2^d quarter
of 1824, by John Clark, under contract of the 22nd of September 1823. The South, east and west boundary lines the subdivision
line and the Indian reservation, were surveyed in the 3^d quarter of 1824, all by D. B. Spaulding, under contract of the
3rd of October 1823.

William Milburn
Surveyor General

Register 18 April 1857
Comptroller 27 August 1859

Aggregate Area { Public Land 210,403.75
Indian Reservation 1580.00
Total 211,983.75 ac.

Township 35 North of the base line, Range 13 East of the 3rd principal meridian.

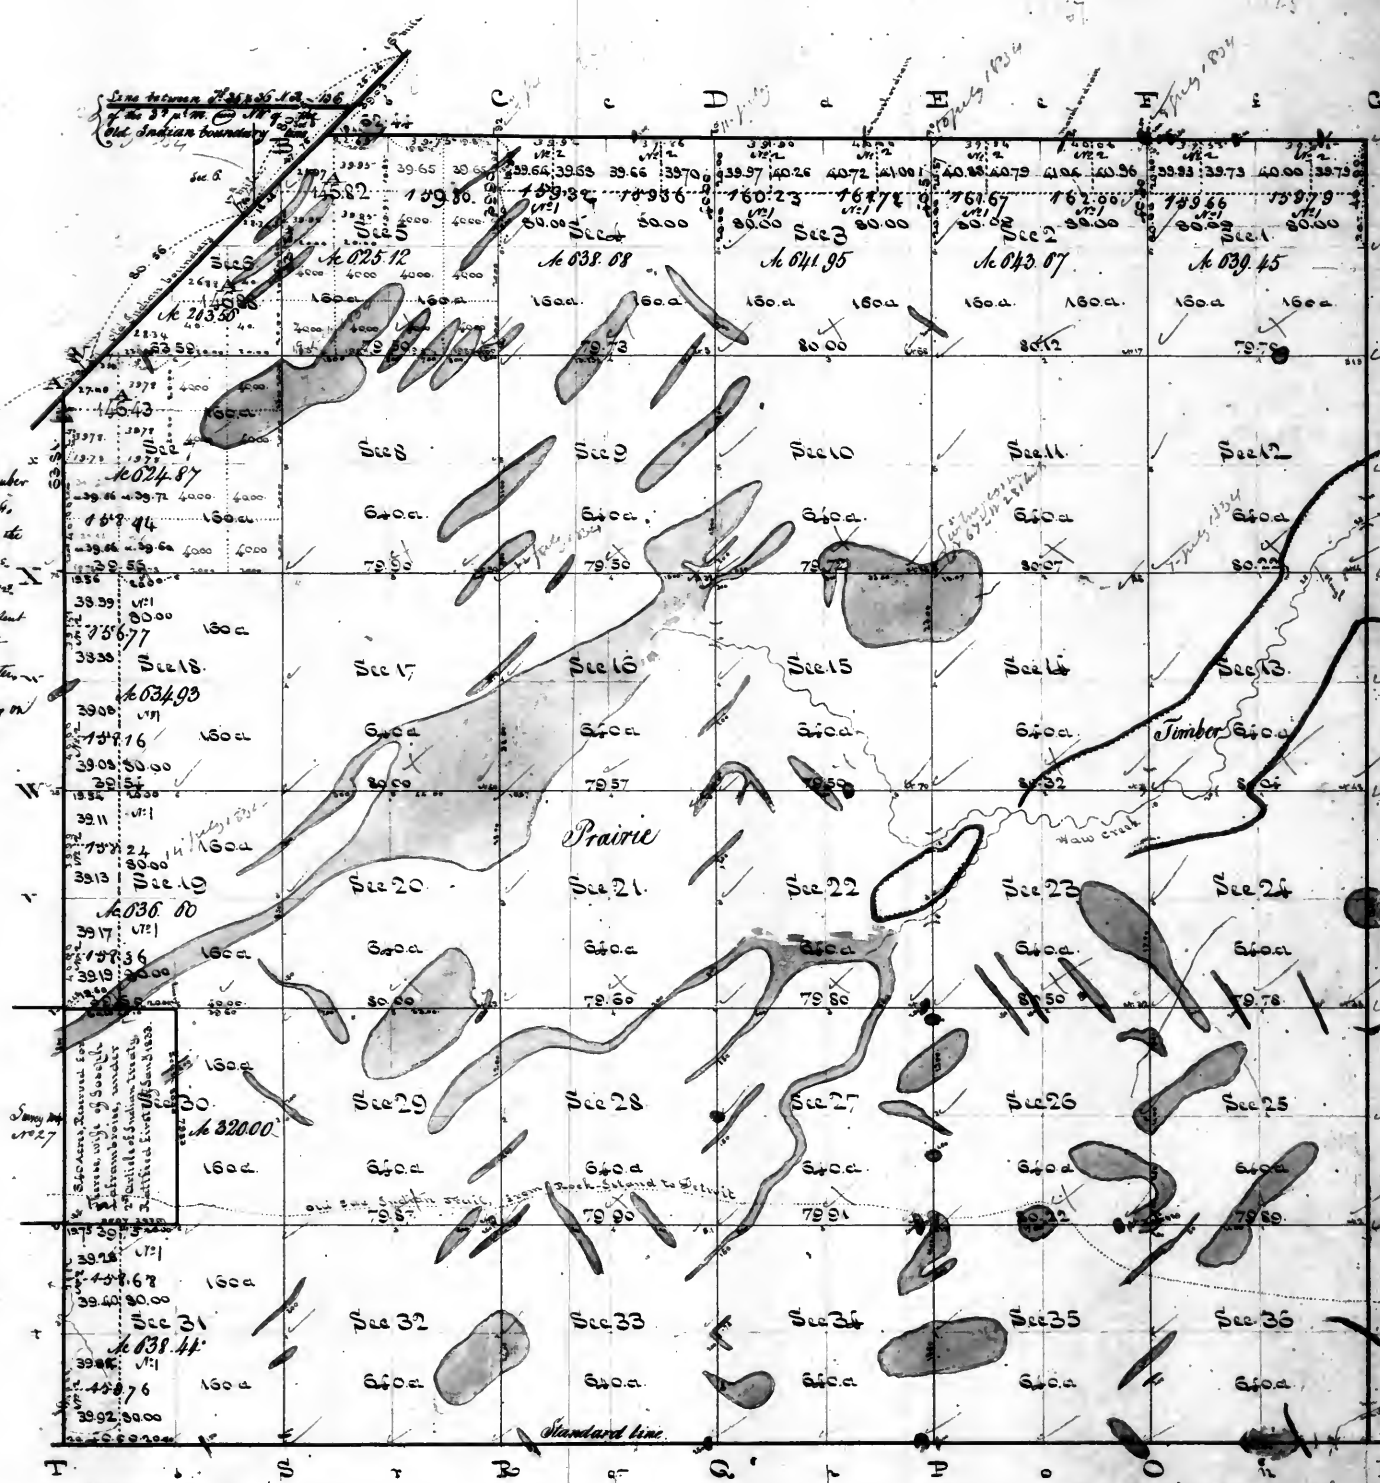

Surveyor General's Office - Saint Louis 26 August 1832.
The mile points designated on the old Indian boundary line are, the points proposed one mile apart according to the measurement on the said line at the time of the survey thereof, by W. H. Allen. These numbers are progressive from Lake Michigan - The distances set down between said mile points are according to the measurement of 1832.

William Milburn
Surveyor General

Christian
Indian boundary line
at the line 1st & 2nd

Surveyor General's Office.
Saint Louis 19 August 1832.

The above plat of Township 35 north of the base line, range 13 east of the 3rd principal meridian, South east of 'old Indian boundary line' is strictly conformable to the field notes of the survey of said fractional township on file in this office, which have been examined and approved - The line designated 'old Indian boundary line' was retraced and the corners or mile points thereon, were renewed by Don Alonzo Spaulding, in the 2nd quarter of 1834, under contract of the 3rd day of October 1830 - The said 'old Indian boundary line' was originally surveyed in the 1st quarter of 1819 by James M. Duncan, assistant to John C. Sullivan, under a letter of Appointment from William Rector, Surveyor of the Lands of the United States in Illinois and Missouri, dated October the 13. 1818, authorizing Sullivan as Surveyor and Duncan as assistant to survey under the direction of Commissioners Graham and Philips, appointed by the President of the United States, to run the line of the tracts ceded by the treaty of Saint Louis of the 24th of August 1816 (page 177 and following - Land laws, within 1823) - This being the line agreed to be run from a point on Lake Michigan 10 miles Southwest of the mouth of the Chicago creek in a direct line to a point on the Kankakee 10 miles above its mouth, and was found by said Sullivan and Duncan to run S. 48° 2' W. 45 miles and 18 chains - In the 3rd quarter of 1821, John Wallis, whilst assisting Stephen Rector and Thomas C. Rector, in the execution of their contract of the 20th of March 1821, being unable to find and properly locate this line and the mile points thereon, further Southwest from the latter than the 8th mile point, commenced thence, and surveyed S. 48° 2' W. and struck the bank of the Kankakee 180 links South of the old line, but about 5 chains further Southwest - It was this resurveyed line to which the Survey to the N. W. were closed, and which was retraced and renewed by Spaulding, and is laid down on this map, in accordance with his field notes - The north, the east and south boundaries, were surveyed in the 2nd and 3rd quarters of 1834 - The subdivision line - and the Indian reservation, were surveyed in the 3rd quarter of the same year - all by John A. Clark, under contract of the 22nd of September 1830.

William Milburn
Surveyor General


Aggregate Area. 2224.27 acres of Public Land
Indian Reservation. 520.00 acres
Total. 2744.27 acres.

Township 36 North of the base line, Range 13 East of the 3rd principal meridian

Surveyor General's Office.
Saint Louis 26 August 1839

The mile points designated on the old Indian boundary line, are the points perpetuated one mile apart according to the measurement on the said line, at the time of the survey thereof by Warren. Their numbers are progressive from Lake Michigan. The distances set down between said mile points are according to the measurement of M. Spaulding.

William Millman
Surveyor General

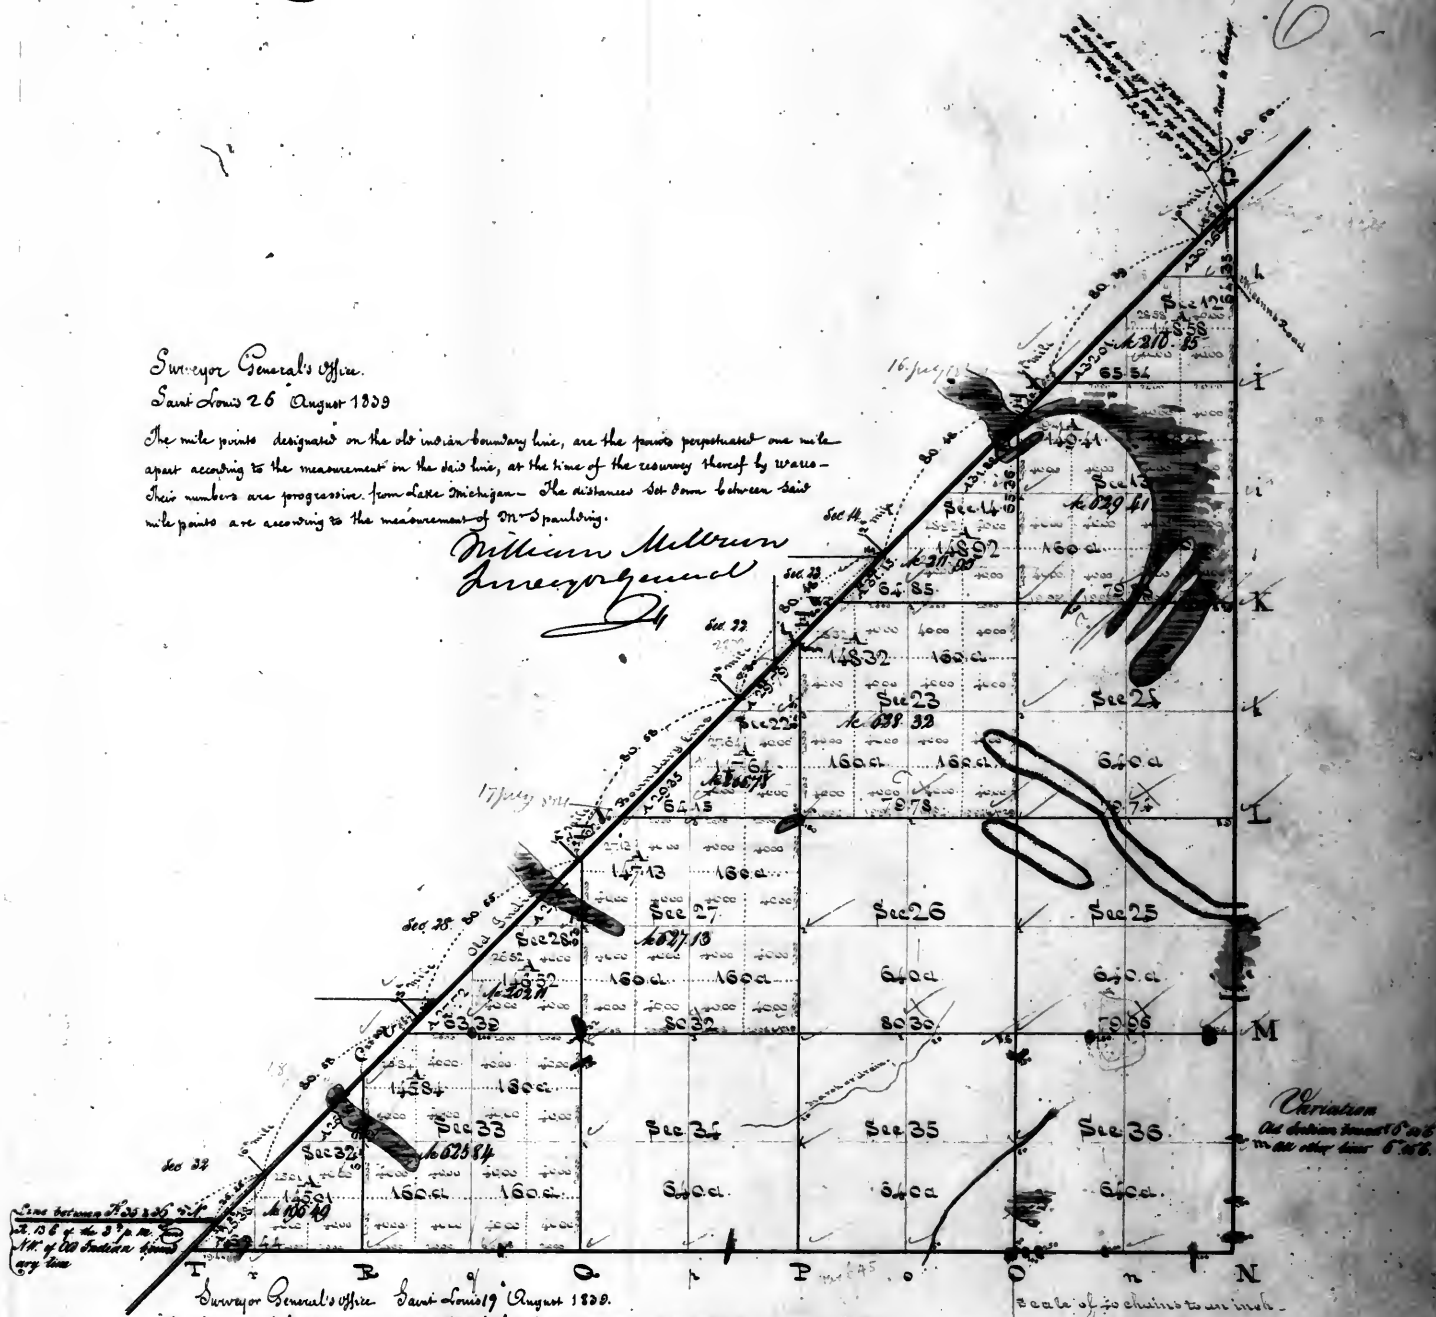


Surveyor General's Office Saint Louis 19 August 1839.

The above plat of fractional township 36 north of the base line, range 13 east of the 3rd principal meridian, south east of old Indian boundary is strictly conformable to the field notes of the survey thereof on file in this office which have been examined and approved. The line designated 'old Indian boundary line' was retraced and the mile points or corners thereon were renewed, by M. Spaulding, in the 2nd quarter of 1836, under contract of the 3rd of October 1835. The said 'old Indian boundary line' was originally surveyed in the 1st quarter of 1810, by James M. Duncan assistant to John C. Sullivan, under a letter of appointment from William Redter, Surveyor of the lands of the United States in Illinois, dated October the 15th 1810; authorizing Sullivan as Surveyor, and Duncan as assistant to survey under the direction of Commissioners Graham and Phelps, appointed by the President of the United States to run the line of the waste ceded by the treaty of Saint Louis of the 24th of August 1816 (page 177 and following - Land Laws, edition of 1825) - This being the line agreed to be run from a point on Lake Michigan 10 miles southward of the mouth of the Chicago river, in a direct line to a point on the Wabash 10 miles above its mouth - and was found by said Sullivan and Duncan to run S. 43° 2' W. 45 miles and 13 chains - In the 3rd quarter of 1821, John Wells, whilst assisting Stephen and Thomas C. Rector, on the occasion of their contract of the 20th of March 1821, being unable to find and properly identify this line and the mile points thereon; further southward from the latter than the 8th mile point, named Horst, and resurveyed S. 41° 2' W. and 57 miles the head of the Wabash 180 miles south of the old line, but about 5 chains further southward - It was this resurveyed line to which the survey to the NW corner closed, and which was retraced and renewed by Spaulding; and is laid down on this map in accordance with his field notes - The South and east boundaries were surveyed in the 2nd quarter of 1834 - and the subdivision lines in the 3rd quarter of the same year - all by John A. Clark, under his contract of the 22nd of September 1835.

Aggregate area 7278.88 acres.

William Millman
Surveyor General


7

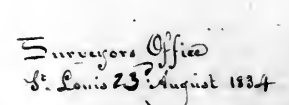

E. O. Simpson

Plat of Township N° 37 North of the Base line Range N° 13 East of the 3rd principal Meridian

8

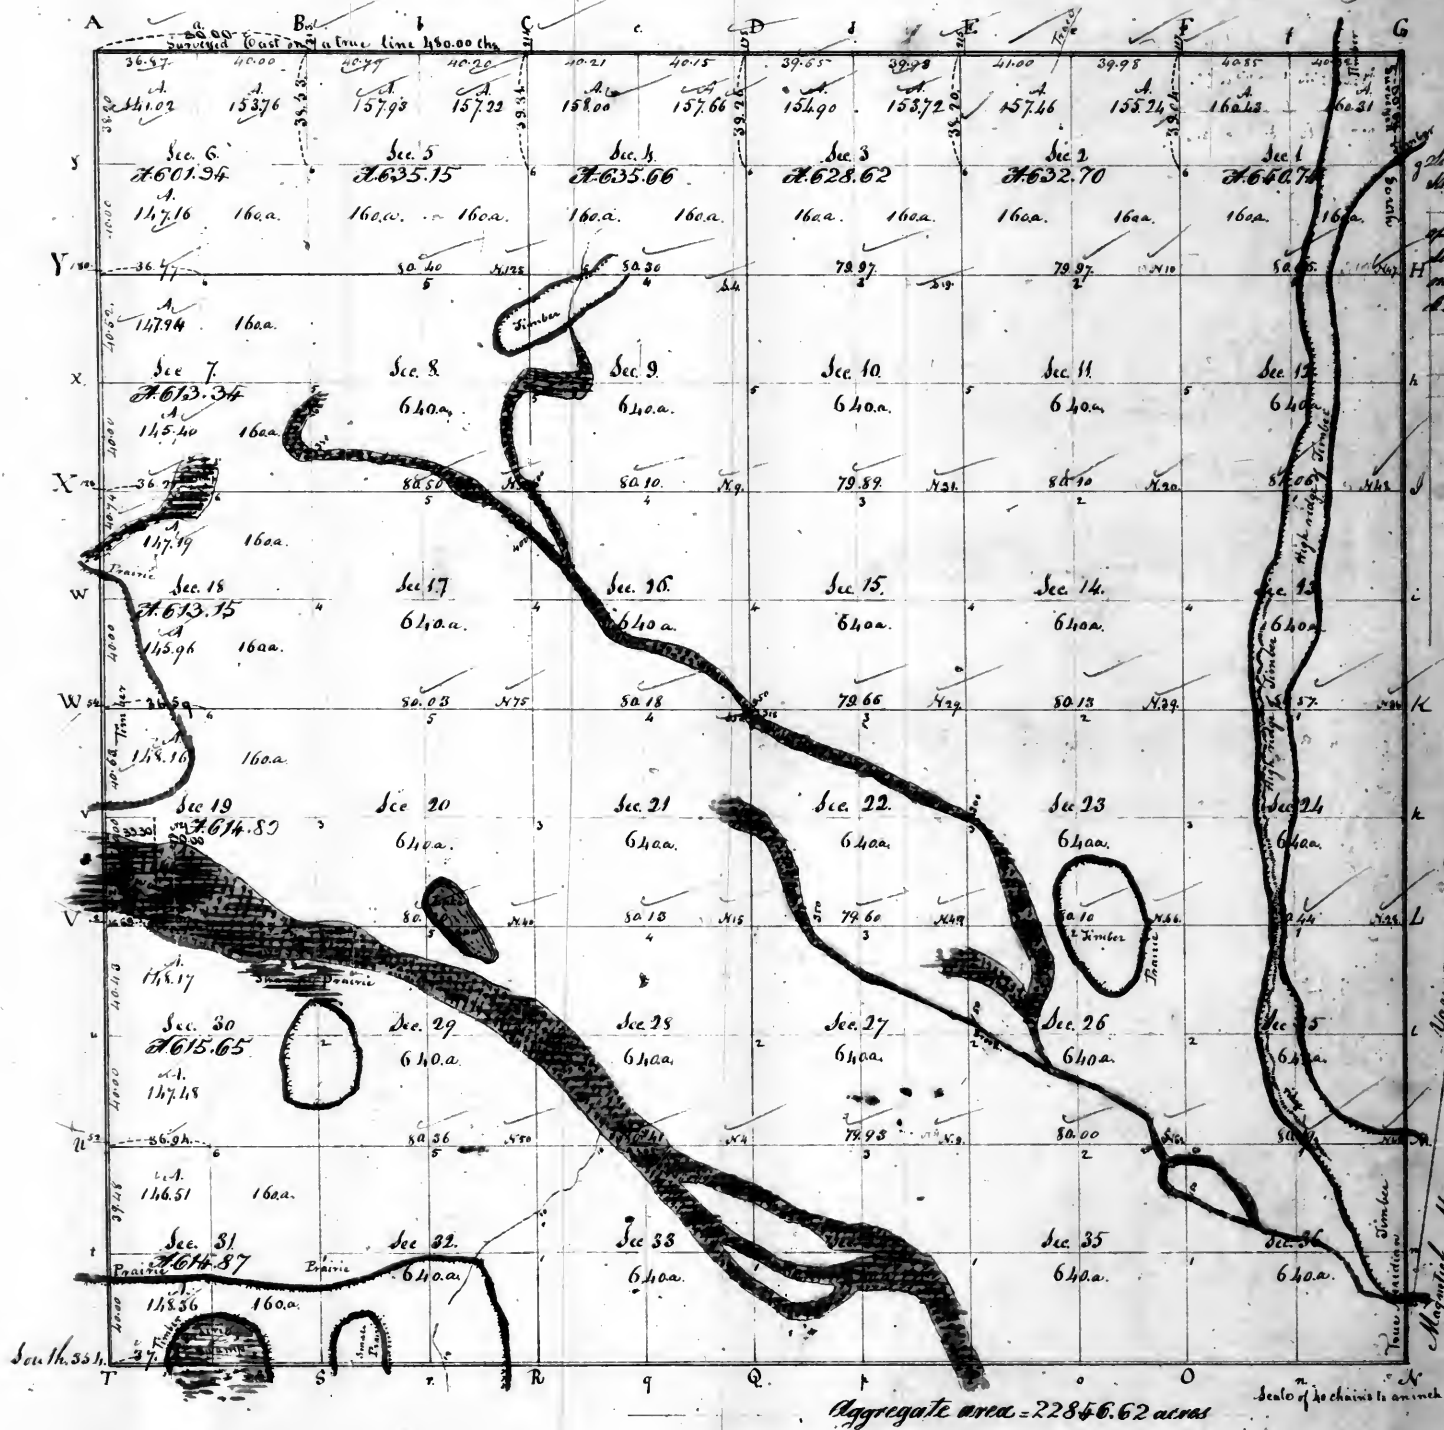

Shuman's Office 13th November.
 Subdivision under the act
 of 1832, viz. the S.W. q. of Sec. 15
 and Sec. 16 of Twp. 37 N. R. 13 E.
 are to be kept open and another to be
 a commission on the 27th April 1834


Ex-10 from
 1834

Surveyors Office
 St. Louis July 3, 1834.

The above Plat of Township 37 North of the base line, Range 13 East of the 3rd principal meridian, is conformable to the field notes of the survey thereof on file in this Office.

E. J. Sanham

Plat of Township 38 North of the Base line. Range 13 East of the 3^d Principal Meridian

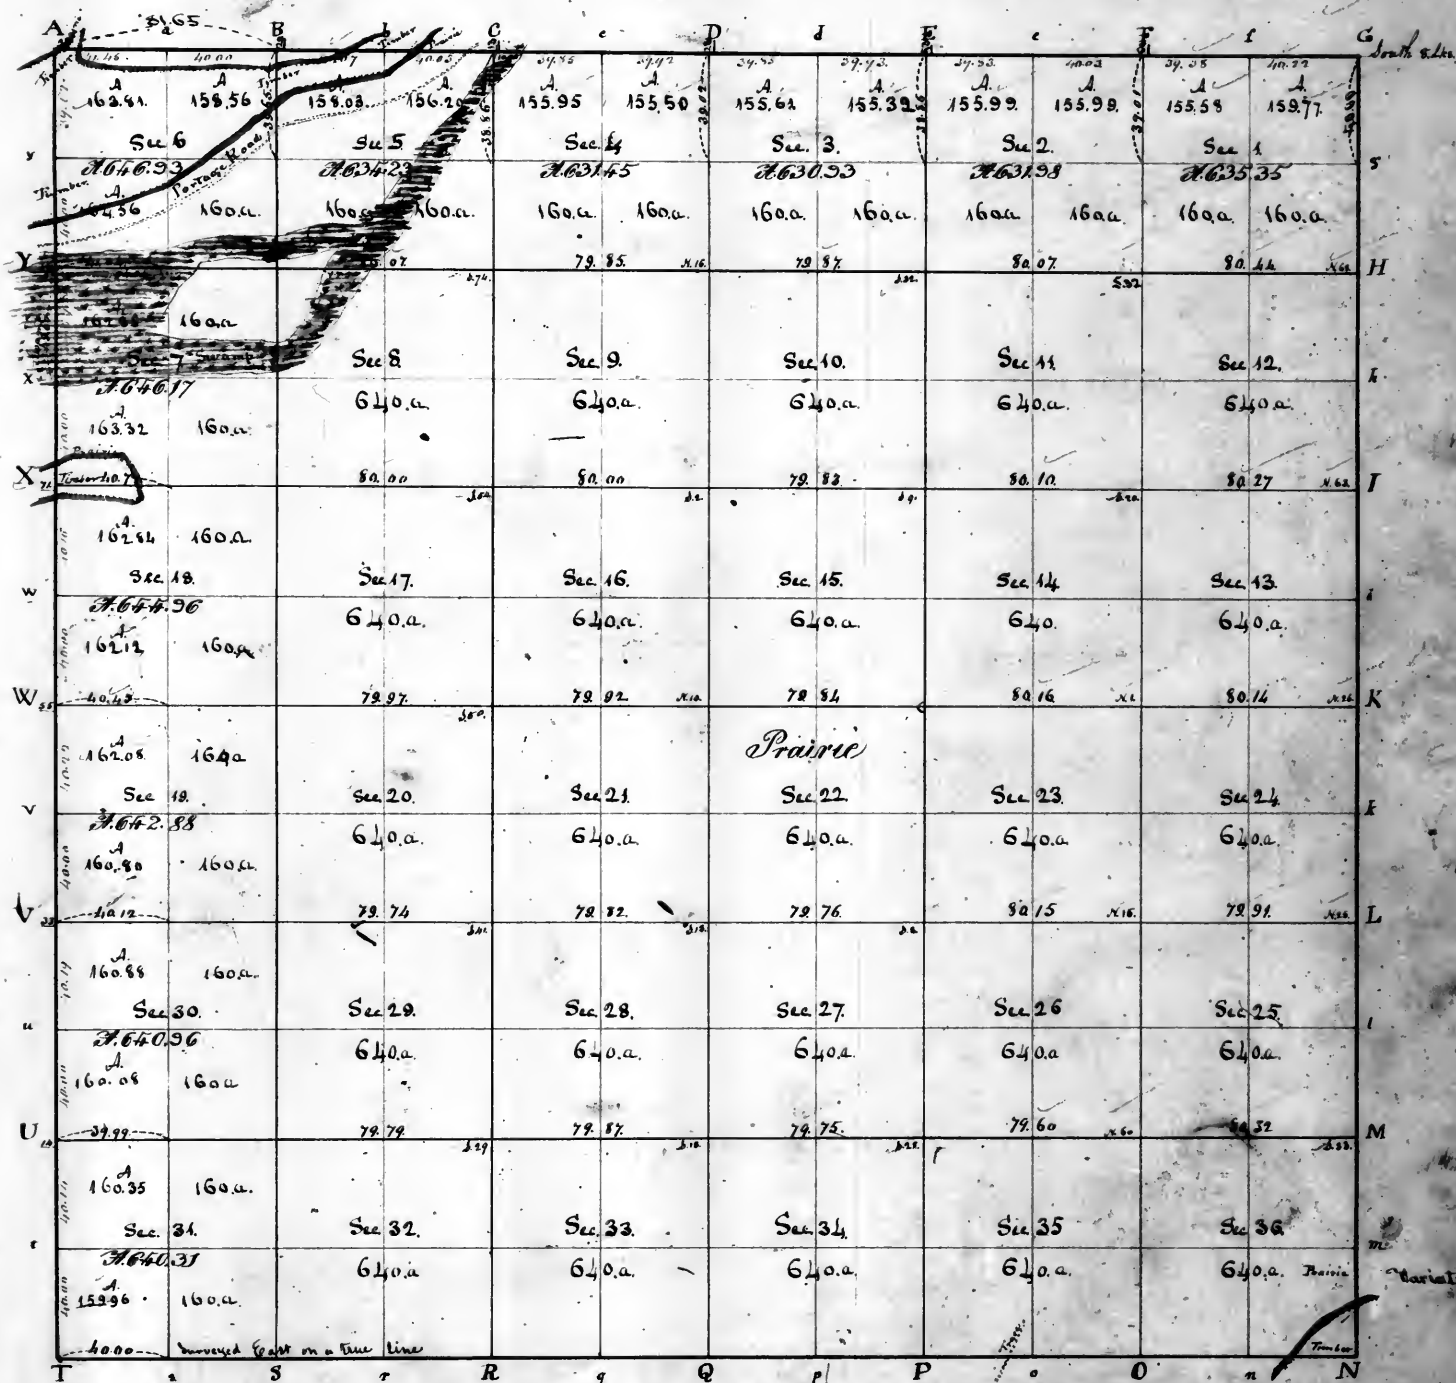


Surveyors Office
St. Louis July 31 1854

The above Plat of Township 38 North of the base line, Range 13 East of the 3^d Principal Meridian, is conformable to the field notes of the survey thereof on file in this Office.

E. J. Langham

Plat of Township N° 39 North of the Base line. Range 13 East of the 3^d Principal Meridian

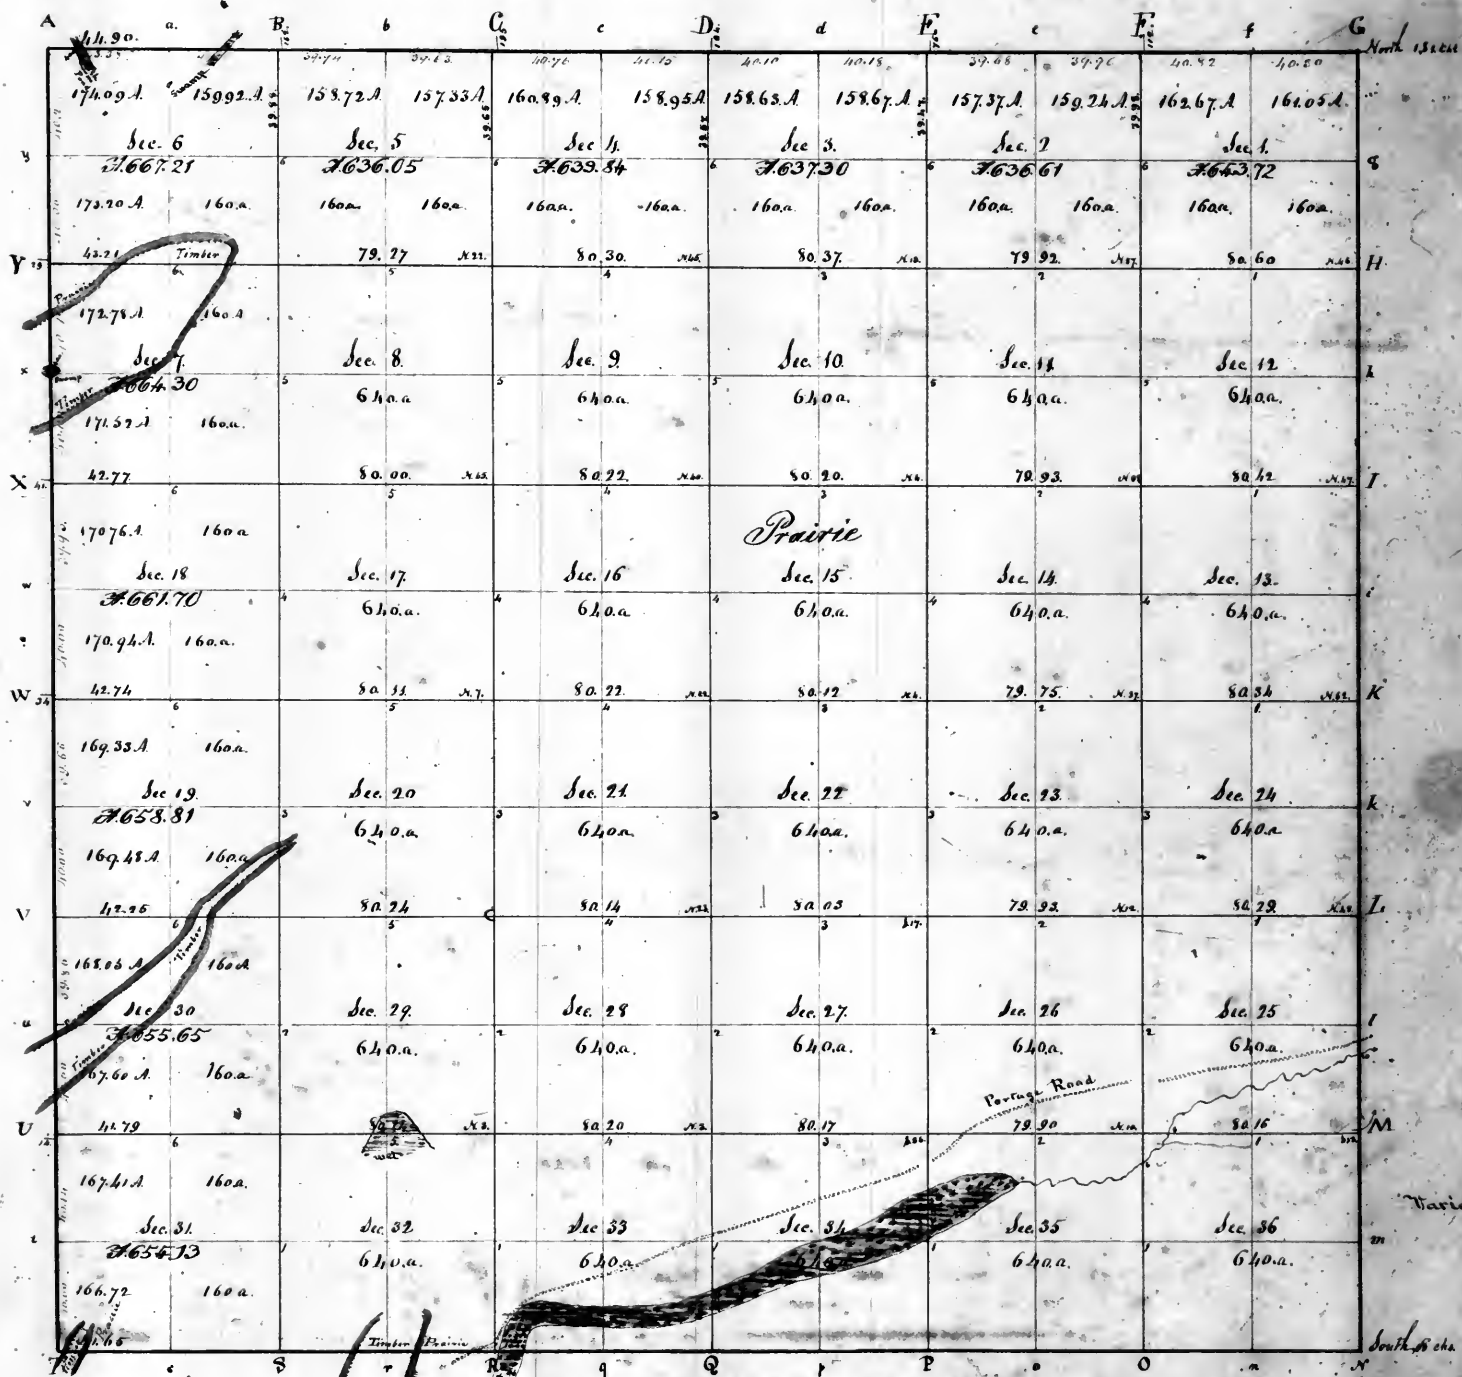

Surveyors Office
St. Louis July 1854

This above Plat of Township 39 North of the base line, Range 13 East of the 3^d Principal Meridian, is conformable to the field notes of the survey thereof on file in this Office.

E. J. Sanham

[illegible]

over. 1

10


— T. 41. N. 13 E — — — — — 315.16

Total = 1809647 ac.

The above Plate of fractional Townships 40 & 41 North of the base line, Range 13 East of the 3 principal Meridian, South East of the Old Indian boundary line, is conformable to the field notes of the survey thereof on file in this Office.

E. T. Sengham


12.

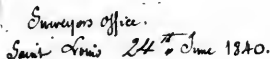

William Milburn
Surveyor of the public lands
in the States of Illinois & Indiana.

Fractional Township 41 North Range 13 East of the 2d principal Meridian

13

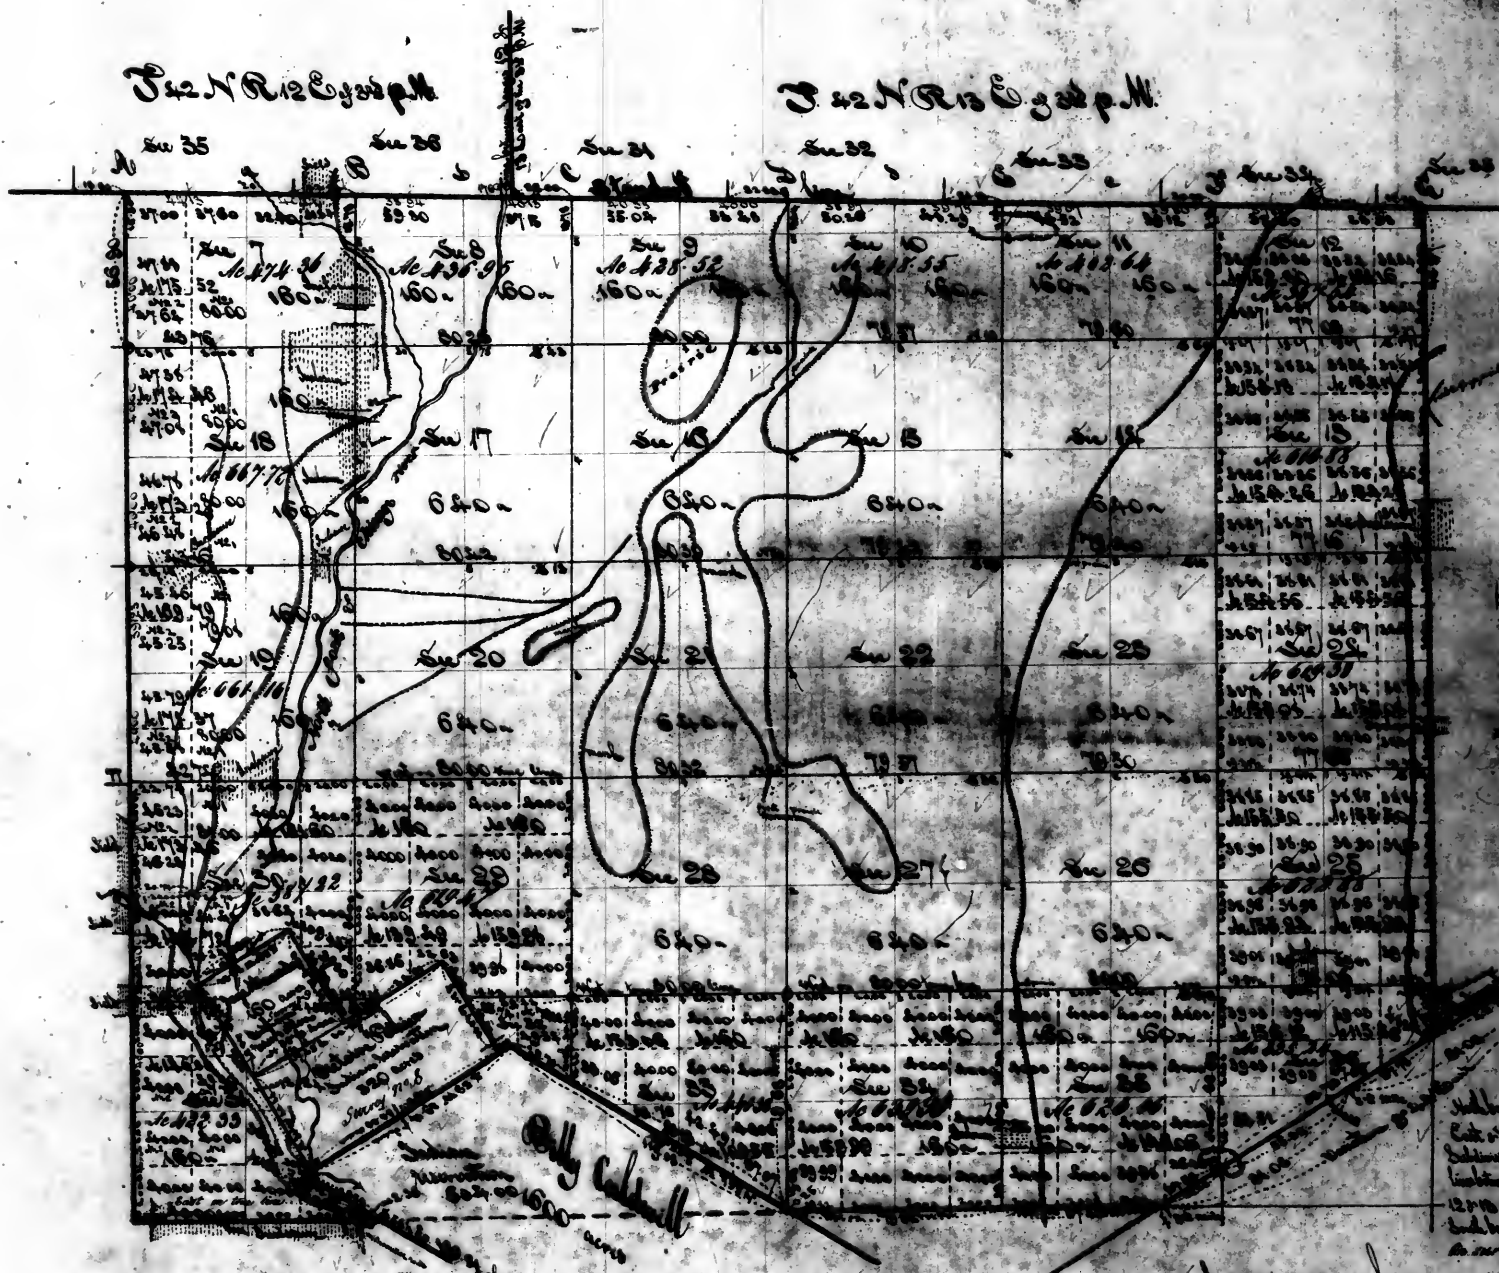

Surveyor's Office
June 24 1840
The above plat of fractional township 41 north of the base line, range 13 east of the 2d principal meridian, is hereby confirmed to the field notes of the survey of said fractional township on file in this office, which have been examined and approved. The south eastern boundary of this fractional township which is designated 'McArthur boundary line' was surveyed in the 4th quarter of 1818, by John C. Sullivan, as principal surveyor, and James McArthur, as assistant surveyor, under the authority of a letter from William Hector, Surveyor of the public lands in the Territories (now States) of Illinois and Missouri, dated the 13th October 1818, authorizing said Sullivan and McArthur to survey under the direction of Commissioners Graham and Phelps, appointed by the President of the United States, to run the line of the tracts ceded by the treaty of St. Louis of the 23rd of August 1804 (page 177 and following, laws of Illinois of 1820) - This being the line agreed to be run from a point ten miles north of the west end of the Portage between Chicago Creek which empties into Lake Michigan and the River Des Plaines, a part of the Chicago, in a direct line to a point on Lake Michigan, the north end of the mouth of Chicago Creek, and was found by said Sullivan and McArthur to run from the above designated point on Lake Michigan S. 60° E. 10, 3 miles and 75 chains, to the point 10 miles north of the west end of the Portage. The said old survey boundary line was retraced, and the fractional section corners for the surveys on the south east side thereof, and the mile points thereon were renewed in the 3rd quarter of 1837, by E. S. Peck, under contract signed by the Surveyor General on the 8th of May, and by 7th of June 1837. This recovery was paid for in the 4th quarter of 1838 - and charged in the account current of the Surveyor General for that quarter, Voucher No. 5. - The north boundary of this fractional township, was surveyed in the 2nd quarter of 1837, by James Thompson, under contract signed by the Surveyor General on the 21st of November, and by 7th of December 1836. - It was paid for in the 1st quarter of 1839, and charged in the account current of the Surveyor General, for that quarter, Voucher No. 6. - The south boundary, West of the old Indian line, viz: East of the survey of Billy Caldwell's Indian reservation, Trunk 57, 25 chains, and west of said Caldwell's survey, Trunk 8, 63 chains together 2 miles 65.34 chains. - The west boundary, 5 miles 56.30 chains - the east boundary, North of the old Indian line, Trunk 65, 22 chains, the subdivision lines 44 miles 55.41 chains, were surveyed, - and the lines of the public surveys, were connected with the surveys of the Indian grants. - 2 miles and 44 chains, all in the 4th quarter of 1839, by George W. Hamilton, under contract of the 21st of September 1839 - They were paid for in the 3rd quarter of 1840, and they will be charged in the account current of the Surveyor General, during the 4th quarter, under the general appropriation for surveying the public lands, Voucher No. 12. - The tract of - 1600 acres, granted to John W. Moore - of 225 acres, granted to Victor J. Fisher, - and of 1600 acres, granted to Billy Caldwell, by the fourth article of the treaty between the United States and the United Nations of Chippewa, Ottawa, and Shawanoe Indians, ratified on the 2nd day of January 1830, were surveyed in the 2nd quarter of 1836, by B. B. Cross, under instructions of the 10th of May of the same year. - It does not appear from the files of accounts in this office that this surveying by B. B. Cross, has ever been paid for.







William Hamilton
Surveyor of the public lands in the
States of Illinois and Missouri

W. H.

Fractional Township 42 North Range 13 East 1st principal Meridian

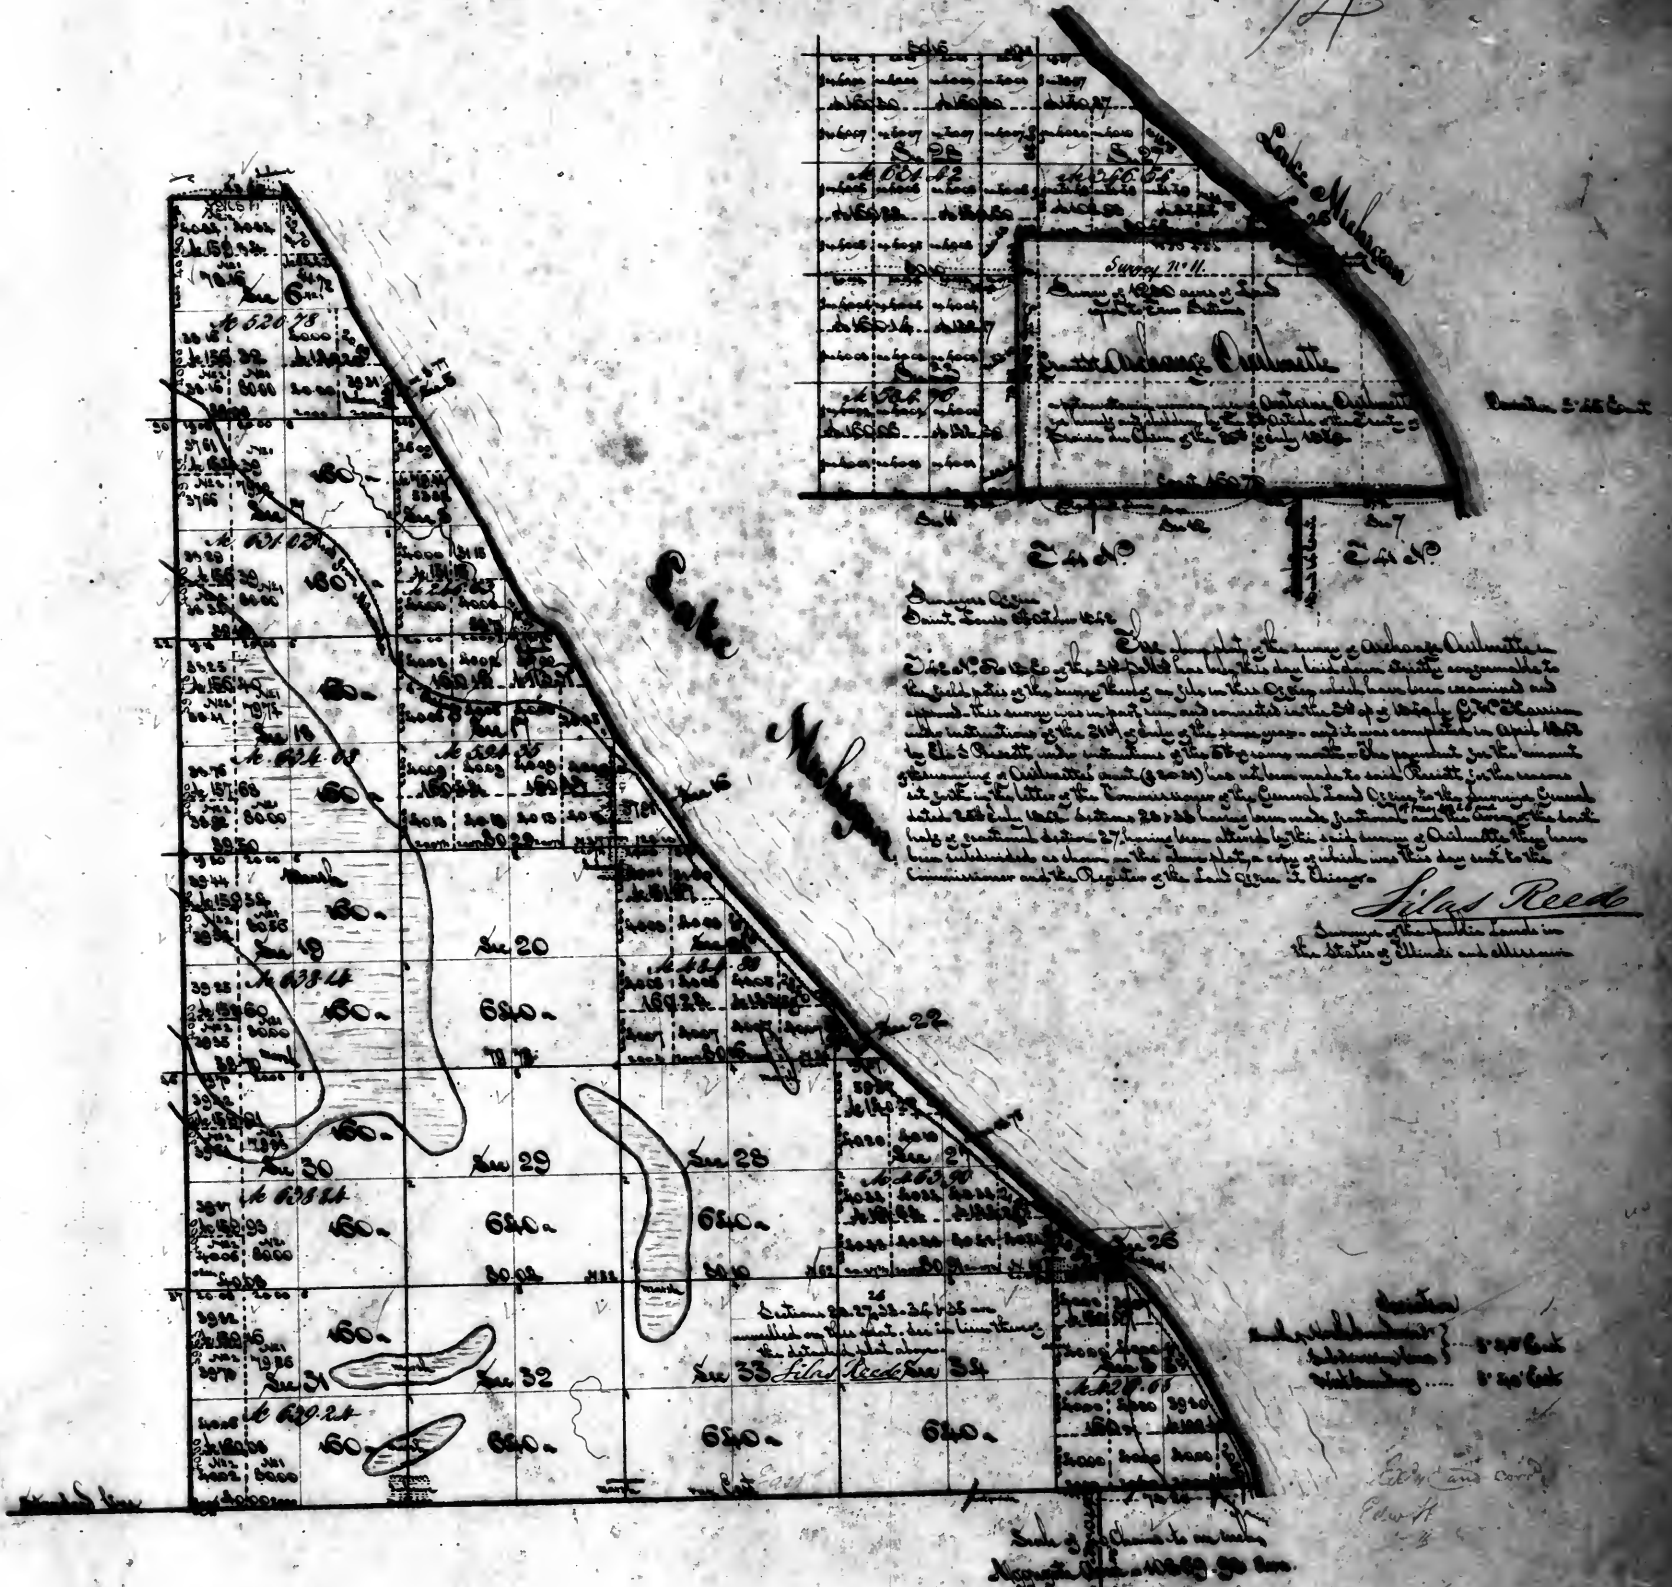

Surveyors Office
Saint Louis 24 June 1840.


The above plat of fractional township 42 north of the base line, range 13 east of the 3rd principal meridian, on the western margin of Lake Michigan, is strictly conformable to the plat notes of the survey of said fractional township, on file in this office which have been examined and approved. The South boundary 4 miles 14.20 chains, was surveyed in the 2nd quarter of 1837, by James Thompson, under contract signed by the Surveyor General on the 21st of November 1836, and by W^m Thompson on the 15th of December of the same year. It was paid for in the 1st quarter of 1839, and charged in the account current of the Surveyor General, for that quarter, Voucher No 6. The west boundary 6 miles - the north boundary 4.3.66 chains - the subdivision lines 24 miles 77.73 chains - and the meanders of the western margin of Lake Michigan 7 miles 41.43 chains, were surveyed in the 4th quarter of 1839, all by George W. Harrison, under contract of the 31st of September of the same year. These surveys by W^m Harrison, were paid for in this 2nd quarter of 1840, and they will be charged in the account current of the Surveyor General, during the said quarter under the general appropriation for surveying the public lands, Voucher No 12.

William Harrison
Surveyor of the public lands in
the States of Illinois and Wisconsin.

Chor

Township 31 North of the base line, Range 14 East of the 3rd principal meridian

15

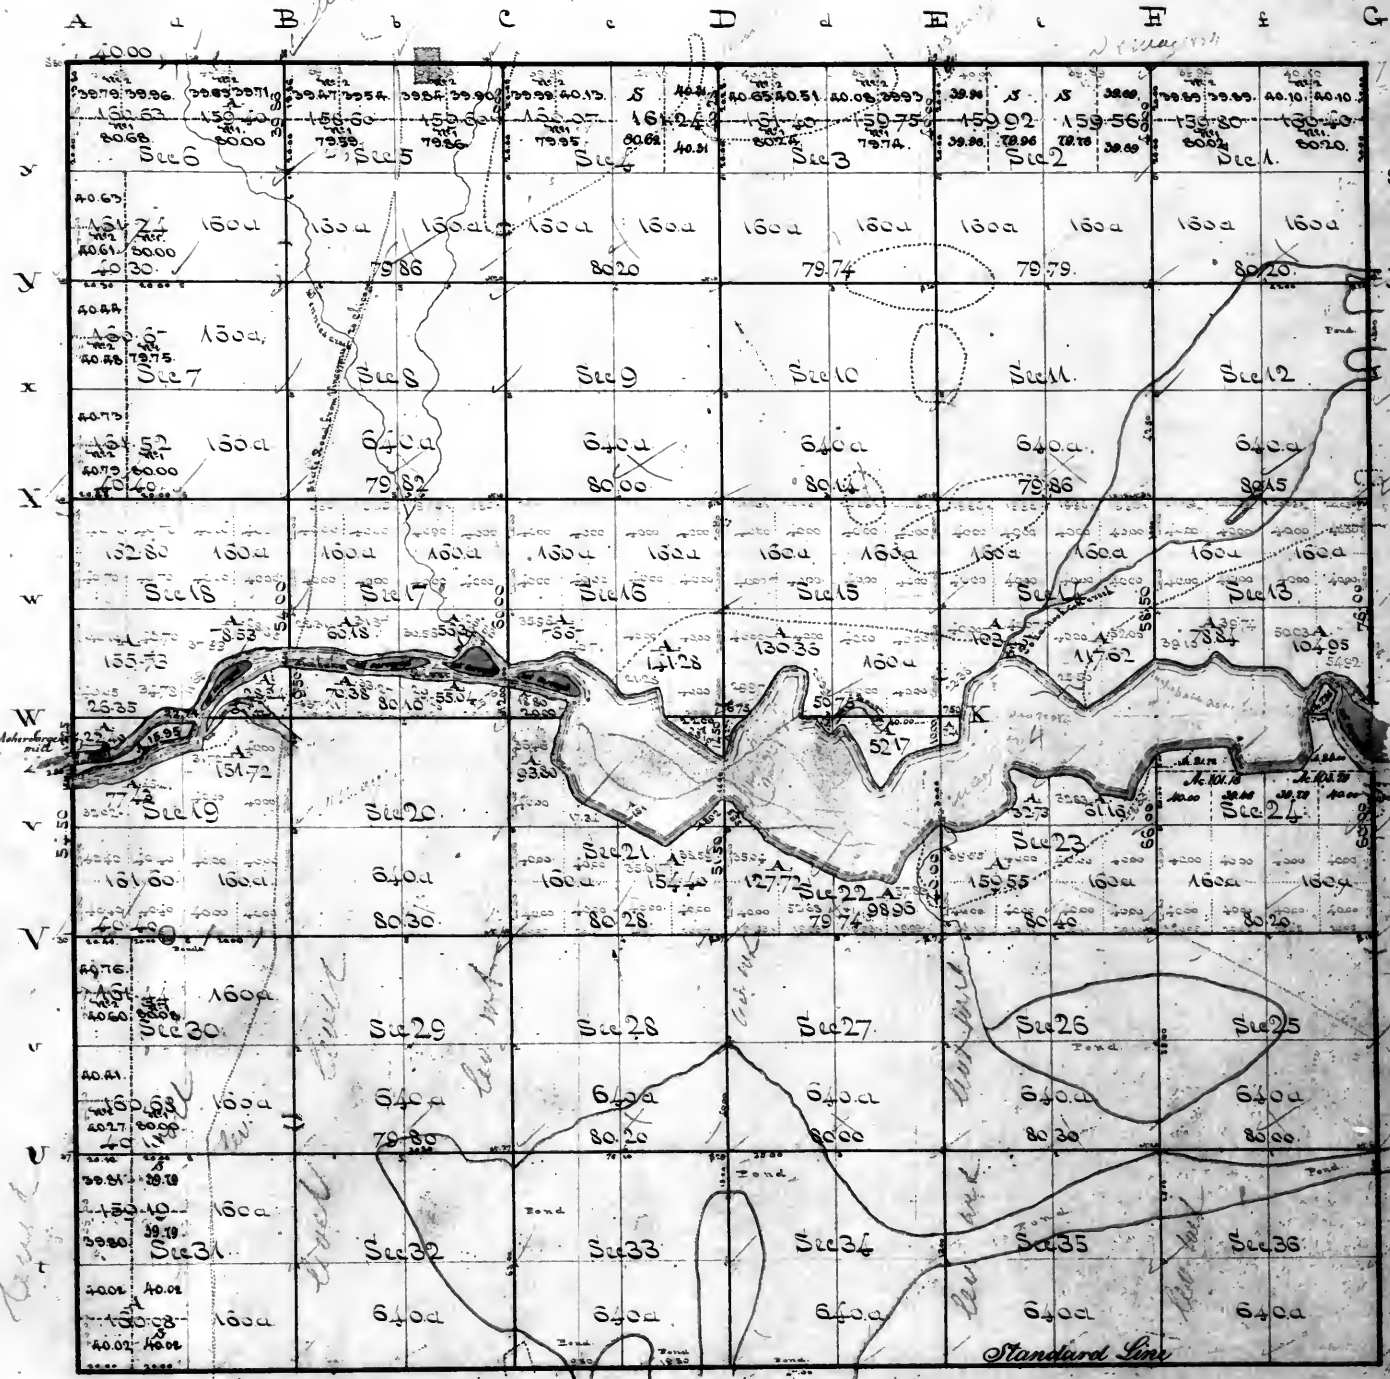

Surveyor General's Office
 St. Louis, the 7th of April 1840
 The survey of that part of an island, which lies in Section 13, including the connections thereof with the surveys on the main shore, has this day been laid down on this plat, according to the field notes thereof on file in this office, which have been examined and approved. Said survey was executed by Addison Collins in the first quarter of 1840, under instructions from this office, dated the 11th of December 1839, signed in conformity with the letter of the Commissioner of the General Land Office, dated the 17th of July 1837. A plat of fractional section 13 on island has this day been sent to the General Land Office, and another plat thereof to the Register of the District Land Office.
 William H. Brown

On February 5th 1839, the area of the island of the north half of section 24, and of fractional section 13, and the river, was calculated, also the north half of section 2, and the south half of section 3, and the whole township was divided into 36 equal parts, and a copy of the plat thereof was sent to the Commissioner of the General Land Office, and a copy of the plat of the whole township was sent to the Register at Chicago on the same day.

See letter from Register to St. Louis giving an account of sales.

Public land on main shore exclusive of the old half of sec. 24 and that part of sec. 13 which lies south of the river. 21400. 4 acres.
 Estimated area of river, including islands, of 3 of sec. 24 and that part of sec. 13 which lies south of the river. 1406. 66.

Total, 22806. 06 acres.


Surveyors Office.
 Saint Louis 23rd November 1838

The above plat of Township 31 North of the base line, range 14 East of the 3rd principal meridian, except the north fractional half of section 24, and that part of section 13, which lies south of the Kankakee river is strictly conformable to the field notes of the survey of that township, on file in this office, which have been examined and approved. The South and West boundary lines, were surveyed in the 4th quarter of 1835, and the East and North boundaries and the subdivision lines and meanders, were surveyed in the 2nd quarter of 1834, all by Daniel W. Beckwith, under contract of the 25th day of October 1835.

Daniel W. Beckwith.
 Surveyor.

Township 32 North of the base line Range 14 East of the 3rd principal Meridian

16

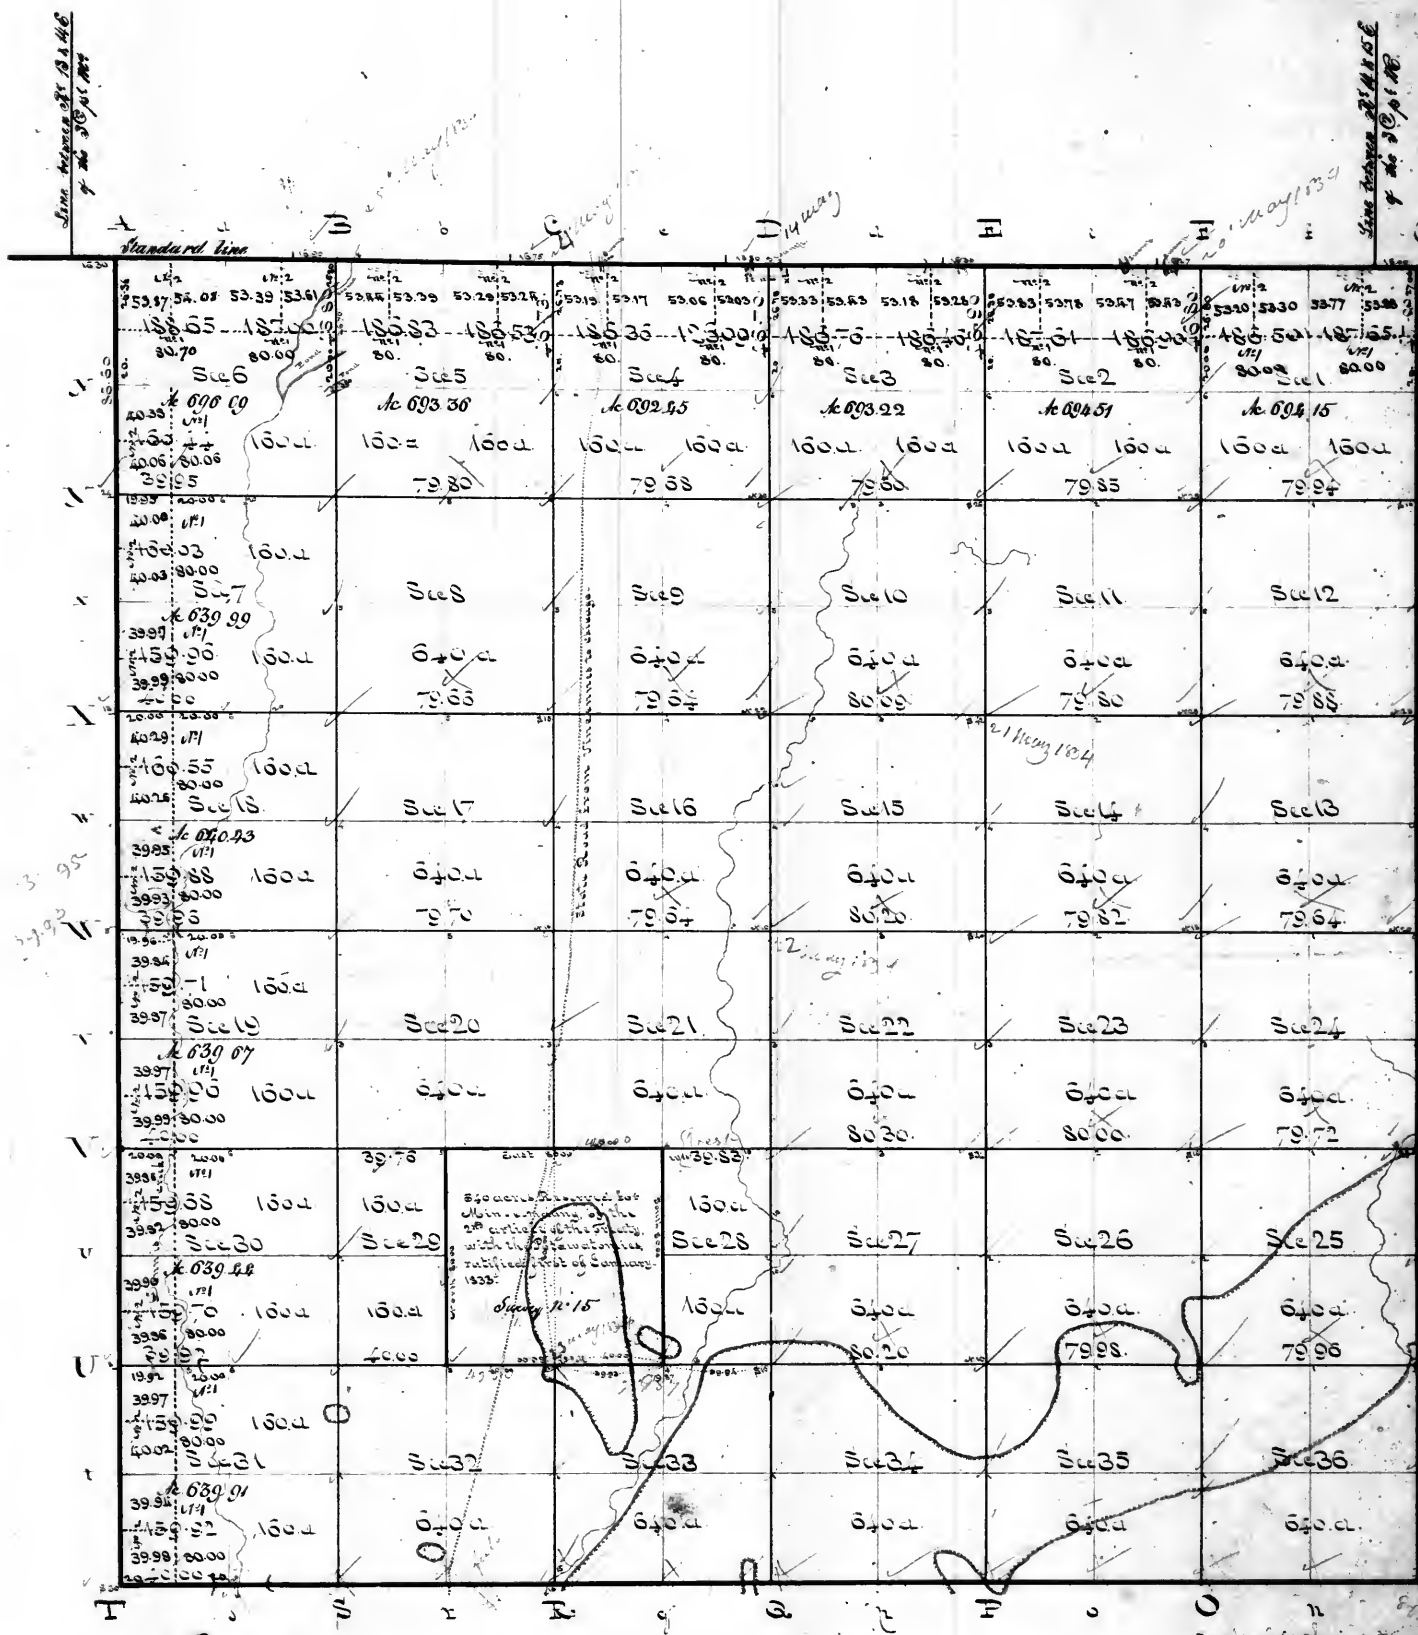

Surveyor's Office 12th November
Saint Louis, Mo.
Subdivided under the act
of 1820, the lot of Sec 1, the 4th of
Sec 2, the 6th of Sec 3, the 10th of Sec 4, the 14th of
Sec 5, and last being copies of the
plat thereof, are to the Register, and are
there to the Commissioner, on the 27th
of August 1845.
27th of August 1845. Subdivided
and a plat of it is to be
to Comr. H. Register.
Note
14th May 1846 Variation of the middle
served near the centre of the township
and found to be 6th East

Surveyor General's Office
Saint Louis 16th August 1839.


Public Land 22723.22 acres
Indian Reservation 6.00 acres
Total 23683.22 acres

The above plat of Township 32 north of the base line, range 14 east of the 3rd principal meridian is strictly conformable to the field notes of the Survey thereof on file in this office, which have been examined and approved. The north boundary was surveyed in the 2nd quarter of 1834, by Don Alonzo Spaulding, under contract of the 3rd of October 1833. The west, the South and the east boundaries, the subdivision lines, and the Indian reservation, were surveyed in the 2nd quarter of 1834, by Daniel W. Beckwith, under contract of the 29th of October 1833.

William Milburn
Surveyor General

Township 33 North of the base line Range 14 East of 3rd principal Meridian.

17

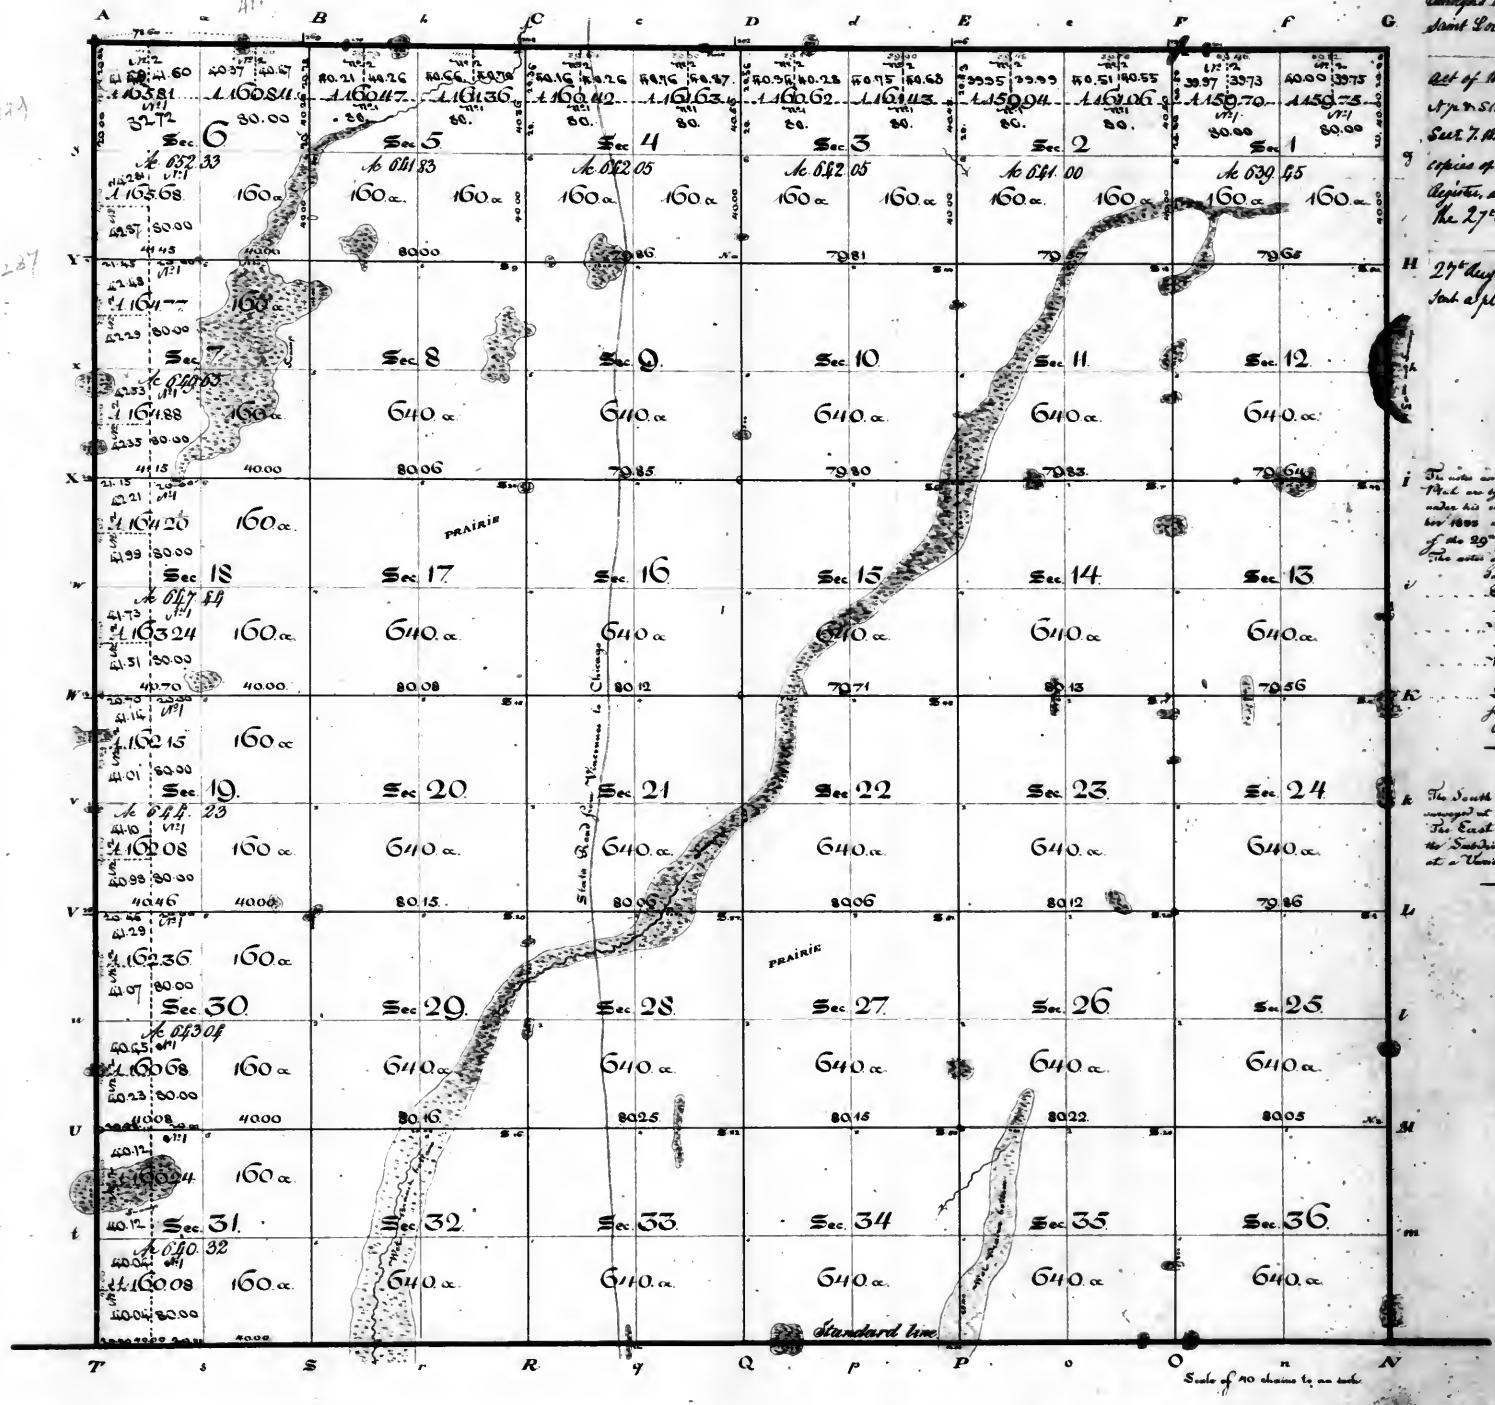

Surveyors Office 12th November
St. Louis 1845
Subdivided under the
act of 1833: viz. the 17th of Sec. 9 of
the 2nd of Sec. 6: the 17th of
Sec. 7: the 17th of Sec. 13: and the 17th
of the plat thereof: one to the
Republic, and another to the State, on
the 27th August 1845.

H 27th August 1845: subdivided &
plat of plat of 17th of Sec. 13: 1845.

i The notes and in the construction of this
Plat are by Don Alonzo Spaulding
under his contract of the 3rd of Oct.
1844 and changed for in his account
of the 25th of January 1845
The notes of the South boundary are
dated 3rd of June 1844.
East boundary are dated
4th of June 1844.
North boundary are dated
4th of June 1844.
West boundary are dated
30th of May 1844.
Subdivision lines are dated
from the 12th to the 23rd of
August 1844.

k The South & West boundaries were
surveyed at a Variation of 4th East.
The East & North boundaries
the Subdivision lines were surveyed
at a Variation of 5th East.


Aggregate Area 23083.33 acres

Surveyors Office
St. Louis 17th August 1849

This is a Plat of Township 33 North of the base line Range 14 East of 3rd principal Meridian, conformable to the field
notes of the survey thereof - in the Office which have been examined and approved - The section boundary lines were surveyed on
the 2nd quarter of 1844 - and the Sectional lines on the 3rd quarter of the same year, - all by Alonzo Spaulding under his contract
of the 3rd of October 1844 -

William Milburn
Surveyor General
D.H.

18.

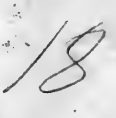

William Milburn
Governor General L₄


Township 35 North of the base line, Range 14 East of the 3rd principal meridian.

Color

19

Surveyor's Office
Saint Louis 19th Nov. 1833.
Subscribed and sworn to
at of 1833, viz: the 1st of Dec
1833, that per S.M. of Sec 6, the
S.M. of Sec 7 and the W.P. of Sec
18, 19 and 20 and the survey copies
of the plat thereof, are to the Register
and on the 2nd of August 1835.

Correction
on West boundary line
on the other line 6th east.

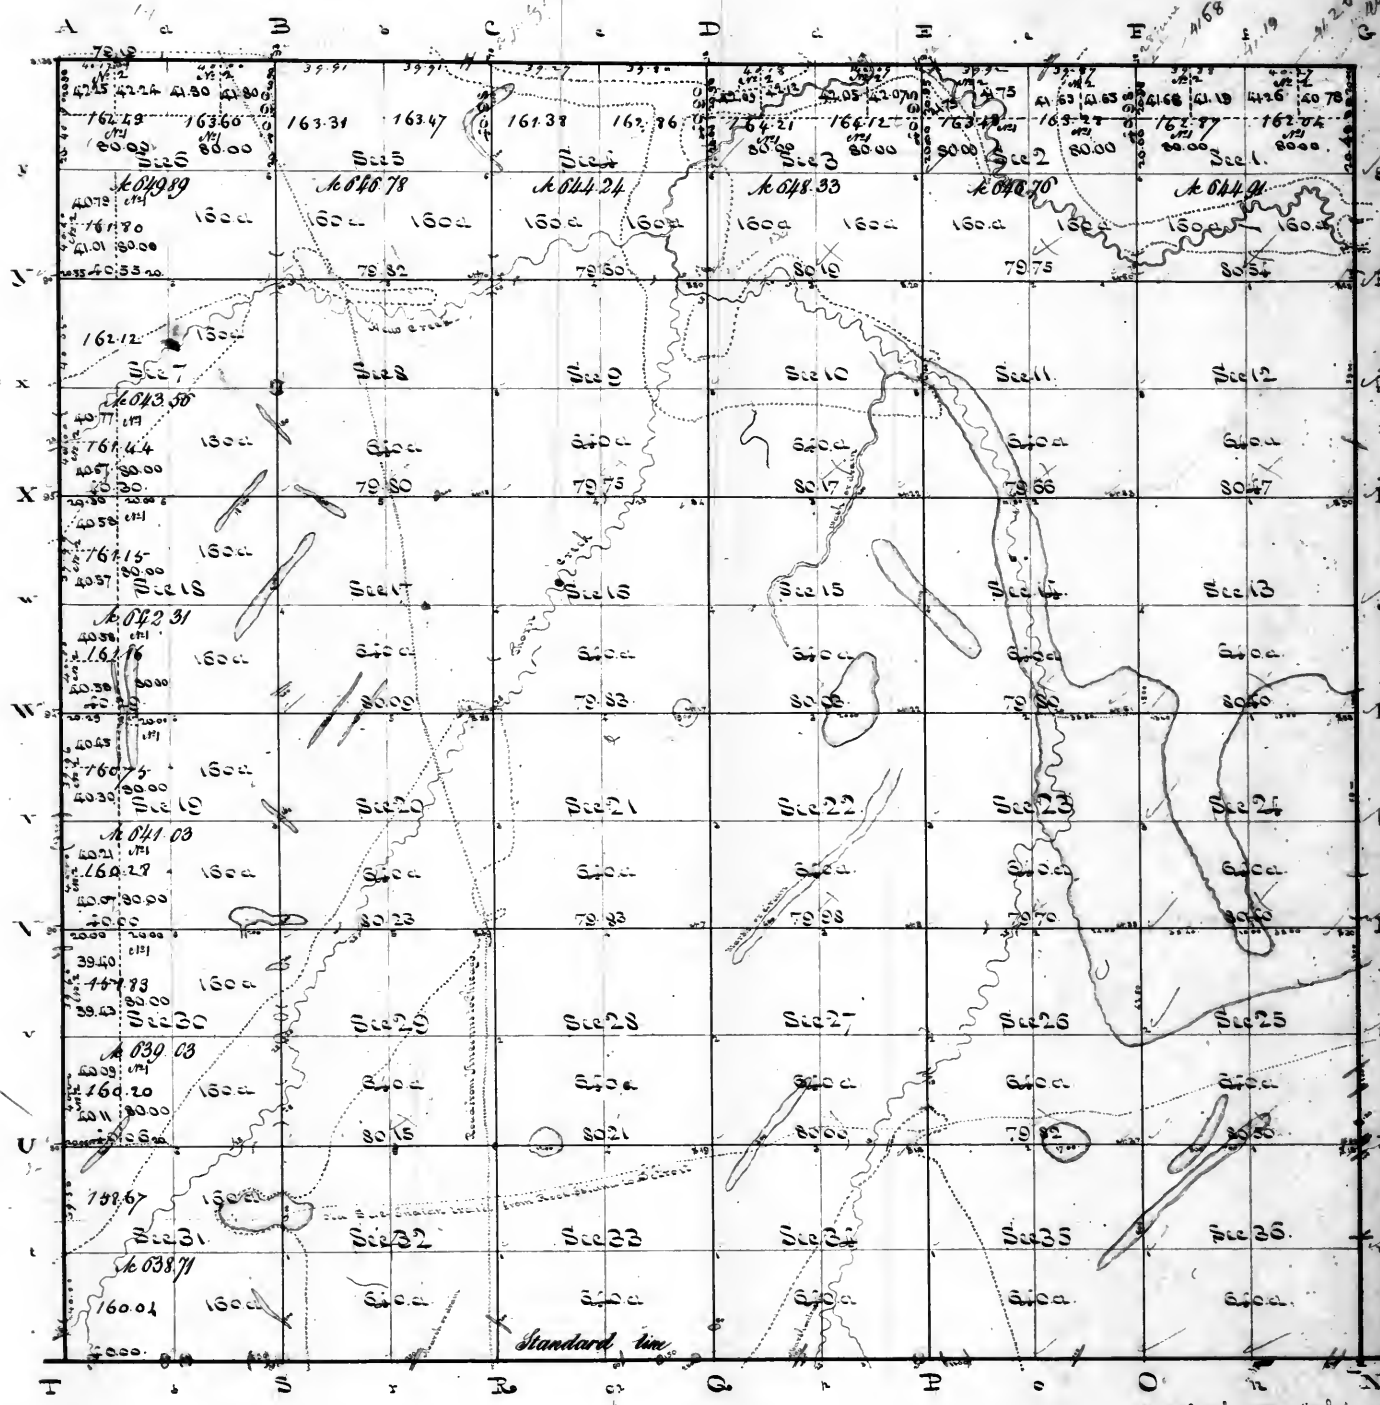

Aggregate area 2385.55 acres.


Surveyor General's Office.
Saint Louis 19th August 1833.

The above plat of township 35 north of the base line, range 14 east of the 3rd principal meridian, is strictly conformable to the field notes of the survey thereof on file in this office, which have been examined and approved. The section lines, were surveyed in the 2nd quarter of 1834 and the subdivision lines in the 2nd and 3rd quarters of that year, - all by John A. Clark, under contract of the 22nd of September 1833.

William H. Miller
Surveyor General

Township 36 North of the base line, Range 14 East of the 3rd principal meridian

Color 20

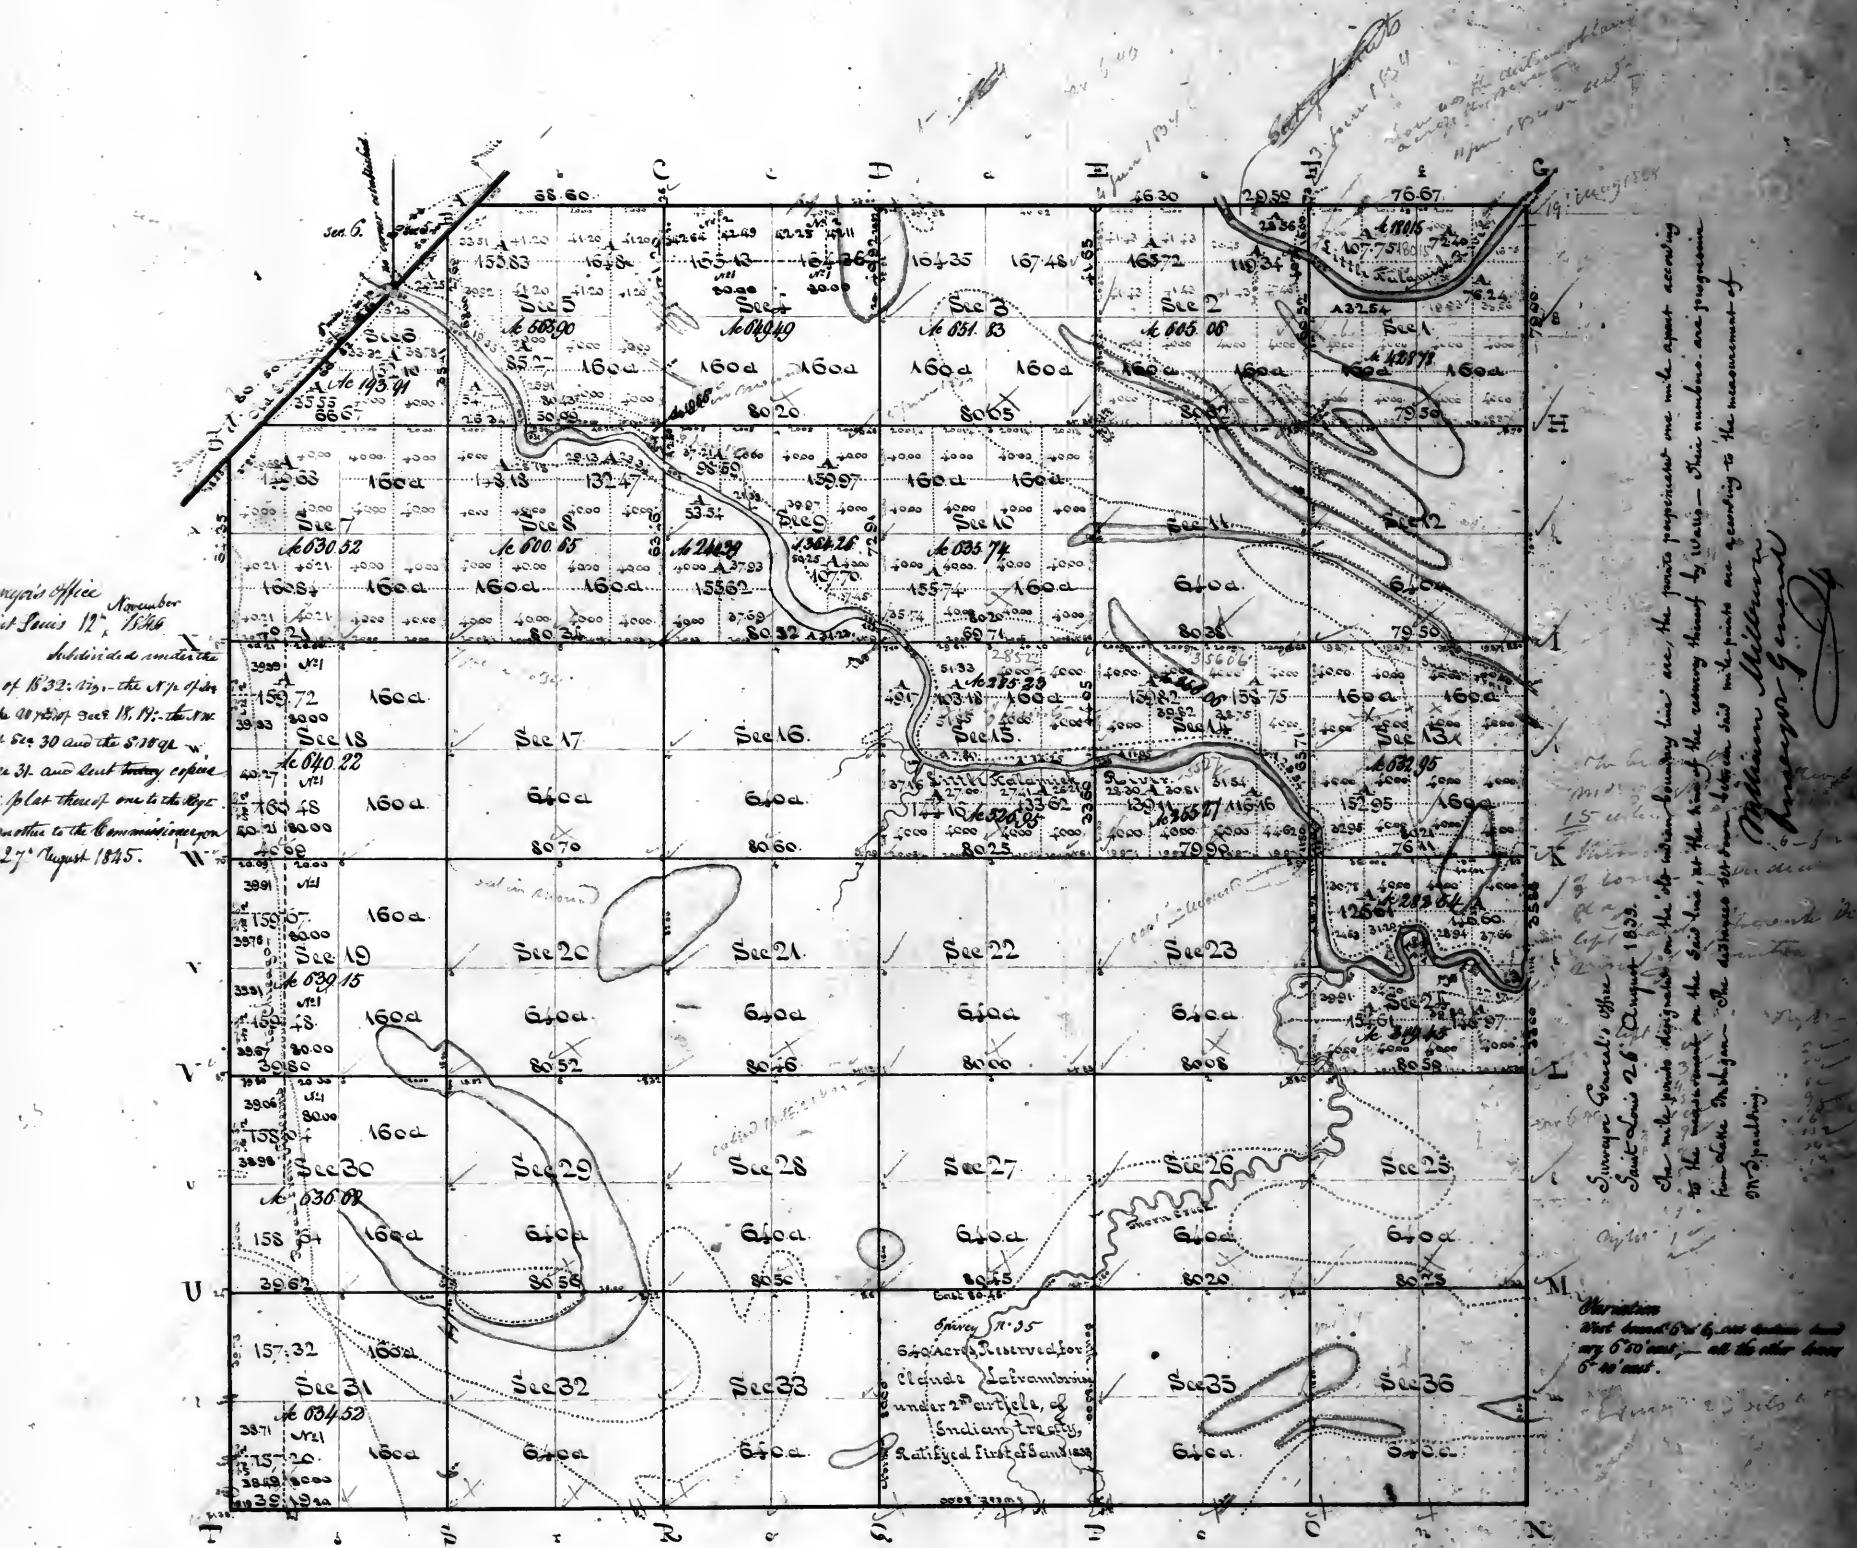

Surveyor General's Office.
Saint Louis 19th August 1838


The above plat of fractional township 36 north of the base line, range 14 east of the 3rd principal meridian, south east of the old Indian boundary line, is strictly conformable to the field notes of said fractional township on file in this office which have been examined and approved. The line designated 'old Indian boundary line' was retraced and the corners or mile-points thereon were renewed; by J. B. Spaulding, in the 2nd quarter of 1838, under contract of the 3rd day of October 1833. The said 'old Indian boundary line' was originally surveyed in the 1st quarter of 1810, by James M. Duncan, assistant to John C. Sullivan, under a letter of appointment from William Reeder, Surveyor of the lands of the United States in Missouri. By Missouri, 18th October the 17th 1817, authorizing Sullivan as surveyor and Duncan as assistant, to survey under the direction of Commissioner Graham and Phelps, appointed by the President of the United States to run the line of the tract ceded by the treaty of Saint Louis of the 24th of August 1816 (page 177 and following - Land laws, edition of 1828). This being the line agreed to be run from a point on Lake Michigan 10 miles southward of the mouth of the Chicago creek, in a direct line to a point on the Kankakee 10 miles above its mouth, and was found by said Sullivan and Duncan to run S. 45° 2' 10" W. 4 miles and 18 chains. In the 3rd quarter of 1821, John Wells, assistant to Stephen Reeder and Thomas C. Reeder, in the execution of their contract of the 20th of March 1821, being unable to find and properly identify this line and the mile-points thereon, further southward from the latter than the 1st mile-point, commenced thereat, and retraced S. 45° 2' 10" W. and struck the bank of the Kankakee 180 links south of the old line, but about 5 chains further southward. It was this retraced line to which the surveys to the N. W. were done, and which was retraced and renewed by Spaulding; and is laid down on this map, in accordance with his field notes. The north, the east, the south of the west boundary line - the subdivision line and measures of both, banks of Little Kankakee River, and the Indian Reservation, were all surveyed in the 2nd quarter of 1834, by John B. Clark, under contract of the 22nd of September 1833.

William Millman
Surveyor General

Surveyor General's Office
Saint Louis 26th August 1838.
The mile-points designated on the old Indian boundary line are, the points proposed one mile apart according to the measurement on the line at the time of the survey thereof by Wells. Their numbers are given in the margin of the plat. The distances between said mile-points are according to the measurement of Spaulding.

Not drawn by any section and any 5' 30" and all the other lines 6' 40" and.

Aggregate area of Public land 21765.28
Indian reservation 610.00
Total 22405.28 acres

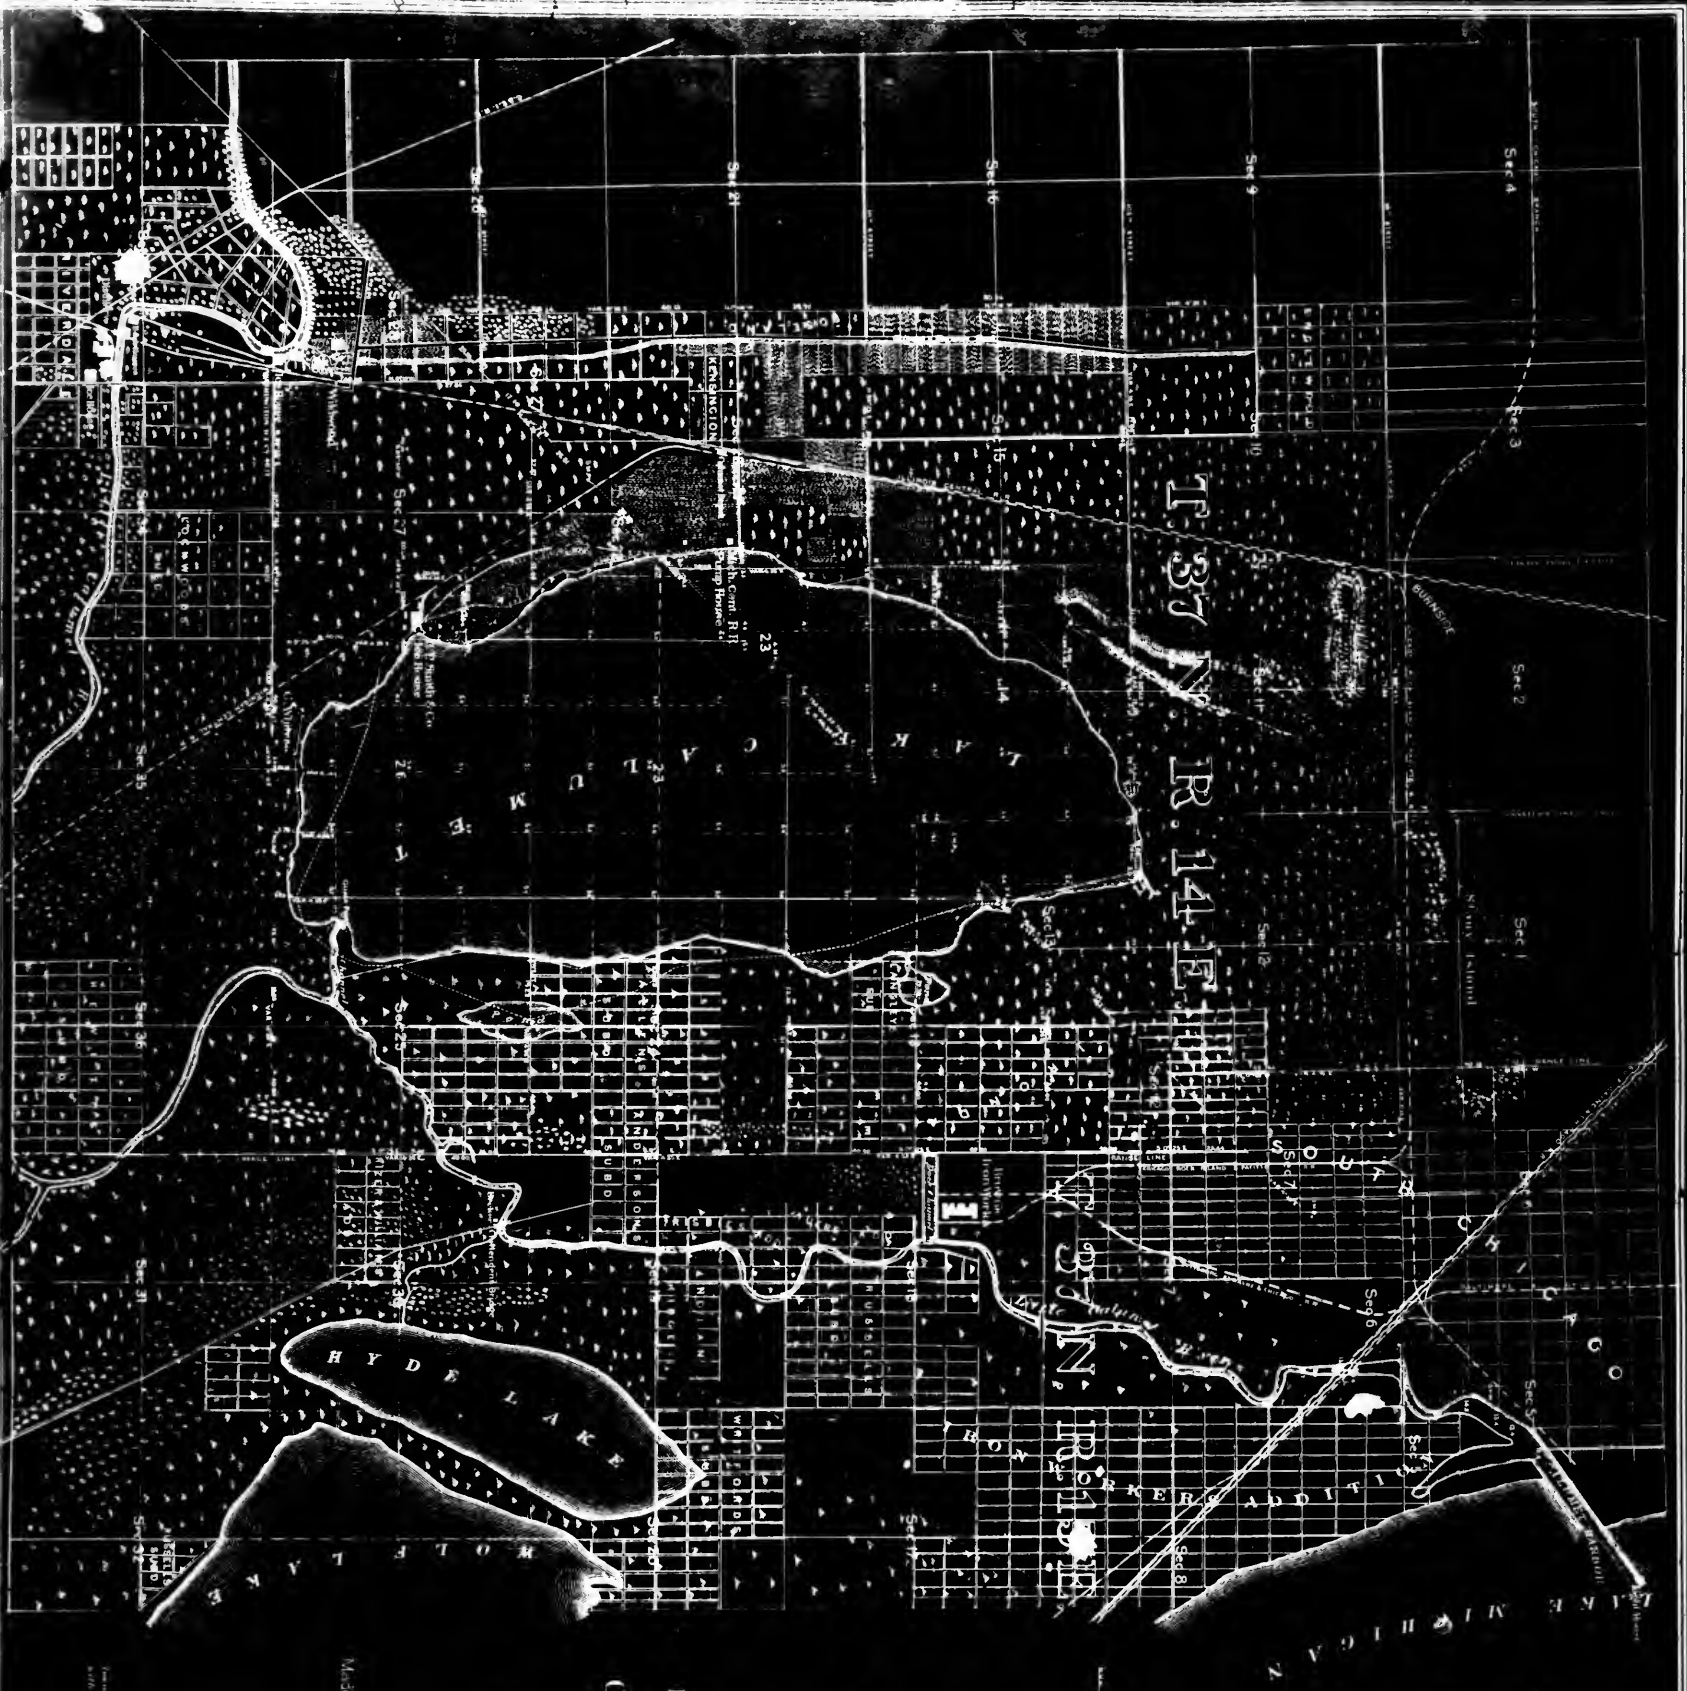

SCALE OF MILES 20+10+5

NOTE

The general outline of the lake is taken from the U.S. Geological Survey. The position of the lake is shown by the dotted line. 

DEPARTMENT OF THE INTERIOR.
GENERAL LAND OFFICE.

MAP

ILLUSTRATING THE RETRACEMENT
OF THE
ORIGINAL PUBLIC LAND SURVEYS

TOWNSHIP 37 NORTH, RANGE XIV EAST.

THIRD T37N R14E

1873

Special Examination made to determine the character of the Area

LAKE CALUMET.

LAKE MICIGAN.

and its relation to LITTLE CALUMET and

LAKE MICIGAN.

Made by order of the Hon. Commissioner of the General Land Office
under instructions dated April 25th 1872.

Survey commenced May 26 1873.

Completed Aug 2 1873.

J. B. BAILEY.

Special Examiner G.L.O.

General Land Office

Washington, D.C. 1873

J. B. Bailey



22



| | |
|---------------------|---------------|
| Shawson in feathers | 12.14.23 |
| from A | |
| 1155.6 | 1.00 ds |
| 1124 | 14.77.6 cover |
| 1131.6 | 17.71 |
| 1157.6 | 35.00 |
| 1155.6 | 44.00 to h |
| from B | |
| 5126 | 42.75 to d |
| <u>Total</u> | <u>201.86</u> |

| | |
|---|------------|
| Lines run by the Lewis and Clark attractions of the 1 st November 1850 | |
| Sp 37 To 14. North of Indian line | 1. 00 37 |
| The line between Indians 10 4 11 | |
| do 16 4 15 | 1. 00 30 |
| do 18 4 23 & back of lake | 2. 57 |
| do 22 4 23 & point W | 20. 00 |
| do 11 4 14 | 1. 00. 30. |
| do 12 4 13 & Indian line | 64. 53 |
| Meander on Sept. 13. 14 4 23 | 2. 00. 95 |
| Sp 37 R 14. South of Indian line | |
| Line between Indians 12 4 13 | 64. 50 |
| Connection with Green and Comar to Indians 12 | |
| 4 13 on Indian line | 19. 95 |
| Total | 7. 11. 58 |




Yours respectfully,
J. H. ...


Surveyors Office
St. Louis July 1874

The above Plat of fractional Townships 36 & 37 North of the base line, Range 14 East of the 3^d principal meridian, North West of the Old Indian boundary line, except fractional sections 13, 14 & 23 Township 37 North, is conformable to the field notes of the survey thereof on file in this Office.

E. J. Sanborn

to the field notes of the Survey thereof on file in
E. T. Langham

Plat of Township N° 38 North of the Base line. Range N° 14 East of the 3^d Principal Meridian.

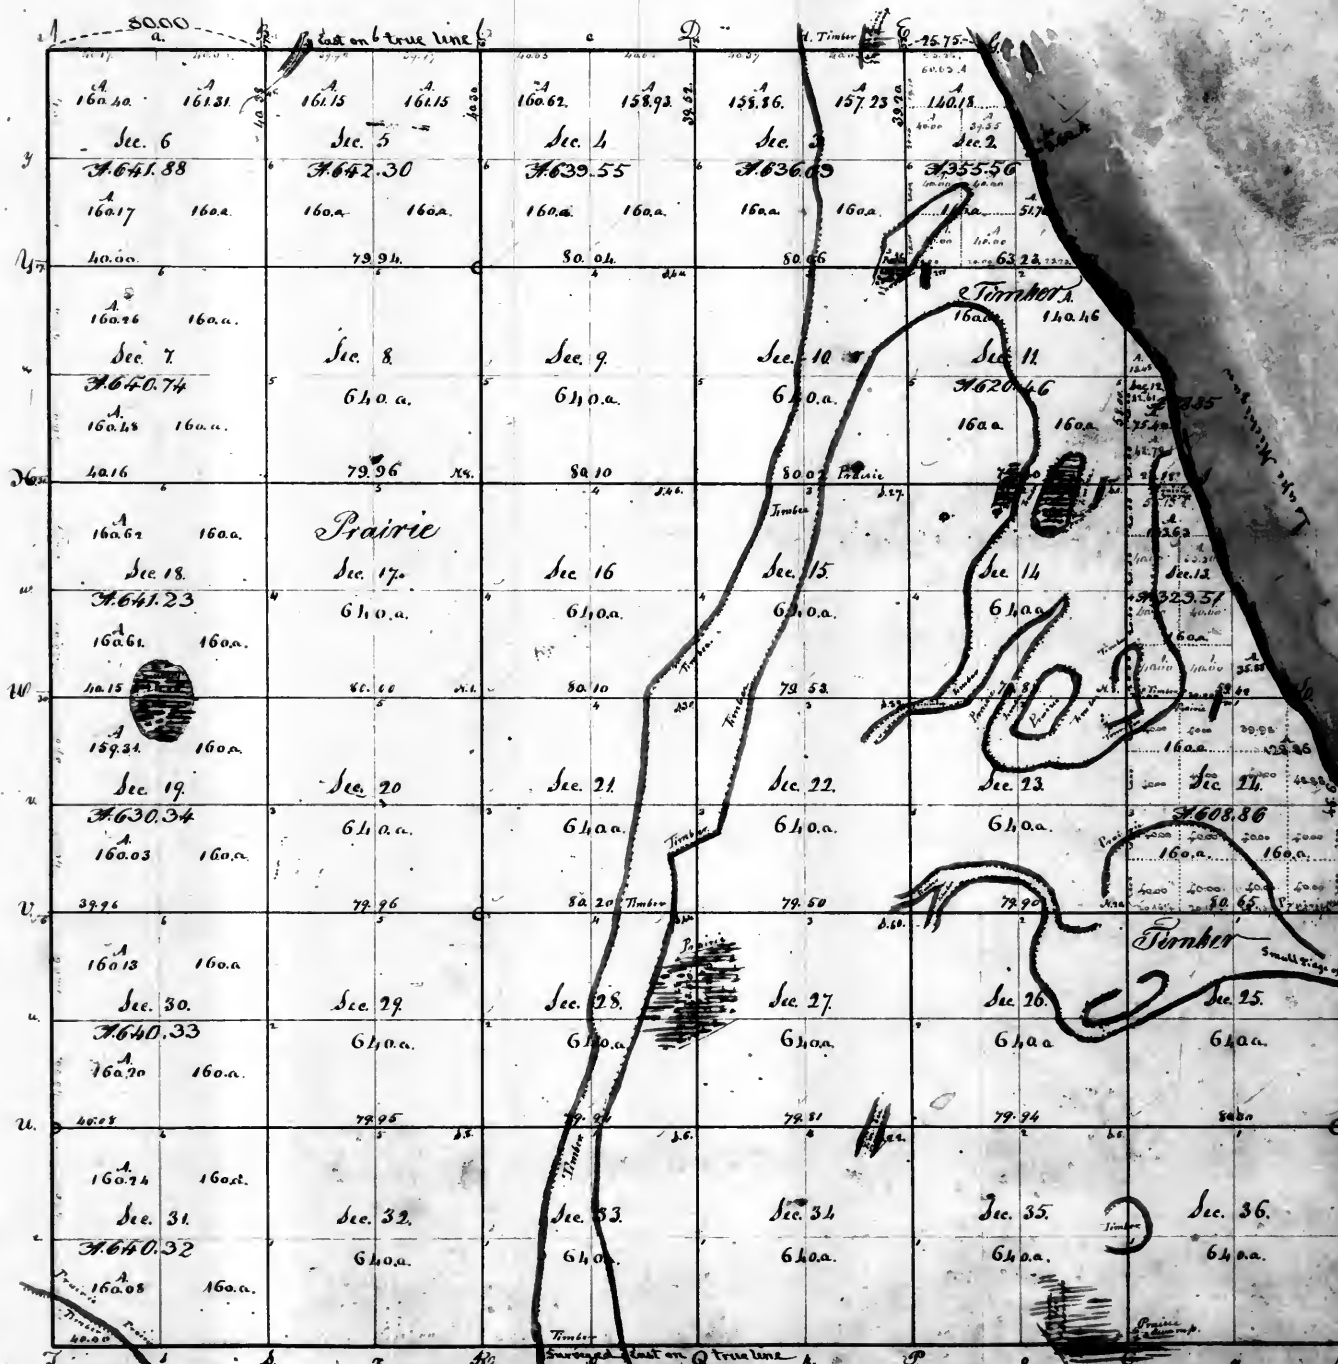

Statement of the means of
Michigan in 3 33 00. 30 10 00
Beginning at the corner of
15 4 2 3 33 00 30 10 00
00 25 00 15.00
00 20 00 18.50
00 20 00 21.50 to corner of
12 4 13 - 30 00 -
00 16 00 15.00
00 16 00 27.50
00 20 00 21.50 to corner of
11 4 12 - 30 00 -
00 27 00 27.50 to corner of
00 11 - 30 00 -
00 28 00 17.00
00 20 00 18.50
00 26 00 17.50
00 28 00 3.04 3.00 3.00

Surveyor's Office
St. Louis 10 Sept 1854
Plat of Sec. 2, 12, 25 and
26 to the corner of the 3^d line

Surveyor's Office
St. Louis July 1854.

The above Plat of fractional Township 38 North of the base line, Range 14 East of the 3^d Principal Meridian, is conformable to the field notes of the survey thereof on file in this Office

E. J. Symptom

Fractional Townships 40 North of the base line, Range 14 East of the 3rd principal Meridian and that part of fractional Township 41 North, Range 14 East which lies South East of the Old Indian boundary line.

24

Township 41 North

Township 40 North



Surveyor's Office
St. Louis, Mo. Sept. 1832.
Plat of fractional Secs 23, 30, 31, 40, 52
in T. 41 N. R. 14 E., sent this
day to the Commr of the Genl
Land Office.

Areas of the several sections of
T. 40 N. R. 14 E. of the 3rd principal Meridian

| | |
|---------------|--------|
| Sec 5 | 516.17 |
| Sec 6 | 640.73 |
| Sec 7 | 640.00 |
| Sec 8 | 584.47 |
| Sec 16 | 42.35 |
| Sec 17 | 639.75 |
| Sec 18 | 640.00 |
| Sec 19 | 640.00 |
| Sec 20 | 640.00 |
| Sec 21 | 224.16 |
| Sec 28 | 391.10 |
| Sec 29 | 640.00 |
| Sec 30 | 640.00 |
| Sec 31 | 640.00 |
| Sec 32 | 640.00 |
| Sec 33 | 585.40 |
| Sec 34 | 4.00 |
| Total 8742.00 | |

Areas of the several sections of
T. 41 N. R. 14 E. of the 3rd principal Meridian

| | |
|---------------|--------|
| Sec 29 | 129.92 |
| Sec 30 | 73.60 |
| Sec 31 | 611.35 |
| Sec 32 | 419.45 |
| Total 1233.72 | |

Surveyor's Office
St. Louis, Mo. Sept. 1832.
Plat of fractional Secs 5, 16, 17, 21, 28, 30, 35 in T. 40 N. R. 14 E.
sent this day to the Commr of the General Land Office.

Surveyor's Office
St. Louis, July 27, 1834.

The above Plat of fractional Township 40 North of the base line, Range 14 East of the 3rd principal Meridian, and that part of fractional Township 41 North, Range 14 East which lies South East of the Old Indian boundary, is conformable to the field notes of the survey thereof on file in this Office.


correctly copied from the

E. J. Coningham

Fractional Township 4 North Range 14 East of the 3d principal Meridian

25

J. N. R. S. E. 1840

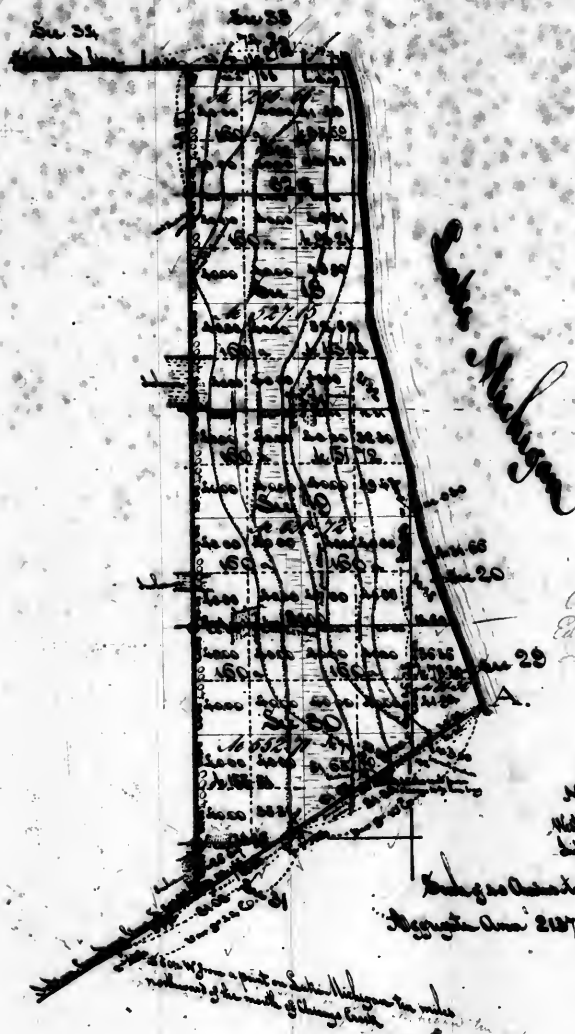

Surveyors Office

St. Louis 24th June 1840

The mile points designated on the 'Old Indian boundary line' are the points measured one mile apart, according to the measurement on the said line at the time of the survey thereof by Messrs. Sullivan and Duncan - their numbers are progressive from the point A on this plan on the margin of Lake Michigan - The distances between said mile points are according to the measurement of Mr. Breese.

William H. Sullivan
Surveyor of the public lands
in Illinois and Missouri

[Signature]

Distance
North boundary 5 1/2 miles
West boundary 5 1/2 miles
East boundary 5 1/2 miles

Surveyed June 24 1840

Surveyors Office

St. Louis 24th June 1840

The above plat of fractional township 4 North range 14 East of the 3^d principal meridian, north west of the old Indian boundary line, and on the western side of Lake Michigan, is strictly conformable to the field notes of the survey of said fractional township on file in this office, which have been examined and approved - The South eastern boundary of this fractional township which is designated 'Old Indian boundary line' was surveyed in the 4th quarter of 1818, by John C. Sullivan, as principal surveyor, and James M. Duncan, as assistant surveyor, under the authority of a letter from William H. Sullivan, Surveyor of the public lands in the territories (now states) of Illinois and Missouri, dated the 18th of October 1818, authorizing said Sullivan and Duncan to survey under the direction of Commissioners Graham and Phelps, appointed by the President of the United States, to run the lines of the tracts ceded by the treaty of Saint Louis of the 24th of August 1816 - C. page 177 and following, land laws, section of 1823 - This being the line agreed to be run from a point ten miles north of the west end of the portage between Chicago Creek, which empties into Lake Michigan, and the River Des Plaines, a fork of the Illinois, in a direct line to a point on Lake Michigan ten miles northward of the mouth of Chicago Creek - and was found by said Sullivan and Duncan to run from the above designated point on Lake Michigan (A on this plat) S. 60 1/2 W. 8 miles and 75 chains to the said point 10 miles north of the west end of the portage - The said 'Old Indian boundary line' was retraced, and the fractional section corners for the surveys on the S. E. side thereof, and the mile points thereon, were renewed in the 3^d quarter of 1837, by E. J. Trickett, under contract signed by the Surveyor General on the 8th of May, and by Mr. Trickett on the 2^d of June 1837 - This running was paid for in the 4th quarter of 1838, and charged in the account current of the Surveyor General for that quarter, Voucher D. 5 - The north boundary of this fractional township 57.91 chains, was surveyed in the 3^d quarter of 1837, by James Thompson, under contract signed by the Surveyor General on the 21st of November, and by Mr. Thompson on the 15th of December 1836 - it was paid for in the 1st quarter of 1839, and charged in the account current of the Surveyor General for said quarter, Voucher D. 6 - The west boundary 3 miles 65.42 chains - the subdivision lines 3 miles 33.65 chains, and the meanders of the western margin of Lake Michigan 3 miles 4.59 chains, were surveyed in the 4th quarter of 1839, all by George W. Harrison, under contract of the 21st of September of the same year - They were paid for in this 2^d quarter of 1840, and they will be charged in the account current of the Surveyor General, during said quarter, under the general appropriation for surveying the public lands, Voucher D. 12.


William H. Sullivan
Surveyor of the public lands in
the States of Illinois and Missouri

[Signature]

Fractional Township 31 North, Range 15 East, 3rd Principal Meridian

26

62
99

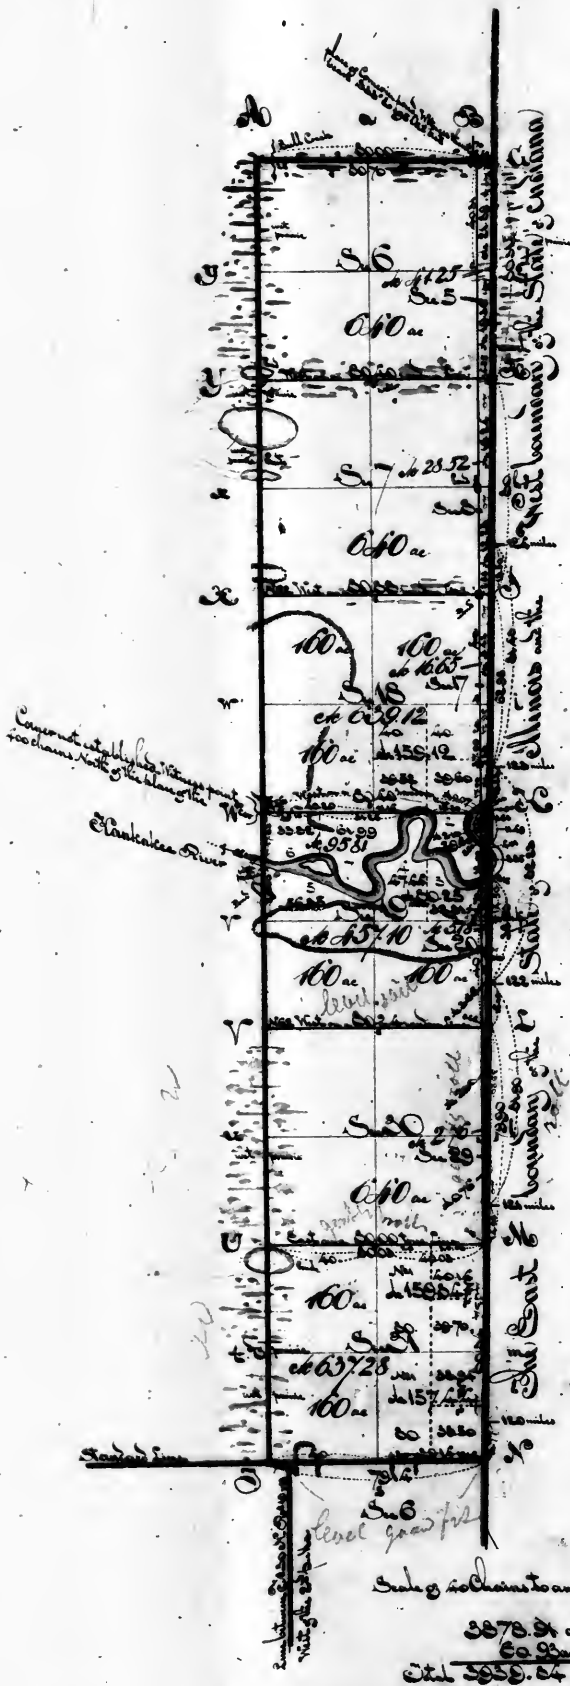

A - West boundary of fractional township along Section 10 & 15 was surveyed by [illegible] in 1836 or 1837. From the corner to Section 26 & 27 on the East boundary of Township 31 North to the corner to the South boundary of the river, together they place of the corner to Section 10 & 15 from the river. It is along the East boundary of Section 10, 400 chains to the North bank of the river - in 1838 [illegible] established a corner to Section 24 by [illegible] on the North bank of the river 207 ch. 10 in. & the corner on the South bank of the river.

The mile-points designated on the State line are the points perpetuated one mile apart according to the measurement on the said line at the time of the survey thereof. These numbers are progressive from the intersection with the Wabash river.

B - Connections and remeasurements on the State line, by Houlanicki, referred to in the Statement to this plat.

| | |
|--|---------------|
| From S. corner of township to 121 st mile post | m. ch. in. |
| From corner to sections 20 & 29 to 122 nd mile post | 16.00 |
| From corner to sections 17 & 20 to 123 rd mile post | 17.00 |
| From corner to sections 8 & 17 to N.E. corner of township | 2.00, 31 |
| Total | 347.65 |

Particular
North & South boundaries & Subdivision Lines T 15 East
West boundary to East
State line 800 East.

Surveyor's Office.


Saint Louis 2nd of June 1843.

The above plat of fractional township 31 north of the base line, range 15 east of the 3rd principal meridian, west of the line between the States of Indiana and Illinois, is strictly conformable to the field notes of the survey thereof on file in this office which have been examined and approved. The said State line was surveyed or rather a line which had been formerly run, was retraced, marked and measured in the 1st or 2nd quarter of 1824, by Silas Hickey, under the provisions of the act of Congress of the 2nd of March 1820 to authorize the President of the United States to cause the public surveys to be connected with the line of demarcation between the States of Indiana and Illinois, as certified to this office on the 10th of June 1834 by Mr. J. Williams, Surveyor General of Ohio, Indiana and Michigan. In the 1st quarter of 1843, Silas Houlanicki, under his contract of the 9th of November 1842, made the connections and measurements along said line, details in the Statement B, above - 2 miles 47.65 chains, which were paid for in his 2nd quarter of 1843; and will be charged in the Surveyor General's account for said quarter Voucher N^o 1 - The west boundary 6 miles was surveyed in May 1844, by W. Beckwith, under contract of the 29th of October 1843 - See note A above for some operations in this line by Houlanicki, in January 1843 - The South boundary 79.14 chains - the north boundary 1 mile 6.42 chains - the subdivision lines 10 miles 11.73 chains, and the measure of both banks of the River & the river 4 miles 21.69 chains, were surveyed in January 1843, by Silas Houlanicki, under his contract of the 9th of November 1842. They were paid for in his 1st quarter of 1843; and they will be charged in the account current of the Surveyor General during said quarter Voucher N^o 1.

Silas Houlanicki
Surveyor of the public land in
the State of Illinois & Wisconsin

Fractional Township 32 North Range 15 East, 3d Principal Meridian

27

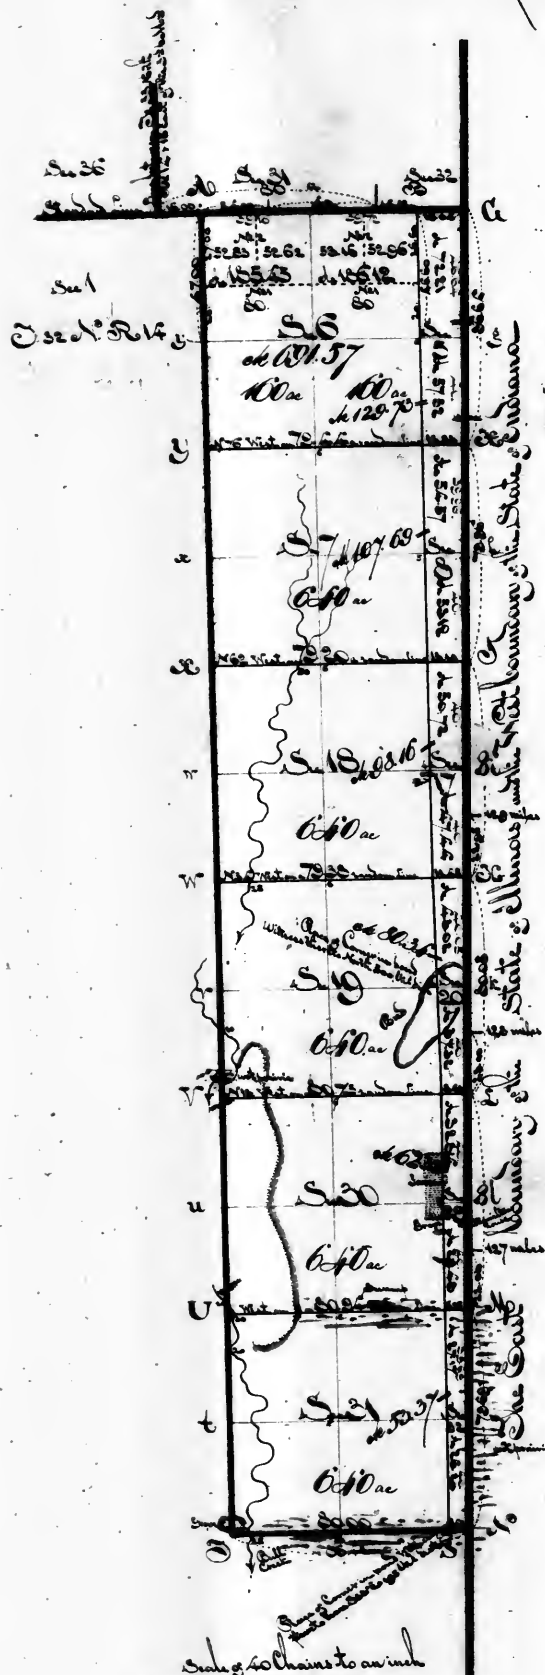

The South boundary of Sec. 32 T. 32 N. R. 15 E. 3d P.M. was stated by the act of the Original Survey by S. A. Spaulding to be 15 chains. The distances at points along said line on this plat are conformable to the measurement of said line by S. A. Spaulding.

A. M. Kulamicki having been instructed to verify the closing of the west boundary of this township on the Howard line, as run by Spaulding, resurveyed the East boundary of sec. 1 T. 32 N. R. 14 E. north of the quarter section corner, and found it 146.25 ch. - he also ascertained the distance from the corner to sec. 1 T. 32 N. R. 14 E. and sec. 6 T. 32 N. R. 15 West to the corner of T. 32 N. R. 15 E. to be 15.95 chains - together 62.77 chains, which were paid for to said Kulamicki, and will be charged to the United States, as his other surveying in this township.

Silas Reed

The mile-points designated on the State line are the points designated one mile apart, according to the measurement on the said line, at the time of the survey thereof - Their numbers are progressive from the intersection with the Wabash river.

Variation

North boundary - 6.45 East.
State boundary - 6.46 East.
West boundary - 7 East.
South boundary & subdivision lines - 7.15 East.


Surveyor's Office.
Saint Louis 2^d of June 1843.

The above plat of fractional township 32 north of the base line, range 15 east of the 3^d principal meridian, west of the line between the States of Indiana & Illinois is strictly conformable to the plat notes of the survey thereof on file in this office which have been examined and approved - The said State line was surveyed, or rather a line which had been formerly run, was retraced, marked and measured in the 3^d quarters of 1834, by Silas Reed, under the provisions of the act of Congress of the 2^d of March 1833 - & authorized the President of the United States to cause the public surveys to be connected with the line of demarcation between the States of Indiana and Illinois as certified to this Office by Mr. J. Williams, Surveyor General of Ohio, Indiana & Michigan - In January 1843, Silas Kulamicki, under his contract of the 9th of November 1842, resurveyed this line 6 miles 6.34 chains, which was erroneously set down in Kulamicki's account 6 miles 6.29 chains, and paid for on the 5th of May 1843; which account will be voucher No. 1 of the account current of the Surveyor General for this 3^d quarter of 1843 - The west boundary 6 miles and 7 chains was surveyed in May 1834, by B. W. Desha, under his contract of the 29th of October 1833 (see note A above) - The north boundary 1 mile 15.26 chains was surveyed by B. A. Spaulding in August 1834 under his contract of the 3rd of October 1833 - It was resurveyed by Kulamicki in the 1st quarter of 1843, under his contract of the 9th of November 1842 - 1 mile 14.86 chains, which was paid for in the 2^d quarter of 1843; and will be charged on the account of the Surveyor General during the said quarter voucher No. 1 - The South boundary 1 mile 6.42 chains, and the subdivision lines 11 miles 60.25 chains, were surveyed by the said Kulamicki in the 1st quarter of 1843, under his contract of the 9th of November 1842. These surveys were paid for to Kulamicki, and they will be charged to the United States as aforesaid.

Silas Reed
Surveyor of the public lands in
the States of Indiana & Illinois

Fractional Township 33 North of the base line Range 15 East of 3rd principal Meridian

28

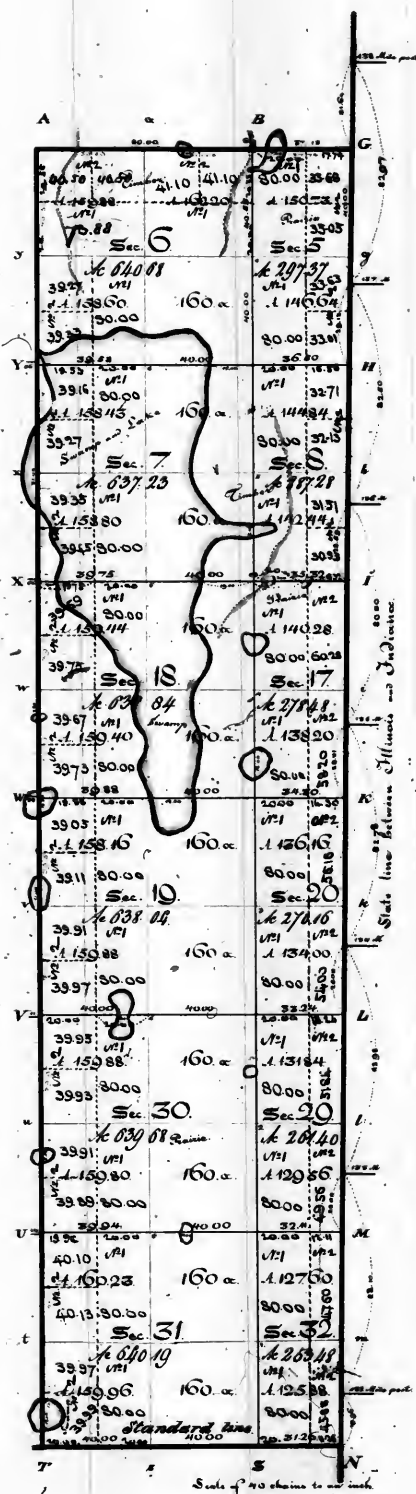

Aggregate Area 5482.83 acres

Surveyor's Office

St. Louis 12th Nov. 1845.

Subdivided under the act of 1833, 14, the same fractional in Sec 5, 8, 17, 20, 29 & 32 - the 10th & 15th W. of Sec 6, the Wth of Sec 7, 12, 14, 30 & 31 and sent many copies of the plat thereof on to the Register and another to the same, on the 27th of August 1845.

Reference to the field notes and on the continuation of this plat of the State line between Missouri & Indiana along the East boundary of this fractional Township by Sylvester Sibley in March, April 1834 of the North West & South boundaries of Sub-Division lines by Don Alango Spaulding under the contract of the 3rd of October 1833 and changed for in his account of the 29th of January 1835. The notes of the South boundary are dated 15th of August, 1834. North boundary are dated 26th of August, 1834. West boundary are dated 4th of June 1834. Subdivision lines are dated 19th & 20th of August 1834.

The State line shows Missouri & Indiana was surveyed at a Variation of 0th 20' East. The North West & South boundaries of the Subdivisions lines were surveyed at a Variation of 0th 45' East.

Surveyor General's Office.

St. Louis 26th August 1839.

The mile points designated on the State line are, the points re-petitioned one with a part according to the measurement on the said line, at the time of the survey thereof. Their numbers are progressive from the intersection with the Wabash river. The distances set down between said mile points are according to the measurement of Wm. S. Day.

William M. McQuinn
Surveyor General


Surveyor's Office

St. Louis 17th August 1839.

The said plat of fractional Township 33 North of the base line Range 15 East of 3rd principal Meridian is exactly faithful to the field notes of the survey thereof in file in the Office which have been examined and approved. The east boundary line, that is the line between the States of Indiana and Illinois was surveyed, in 1834, a rather a line which had been formerly run, was "surveyed, marked and measured" in the 3rd & 2nd quarter of 1834, by Sylvester Sibley, under the provisions of the act of Congress of the 2nd of March 1833 to authorize the President of the United States to cause the public surveys to be connected with the line of demarcation between the States of Indiana and Illinois as subject to this Office on the 10th of June 1834. by Mr. J. Williams, Surveyor General of Ohio, Indiana and Michigan. The West boundary was surveyed in the 2nd quarter of 1834. The South boundary - the North boundary and the Subdivision lines, were surveyed in the 3rd quarter of 1834 - all by D. A. Spaulding, under his contract of the 3rd of October 1833.

William M. McQuinn
Surveyor General

Fractional Township 34 North of the base line Range 15 East of 3rd principal Meridian

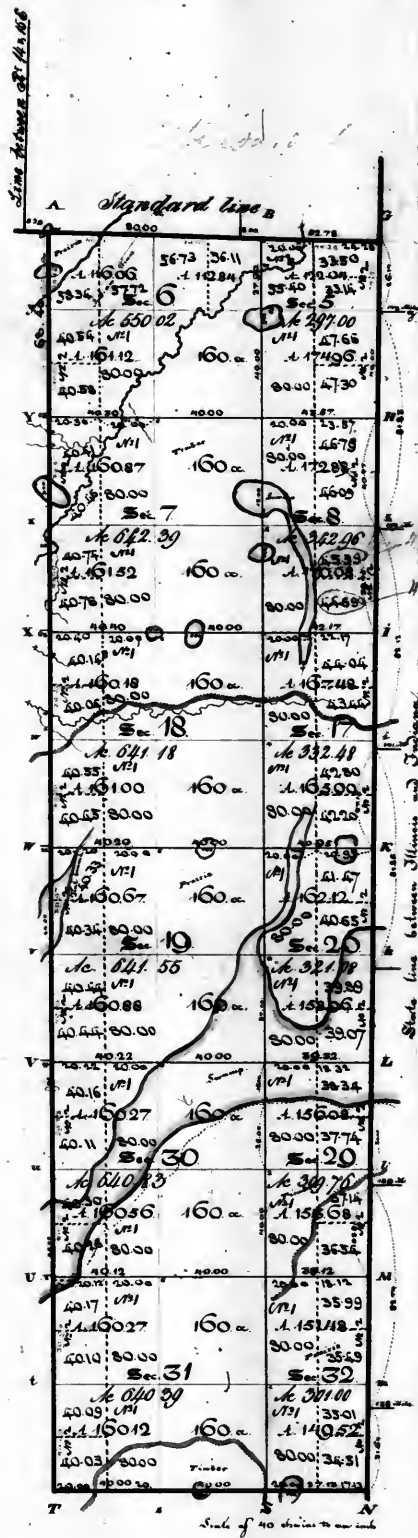

29

Surveyor's Office

St. Louis 12th Nov. 1844

Subdivision made on the 20th of 1832, 14th section fractional at Sec 5, 8, 17, 20, 29 & 32; the N^W 1/4 Sec 24, 25, 26, 27, 28, 29, 30 & 31; the N^W 1/4 of Sec 32, 33, 34, 35, 36 & 37. And that being a part of the first township, one to the State, and another to the 16 commissioners, on the 27th of August 1845.

Reference is made to the field notes used in the construction of this Map of the State line between Illinois & Indiana being the East boundary of the fractional Township by Sylvester Sibley in March & April 1834 of the North boundary by John Clark dated 16th of May 1834 of the South & West boundaries & East division line by David Allen Spanning under his contract of the 2nd of October 1833 and changed for in his account of the 25th of January 1835. The West of the South boundary on dated 26th of August 1834. West boundary on dated 5th & 6th of June 1834. Subdivision lines are dated from the 27th to the 29th of August 1834.

The East boundary was surveyed at a Variation of 6° 30' East. The North boundary was surveyed at a Variation of 5° 40' East. The South & West boundaries of the Subdivision lines were surveyed at a Variation of 6° 45' East.

Surveyor General's Office

St. Louis 26th August 1839.

The mile points designated on the State line are, the points perpetuated one mile apart according to the measurement on the said line, at the time of the survey thereof. Their numbers are progressive from the intersection with the Wabash river. The distances set down between said mile points are according to the measurements of Mr. Sibley.

William Miller
Surveyor General
24

Aggregate Area... 5660 64. and

Surveyor's Office
St. Louis 17th August 1855


The above Acts of fractional Township 34 North of the base line Range 15 East of 3rd principal Meridian is referable to the field notes of the survey thereof in the Office which have been examined and approved. The east boundary line which is the line between the States of Indiana and Illinois, was surveyed, or rather, a line which had been formerly run was retraced, marked and measured in the 1st or 2nd quarter of 1834, by Sylvester Sibley under the provisions of the act of Congress of the 2nd of March 1833. To authorize the President of the United States to cause the public surveys to be connected with the line of demarcation between the States of Indiana and Illinois as certified to this office on the 10th day of June 1834, by Mr. J. Williams, Surveyor General of Ohio, Indiana & Michigan. The North boundary was surveyed in the 2nd quarter of 1834, by John Clark, under contract of the 22nd of September 1833. The West boundary was surveyed in the 2nd quarter of 1834, and the South boundary of the subdivision line in the 3rd quarter of 1834, all by D. Sibley Spanning, under contract of the 2nd of October 1833.

William Miller
Surveyor General
24

Color

Township 35 North of the base line, Range 15 East of the 3rd Principal Meridian.

30

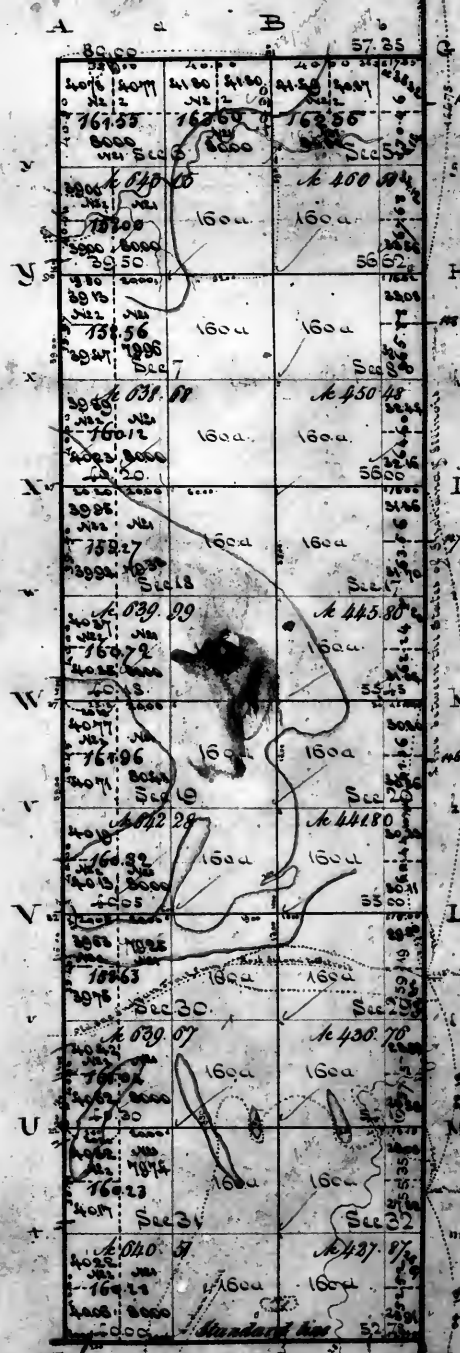

Surveyor General's Office
St. Louis 26 August 1839.
The rule points designated on the State line are the points perpetuated one mile apart according to the measurement on the said line at the time of the Survey thereof - Their numbers are progressive from the intersection with the Wabash river - The distances set down between said mile points are according to the measurement of 1760 Sibley and where the distances between the mile points are not designated on this map, the said points were not found by 1760 Sibley, in said measurement.

William H. Williams
Surveyor General's Office
St. Louis 19 August 1839.

This plat of fractional township 35 north of the base line, range 15 East of the 3rd Principal Meridian, was of the line dividing the States of Indiana & Illinois is strictly conformable to the field notes of the survey of said fractional township on file in this office, which have been examined and approved - The east boundary line, which is the line between the States of Indiana and Illinois was surveyed, or rather a line, which had been formerly run was retraced, marked and measured in the 1st & 2nd quarter of 1824, by Sylvester Sibley, under the provisions of the act of Congress of the 2nd of March 1822. To authorize the President of the United States to cause the public survey to be connected with the line of demarcation between the States of Indiana and Illinois as certified to this office on the 10th of June 1824, by M. J. Williams, Surveyor General of Ohio, Indiana & Michigan - The North, the west, and the South boundary lines were surveyed in the 2nd quarter of 1824, and the sectional lines in the 3rd quarter of the same year, all by John A. Clark, under contract of the 22nd of September 1823.


William H. Williams
Surveyor General's Office
St. Louis 19 August 1839.

Scale of 20 chains to an inch
Total area 6507.49 acres
Variation in line between the States of Indiana and Illinois 6" to west, - on all the rest or line 6" to east.

Color

Township 36 North of the base line, Range 15 East of the 3rd principal meridian

31

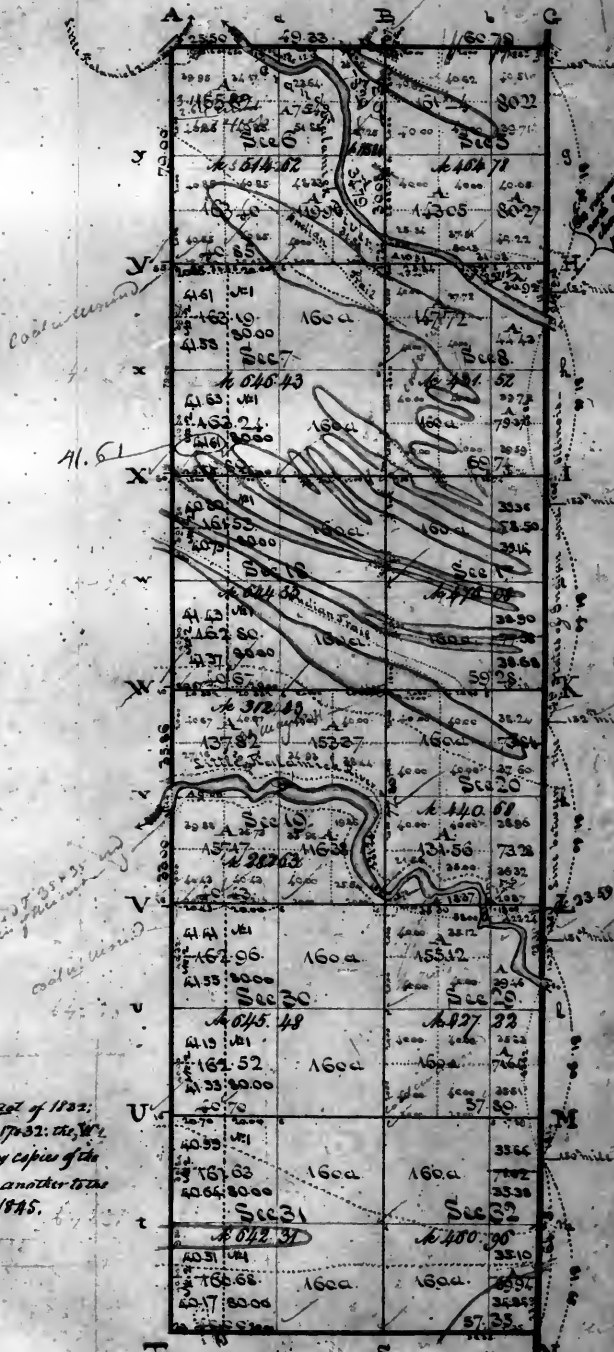

Course 21.63
Water 25.20
Error 3.57
Drs not close

Surveyor's Office
Saint Louis 12th November

Subdivided under the act of 1832:
viz. the 8th of fractional sections 17, 22, 23, 24,1000.

Aggregate area - 6598.90 acres
Variation in line between the states of
Indiana & Illinois 5' 0" east, - in all the
other lines 5' 10" east.

Surveyor General's office.
Saint Louis 19th August 1839.
This plat of fractional township 36 north of the
base line, range 15 east of the 3rd principal meridian,
West of the line of demarcation between the States
of Indiana & Illinois, is made conformable to the
field notes of the survey of this fractional township
on file in this office which have been examined
and approved. The east boundary line which is the
line between the States of Indiana and Illinois, was
surveyed, or rather a line which had been formerly
run was retraced, marked and measured in the 1st
or 2nd quarter of 1834, by Sylvester Sibley, under
the provisions of the act of Congress of the 2nd of March
1833 to authorize the President of the United States
to cause the public surveys to be continued with the
line of demarcation between the States of Indiana
and Illinois, as certified to this office on the 10th of
June 1834, by M. J. Williams, Surveyor General
of Ohio, Indiana & Michigan. The north, the
west, and the south boundaries - the published one
and measure of the Grand Kalamazoo and the
Little Kalamazoo Rivers, were all surveyed
in the 2nd quarter of 1834, by John A. Davis
under his contract of the 22nd of September 1833.

William H. Harrison
Surveyor General

Surveyor General's office.
Saint Louis 26th August 1839.
The mile points designated on the state line
the points perpendicular one mile apart according
measurement on the state line, as the basis of
thereof - their numbers are progressive from
intersection with the United river - The distance
set down between said mile points are
the measurement of M. Sibley.

William H. Harrison
Surveyor General

Township 37 North of the base line, Range 13 East of the 3rd principal meridian

32

Surveyor's Office
 Saint Louis 15th March 1855.

Subscribed under the act of 1803,
 upon the fractional part of Section 17 and some
 other copies of the plat thereof one to the Register
 and another to the Commissioner, on the
 27th of August 1845.

Surveyor General's Office
 Saint Louis 26th August 1855.

The mile points designated on the State line are
 the points perpetuated on the map according to
 the measurement on the said line, at the time of the
 survey thereof - their numbers are progressive from
 the intersection with the Wabash river - The distances
 set down between said mile points are according
 to the measurement of Mr. S. Silby - and where
 the distances between the mile points are not
 designated on this map the said points were not
 found by Mr. Silby.

William Williams
 Surveyor General

Note
 of Survey of August 1855

On retracing the State line from
 the station in the field notes of the 185th mile at the
 corner of Section 17 and 18, and the corner to the 18th
 mile point at 31.05 chains, which gave for the length
 of the east boundary of section 30 of this township
 exclusive of the falling of the north boundary of
 section 30, of 3.44 chains north of the 18th mile point only
 16.74 chains. - According to the measurement of the line
 along the southern boundary of section 30, measured
 by John A. Clark, the east boundary thereof is 16.74
 chains. - Mr. Silby did not establish a corner at
 the above station for continuation of the line to
 State line - therefore the length of the said east
 boundary of section 30 is not chain according to the
 calculation of Mr. Clark - measurement of the line was
 by 53.9 chains - and the calculation of the corner
 the said section 30 was made accordingly.

William Williams
 Surveyor General



Surveyor General's Office
 Saint Louis August 1855.

This plat of fractional township 37 North of the base line
 of the 3rd principal meridian - South east of the
 South west of Lake Michigan, and west of the line of
 the States of Indiana and Illinois - is a copy of the
 of the Survey of said fractional township and the
 line examined and approved with the line designated by the
 originally surveyed in the Township of 1818 by Thomas
 A. C. Graham, who is later of appointment from 1818 to
 land of the United States in Illinois and Missouri and
 authorizing William Williams Surveyor General as assistant
 the Director of Commissioners Graham and Phelps
 Division of the United States to run the line of the
 The Survey of said township of the 27th of August 1855
 bearing - said line - which of 1818 - This being
 the line of the State of Illinois and the State of
 of the Chicago river in section 17 and 18 of section 30
 of the township - and with first by the
 5.45° 2' 10" - 33 miles and 48 chains - this
 line was retraced and the mile points thereon
 Mr. A. Spaulding in the 2nd quarter of 1848,
 2nd of October 1850 - It was then again
 which the survey is the 18th mile point was shown
 on this map, in accordance with the notes of the
 east boundary line which is the line between the
 and Illinois was surveyed or rather a line which
 formerly was, was retraced, measured and
 2nd quarter of 1854, by J. A. Clark, and
 the act of Congress of the 2nd of March 1855
 "Division of the Survey of the State of Illinois"
 connected with the line of the State of
 Indiana and Illinois as a matter of
 June 1854, by Mr. W. Williams, Surveyor
 Indiana and Michigan - The west
 was surveyed in the 2nd quarter
 lines - and measured of 16.74 chains
 as "roughly" better, was shown on
 and 1st quarter of 1856 - as by
 corner of the 22nd of September 1848

William Williams
 Surveyor General

Scale of 1 inch = 40 chains -
 aggregate area 352.03 acres
 Direction to the boundary line is shown on the map
 - as the line between the States of Indiana and Illinois
 6° 14' east - as all the other lines 6° 14' east -

Surveyor General's Office, Saint Louis 26th August 1855.

Mr. Spaulding did not find any of the old mile points on the Indian boundary - E. End of the T^h mile - The therefore established new mile points
 line surveyed by Division, as indicated in position by the above fractional section corner of the old survey to be
 1845 - According to Spaulding's position the line between boundary between the line and the T^h mile
 found by this survey is that 78.15 chains from the lake at the mouth of the Little Kalamazoo

William Williams

Fractional Townships N. 38. North of the base line Range N. 15 East of the 3^d principal Meridian
and that part of fractional Township 37 North, same Range, which lies North West of the Old Indian boundary.
which lies N.W. of the old Indian boundary

33

Surveyor's Office
St. Louis 25th April 1850.
A Copy of pp. 587 and of the S. 6. of
of Ser. 6 in T. 37. N. 15. E. of 3^d pl. Mer.
(North of the Indian boundary line) was sent
this day to the Register, and another copy
to the Commr. on the same day



Statement of the meander of the West Bank of
Lake Michigan in Fractional Township 38 North
N. 15. E. of the 3^d pl. Meridian
Commencing at the mouth of the Little Calumet at the
Indian boundary line, thence along fractional Section
5. ... N. 6. W. 46. 63 ch. to the
corner of fractional Section 6 735.50 ch. 37. 8. 31

Thence along fractional Section 6 422.35 ch. to the
N. 4. W. 25. 50 ch. to
N. 5. W. 16. 10
N. 17. W. 32. 01
N. 38. W. 2. 51
N. 41. W. 7. 11 to the corner of
fractional Section 29 438.1
Thence along fractional Section 29
N. 48. W. 13. 50 ch. to
N. 46. 31 W. 1. 64 to corner of
fractional Section 29 438.1
Thence along fractional Section 29
N. 34. W. 8. 31 ch. to
N. 36. W. 51. 11
N. 41. W. 30. 75 to the corner of
fractional Section 19 438.1
Thence along fractional Section 19
N. 56. W. 13. 50 ch. to
N. 38. W. 32. 51
N. 29. W. 9. 01
N. 27. W. 9. 17 to the corner of
fractional Section 19 on the base line - 438.1


Surveyor's Office
St. Louis July 3, 1854

The above Plat of Township 38 North of the base line, Range 15 East of the 3^d principal
meridian, and that part of fractional Township 37 North, same Range, which lies North West of the Old Indian boundary is conformable
to the field notes of the survey thereof on file in this Office.

E. J. Vanhook

at 12. 2nd at a Var. of 7 1/2. 2nd at a Var. of 5 to 6 subdivision. Var. uncertain in the copy of the field notes.

36

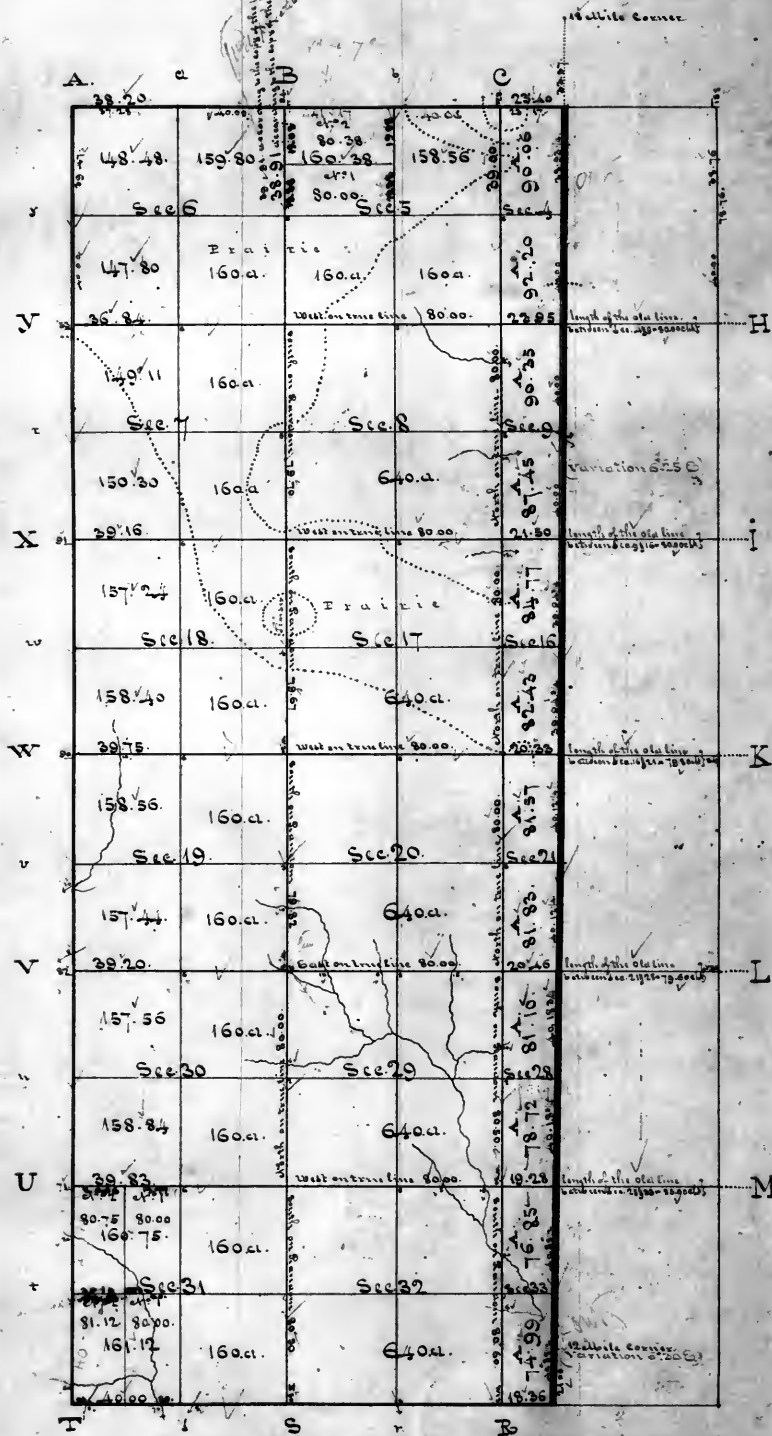

| | Roak | 36 | 1/2 10 W | 7 |
| Sections 16 15 12 13 | Elm | 20 | 5 22 W | 48 |
| | 5 Oak | 10 | West | 100 |
| Sections 2 15 28 5 12 13 | Elm | 28 | 5 32 W | 21 |
| | Virginia | 10 | 1/2 28 W | 47 |
| Sections 28 15 23 5 12 13 | Hickory | 20 | 5 28 W | 47 |
| | Hickory | 12 | 1/2 30 W | 44 |
| Sections 15 15 15 15 12 13 | Elm | 12 | 5 10 W | 21 |
| | Horribian | 3 | 1/2 15 W | 23 |

Notes: The distance set down in red ink as between the quarter section and section corners on the State Survey, are not measured but estimated distances.

Surveyors Office


U. S. 19th January 1829³ The above plat of that part of Twp. N. 10. E. R. 10. 11. of Ill. which lies within the State of Illinois: is corroborated (as seen in both copies of the plat of said Township, and in the several copies of false maps & having been furnished to the Office: of the Surveyor of the Boundary line between the States of Indiana and Illinois: & used of them in the line between the States of Indiana and Illinois: & the lines of the Section Survey of the U. S. plat. is not inconsistent with it. — Wm. C. Rice Secy. of Dist. Ct. 2
— Wm. Bluff & J. J. Clark 3

That part of Township 14 North of the base line. Range 10 West of the 2^d principal meridian, lying West of the line between the States of Indiana & Illinois.

61° 23' 00" of T. 14 N. 10 W. at Van Cleave estimated at 10000. Subdivision in copy of the same Van Cleave

2

37

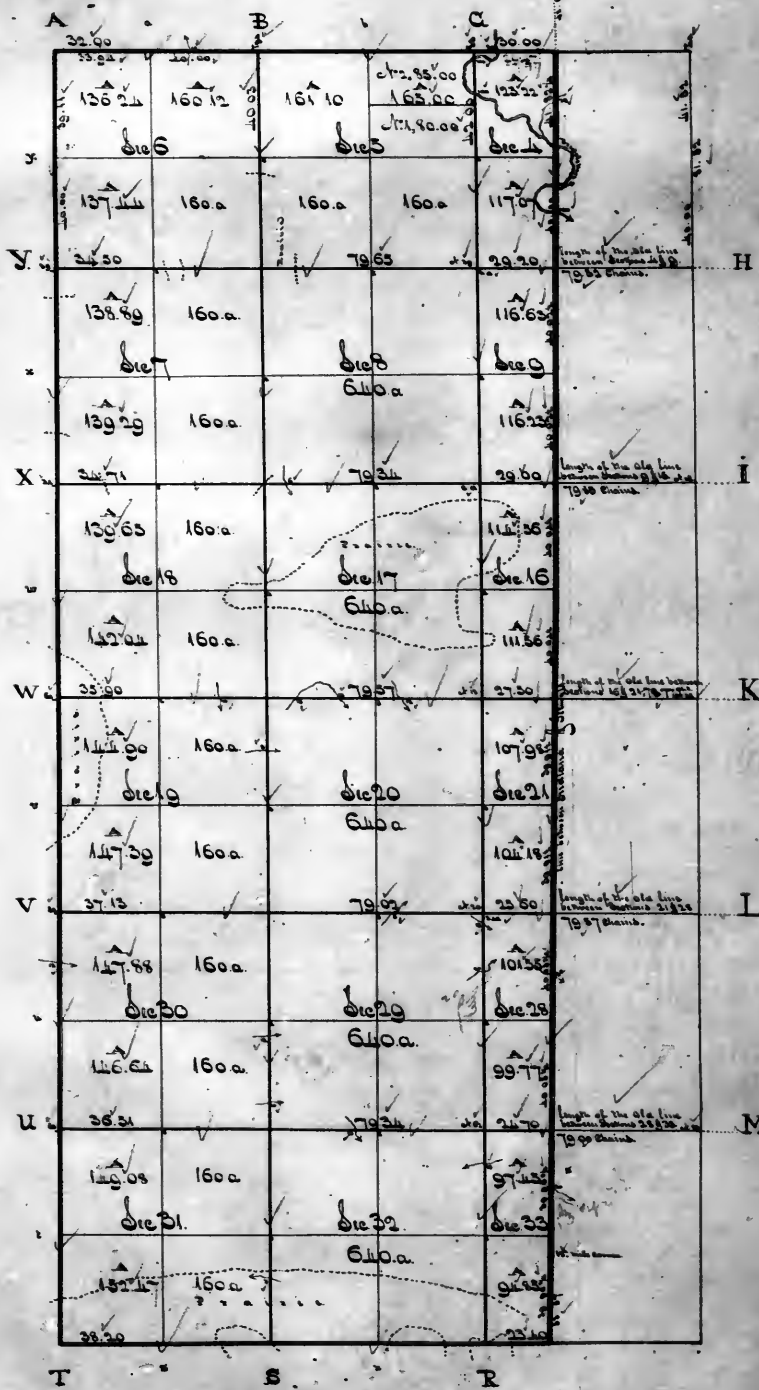

A Description of corners established on the Eastern boundary line of the State of Illinois, in S. 14 N. 30 10 W. of the 2^d principal meridian.


| Section | Corner | Distance | Direction | Remarks |
|-----------|-----------|-----------|-----------|-----------|

Wm. C. Rice, Surveyor

Surveyors Office
St. Louis, Mo. January 1893
The above plat of the part of township 14 N. 10 W. of the 2^d principal meridian, which lies within the State of Illinois, is conformable to the copy of the plat of the same as far as may be, the copies of the plat of the survey have been furnished to the Office, of the Township, of the Boundary line between the States of Indiana and Illinois, and the connections made between the lines of the plat and the lines of the survey, and that the survey is correct.
Wm. C. Rice, Surveyor
St. Louis, Mo. Jan. 1893.

5. 2nd Jib at 210W 2° at Var 6.25 Correction at Var 6 - 6.25 3rd Jib at 211W 5.25 3rd Jib at 210W at a Var. of 7 - Subdivision at a Var.

38

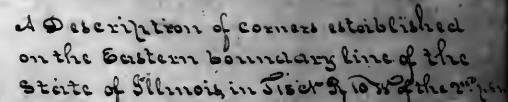


Note: The distances set down in red figures between the quarter section and section corners on the State Boundary, are not measured, but estimated distances.

Cornphor
17m

See also Office —
St. Louis 20 January 1829³ The above plat of the party of J. N. 15. N. R. 10. W. of the 2^d
P. 4th. which lies within the State of Illinois; is conformable (as per survey)
to the copy of the plat of said Township, and to the copies of the public records of
survey thereof (in having relation thereto) which have been furnished to this
Office. — W. M. Rice Sur. of Pub. Lands
— Ill. Map: + Tr. of Ark: —


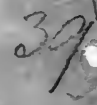


The distances set down in red figures between the quarter and section corners on the State Boundary, are not measured but the distances.

Compans
11, 12, 13

Aggregate area in T. 16. N. 10. W. 2 = 8167.23 ac.
T. 17. N. 10. W. = 286.7 ac.

Total = 8535.02 acres

[illegible]

40

[illegible]

Plat number of Aug. 338.10

| Total number of Acres | | | | | |
|---|------------------------------|-----------------------------|---|---|--|
| Survey Designated. | By Whom Surveyed. | Date of Contract. | Amount of Survey.
M. Ch. ² Lk. ² | When Surveyed. | When Charged in
the Sur. ^{ts} Gen ^l 's acc ^t |
| N. Township line,
cloving on State line
Subdivisions. | J. R. McGall
Perlin Kent. | Jan'y 15 th 1834 | | 2 ^d 9 th 1824
1 st 9 th 1834 | |

The above Map of Township N^o 16 North of Range E^o 10 West of the
Principal Meridian, Missouri is strictly conformable to the field notes
of the survey thereof on file in this Office, which have been examined and approved.
Surveyor General's Office,
Cincinnati, Sept. 7, 1863. *William Johnston* Sur. Gen.

41




Total number of Acres 1544.92

| Total number of Acres | | | | | |
|---|----------------------------|-----------------------------|---|--|--|
| Survey Originated. | By Whom Surveyed. | Date of Contract. | Amount of Survey.
M. Ch. ^s Lk. ^s | When Surveyed. | When Charged in
the Sur. ^r Gen. ^l acc. ^t |
| Township lines,
claim on State line
Subdivisions, | J. R. McCall
Perin Kirk | Jan'y 15 th 1834 | | 2 ⁹ / ₁₆ 1821
1 ⁹ / ₁₆ 1834 | |

The above Map of Township 15 N. of Range 15 W. of the Principal Meridian, in Missouri, is found conformable to the field notes of the survey thereof on file in this Office, which have been examined and approved.

Surveyor General's Office,
Cincinnati, Sept. 7, 1843. } William Johnston, Secy. Genl.

42

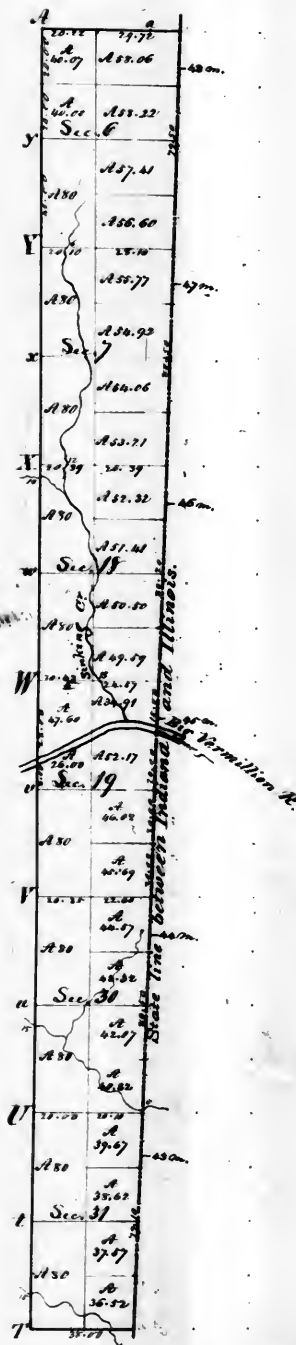

Total number of Acres 2108.45

[illegible]


The above Map of Township N. 10. North of Range N. 10. W. of the 2.
Principal Meridian in Illinois is truly conformable to the field notes
of the survey thereof on file in this Office which have been examined and approved
Surveyor General's Office.
Cincinnati, Sept. 9. 1865 } William Johnston, Sur. Genl.

Township N.^o 19 N. Range N.^o 10 W. 2nd Mer. (Ill.)



43

Total number of Acres 2599.24

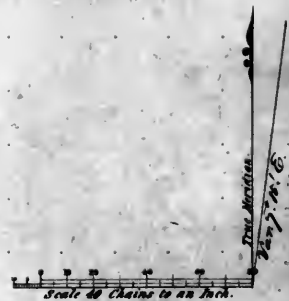


| Total number of Acres | | | | | |
|--|-------------------|-------------------|----------------------------------|-------------------------|---|
| Survey Designated. | By Whom Surveyed. | Date of Contract. | Amount of Survey.
Ac. Co. Lk. | When Surveyed. | When Charged in
the Sur. Genl. acc't |
| Township lines. | J. B. McCall | Jan. 18. 1834 | | 2 nd 9. 1834 | |
| Changes in State from
Subdivisions. | James Kent | | | 1 st 4. 1834 | |
| | | | | | |
| | | | | | |
| | | | | | |

The above Map of Township N. 19 North of Range N. 10 West of the 2nd Principal Meridian (Illinois) is strictly conformable to the field notes of the survey thereof on file in this Office, which have been examined and approved.

Surveyor General's Office.
Cincinnati, Sept. 11. 1843

William Johnston, Sur. Genl.

44

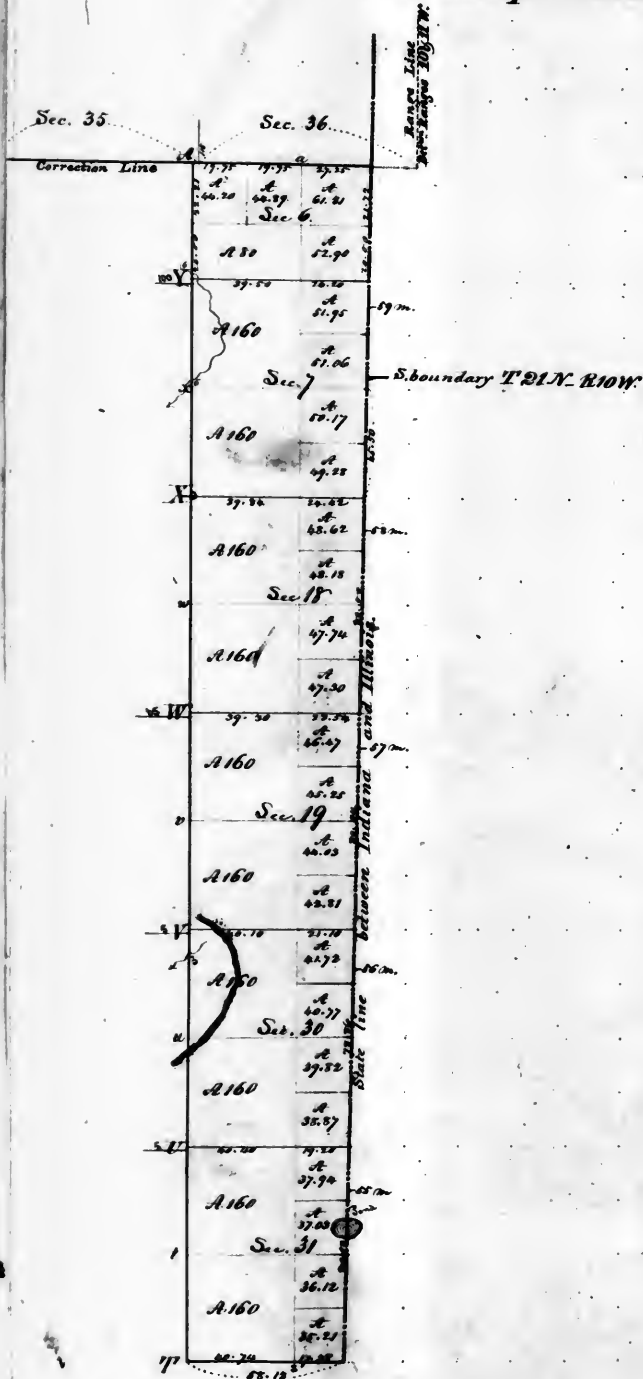

Total Number of Acers 2763.64

[illegible]

The above Map of Township A. 20 North of Range 2 West of the 2^d Principal Meridian (Illinois) is truly conformable to the field notes of the survey thereof on file in this Office, which have been examined and approved by the

Surveyor General's Office,
Cincinnati, Sept. 11th 1843. William Johnston, Sur. Genl.

45

Scrub.

| | |
|--------|-----|
| 157.32 | NW. |
| 162.89 | NE. |
| 168.81 | SE |
| 160 | |
| <hr/> | |
| 641.02 | |

154.69 MS
 148.63 SS
 320
 623 52

661. 02 Sep 12
 623. 32 Dec 13
 598. 68. Feb. 24
 574. 25 Apr 25
 549. 22 36
 525. 18
 20

$$\begin{array}{r} 130.2145 \\ 124.0758 \\ \hline 574.28 \end{array}$$

320.00
130.25
124.07


574.28

$$\begin{array}{r} 320.00 \\ 117.43 \\ 111.79 \\ \hline 549.22 \end{array}$$

Sec. 13. 142.52 NE.
136.36 SE.
320.00
598.88

3511.90

Total number of Rong 3,512.45

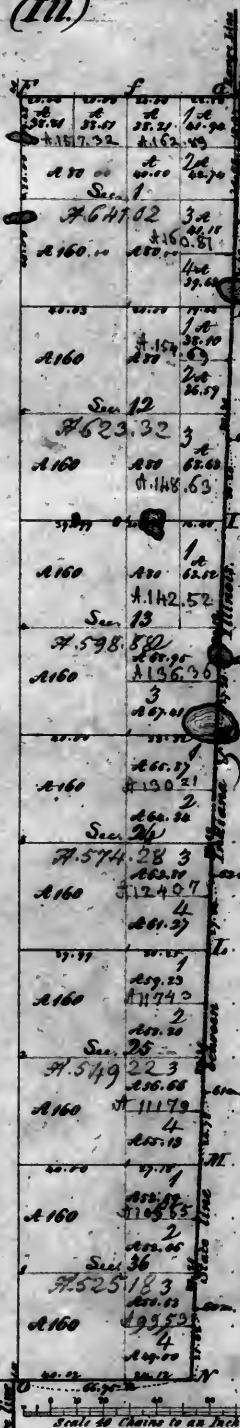
[illegible][illegible]

The above Map of Township 11.20 North of Range 1.10 East of the 2^d Principal Meridian (Illinois) is strictly conformable to the field notes of the survey thereof on file in this Office, which have been examined and approved.

Surveyor General's Office,
Cincinnati, Sept. 12, 1843

William Johnston, Sur. Genl

46

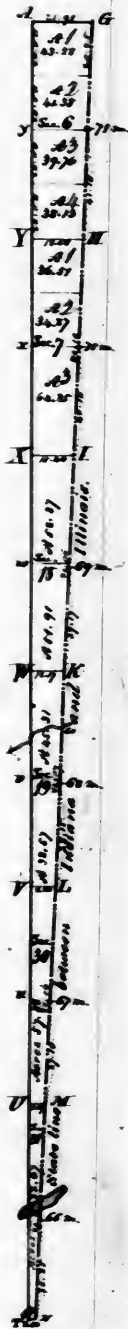

Steel number of Aero 583.50.


[illegible]

The above Map of Township A. 33 North of Range 1. 20 West of the 3rd Principal Meridian (Illinois) is truly conformable to the field notes of the survey thereof on file in this Office, which have been examined, and approved by the Surveyor General's Office.

Cincinnati, Sept. 15. 1843. William Johnston, Sur. Genl.

Township N^o 23 N. Range N^o 10 W. 3rd Mer. (II.)

47

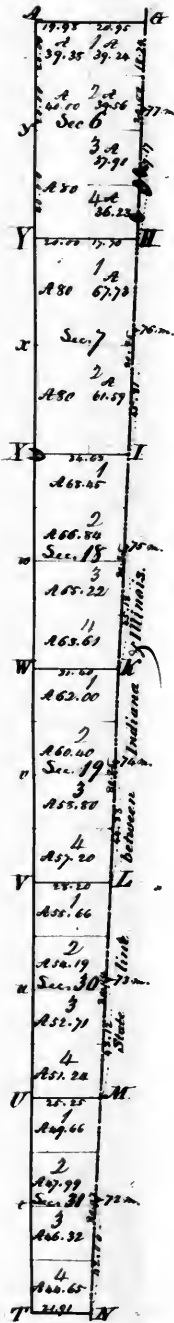

Total number of Acres 1,506.57

Scale 20 Chains to an Inch

| Total number of Acres | | | | | |
|---|-------------------|----------------------------|---|-------------------------------------|--|
| Survey Designated. | By Whom Surveyed. | Date of Contract. | Amount of Survey M. CA ² Lk ² | When Surveyed. | When Checked in the Sur. Genl's Office |
| Township lines, changes in State line Subdivisions. | Rein Kent | Jan. 15 th 1843 | | 2 ^d 9 th 1844 | |
| | | | | | |
| | | | | | |
| | | | | | |
| | | | | | |

The above Map of Township N. 23 North of Range N. 10 West of the 2^d Principal Meridian (Illinois) is truly conformable to the field notes of the survey thereof on file in this Office, which have been examined and approved.

Surveyor General's Office,
Cincinnati, Sept. 13, 1843

William Johnston Sur. Genl.

Township N.º 24N. Range N.º 10W. 2nd Mer. (IV.)



48

Total number of Acry 2,429.36

| <i>Total number of Acres</i> | | | | | |
|---|-----------------------------|--------------------------|--|--------------------------|---|
| <i>Survey Designated.</i> | <i>To Whom Surrendered.</i> | <i>Date of Contract.</i> | <i>Amount of Surrender.
M. Ch^s L^s.</i> | <i>When Surrendered.</i> | <i>When Charged in
the Sur^r' Genl's acc't!</i> |
| Township lines,
<i>along pre-settled line</i>
Subdivisions, | Perrin Hunt | Jan'y 15. 1834 | () | 9 th of 1834 | 4 th of 1834 |
| | | | | | |
| | | | | | |
| | | | | | |
| | | | | | |
| | | | | | |

The above Map of Township N. 24 North of Range 8, W. 10 E. 2, Principal Meridian, (Illinois) is strictly conformable to the field notes of the survey thereof on file in this Office, which have been examined and approved.

Surveyor General's Office,
Cincinnati, Sept. 13, 1843

William Johnston Sur. Genl.

49

True Met.
Can not given
(State line 6: B.)

The above Map of Township 1 N. 25. North, of Range 19. 10 West of the 2nd Principal Meridian (Illinois) is strictly conformable to the field notes of the survey thereof on file in this office, which have been examined and approved.

and approved.
Surveyor General's Office
Cincinnati Sept. 20. 1843

Township N^o 27 N, Range N^o 10 West, 2^d Mer. (Illinois.)

[illegible]


Total number of Acres 2,515.78

| Survey Designated. | To Whom Surveyed. | Date of Contract. | Amount of Surveys.
M. Ch. Lk. | When Surveyed. | When Cashed in
the Surveyors' Office. |
|---------------------|-------------------|-------------------|----------------------------------|----------------|--|
| Township lines. | | | | | |
| Having on that line | Barin Kent | Oct. 15. 1834 | | July 1834 | 4 th of 1834 |
| Subdivisions. | | | | | |

The above Map of Township N.^o 37 North, of Range E.^o 10 West of
Principal Meridian (Illinois) is a steady conformable to the field
of the survey thereof on file in this Office, which have been examined and approved
Surveyor General's Office,
Cincinnati, Sept. 25, 1843. William Johnston, Sur. Genl

Fractional Township 28 North, the base line Range 10 West of the 2^d principal meridian

52

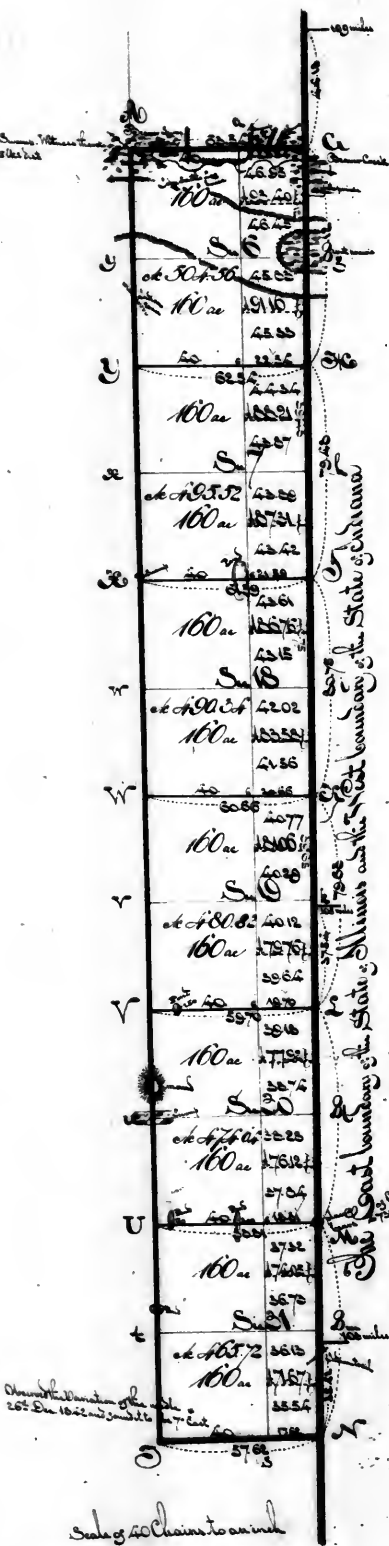

It appears to be the case below - By the comparison of the field notes of the Survey of the South boundary of this township, in 1842, by Mr. Call, with the survey thereof in 1842, by Holmanicki, it is evident that Mr. Call ran south 60.58 chains further East, to intersect what was supposed to be the State line - that in consequence of this discrepancy there is an offset in the corner due north of the line that line, shown on the plat of this office, from the records and the field notes therein, it appears that the East and West lines in the Eastern tier of sections in township 27 to 10, intersect only a "N 4 S line"; and nothing can be inferred from them of their closing on a "State line" - that the operations by Silbey in 1834, on the line between the States of Illinois & Indiana, were but a retracing, measuring and measuring thereof - that he did not connect the lines of the public surveys, on the West side, therewith, which renders it impossible to determine its position in T. 27 to 10 - that Holmanicki, who subdivided this township, from several mile posts still standing and plainly marked on the State line - that his work closes with the surveys on the north of his district; and that particularly in T. N. 28, 15 E. of 3^d 1st 16th, his surveys along Kankakee river, and his closing of the line between these sections on the State line, show the position of the said river to be as reported by Silbey, between the 182nd and 183rd mile-points - It is in consequence of these facts, that Mr. Holmanicki's surveys were approved and paid for.

Silas Reed
Surveyor of the public lands in
the State of Illinois & Wisconsin.

The mile points designated on the State line are the points perpetuated one mile apart according to the measurement on the said line, at the time of the Survey thereof - These numbers are progressive from the intersection with the westward line.

Variation
North & South boundaries & Subdivision lines 7th West Coast.
West boundary 7th East.
State line 6th East.

Scale of 40 chains to an inch
Aggregate Area 2911.00 acres


Surveyor's Office, Saint Louis 3rd of June 1843.

The above plat of fractional township 28 north of the base line, range 10 west of the 2^d principal meridian, west of the line between the States of Indiana and Illinois, is strictly conformable to the field notes of the Survey thereof on file in this office, which have been examined and approved - The said State line was surveyed, or rather a line which had been formerly run, was retraced, marked and measured in the 1st and 2nd quarters of 1824, by Silvester Silbey, under the provisions of the act of Congress of the 2^d of March 1805 to authorize the President of the United States to cause the public surveys to be connected with the line of demarcation between the States of Indiana and Illinois, as certified to this office on the 10th of June 1824, by Mr. J. W. Williams, Surveyor General of Ohio, Indiana, and Michigan - It was re-surveyed 6 miles in December 1842, by John Holmanicki, under contract of the 3rd of November of that year; these 6 miles were paid for in this 2^d quarter of 1843; and they will be charged in my account for the said quarter Voucher No. 1 - The south boundary was surveyed in September 1842 by J. B. M. Call, under instructions of the 18th April of that year - See the Statement A above - It was re-surveyed 57.62 chains, in the 4th quarter of 1842, by the said Holmanicki, under his said contract; and the 57.62 chains were paid as above - The west boundary 60.00 miles, were surveyed by Edward Smith in November 1833, under contract of 27th September 1833 - The north boundary 60.58 chains - and the subdivision lines, 3 miles 60.30 chains, were surveyed in the 4th quarter of 1842, by the said Holmanicki, under his said contract of the 3rd of November of said year: - They were paid for in this 2^d quarter of 1843 and they will be charged in the account current of the Surveyor General during the said quarter, Voucher No. 1.

Silas Reed
Surveyor of the public lands in
the State of Illinois & Wisconsin.

Fractional Township 22 North, Range 10 West, 2^d Principal Meridian

53

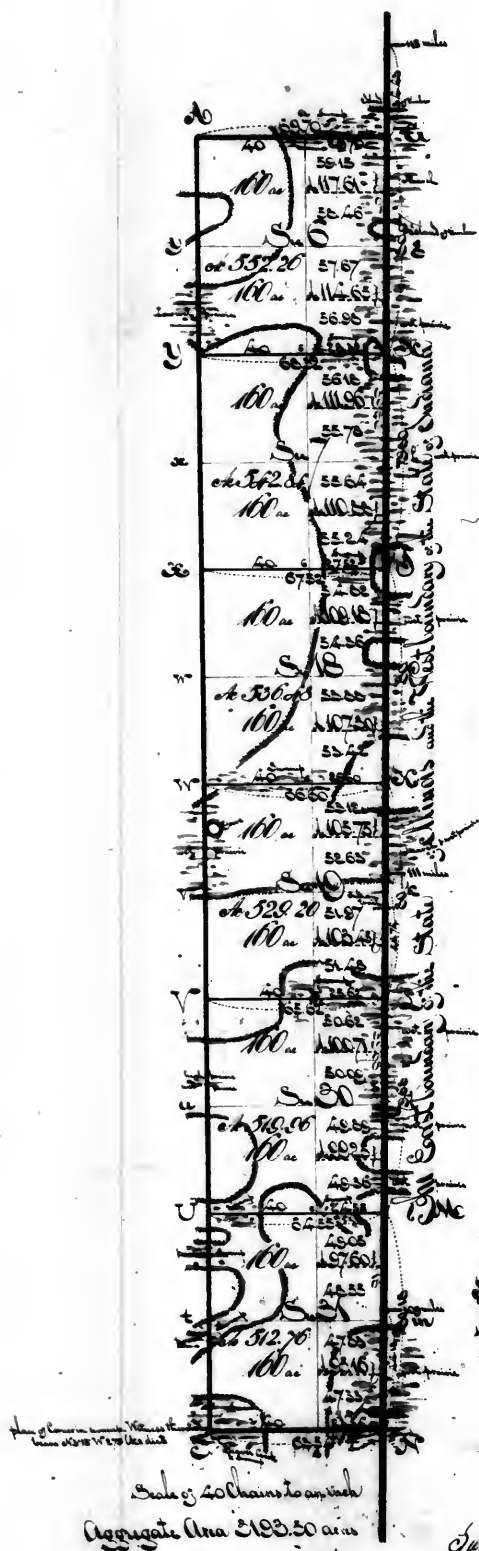

The mile points designated on the State line are the points perpetuated one mile apart according to the measurements on the said line, at the time of the survey thereof - Their number are progressive from the intersection with the Washburn river.

Location
of South boundary & Subdivision line & East.
of boundary & East.
State line & East.


Surveyor's office.
St. Louis 2^d of June 1843.

The above plat of township 22 north of the base line, range 10 west of the 2^d principal meridian, west of the line between the States of Indiana and Illinois, is strictly conformable to the field notes of the survey thereof on file in this office, which have been examined and approved. The east boundary or said State line, was surveyed, or rather, a line which had been formerly run, was retraced, marked and measured in the 1st and 3rd quarters of 1834, by Silvester Sibley, under the provisions of the act of Congress of the 2^d of March 1833, to authorize the President of the United States to cause the public surveys to be conducted with the line of demarcation between the States of Indiana and Illinois, as certified to this office on the 10th of June 1834, by Mr. J. Williams, Surveyor General of Ohio, Indiana & Michigan. It was surveyed 5 miles 79.17 chains, in January 1843, by John H. Hulme, under his contract of the 3rd of November 1842. This survey was paid for in this 2^d quarter of 1843, and it will be charged in the Surveyor's General's account for the said quarter, Voucher N^o 1. The west boundary 6 miles was surveyed in the 1st quarter of 1835, by Edward Smith, under his contract of the 27th of September 1833. The south boundary 63.58 chains - the north boundary 69.70 chains - and the subdivision line 4 miles 16.67 chains were surveyed in the 1st quarter of 1843, by John H. Hulme, under contract of the 3rd of November 1842. They were paid for in this 2^d quarter of 1843, and they will be charged in the account of the Surveyor General for this last quarter, Voucher N^o 1.

Silas Reed

Surveyor of the public lands in
the State of Illinois &c. Missouri.

54

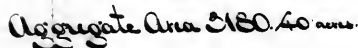

Variation


day 1 Subversion times 7:00 East.
day 2 7:15 East.
day 3 7:00 East.
day 4 6:30 East.

Saint Louis 2nd of June 1843.

may make change in the account
Silas Reed
Surveyor of the public lands in the
State of Illinois vs McHenry.

Township 28 North of the base line, Range 11 West of the 2nd principal meridian

55

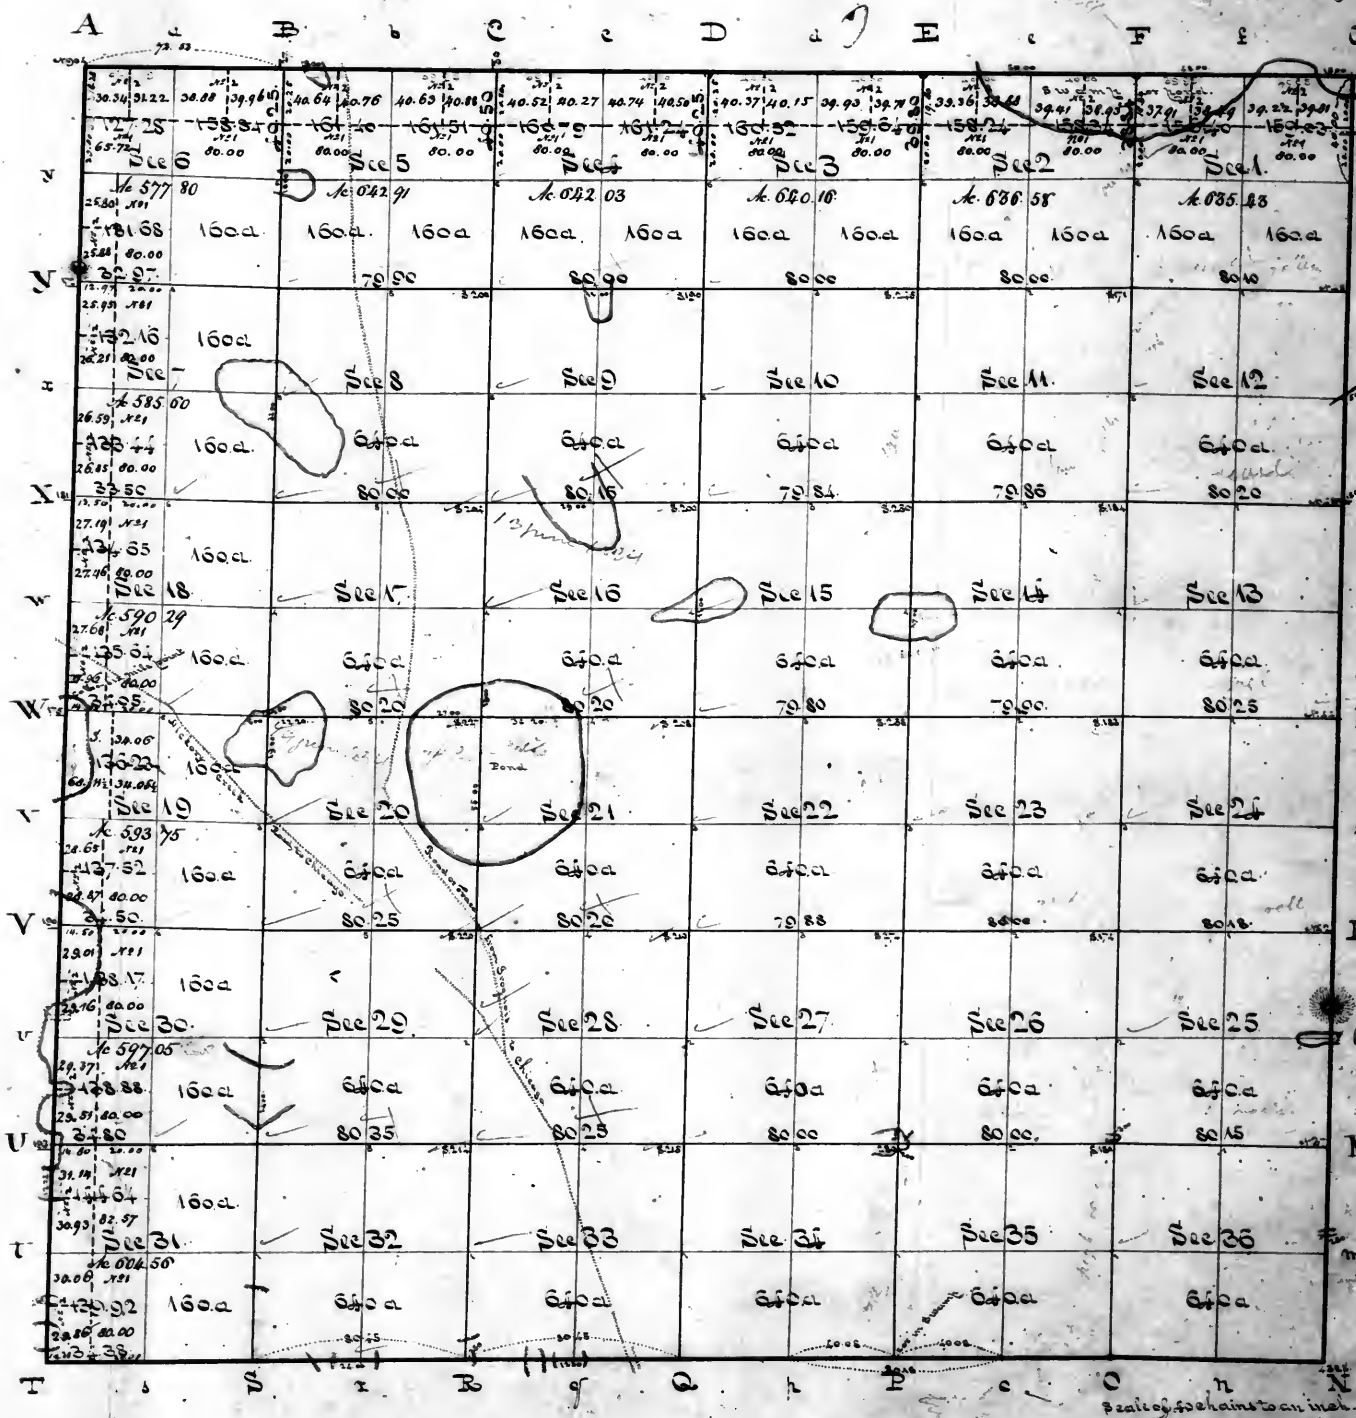




Surveyors Office
St. Louis 16th August 1829

The above Plat of Township 28 North of the base line, Range 11 West of the 2nd principal meridian, is conformable to the field notes thereof on file in this office which have been examined and approved. The South boundary was surveyed in the 3rd quarter of 1822, by James B. McCall, under instructions of the 18th of April 1822, and in the 2nd quarter of 1824, Edward Smith being unable to find the old corners to sections 32 and 33 - and 34 & 35, resurveyed and established the proper corners thereon; the South boundary of sections 32 & 33 - that part of the South boundary of section 34 which lies East of quarter section corner - and that part of the South boundary of section 35 which lies West of quarter section corner, as represented on this map - the West - the east - and the north boundaries, were surveyed in the 4th quarter of 1822, and the subdivision lines, in the 2nd quarter of 1824 - all by Edward Smith, under contract of the 27th of September 1822.

William McCall
Surveyor General

aggregate area 22746.16 acres.

234

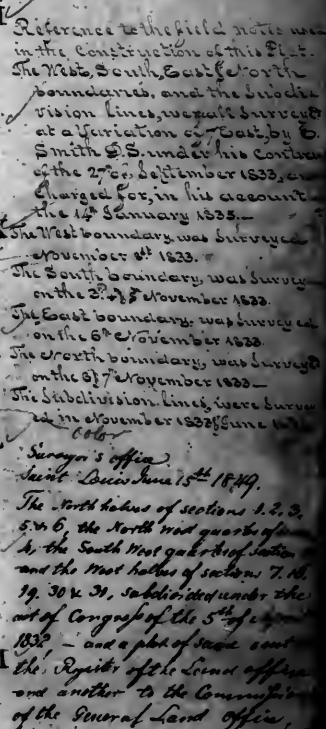

Scale of 40 chains to an inch

aggregate area 22546.34 acres.

The above Plat of Township 29 North of the base line, Range 11 West of the 2^d principal meridian is ^{strictly} conformable to the field notes ^{of the survey} there on file in this office which have been examined and approved - The exterior boundary lines were surveyed in the 4th quarter of 1822 - and the subdivision lines were surveyed in the 4th quarter of 1822; and the 2^d quarter of 1824 - all by Edward Smith, under contract of the 27th day of September 1822.

William Milburn
Sergeant General






















Surveyor's Office

St Louis June 1st 1834

The North halves of sections 5 & 6, the South West quarter of section 6, and the West halves of sections 7, 10, 19, 20, 31, subdivided under the act of Congress of the 5th of April 1820, and a plat thereof sent to the Register, and another to the Commissioner of the General Land office.

Carter T. J.

Aggregate area 21342.75 acres.

The above plat of township 30 north of the base line, range 11 west of the 2^d principal meridian, is strictly conformable to the field notes of the survey thereof on file in this office, which have been examined and approved. The north boundary was surveyed in the 4th quarter of 1833, by Carl W. Beckwith, under contract of the 29th of October 1833. The south and west boundaries were surveyed in the 4th quarter of 1833 - and the subdivision lines, were surveyed in the 2^d quarter of 1834, by Edward Smith, under contract of the 27th of September 1833.


William Hutton

William Maltman
Incorporation

24

Township 28 North of the base line, Range 12 West of the 2nd Principal Meridian

58

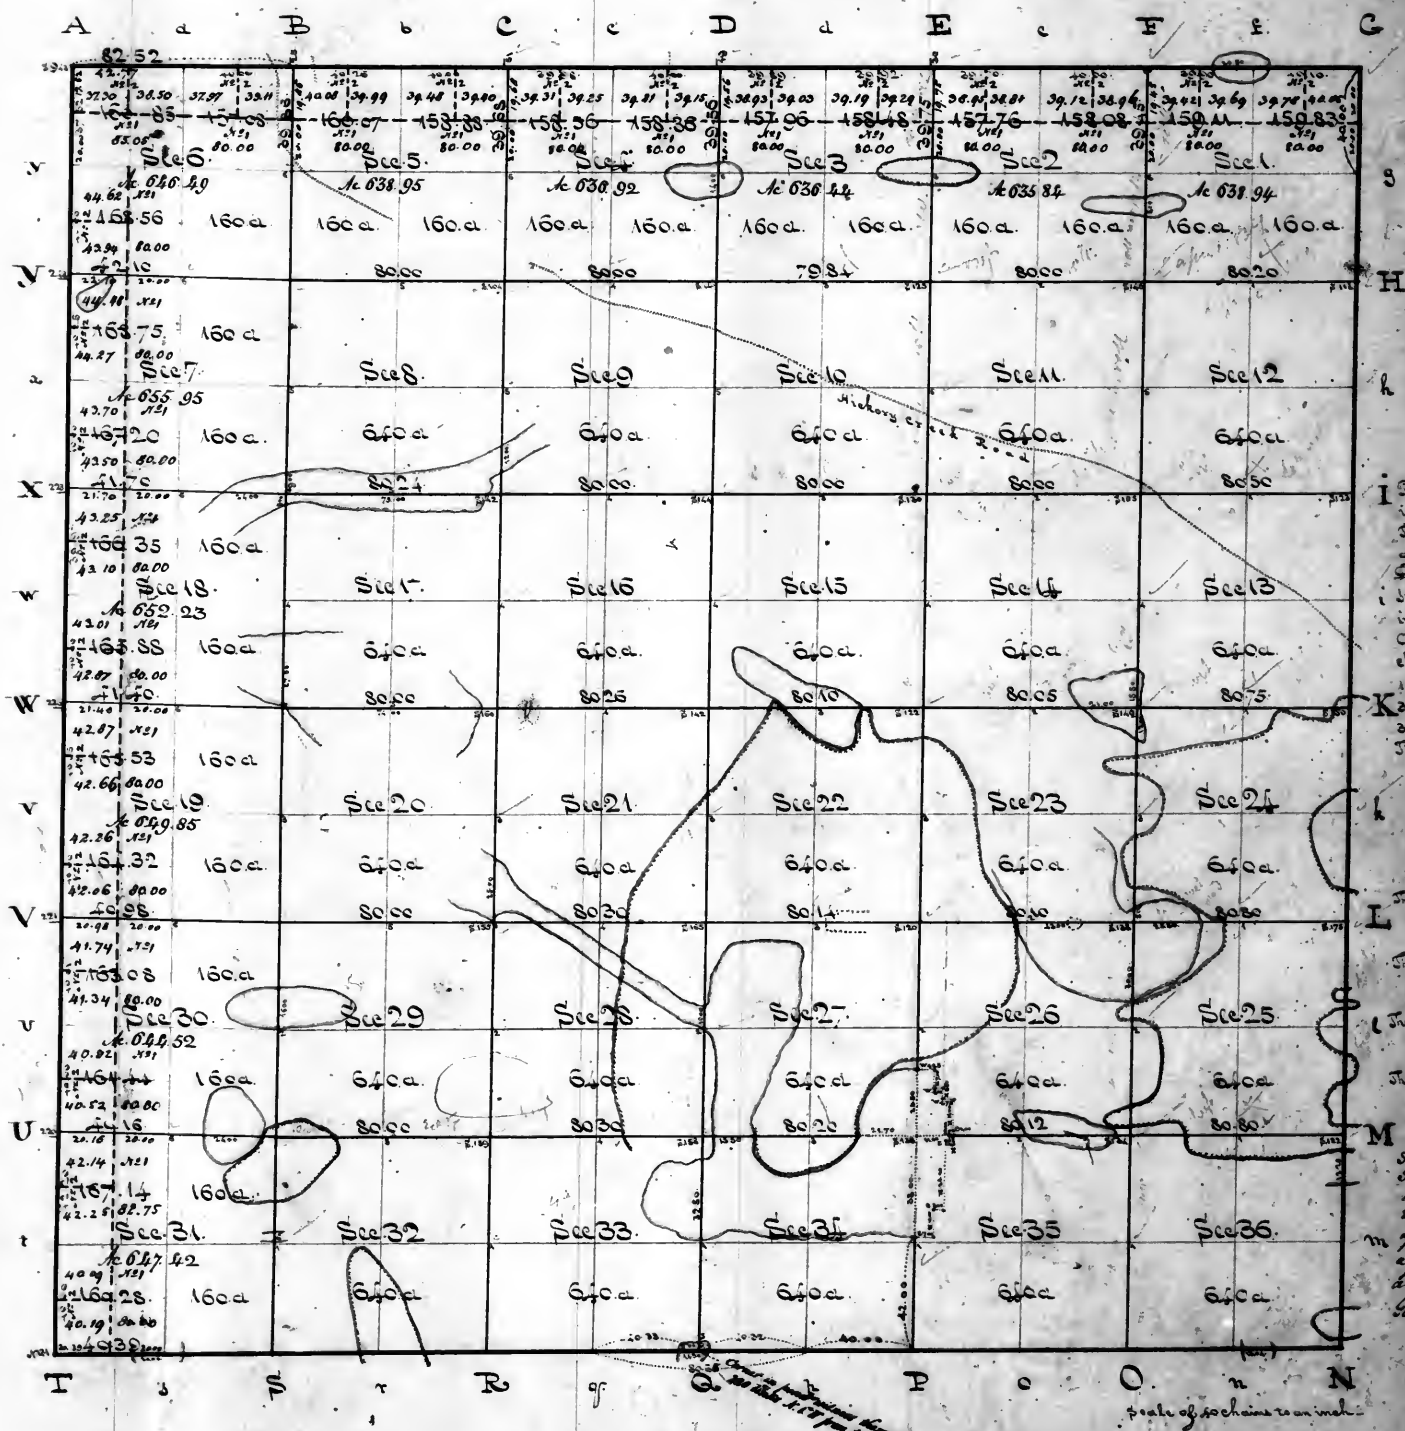


I Referenced to the field notes in the construction of this plat the South boundary was surveyed on 9th October 1822, by S. B. Smith, S. S., variation not stated, and the same boundary, examined and in part resurveyed on the 4th of April 1824, by S. B. Smith, S. S., charged for in his account of the 16th January 1825, to wit: S. B. Smith, W. of 1st Sec. cor., and the S. 1st Sec. 22, 23, 24, 25, 26, 27, 28, 29, 30, 31, 32, 33, 34, 35, 36, of 1st Sec. cor. - The West, East & North boundaries and the subdivision lines were surveyed by S. B. Smith, S. S., under his contract of the 27th of September 1823, and charged for in his account of the 16th of January 1825. The West boundary was surveyed on the 25th October 1823, at a variation of 7th 26th East. The East boundary was surveyed on the 26th October 1823, at a variation of 1st East. The North boundary was surveyed on the 20th 1st October 1823, at a variation of 1st East. The subdivision lines were surveyed from the 2nd to the 9th of April 1824, at a variation of 7th 26th East. Surveyor's office: Saint Louis, June 15th 1849. Subdivided the North half of sec. 1, 2, 3 & 4, of the South West 1/4 of section 6, and the North half of section 7, 8, 9, 10, 11, 12, and a plat thereof to the Register, and to the Commissioner General Land Office.

Surveyors Office
St. Louis 16th August 1837

The above Plat of Township 28 North of the base line, Range 12 West of the 2nd Principal Meridian, is conformable to the field notes, & is on file in this office, which have been examined and approved - The South boundary was surveyed in the 4th quarter of 1822, by James D. Smith, S. S., under instructions of the 18th of April of that year: - In the 2nd quarter of 1824, Edward Smith whilst subdividing the township was unable to find the corner to sections 22 and 24 - and therefore re-established it as represented on the map - the west, east and north boundaries, were surveyed in the 4th quarter of 1823, and the subdivision lines were surveyed in the 2nd quarter of 1824, by Edward Smith, under contract of the 27th of September 1823.

William Milburn
Surveyor General

55
Township 29 North of the base line, Range 12 West of the 2nd Principal Meridian

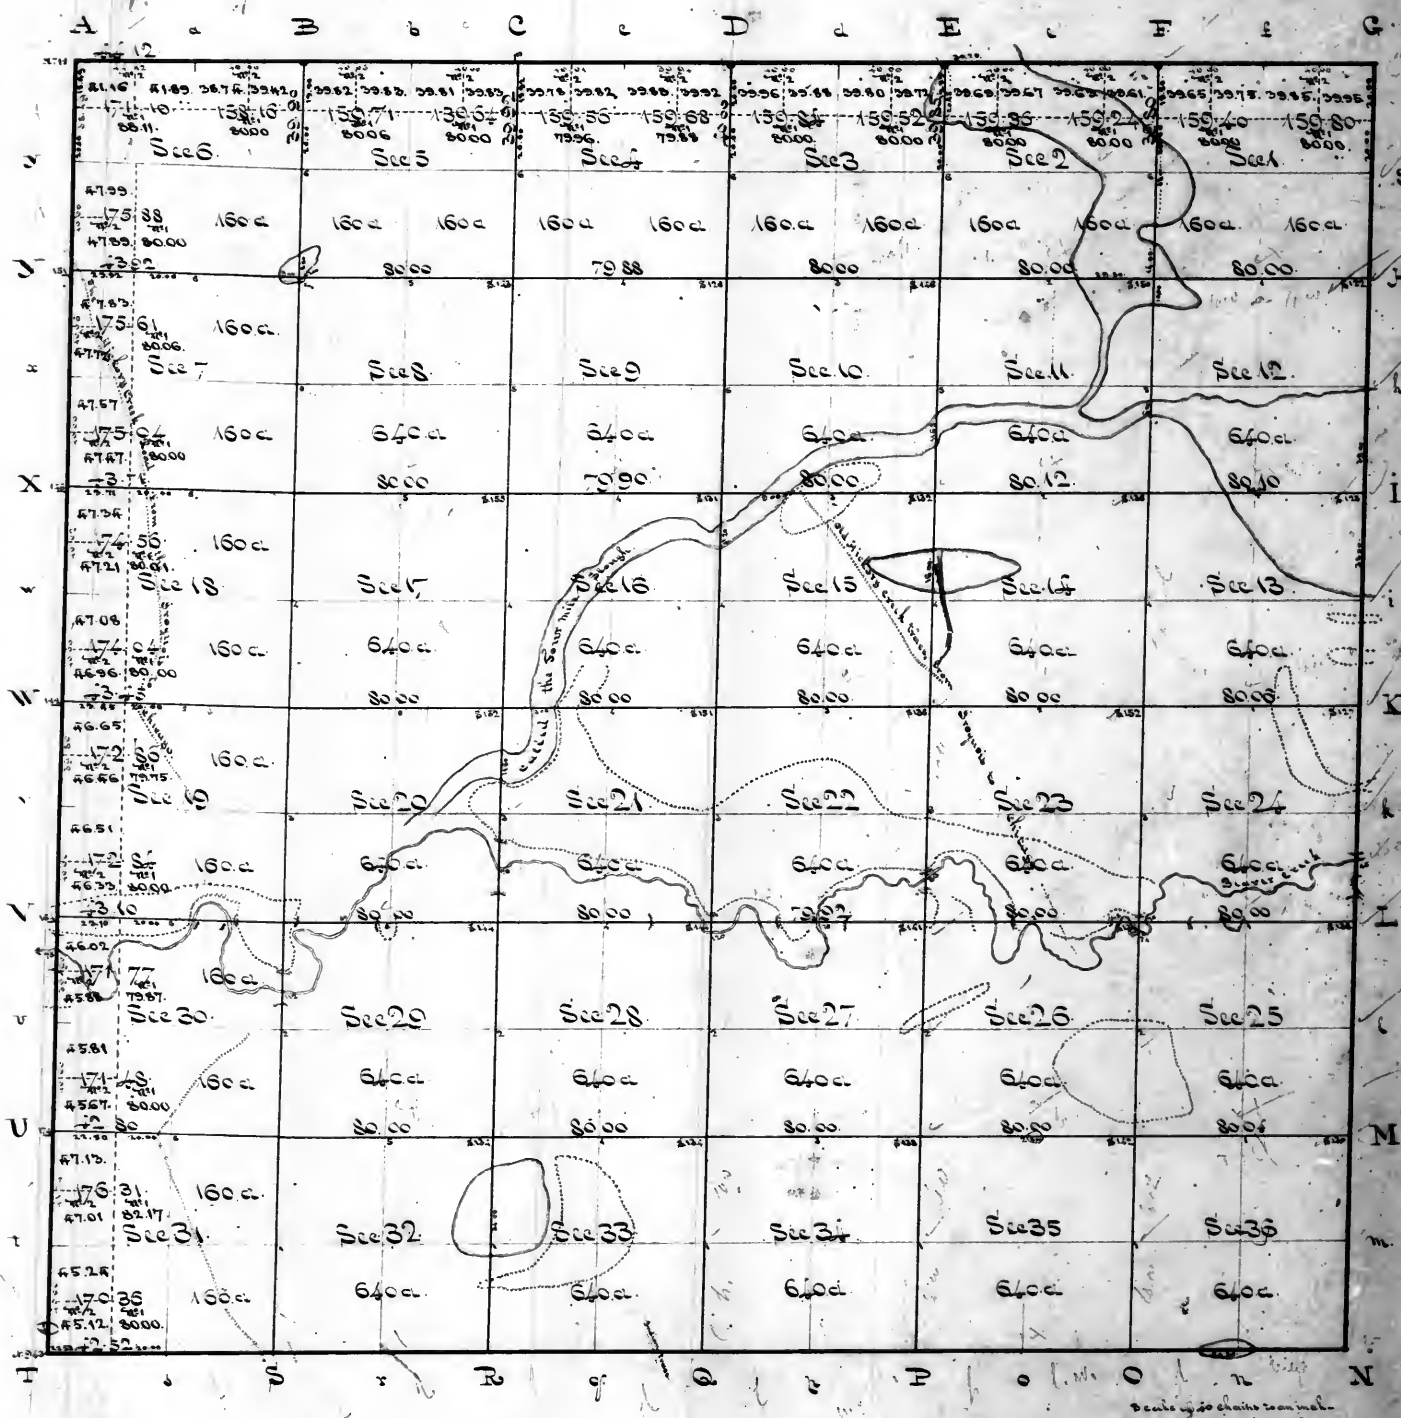

I Refer to the field notes in the construction of this Plat. The West, South, East & North boundaries, and the subdivision lines, were all surveyed at a Variation of 7° East by E. Smith & S. under his contract of the 27th of September 1833, and charged for in his account of the 1st of January 1835. The West boundary, was surveyed on the 28th October 1833. The South boundary, was surveyed on the 30th October 1833. The East boundary, was surveyed on the 1st of November 1833. The North boundary, was surveyed with the theodolite on the 1st of November 1833. The subdivision lines, were surveyed from the 15th to the 16th of April 1834.

Variation 7° East

aggregate area 23195.82 acres.


Surveyors Office
St. Louis 9th May 1839

The above Plat of Township 29 North of the base line, Range 12 West of the 2nd Principal Meridian, is, conformable to the field notes thereof on file in this Office, which have been examined and approved. The exterior boundary lines were surveyed in the 4th quarter of 1833 and the subdivision lines in the 2nd quarter of 1834 - all by Edward Smith under contract of the 27th of September 1833.

William Melbourn
Surveyor General

W. A.

Township No 28 North of the Base line in Range No 13 West of the 2^d principal Meridian.

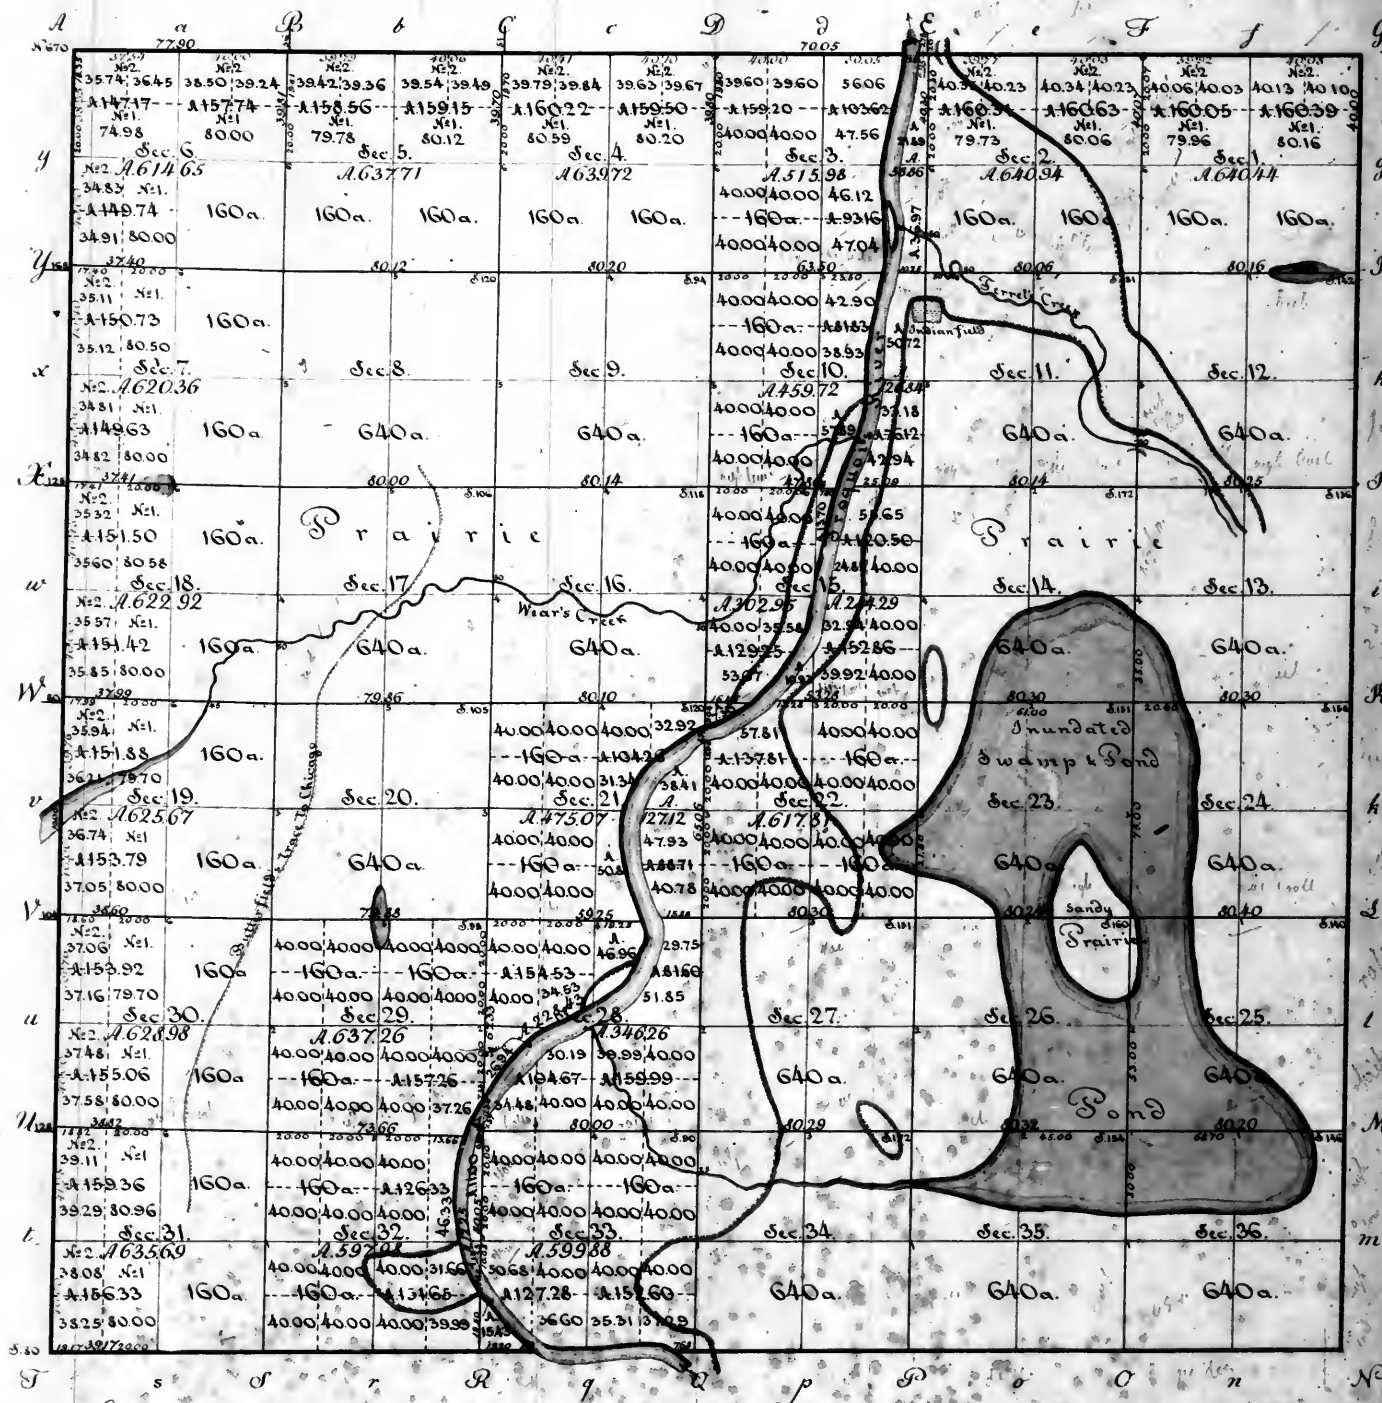


Surveyors Office
Saint Louis 9th of May 1839.

Scale of 40 chains to one inch.
Aggregate Area 22600.58 acres.

The above plat of township 28 north of the base line range 13 west of the 2^d principal meridian is strictly conformable to the field notes of the survey thereof on file in this office which have been examined and approved. The south boundary was surveyed in the 4th quarter of 1822 by James R. McCall under instructions of the 18th of April of that year - and in the 2^d quarter of 1834 Edward Smith preparatory to measuring the river remeasured the fractional south boundaries of section 33, and established corners at the intersections with the river. The west boundary 6 miles, was surveyed in the 2^d quarter of 1834, by William L. D. Ewing, under contract of the 15th of August 1833. The east boundary was surveyed in the 4th quarter of 1833 and the 3^d quarter of 1834 - and the subdivision lines were surveyed in the 2^d and 3^d quarters of 1834 - all by Edward Smith under contract of the 27th of September 1833.

William Melbourne
Surveyor General
Off

DIAGRAM OF THE SURVEY OF MEANDERED LAKE IN TOWNSHIP No. 32 N. RANGE No. 13 EAST 3d Principal Mer., ILLINOIS

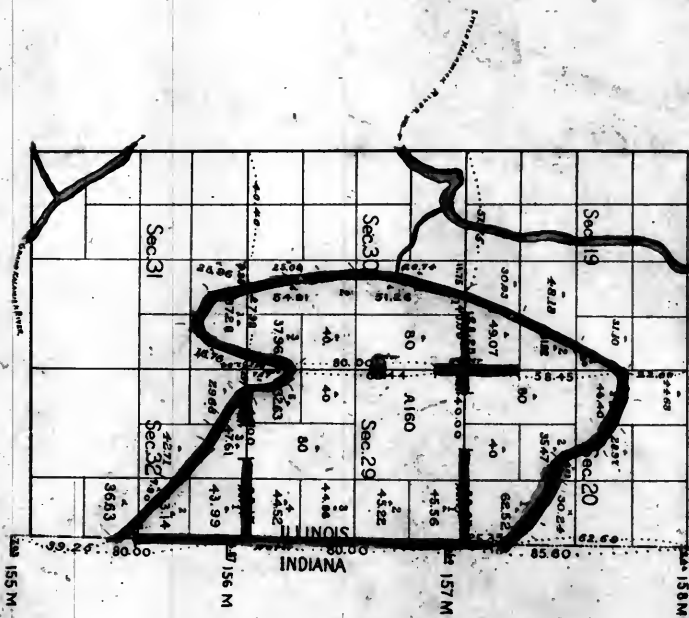

I hereby certify that the above is a correct and true survey executed by Alexander McKee, Deputy Surveyor, under contract bearing date the 6th day of September, 1874, of a Meandered Lake in fractional Section 19, 20, 29, 30, 31, S. 2. Township 32° N. Range 13° E. 3d of 3rd Principal Meridian in the State of Illinois, and is strictly conformable to the provisions of the Survey thereof which have been examined and approved.

Department of the Interior
General Land Office Bureau
31st 1874
Commissioner and Ex. Officer
Surveyor General of
Illinois.
A. J. Smith


See field notes Survey of Lake Meandered and by 1874 in Bureau No. 15. South. 144 side.

D I A G R A M
of
KALAMICK LAKE
IN

T.37N. R.14E, 3^d PRIN. MER.
North & South of Old Indian Boundary.

ILLINOIS.

Note: The dotted line shaded blue, shows the present
margin of the lake, but is not considered.
The line shaded red, shows the meandered
boundary of lake as previously surveyed.

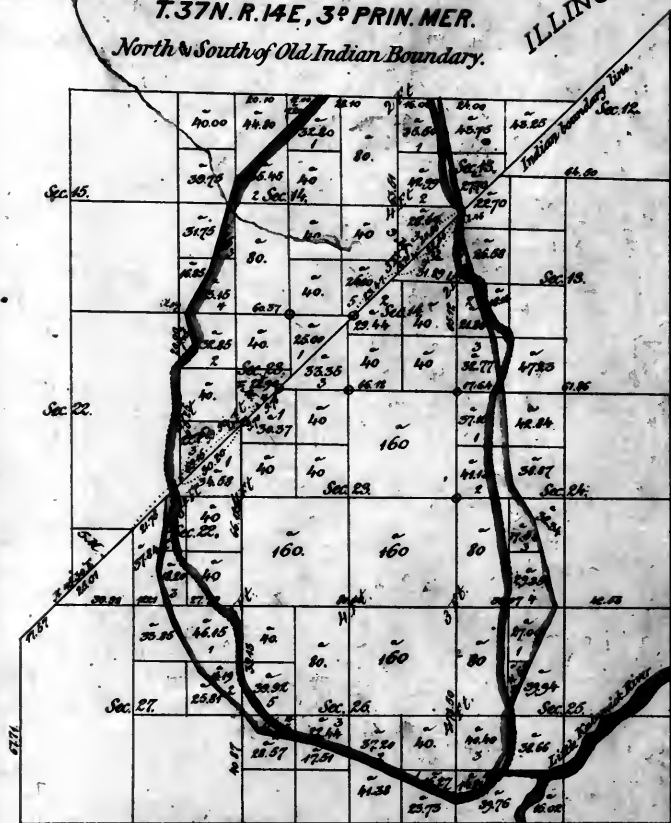

Department of the Interior
General Land Office
May 15. 1878.

1777
10. 1877.

Whereby certify that the above Diagram of Kalamazoo Lake in Sections 13, 14 & 15, T. 37 N. R. 14 E. 3^d Principal Meridian; South of Indian boundary line, and Sections 13, 14 & 15, T. 25 N. and 27, T. 37 N. R. 14 E. 3^d Principal Meridian; South of Indian boundary line in the State of Illinois, is a correct plot of the survey, executed by Alexander Wilcox, Deputy Surveyor, under his contract entered into with the Commissioner of the General Land Office, bearing date the 15th day of December 1877, in accordance with Section 220, U. S. Revised Statutes, and is strictly conformable to the field notes thereof, which have been examined and approved.

1877

Note - Figures in this color indicate depth of water as shown by Field Notes of recent survey. Blue rings show corners at which depths of water were recorded in Field Notes.

Commissioner, and
Ex Officio Sec. Genl of Illinois

T 37 N R. 14 E. of the 3rd pr. Mer

Red with letter 7/6/51



Measure
from a
N 45 E 8.00 ch
N 12 W 14.07 to corner
N 31 E 17.91
N 18 1/4 E 38.00
N 45 E 44.00 to b
from c
S 12 E 62.98 to a
Total 207.96

Line run by John Lewis under instructions of the 19th November 1850
J. 37 R. 14 N. of Indian line
The line between sections 10 & 11 1.00.37
do 14 & 15 1.00.30
do 14 & 23 to bank of lake 2.57
do 22 & 23 do 20.00
do 11 & 14 1.00.30
do 12 & 13 to Indian line 69.43
Measure in Oct. 19. 14 & 23 2.01.96
J. 37 R. 14 S. of Indian line 64.58
Line between sections 12 & 13
Continued with corner d and corner to S 12 &
13 on Indian line 18.95
Total 778.38


Office of the Surveyor General for Illinois and Missouri
Illinois 6 February 1851.

The above plat of fractional sections 13, 14 & 23 in Township 37 north of the base line range 14 East of the 3rd principal meridian, north of the old Indian line, is strictly conformable to the field notes of the survey thereof on file in this office which have been examined and approved. In the subdivision in June 1841, of the township, by John Wells, under the contract of Theo C. Rector and Stephen Rector of the 20 March of that year, the Kalamazoo Lake was not measured along said sections 13, 14 & 23, which prevented the calculation of the areas of their respective tracts. To remedy this omission, John Lewis, was on the 14th November 1850, instructed to complete the survey of the said section. In December of the same year, he executed the work, and in order to close it with the adjacent lines, and remove all missing corners, he surveyed twice the measure of section 13, 14 & 23, the lines detailed in the above Statement - in all 7 miles 18.38 chains, which are paid for this day to said Lewis, and will be charged in my account current with the United States during the 1st quarter of 1851, under the appropriation of \$1200, made on the 3 March 1849, for the correction of erroneous and defective surveys in small and detached portions in Illinois and Missouri at a rate not exceeding six dollars per mile. See page 65, act 2 Session of 30 Congress.

A copy of this plat was sent to the Register
on 6 February 1851.

M. Lewis Rector
Surveyor General

Township No 38 North of the Base line Range No 14 East of 3^d principal Meridian

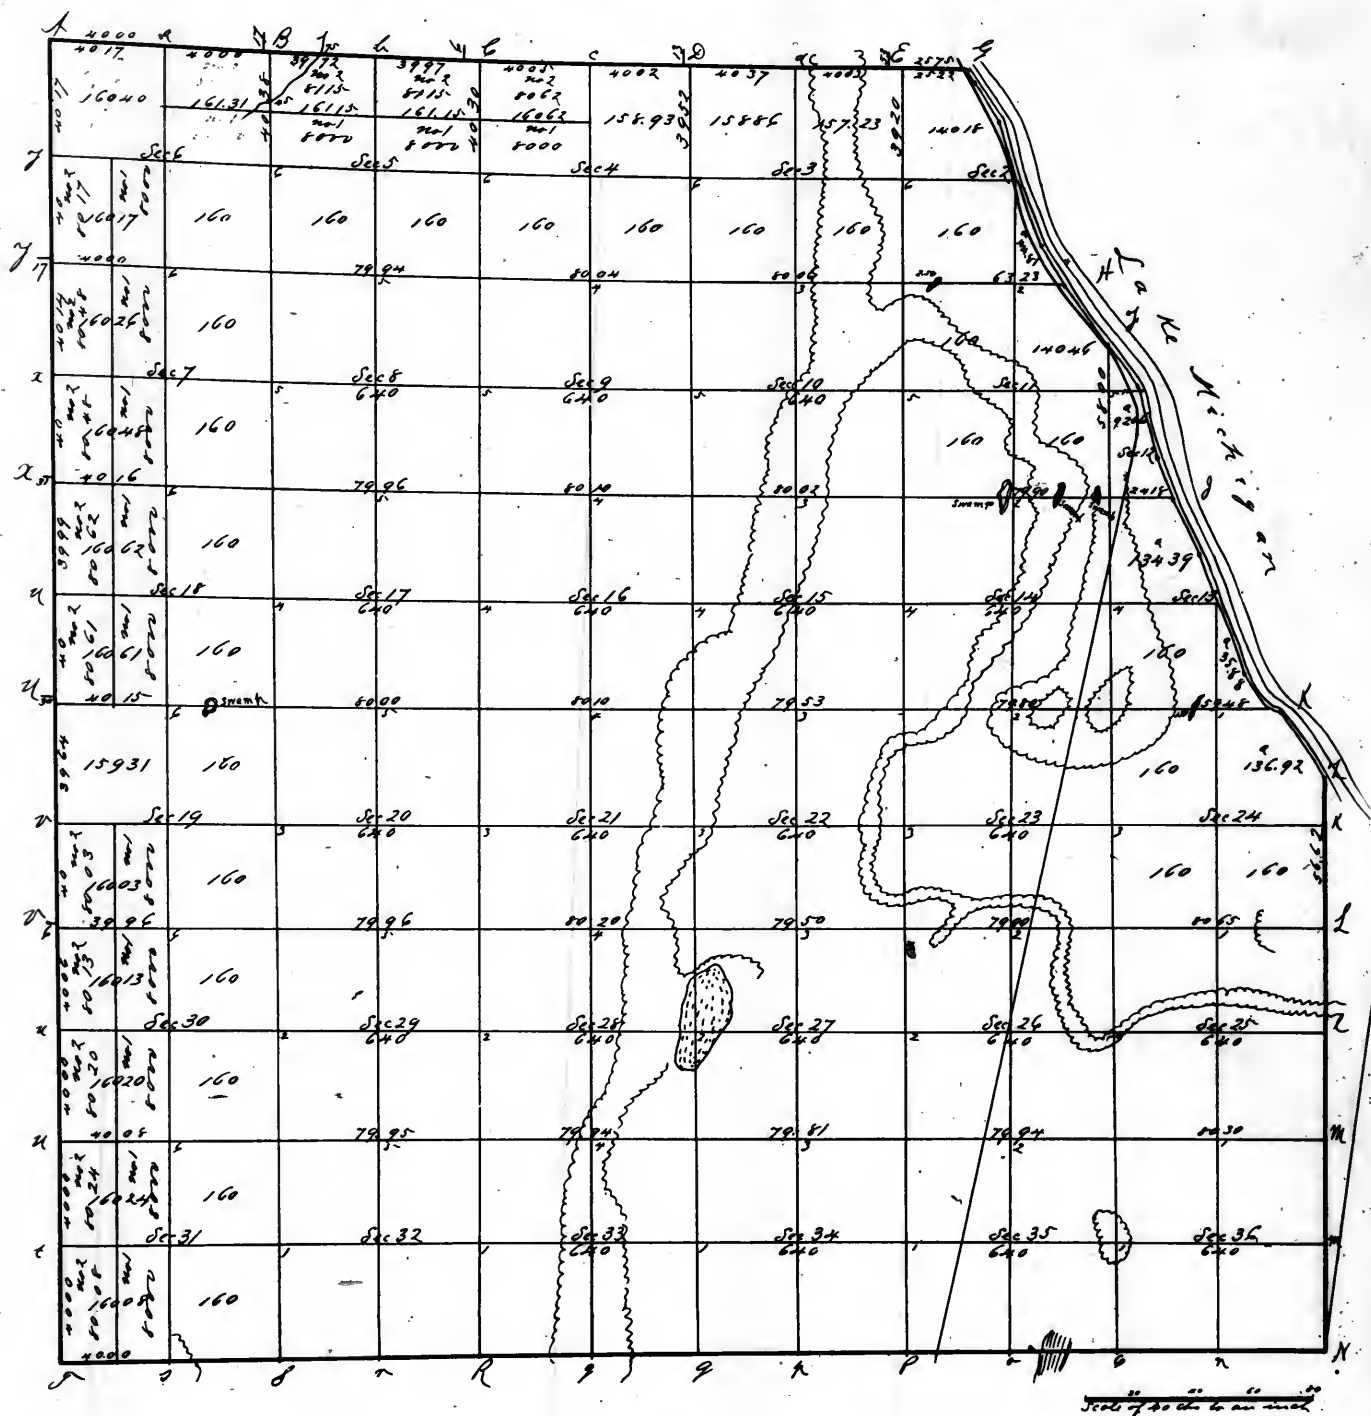


Pursuant to a contract with instructions from William Reichen Surveyor of the lands of the United States in the States of Missouri & Illinois & Territory of Arkansas bearing date the twentieth day of March 1821 We have admeasured, laid out & surveyed the above described Township & do hereby certify that it had such marked bounds both natural & artificial as are represented on said plot and described in the field notes made hereof & returned with this plot into the Office of the Surveyor of the lands of the United States in the States of Missouri & Illinois & Territory of Arkansas

Certified this sixth day of November 1822

Examined

by Tho^s C & J Reichen D. Surveyors
Total Quantity Acres Sec
21206.48

Tract Township No 40 & 41 North of the Base line Range No 14 East of 3^d principal Meridian

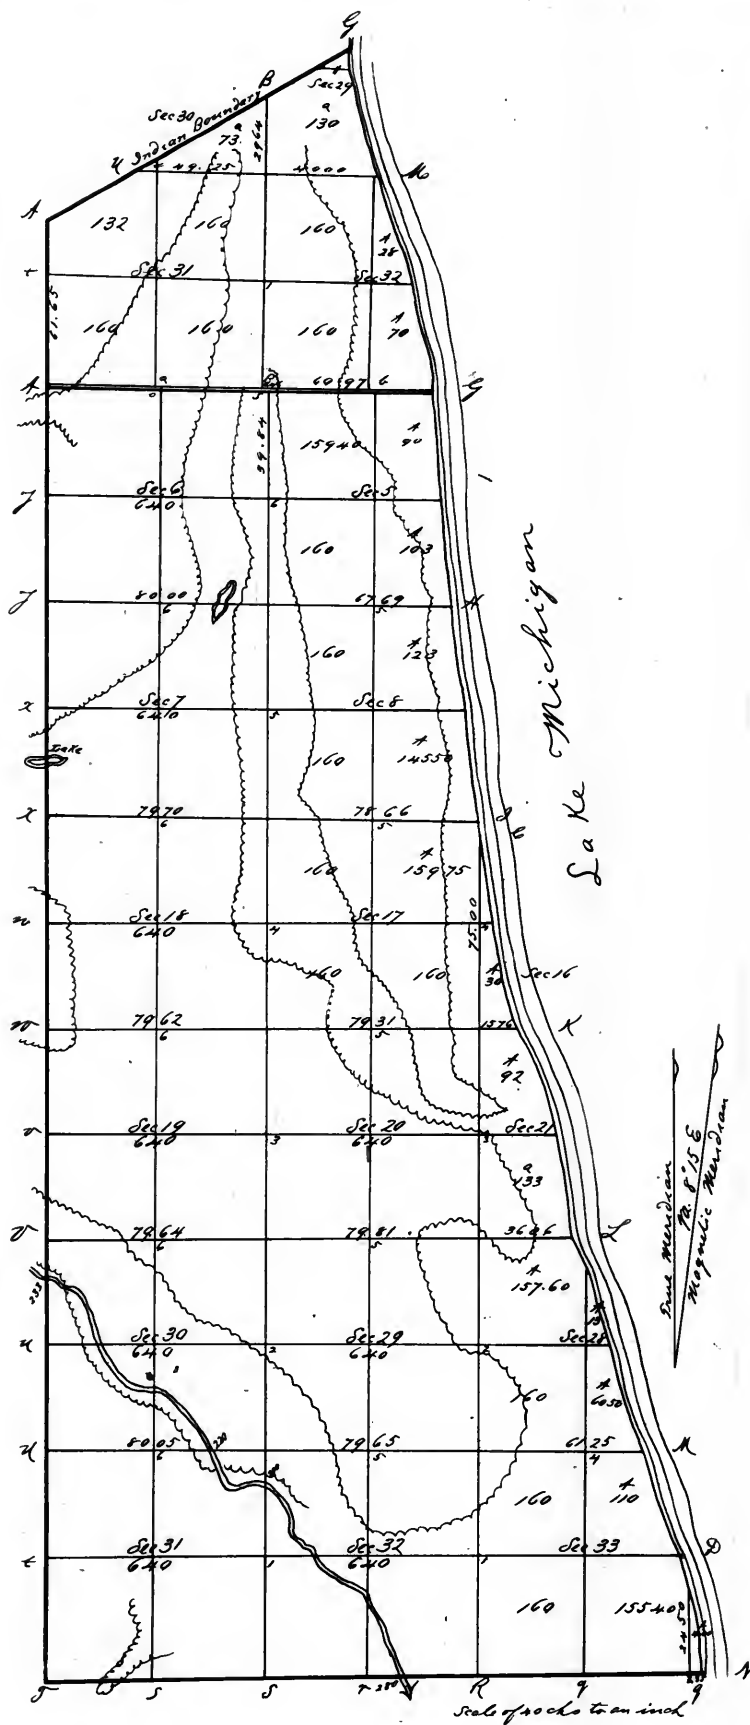

Presented to a court of said & instructions from William Reichen Surveyor of the Lands of the United States in the State of Missouri and Illinois and Territory of Arkansas bearing date the twentieth day of March 1827. The said court and Surveyor the above described Township and do hereby certify that it has such marks and bounds look material and artificial as are represented on said plot and described in the field notes made thereof and returned with said plot into the Office of the Surveyor of the Lands of the United States in the State of Missouri and Illinois


Certified this first day of November 1827

Examined *Wm Reichen*

Wm Reichen
Surveyor

B. C.
19.


Tract Townships No 36 and 37 North of the Base line Range No 14 East 3^d principal Meridian.

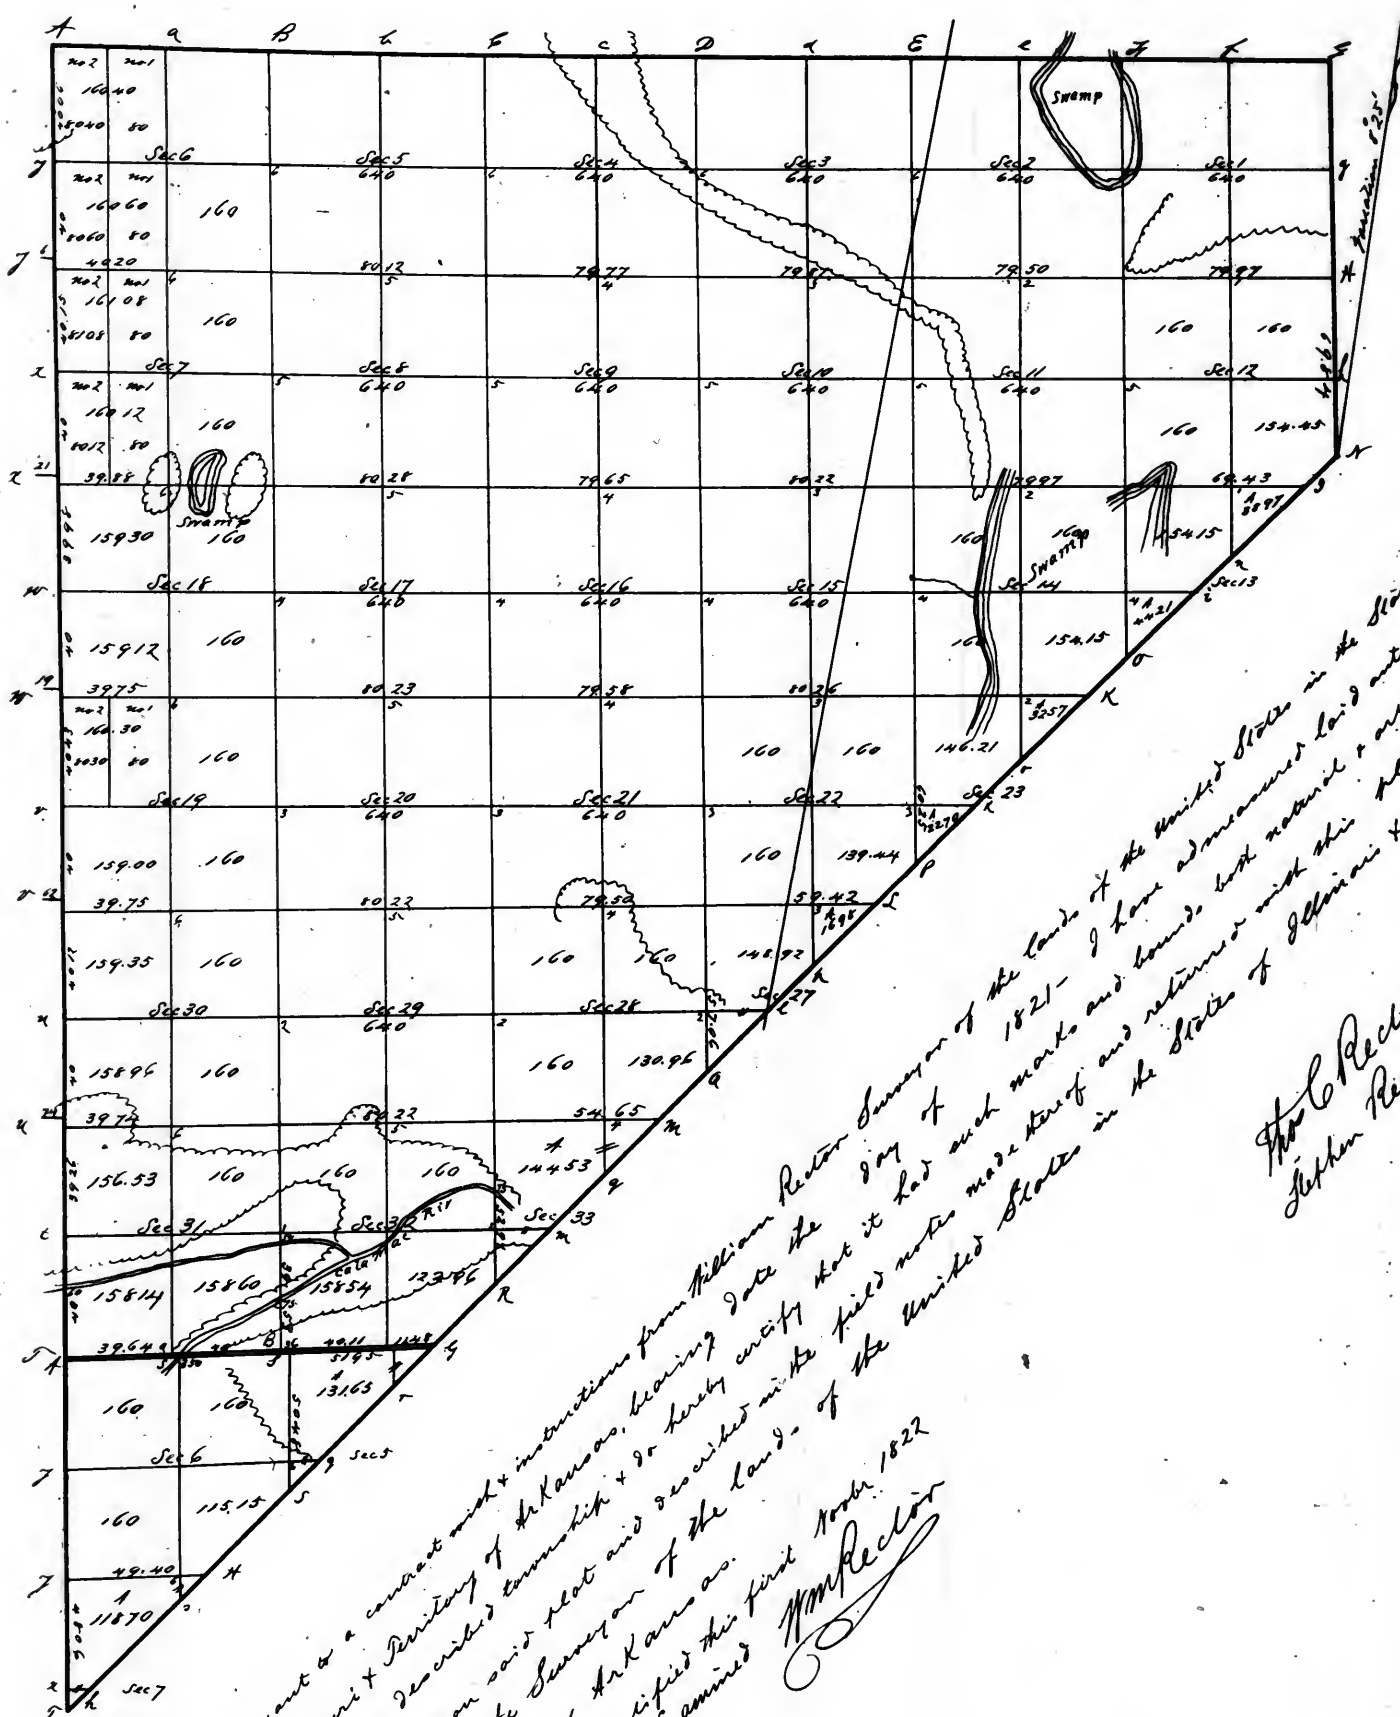

I amant & a contract with instructions from William Rector Surveyor of the lands of the United States in the State of Illinois
& Missouri & Territory of Arkansas, bearing date the 9th of 1821 - I have admeasured laid out & surveyed
the above described township & do hereby certify that it had such marks and bounds both natural & artificial as are
represented on said plat and described in the field notes made thereof and returned with this plat into the
Office of the Surveyor of the lands of the United States in the State of Illinois & Missouri
& Territory of Arkansas as
certified this first month 1822
Examined
Wm Rector
Stephen Rector

Township 29 North of the base line, Range 13 West of the 2^d principal meridian

62

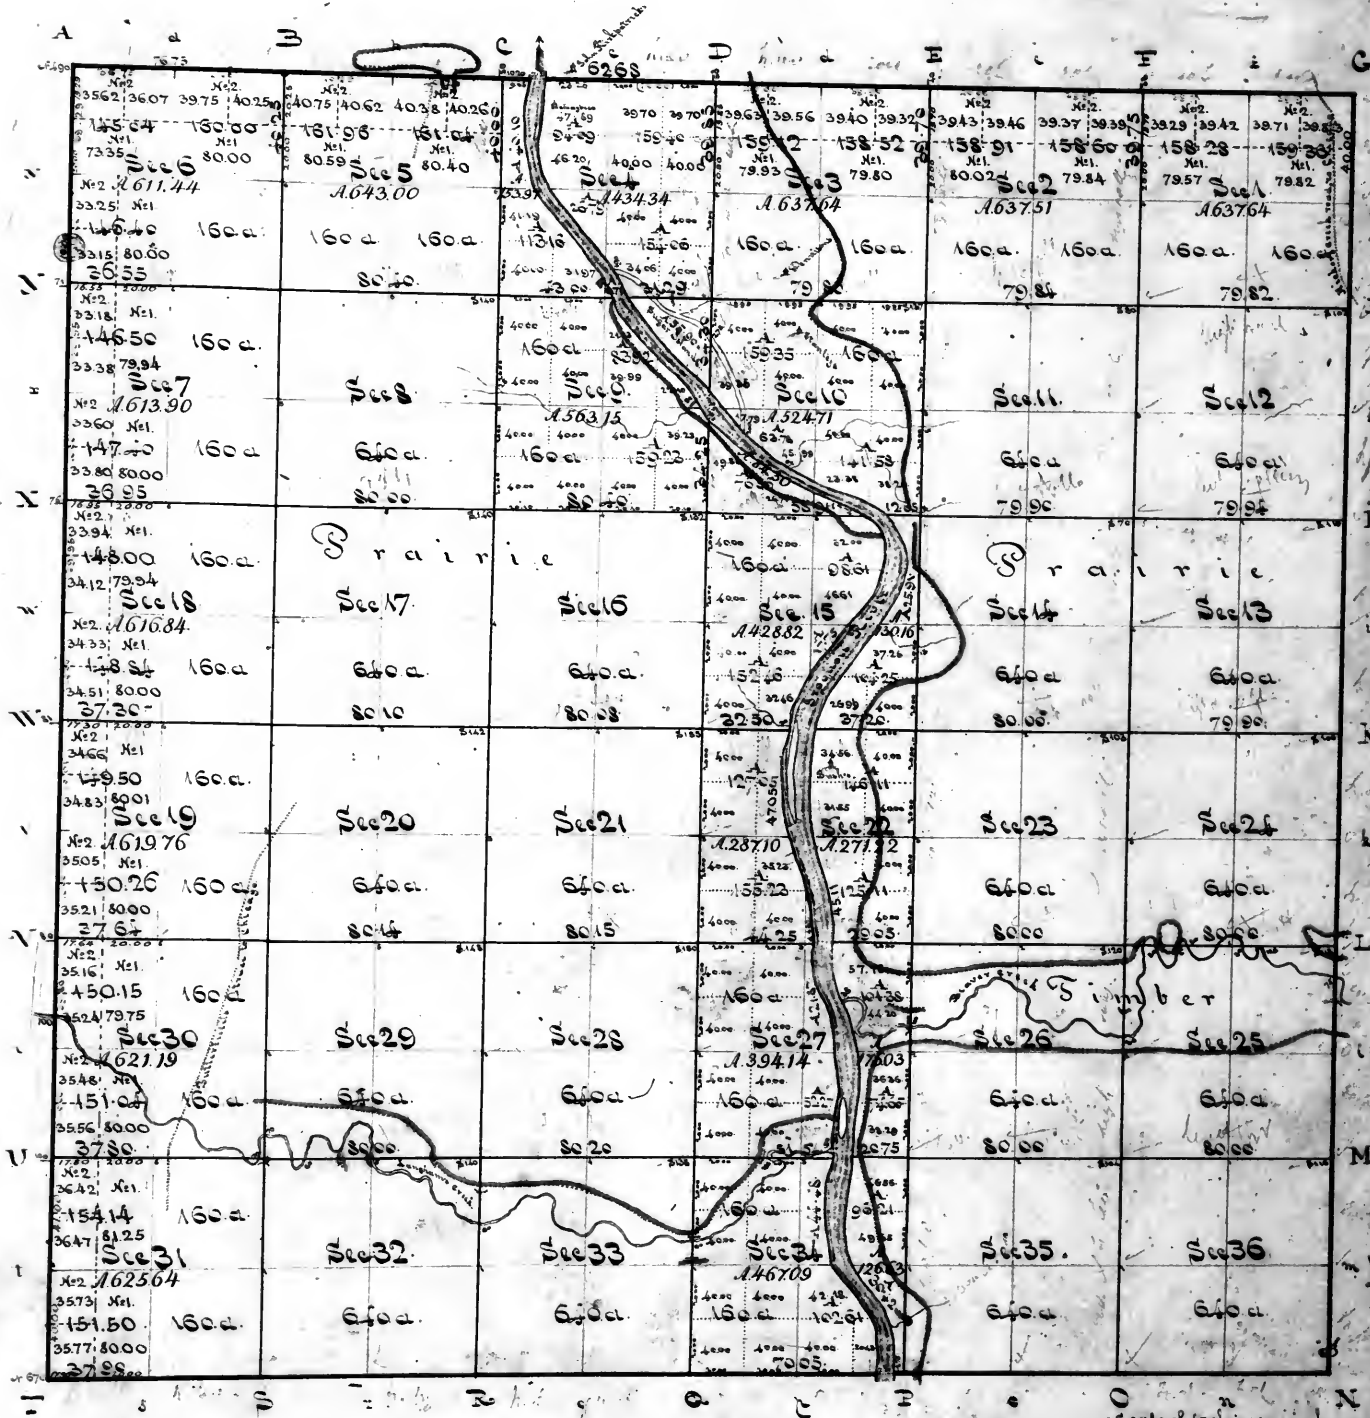

Note: The also which runs on the East side of Sugar Island in Sect. 10 is not ranging, and was not therefore measured, consequently the said island and also are attached to and form parts of the proper subdivisions of the sections.
William Milburn
Surveyor General
JH

Variation:
on West by 7°25' East
all the other lines 7°30' East.


Aggregate Area 22522.12 acres.

Surveyors Office.
Saint Louis 9th of May 1833.

The above plat of Township 29 north of the base line, range 13 West of the 2^d principal meridian is strictly conformable to the field notes of the survey thereof on file in this Office, which have been examined and approved. The west boundary was surveyed in the 2^d quarter of 1833 by Wm. L. D. Ewing, under contract of the 15th of August 1833. And the South boundary was surveyed in the 4th quarter of 1833 and the 3^d quarter of 1834. The east and North boundaries were surveyed in the 4th quarter of 1833 and the subdivision lines in the 2^d and 3^d quarters of 1834 - all by Edward Smith under contract of the 27th of September 1833.

William Milburn
Surveyor General
JH

63

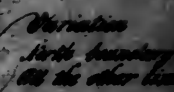


Public Land 19632.97 acres
Reservations 1928.00 acres
Total 21552.97 acres

William Willbourn
Bureau of General Land Office

Township 5 North of the base line Range 14 West of the 2^d principal Meridian

64

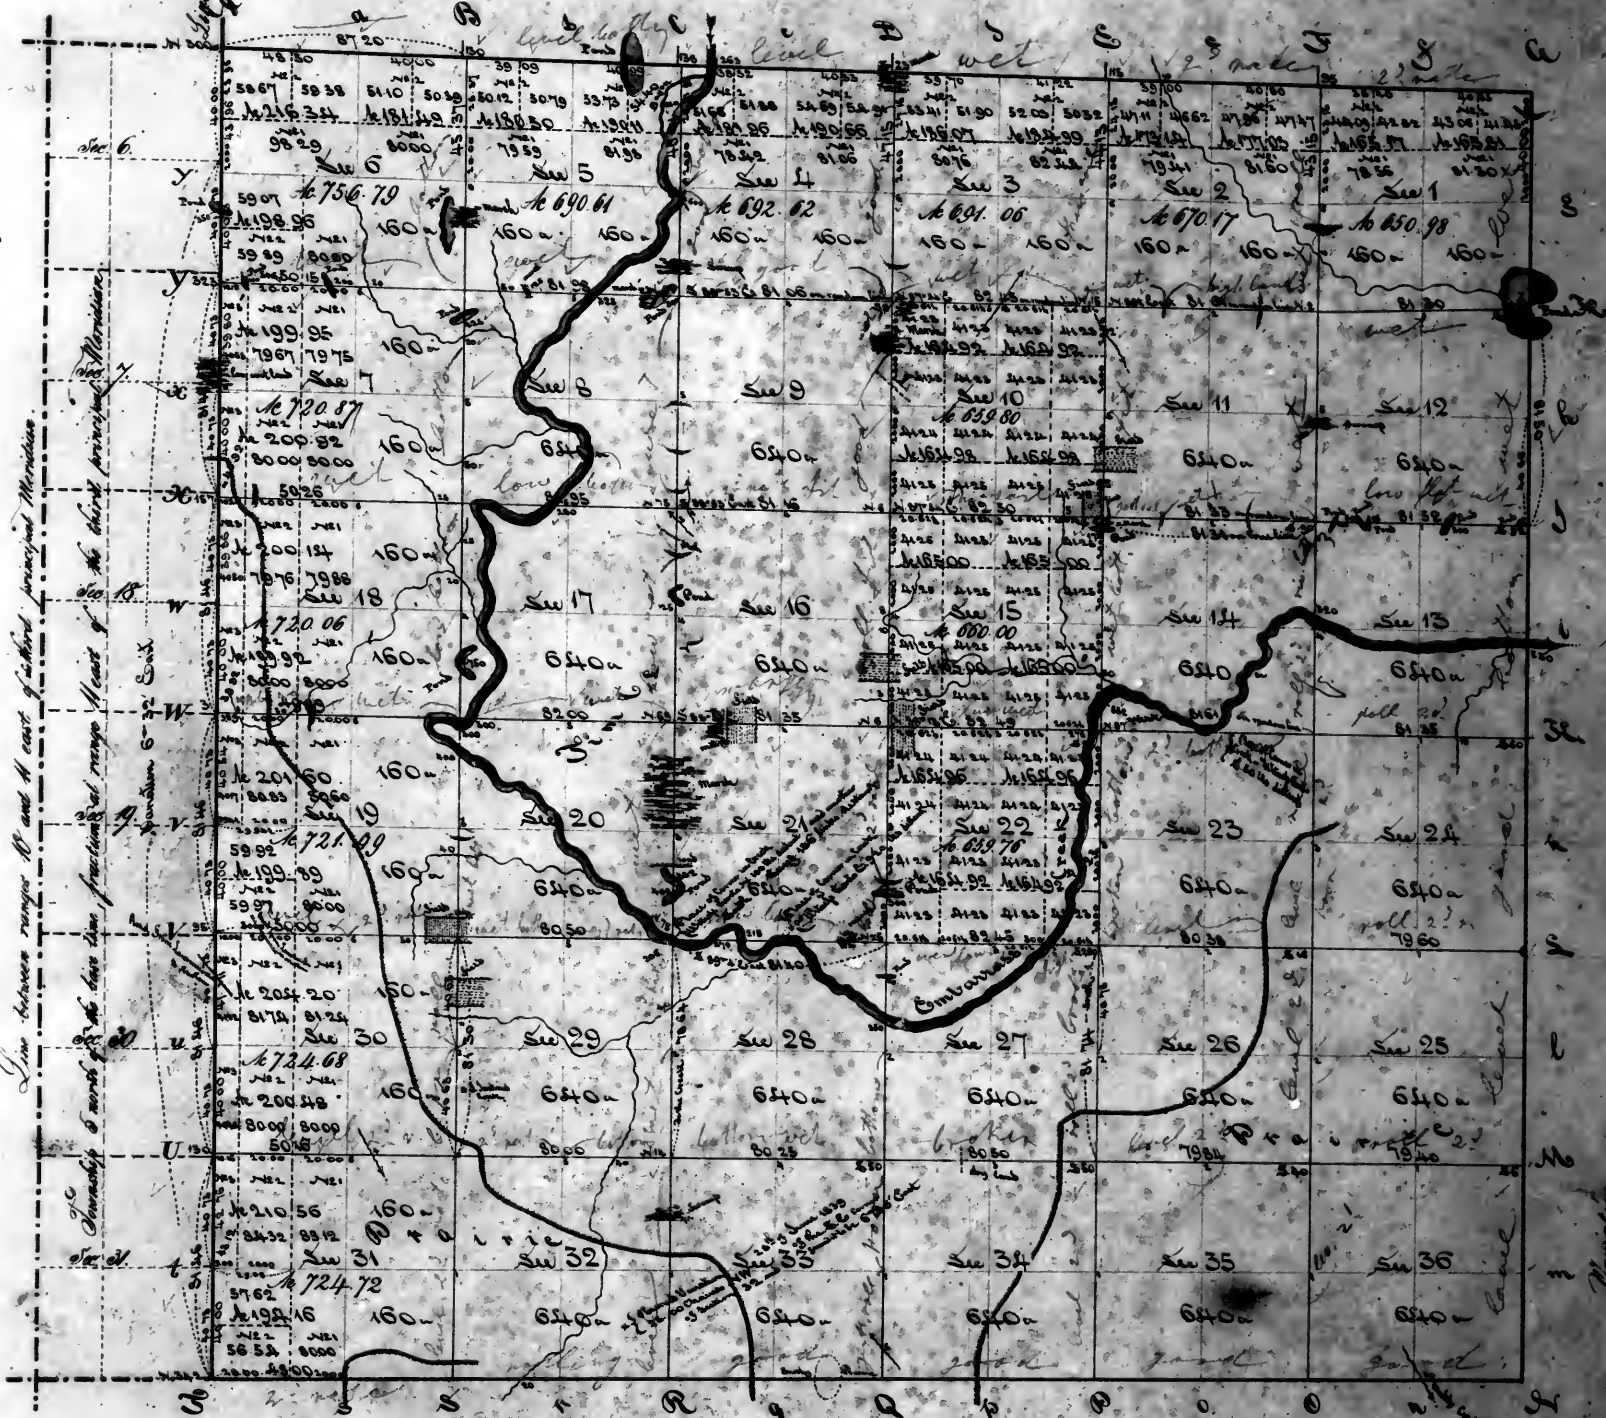

Surveyor General's Office
St. Louis 14th January 1840.

Aggregate Area = 23523.61 acres.

The above plat of township 5 North of the base line Range 14 West of the 2^d principal Meridian is hereby confirmed to the plat & sites of the survey thereof in file in this office which have been examined and approved. The East and West boundaries 6 miles each. The North boundary 6 miles and 8 chains. The South boundary 6 miles and 7.20 chains. And the subdivisions lines between sections 35 & 36 - 25 & 26 - 24 & 25 - 23 & 24 - 13 & 22 - South half of 13 & 14 - 30 & 35 - 26 & 35 - 26 & 27 - 23 & 26 - 22 & 23 - 14 & 23 - 33 & 32 - 27 & 32 - South half of 27 & 28 - 32 & 33 - 28 & 33 - 25 & 29 - 31 & 32 - 30 & 31 - 29 & 33 - 29 & 30 - 19 & 20 and South half of 19 & 20 now surveyed by Daniel Sullivan in the years 1818 & 1819 under contract of the S. & C. of Kansas 1818. In the 2^d & 3^d quarters of 1839 Henry W. Conrad under contract of the 17th of May 1839 approved the plat of the subdivisions lines of the township and resurveyed a part of the East & West boundaries being and some of the subdivisions lines which had been surveyed by Sullivan amounting to 8.9 miles 70.05 chains which was paid for in the 2^d quarter of 1839 and charged in the account amount of the Surveyor General for that quarter. Charles S. S. is more particularly designated in the second paragraph of the plat. The subdivisions lines above designated as surveyed by Sullivan and which were resurveyed by Conrad amounting to 18 miles 1.75 chains have not yet been paid for.

William Milburn
Surveyor General

St. Louis 13th November 1841.



Jos. C. Brown
Surveyor of the public lands for the
St. Louis District






3987
3649
7636

Township 28 North of the base line Range 14 West of 2nd principal Meridian

65

162.74
158.28
24.46


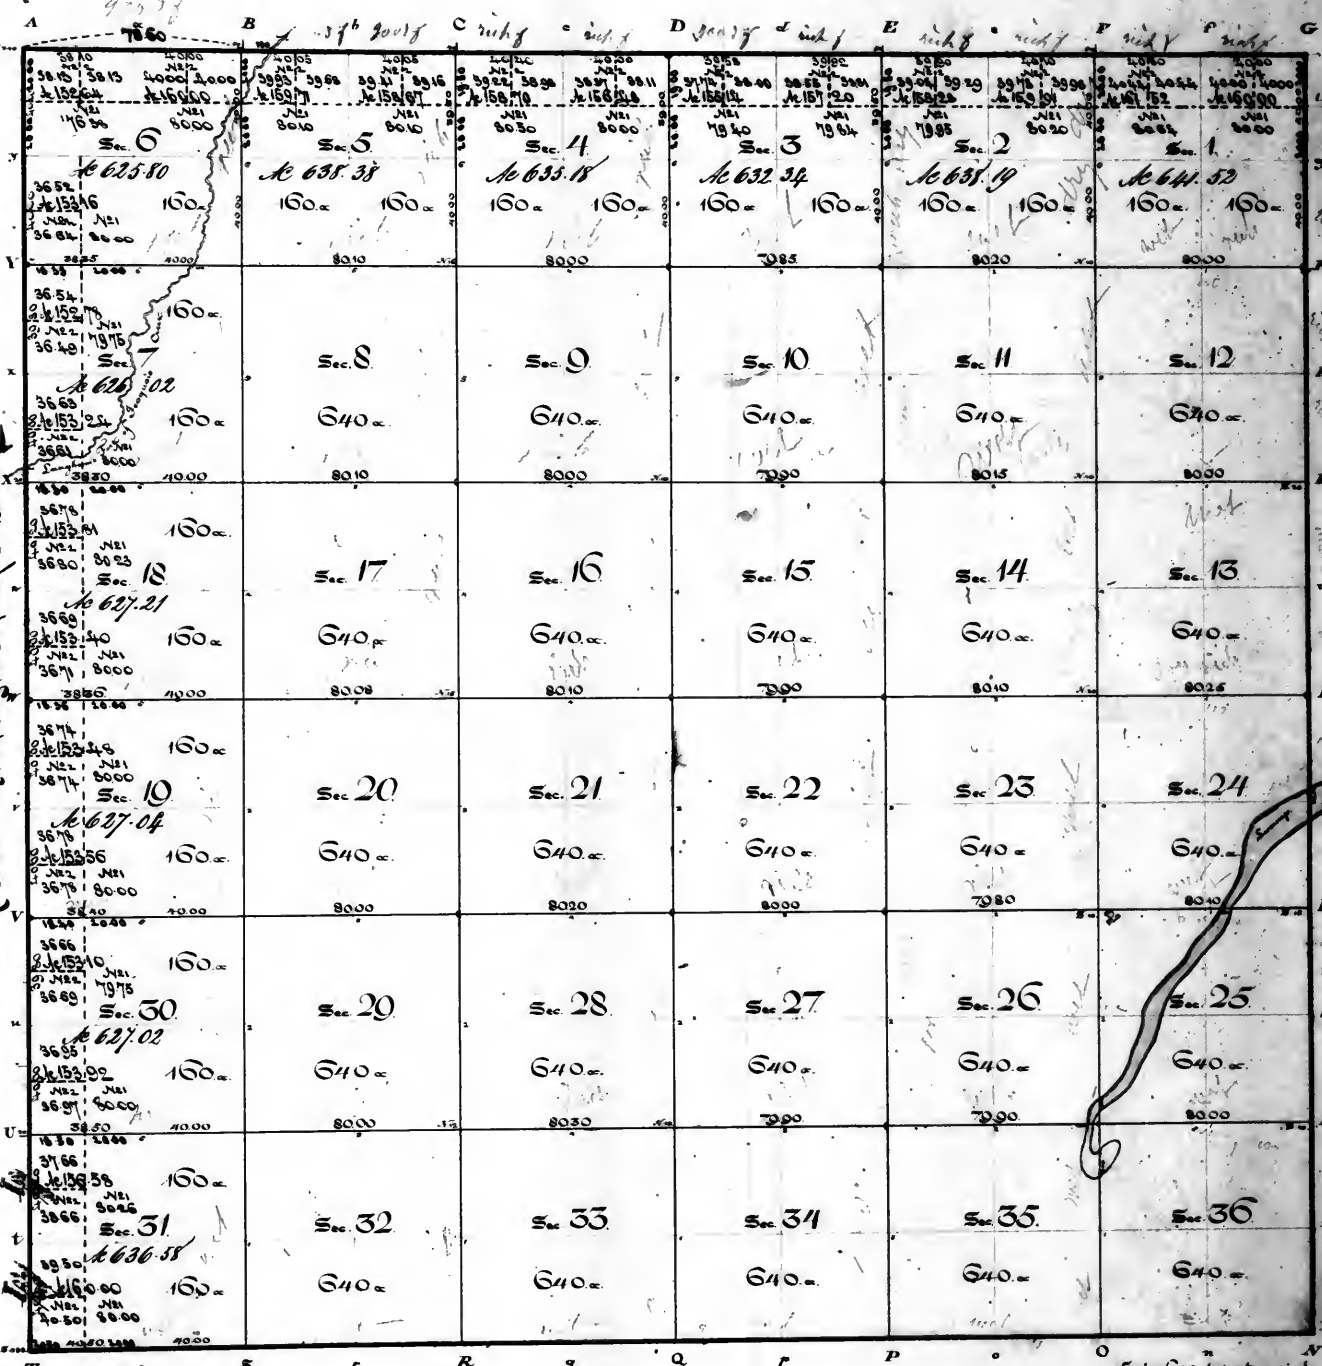


William Melbourn

Aggregate Area = 22955.28 acres.

Surveyor's Office
St. Louis 20th March 1840.


The above Plan of Township 28 North of the base line Range 14 West of 2nd principal Meridian is strictly conformable to the field notes of the survey, stored in file in this Office, which have been examined and approved. The whole boundary 6 miles and 50 rods was surveyed in the 1st quarter of 1832, by J. B. McCall, under instructions of the 17th of April of that year. The west boundary 6 miles, was surveyed in the 4th quarter of 1833. The east boundary 6 miles was surveyed in the 2nd quarter of 1834. The north boundary 5 miles 77.60 chains, and the subdivision line 53 miles 70.34 chains were surveyed in the 4th quarter of 1833, and 2nd quarter of 1834, all by William Lee D. Ewing, under contract of the 15th day of August 1833. These surveys by Ewing were, to the extent noted in the margin, paid for on the 22nd of February 1840; and they will be charged in the account current of the Surveyor General for the present quarter, (being the 1st quarter of 1840) under the general appropriation for surveying the public lands, Voucher N^o 7.

William Melbourn
Surveyor of the public lands in
the State of Illinois & Missouri.

24

Township 29 North of the base line Range 14 West of 2nd principal Meridian

66

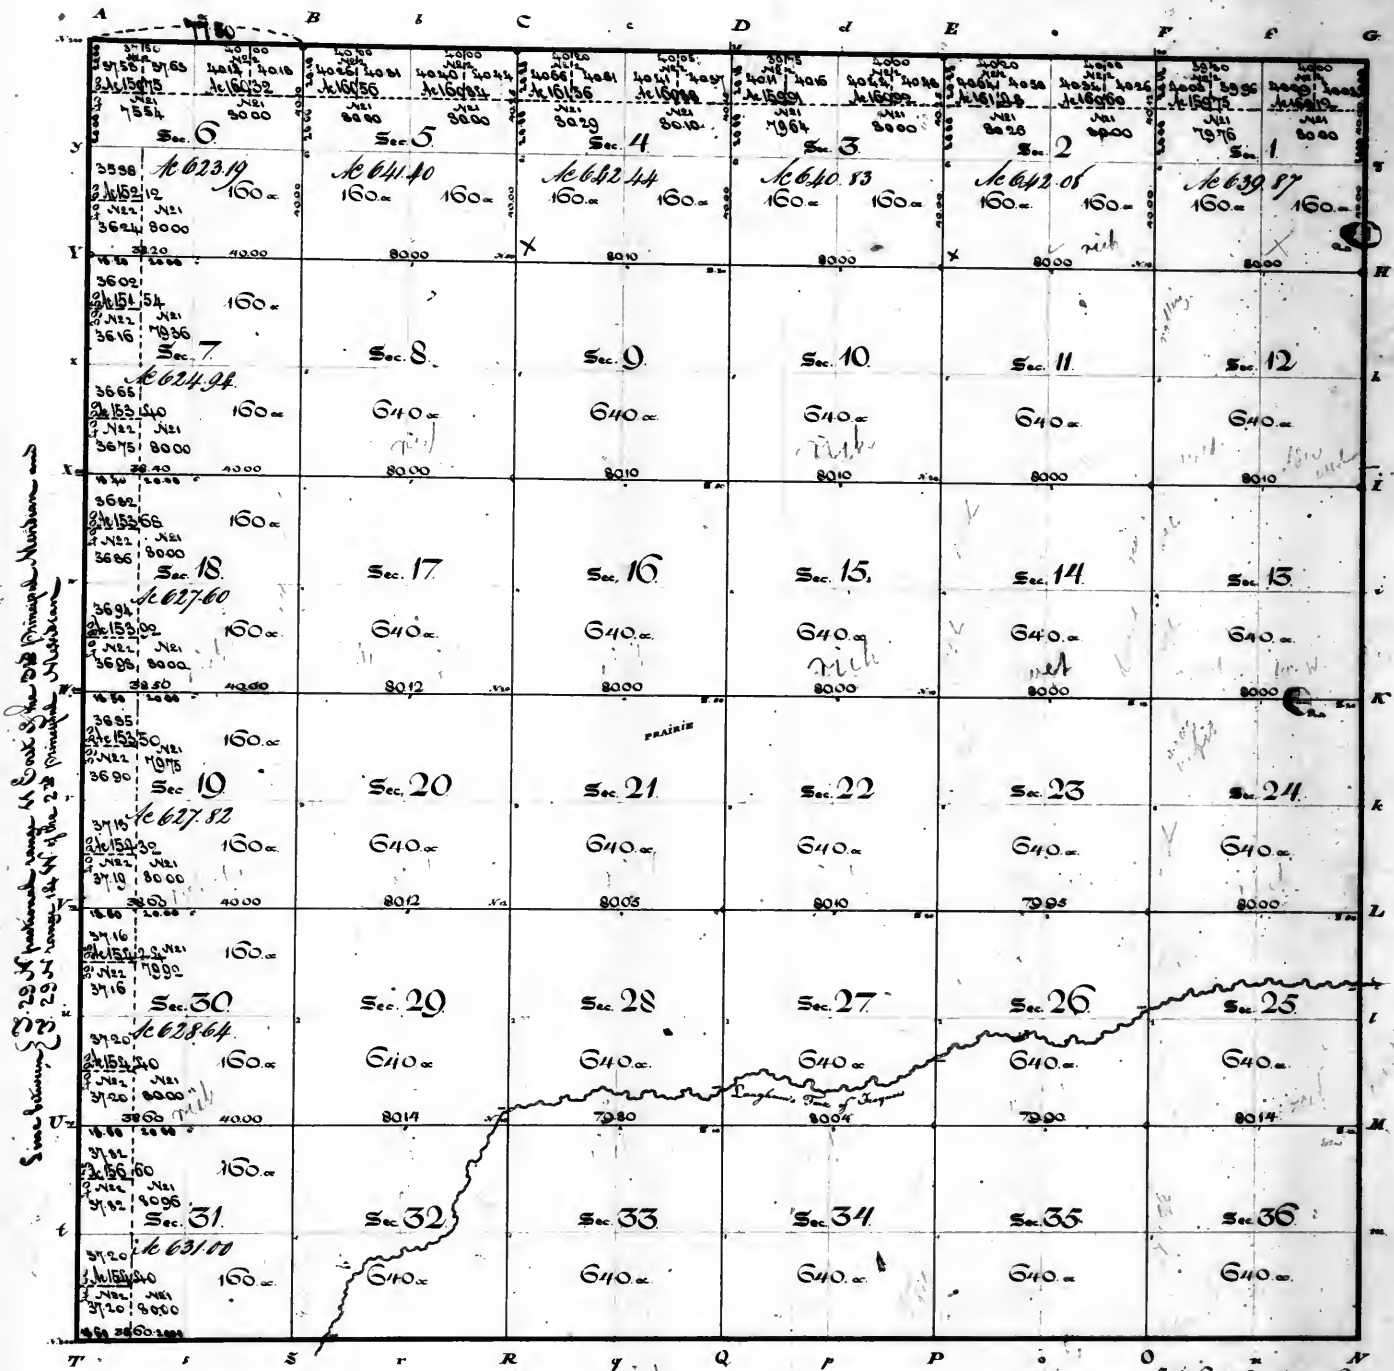

Sec. 1-36 of Township 29 North of the base line Range 14 West of 2nd principal Meridian


William Milburn

Aggregate Area = 22969.81 acres.

North East and West boundaries
Subdivision lines


Surveyors Office
St. Louis 10 March 1840.

The above Plat of Township 29 North of the base line Range 14 West of 2nd principal Meridian is made conformable to the field notes of the survey thereof on file in this Office, which have been examined and approved. The west boundary 6 miles was surveyed in the 1st quarter of 1833. The east boundary 6 miles was surveyed in the 3rd quarter of 1834. The north boundary 5 miles 77.50 chains - the South boundary 5 miles 78.50 chains - and the subdivision lines 5.9 miles, 73.53 chains were surveyed in the 4th quarter of 1833 and 2nd quarter of 1834, all by William Lee D. Ewing, a true contract of the 15th day of August 1833. Therein was paid for, to the extent noted in the margin, on the 23rd day of February 1840, and they will be charged in the account current of the Surveyor General for the present quarter (being the 1st quarter of 1840) under the general appropriation for surveying the public lands (Under 2nd).

William Milburn
Surveyor of the public lands
in the State of Missouri.

[Signature]

Township 30 North of the base line Range 14 West of 2^d principal Meridian

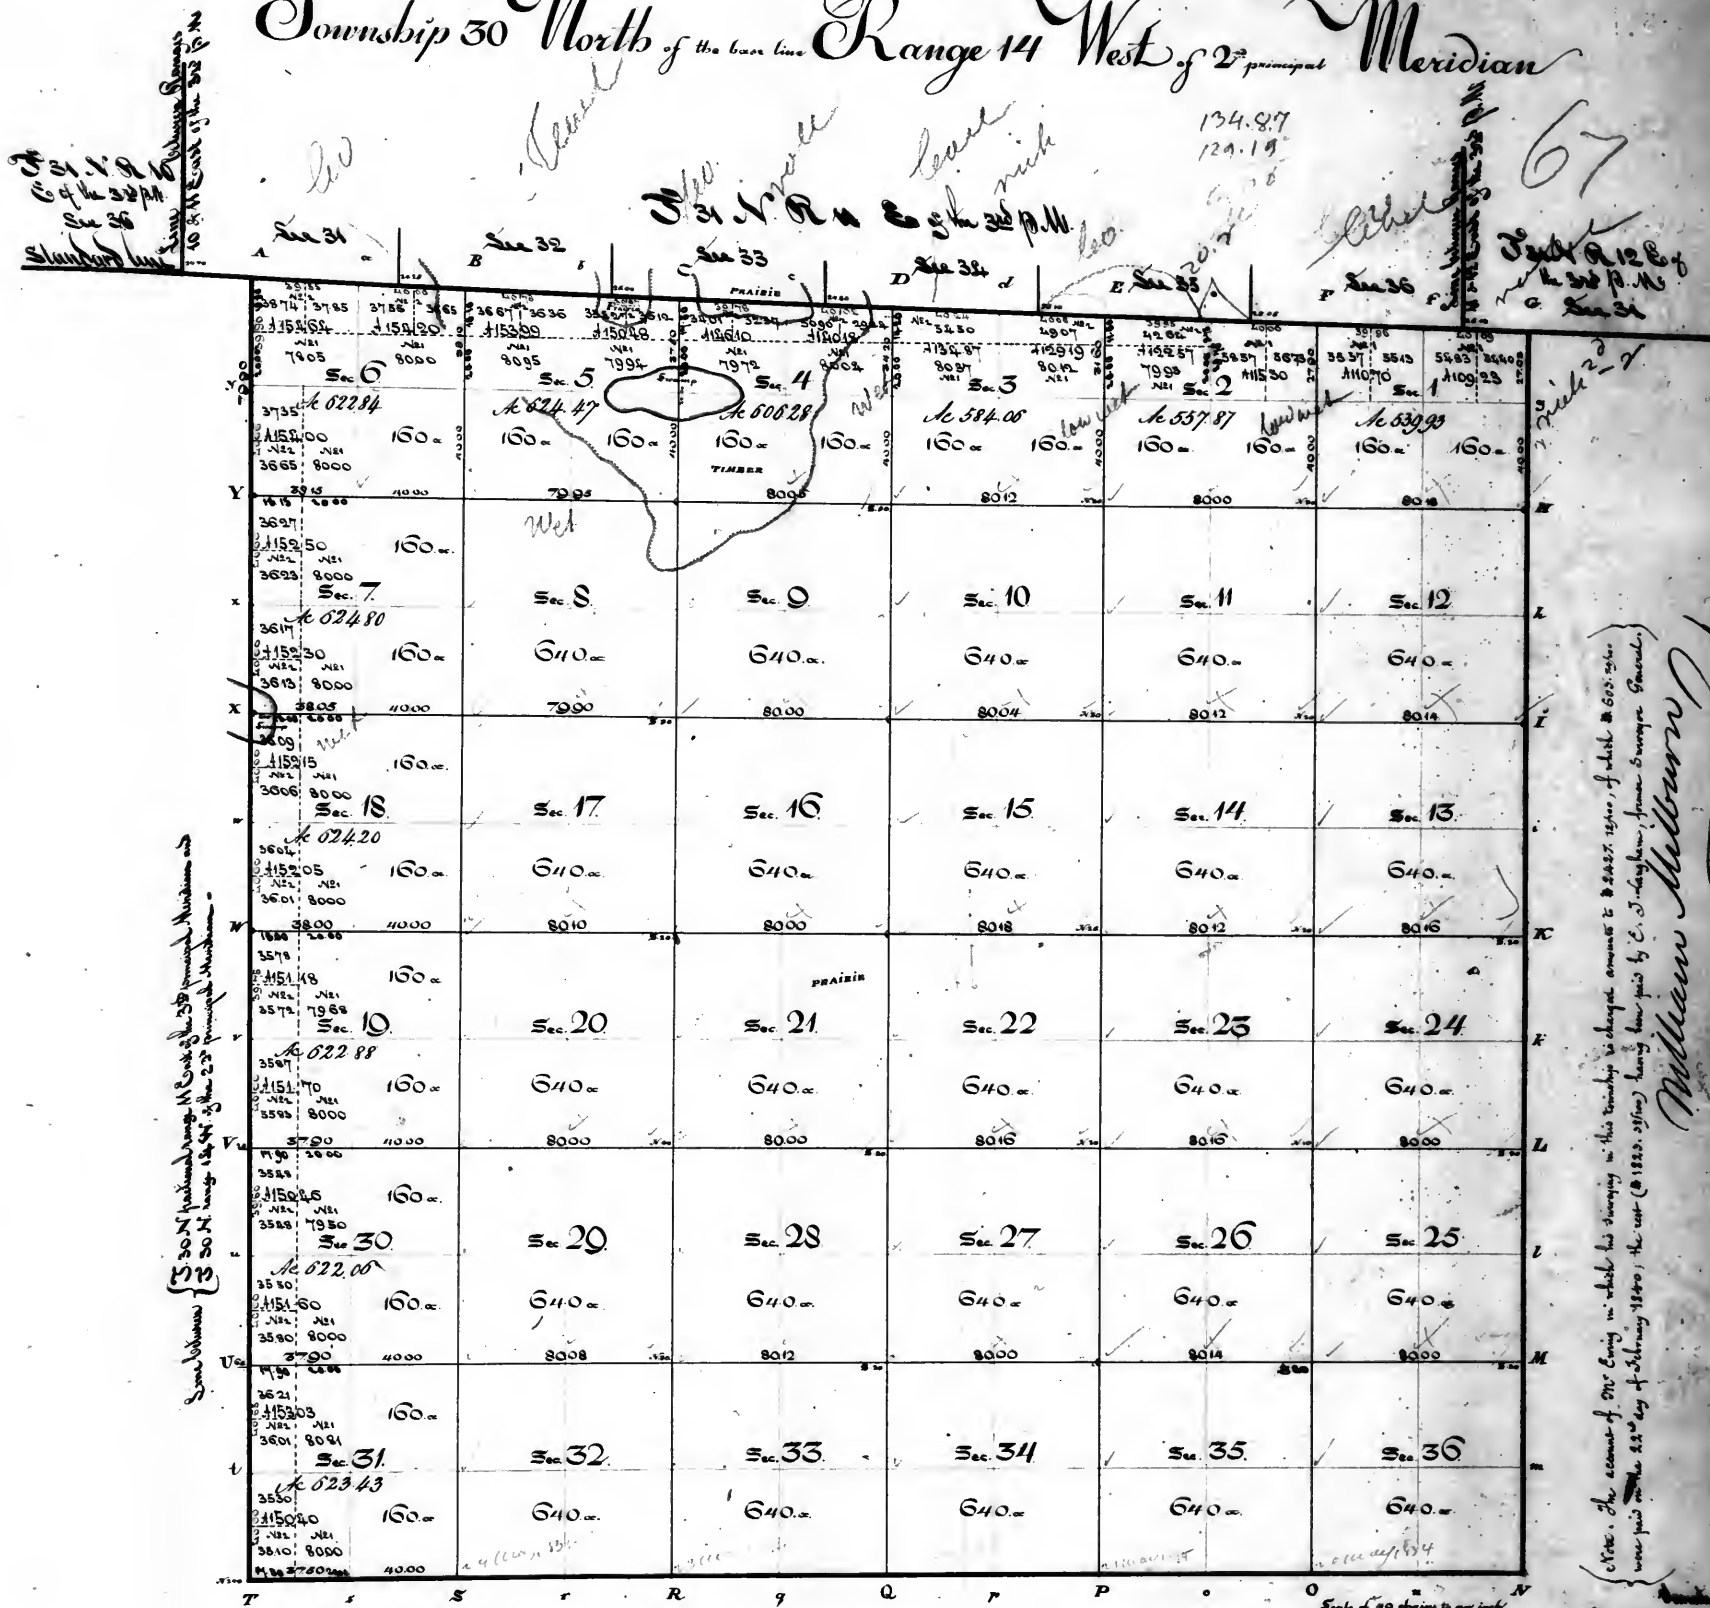

Survey of 30 N. Township 30 N. Range 14 W. of 2^d principal Meridian -
 30 N. Range 14 W. of 2^d principal Meridian -

1870. The amount of 9100 acres in which has been surveyed in this township is charged amount to \$22,652.82, of which \$655.94 was paid for the 22^d day of February 1870, the rest (\$22,000.00) being due from C. J. Layman, from Surveyor General.

William Melbourn

Aggregate Area - 22,652.82 acres

Surveyors Office
 St. Louis, 20 March 1870.

The above Part of Township 30 North of the base line Range 14 West of 2^d principal Meridian is hereby confirmed to the field notes of the survey thereof - file in this Office, which have been measured and approved. The south boundary was surveyed in the 4th quarter 1833 by Daniel W. Backus under contract of the 20th of October of that year - The South boundary 5 miles 77.50 chains was surveyed in the 4th quarter of 1833 - and 2^d quarter of 1834 - the West boundary 5 miles 79.90 chains, the east boundary 5 miles 67.03 chains and the subdivision lines 5.9 miles 41.02 chains, were surveyed in the 2^d quarter of 1834 - all by William Lee L. Enig, under contract of the 15th day of August 1833 - The Survey by Enig, was to the extent noted on the margin paid for, on the 22^d of February 1870; and they will be charged in the account current of the Surveyor General for the present quarter (being the 1st quarter of 1870) under the general appropriation for surveying the public lands, Voucher No. 7

William Melbourn
 Surveyor of the public lands
 in the State of Illinois & Missouri

U. S. DEPARTMENT OF THE INTERIOR,
GENERAL LAND OFFICE,

WASHINGTON, D. C., May 5, 1900.

ADDRESS ONLY THE
COMMISSIONER OF THE GENERAL LAND OFFICE.

Asking for copies of
plats.

Hon. Auditor of State,
Springfield, Ills.

Sir:

This office has copies of diagrams on file, of
T. 48 N., R. 18 E., Third Prin. Mer., one approved January
18, 1841, and the other October 8, 1848. The originals,
however, cannot be found, after careful search. Please
cause to be made certified copies from the plats on file
in your office, placing your certificates directly on the
face of the plats. I inclose frank and also franked envel-
ope, and thank you for the favor of furnishing copies to
replenish files.

Very respectfully,


J. W. Bond

Assistant Commissioner.

cdp

VOL. 31

Plat of Township no. 1 South of the Base line in Range no. 1 West of the 3^d Principal Meridian

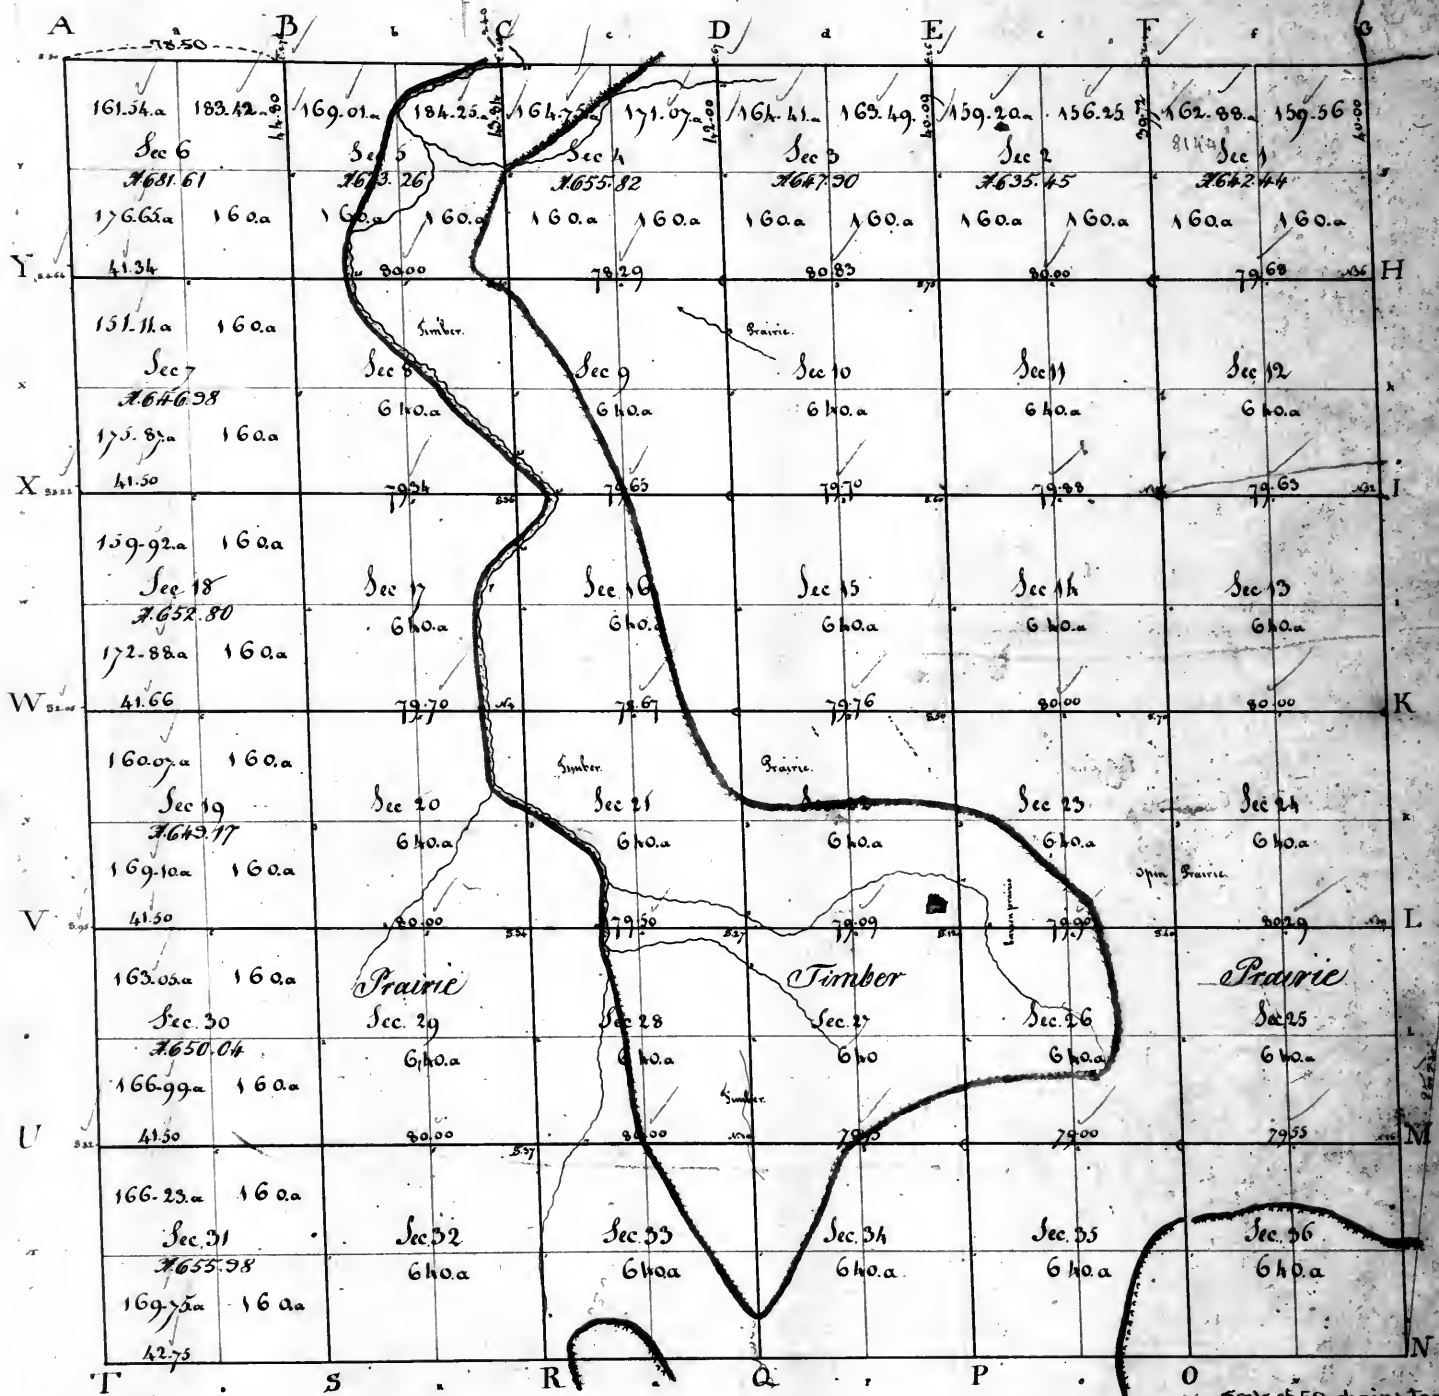

Surveyor's Office


St. Louis 15th January 1835.

The above plat of Township 1 South of the Base line Range 1 West of the 3^d Principal Meridian is conformable to the field notes of the survey thereof on file in this Office.

E. J. Langham

Scale of 40 chains to an inch
Aggregate area = 23191.45 acres

Plat of Township 16:2 South of the Base line in Range 11 West of the 3^d Principal Meridian.

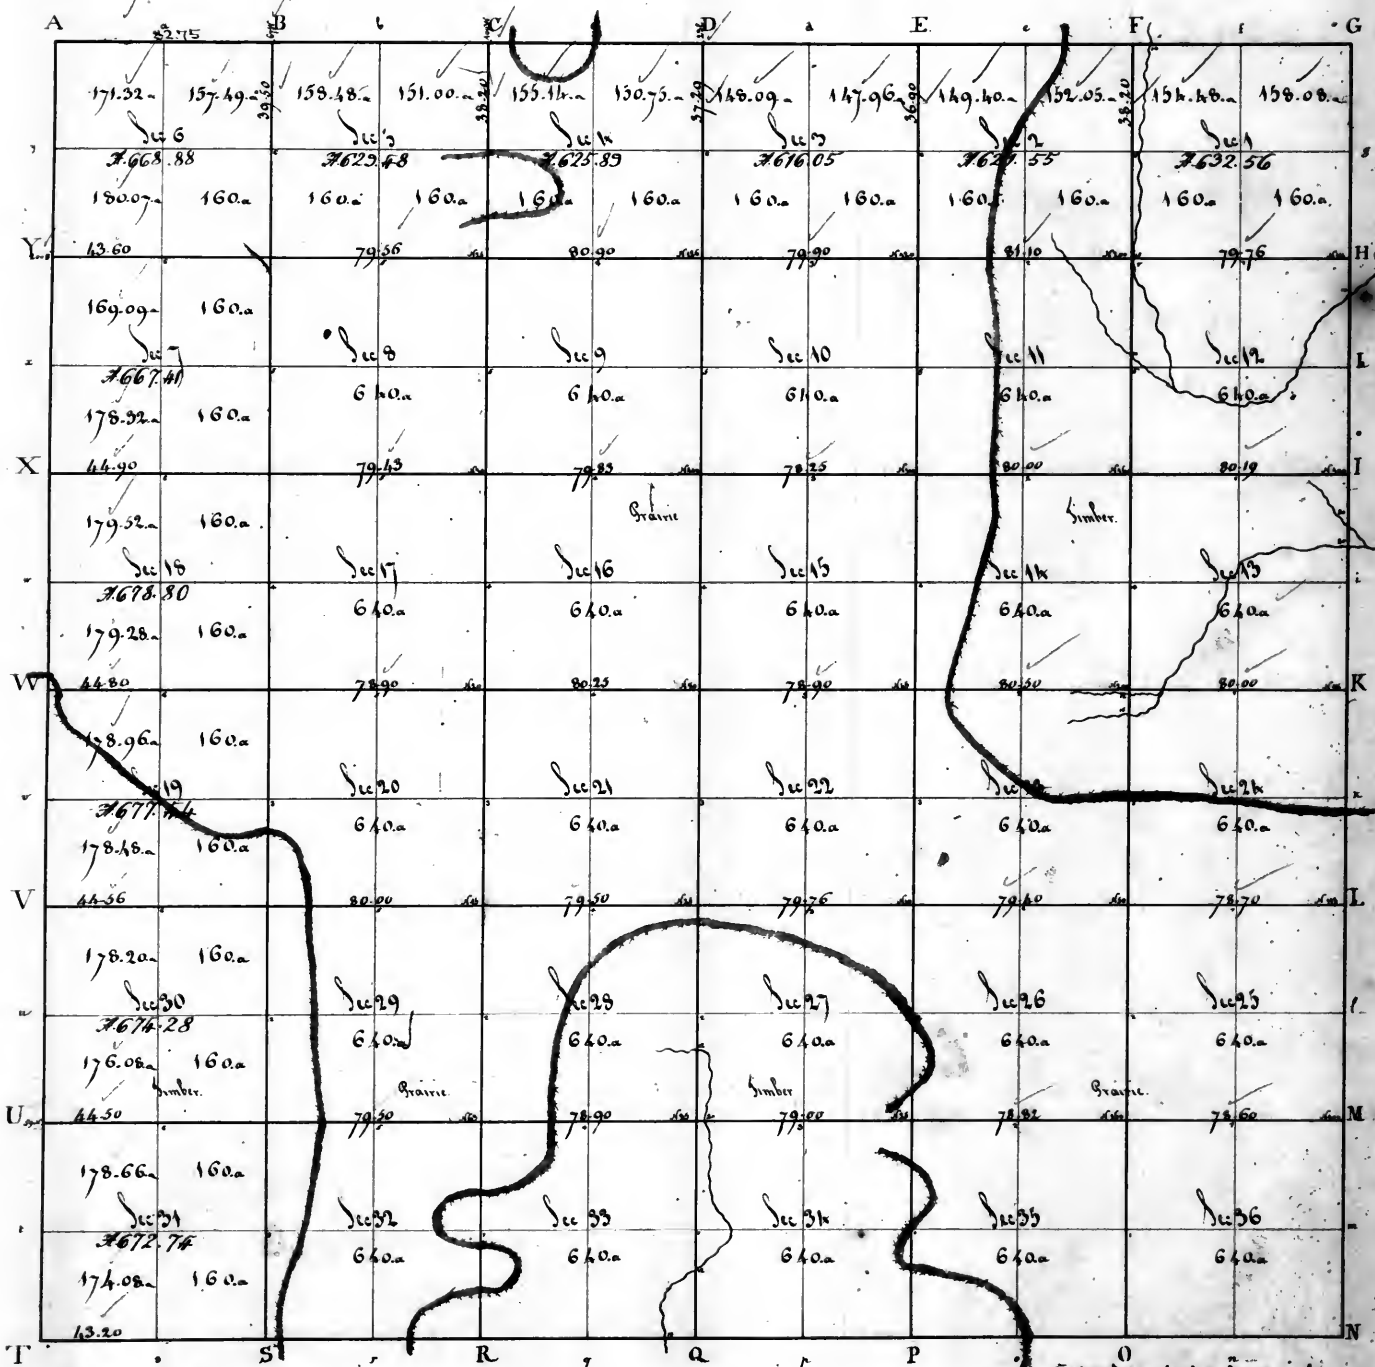


Surveyors Office

St. Louis 19th January 1835

The above plat of Township 16:2 South of the Base line Range 11 West of the 3^d principal meridian is conformable to the field notes of the survey thereof on file in this Office.

E. J. Longham

Plat of Township 15:3 South of the Base line, in Range 1 West of the 3^d principal Meridian

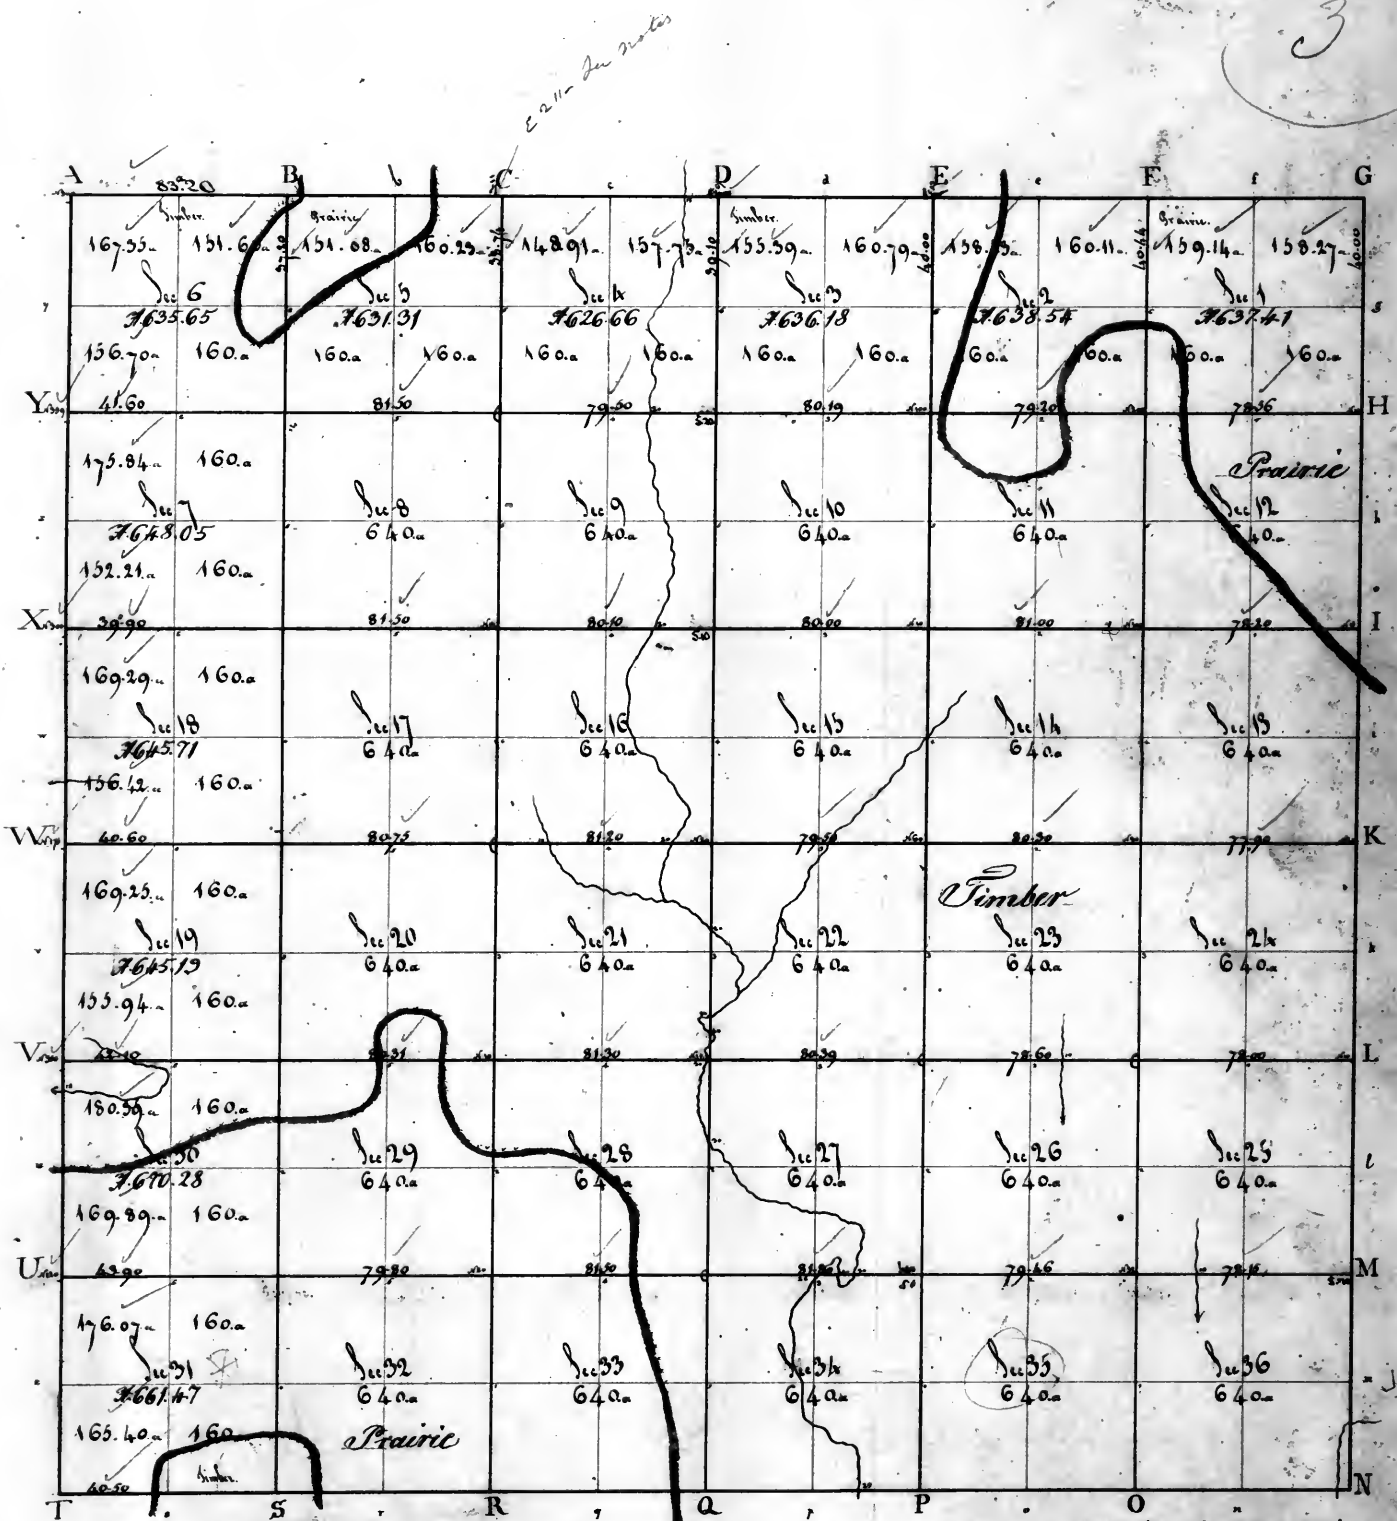

Surveyor's Office


St. Louis 19th January 1835.

The above plat of Township 15:3 South of the Base line Range 1 West of the 3^d principal Meridian is conformable to the field notes of the Survey thereof on file in this Office

E. J. Longham

Scale of 50 chains to an inch
Aggregate area 23076.45 acres

Plat of Township 11th 4 South of the Base line in Range 1st West of the 3rd principal Meridian.

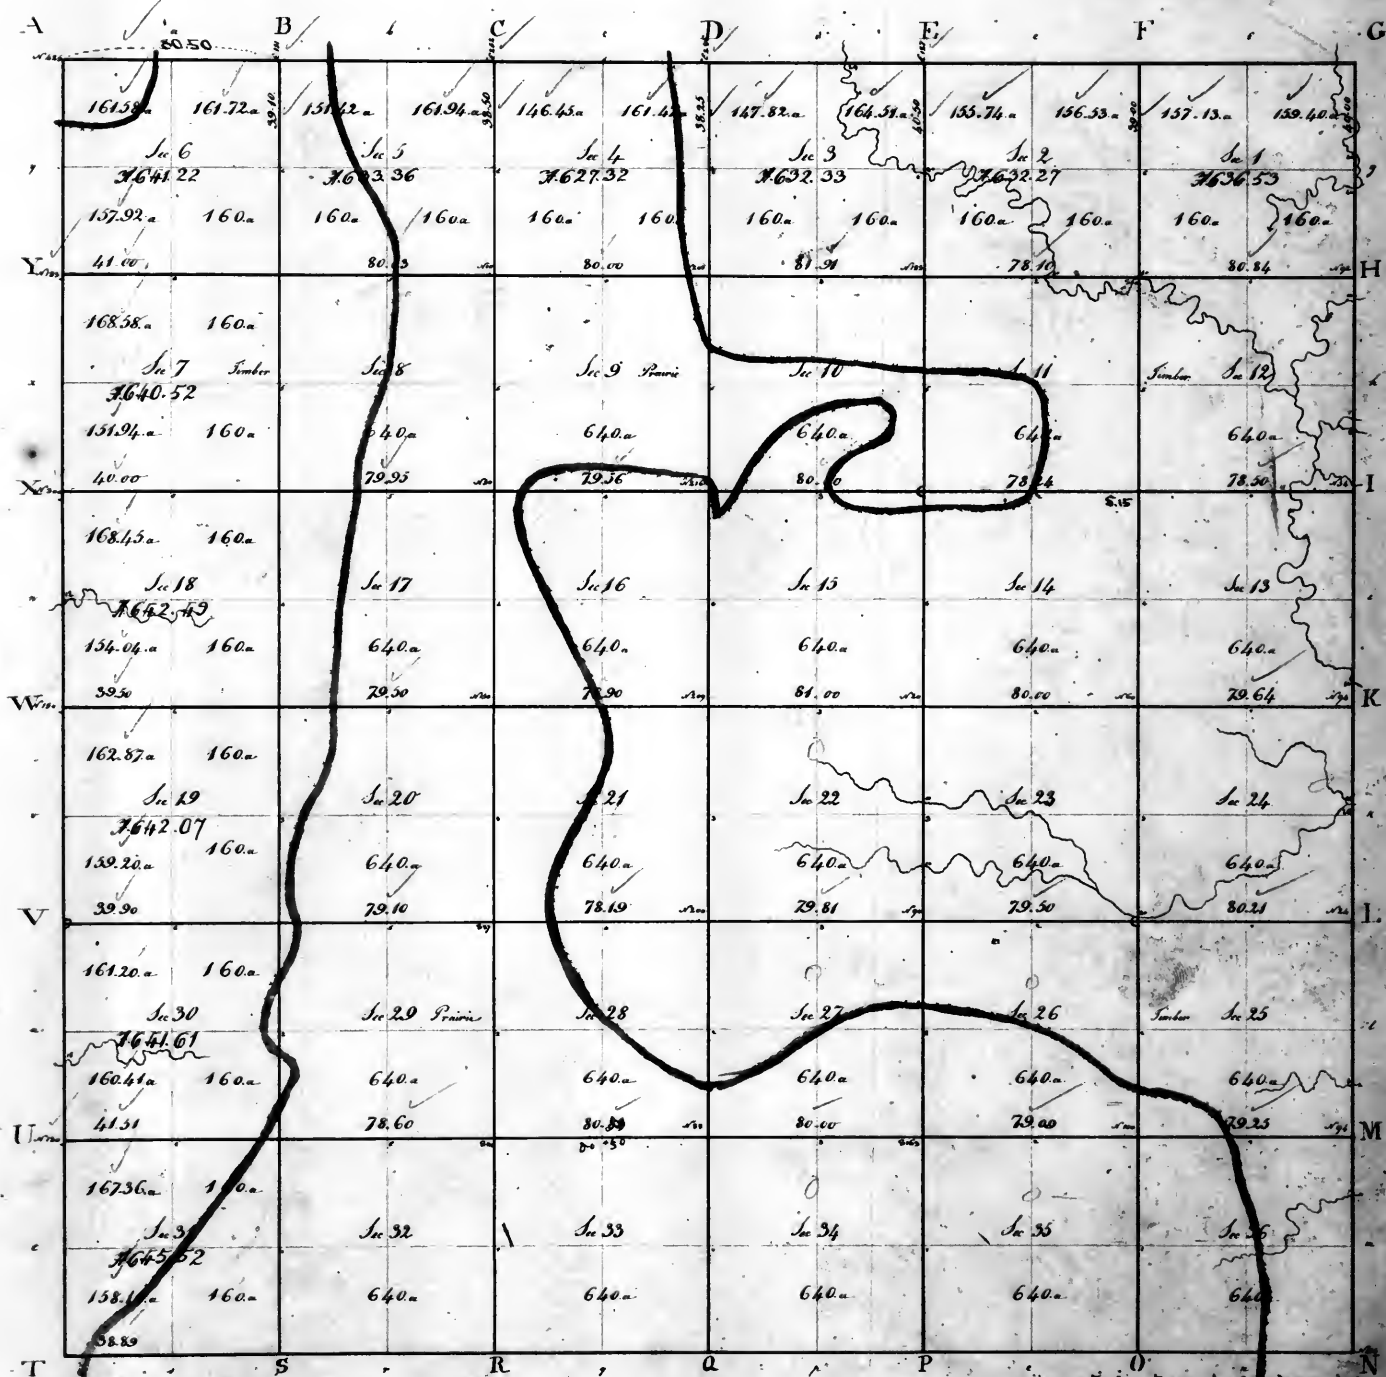


Surveyors Office

St Louis 17th January 1835.

The above plat of Township 11 South of the Base line Range 1 West of the 3rd principal meridian is conformable to the field notes of the survey thereof file in this Office.

E. J. Laughlin

Plat of Township n: 5 South of the Base Line Range n: 1 West of the 3^d Principal Meridian

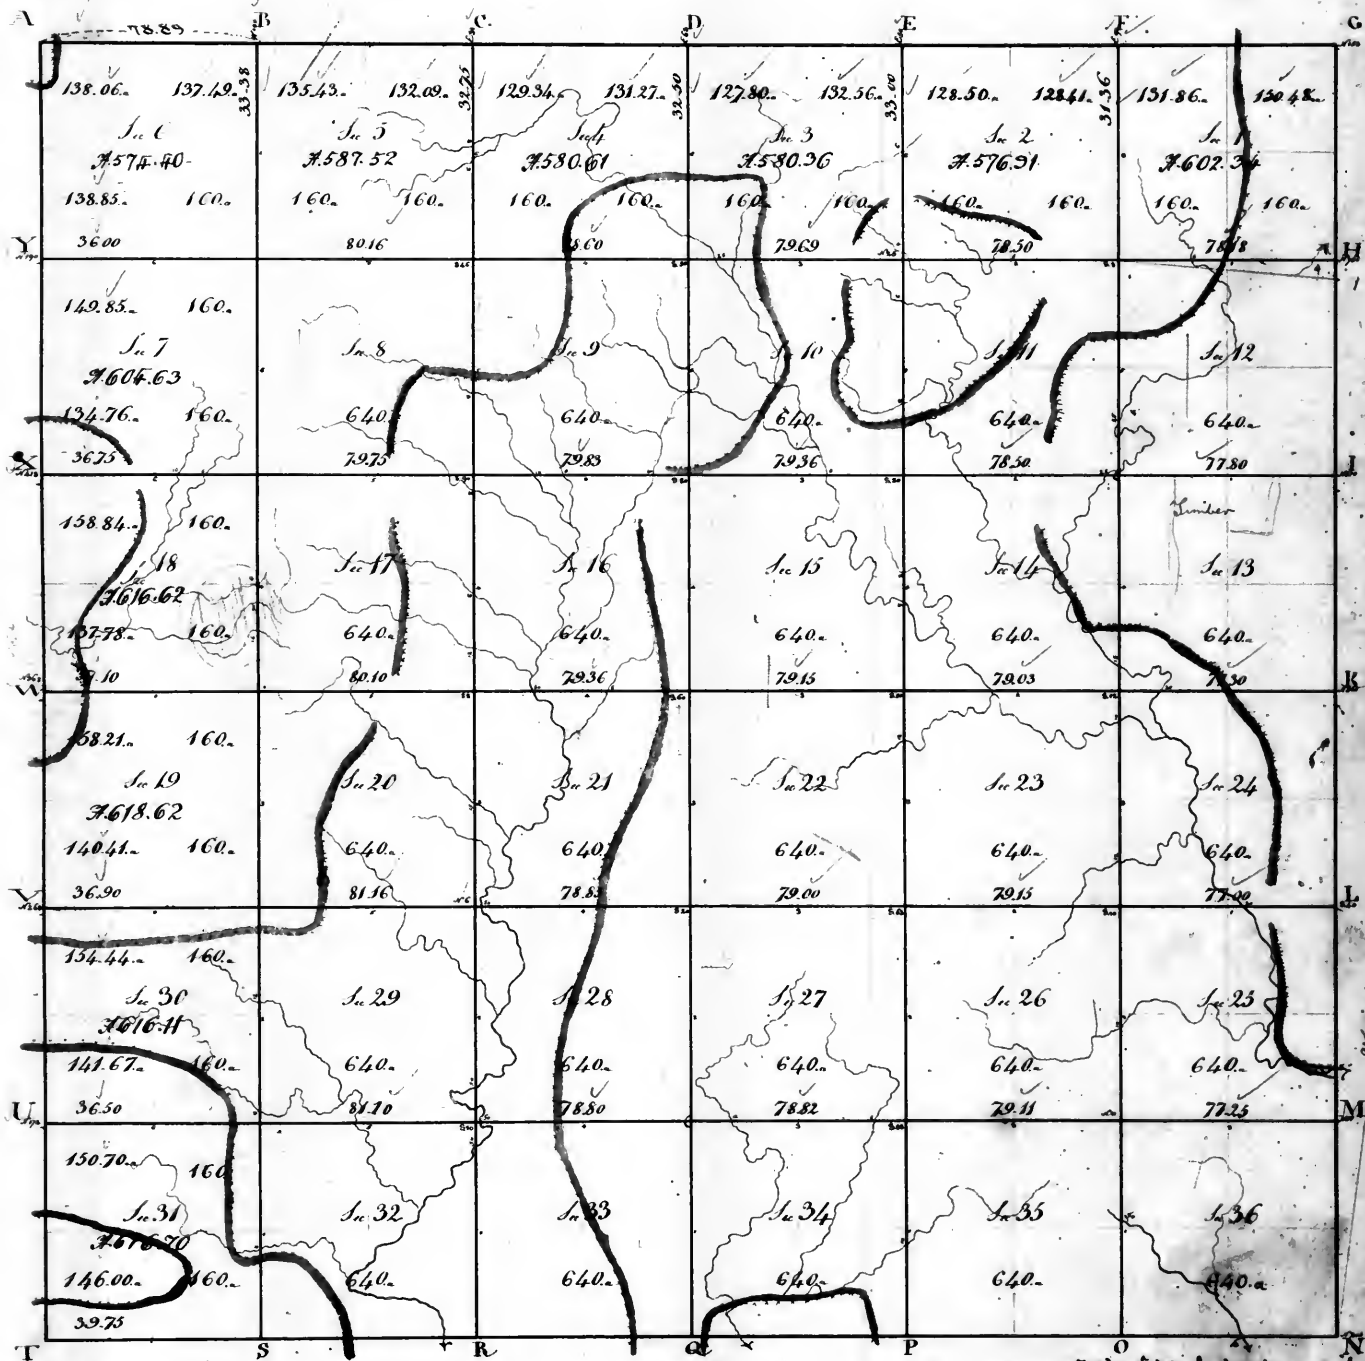

Surveyors Office


St. Louis 17th January 1835.

The above plat of Township 5 South of the Base line Range 1 West of the 3^d principal meridian is conformable to the field notes of the survey thereof on file in this Office.

E. J. Sangham

Map of Township n: 6 South of the Base line in Range n: 1 West of the 3 principal Meridian.

6

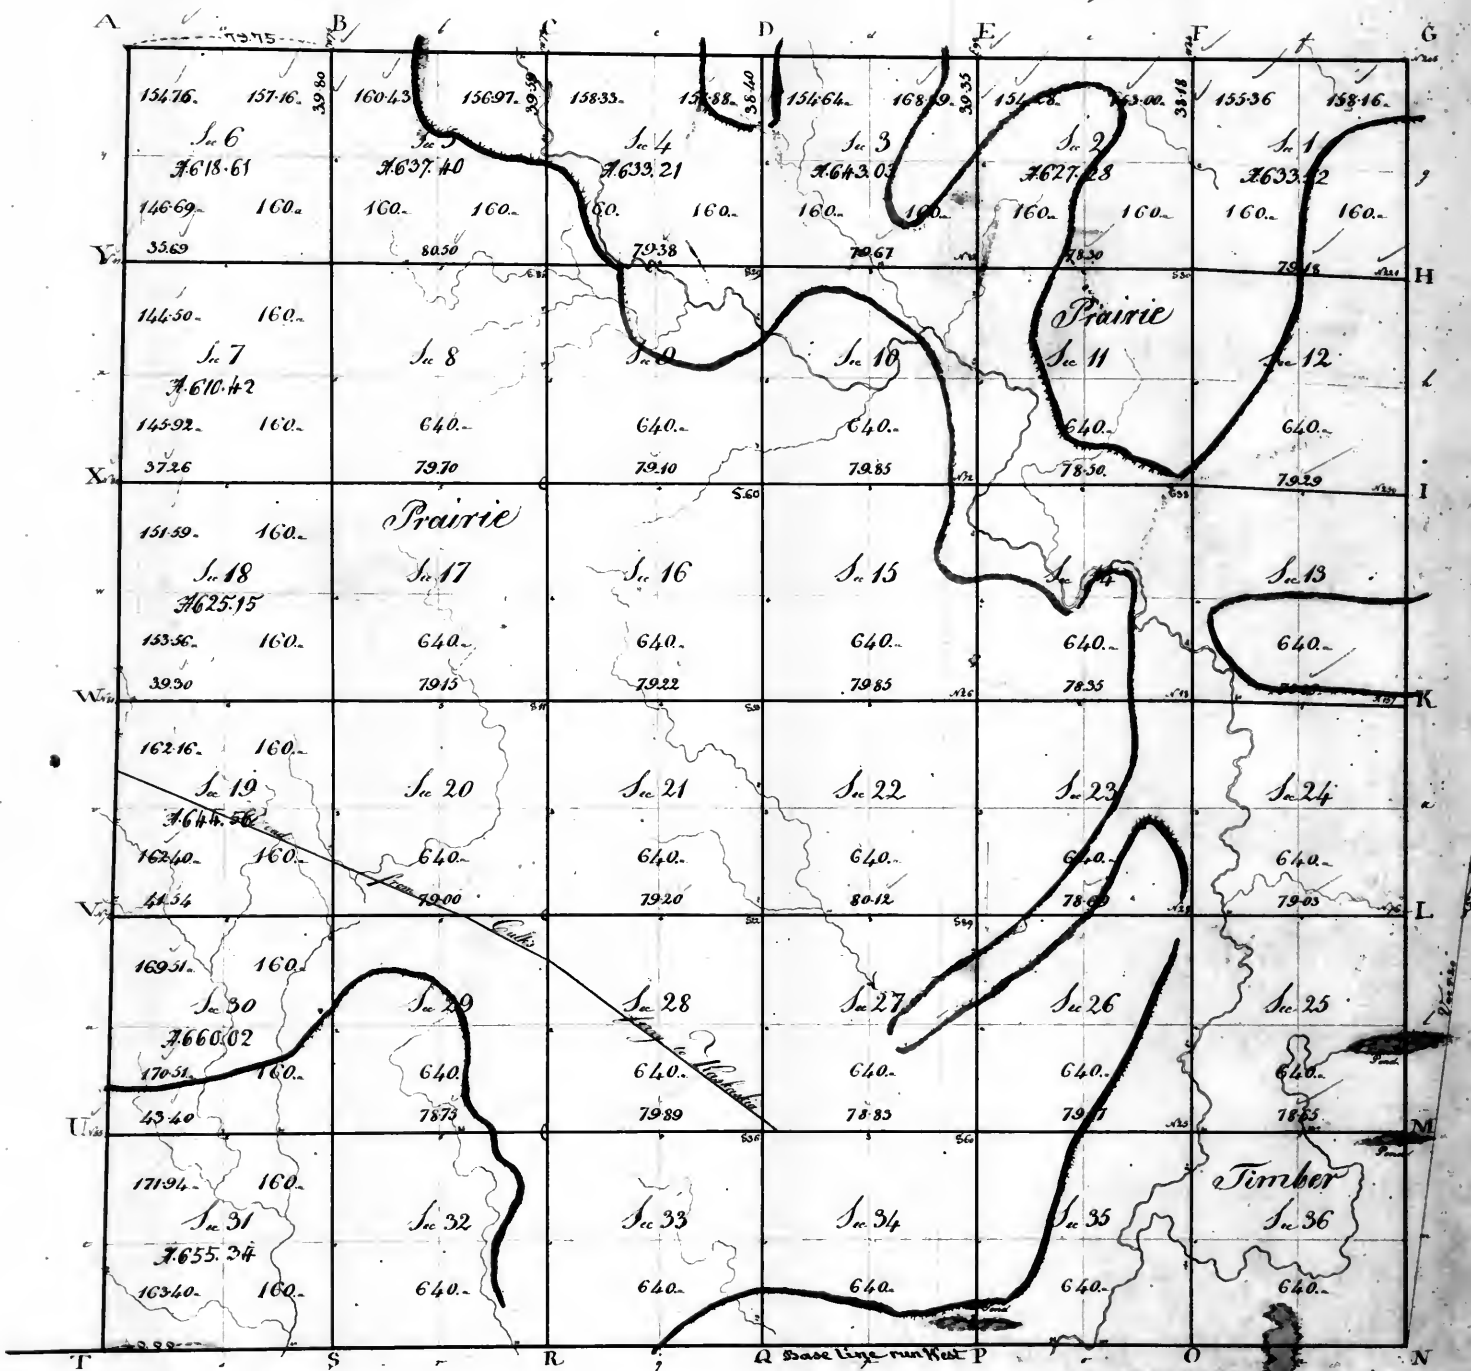


Surveyors Office
St Louis 17th January 1835.

The above plat of Township 6 South of the Base line Range 1 West of the 3 principal Meridian is conformable to the field notes of the survey thereof file in this Office

E. J. Sanghoun

Plat of Township n. 7 South of the Base line, in Range n. 1 West of the 3rd principal meridian.

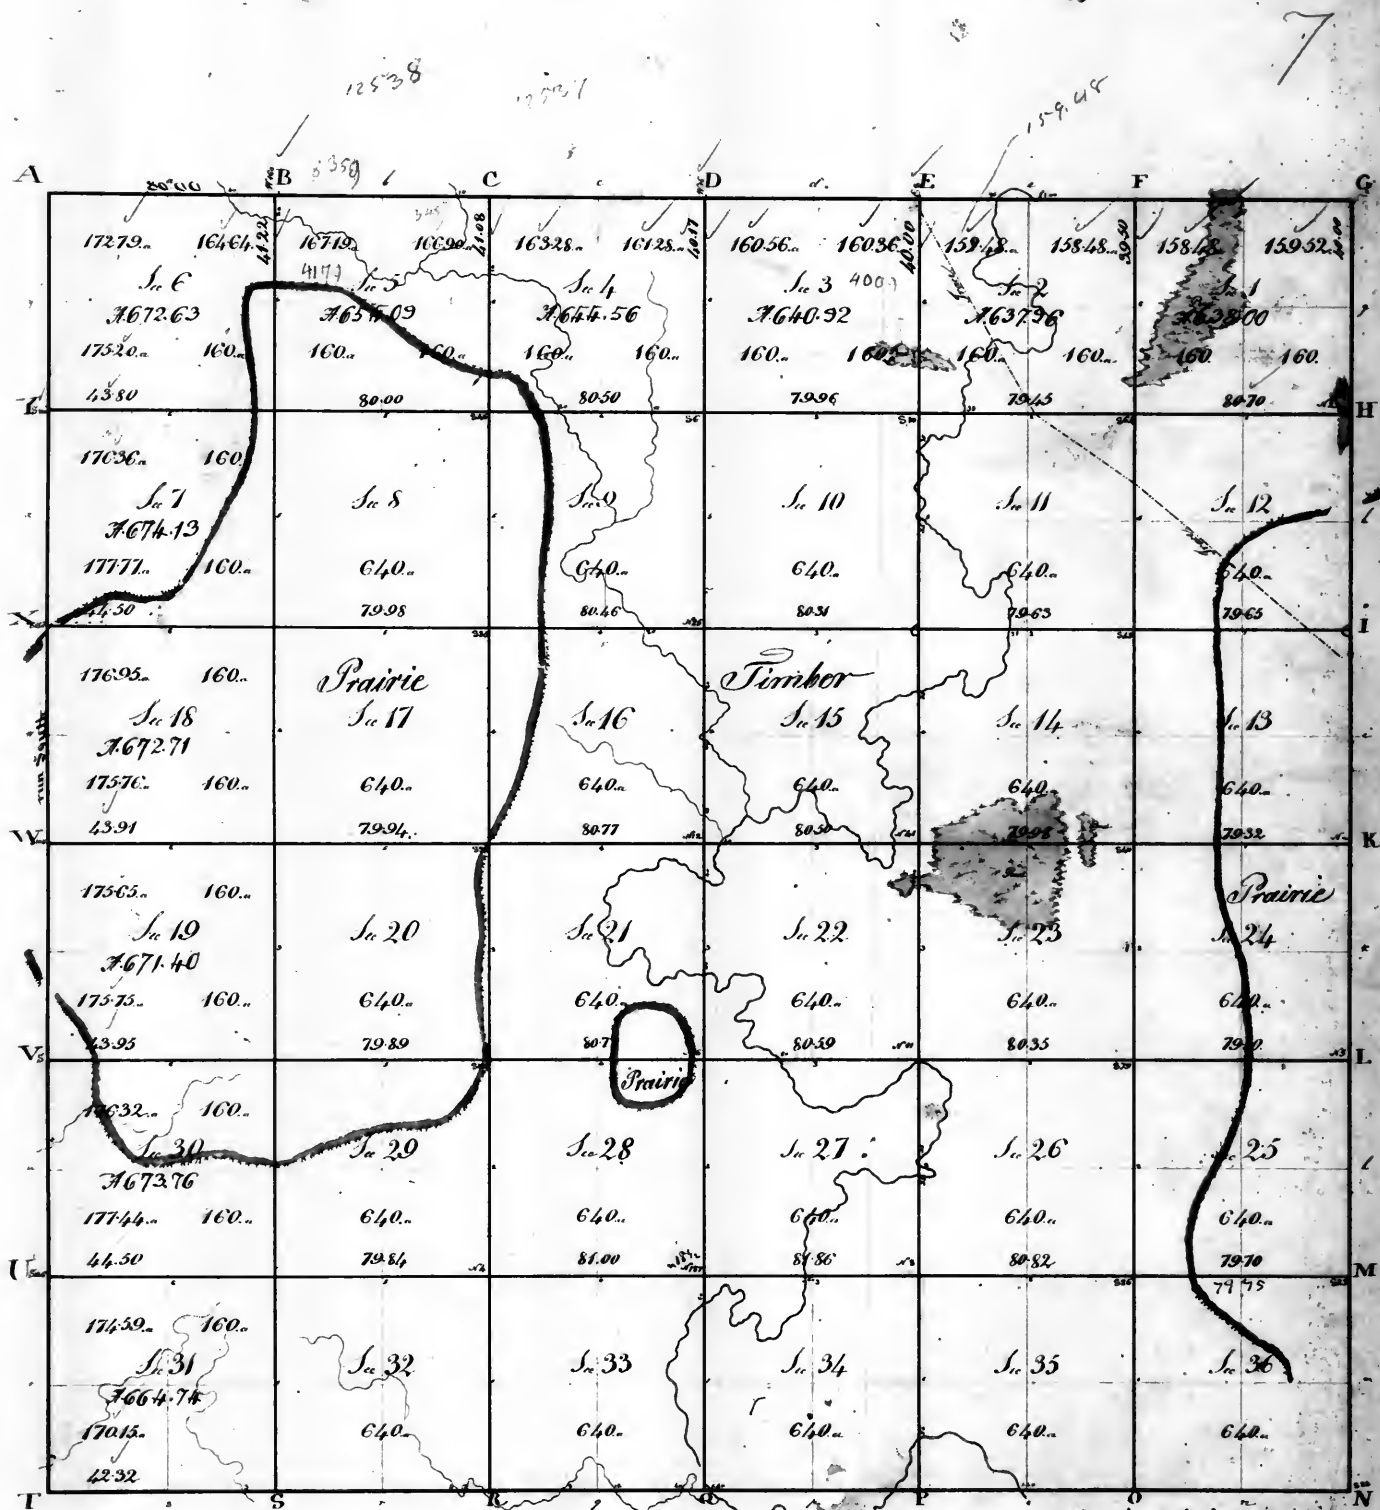


Surveyors Office
St Louis 19th January 1855.

The above plat of Township n. 7 South of the Base line Range n. 1 West of the 3rd principal meridian is conformable to the field notes of the Survey thereof on file in this Office.

E. J. Sargham

Plat of Township 18 South of the Base line in Range 11 West of the 3rd principal Meridian.

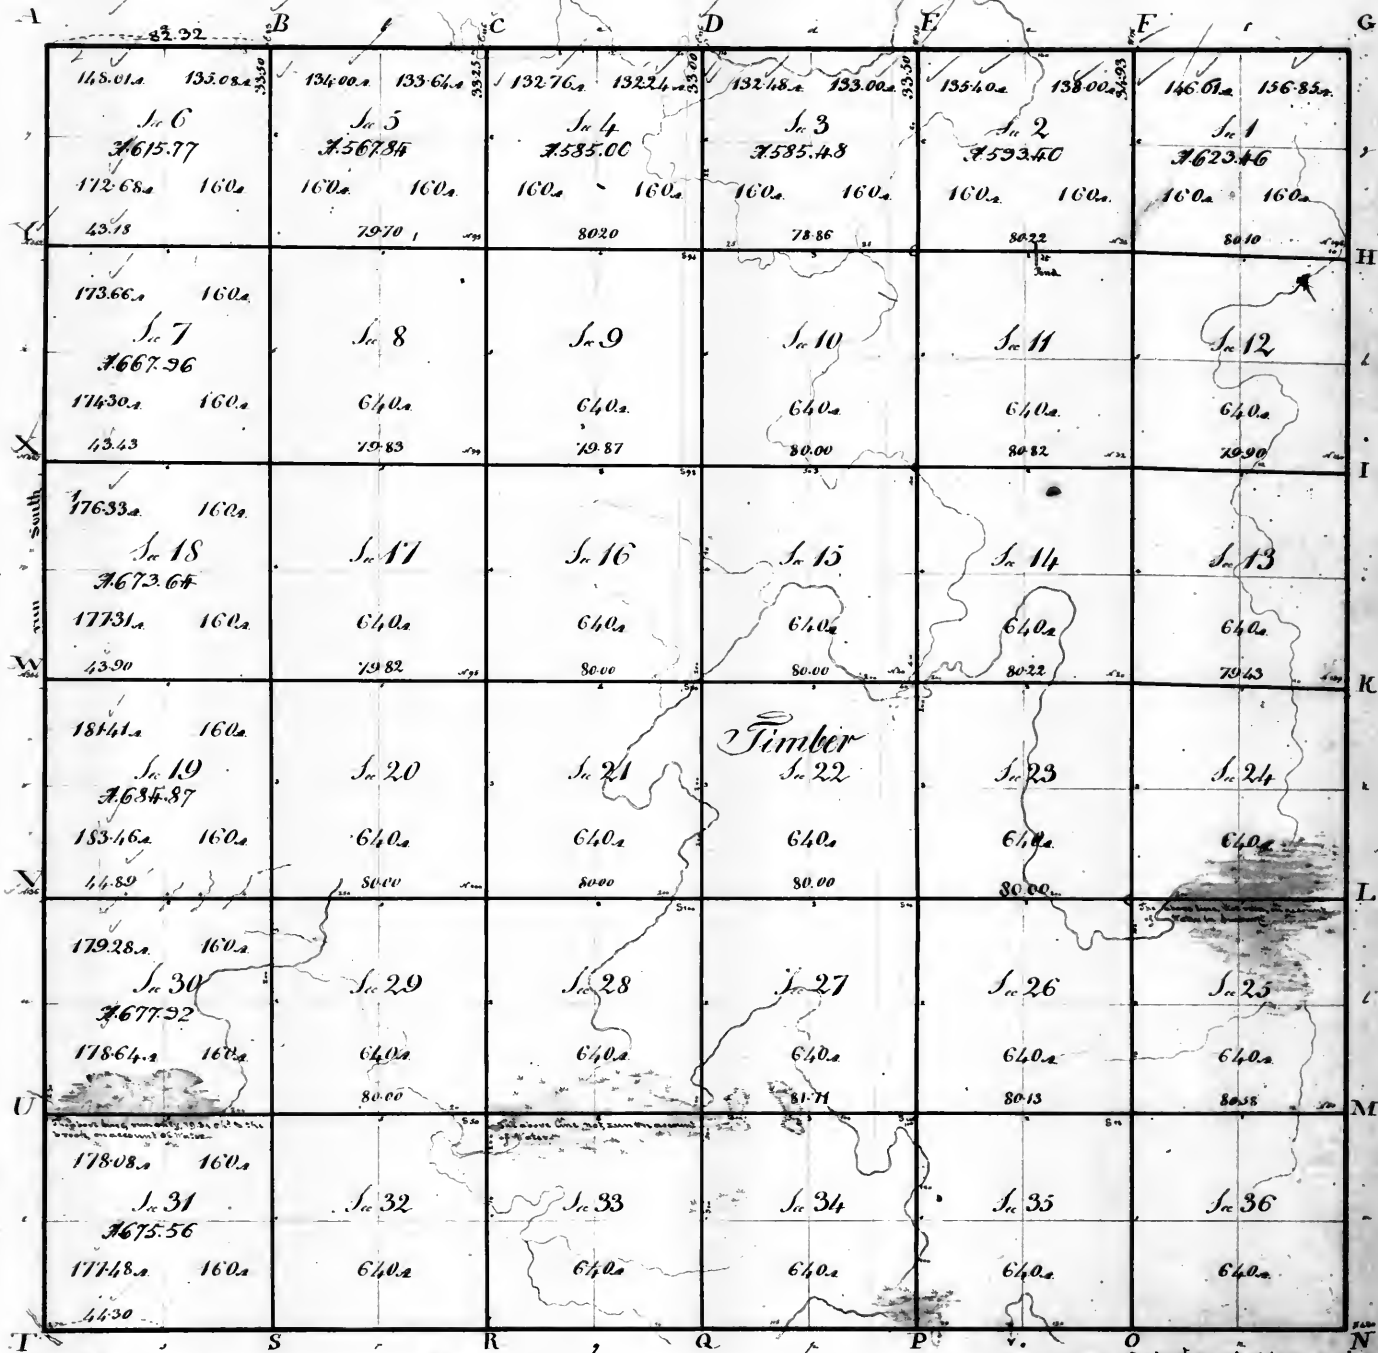

Surveyor's Office


St. Louis 17th January 1835.

The above plat of Township 18 South of the Base line Range 11 West of the 3rd principal Meridian is conformable to the field notes of the Survey thereof on file in this Office.

E. J. Langhorne

Scale of 40 chains to an inch
Aggregate area = 22970.70 acres

Map of Township 11:9 South of the Base Line, in Range 11:1 West of the 3^d principal meridian.

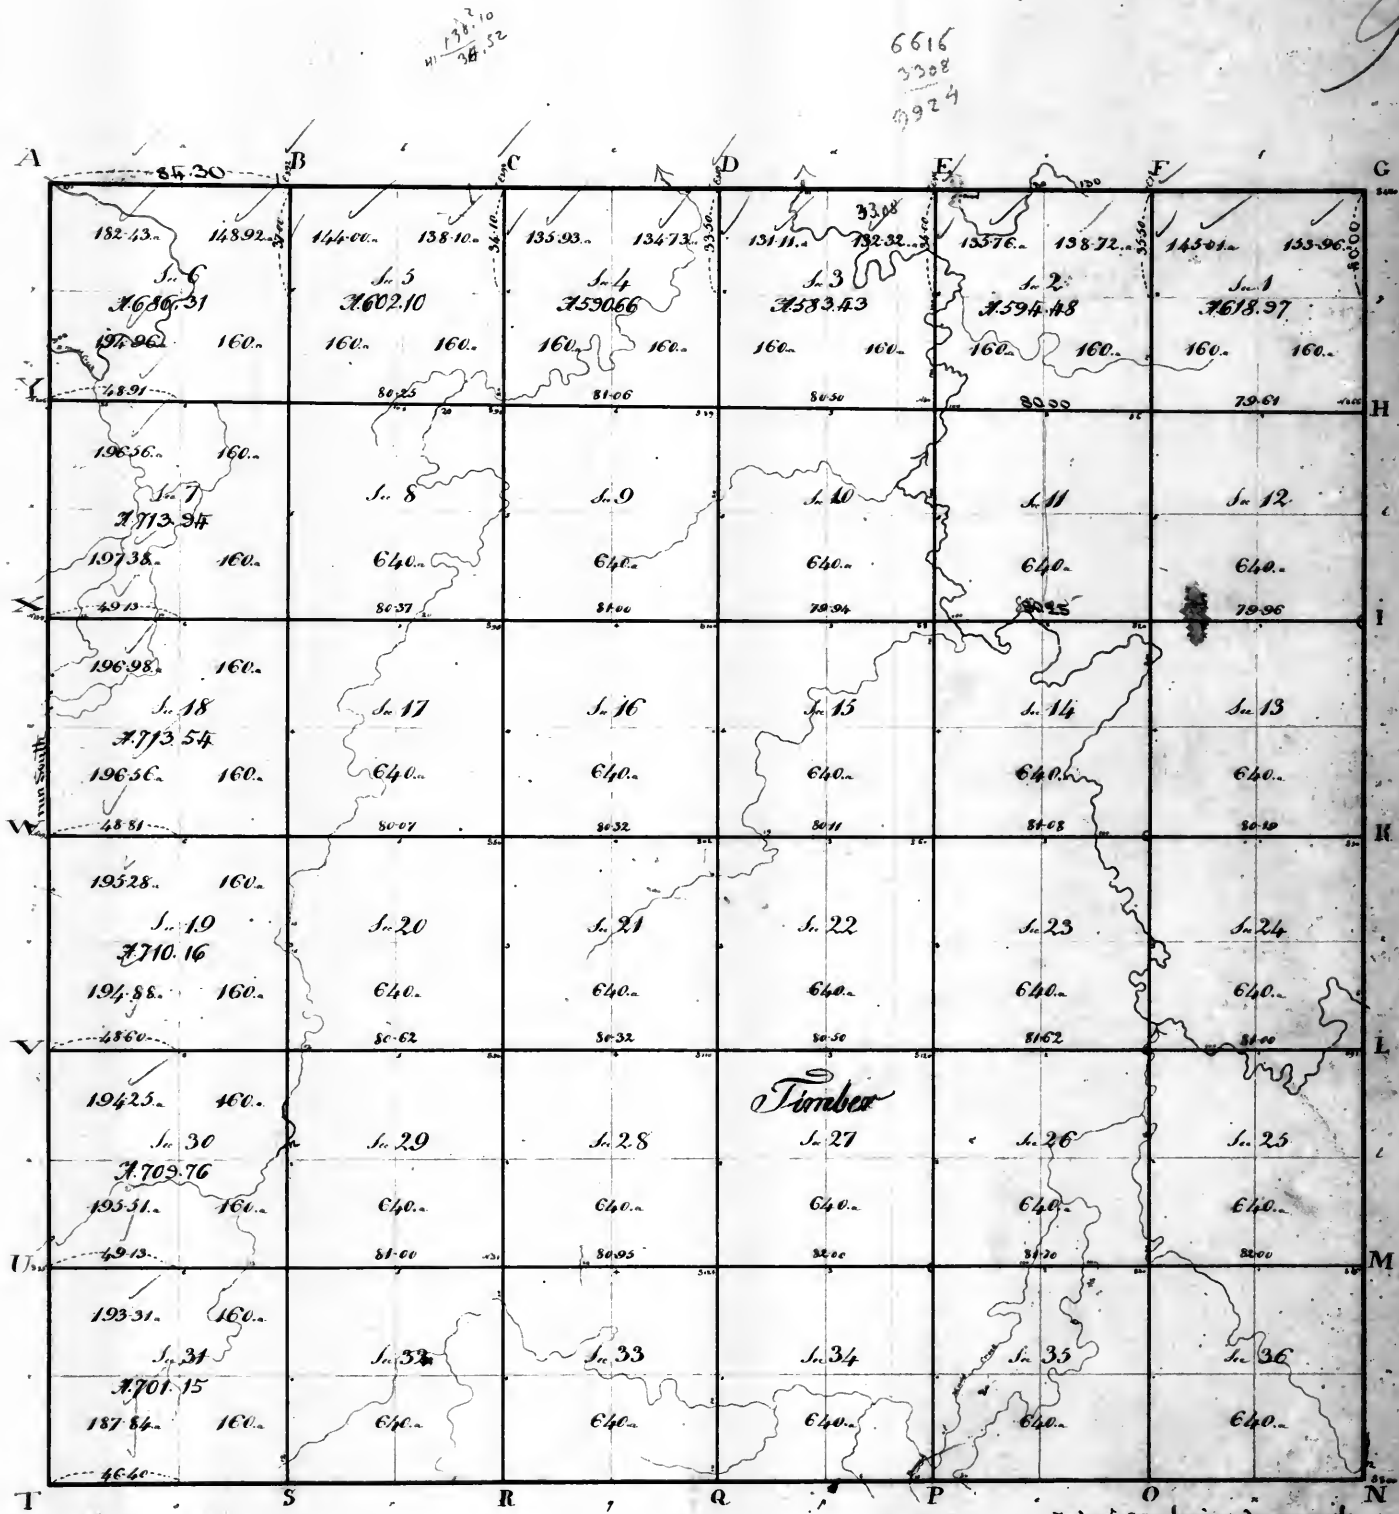


Surveyors Office

St. Louis 19th January 1885.

The above plat of Township 9 South of the Base line Range 11 West of the 3^d principal meridian is conformable to the field notes of the survey thereof on file in this Office.

E. J. Sanghams

Map of Township n: 10 South of the Base line Range n: 1 West of the 3^d principal Meridian.

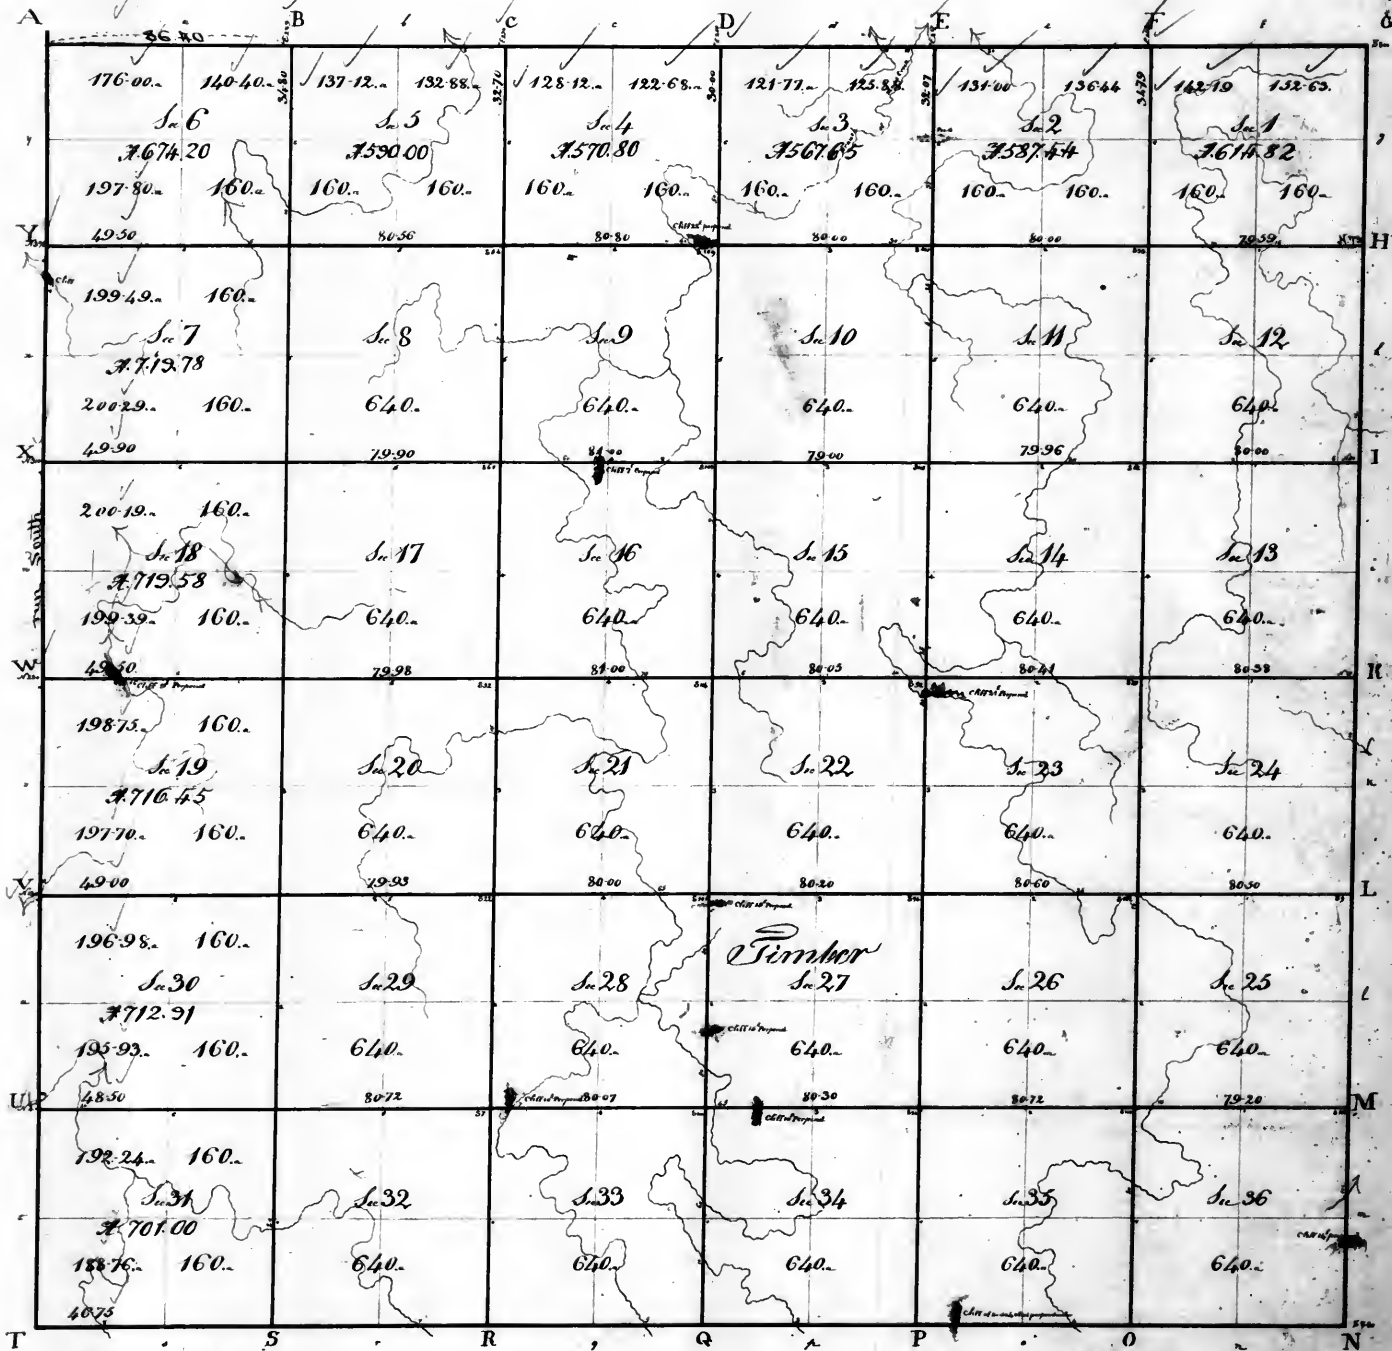


Surveyor's Office
St. Louis 19th January 1835.

Scale of 40 chains to an inch
Aggregate area - 23176.63 acres

The above plat of Township 10 South of the Base line Range 1 West of the 3^d principal Meridian is conformable to the field notes of the survey thereof on file in this Office.

E. J. Longhorne

Plat of Township n: 11 South of the Base line, in Range n: 1 West of the 3^d Principal Meridian

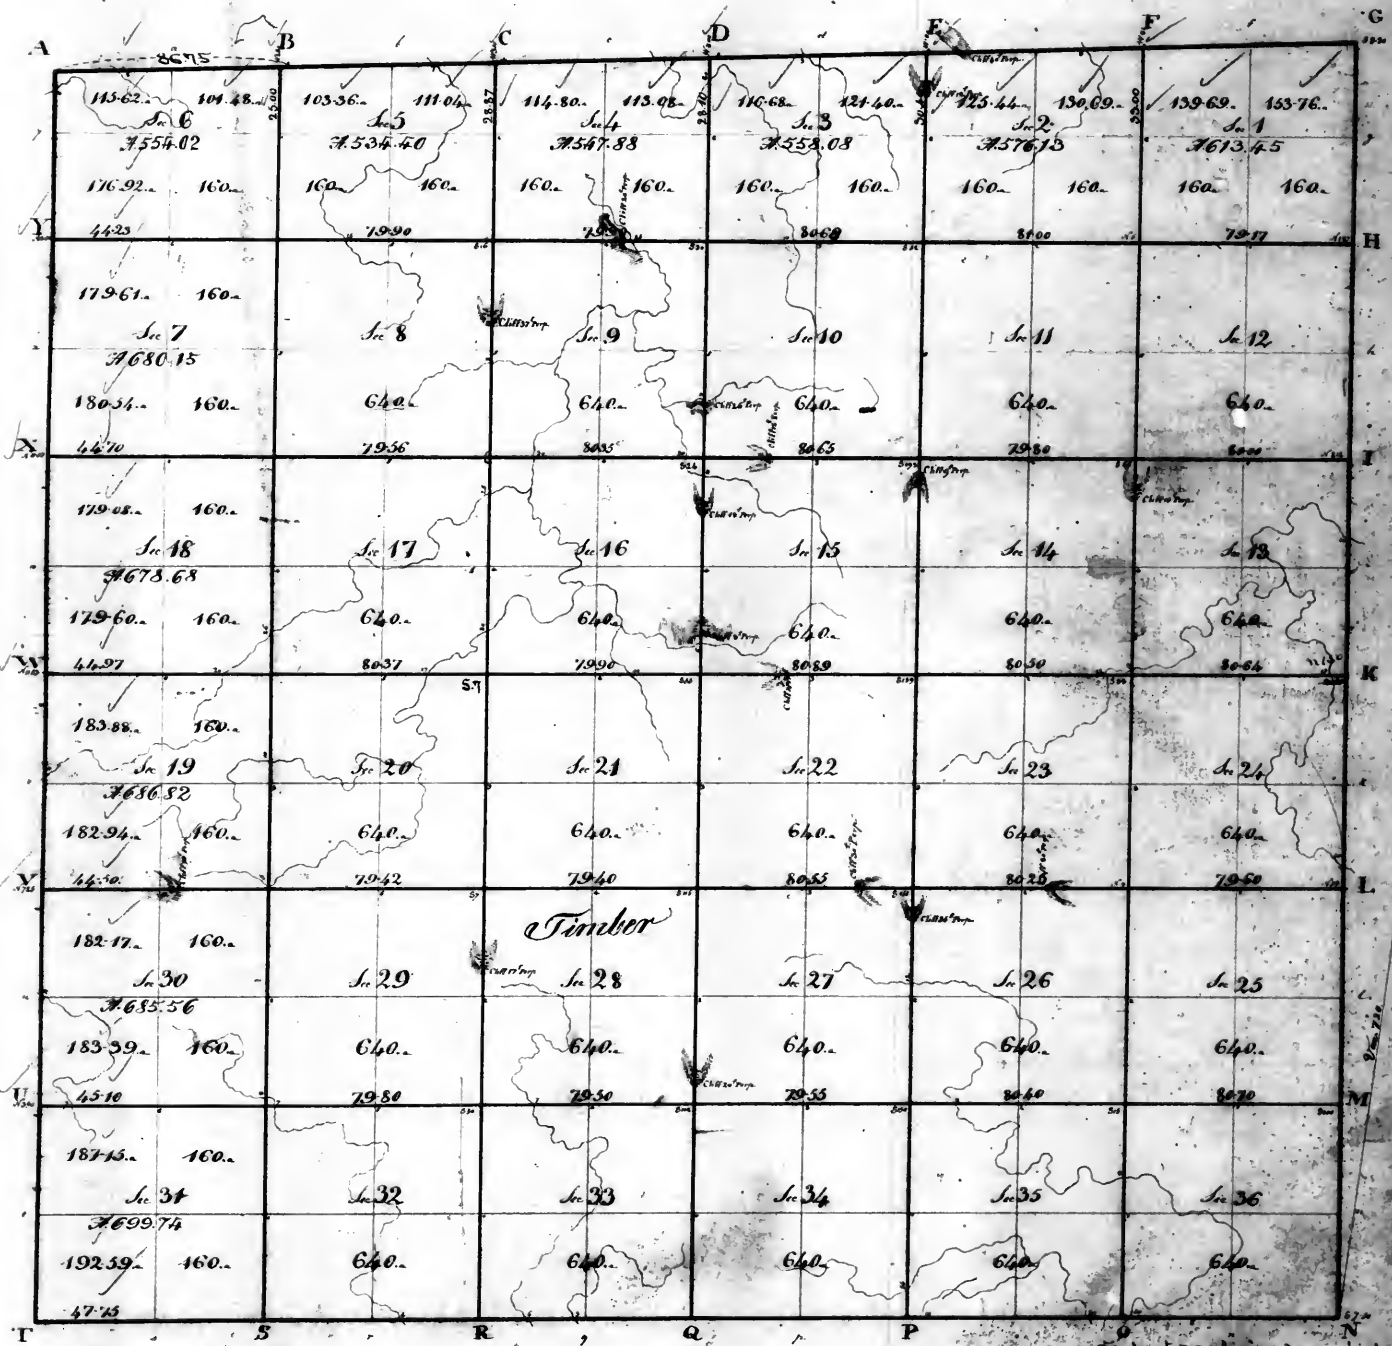


Surveyors Office.

St. Louis 17th January 1835.

The above plat of Township 11 South of the Base line, Range 1 West of the 3^d Principal Meridian is conformable to the field notes of the survey thereof on file in this Office.

E. J. Sengham

Plat of Township n: 11 South of the Base line in Range n: 1 West of the 3^d principal Meridian

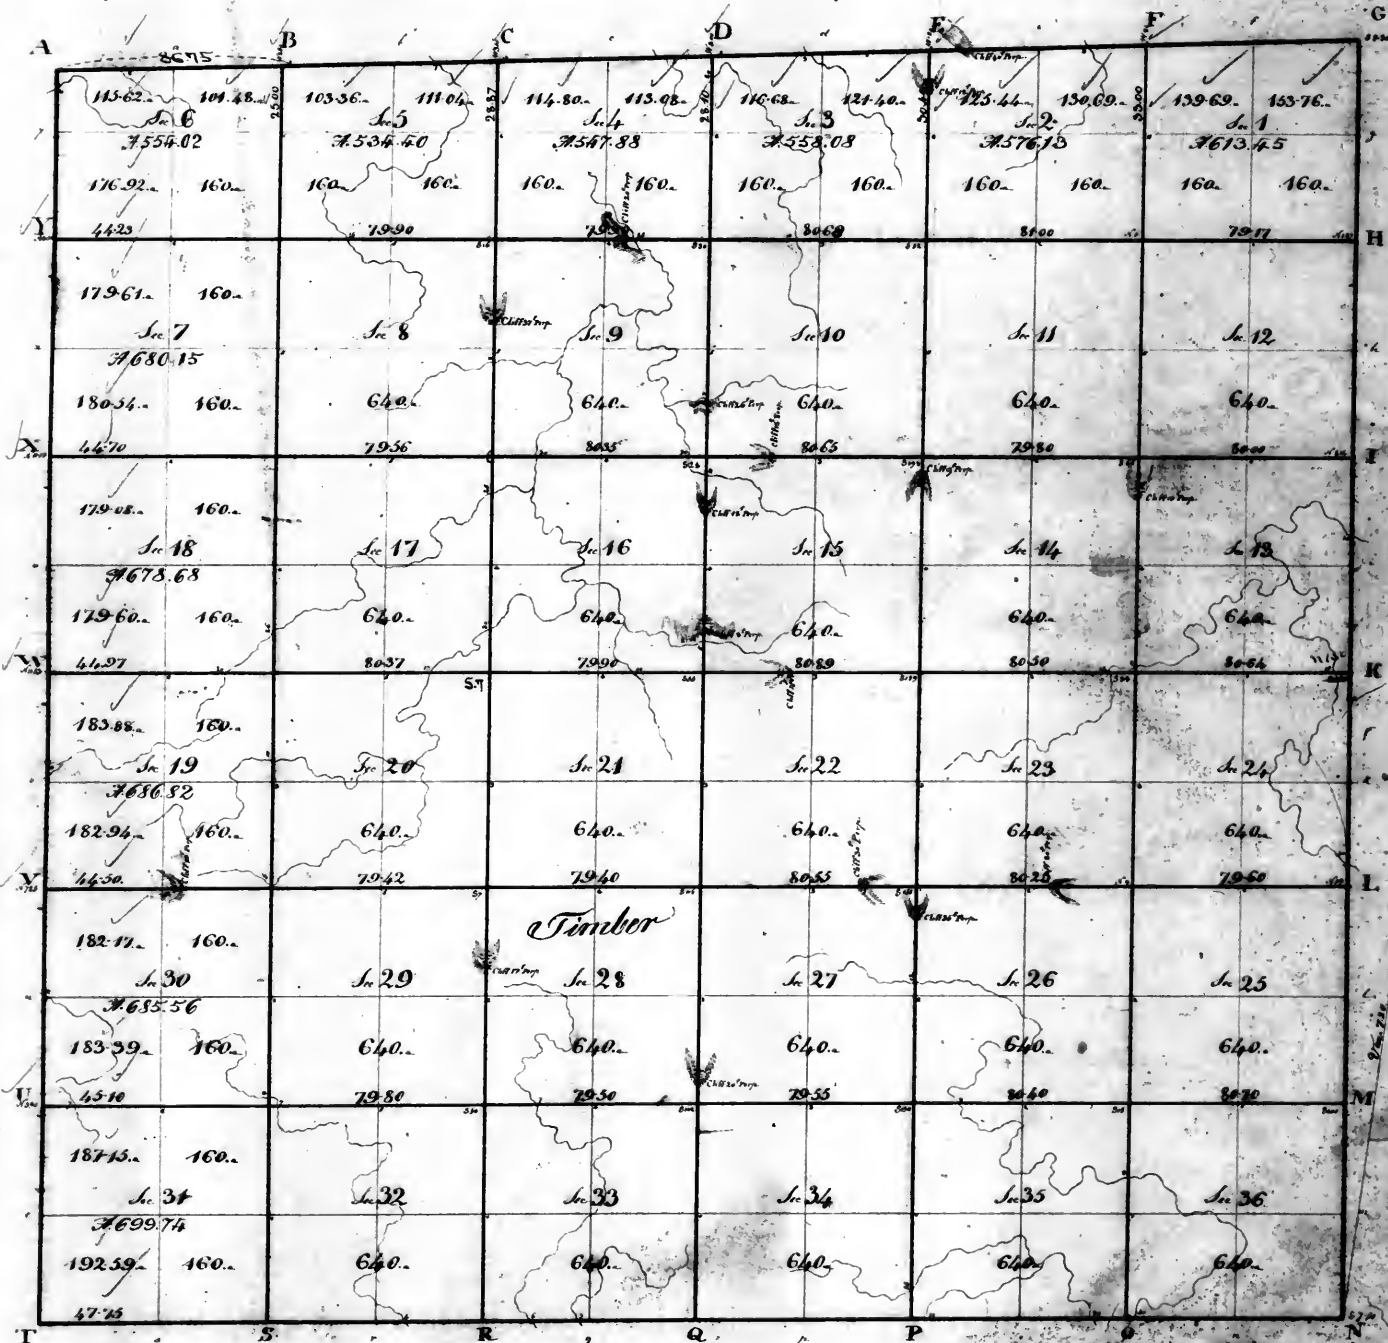

Surveyor's Office.


St. Louis 17th January 1835.

The above plat of Township 11 South of the Base line Range 1 West of the 3^d principal Meridian is conformable to the field notes of the survey thereof on file in this Office.

E. J. Sengham

Plat of Township n: 12 South of the Base line in Range n: 1 West of the Principal meridian.

12

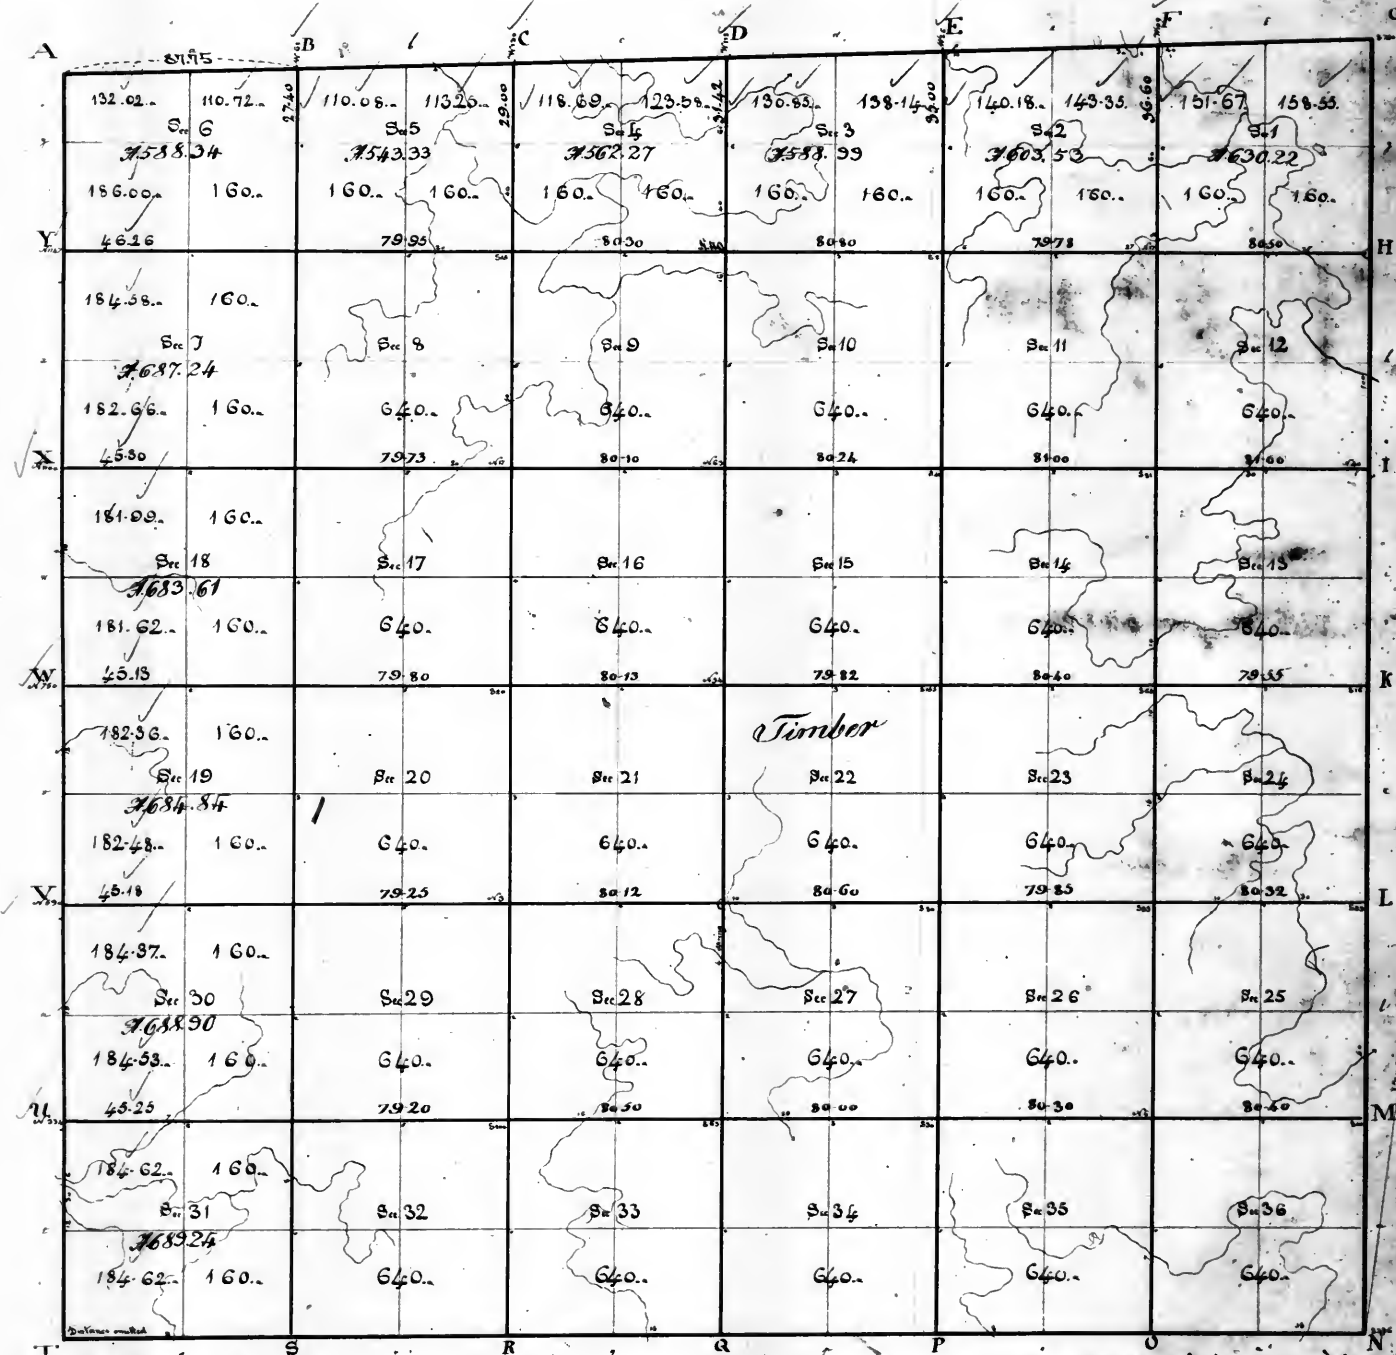

Surveyors Office

St Louis 19th January 1835


The above plat of Township 12 South of the Base line Range 1 West of the Principal meridian is conformable to the field notes of the survey thereof on file in this Office.

Scale of 40 chains to an inch.
Aggregate area - 22950.91 acres

E. J. Sanghams

Plat of Township No. 13 South of the Base Line, in Range No. 1 West of the 3^d Principal Meridian.

13

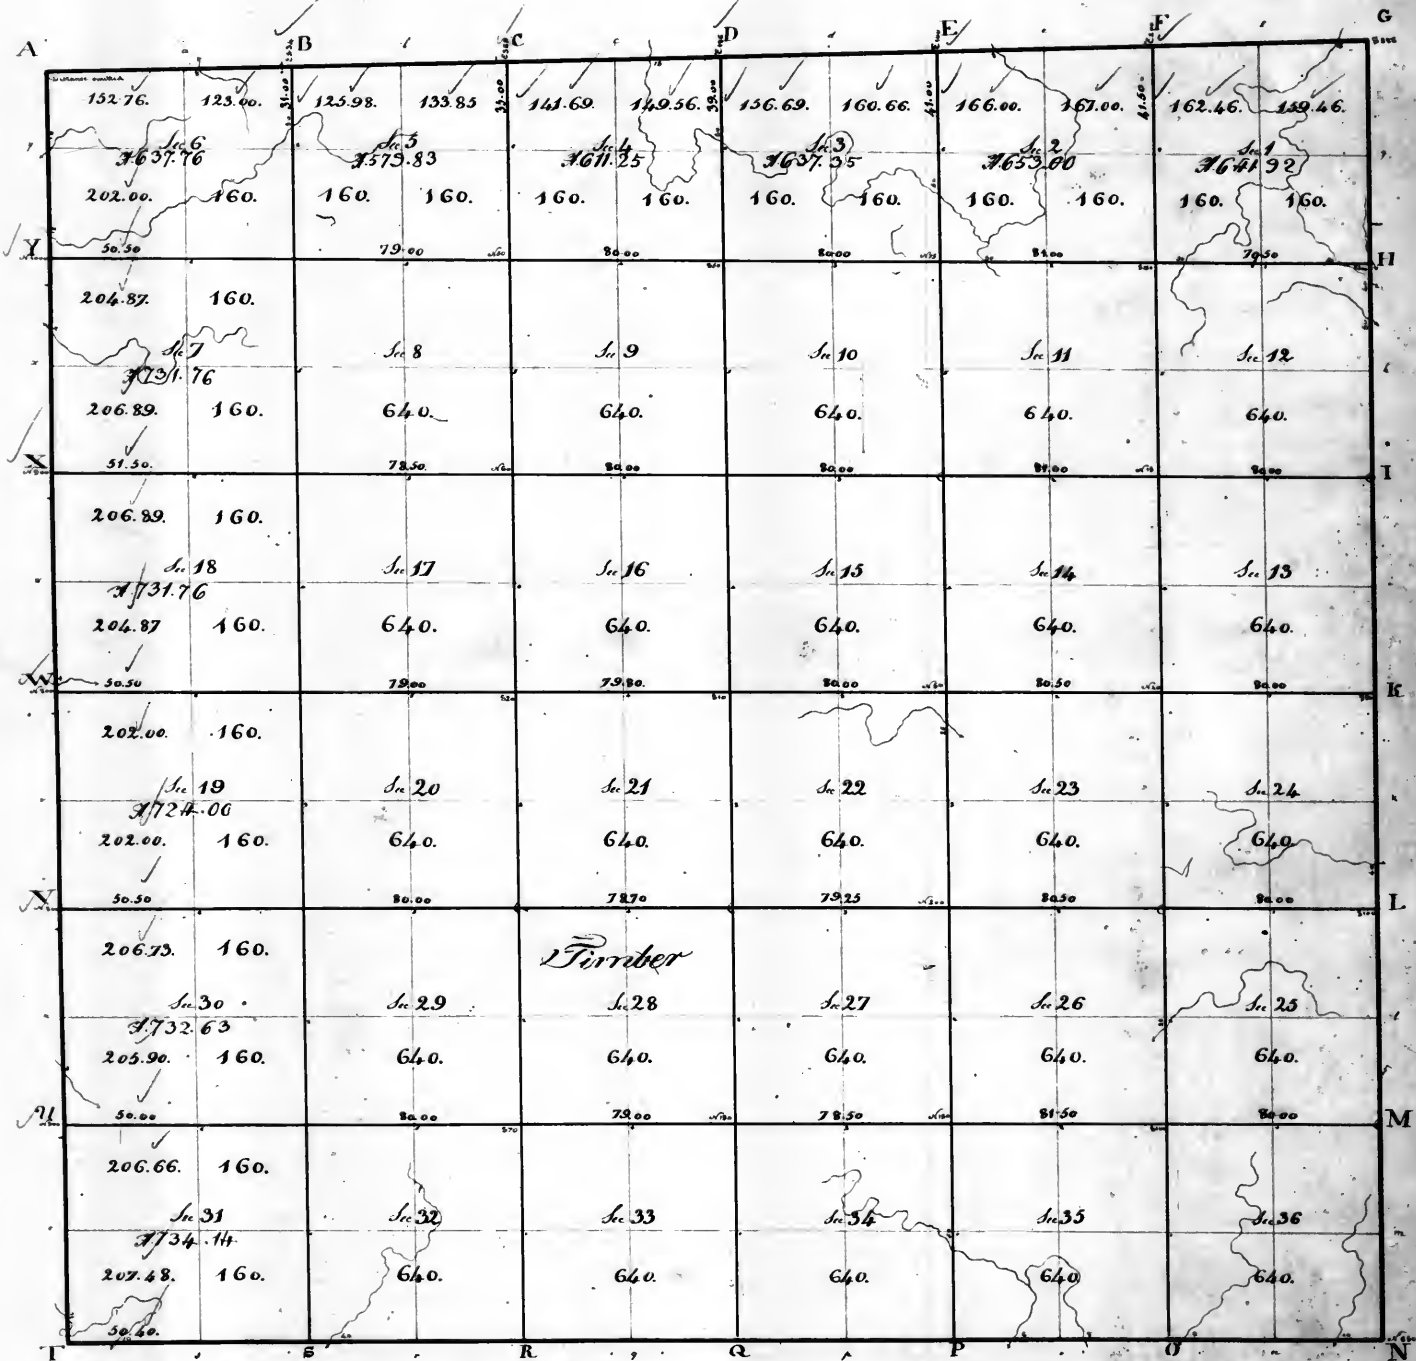

Surveyor's Office
St. Louis 19th January 1855.

Scale of 40 chains to an inch.
Aggregate area - 23415.40 acres

The above plat of Township 13 South of the Base Line Range 1 West of the 3^d Principal Meridian is conformable to the field notes of the survey thereof filed in this Office

E. J. Lingham

14




St. Louis 17th January 1835.

E. J. Snyham

scale of 40 chains to an inch
Aggregate area - 23679.20 acres

Plat of Township n. 15 South of the Base line in Range n. 1 West of the 3^d principal Meridian.

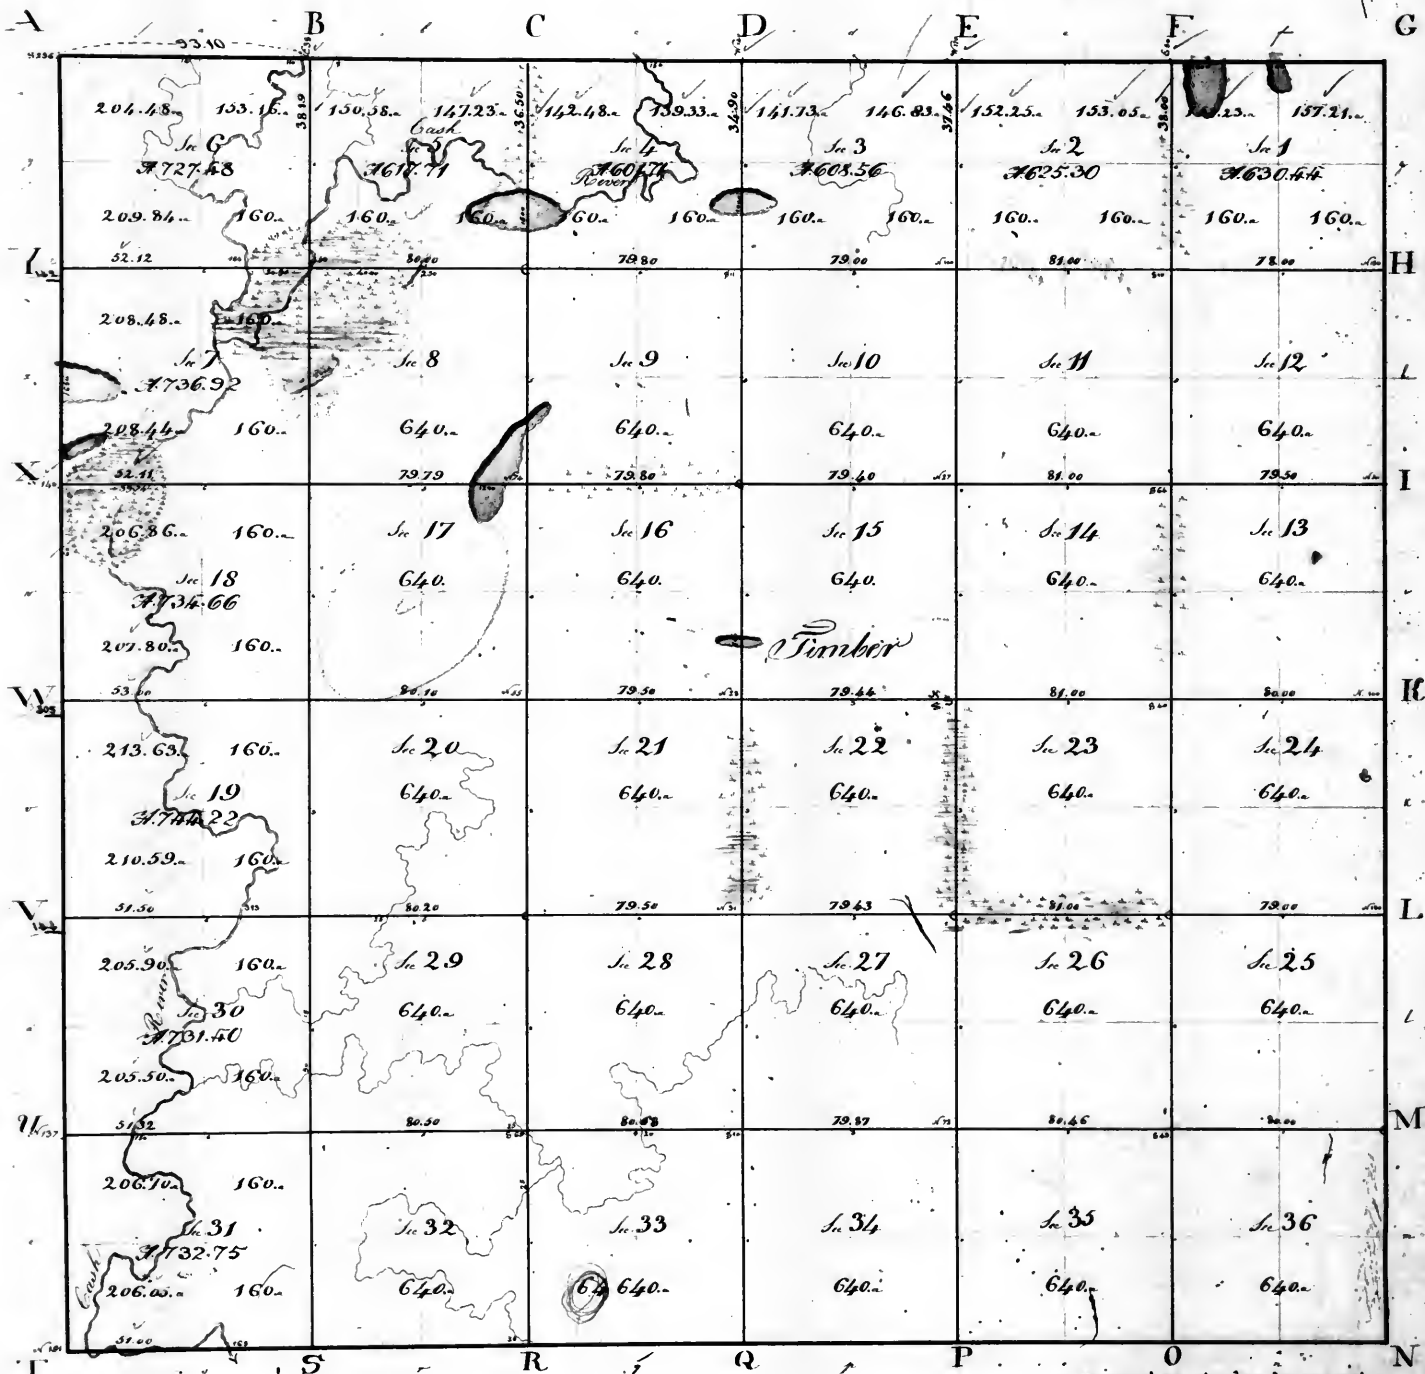

Surveyor's Office


St. Louis 19th January 1835.

The above plat of Township 15 South of the Base line Range 1 West of the 3^d principal Meridian is conformable to the field notes of the survey thereon filed in this Office.

E. J. Sanghorne

Plat of Township n: 16 South of the Baseline in Range n: 1 West of the 3^d Principal Meridian.

16

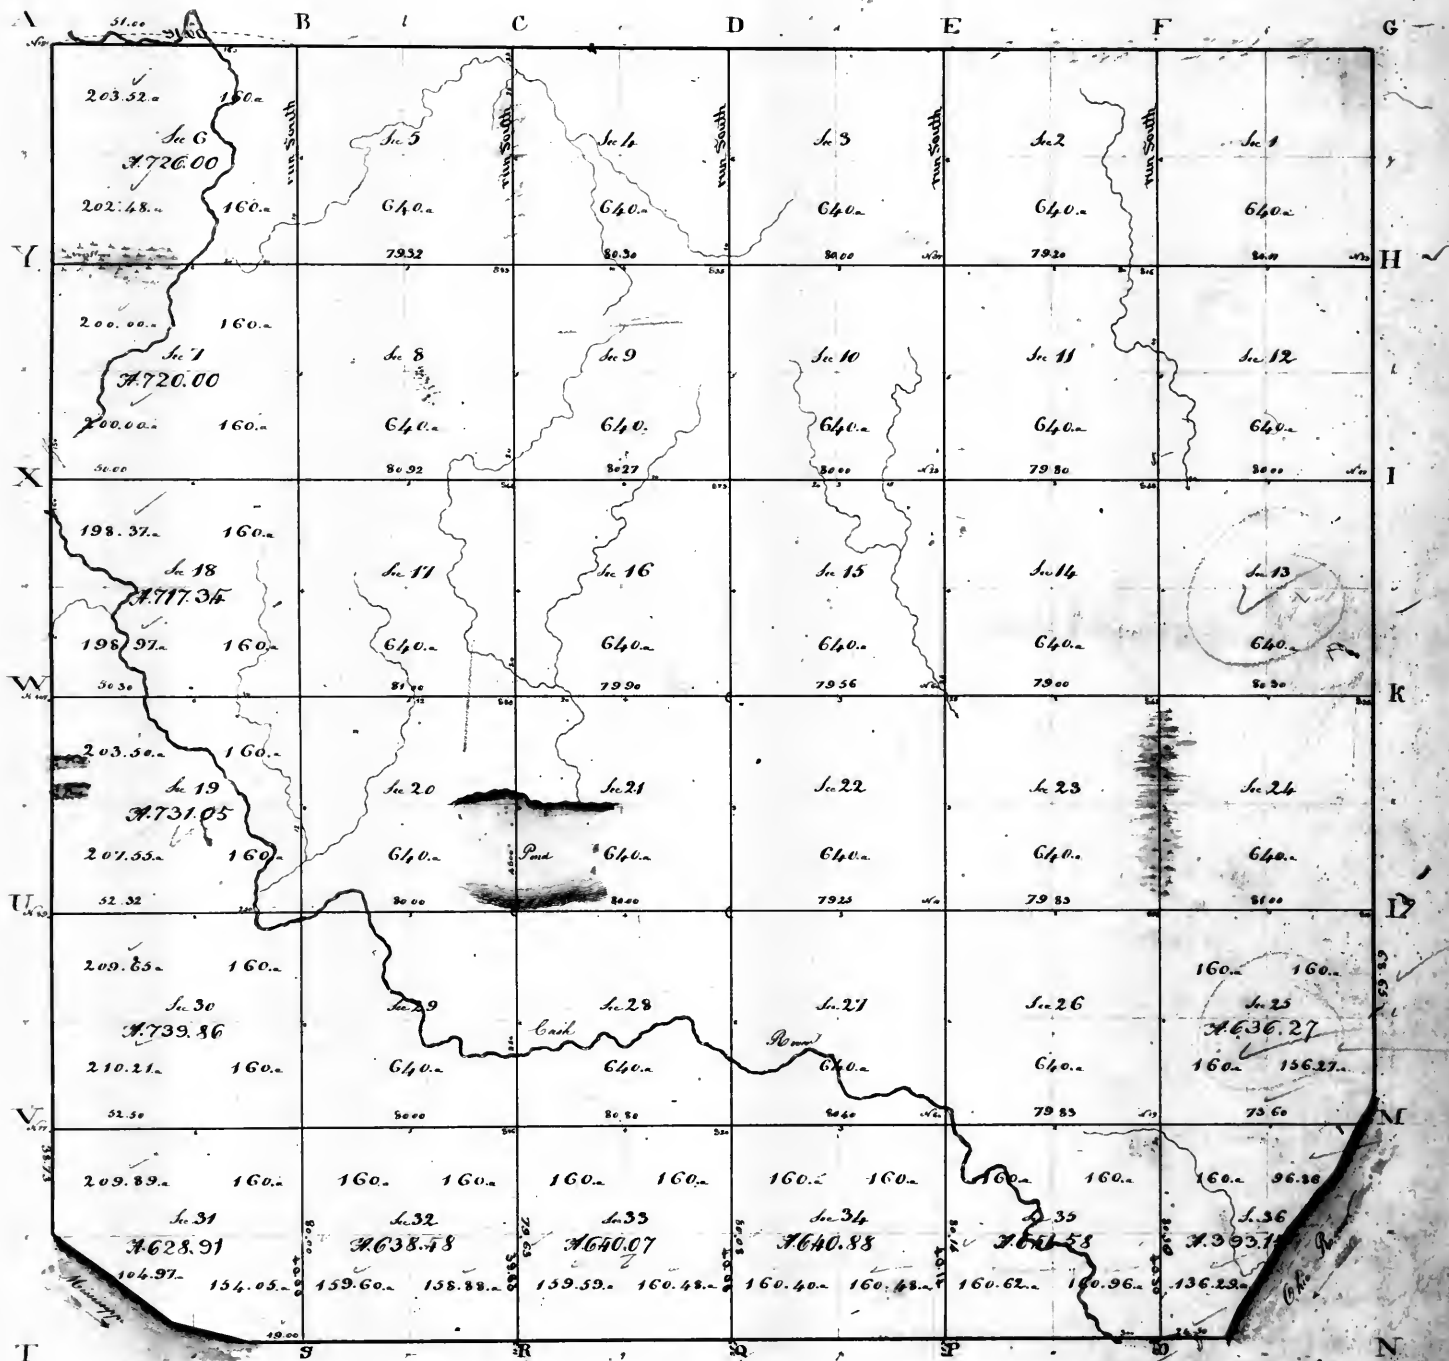


Surveyors Office

St. Louis 19th January 1835

This a true plat of Township 16 South of the Base line Range 1 West of the 3^d Principal Meridian is conformable to the field notes of the Survey thereof on file in this Office.

E. J. S. M. G. H. M.

Plat of Township n. 17 South of the Base line Range n. 1 West of the 3^d principal Meridian. The folios of the survey of Island No. 29 are contained in Book B. 1735 of the Missouri Surveyors.

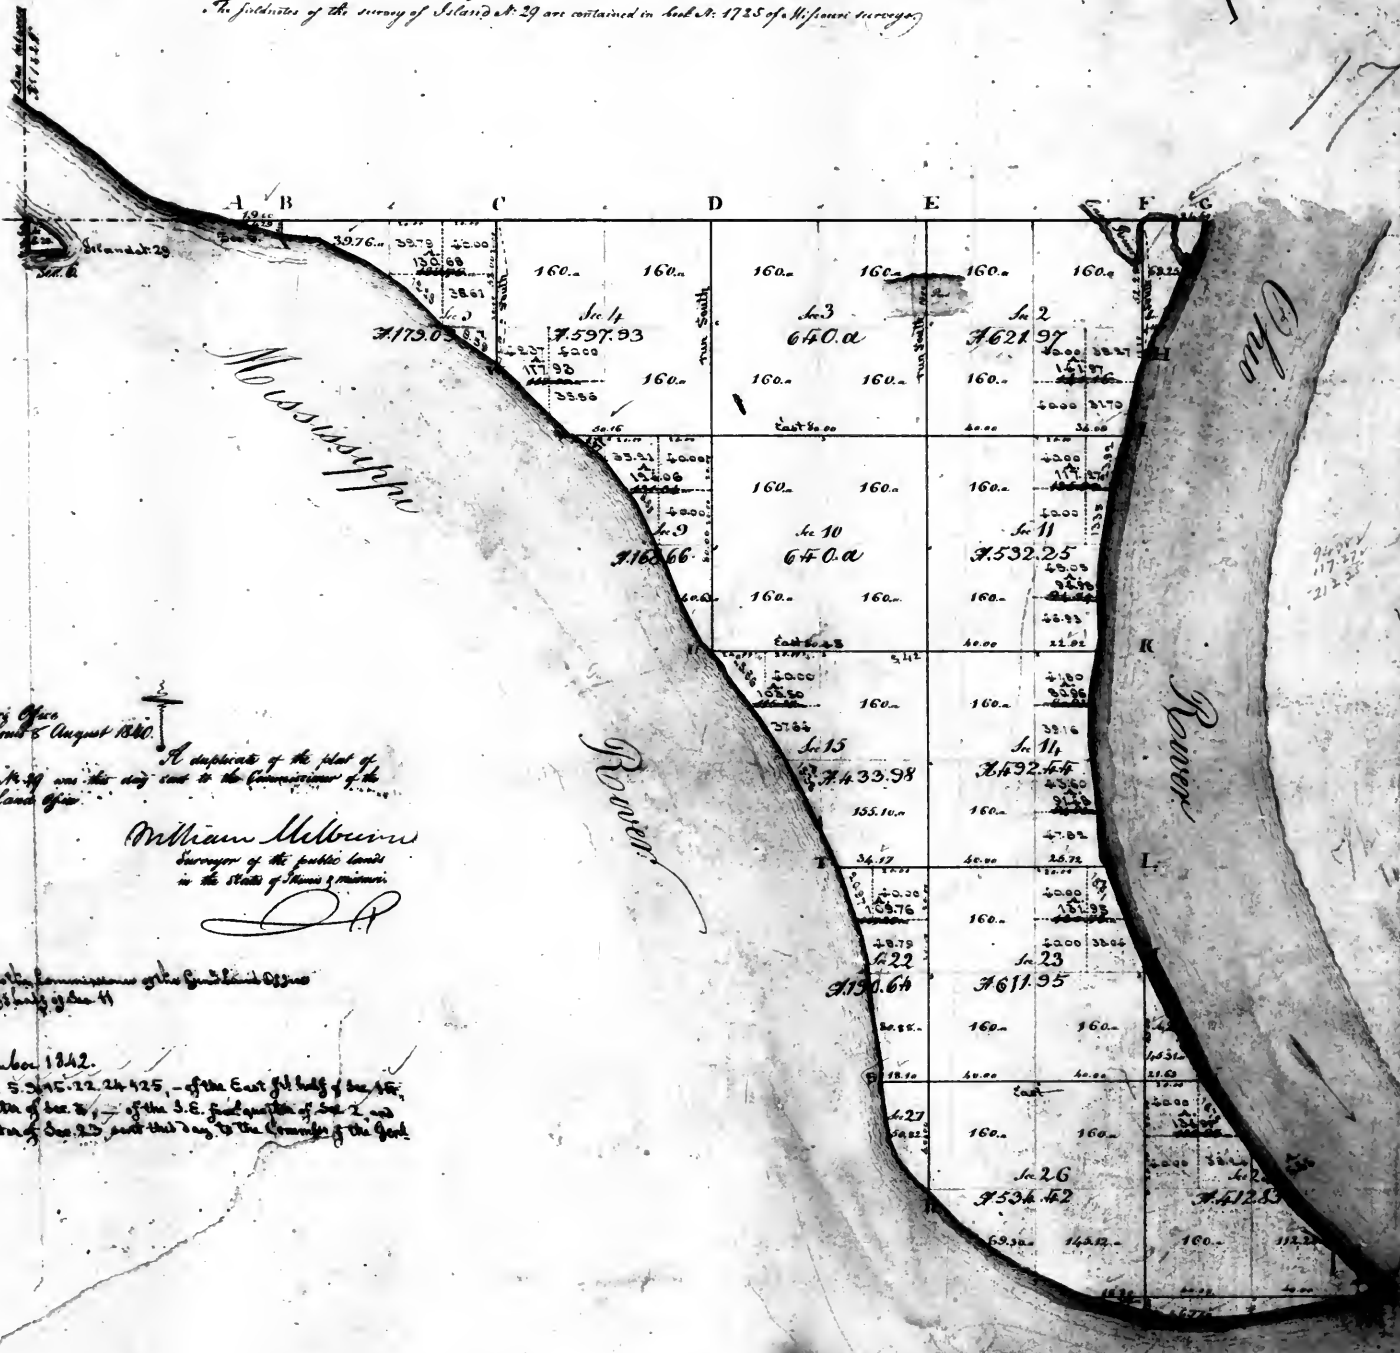

Surveyor's Office
St Louis August 1840.
A duplicate of the plat of
Island No. 29 was this day sent to the Commissioner of the
General Land Office.

William Melbourne
Surveyor of the public lands
in the State of Missouri.

St Louis 14th November 1842.
Plat of Section No. 22, 24, 25, - of the East 1/2 of Sec. 15,
of the S.W. 1/4 of Sec. 2, - of the S.E. 1/4 of Sec. 2, and
of the N.E. 1/4 of Sec. 25, sent this day to the Commissioner of the Genl
Land Office.



Surveyor's Office.
St Louis 17th January 1835.
The above plat of Township 17 South of the Base line Range n. 1 West of the 3^d principal
meridian is conformable to the field notes of the survey thereof on file in this Office.

E. J. Whigham

Plat of Township No. 1 South of the Base line in Range No. 2 West of the 3^d principal Meridian.

18.

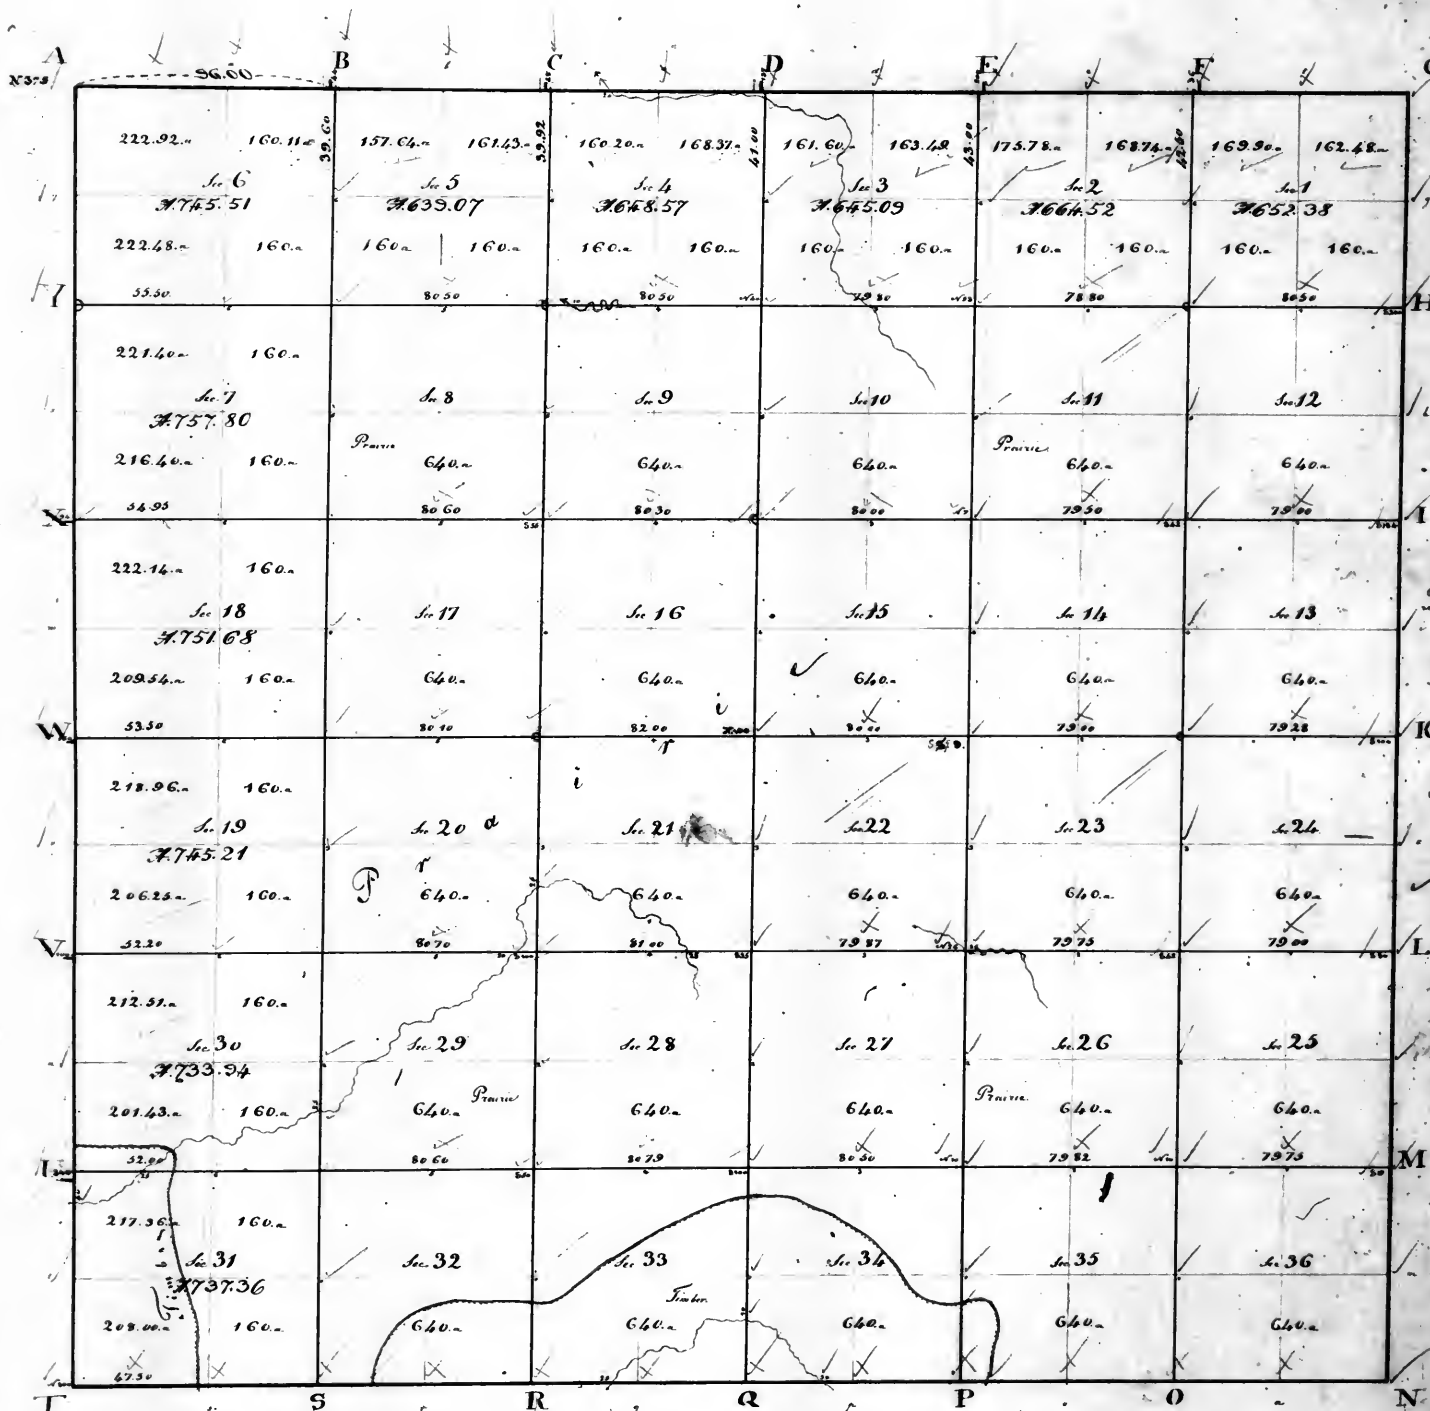


Reference to the field notes used in the construction of this plat.
 South boundary by P.H. Red line for Wm. Rector in Sub. book No. 125 dated Jan'y 10th 1815.
 North boundary by I. Milton Moore for Wm. Rector in Sub. book No. 124 & dated Feb'y 10th 1815.
 East boundary by I. Milton Moore for Wm. Rector in Sub. book No. 124 & dated Feb'y 10th 1815.
 West boundary by Unack'd & L. Milton Moore for Wm. Rector in Sub. book No. 108 & dated Jan'y 10th 1815.
 Subdivision lines by I. Milton Moore for Wm. Rector in book No. 124 & dated from the 5th to the 30th of February 1815.

Surveyors Office
 St. Louis 22^d February 1836

Scale of 40 chains to one inch
 Aggregate area - 23721.15 acres

The above plat of Township 1 South of the Base line Range 2 West of the 3^d principal Meridian is conformable to the field notes of the survey thereof on file in this Office.

E. J. Sampson

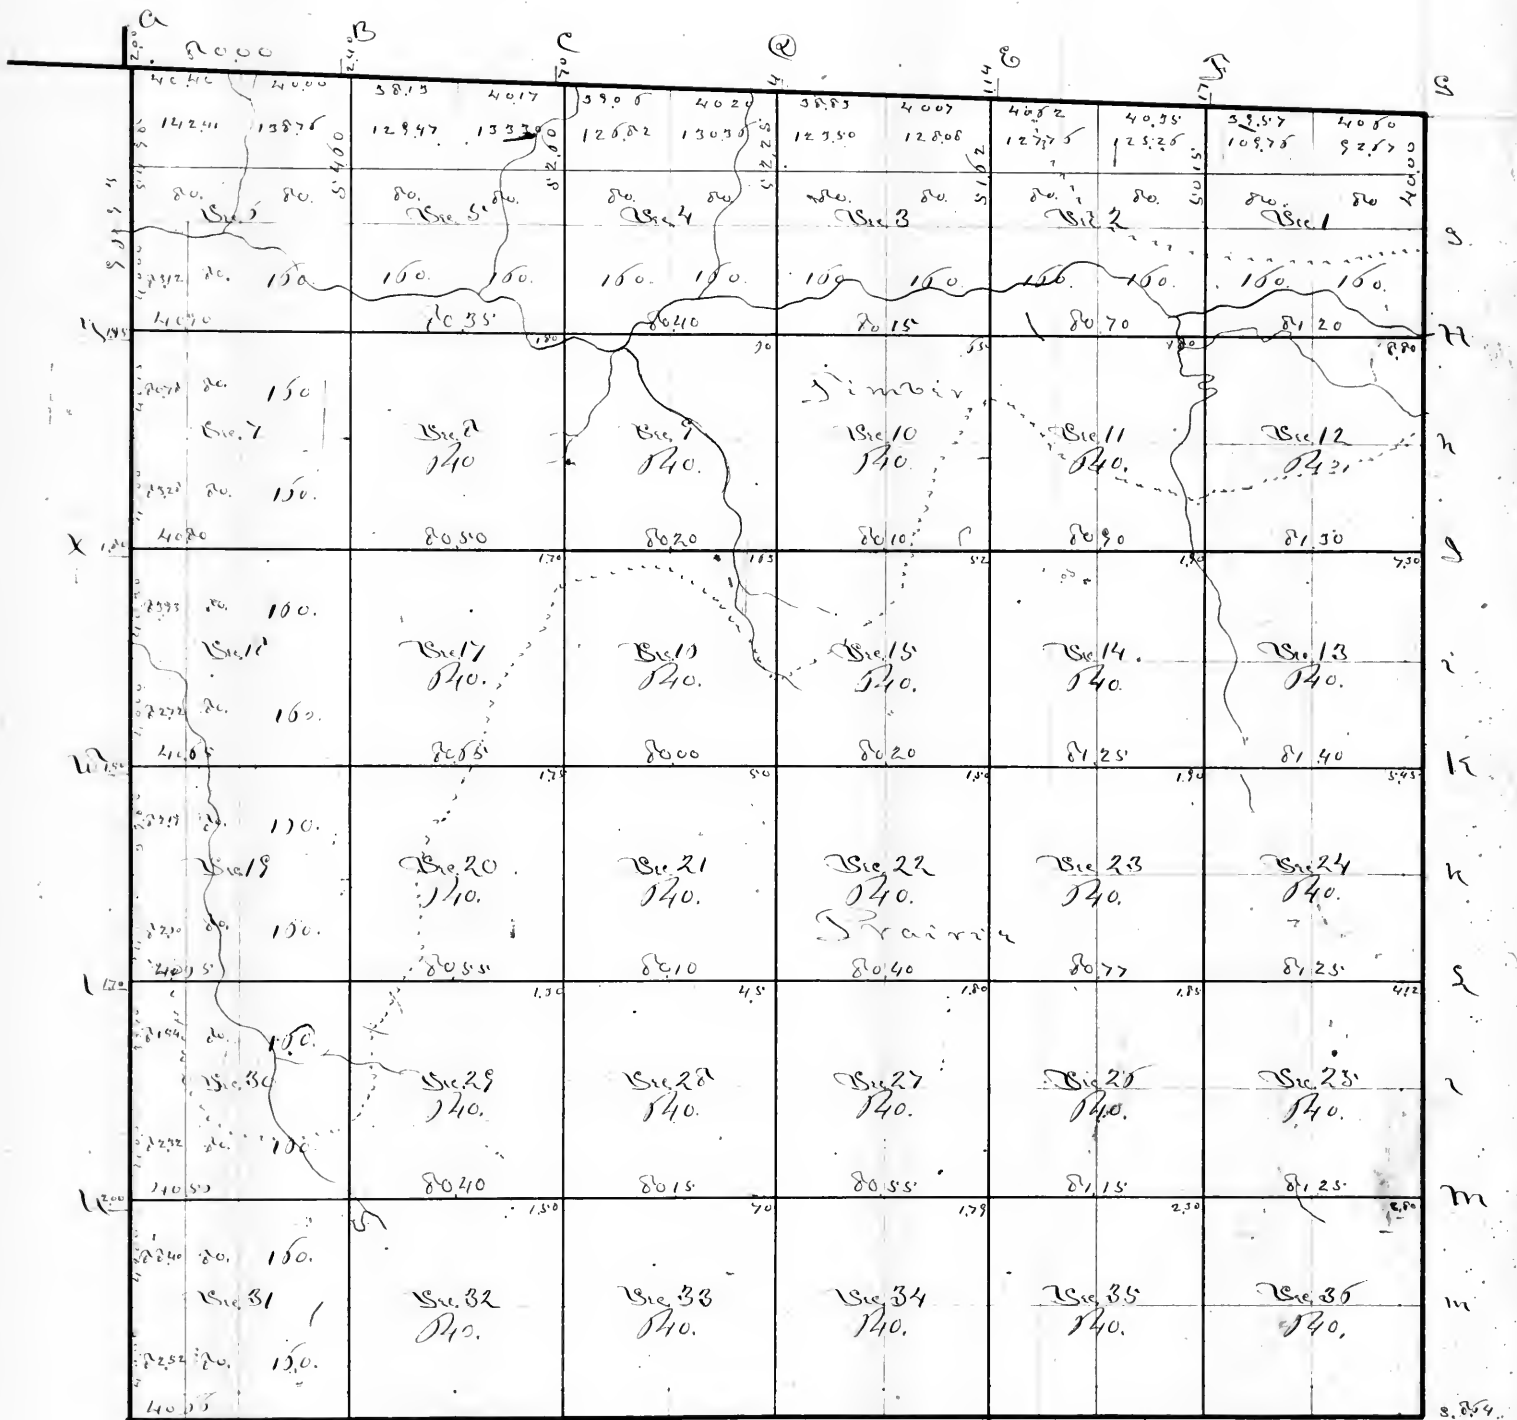

Scale of 40 chains to an inch
 Variation to East
 Congressional Act 2325, 1854
 Office of Custodian U. S. Survey
 Springfield

A true copy of the Original Survey file in this Office

W. W. Newton
 Custodian U. S. Survey

Township N^o 7 North of the Base Line, Range N^o 5 East of the 5th Principal Meridian.

| Exterior Section & Quarter Section corners described. | | | | | Interior Section corners described. | | | | | Interior Section corners, description continued. | | | | | Interior Quarter Section corners, description continued. | | | | | |
|---|----------------|----------|-------------------|------------|-------------------------------------|----------------|----------|-------------------|------------|--|----------------|----------|-------------------|------------|--|----------------|----------|-------------------|------------|--|
| Corners. | Witness Trees. | Section. | Course they bear. | Link dist. | Corners of sections. | Witness Trees. | Section. | Course they bear. | Link dist. | Corners of sections. | Witness Trees. | Section. | Course they bear. | Link dist. | Corners. | Witness Trees. | Section. | Course they bear. | Link dist. | |
| A. <i>Post in mound.</i> | | | | | 25. 26. 35. 36. | W. Oak | 24 | N 62° E | 40 | 29. 30. 31. 32. | South | 18 | N 50° E | 23 | 4. <i>Post in mound.</i> | | | | | |
| | | | | | | W. Oak | 15 | N 57° N | 28 | | Mulberry | 12 | S 24° N | 44 | 5. <i>Pin Oak</i> | 27 | N 8° N | 20 | | |
| B. <i>Post in mound.</i> | | | | | 23. 24. 25. 26. | Pin Oak | 15 | S 71° E | 326 | 19. 20. 29. 30. | Elm | 15 | S 10° N | 52 | 6. <i>Pin Oak</i> | 20 | S 5° E | 45 | | |
| | | | | | | Pin Oak | 15 | N 71° N | 350 | | S. Oak | 20 | N 70° E | 47 | | | | | | |
| C. <i>Lyons</i> | 27 | S 5° N | 34 | | | | | | | | | | | | 10 to E. at 1. | W. Oak | 24 | S 7° E | 43 | |
| D. <i>Hickory</i> | 30 | S 50° E | 31 | | 13. 14. 23. 24. | Hickory | 12 | S 87° E | 59 | 17. 18. 19. 20. | W. Oak | 20 | N 45° E | 18 | 2. <i>Pin Oak</i> | 18 | N 14° N | 57 | | |
| E. <i>Post in mound.</i> | 12 | S 10° E | 115 | | | B. Oak | 15 | N 77° N | 46 | | W. Oak | 20 | S 46° N | 76 | 3. <i>Pin Oak</i> | 18 | N 5° N | 570 | | |
| F. <i>Lyons</i> | 15 | S 45° N | 45 | | | | | | | | | | | | 4. <i>W. Oak</i> | 18 | N 74° N | 40 | | |
| G. <i>Pin Oak</i> | 15 | S 36° N | 46 | | | | | | | | | | | | 5. <i>W. Oak</i> | 18 | S 65° E | — | | |
| | 18 | S 45° E | 53 | | 11. 12. 13. 14. | W. Oak | 20 | N 57° E | 13 | 7. 8. 17. 18. | Post Oak | 12 | S 24° E | 34 | 1. <i>W. Oak</i> | 27 | N 70° E | 8 | | |
| | 15 | S 33° N | 71 | | | W. Oak | 12 | N 53° N | 29 | | Post Oak | 15 | N 9° N | 32 | 2. <i>S. Oak</i> | 18 | S 55° N | 28 | | |
| | 15 | S 12° N | 25 | | | | | | | | | | | | 3. <i>W. Oak</i> | 27 | S 9° N | 57 | | |
| | 15 | S 36° N | 46 | | 1. 2. 11. 12. | Elm | 24 | S 40° N | 15 | 5. 6. 7. 8. | Hardwood | 24 | S 29° E | 22 | 4. <i>Hickory</i> | 18 | S 4° E | 37 | | |
| | | | | | | Elm | 12 | S 55° E | 30 | | W. Oak | 26 | N 72° N | 53 | 5. <i>W. Oak</i> | 18 | S 12° E | 25 | | |
| | | | | | | | | | | | | | | | 6. <i>W. Oak</i> | 18 | N 57° E | 16 | | |
| | | | | | | | | | | | | | | | 7. <i>Maple</i> | 15 | N 5° N | 13 | | |
| | | | | | | | | | | | | | | | 8. <i>Maple</i> | 12 | S 61° E | 38 | | |
| | | | | | | | | | | | | | | | 9. <i>Sugar tree</i> | 8 | S 5° E | 19 | | |
| | | | | | | | | | | | | | | | 10. <i>S. Oak</i> | 15 | N 62° N | 5 | | |
| | | | | | | | | | | | | | | | 11. <i>Hickory</i> | 24 | N 50° N | 17 | | |
| | | | | | | | | | | | | | | | 12. <i>Mulberry</i> | 15 | S 20° E | 42 | | |
| | | | | | | | | | | | | | | | 13. <i>W. Oak</i> | 36 | S 37° N | 21 | | |
| | | | | | | | | | | | | | | | 14. <i>W. Oak</i> | 18 | N 37° E | 37 | | |
| | | | | | | | | | | | | | | | 15. <i>Hickory</i> | 8 | S 39° N | 40 | | |
| | | | | | | | | | | | | | | | 16. <i>Sicamore</i> | 12 | N 39° E | 56 | | |
| | | | | | | | | | | | | | | | 17. <i>W. Oak</i> | 20 | N 6° N | 35 | | |
| | | | | | | | | | | | | | | | 18. <i>W. Oak</i> | 15 | S 25° N | 5 | | |
| | | | | | | | | | | | | | | | 19. <i>W. Oak</i> | 18 | S 20° E | 21 | | |
| | | | | | | | | | | | | | | | 20. <i>Sicamore</i> | 18 | N 1° E | 49 | | |
| | | | | | | | | | | | | | | | 21. <i>W. Oak</i> | 18 | N 15° N | 53 | | |
| | | | | | | | | | | | | | | | 22. <i>W. Oak</i> | 24 | S 12° E | 64 | | |
| | | | | | | | | | | | | | | | 23. <i>S. Oak</i> | 15 | N 15° E | 16 | | |
| | | | | | | | | | | | | | | | 24. <i>Hickory</i> | 12 | S 75° N | 19 | | |
| | | | | | | | | | | | | | | | 25. <i>W. Oak</i> | 24 | N 31° E | 27 | | |
| | | | | | | | | | | | | | | | 26. <i>Hickory</i> | 12 | S 74° N | 57 | | |
| | | | | | | | | | | | | | | | 27. <i>Post in mound.</i> | | | | | |
| | | | | | | | | | | | | | | | 28. <i>Sugar tree</i> | 15 | S 24° E | 31 | | |
| | | | | | | | | | | | | | | | 29. <i>Mulberry</i> | 15 | N 24° N | 57 | | |
| | | | | | | | | | | | | | | | 30. <i>S. Oak</i> | 15 | N 53° N | 20 | | |
| | | | | | | | | | | | | | | | 31. <i>S. Oak</i> | 12 | N 70° E | 17 | | |
| | | | | | | | | | | | | | | | 32. <i>S. Oak</i> | 12 | N 70° E | 35 | | |
| | | | | | | | | | | | | | | | 33. <i>S. Oak</i> | 12 | N 70° E | 35 | | |
| | | | | | | | | | | | | | | | | | | | | |

Township No. 7 North of the Base Line. Range No. 5 East of the 5th Principal Meridian.


| Exterior Section & Quarter Section corners described. | | | | | Interior Section corners described. | | | | | Interior Section corners, description continued. | | | | | Interior Quarter Section corners, description continued. | | | | |
|---|------------------|---------|-------------------|-------------|-------------------------------------|------------------|---------|-------------------|-------------|--|----------------|---------|-------------------|-------------|--|------------------|---------|-------------------|-------------|
| Corner. | Witness Trees. | Section | Course they bear. | Links dist. | Corner of Section. | Witness Trees. | Section | Course they bear. | Links dist. | Corner of Section. | Witness Trees. | Section | Course they bear. | Links dist. | Corner. | Witness Trees. | Section | Course they bear. | Links dist. |

REMARKS.

Wm. H. Jones, Surveyor

Plat of Township No. 2 South of the Base line in Range No. 2 West of the 3^d principal Meridian.

19

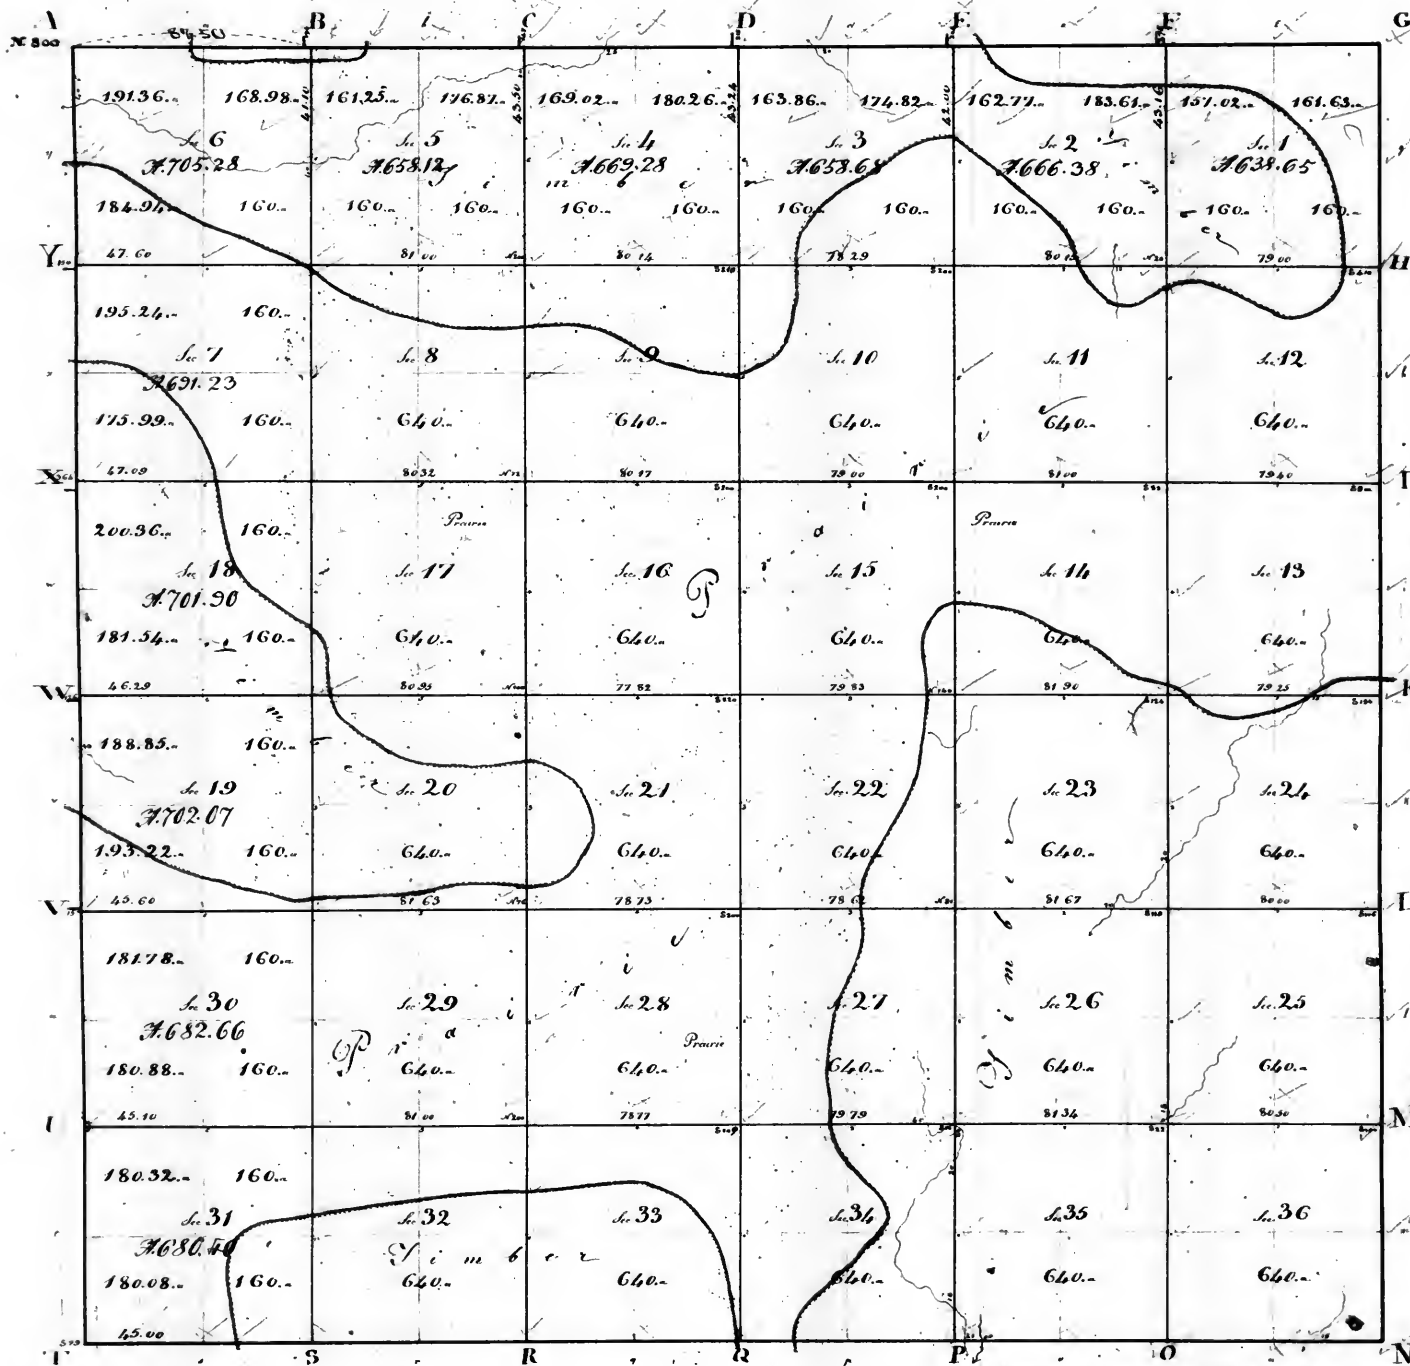

Reference to the field notes used in the construction of this plat. West boundary by P. H. Robbins for Elias Rector in Sub. book No. 109 & dated November 9th 1814. South boundary by P. H. Robbins for Elias Rector in Sub. book No. 126 & dated December 27th 1814. East boundary by P. H. Robbins for Wm. Rector in Sub. book No. 125 & dated January 5th 1815. North boundary by P. H. Robbins for Wm. Rector in Sub. book No. 125 & dated January 10th 1815. Subdivision lines by P. H. Robbins for Wm. Rector in book No. 125 & dated from the 15th to the 25th May 1814.

Surveyors Office
St. Louis 22^d February 1836

Aggregate area = 23454.65 acres
Scale of 40 chains to one inch

The above plat of Township 2 South of the Base line Range 2 West of the 3^d principal Meridian is conformable to the field notes of the survey then on file in this Office.

E. J. Sangham